

Engineering Drawings and Specifications

Former Nanisivik Mine

Non-Hazardous Waste Landfill Design


ACTIVE DRAWING STATUS


DWG NUMBER	DRAWING TITLE	REVISION	DATE	STATUS	OLD/REPLACED REVISIONS	
					Issued for Construction	Issued for Review
1CB002.003-00	Engineering Drawings and Specifications - Former Nanisivik Mine, Non-Hazardous Waste Landfill Design	AB	Aug. 28, 2015	As-Built Pre-commissioning	Rev. 0 Feb 27, 2015	Rev. A Feb. 4, 2015
1CB002.003-01	Site Location	AB	Aug. 28, 2015	As-Built Pre-commissioning	Rev. 0 Feb 27, 2015	Rev. A Feb. 4, 2015
1CB002.003-02	Landfill Plan	AB	Aug. 28, 2015	As-Built Pre-commissioning	Rev. 0 Feb 27, 2015	Rev. A Feb. 4, 2015
1CB002.003-03	Final Grading Plan	AB	Aug. 28, 2015	As-Built Pre-commissioning	Rev. 0 Feb 27, 2015	Rev. A Feb. 4, 2015
1CB002.003-04	Sections and Details	AB	Aug. 28, 2015	As-Built Pre-commissioning	Rev. 0 Feb 27, 2015	Rev. A Feb. 4, 2015

CanZinco Mines Ltd



PROJECT NO: 1CB002.003
AS-BUILT PRE-COMMISSIONING
REVISION AB, August 28, 2015
Drawing No.: 1CB002.003-00

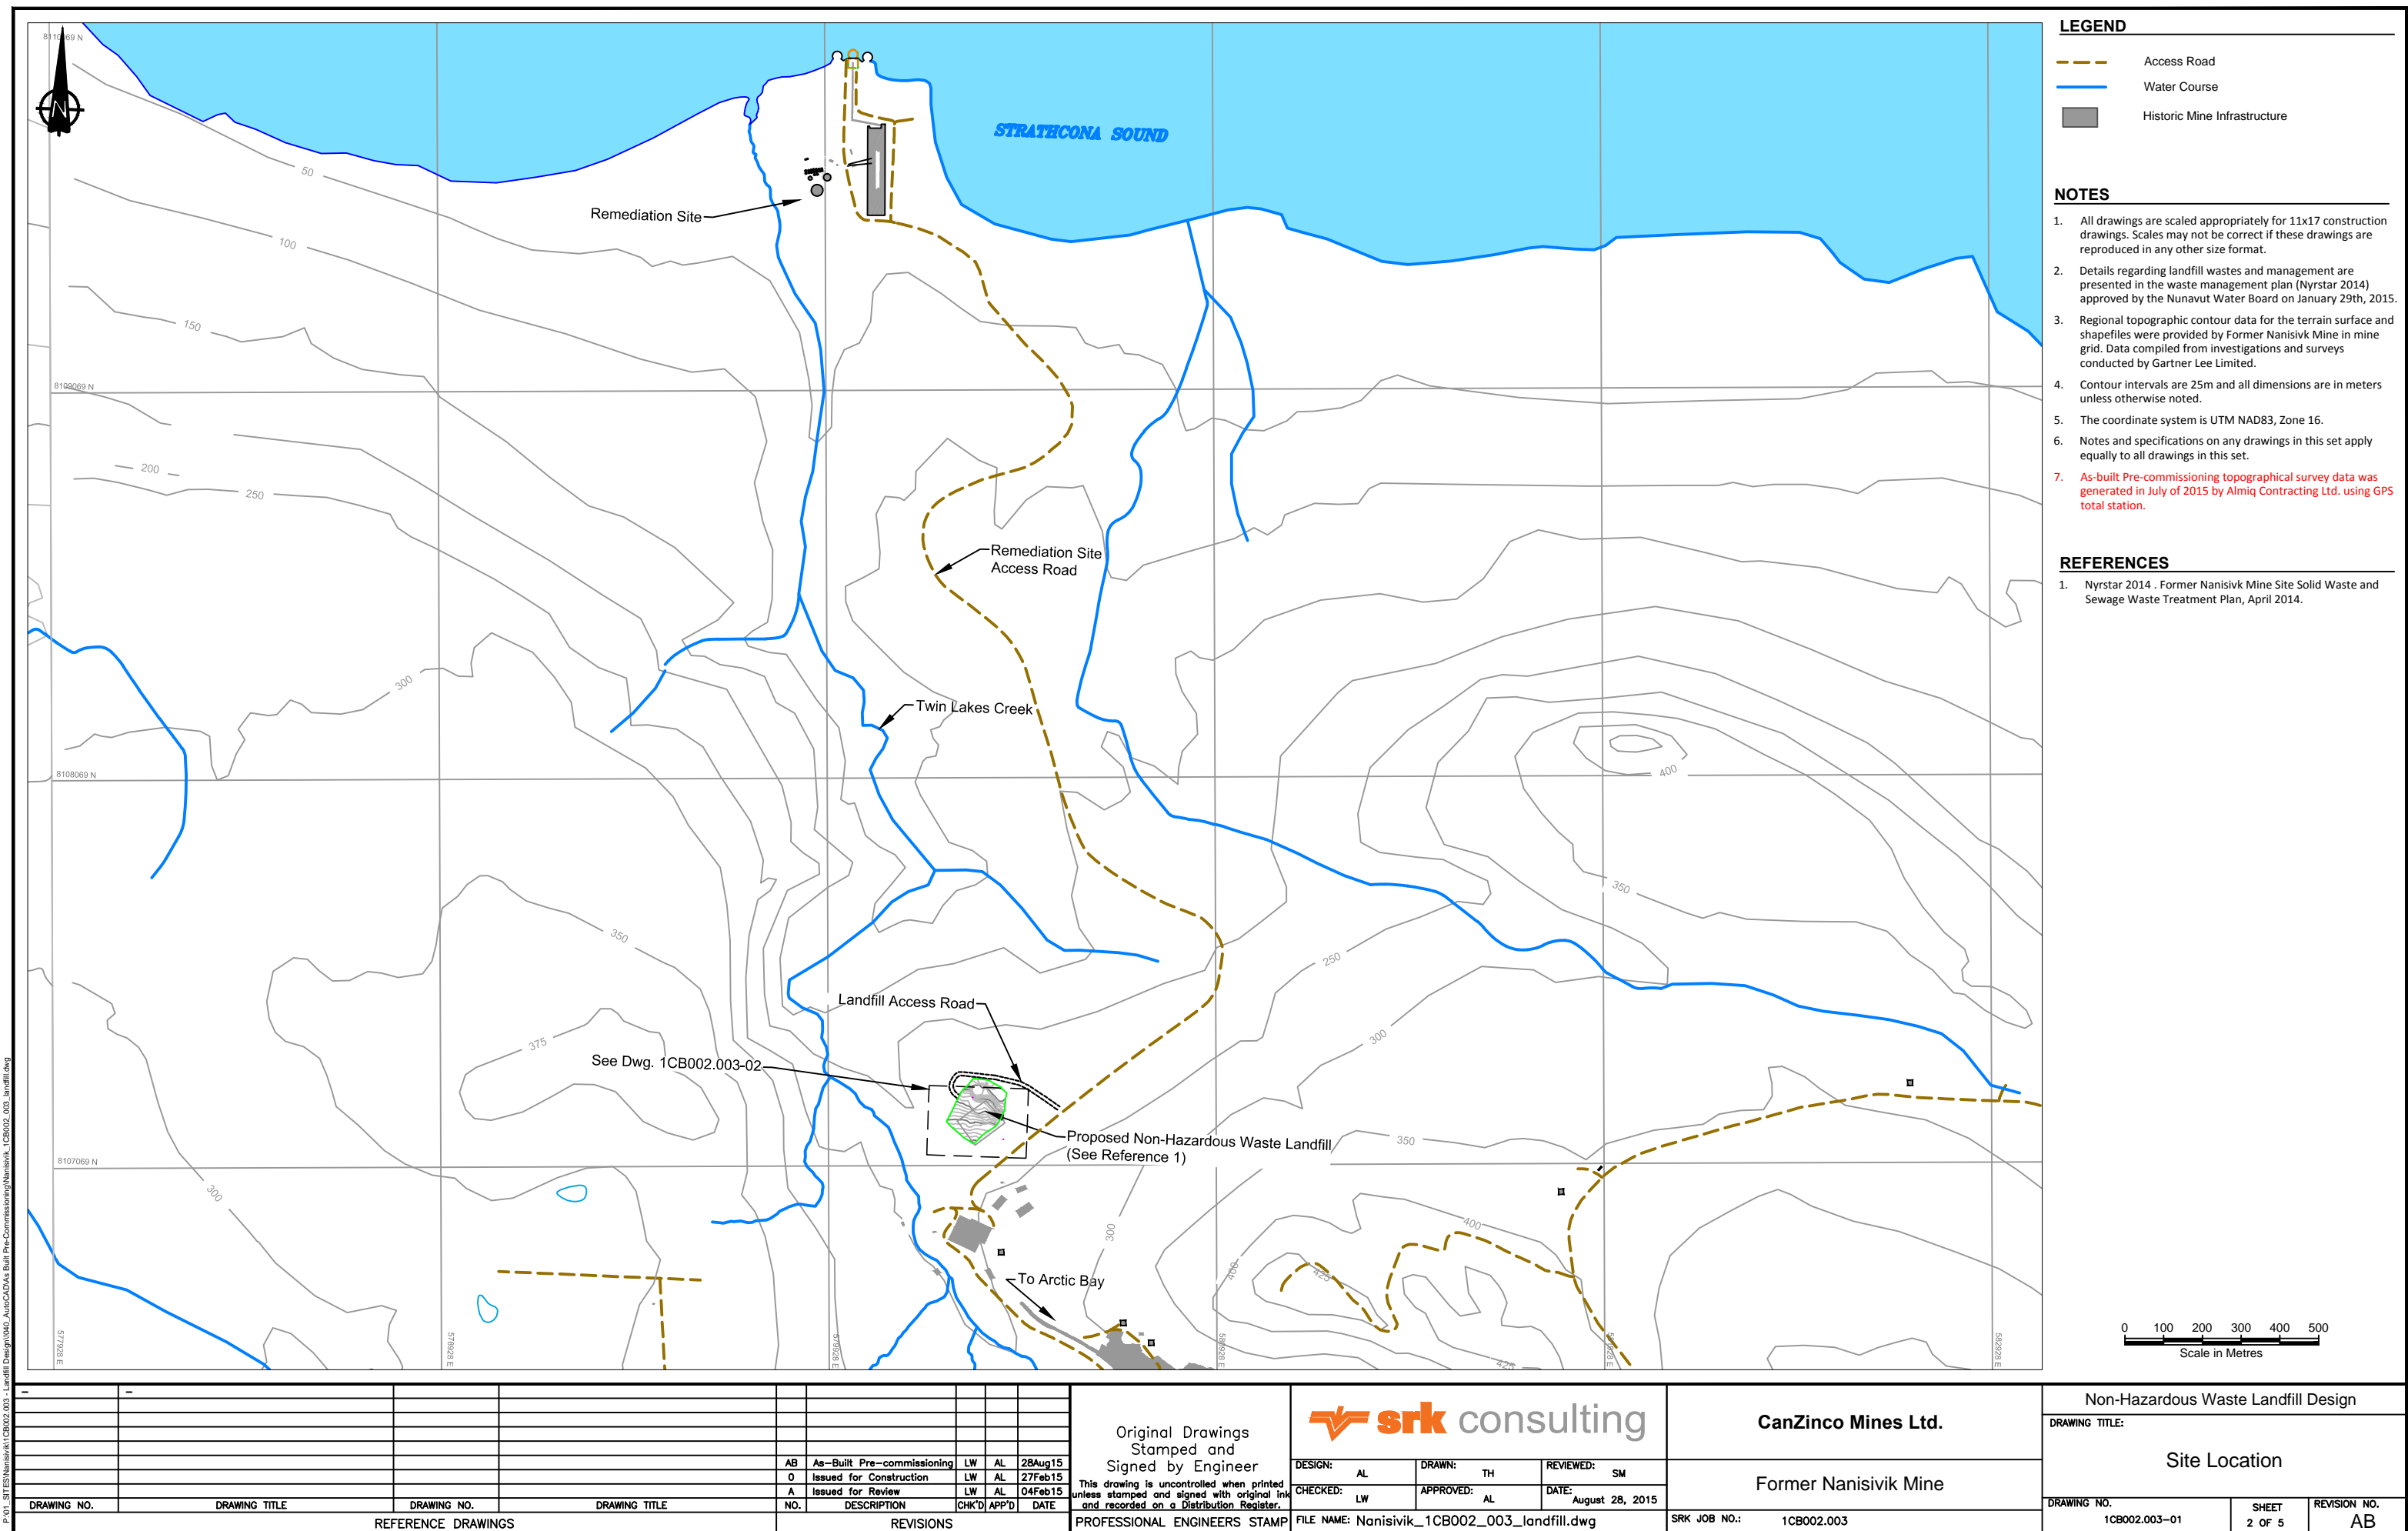

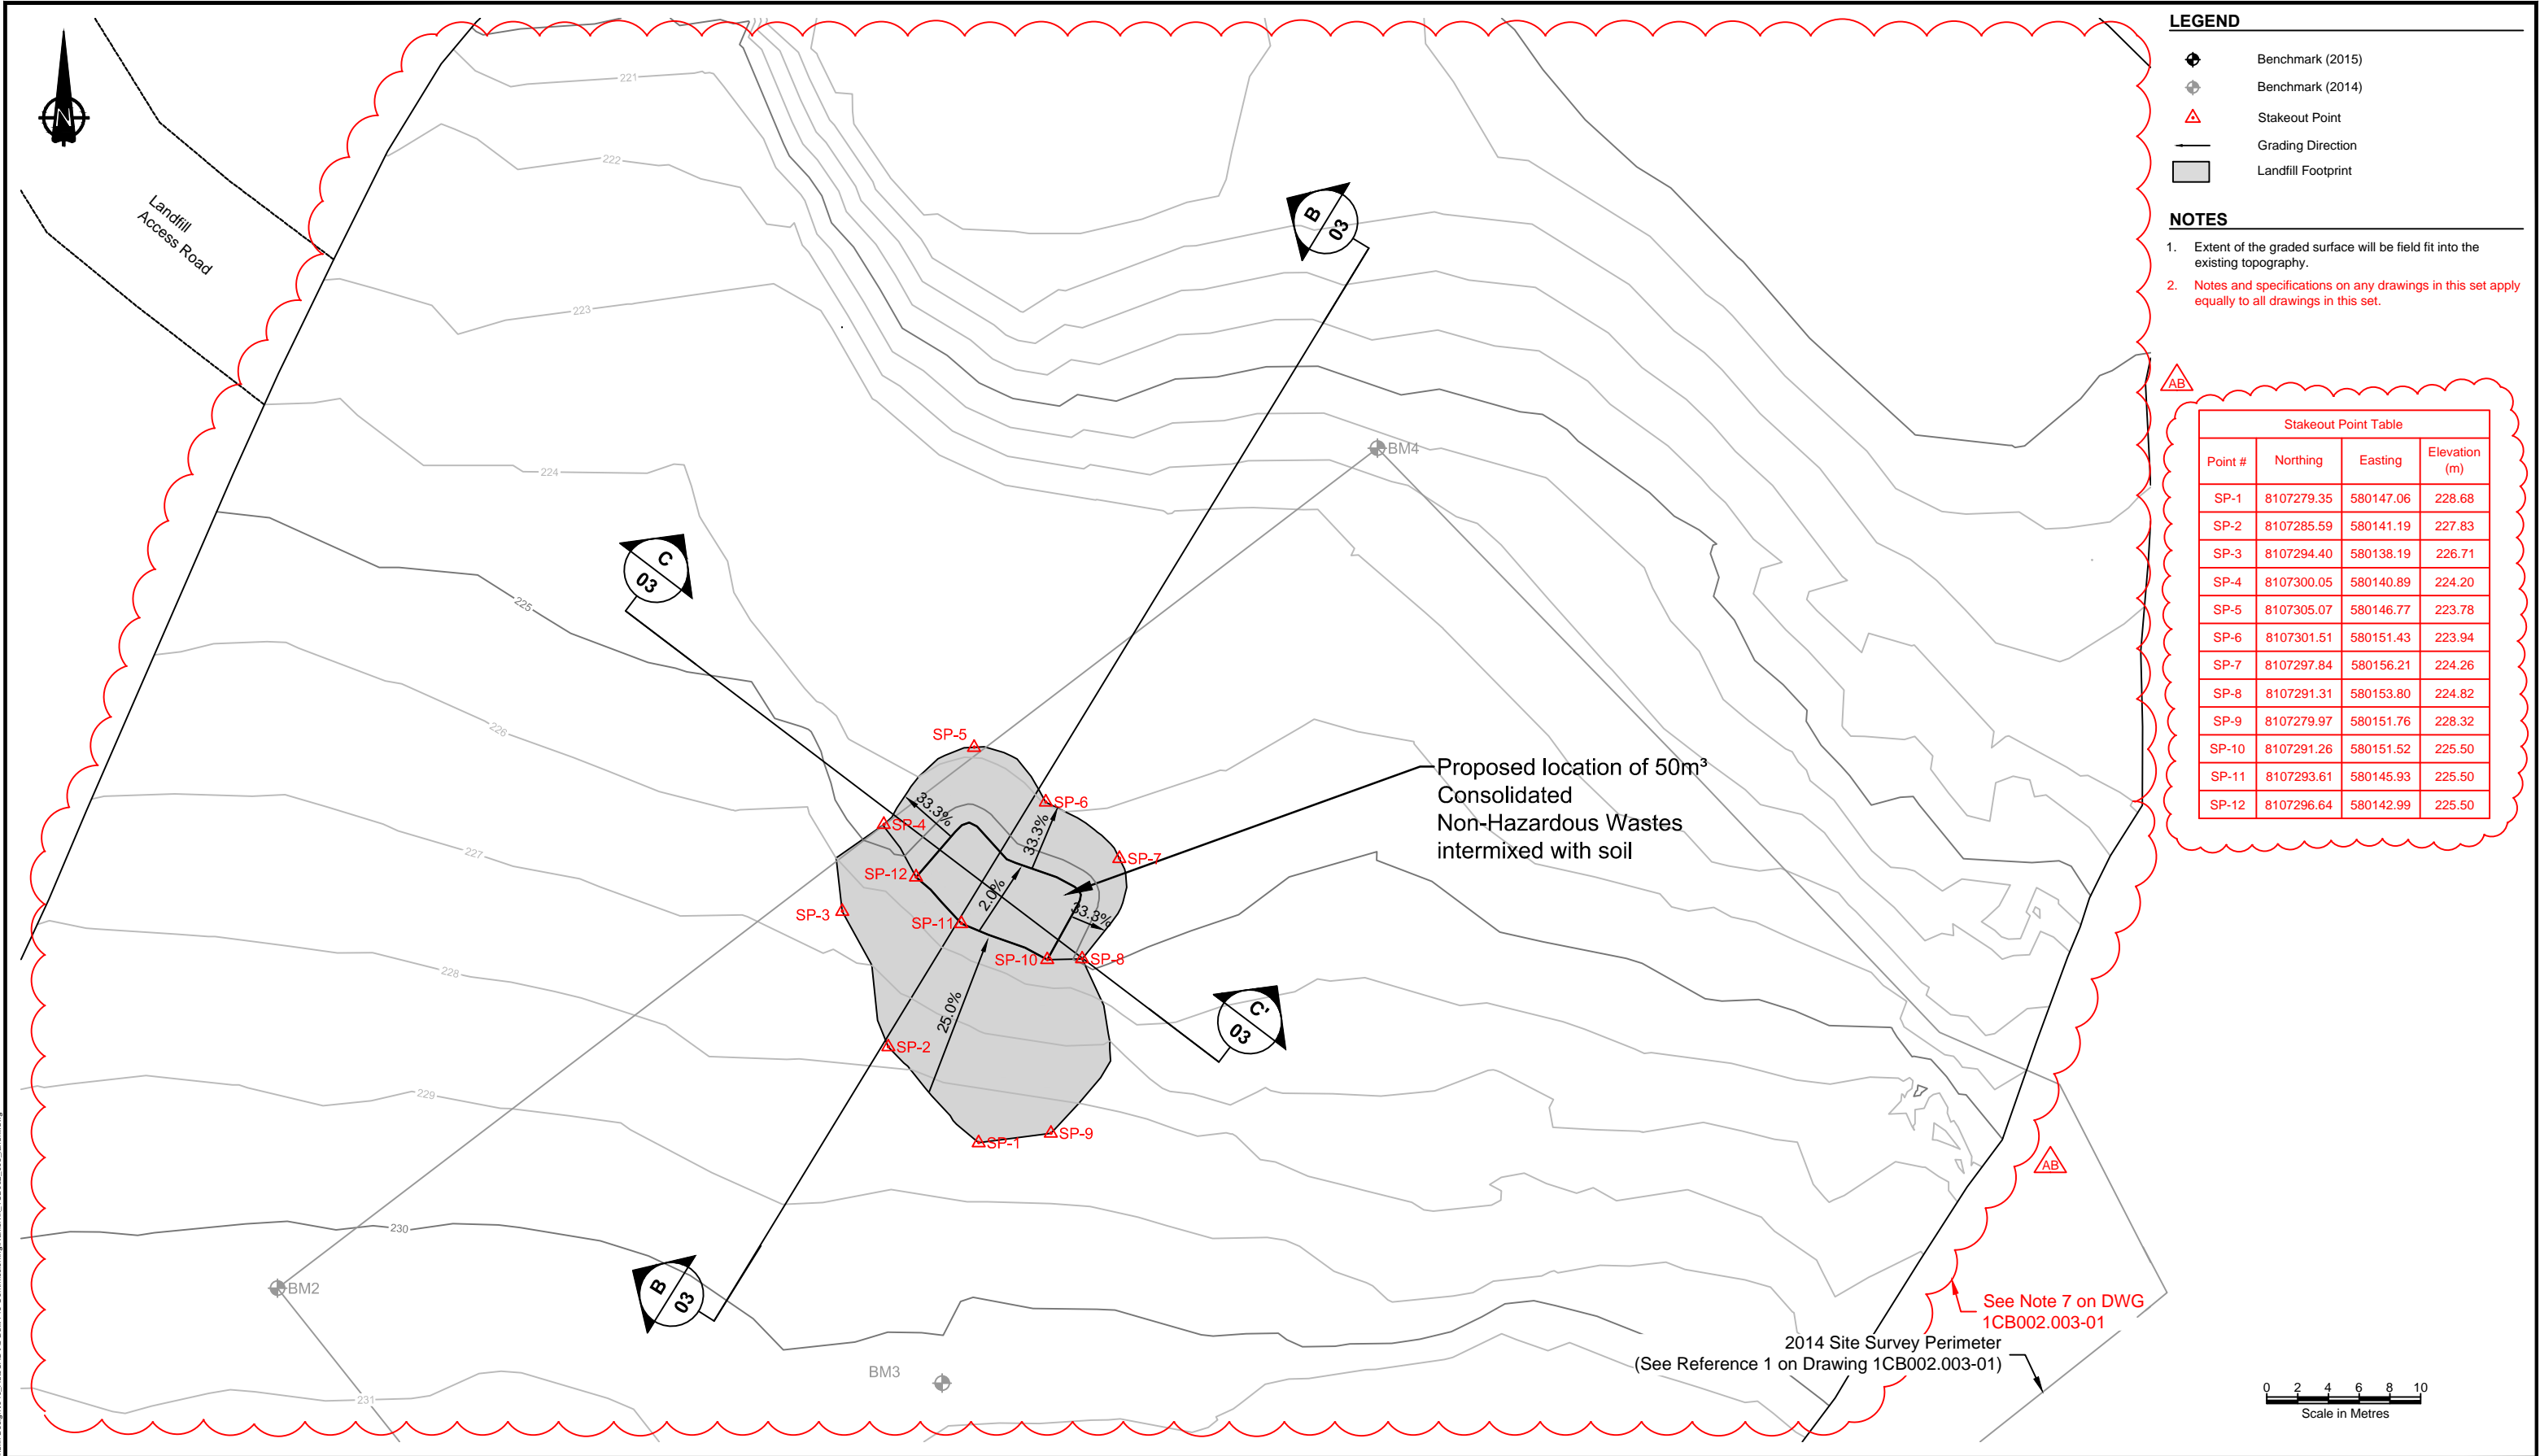

LEGEND

Benchmark (2015)
Benchmark (2014)
Stakeout Point

Grading Direction
Landfill Footprint

- NOTES
1.

Extent of the graded surface will be field fit into the existing topography.
2.


Notes and specifications on any drawings in this set apply equally to all drawings in this set.

Stakeout Point Table


Point #	Northing	Easting	Elevation (m)
SP-1	8107279.35	580147.06	228.68
SP-2	8107285.59	580141.19	227.83
SP-3	8107294.40	580138.19	226.71
SP-4	8107300.05	580140.89	224.20
SP-5	8107305.07	580146.77	223.78
SP-6	8107301.51	580151.43	223.94
SP-7	8107297.84	580156.21	224.26
SP-8	8107291.31	580153.80	224.82
SP-9	8107279.97	580151.76	228.32
SP-10	8107291.26	580151.52	225.50
SP-11	8107293.61	580145.93	225.50
SP-12	8107296.64	580142.99	225.50

P:\01_SITES\Nanisivik\1CB002\003_Landfill Design\040_AutoCAD\As Built Pre-Commissioning\Nanisivik_1CB002_003_Landfill.dwg


P:\01 - SITE\Nanisivik\1CB002.003 - Landfill Design\040 - AutoCAD\As-Built Pre-Commissioning\Nanisivik_1CB002.003_Landfill.dwg

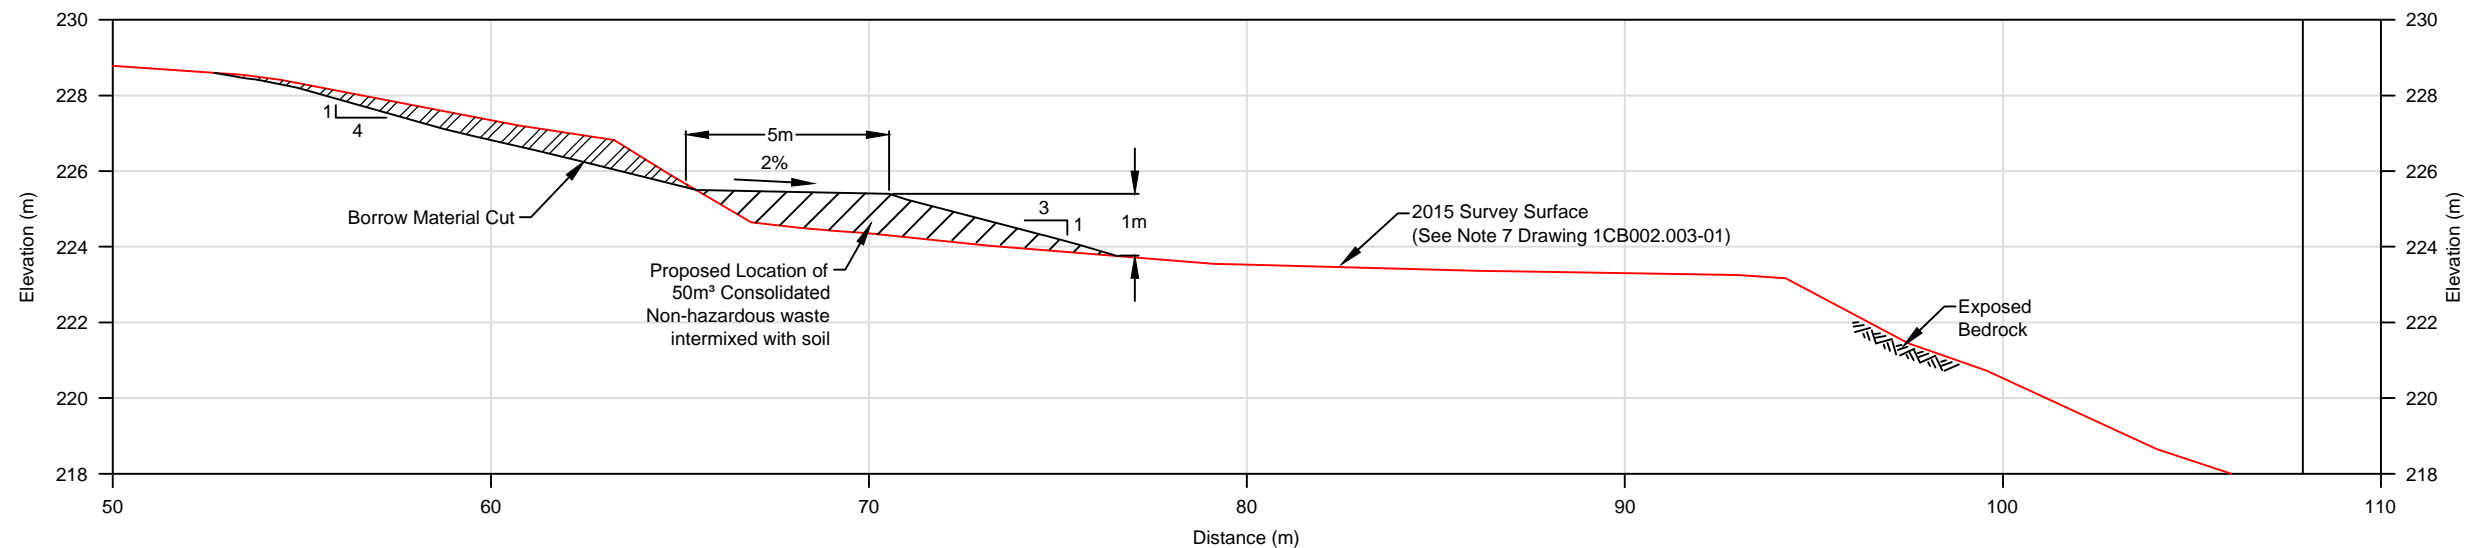

A
02
CROSS SECTION A-A'
Prior to Cover Construction

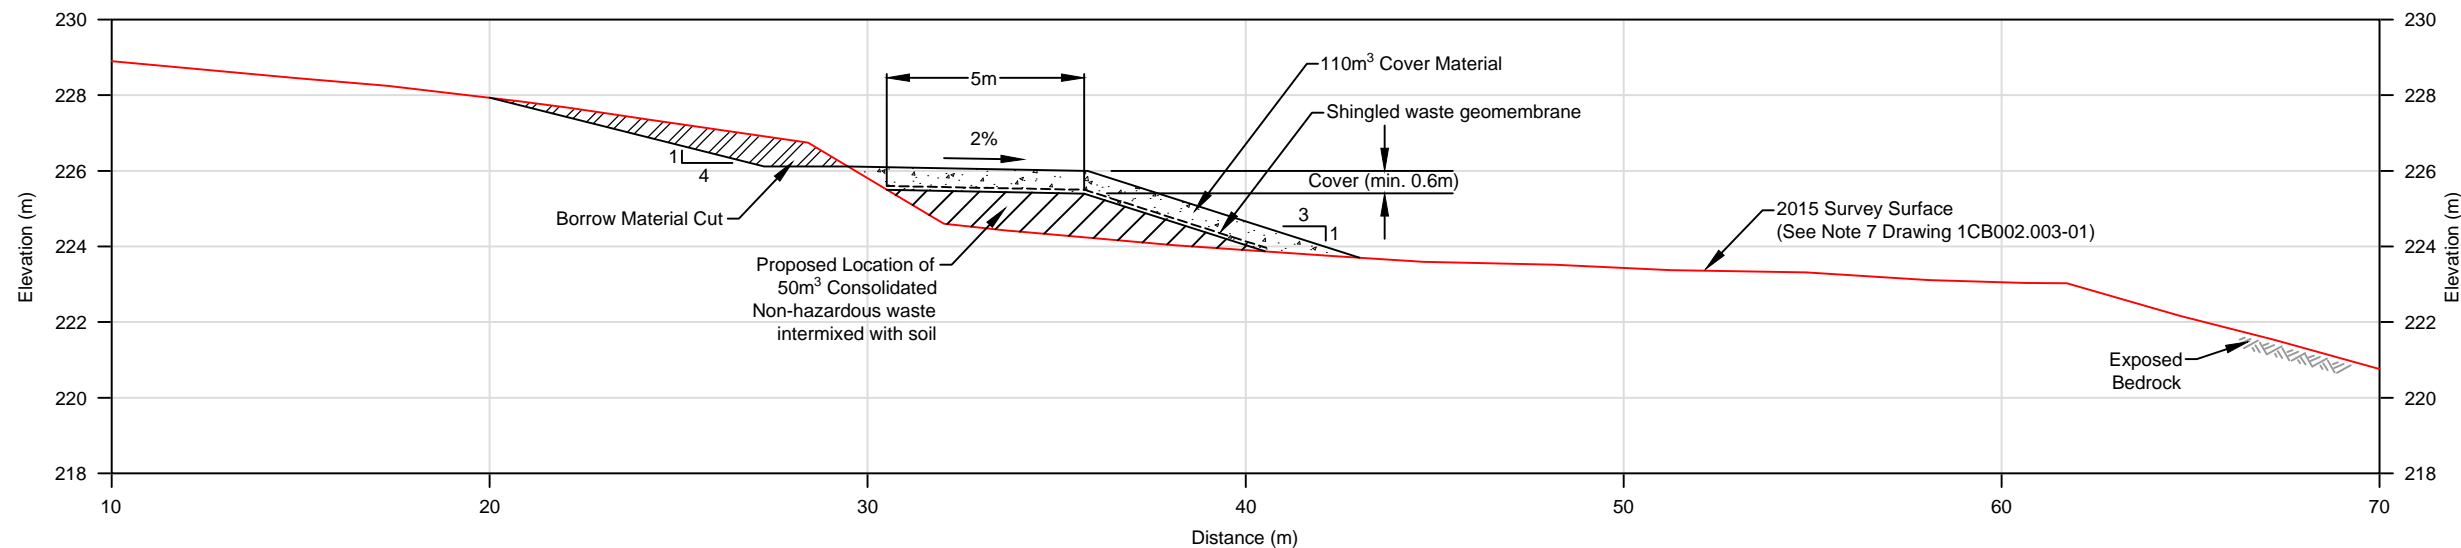


B
03
CROSS SECTION B-B'
After Cover Construction

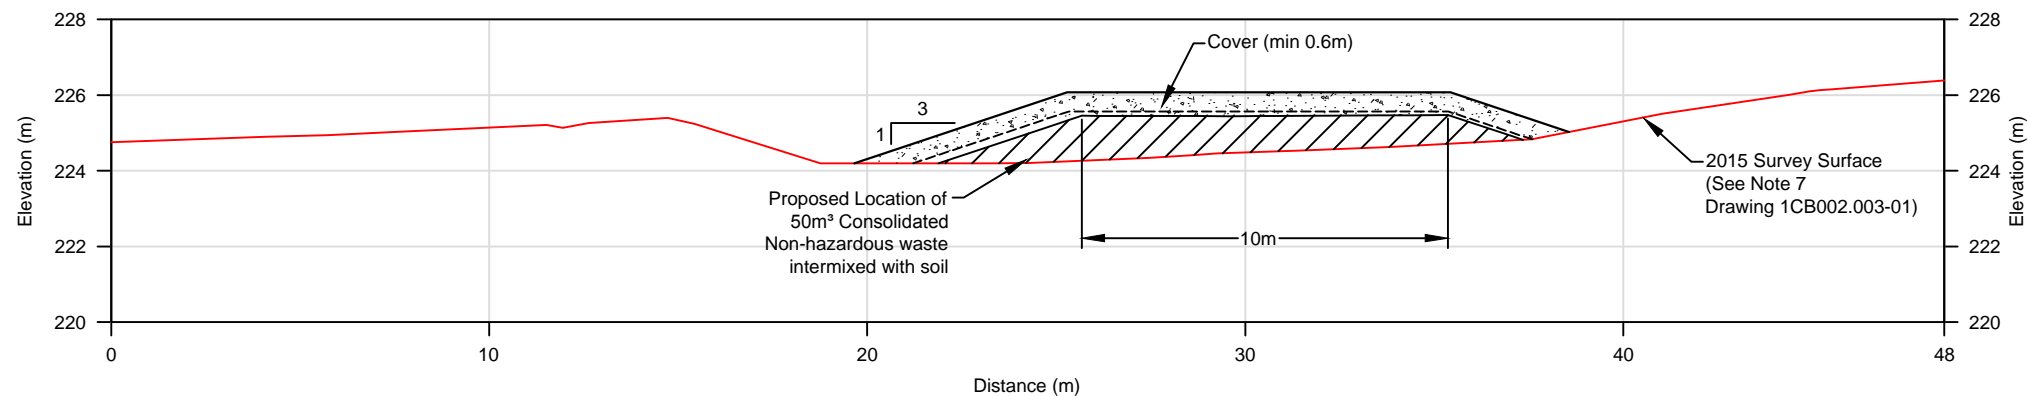

C
03
CROSS SECTION C-C'
After Cover Construction

- LEGEND**
- Shingled Waste Geomembrane
 - Non-hazardous Waste
 - Borrow Material Cut
 - Cover Material
- NOTES**
- Non-hazardous wastes shall be consolidated on the existing pad by stacking alternating layers of waste and clean granular fill to minimize voids.
 - Waste geomembrane, which exhibit no petroleum hydrocarbon contamination, shall be placed over the consolidated non-hazardous wastes in a "shingled" configuration, with adequate overlap to redirect water that percolates through the cover away from the underlying wastes.
 - During construction the Engineer may require that the geomembranes be pinned with waste rebar to prevent the dry cover from sliding.
 - The maximum single loose lift thickness of cover material is 300mm.
 - The minimum compacted cover thickness is 600mm.
 - A method of compaction for cover materials will be developed on site by the engineer.
 - The onsite construction supervisor or engineer will maintain elevation control of the landfill construction.
 - Final grading of the consolidated landfill cover will prevent water ponding. The landfill will be graded to 3:1 (horizontal to vertical) and the upslope cover borrow area graded to 4:1.
 - Notes and specifications on any drawings in this set apply equally to all drawings in this set.

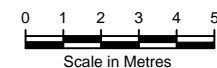

--	--	