




## **FIGURES**

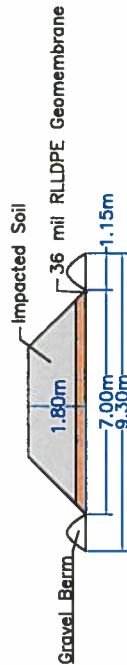

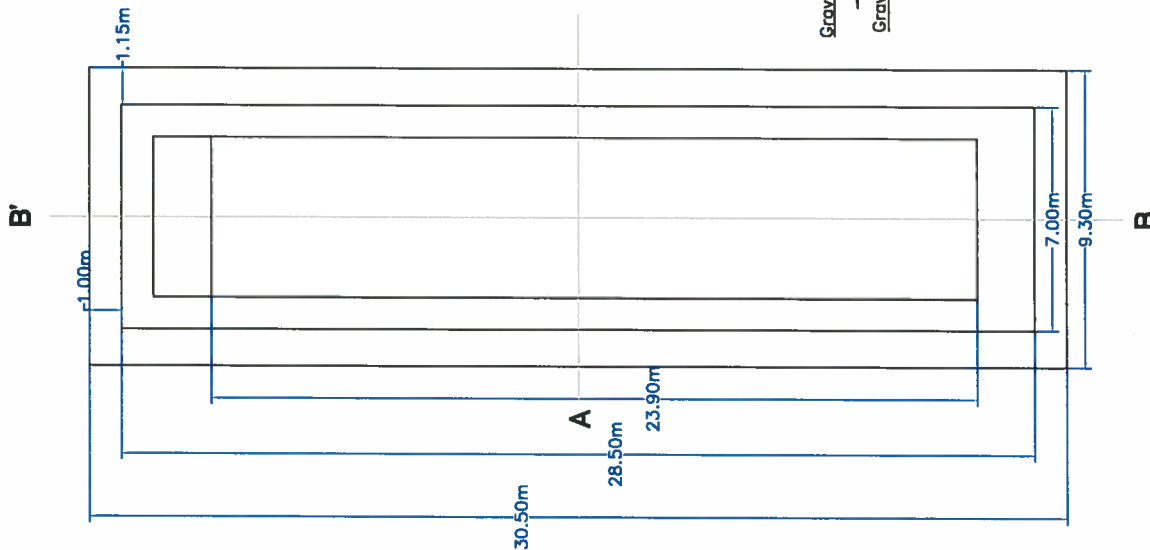


CROSS SECTION A-A'

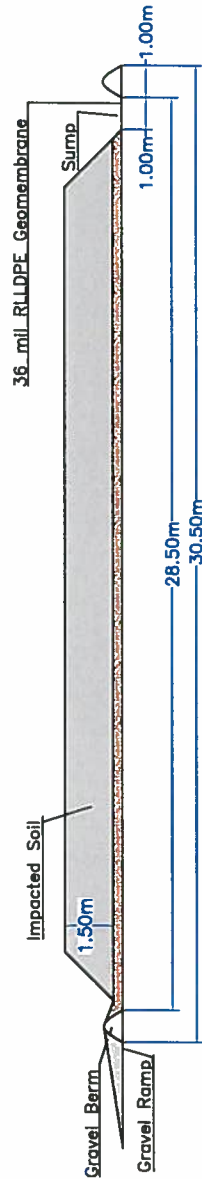


CROSS SECTION B-B'

|                              |                                 |                       |
|------------------------------|---------------------------------|-----------------------|
| PROJECT NUMBER:<br>YB9977-00 | DRAWN BY:<br>K.C.               | DESIGNED BY:<br>J.V.S |
| DATE: 29 OCT. 2012           | CHECKED BY: S.V                 |                       |
| SCALE: AS SHOWN              | AUTOCAD FILE NO: YB9977-ASBUILT |                       |

FIGURE: 2  
BIOPILE TREATMENT CELL

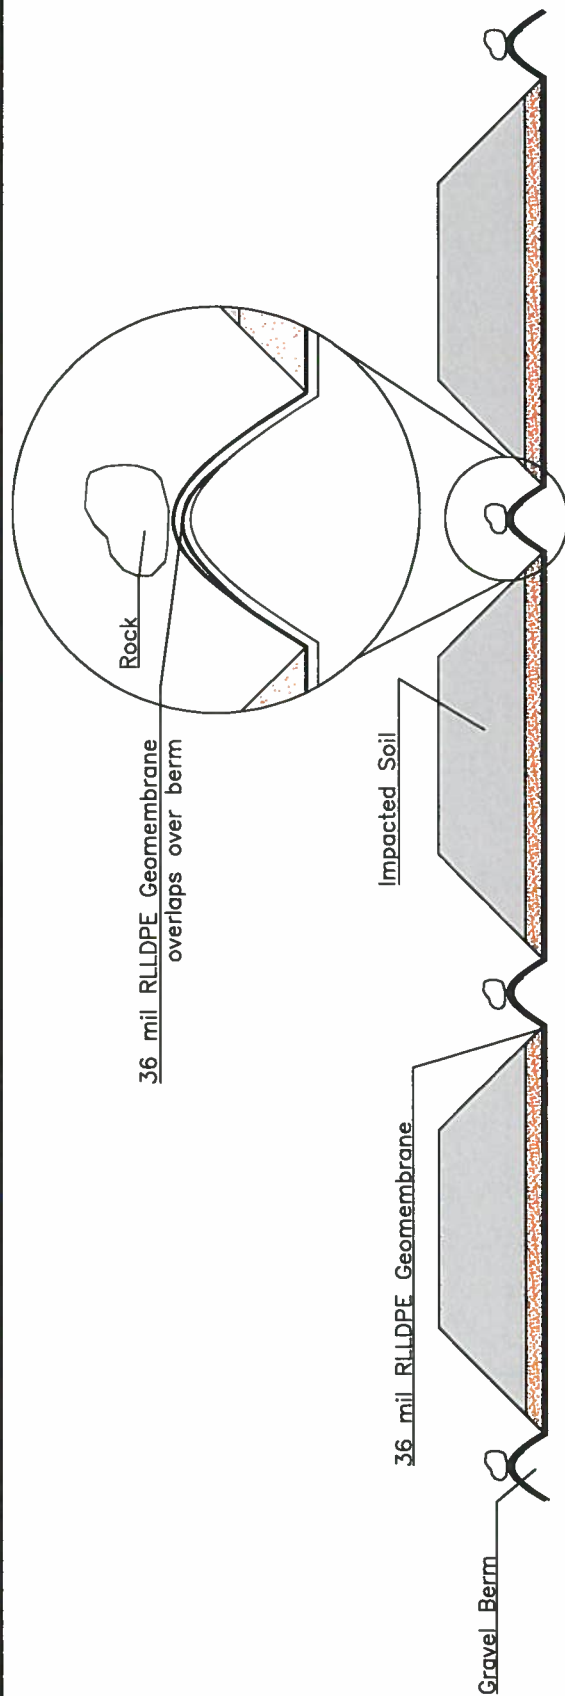

PROFILE VIEW OF MULTIPLE BIOPILES SIDE-BY-SIDE


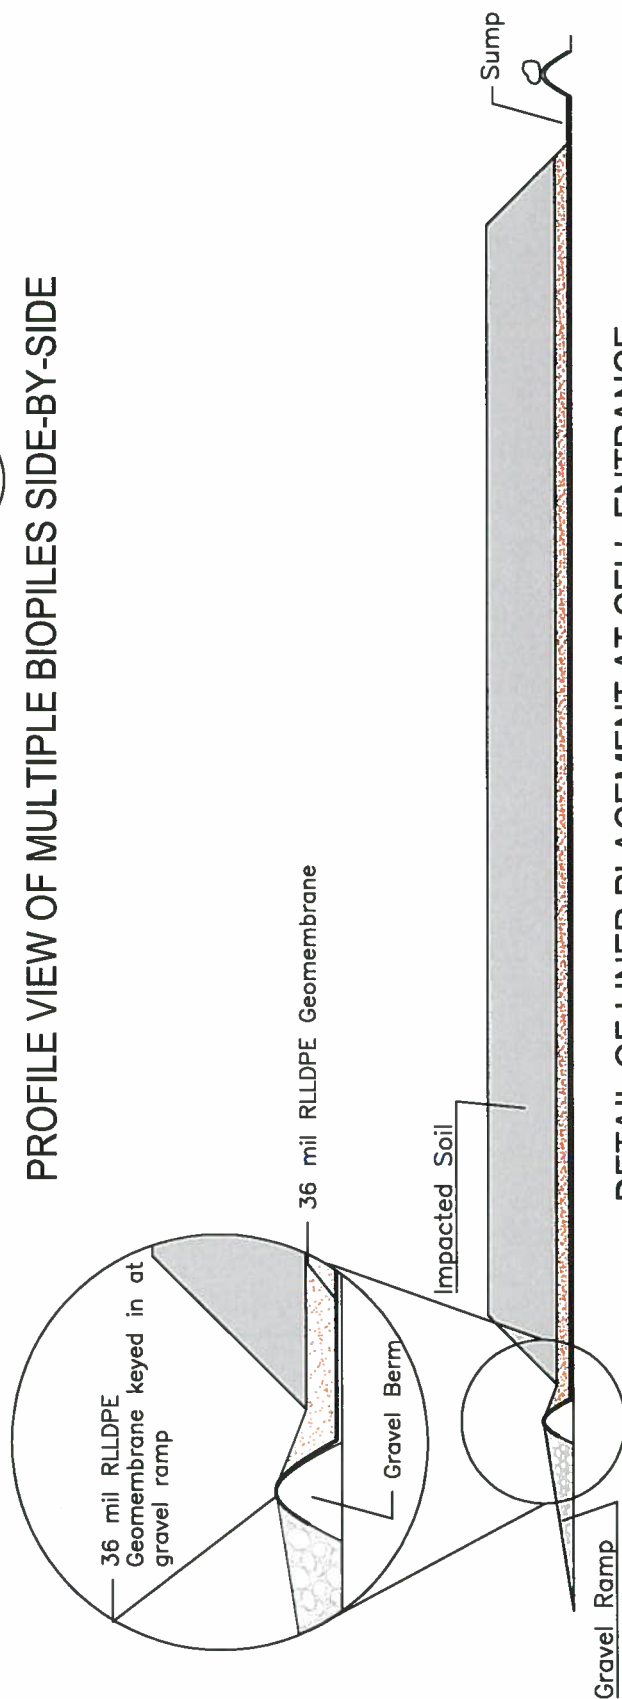


DETAIL OF LINER PLACEMENT AT CELL ENTRANCE


|                              |                                |                       |
|------------------------------|--------------------------------|-----------------------|
| PROJECT NUMBER:<br>YB9977-00 | DRAWN BY:<br>K.C.              | DESIGNED BY:<br>J.V.S |
| DATE: 29 OCT. 2012           | CHECKED BY: S.V.               |                       |
| SCALE: AS SHOWN              | AUTOCAD FILE NO: YB9977-ASSULT |                       |

FIGURE: 3  
BIOPILE TREATMENT CELL DETAILS

B'

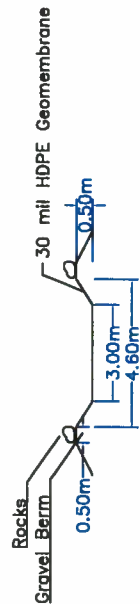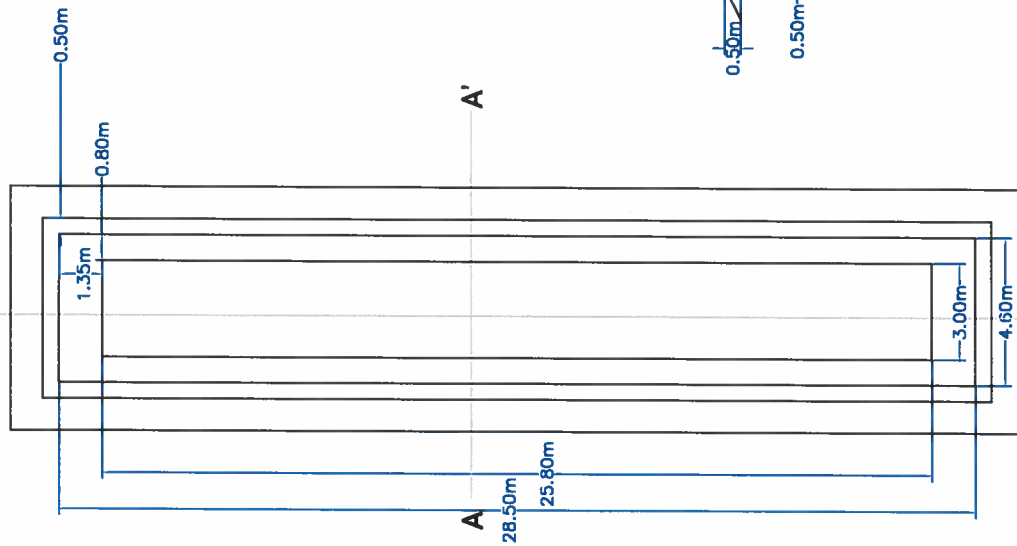



CROSS SECTION A-A'

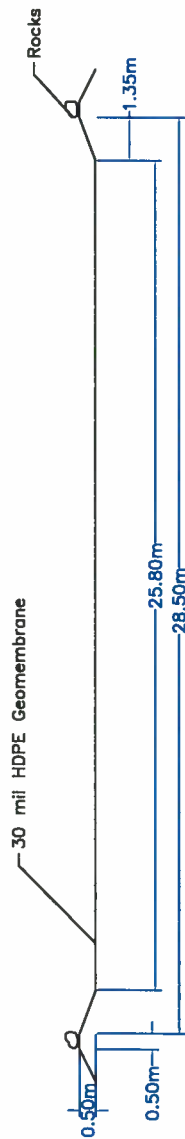


CROSS SECTION B-B'

|                              |                                 |                        |
|------------------------------|---------------------------------|------------------------|
| PROJECT NUMBER:<br>YB9877-00 | DRAWN BY:<br>K.C.               | DESIGNED BY:<br>J.V.S. |
| DATE: 29 OCT. 2012           | CHECKED BY: S.V.                |                        |
| SCALE: AS SHOWN              | AUTOCAD FILE NO: YB9877-ASBUILT |                        |

FIGURE: 4  
LOWER TREATMENT AREA  
STORMWATER RETENTION POND

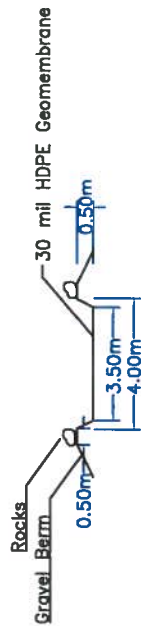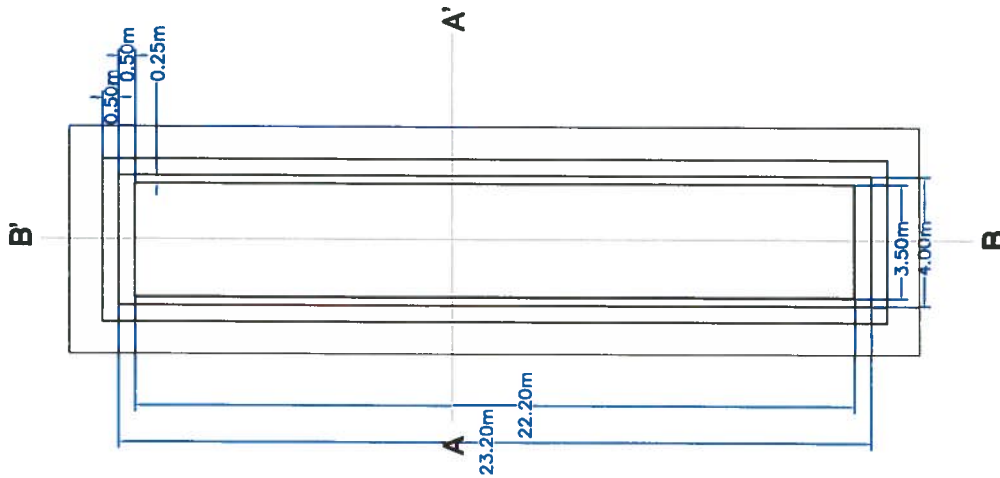

CROSS SECTION A-A'

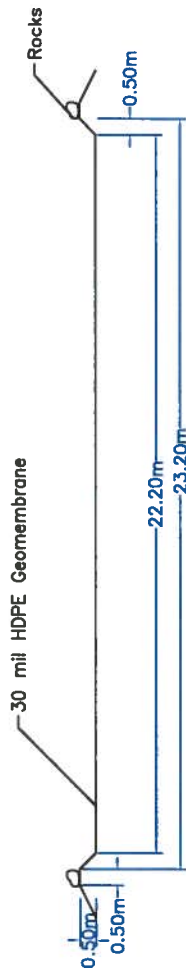

CROSS SECTION B-B'

PROJECT NUMBER:  
YB9977-00

DRAWN BY:  
K.C.

DESIGNED BY:  
J.V.S

DATE: 29 OCT. 2012

CHECKED BY: S.V

SCALE: AS SHOWN

AUTOCAD FILE NO: YB9977-ASBUILT

FIGURE: 5  
UPPER TREATMENT AREA  
STORMWATER RETENTION POND

**WESA**  
A Better Environment for Business