

D

100mm
90
80
70
60
50
40
30
20
10
0

A


5

4


3

2


1

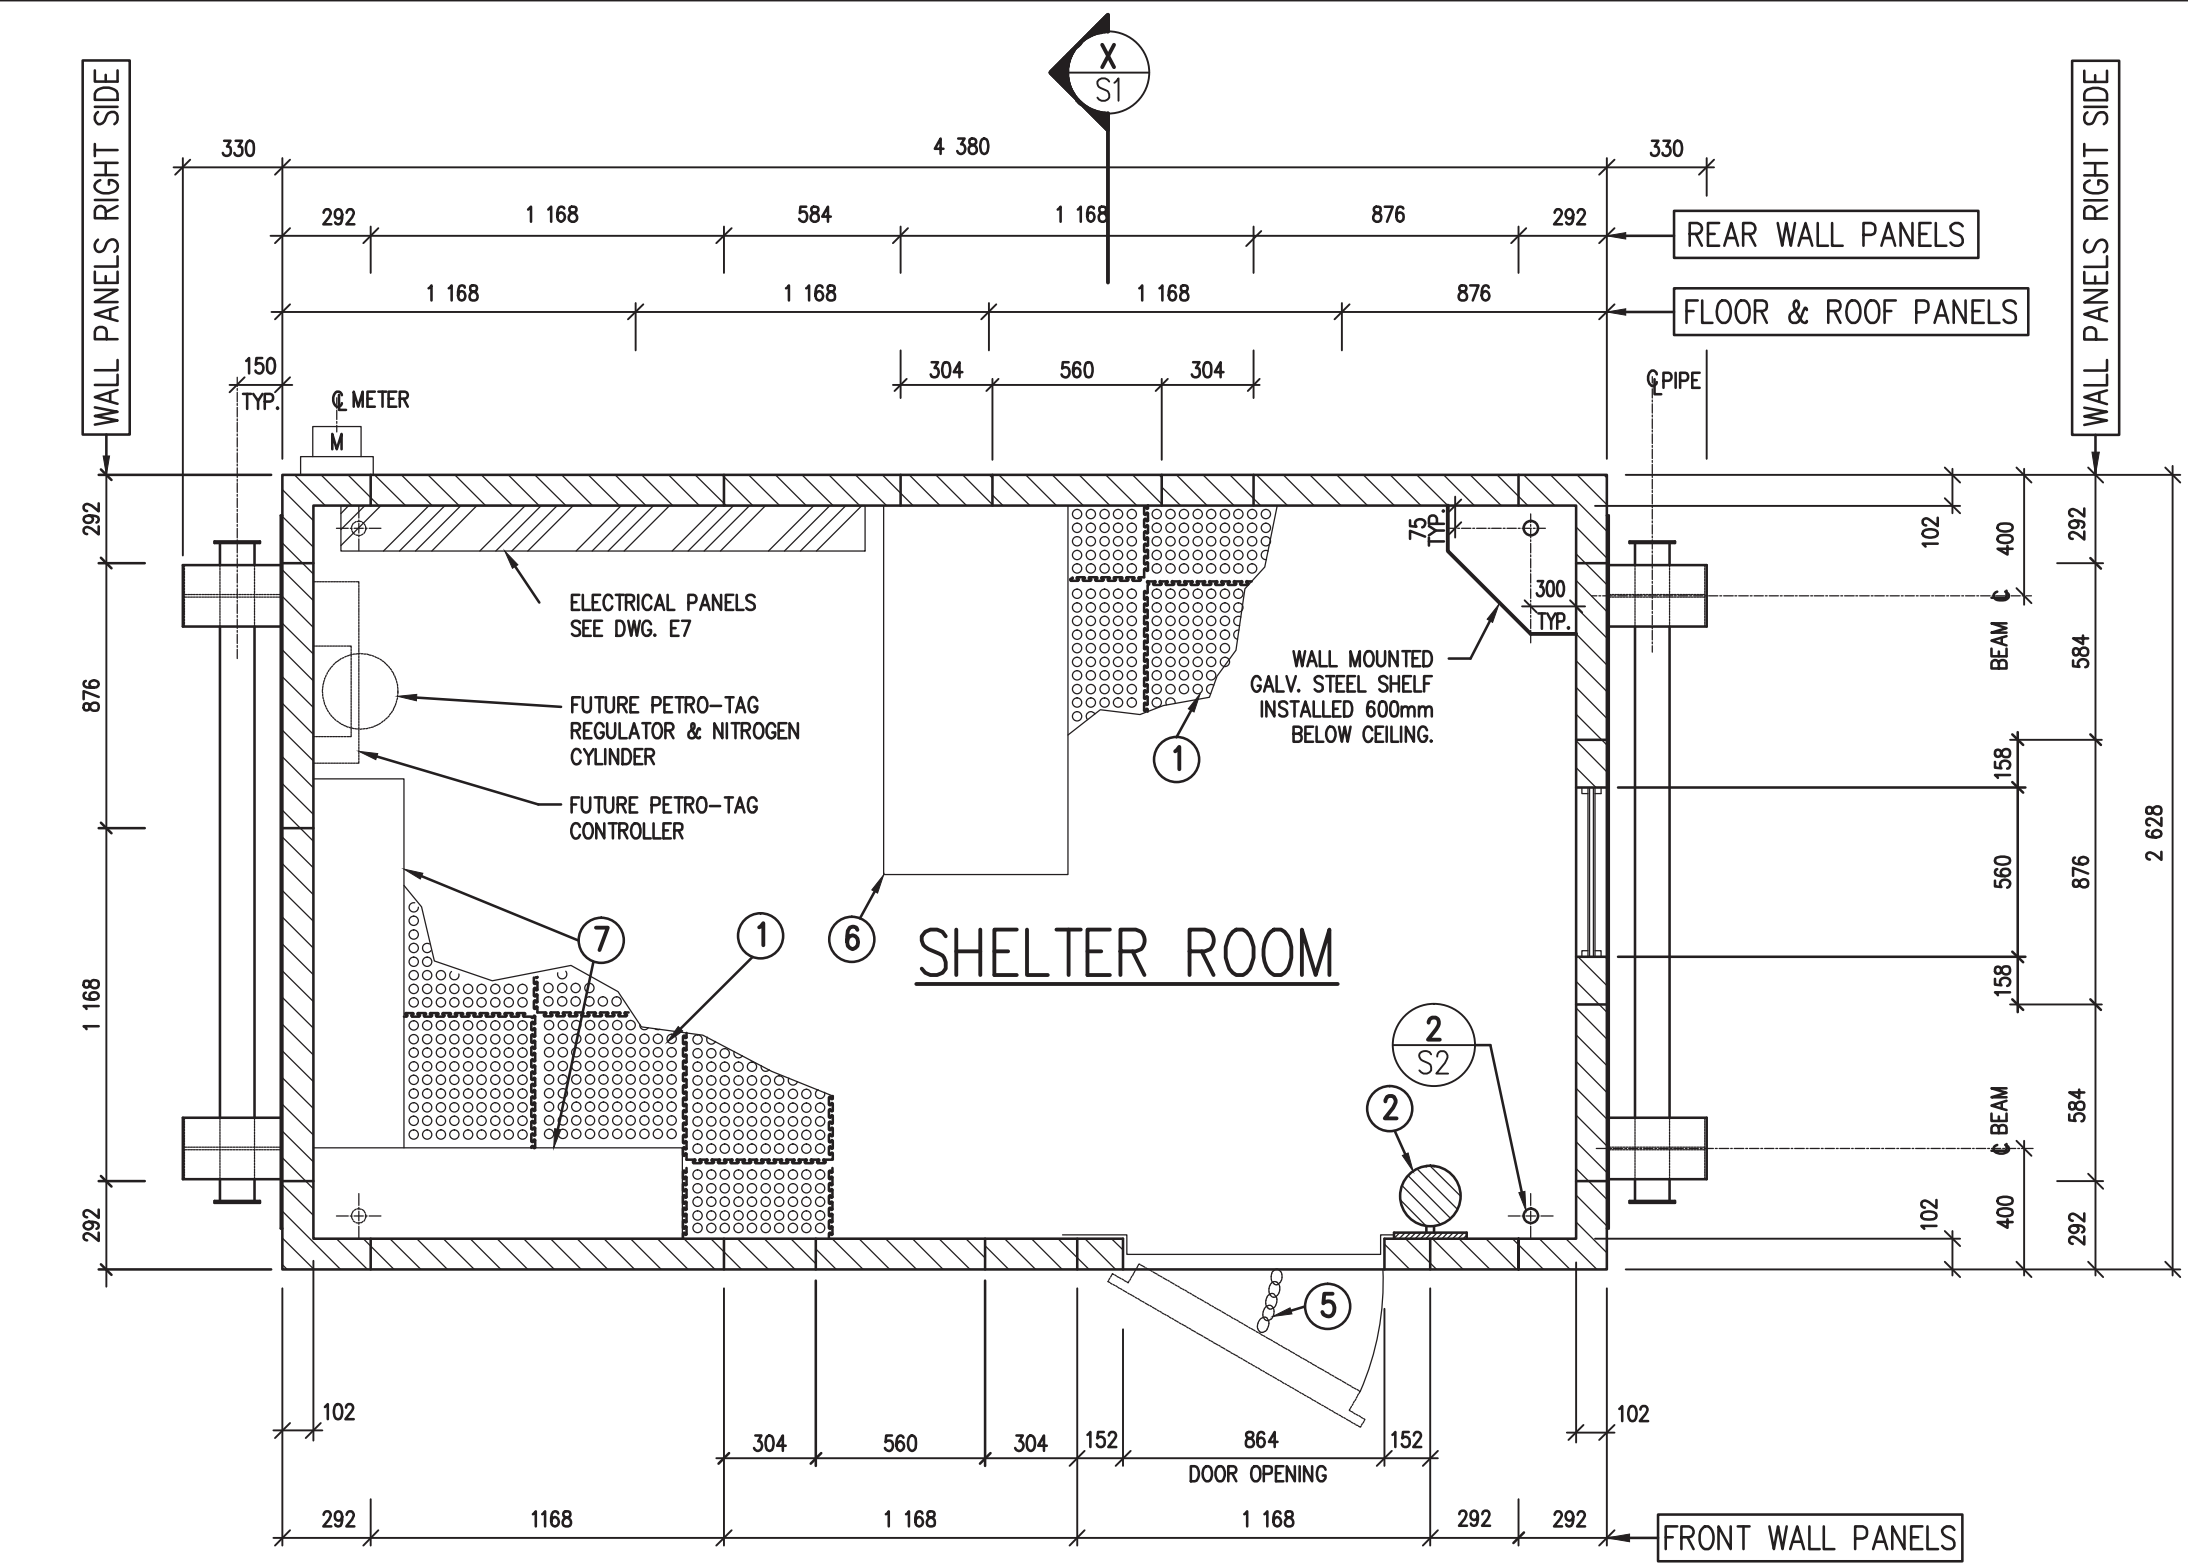


1 PLAN
1/25

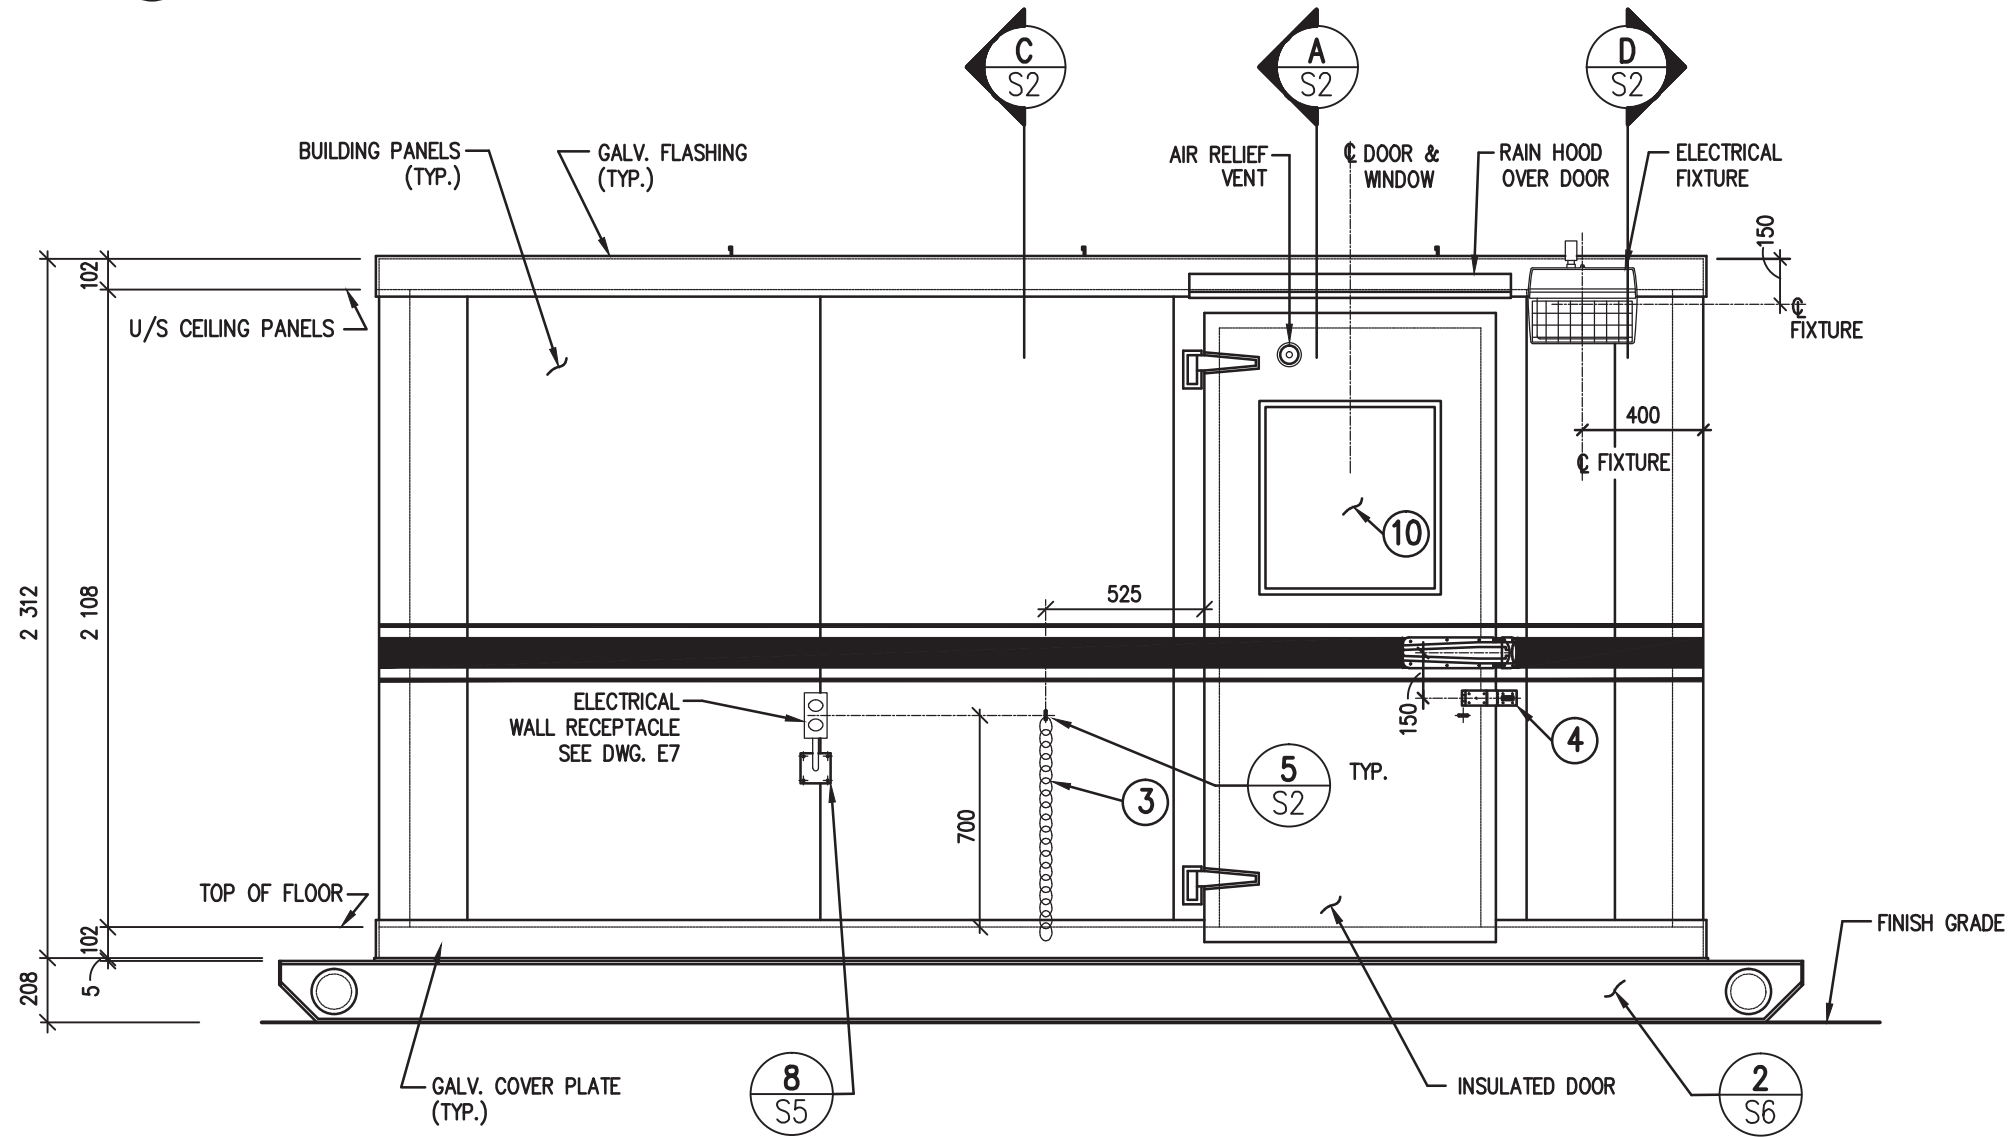


2 FRONT ELEVATION
1/25

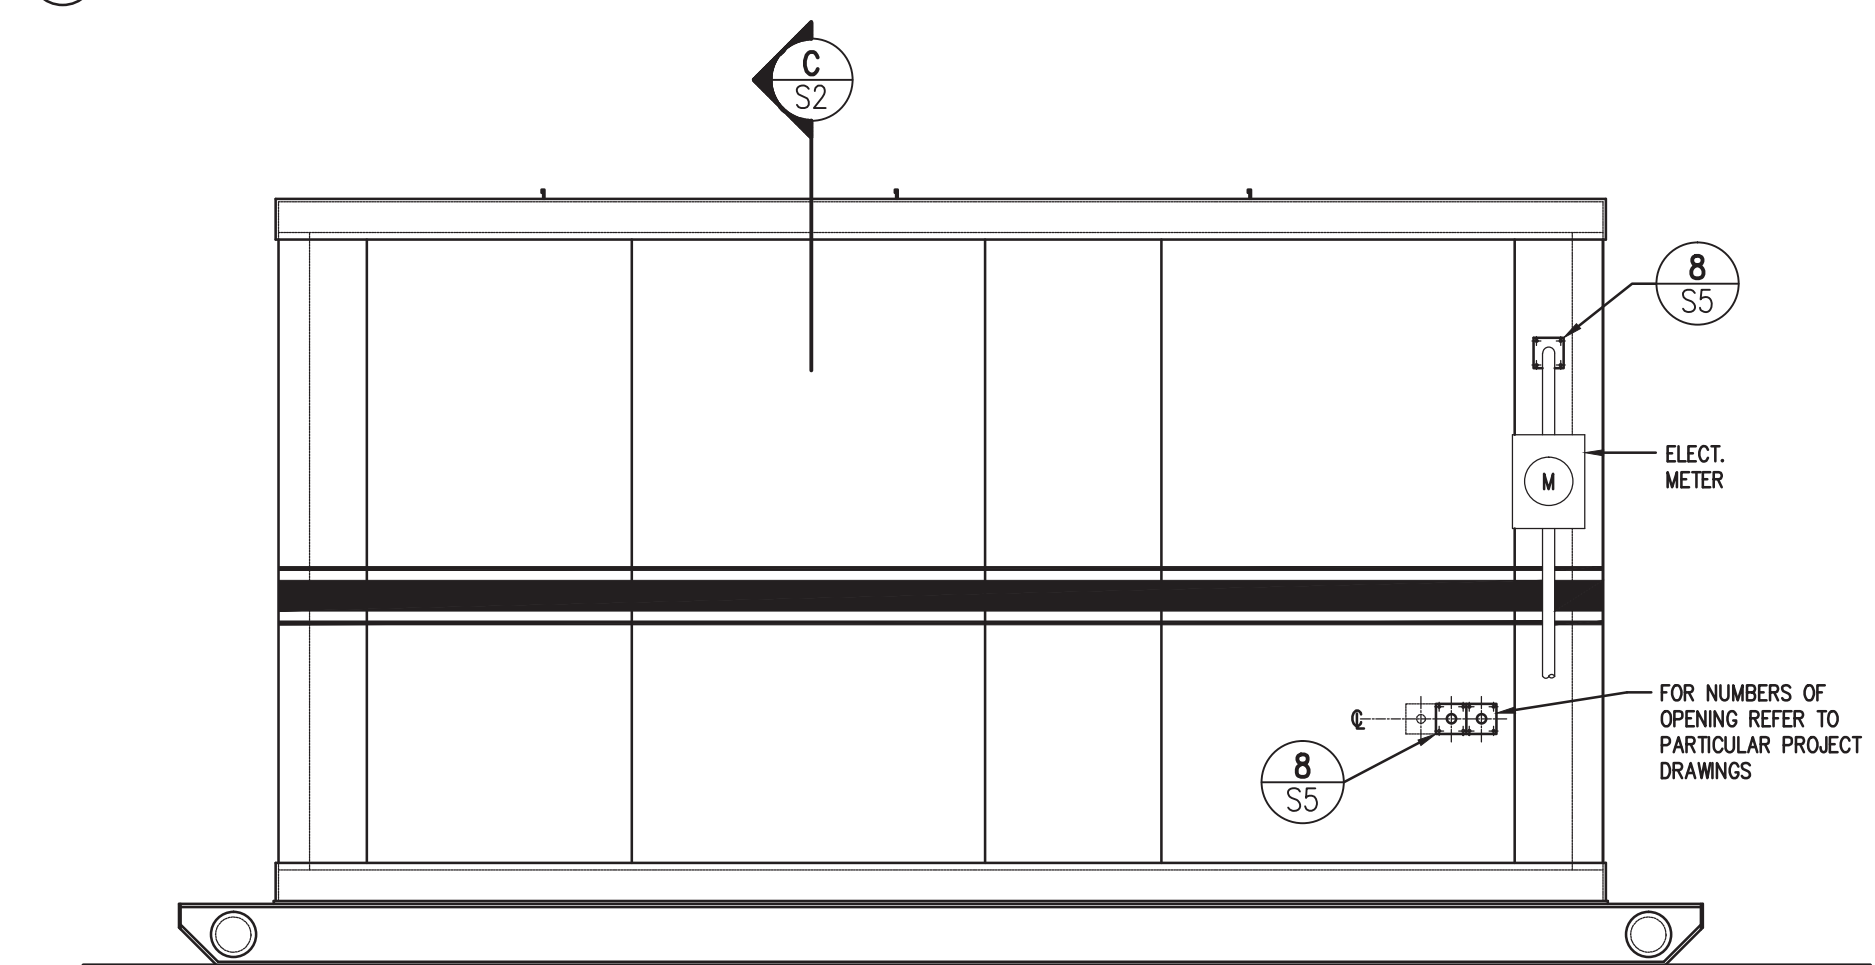


3 REAR ELEVATION
1/25

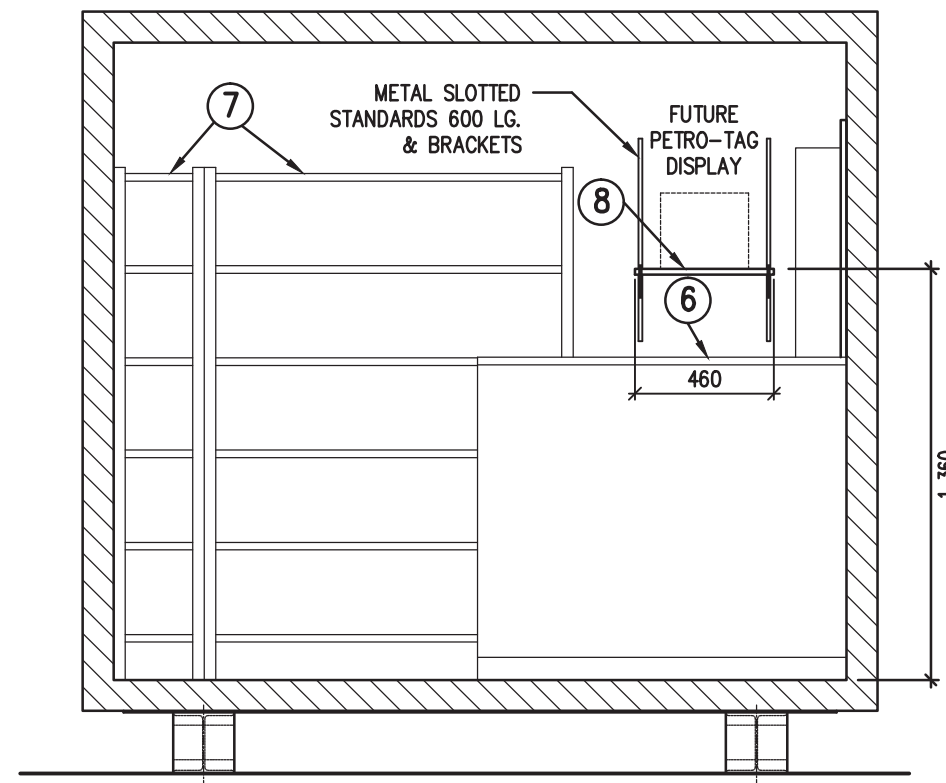

X SECTION
1/25

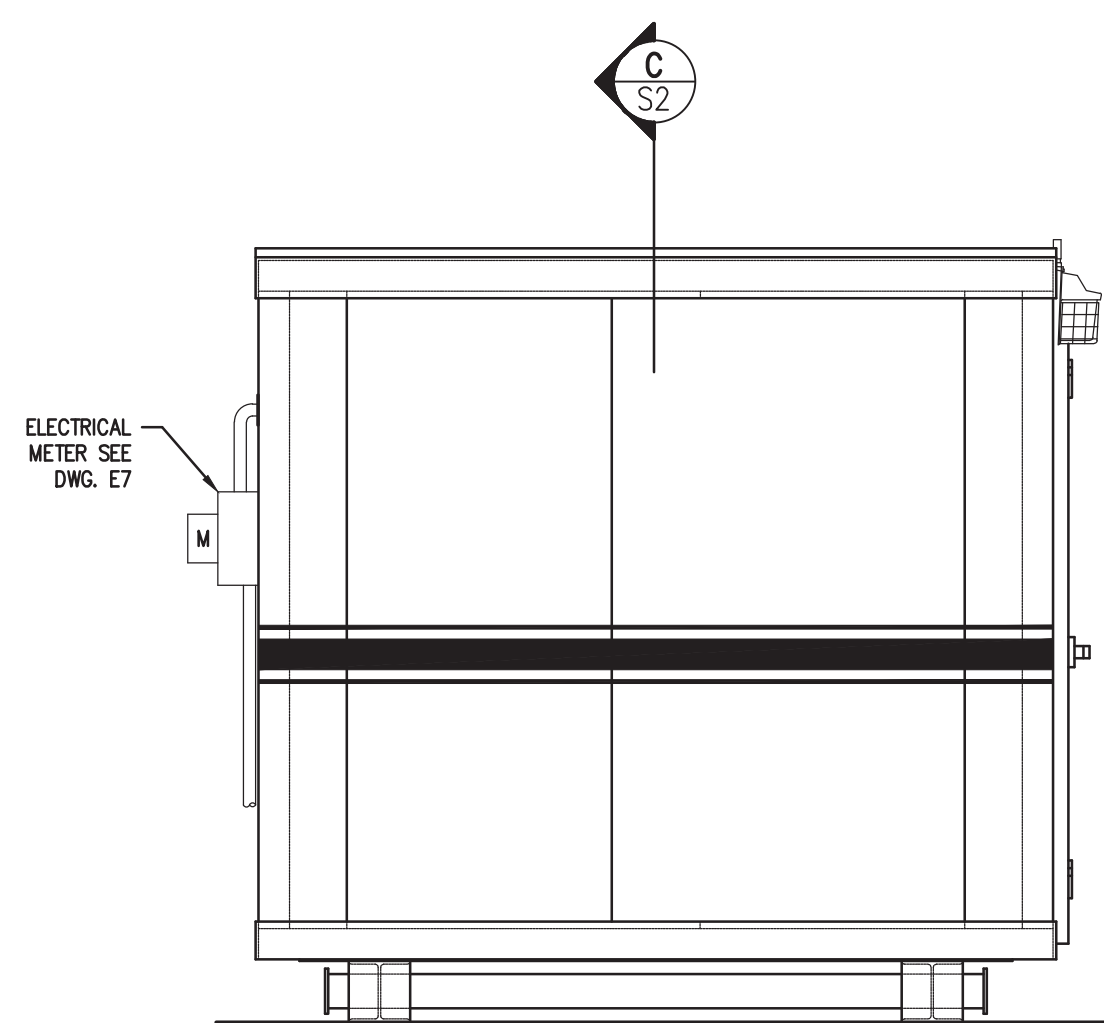

4 LEFT SIDE ELEVATION
1/25

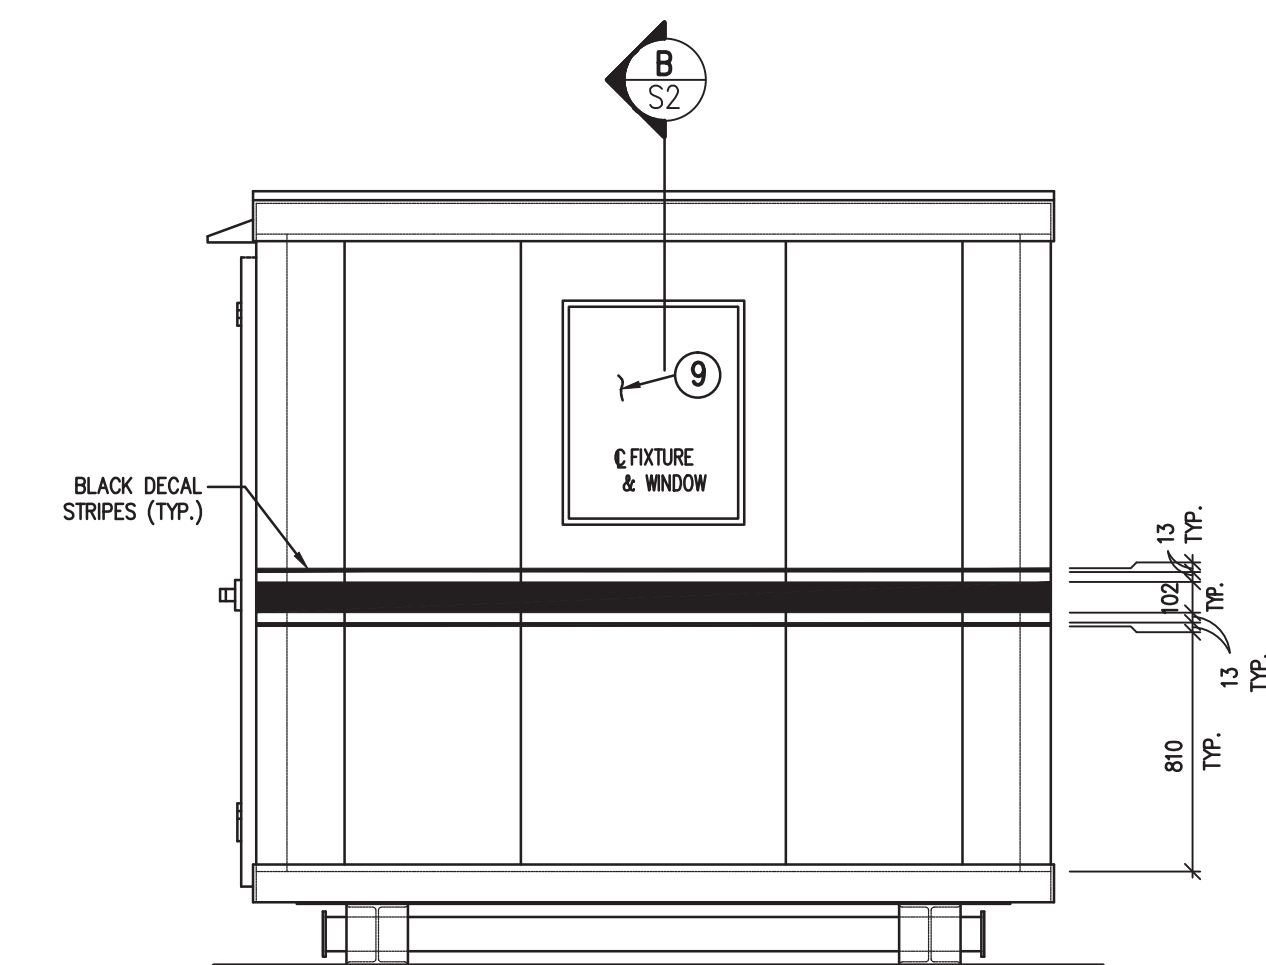

5 RIGHT SIDE ELEVATION
1/25

LEGEND:


- 1 - NON-SKID FLOOR SURFACING SHEETS, SEE SPEC'S
- 2 - FIRE EXTINGUISHER c/w BRACKET MOUNTED 100mm ABOVE FLOOR, SEE SPEC'S
- 3 - CHAIN c/w HOOKS AT EXTERIOR DOOR, SEE SPEC'S
- 4 - HASP, SEE SPEC'S
- 5 - HEAVY DUTY SPRING BUMPER CHAIN ON DOOR, SEE SPEC'S
- 6 - DESK, STAND-UP, SEE SPEC'S
- 7 - METAL SHELVING (2 SECTIONS), SEE SPEC'S
- 8 - METAL SHELF SUPPORT FOR EQUIPMENT, SEE SPEC'S
- 9 - DOUBLE INSULATED THERMOCLEAR POLYCARBONATE SHEETS & ALUM. FRAME, SEE SPEC'S.
- 10 - DOUBLE INSULATED THERMOCLEAR POLYCARBONATE SHEETS & ALUM. FRAME, SEE SPEC'S.

Record Drawing

These drawings have been prepared based on information provided by Inukshuk Construction with a construction completion date of 20.02.2014. Stantec has not verified the accuracy and/or completeness of this information and shall not be responsible for any errors or omissions which may be incorporated herein as a result.

NO.	REVISION DESCRIPTION	DATE ISSUED
03	RECORD DRAWINGS	2013/11/01
02	ISSUED FOR TENDER	2011/06/08
01	ISSUED FOR 95% REVIEW	2011/03/25
00	ISSUED FOR 50% REVIEW	2011/02

PROFESSIONAL SEAL / PERMIT TO PRACTICE

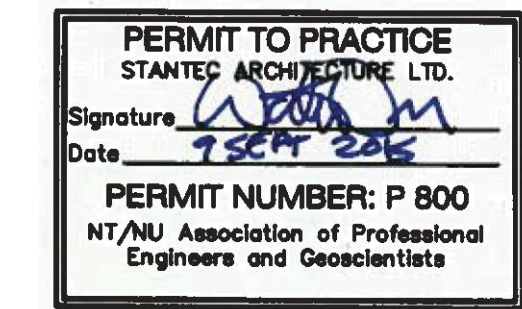


PROJECT TITLE
FUEL STORAGE FACILITY UPGRADES
LOCATION
CHESTERFIELD INLET, NU

DRAWING TITLE
OPERATOR'S SHELTER FLOOR PLAN AND ELEVATIONS

DRAWN BY AF	SCALE AS NOTED
CHECKED BY WO	CLIENT PROJECT NO. 10-3018

FSC PROJECT NO.
2010-1160

DRAWING NO.
S1

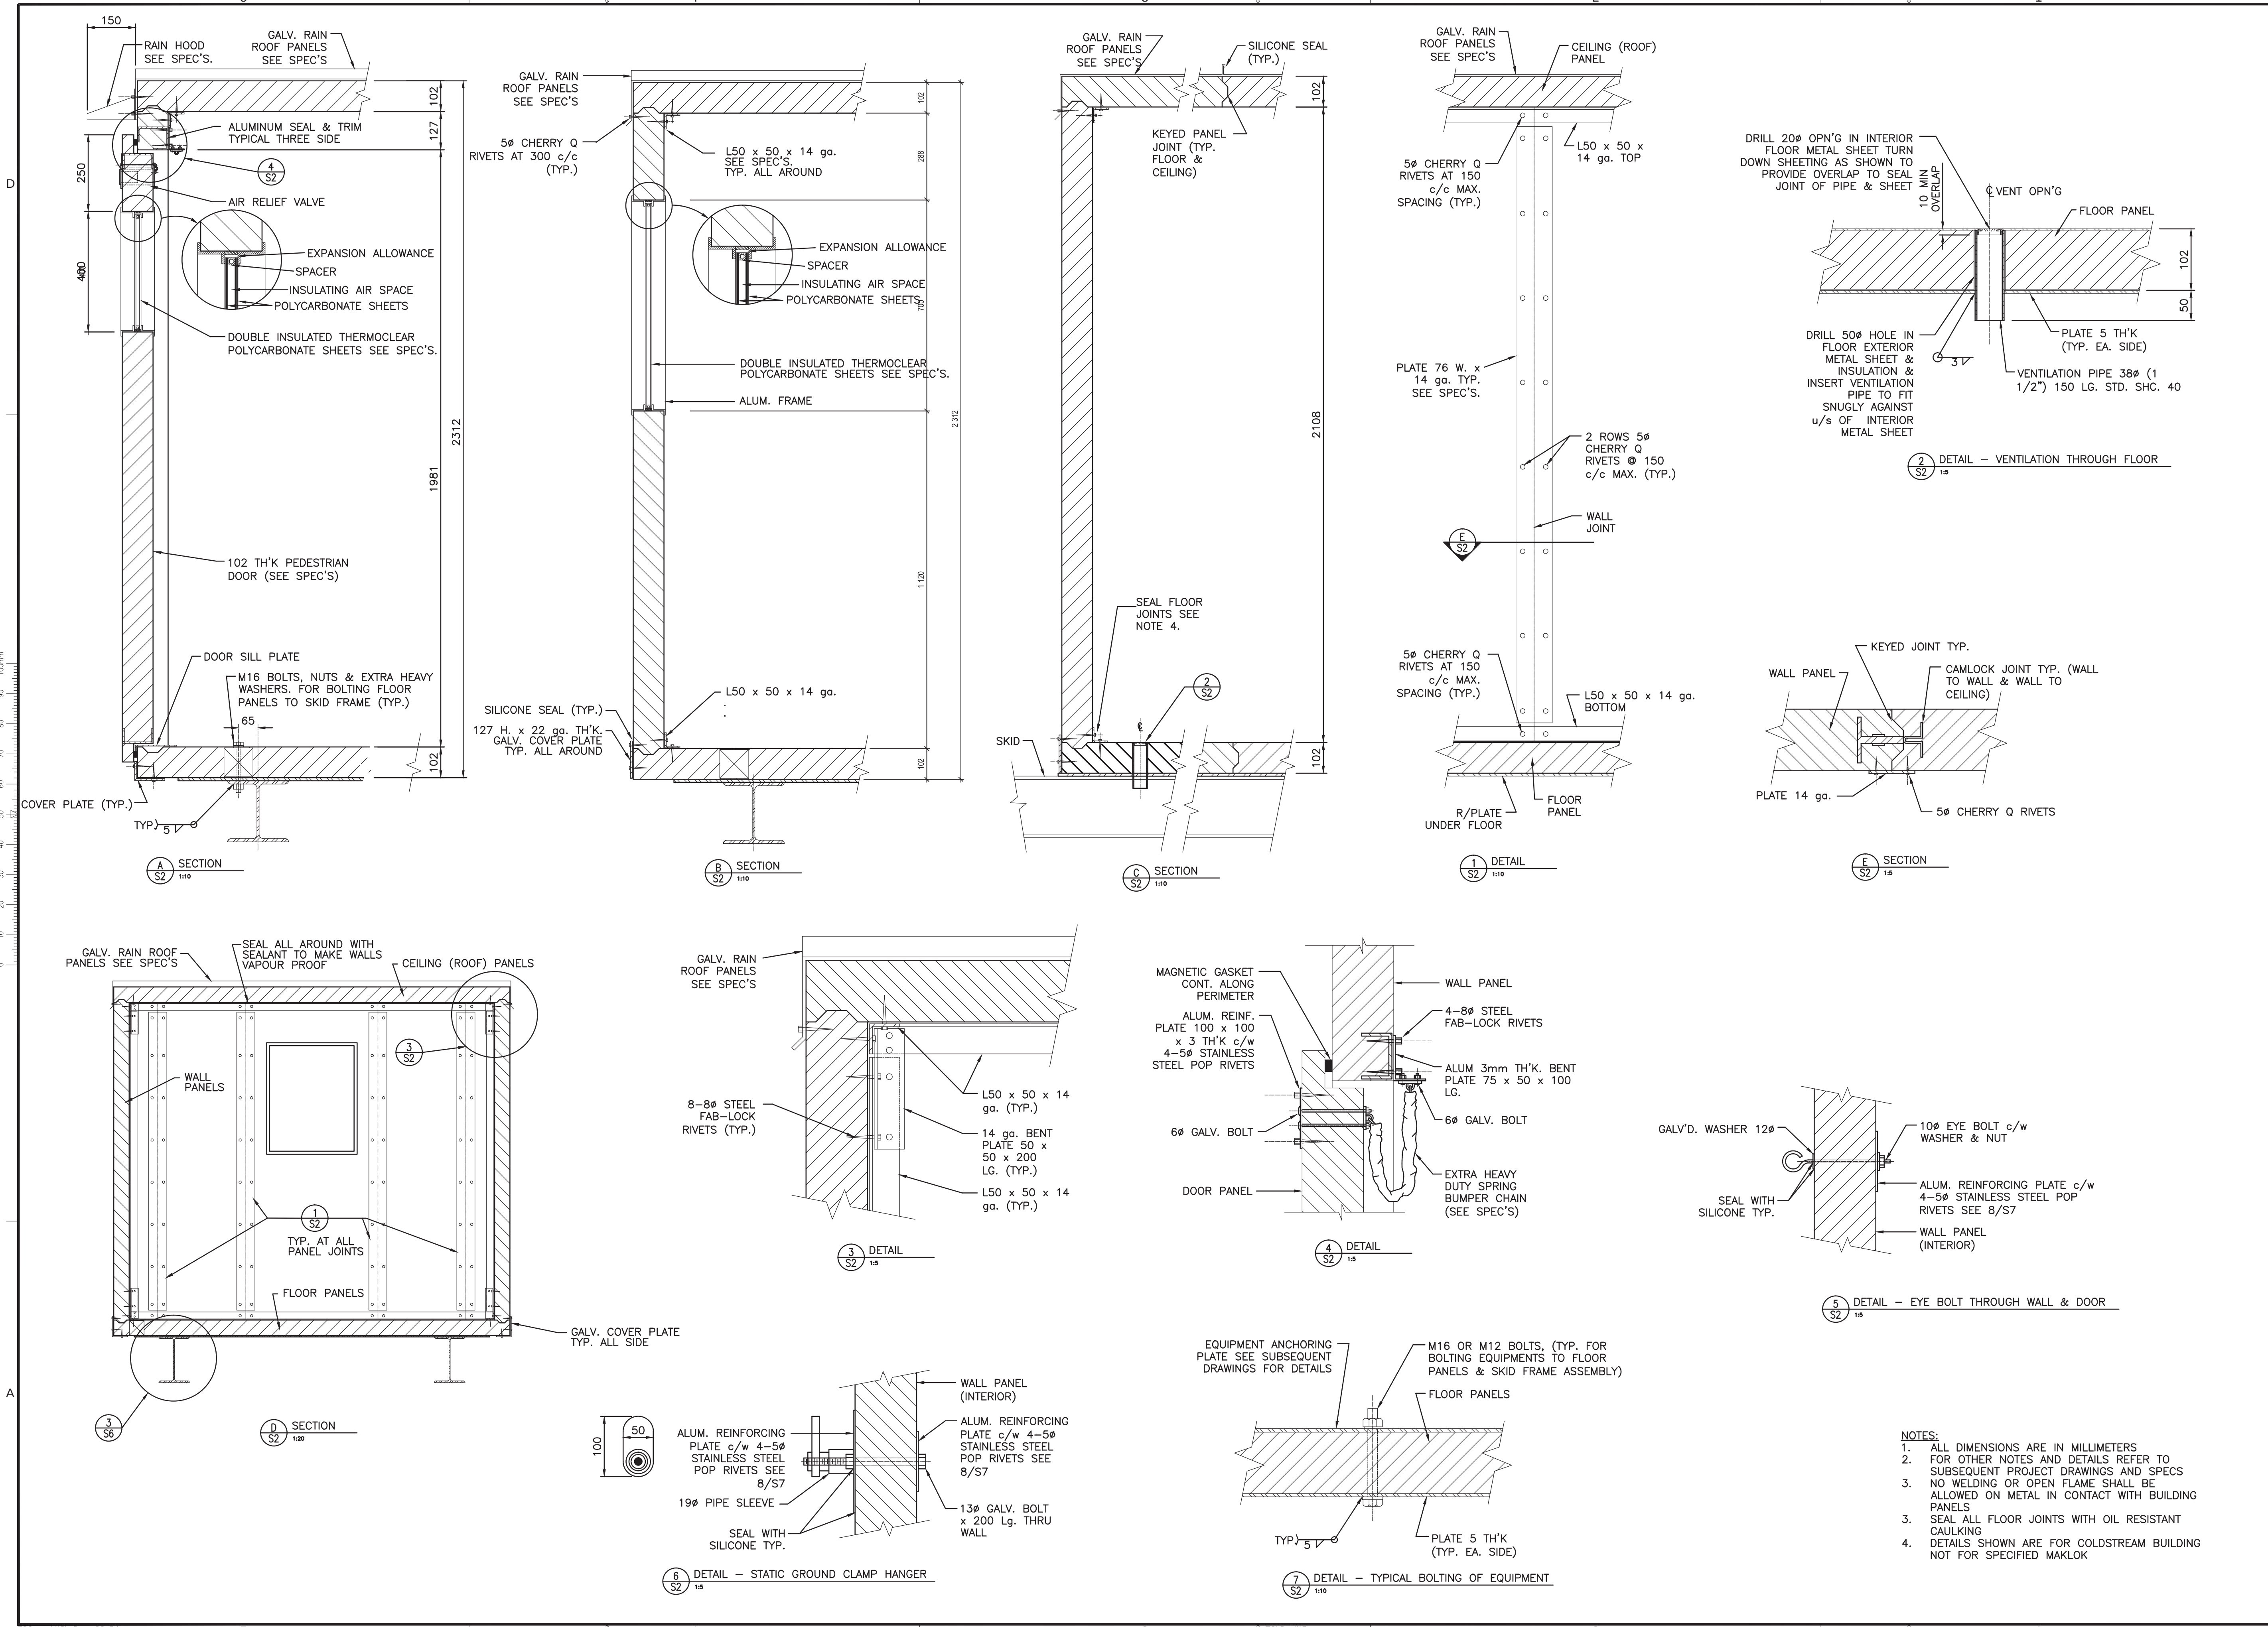


© Copyright Reserved 2011 by FSC Architects & Engineers
The information contained in this drawing is copyright and has been prepared for the sole purpose of the project described herein and for the sole benefit of the Owner. Any unauthorized use of this information will be considered a breach of copyright and may be pursued as such. Use of this information for any purpose other than the project described herein is at the sole risk of the user.

Record Drawing

These drawings have been prepared based on information provided by Inukshuk Construction with a construction completion date of 2022/2024. Stantec has not verified the accuracy and/or completeness of this information and shall not be responsible for any errors or omissions which may be incorporated herein as a result.

NO.	REVISION DESCRIPTION	DATE ISSUED
03	RECORD DRAWINGS	2013/11/01
02	ISSUED FOR TENDER	2011/06/08
01	ISSUED FOR 95% REVIEW	2011/03/25
00	ISSUED FOR 50% REVIEW	2011/02

PROFESSIONAL SEAL / PERMIT TO PRACTICE

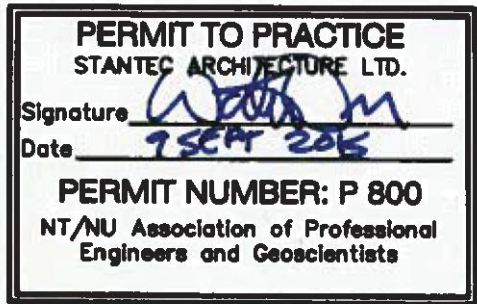

FSC
ARCHITECTS & ENGINEERS
Unit C, 1088 Mivvik Street, Box 1779
Iqaluit, NU, X0A 0H0, Canada
T 867.979.0555 | F 867.979.5711

PROJECT TITLE

FUEL STORAGE FACILITY UPGRADES

LOCATION

CHESTERFIELD INLET, NU

DRAWING TITLE

OPERATOR'S SHELTER SECTION AND DETAILS

DRAWN BY AF SCALE AS NOTED


CHECKED BY WO CLIENT PROJECT NO. 10-3018

FSC PROJECT NO. 2010-1160


DRAWING NO.

S2


OF 45

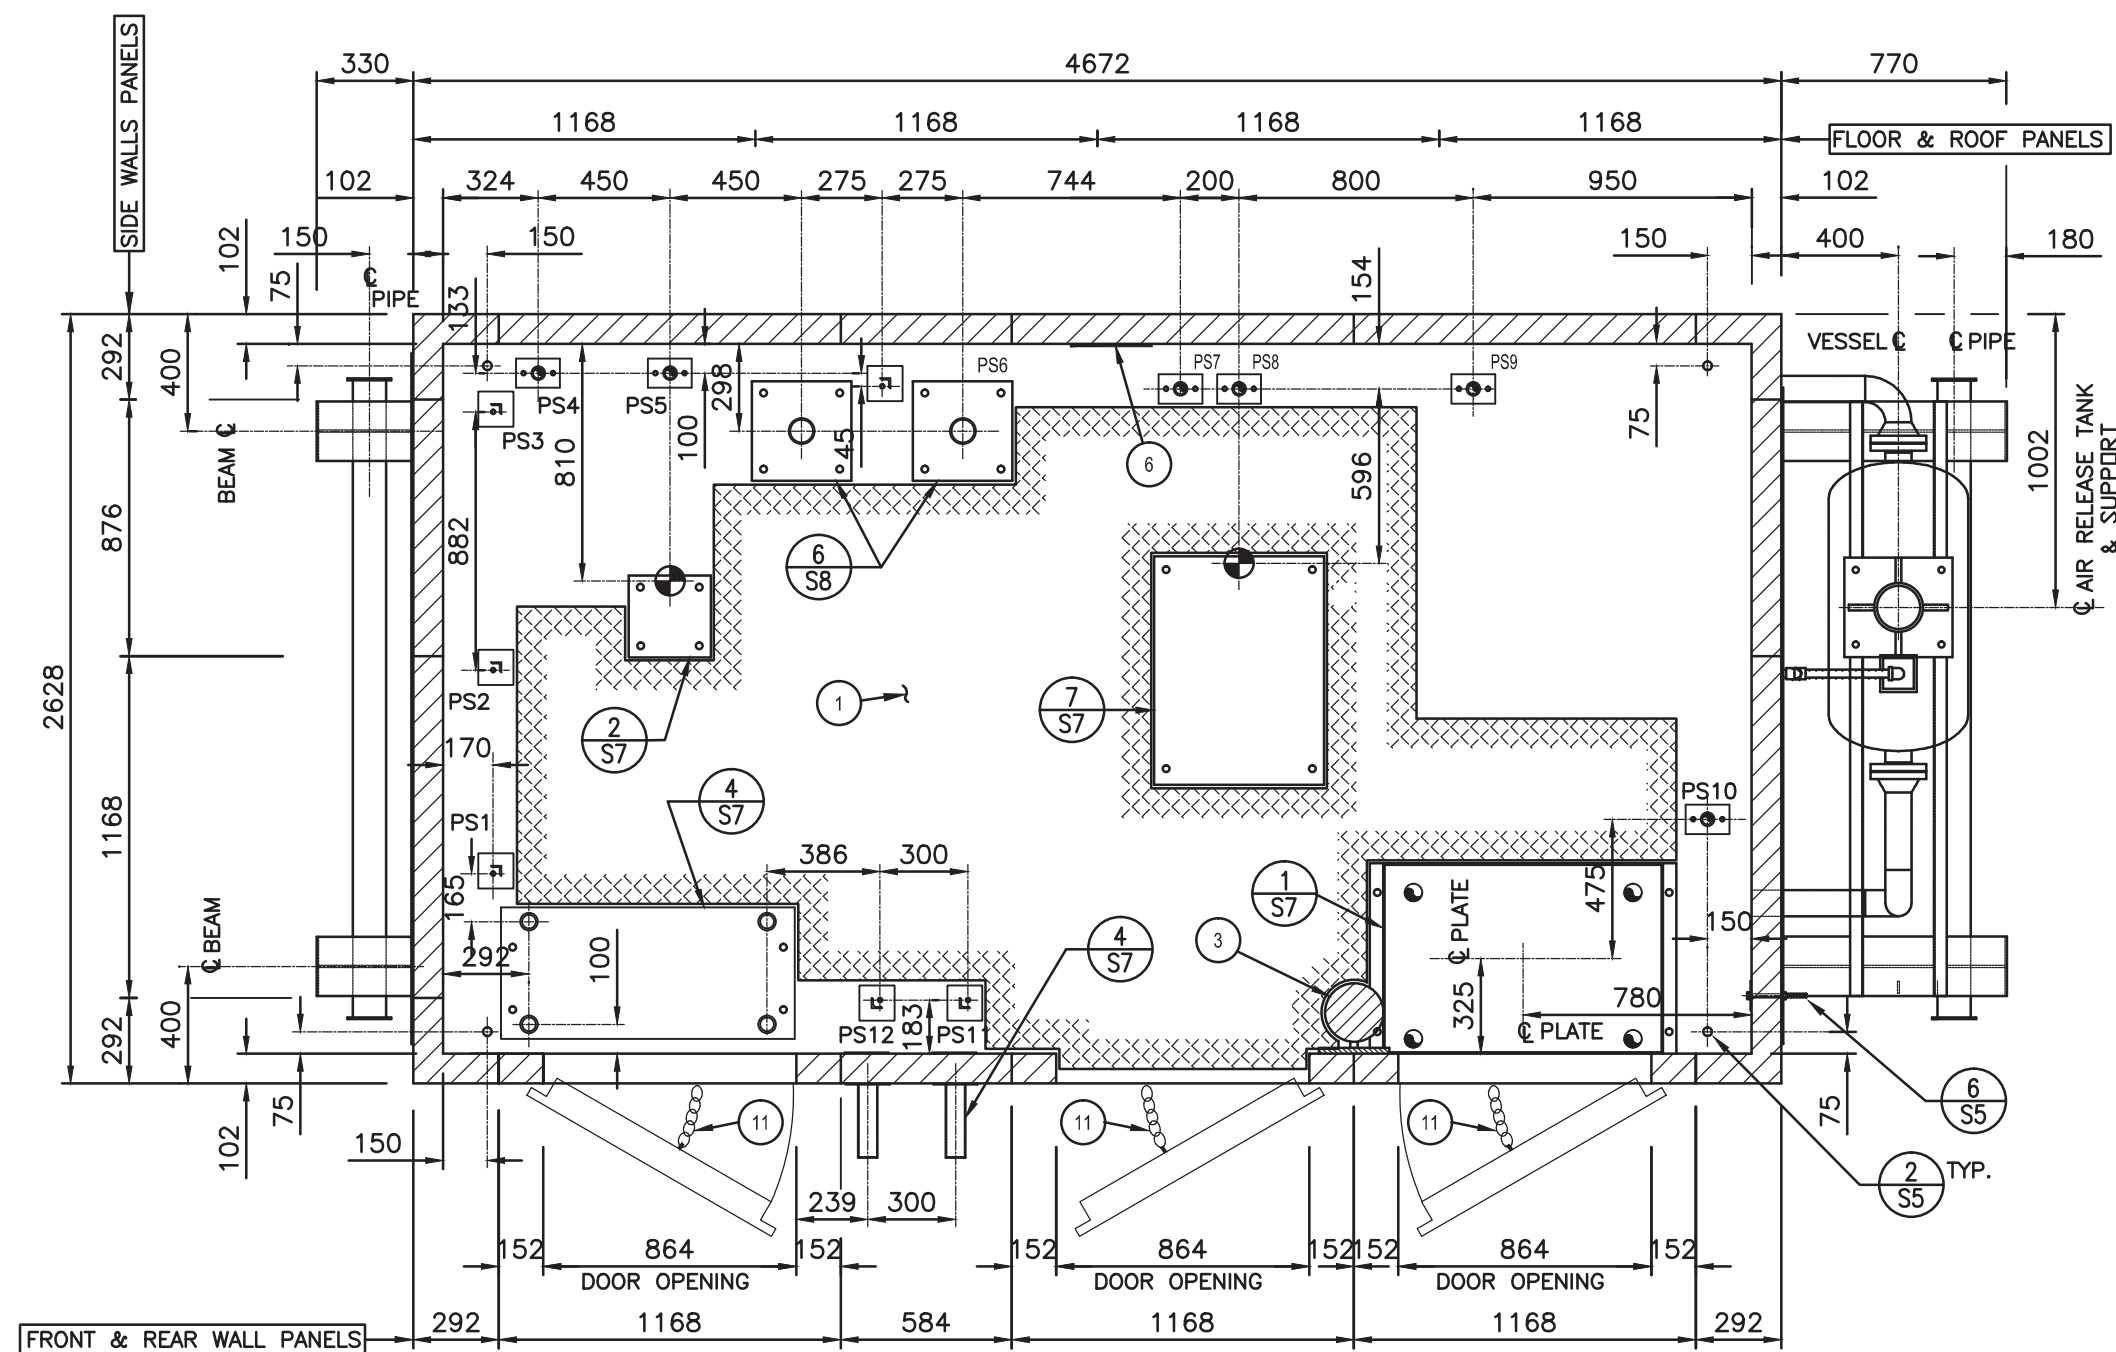

1 PLAN
S4
N.T.S.

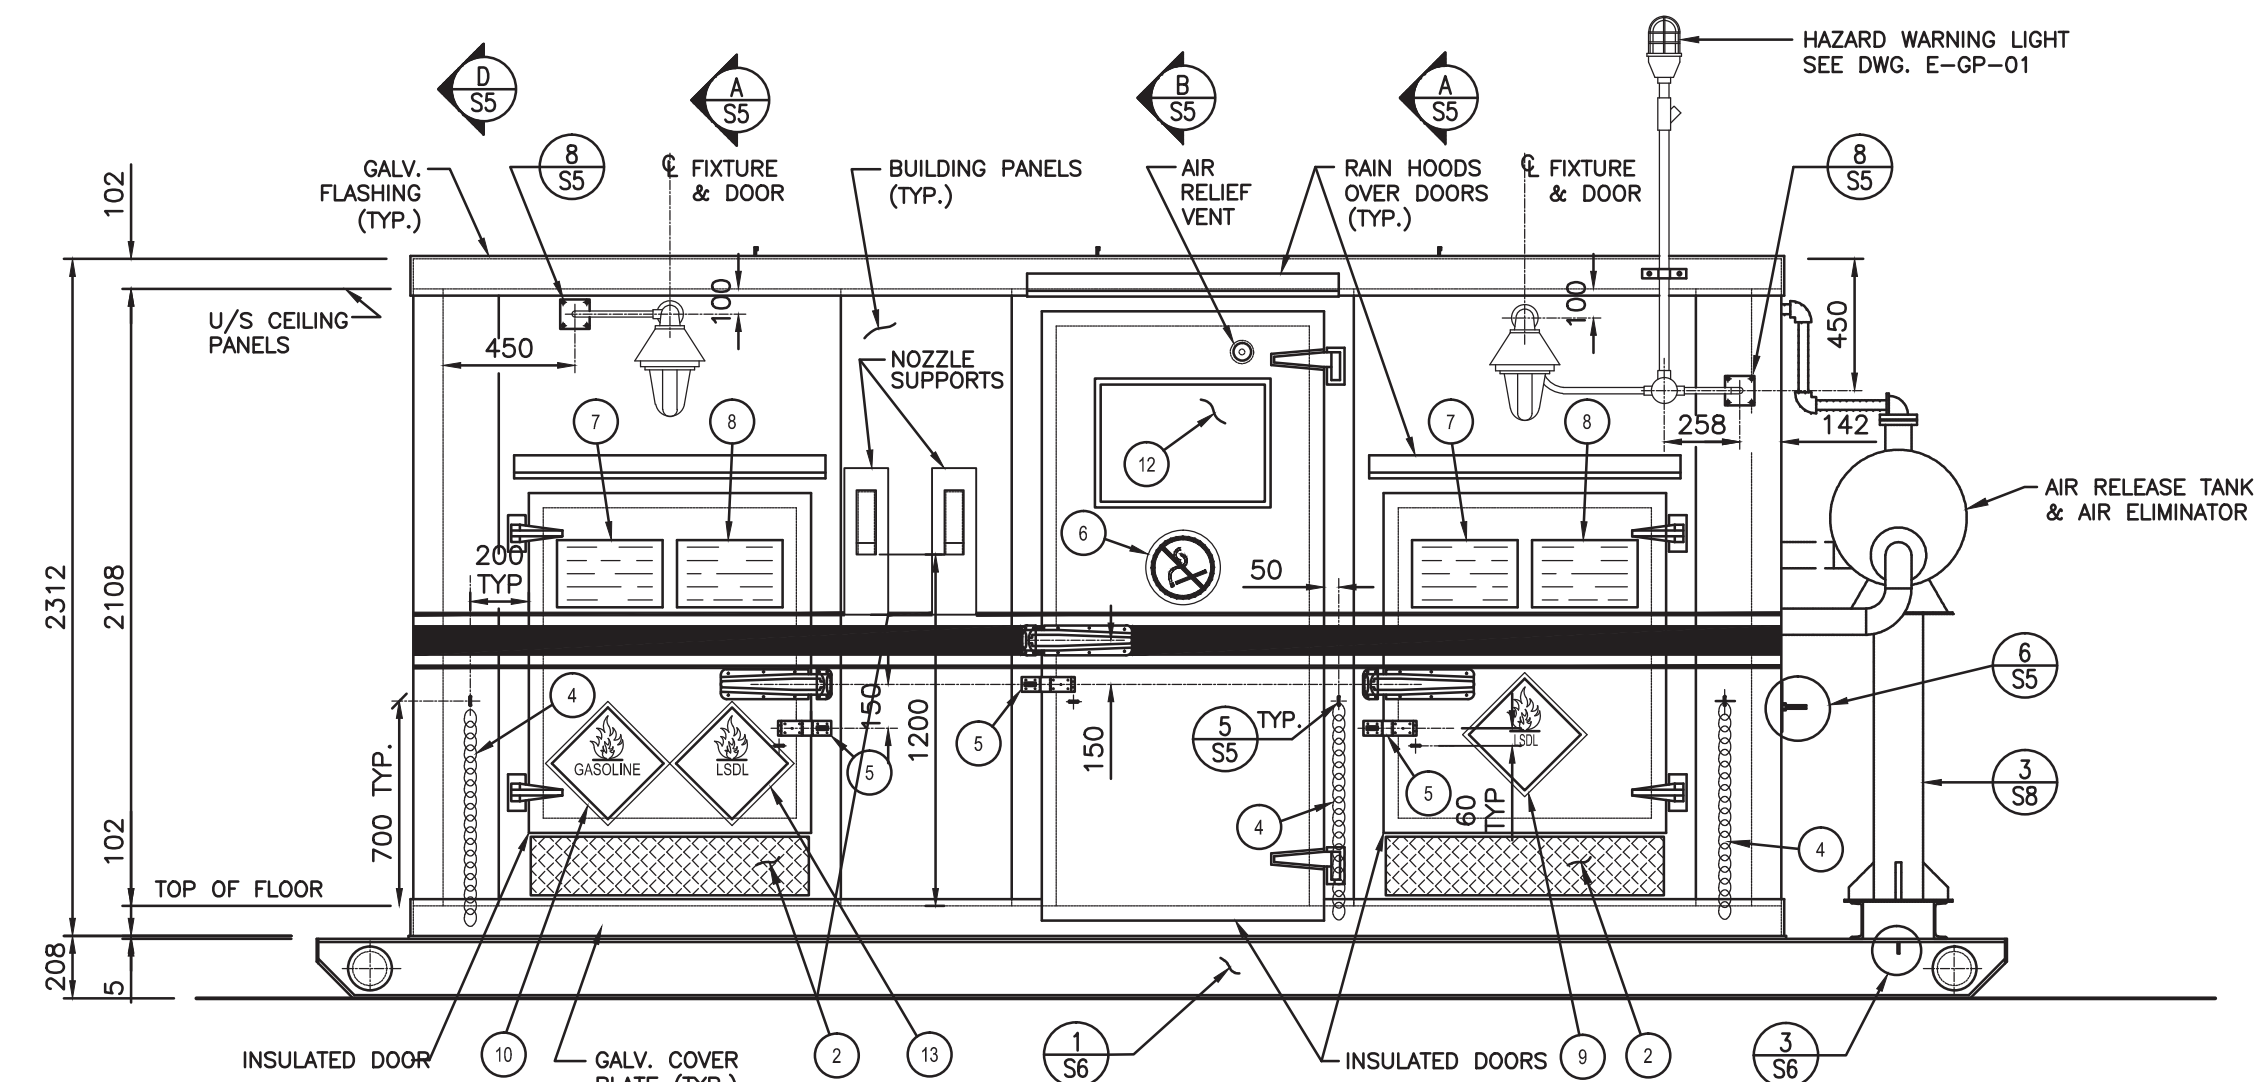


2 FRONT ELEVATION
S4
N.T.S.

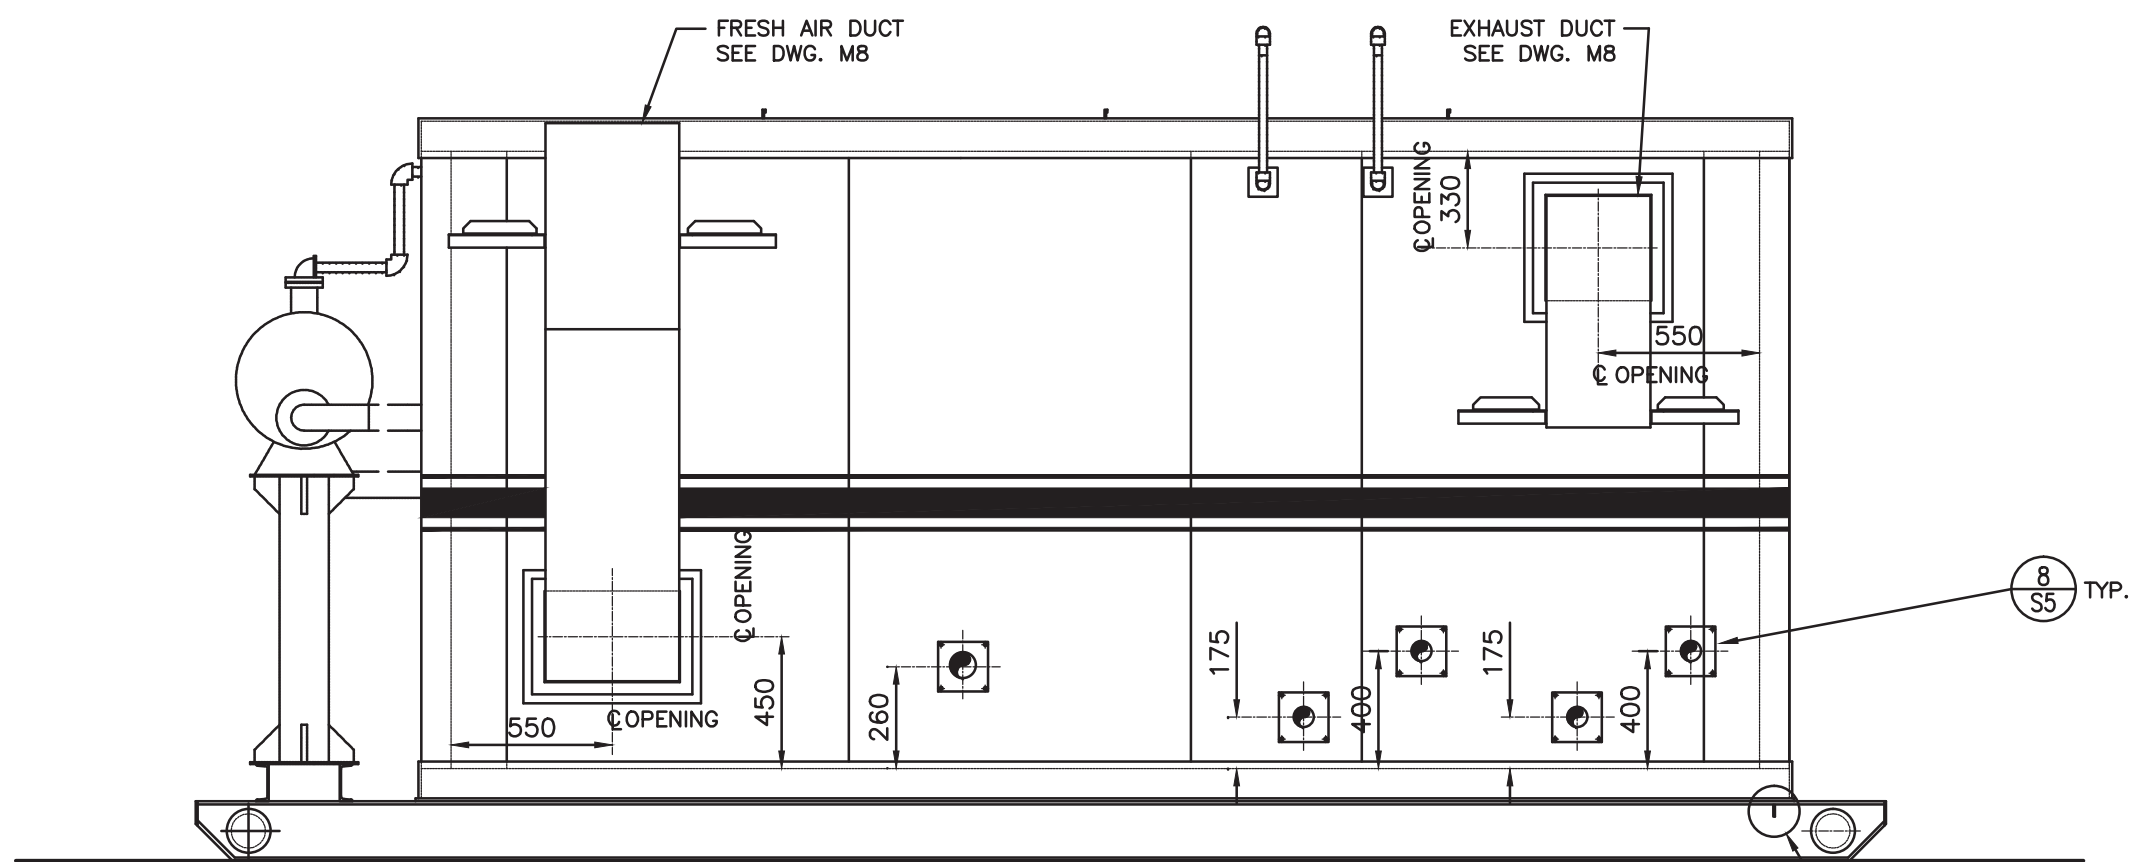


3 REAR ELEVATION
S4
N.T.S.

LEGEND:

- NON-SKID ALUMINUM "SAFETY TREAD" FLOORING SHEETS, SEE SPEC'S. (KEEP NUMBER OF PLATES TO A MINIMUM)
- ALUMINUM CHECKERED PLATE, ALCOA CO. STYLE #C-102 OR EQUIV., 250W x 950LG. x 3 TH'K, (2 REQ'D) POP RIVETTED TO WALL PANELS AT 150 c/c MAX. SPACING AT PERIPHERY
- FIRE EXTINGUISHER c/w BRACKET MOUNTED 100 ABOVE FLOOR - (1 REQ'D), SEE SPEC'S
- HEAVY DUTY CHAIN c/w HOOKS, TYPICAL AT DOORS, SEE SPEC'S (3 REQ'D.)
- HASP - (3 REQ'D), SEE SPEC'S
- "NO SMOKING" SIGN - (2 REQ'D), SEE SPEC'S
- "NO SMOKING/STOP YOUR MOTOR" SIGN (IN ENGLISH) - (2 REQ'D), SEE SPEC'S
- "NO SMOKING/STOP YOUR MOTOR" SIGN (IN LOCAL TRANSLATION) - (2 REQ'D), SEE SPEC'S
- UN NUMBER 1203 "LSDL" SIGN, SEE SPEC'S
- UN NUMBER 1202 "GASOLINE" SIGN, SEE SPEC'S
- HEAVY DUTY SPRING BUMPER CHAIN ON ALL DOORS, SEE SPEC'S (3 REQ'D)
- DOUBLE INSULATED THERMOCLEAR POLYCARBONATE SHEETS & ALUM. FRAME.
- "CLOSE VALVE" SIGN., SEE SPEC'S
- SEAL ALL FLOOR JOINTS WITH OIL RESISTANT CAULKING.
- POST PROCESS FLOW SHEET AND OPERATING INSTRUCTIONS.

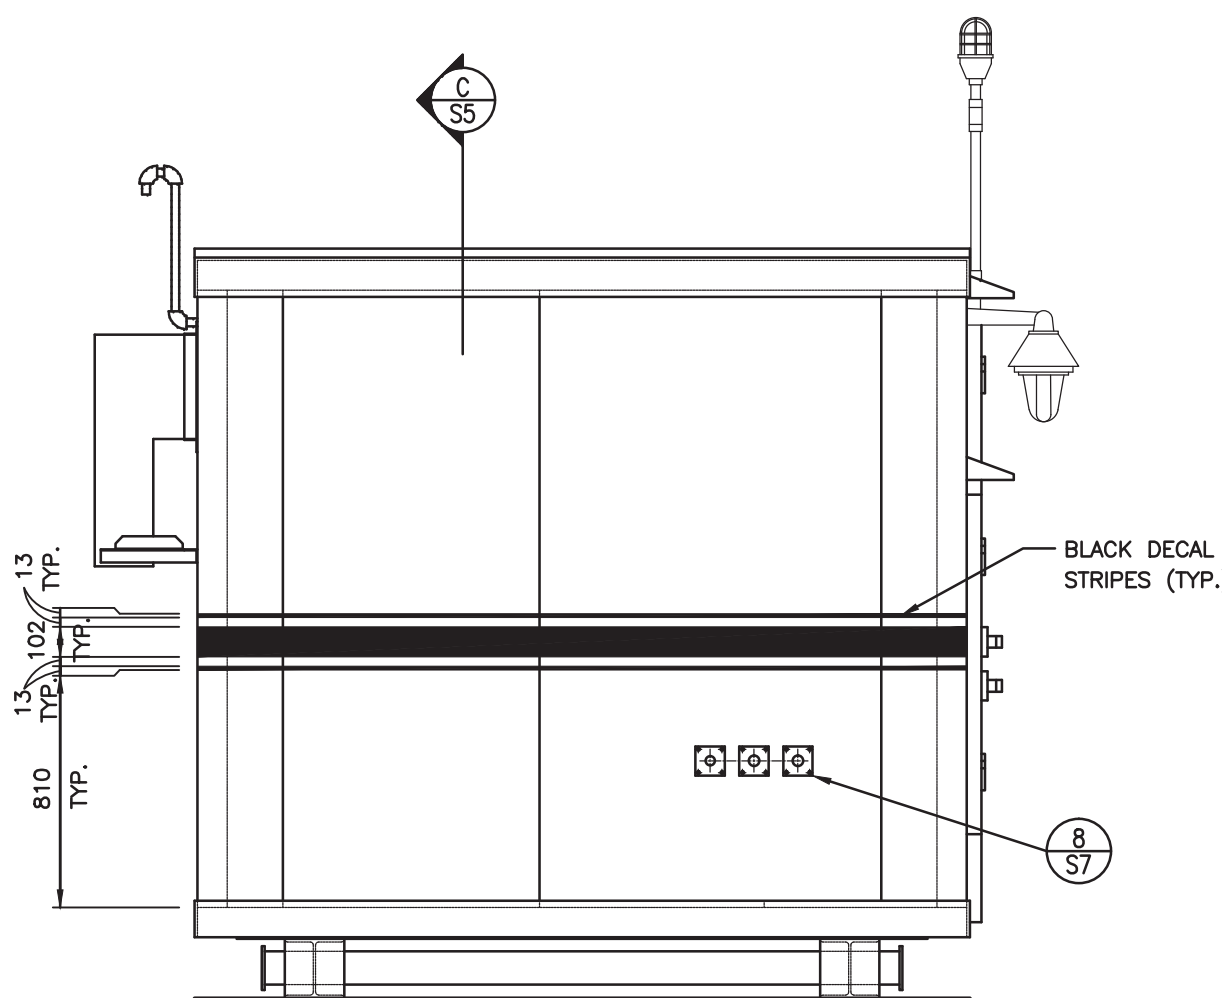

4 LEFT SIDE ELEVATION
S4
N.T.S.

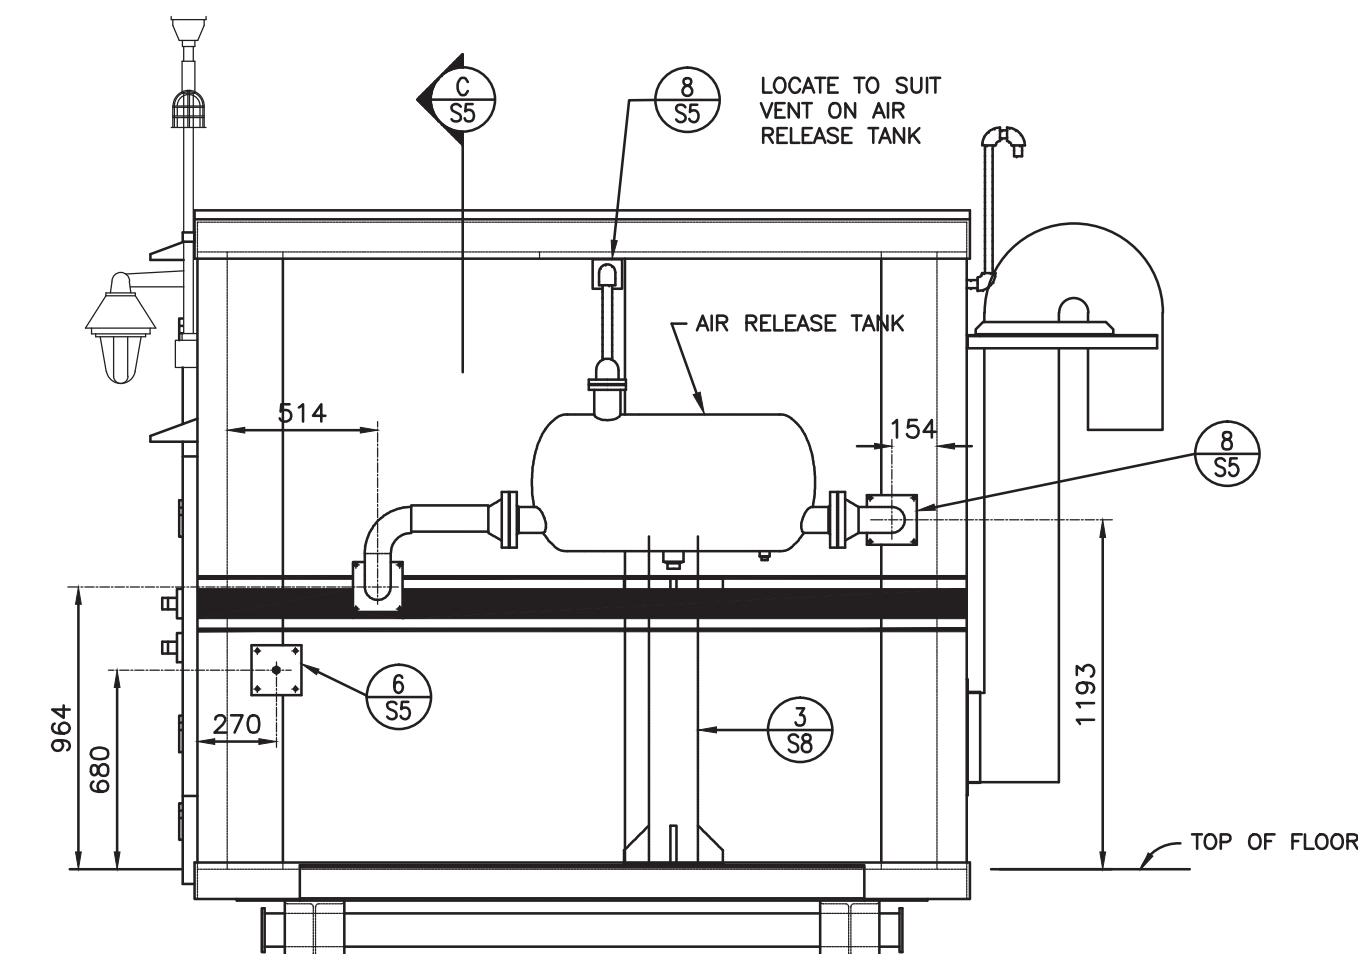

4 RIGHT SIDE ELEVATION
S4
N.T.S.



© Copyright Reserved 2011 by FSC Architects & Engineers
The information contained in this drawing is copyright and has been prepared for the sole purpose of the project described herein and for the sole benefit of the Owner. Any unauthorized use of this information will be considered a breach of copyright and may be pursued as such. Use of this information for any purpose other than the project described herein is at the sole risk of the user.


Record Drawing

These drawings have been prepared based on information provided by Inukshuk Construction with a construction completion date of 20.02.2014. Stantec has not verified the accuracy and/or completeness of this information and shall not be responsible for any errors or omissions which may be incorporated herein as a result.

STANDARD DRAWING A-GP-01

NO.	REVISION DESCRIPTION	DATE ISSUED
03	RECORD DRAWINGS	2013/11/01
02	ISSUED FOR TENDER	2011/06/08
01	ISSUED FOR 95% REVIEW	2011/03/25
00	ISSUED FOR 50% REVIEW	2011/02

PROFESSIONAL SEAL / PERMIT TO PRACTICE

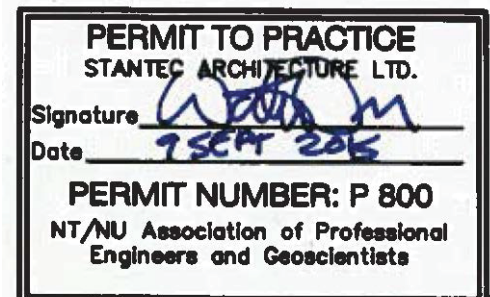

FSC
ARCHITECTS & ENGINEERS
Unit C, 1088 Mivik Street, Box 1779
Iqaluit, NU, X0A 0H0, Canada
T 867.979.0555 | F 867.979.5711


PROJECT TITLE
FUEL STORAGE FACILITY UPGRADES
LOCATION
CHESTERFIELD INLET, NU

DRAWING TITLE
LSDL/GASOLINE DISPENSER BUILDING FLOOR PLAN AND ELEVATIONS

DRAWN BY AF SCALE AS NOTED
CHECKED BY WO CLIENT PROJECT NO. 10-3018

FSC PROJECT NO. 2010-1160

DRAWING NO. S4

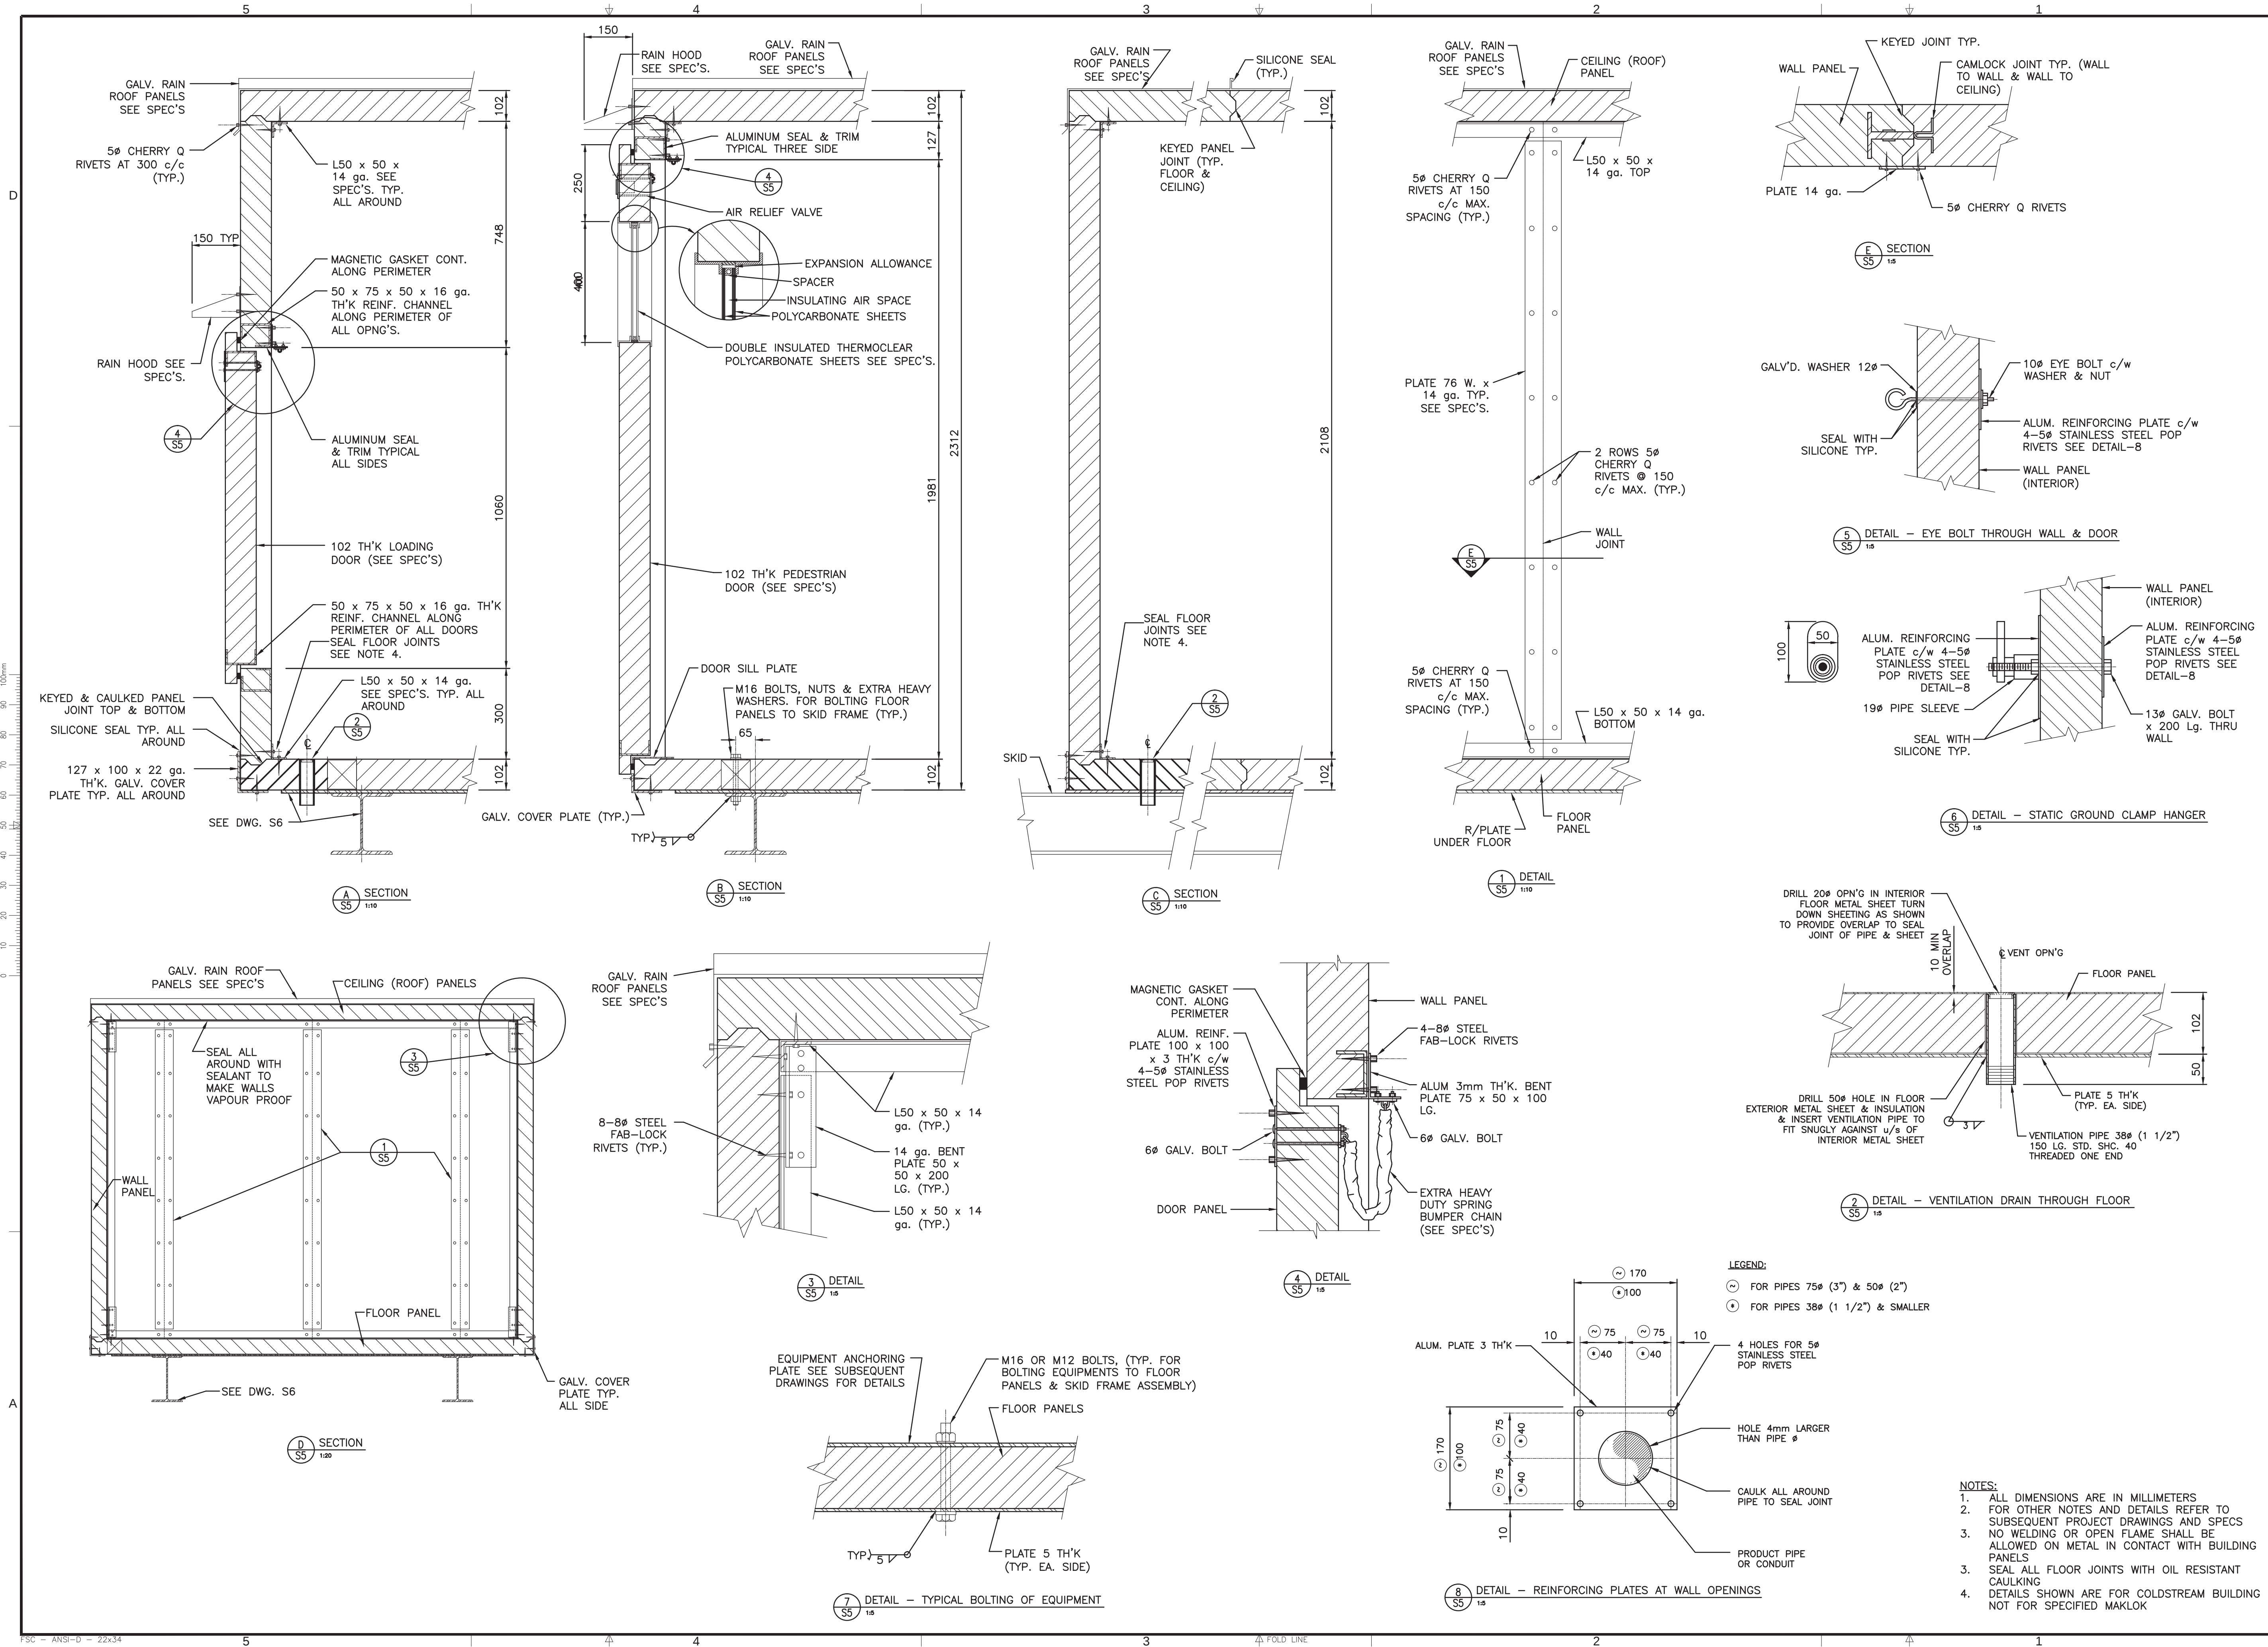

© Copyright Reserved 2011 by FSC Architects & Engineers
The information contained in this drawing is copyright and has been prepared for the sole purpose of the project described herein and for the sole benefit of the Owner. Any unauthorized use of this information will be considered a breach of copyright and may be pursued as such. Use of this information for any purpose other than the project described herein is at the sole risk of the user.


Record Drawing

These drawings have been prepared based on information provided by Inukshuk Construction with a construction completion date of 20.02.2014. Stantec has not verified the accuracy and/or completeness of this information and shall not be responsible for any errors or omissions which may be incorporated herein as a result.

STANDARD DRAWING A-GP-02

NO.	REVISION DESCRIPTION	DATE ISSUED
03	RECORD DRAWINGS	2013/11/01
02	ISSUED FOR TENDER	2011/06/08
01	ISSUED FOR 95% REVIEW	2011/03/25
00	ISSUED FOR 50% REVIEW	2011/02

PROFESSIONAL SEAL / PERMIT TO PRACTICE

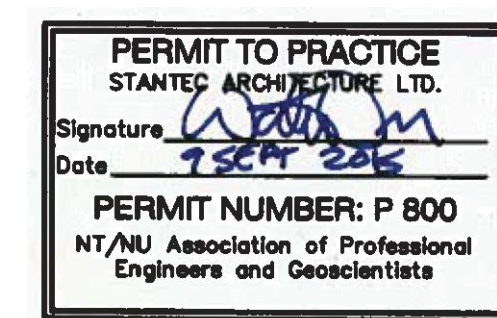

FSC
ARCHITECTS & ENGINEERS
Unit C, 1088 Mivvik Street, Box 1779
Iqaluit, NU, X0A 0H0, Canada
T 867.979.0555 | F 867.979.5711

FUEL STORAGE FACILITY UPGRADES

CHESTERFIELD INLET, NU



LSDI/GASOLINE DISPENSER BUILDING SECTION AND DETAILS

DRAWN BY: AF SCALE: AS NOTED

CHECKED BY: WO CLIENT PROJECT NO: 10-3018

FSC PROJECT NO: 2010-1160

DRAWING NO: S5

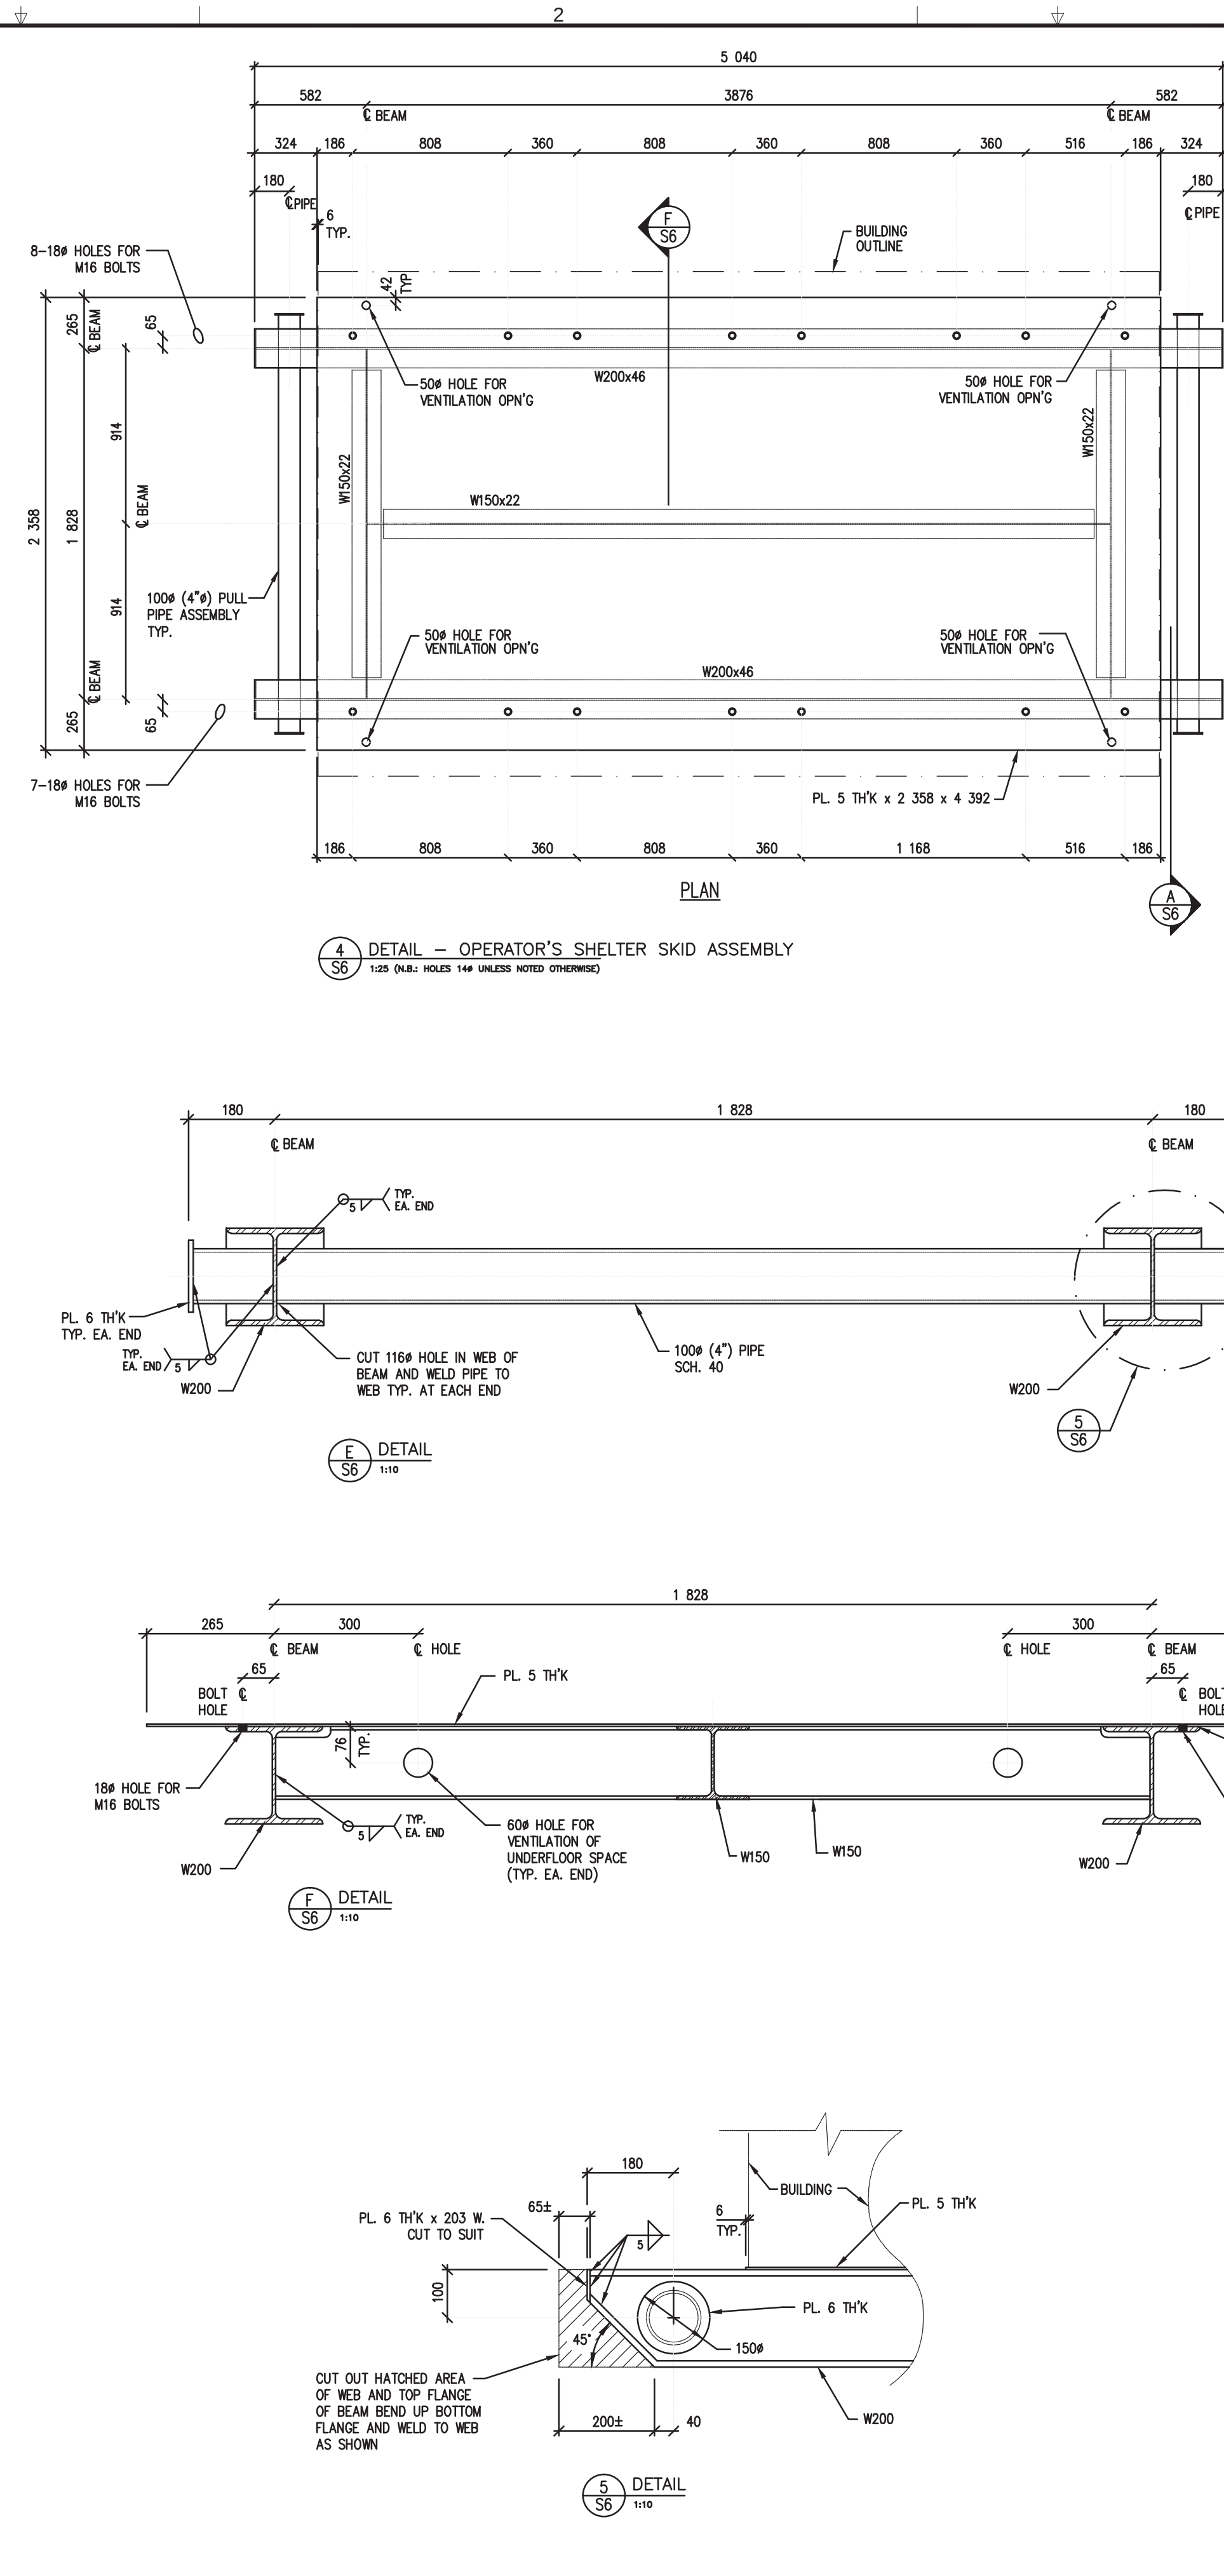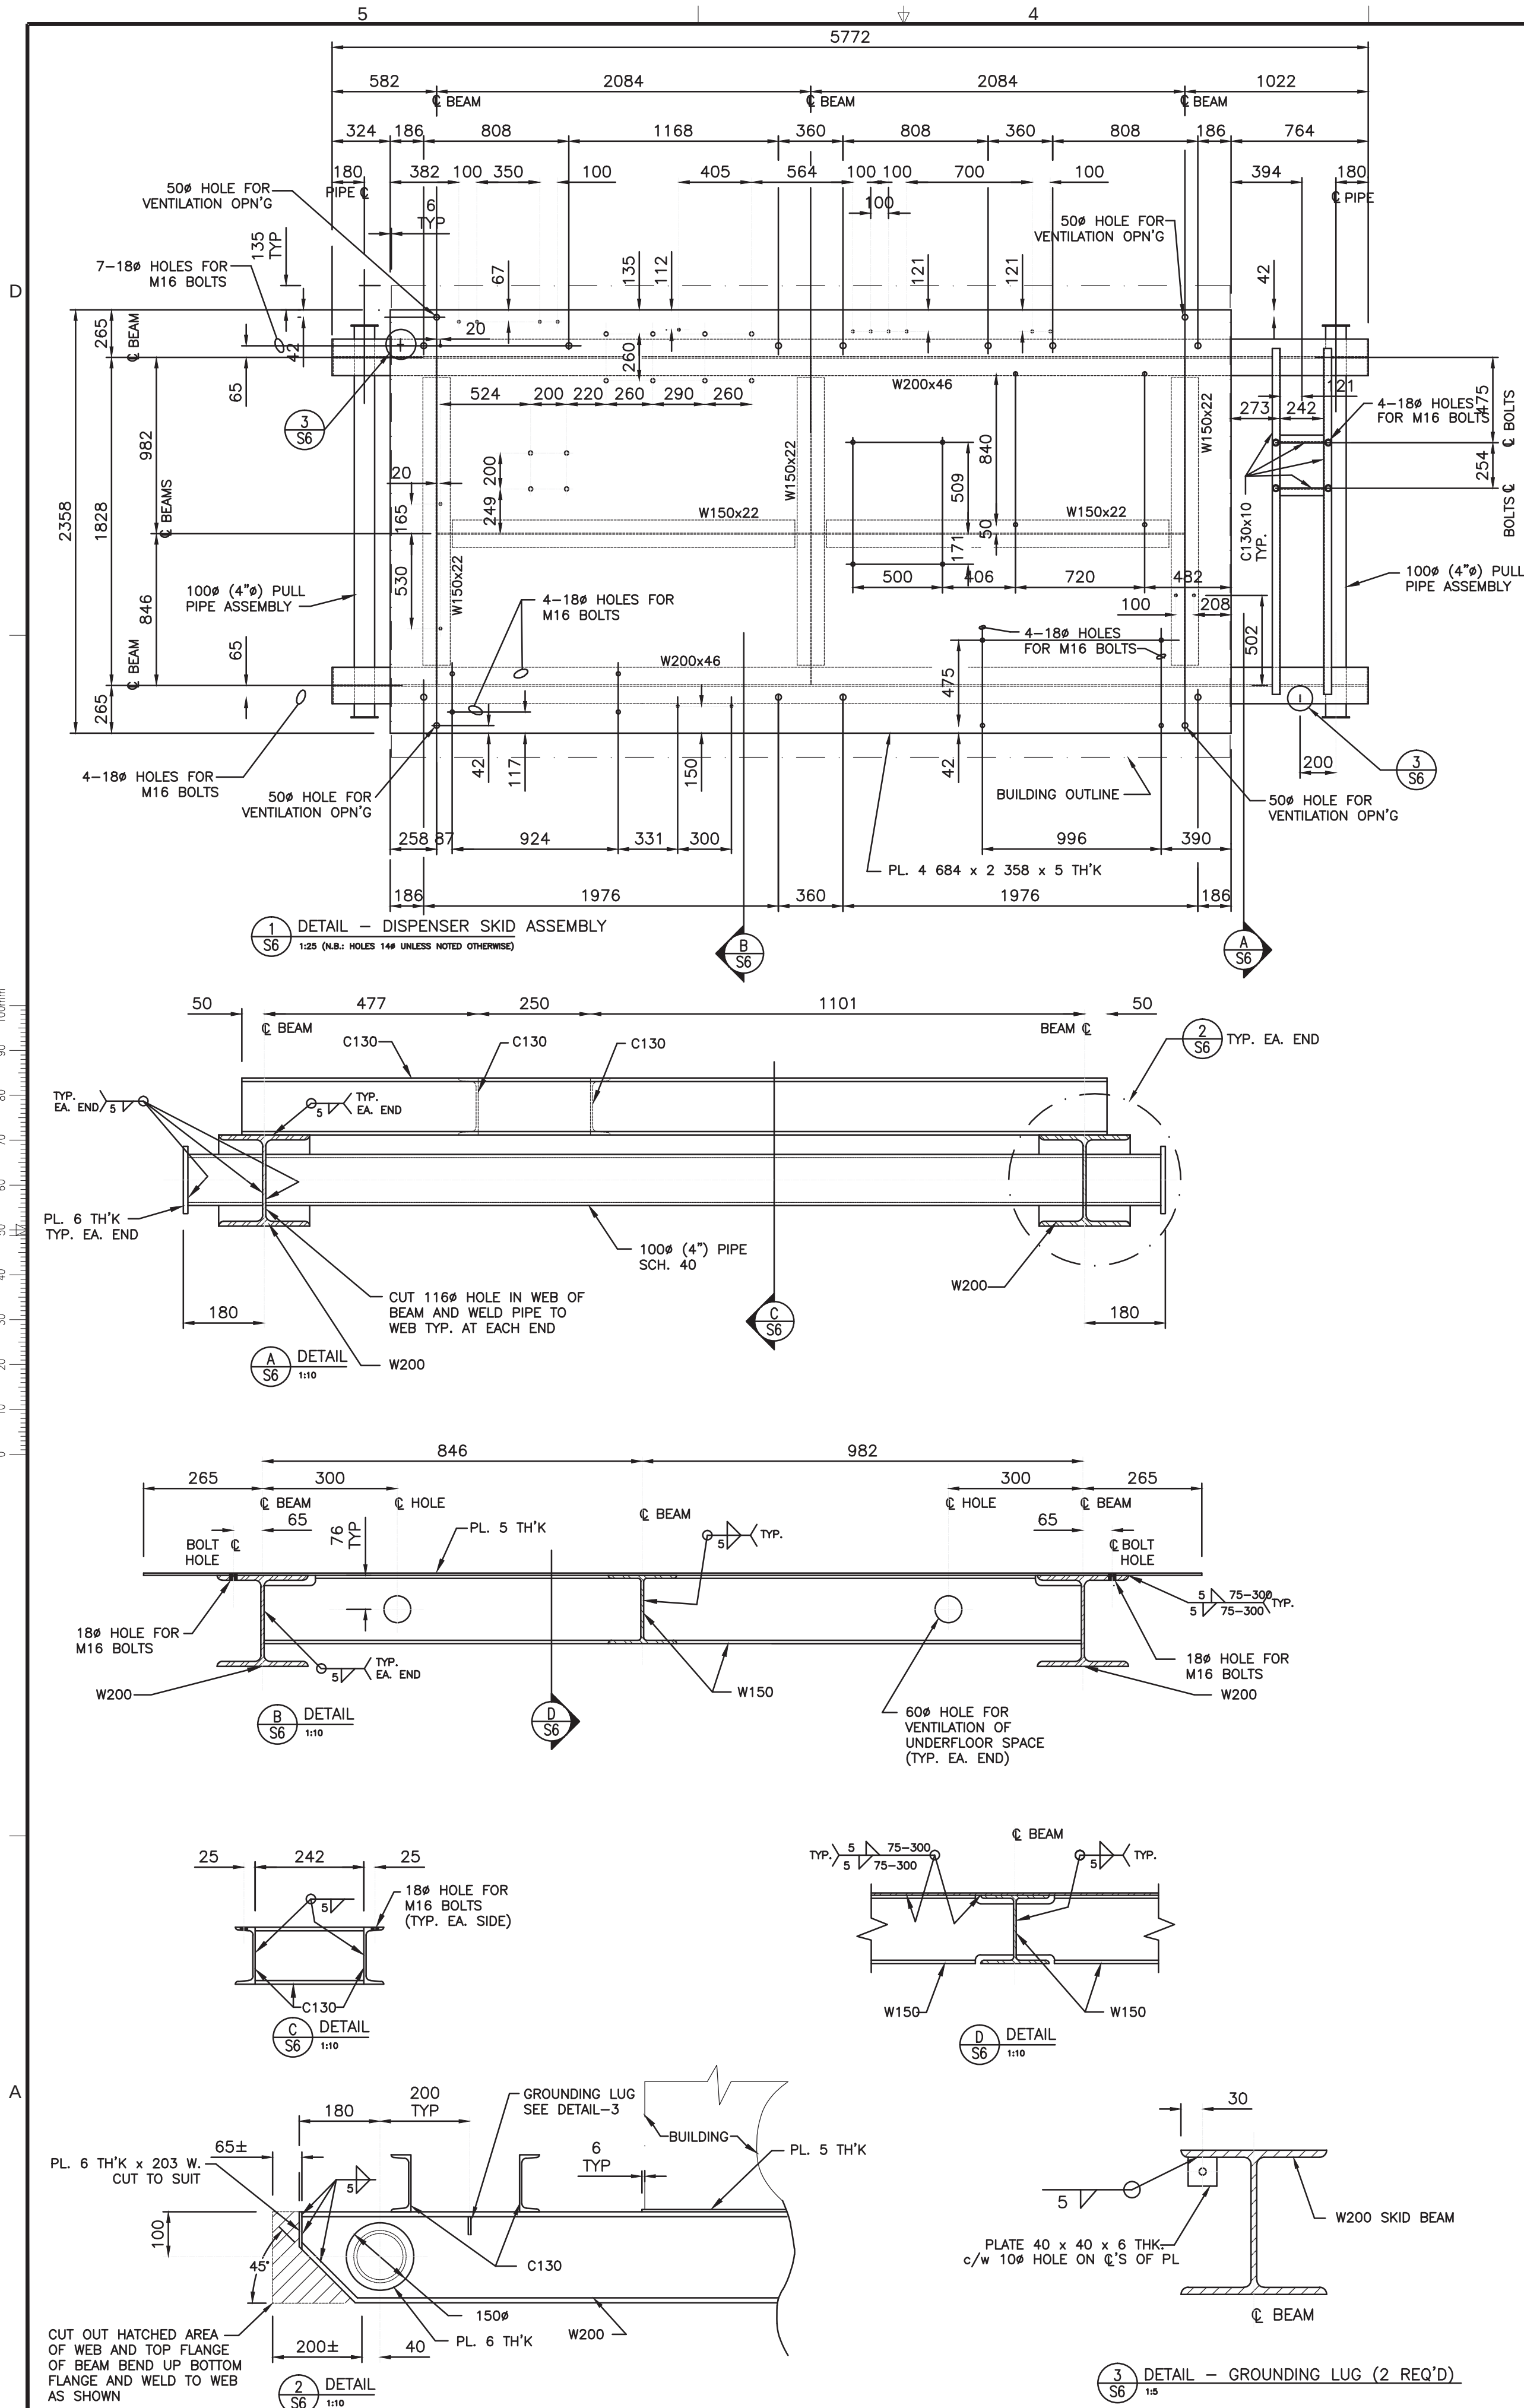

NOTES:

1. ALL DIMENSIONS ARE IN MILLIMETRES.
2. WELDING AT PLATES FLUSH TO U/S OF FLOOR PANELS SHALL BE GROUND SMOOTH TO PERMIT PROPER BEARING OF PANELS TO PLATES.
3. NO WELDING OR OPEN FLAME SHALL BE ALLOWED ON METAL IN CONTACT WITH BUILDING PANELS.
4. ALL BOLTING SHALL BE WITH MACHINE BOLTS TO ASTM A325 GALVANIZED HEX HEADS AND NUTS. ALL SCREWS SHALL BE METAL SCREWS GALVANIZED, SIZES AS SHOWN LENGTHS AS REQUIRED.
5. NUMBER AND SPACINGS OF PANEL MOUNTING HOLES COULD VARY TO SUIT SIZE OF FLOOR PANELS. CONTRACTOR TO VERIFY WITH SHOP DRAWINGS OF PANEL MANUFACTURER FOR FINAL PANEL SIZES PRIOR TO FABRICATION OF SKID FRAME.
6. FOR OTHER NOTES AND DETAILS REFER TO SUBSEQUENT PROJECT DRAWINGS AND SPECIFICATIONS.





© Copyright Reserved 2011 by FSC Architects & Engineers
The information contained in this drawing is copyright and has been prepared for the sole purpose of the project described herein and for the sole benefit of the Owner. Any unauthorized use of this information will be considered a breach of copyright and may be pursued as such. Use of this information for any purpose other than the project described herein is at the sole risk of the user.

Record Drawing

These drawings have been prepared based on information provided by Inukshuk Construction with a construction completion date of 20.02.2014. Stantec has not verified the accuracy and/or completeness of this information and shall not be responsible for any errors or omissions which may be incorporated herein as a result.

NO.	REVISION DESCRIPTION	DATE ISSUED
03	RECORD DRAWINGS	2013/11/01
02	ISSUED FOR TENDER	2011/06/08
01	ISSUED FOR 95% REVIEW	2011/03/25
00	ISSUED FOR 50% REVIEW	2011/02

PROFESSIONAL SEAL / PERMIT TO PRACTICE

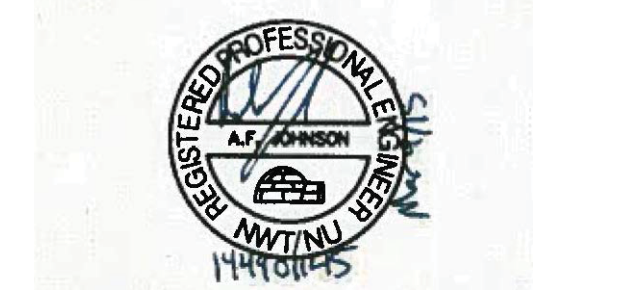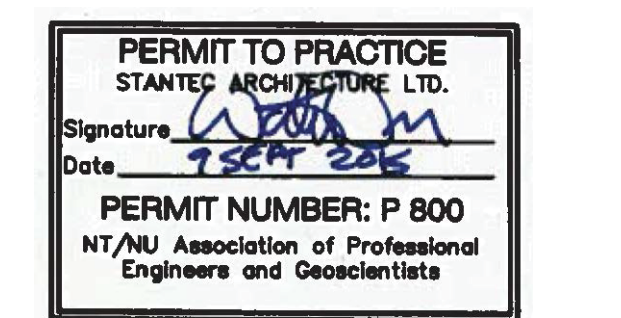

FSC
ARCHITECTS & ENGINEERS
Unit C, 1088 Mivik Street, Box 1779
Iqaluit, NU, X0A 0H0, Canada
T 867.979.0555 | F 867.979.5711








PROJECT TITLE
FUEL STORAGE FACILITY UPGRADES
LOCATION
CHESTERFIELD INLET, NU

DRAWING TITLE
OPERATOR'S SHELTER & DISPENSER BUILDING SKID ASSEMBLY PLAN SECTION AND DETAILS

DRAWN BY AF	SCALE AS NOTED
CHECKED BY WO	CLIENT PROJECT NO. 10-3018
FSC PROJECT NO. 2010-1160	
DRAWING NO. S6	of 45

D

A

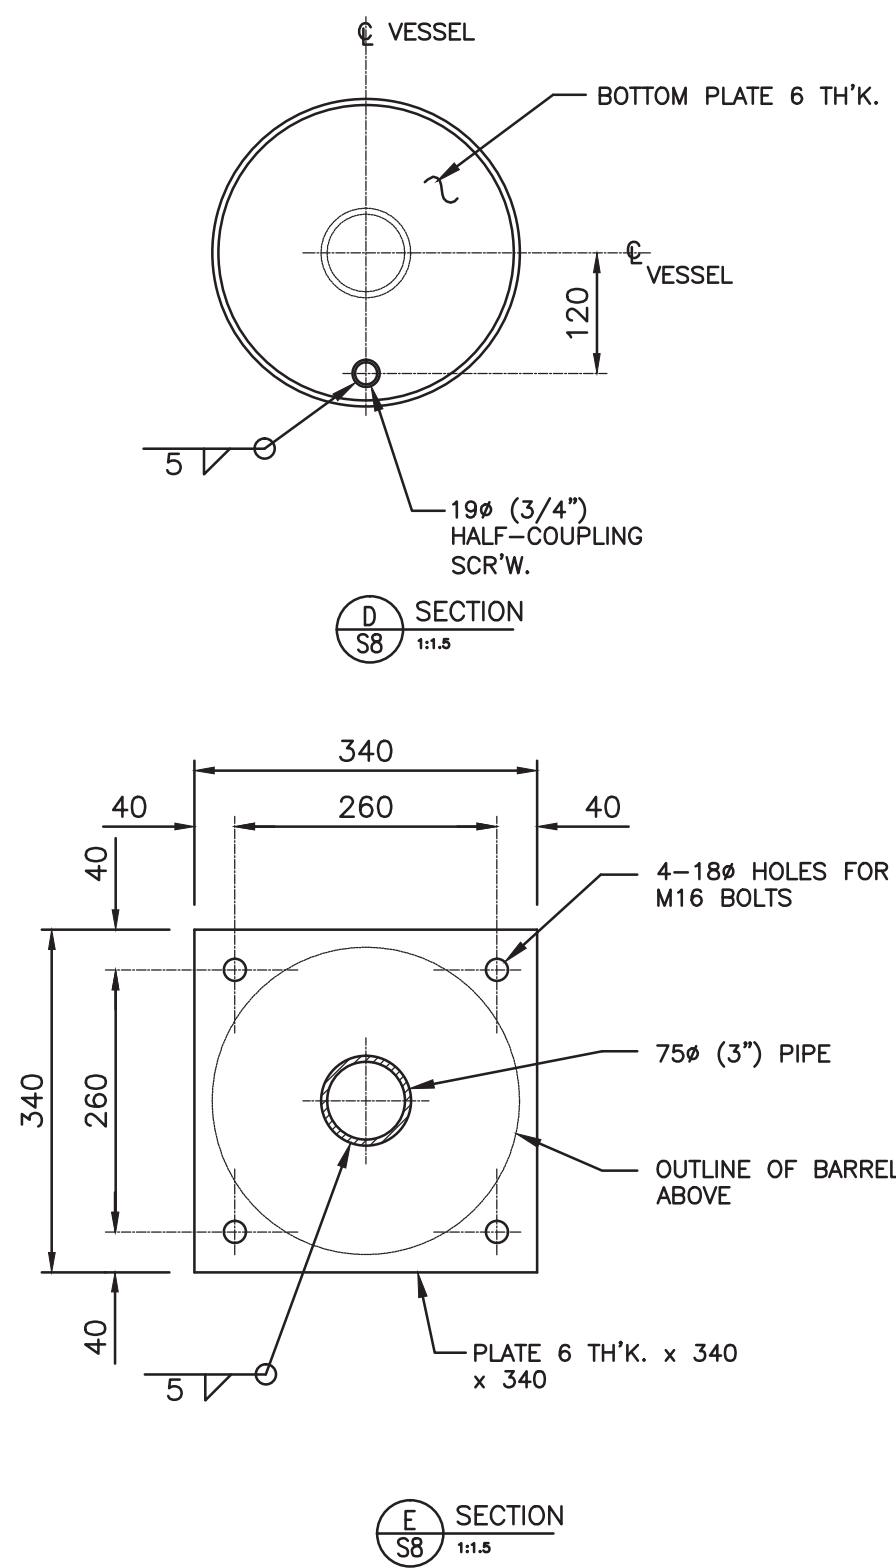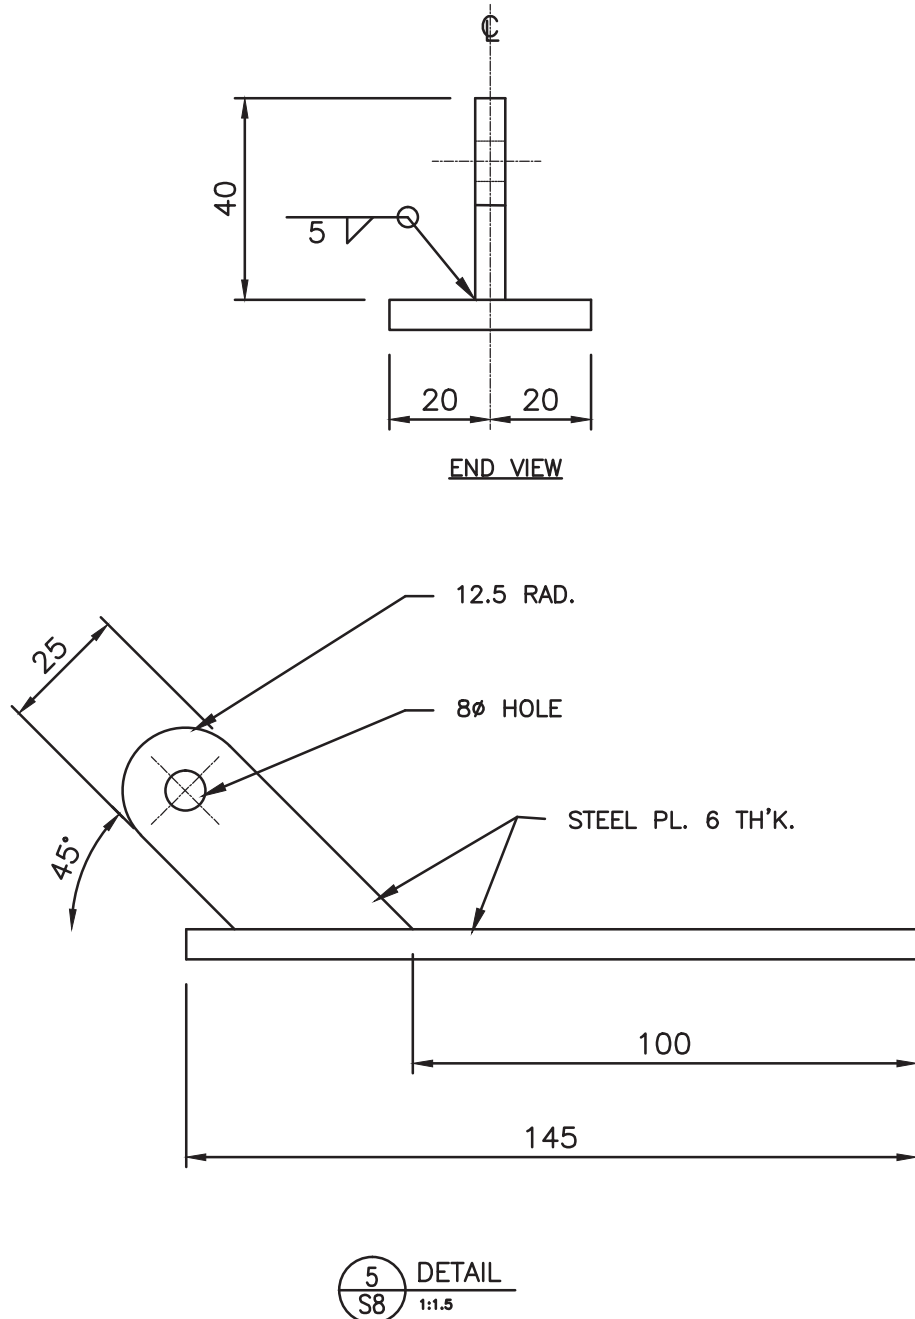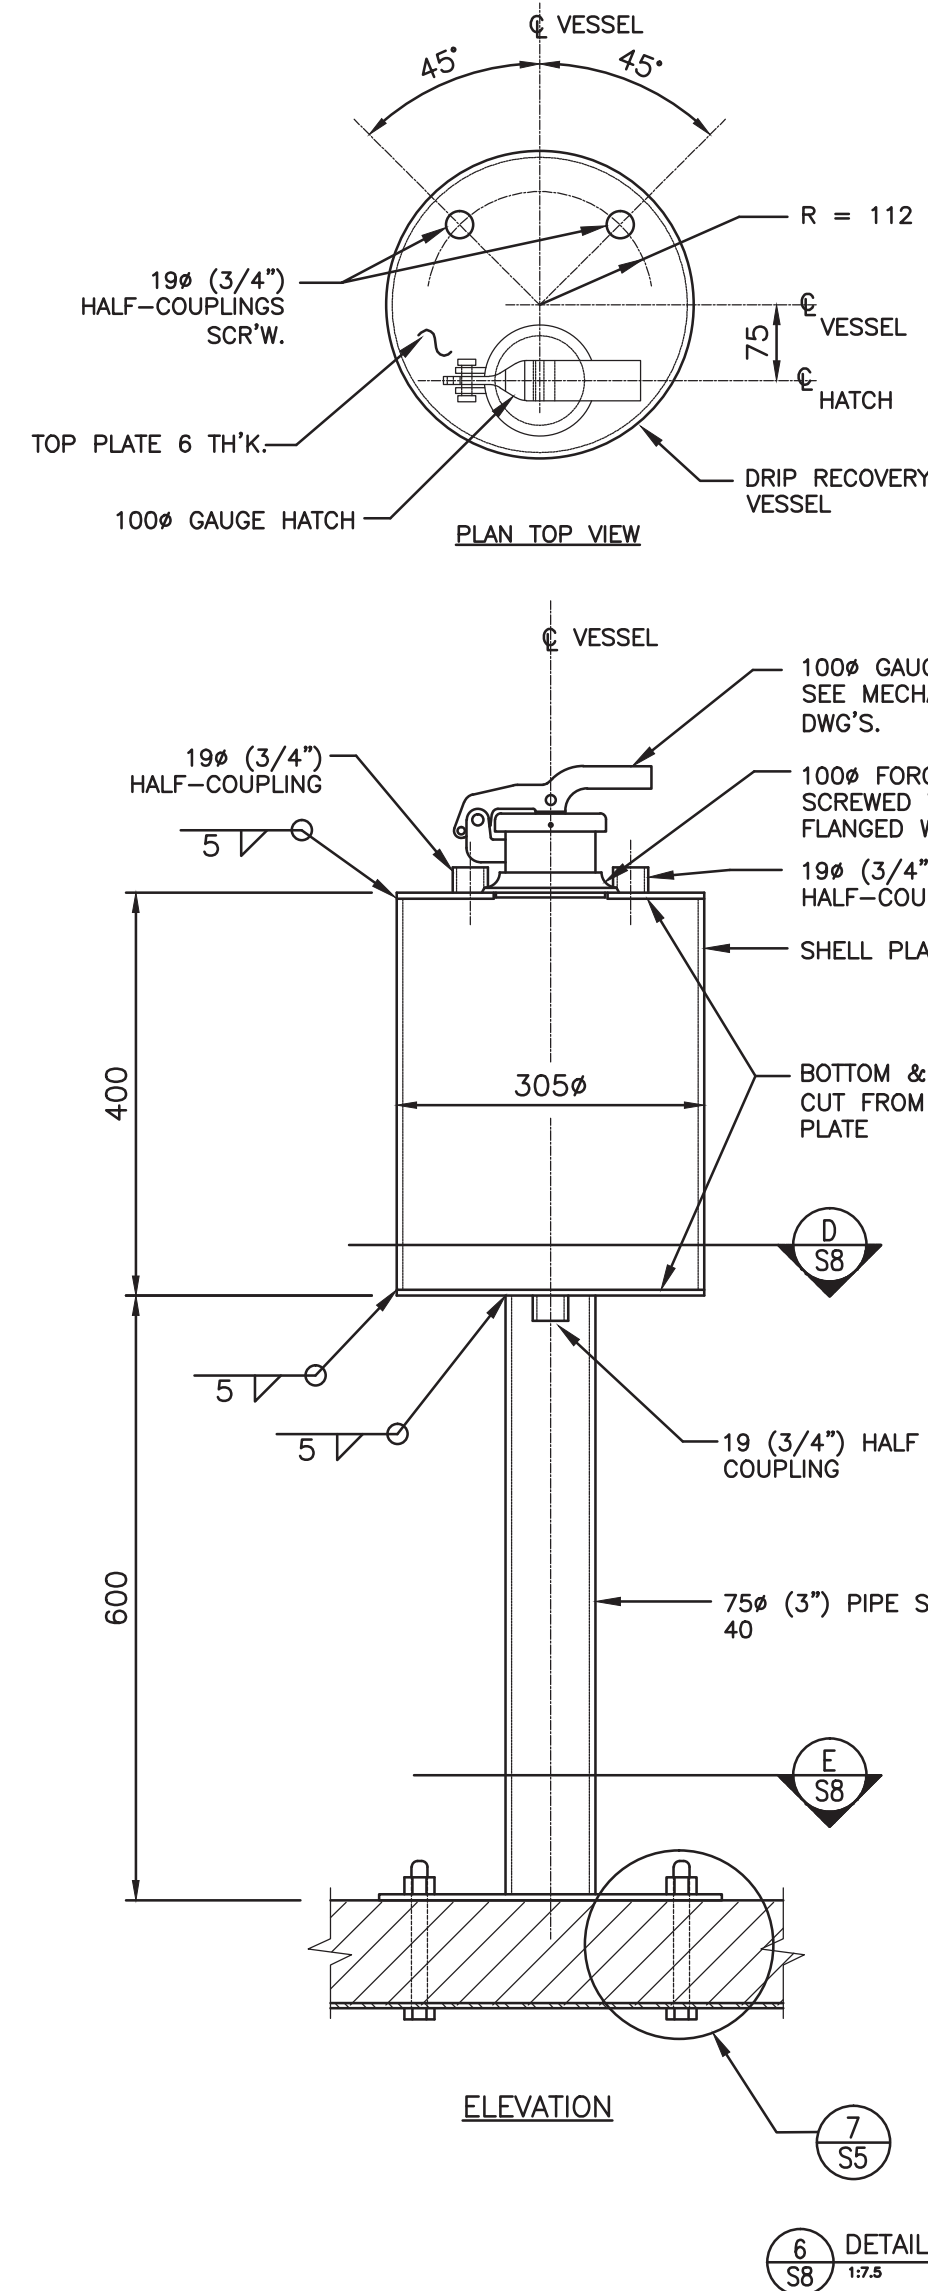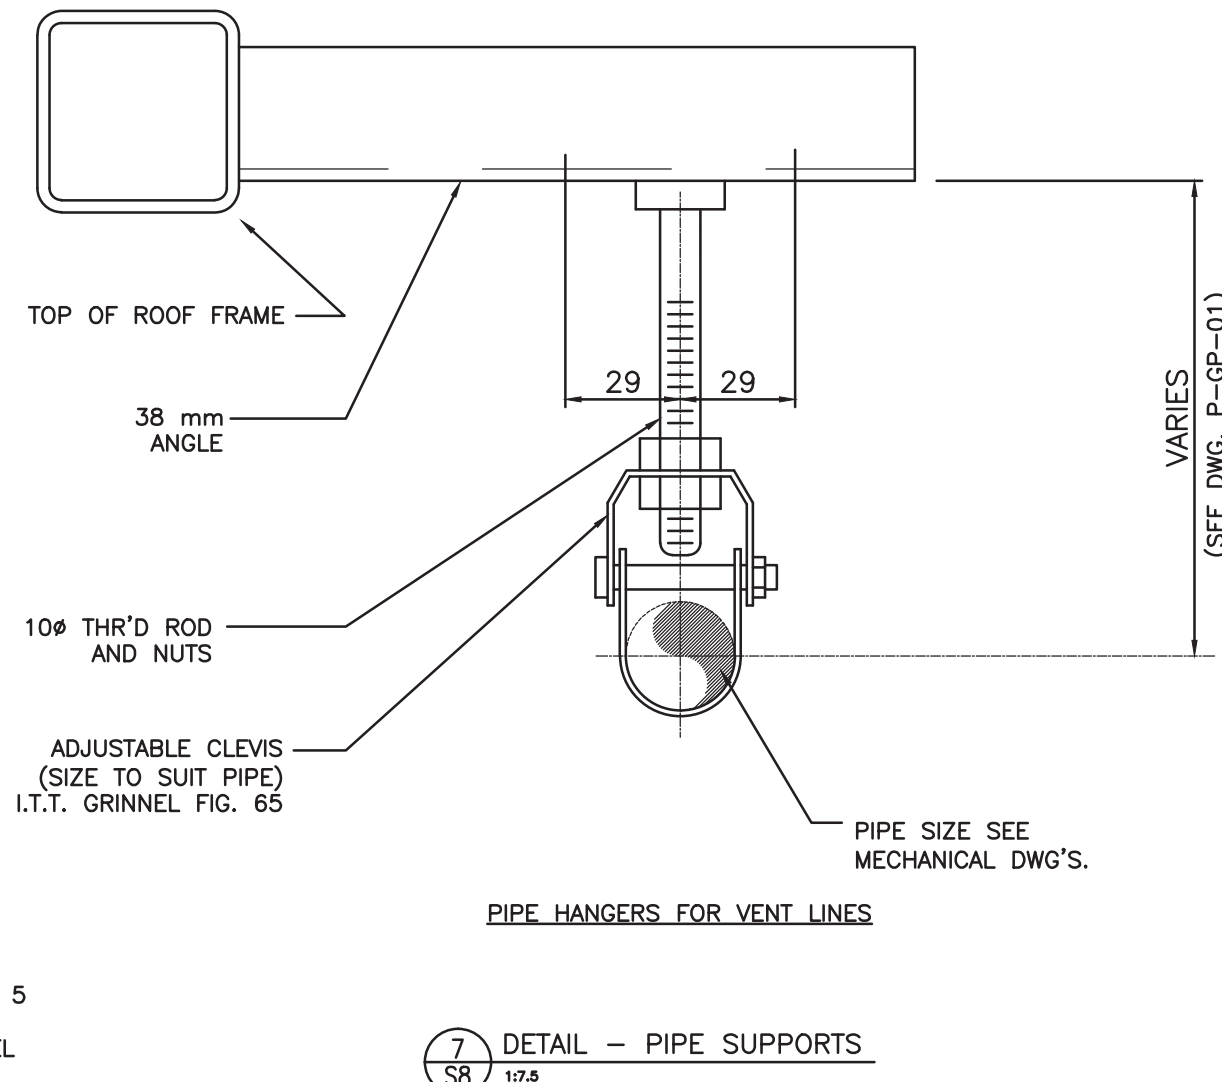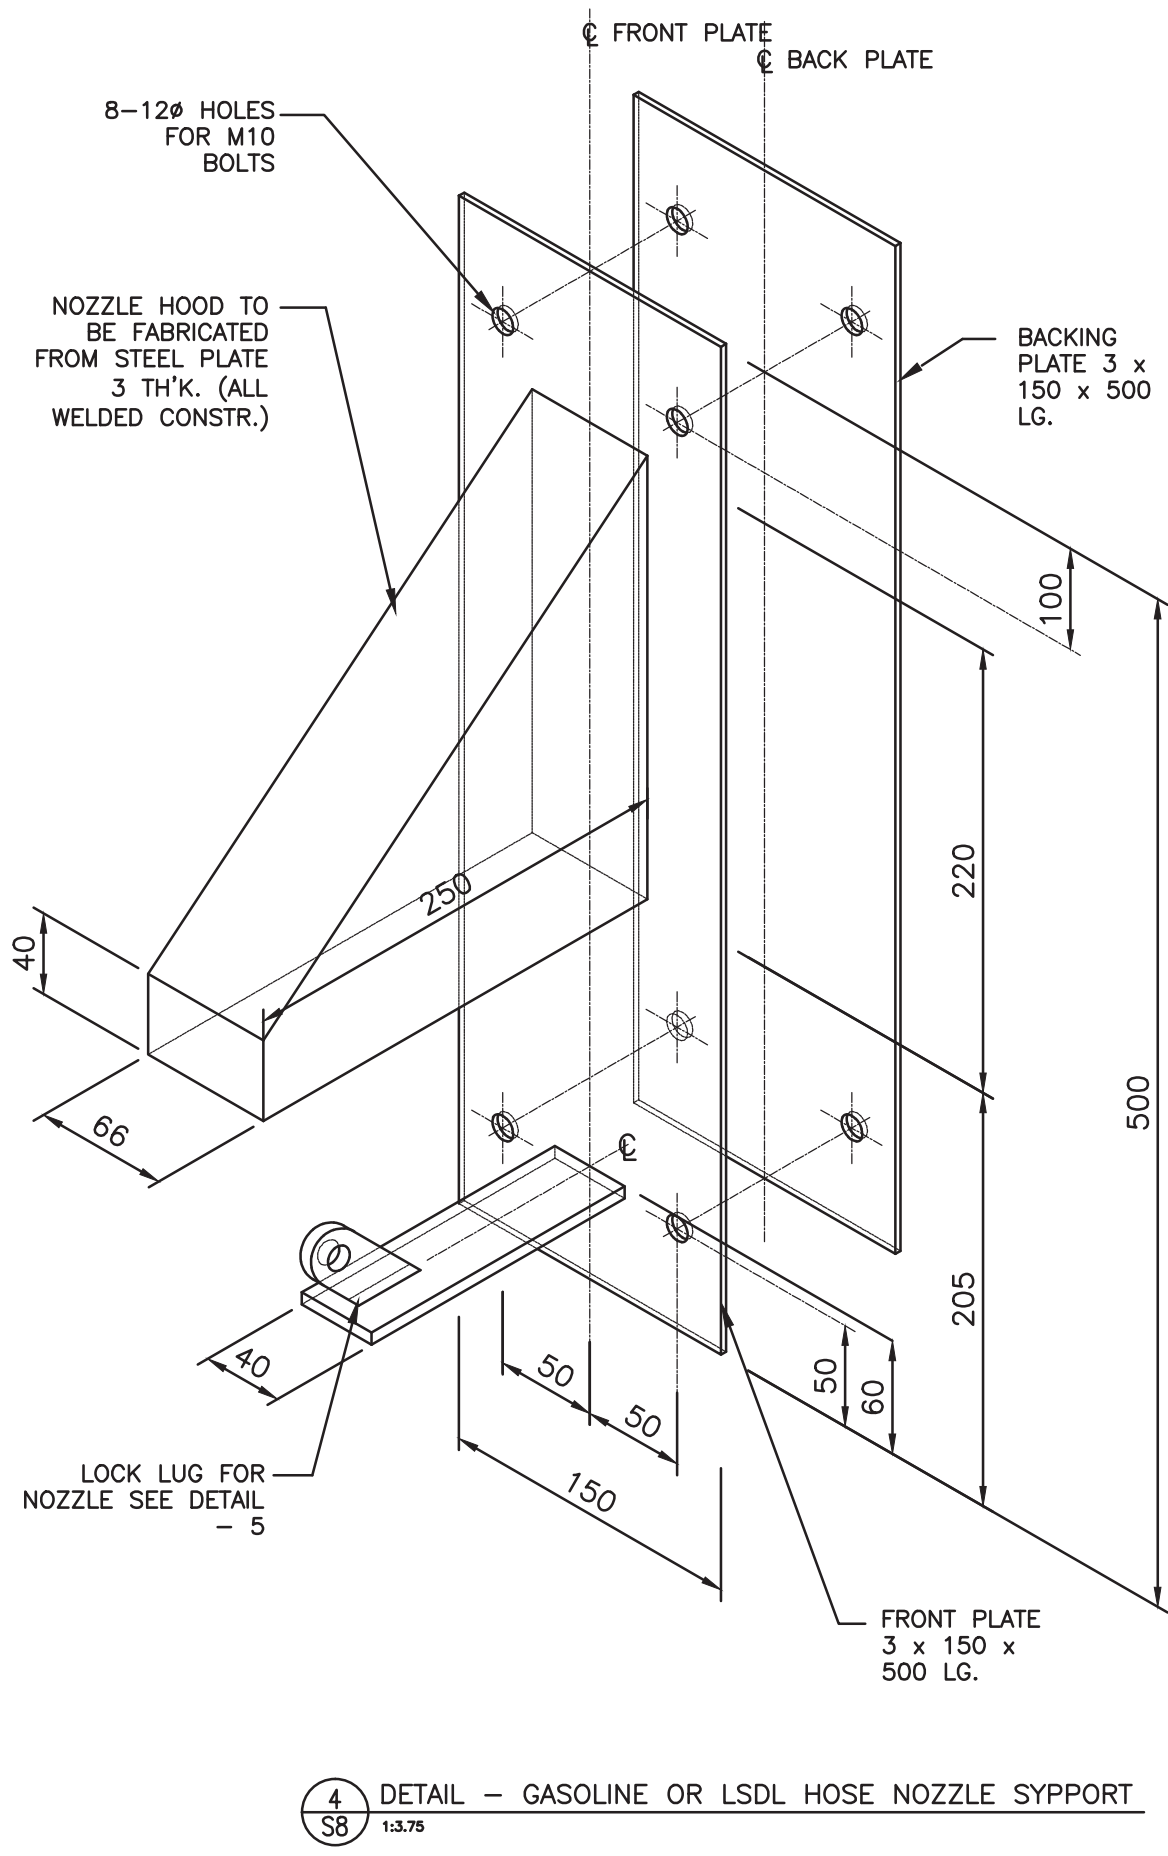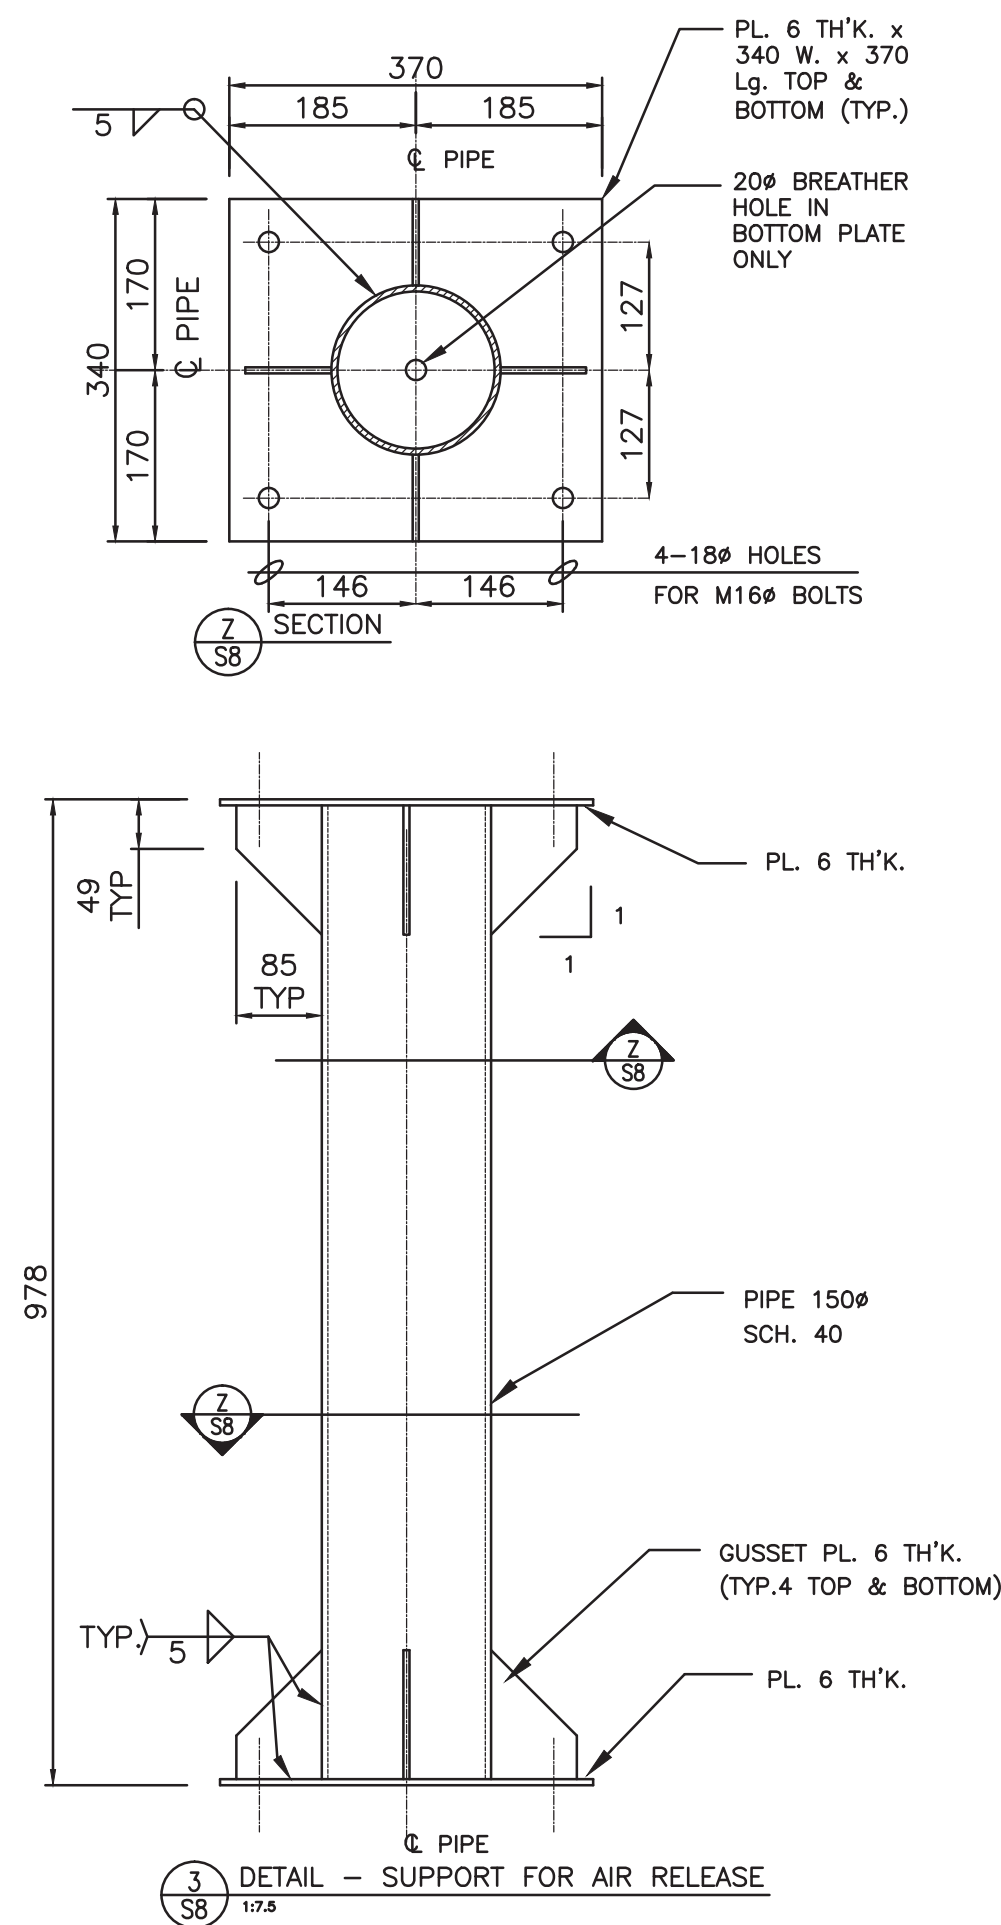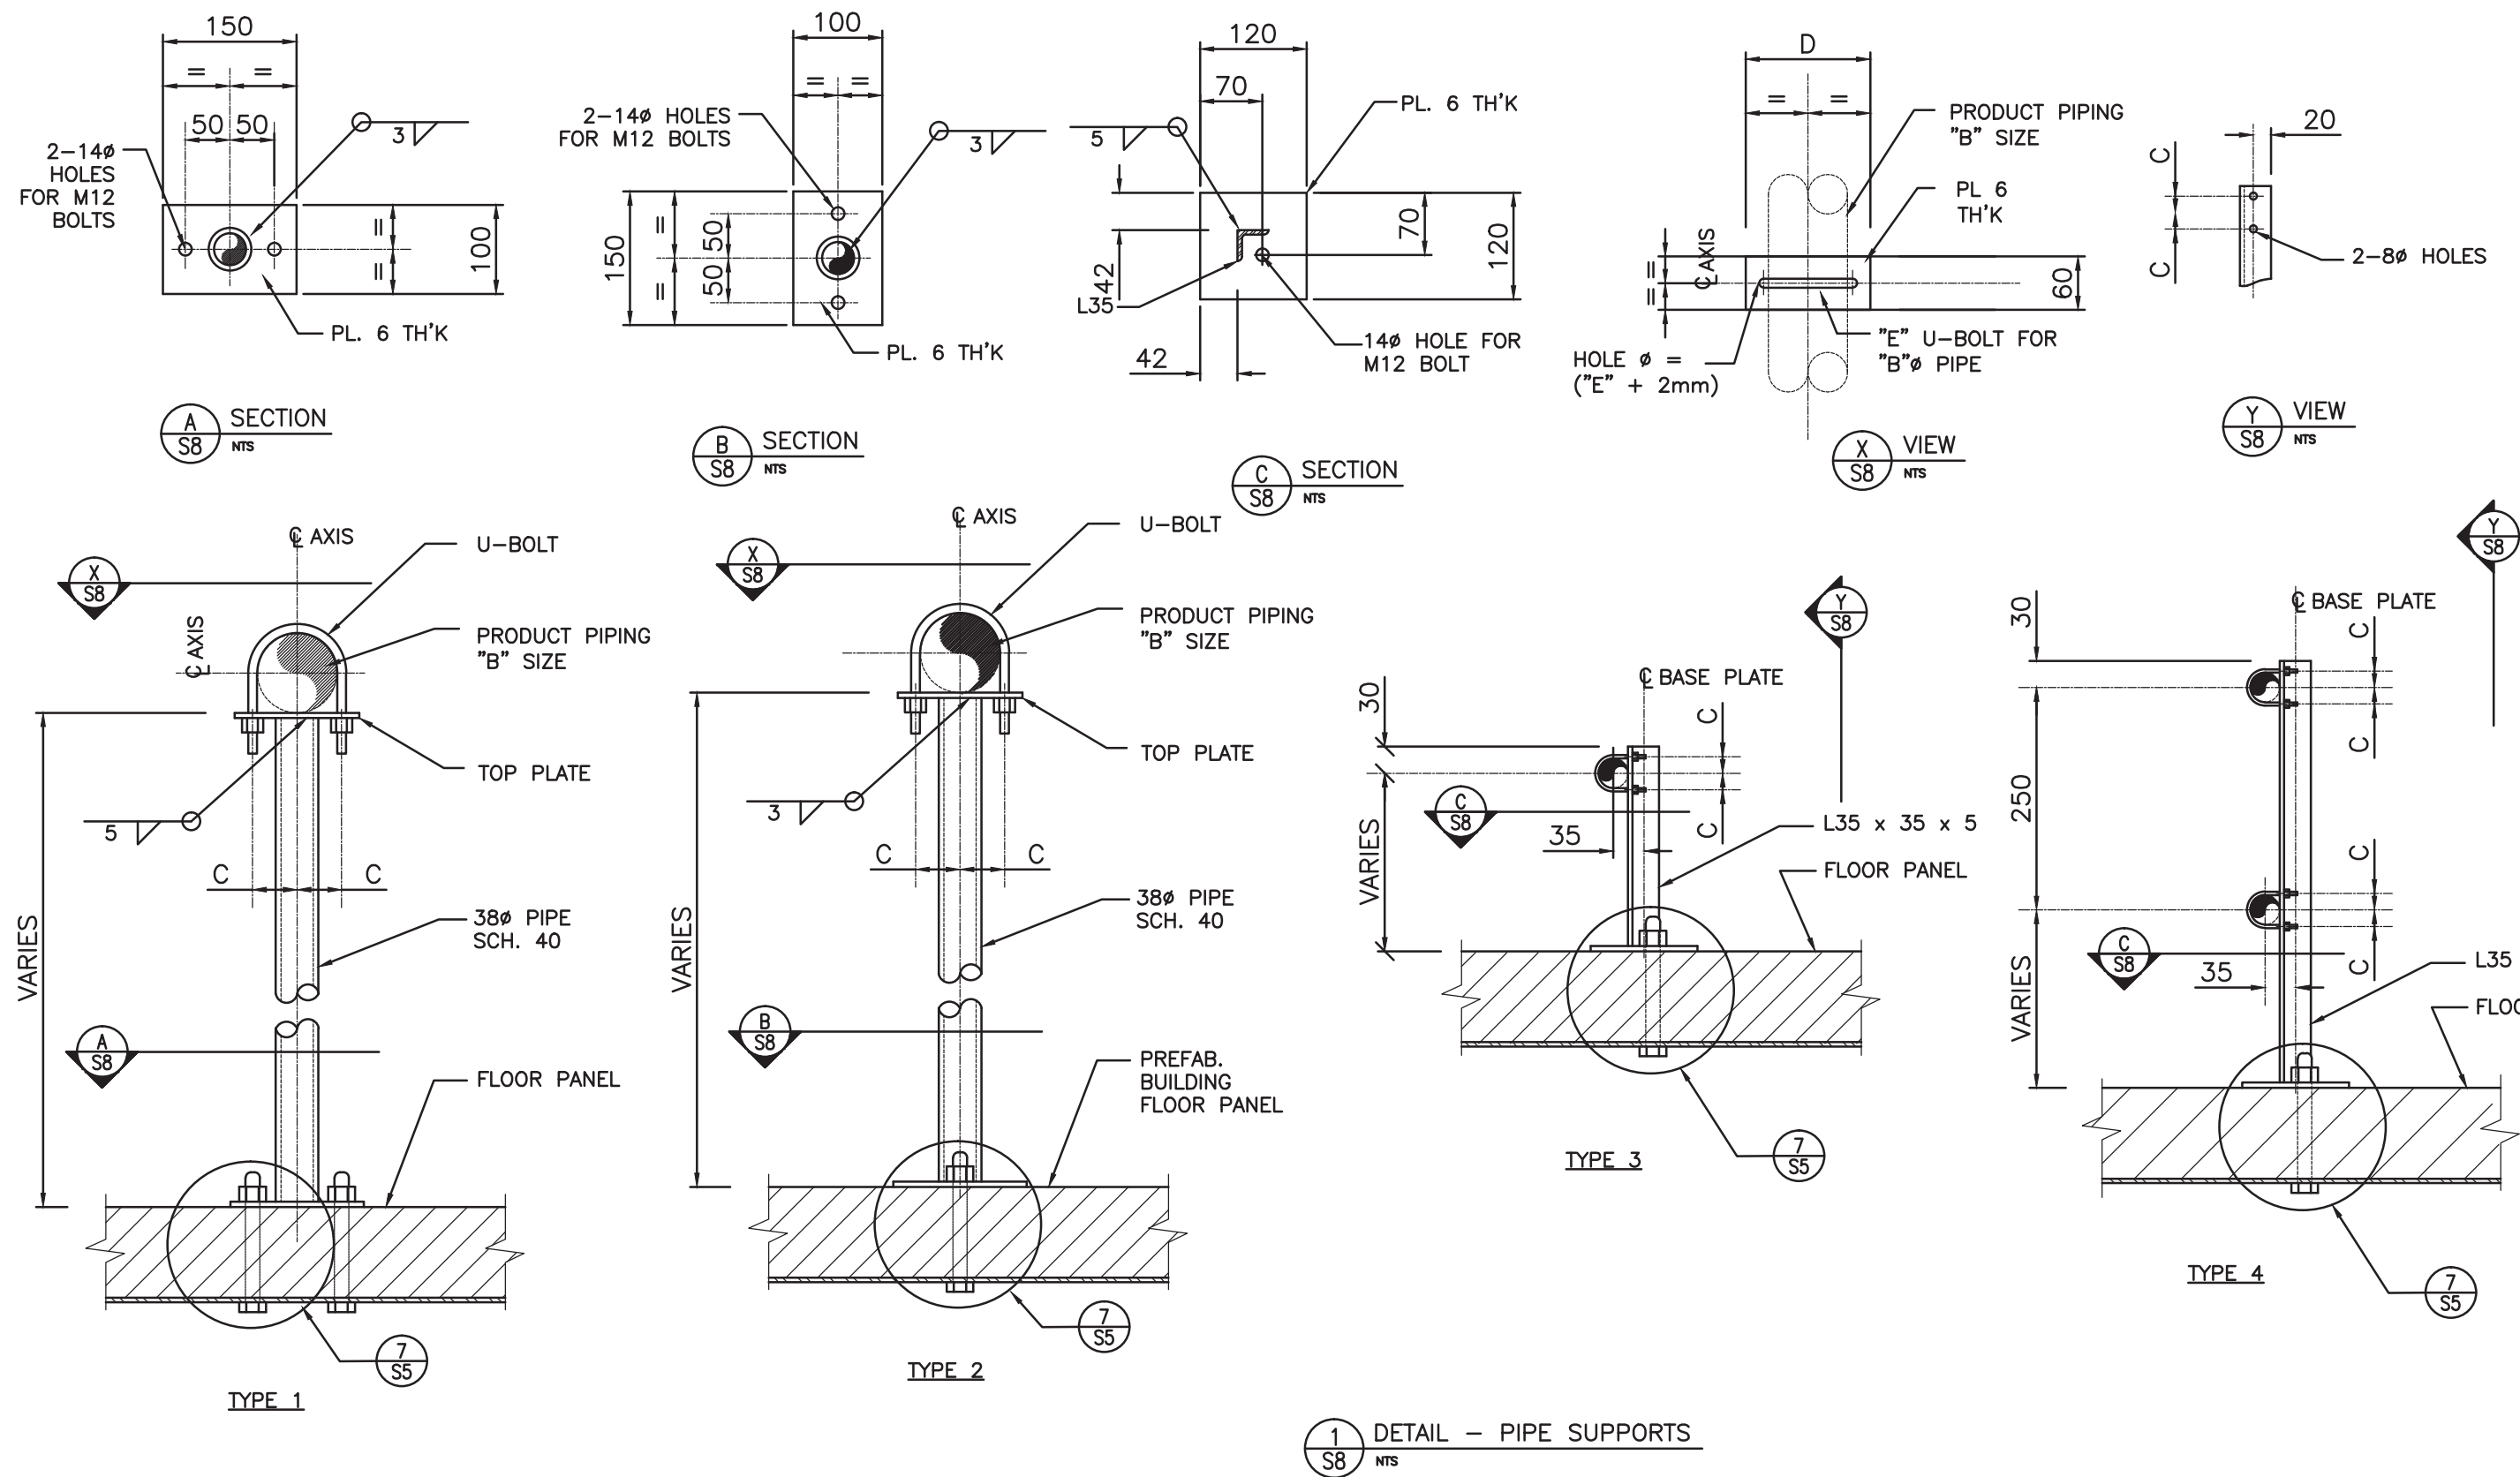

© Copyright Reserved 2011 by FSC Architects & Engineers
The information contained in this drawing is copyright and has been prepared for the sole purpose of the project described herein and for the sole benefit of the Owner. Any unauthorized use of this information will be considered a breach of copyright and may be pursued as such. Use of this information for any purpose other than the project described herein is at the sole risk of the user.


Record Drawing

These drawings have been prepared based on information provided by Inukshuk Construction with a construction completion date of 20.02.2014. Stantec has not verified the accuracy and/or completeness of this information and shall not be responsible for any errors or omissions which may be incorporated herein as a result.

STANDARD DRAWING S-GP-03

NO.	REVISION DESCRIPTION	DATE ISSUED
03	RECORD DRAWINGS	2013/11/01
02	ISSUED FOR TENDER	2011/06/08
01	ISSUED FOR 95% REVIEW	2011/03/25
00	ISSUED FOR 50% REVIEW	2011/02

PROFESSIONAL SEAL / PERMIT TO PRACTICE

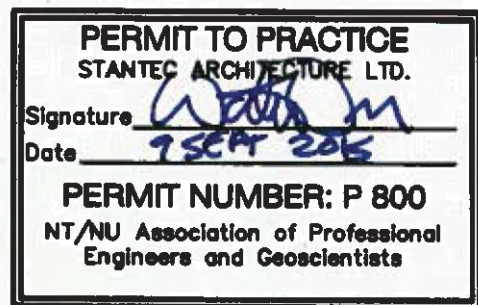

FSC
ARCHITECTS & ENGINEERS
Unit C, 1088 Mivik Street, Box 1779
Iqaluit, NU, X0A 0H0, Canada
T 867.979.0555 | F 867.979.5711

FUEL STORAGE FACILITY UPGRADES
LOCATION: CHESTERFIELD INLET, NU


LSDL/GASOLINE DISPENSER BUILDING SUPPORT AND SAMPLE BARREL DETAILS

DRAWN BY: AF
CHECKED BY: WO
CLIENT PROJECT NO.: 10-3018
FSC PROJECT NO.: 2010-1160
DRAWING NO.: S8


D

100mm
90
80
70
60
50
40
30
20
10
0

A

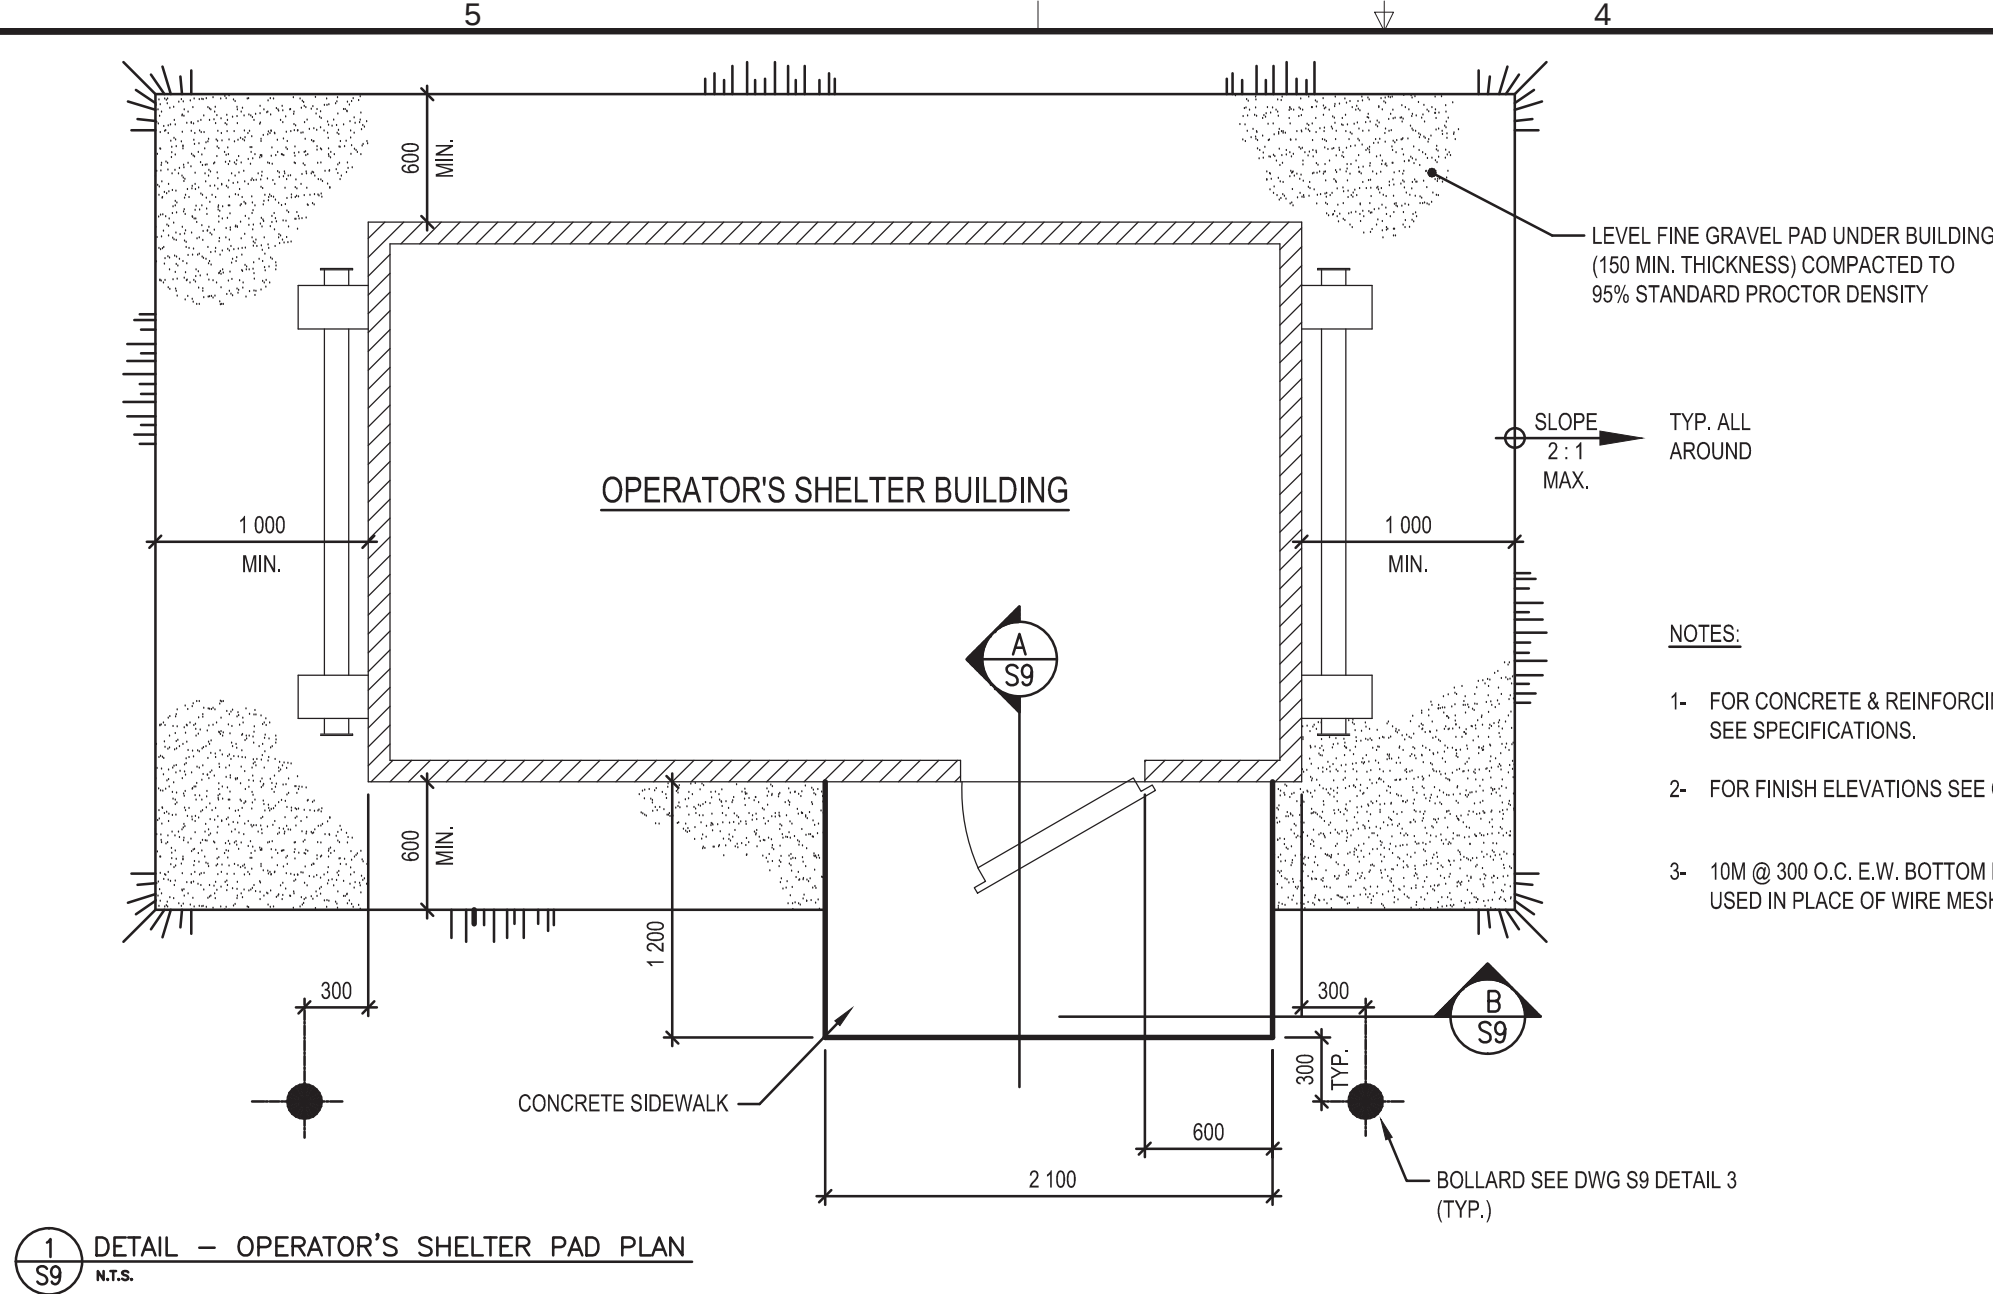


1 S9
N.T.S.
DETAIL - OPERATOR'S SHELTER PAD PLAN


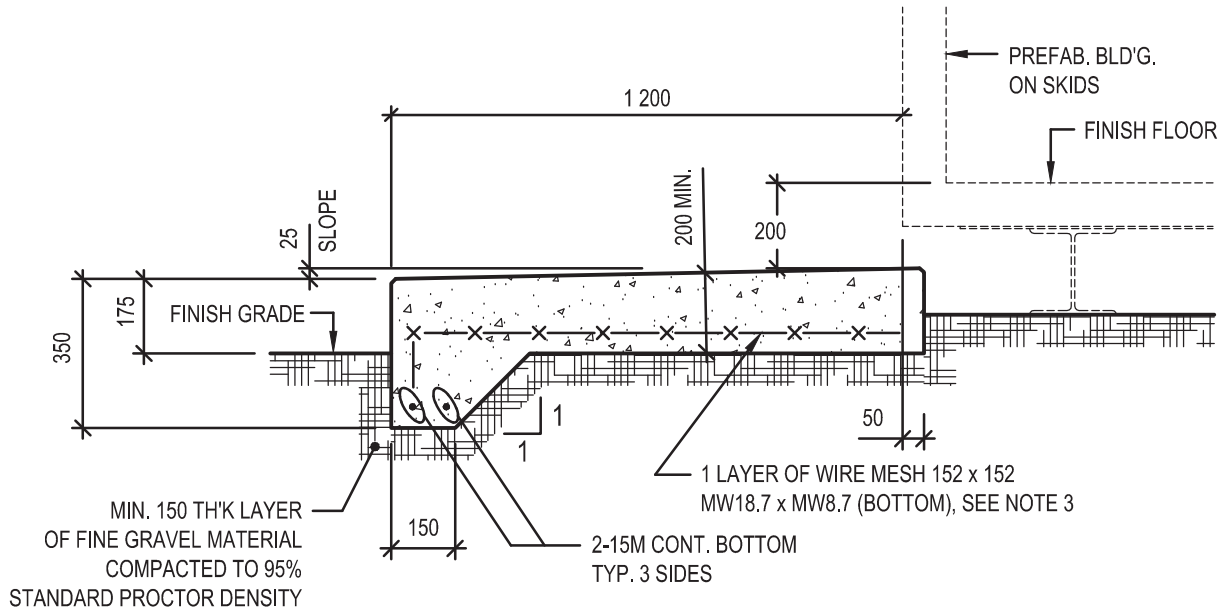


A S9
SECTION


- NOTES:
- 1- FOR CONCRETE & REINFORCING MATERIAL SEE SPECIFICATIONS.
 - 2- FOR FINISH ELEVATIONS SEE C3
 - 3- 10M @ 300 O.C. E.W. BOTTOM MAY BE USED IN PLACE OF WIRE MESH.

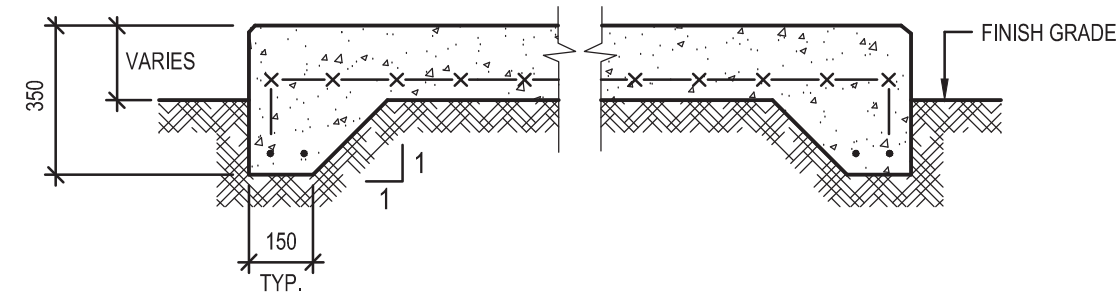


B S9
SECTION

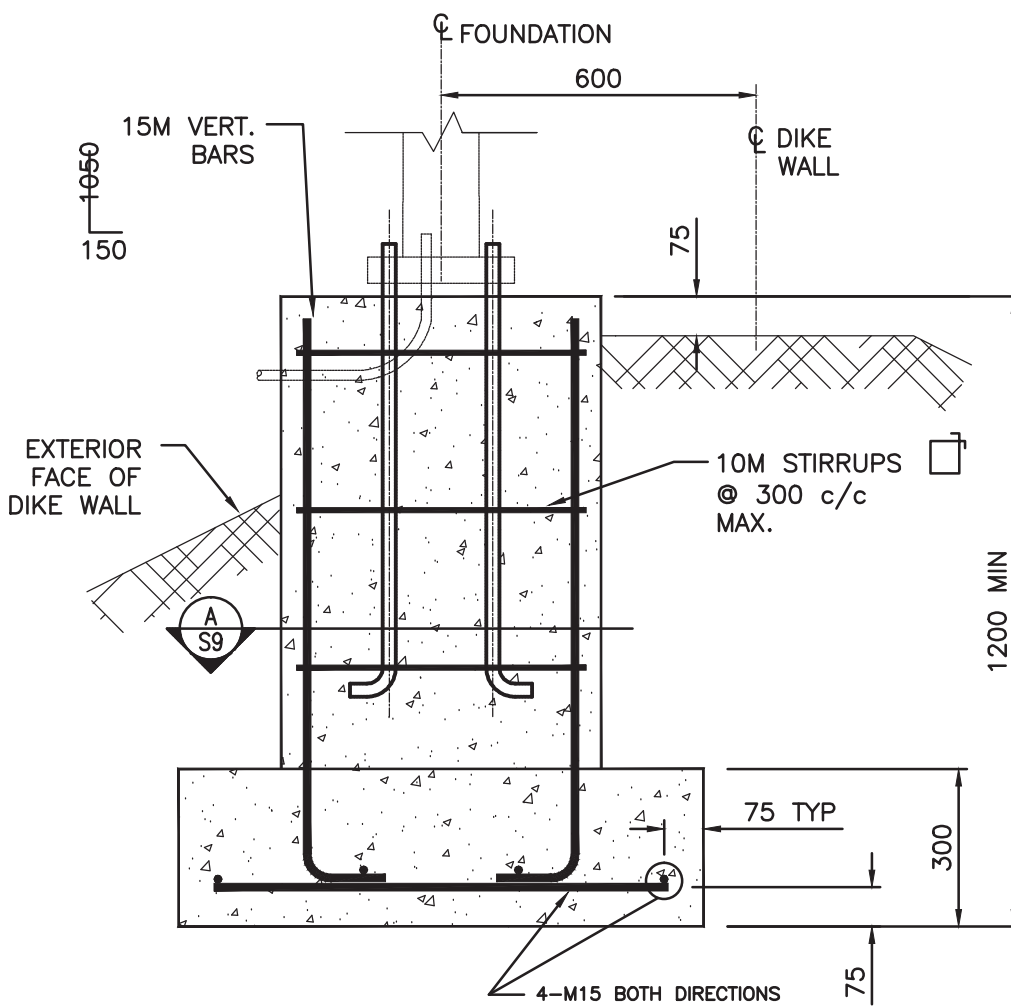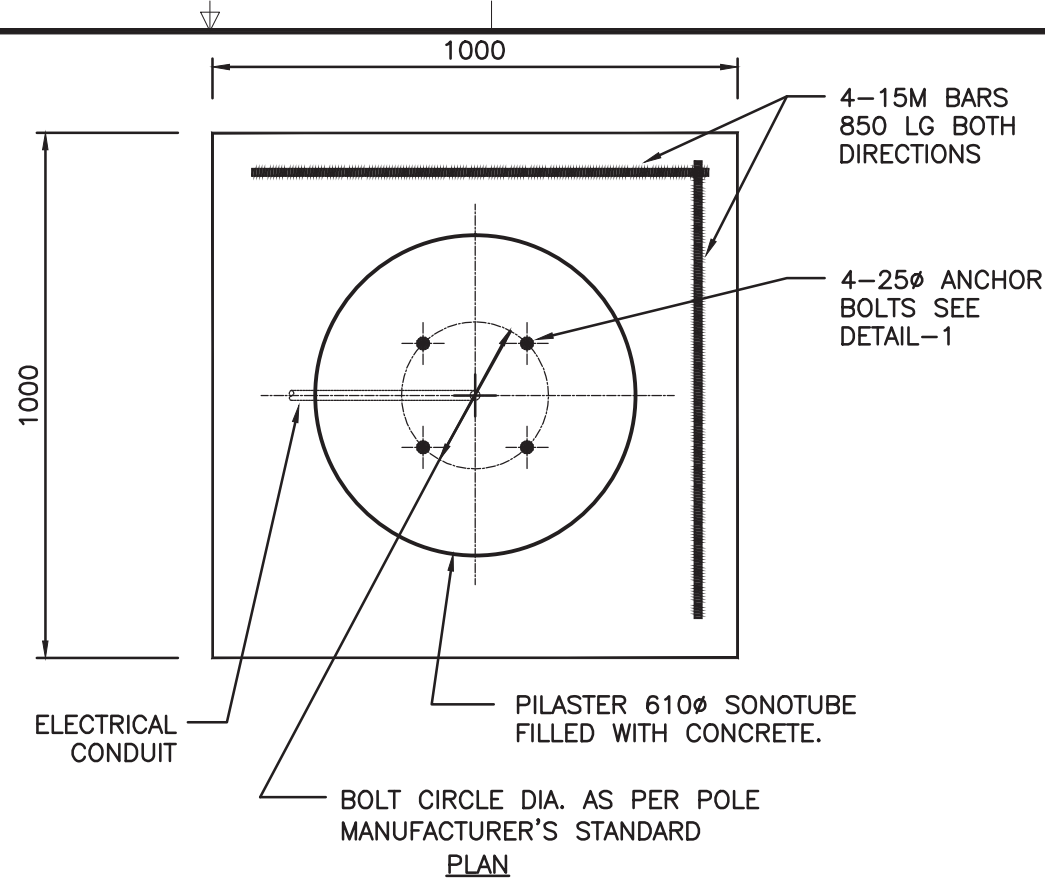

2 S9
N.T.S.
DETAIL - DIKE AREA LIGHT POLE FOUNDATION, PLAN, ELEVATION, SECTION & DETAIL

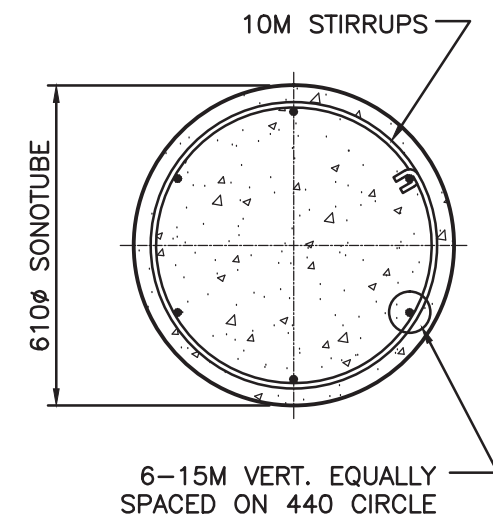


SECTION A-A

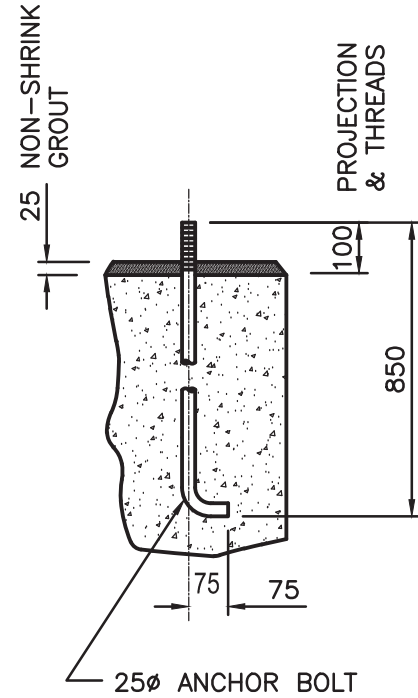

DETAIL - 1

- NOTES:
- 1- FOR CONCRETE & REINFORCING MATERIALS SEE SPECIFICATIONS.
 - 2- ANCHOR BOLTS TO ASTM A307 SPEC.

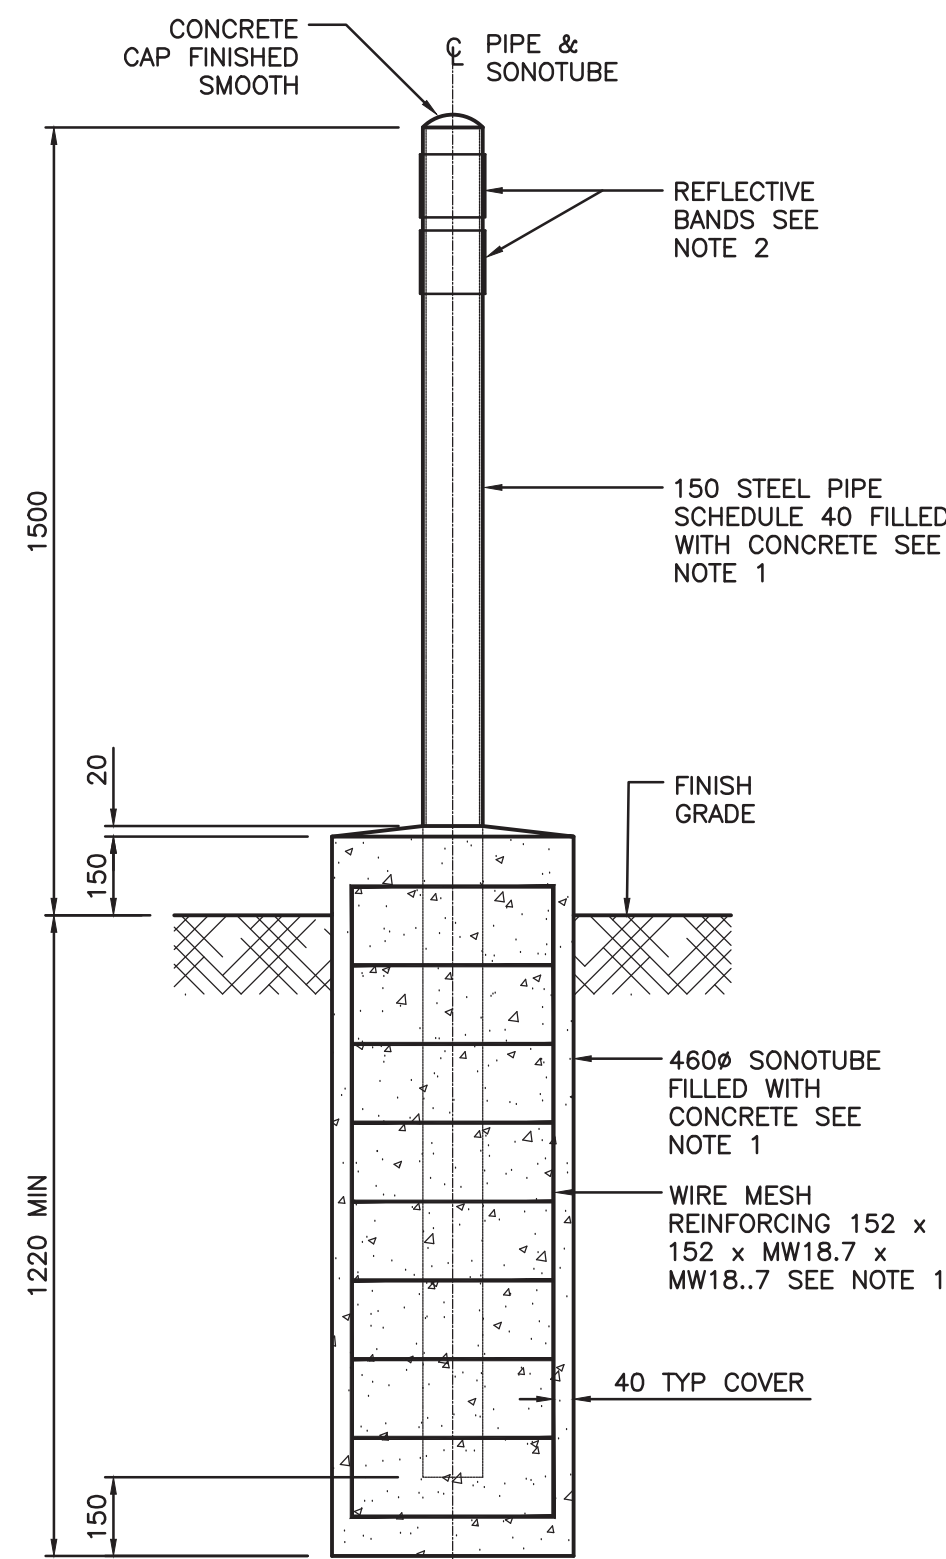

- NOTES:
- 1- FOR CONCRETE AND WIRE MESH MATERIALS SEE SPECIFICATIONS.
 - 2- BOLLARD TO BE PAINTED YELLOW WITH REFLECTIVE BANDS, SEE SPECIFICATIONS
 - 3- FOR MOUNTING IN ROCK, SEE DRAWING S12.

3 S9
N.T.S.
DETAIL - BOLLARD DETAIL



© Copyright Reserved 2011 by FSC Architects & Engineers
The information contained in this drawing is copyright and has been prepared for the sole purpose of the project described herein and for the sole benefit of the Owner. Any unauthorized use of this information will be considered a breach of copyright and may be pursued as such. Use of this information for any purpose other than the project described herein is at the sole risk of the user.

Record Drawing

These drawings have been prepared based on information provided by Inukshuk Construction with a construction completion date of 20.02.2014. Stantec has not verified the accuracy and/or completeness of this information and shall not be responsible for any errors or omissions which may be incorporated herein as a result.

DETAIL 1: STD DWG NT-S21


DETAIL 2: STD DWG NT-S20

DETAIL 3: STD DWG NT-S09

DETAIL 4: STD DWG NT-S33

NO.	REVISION DESCRIPTION	DATE ISSUED
03	RECORD DRAWINGS	2013/11/01
02	ISSUED FOR TENDER	2011/06/08
01	ISSUED FOR 95% REVIEW	2011/03/25
00	ISSUED FOR 50% REVIEW	2011/02

PROFESSIONAL SEAL / PERMIT TO PRACTICE

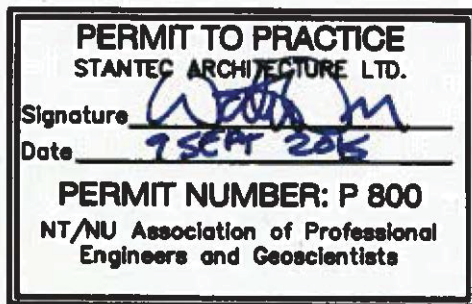

PROJECT TITLE

FUEL STORAGE FACILITY UPGRADES

LOCATION
CHESTERFIELD INLET, NU

STRUCTURAL ASSORTED DETAILS SHEET 1

DRAWN BY
AF

SCALE
AS NOTED

CHECKED BY
WO

CLIENT PROJECT NO.
10-3018

FSC PROJECT NO.
2010-1160



DRAWING NO.
S9

OF 45

D

100mm
90
80
70
60
50
40
30
20
10
0

A

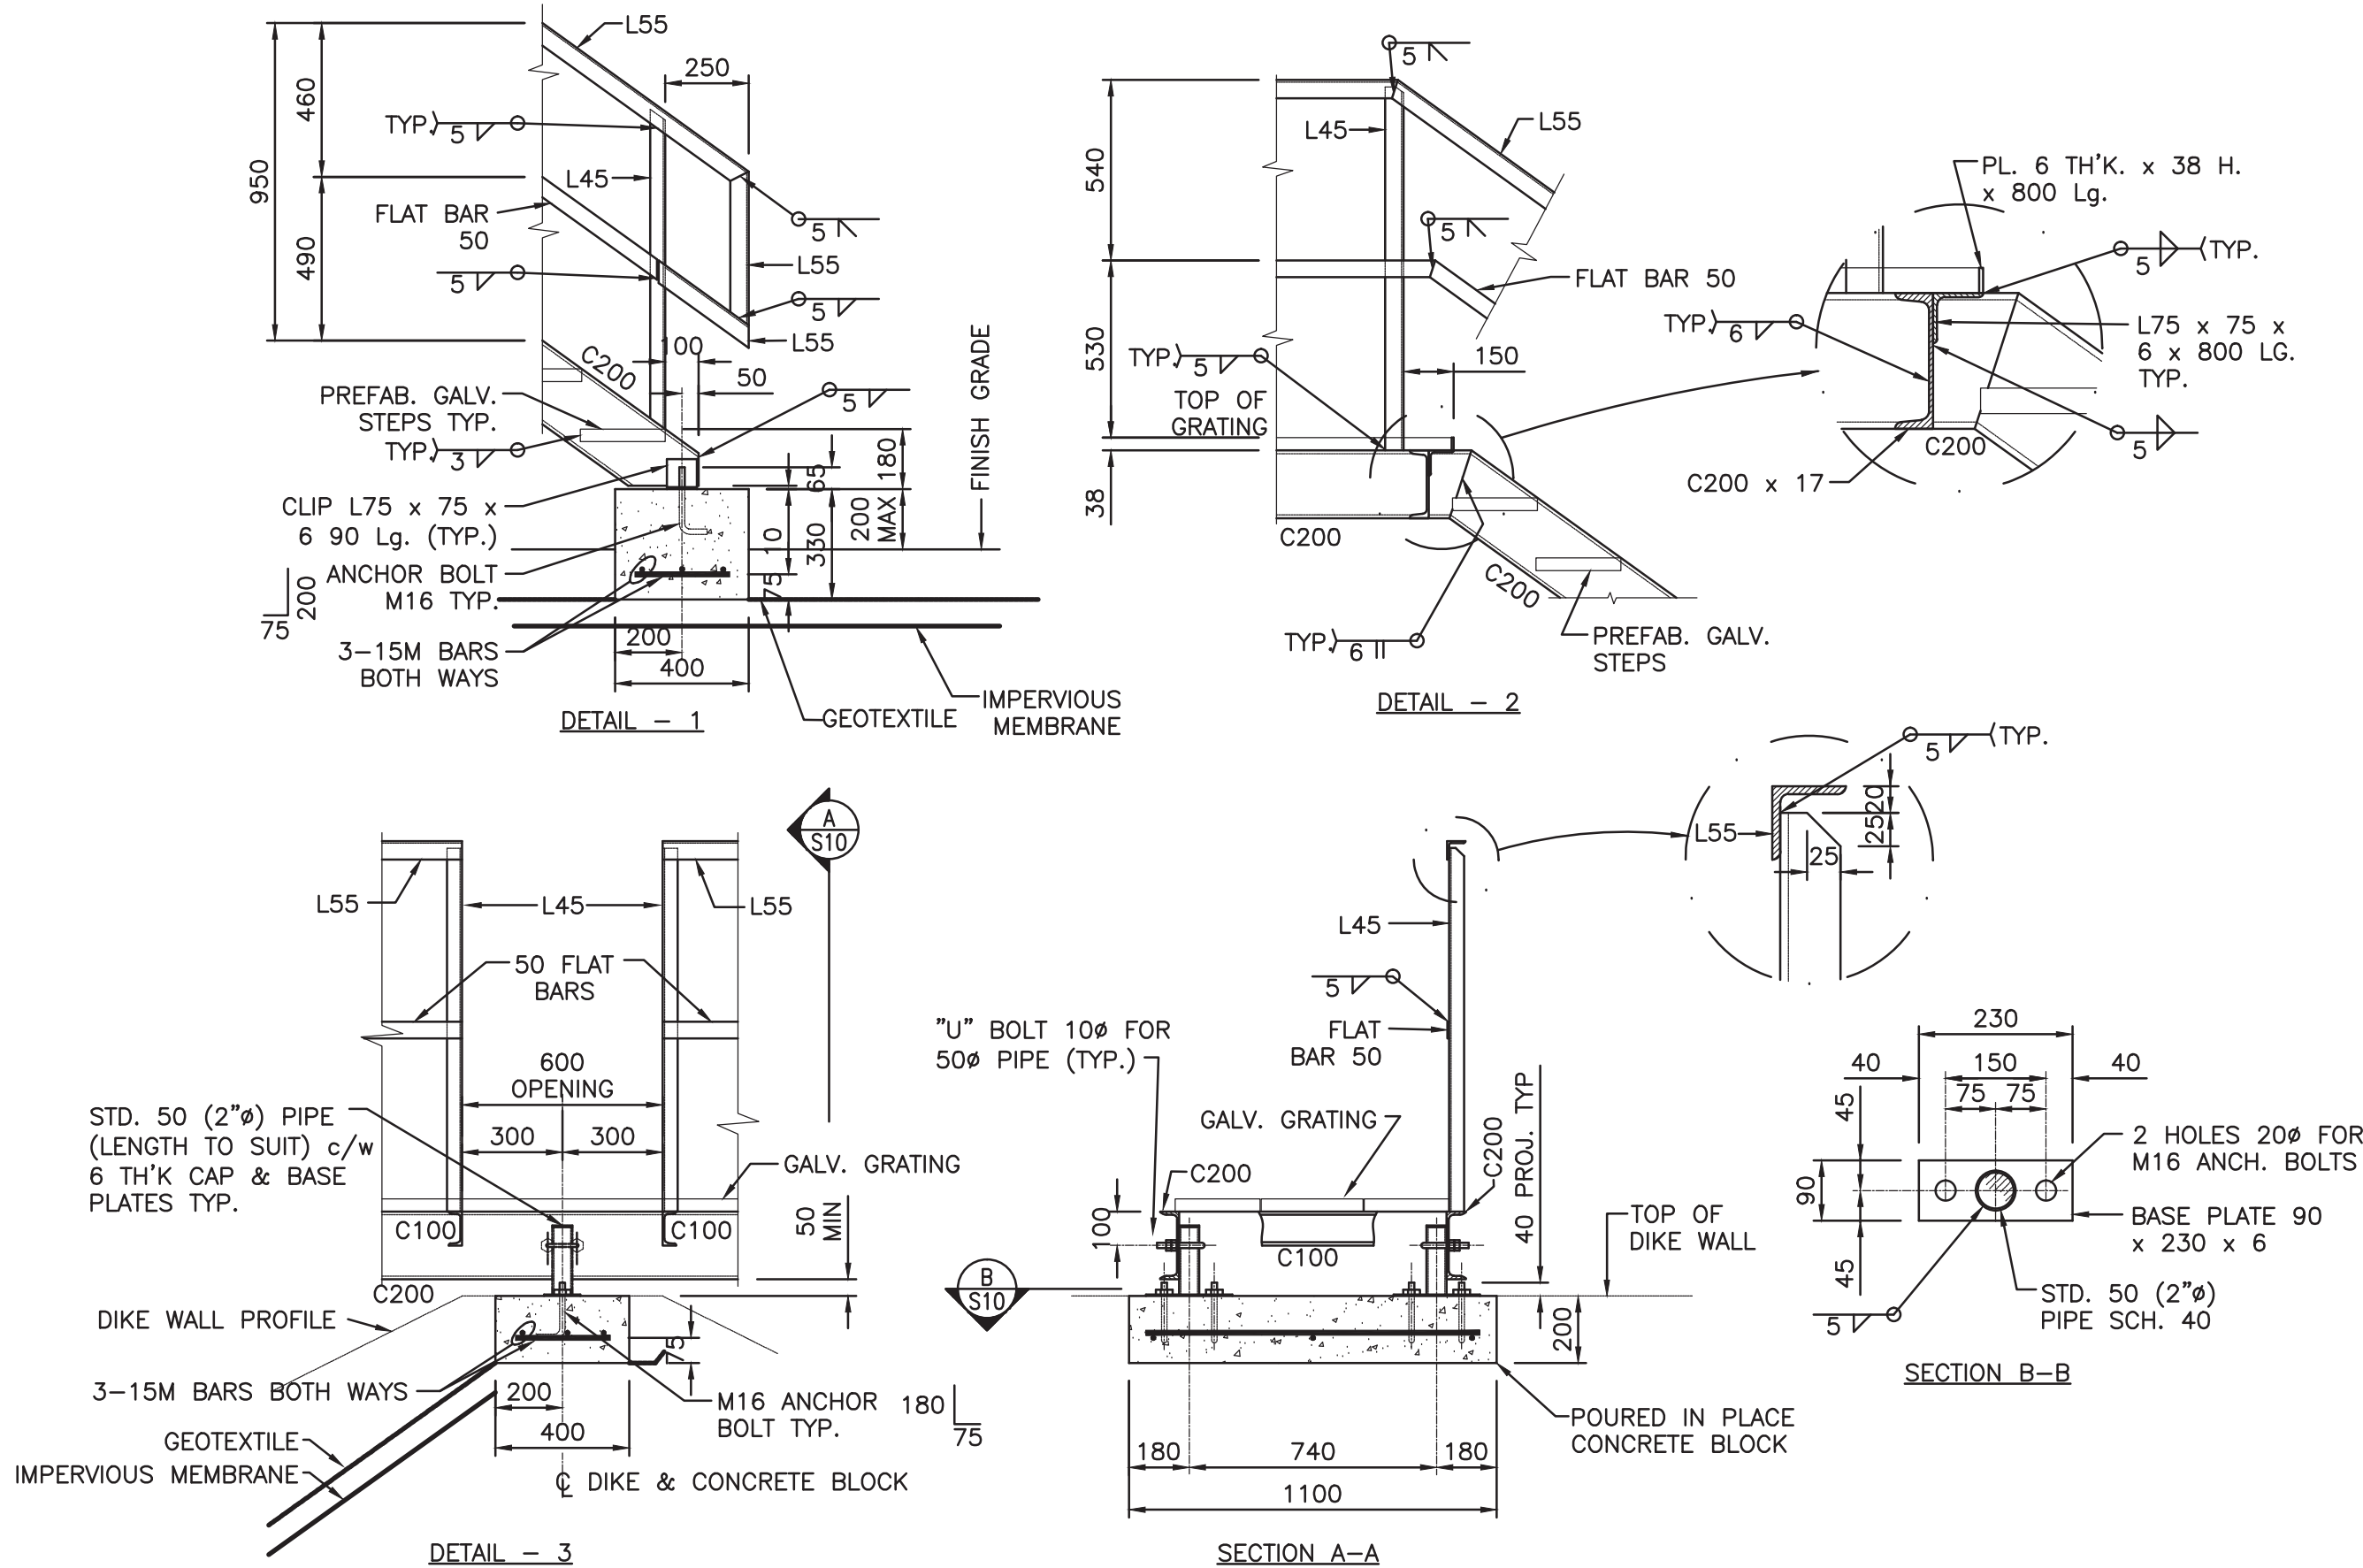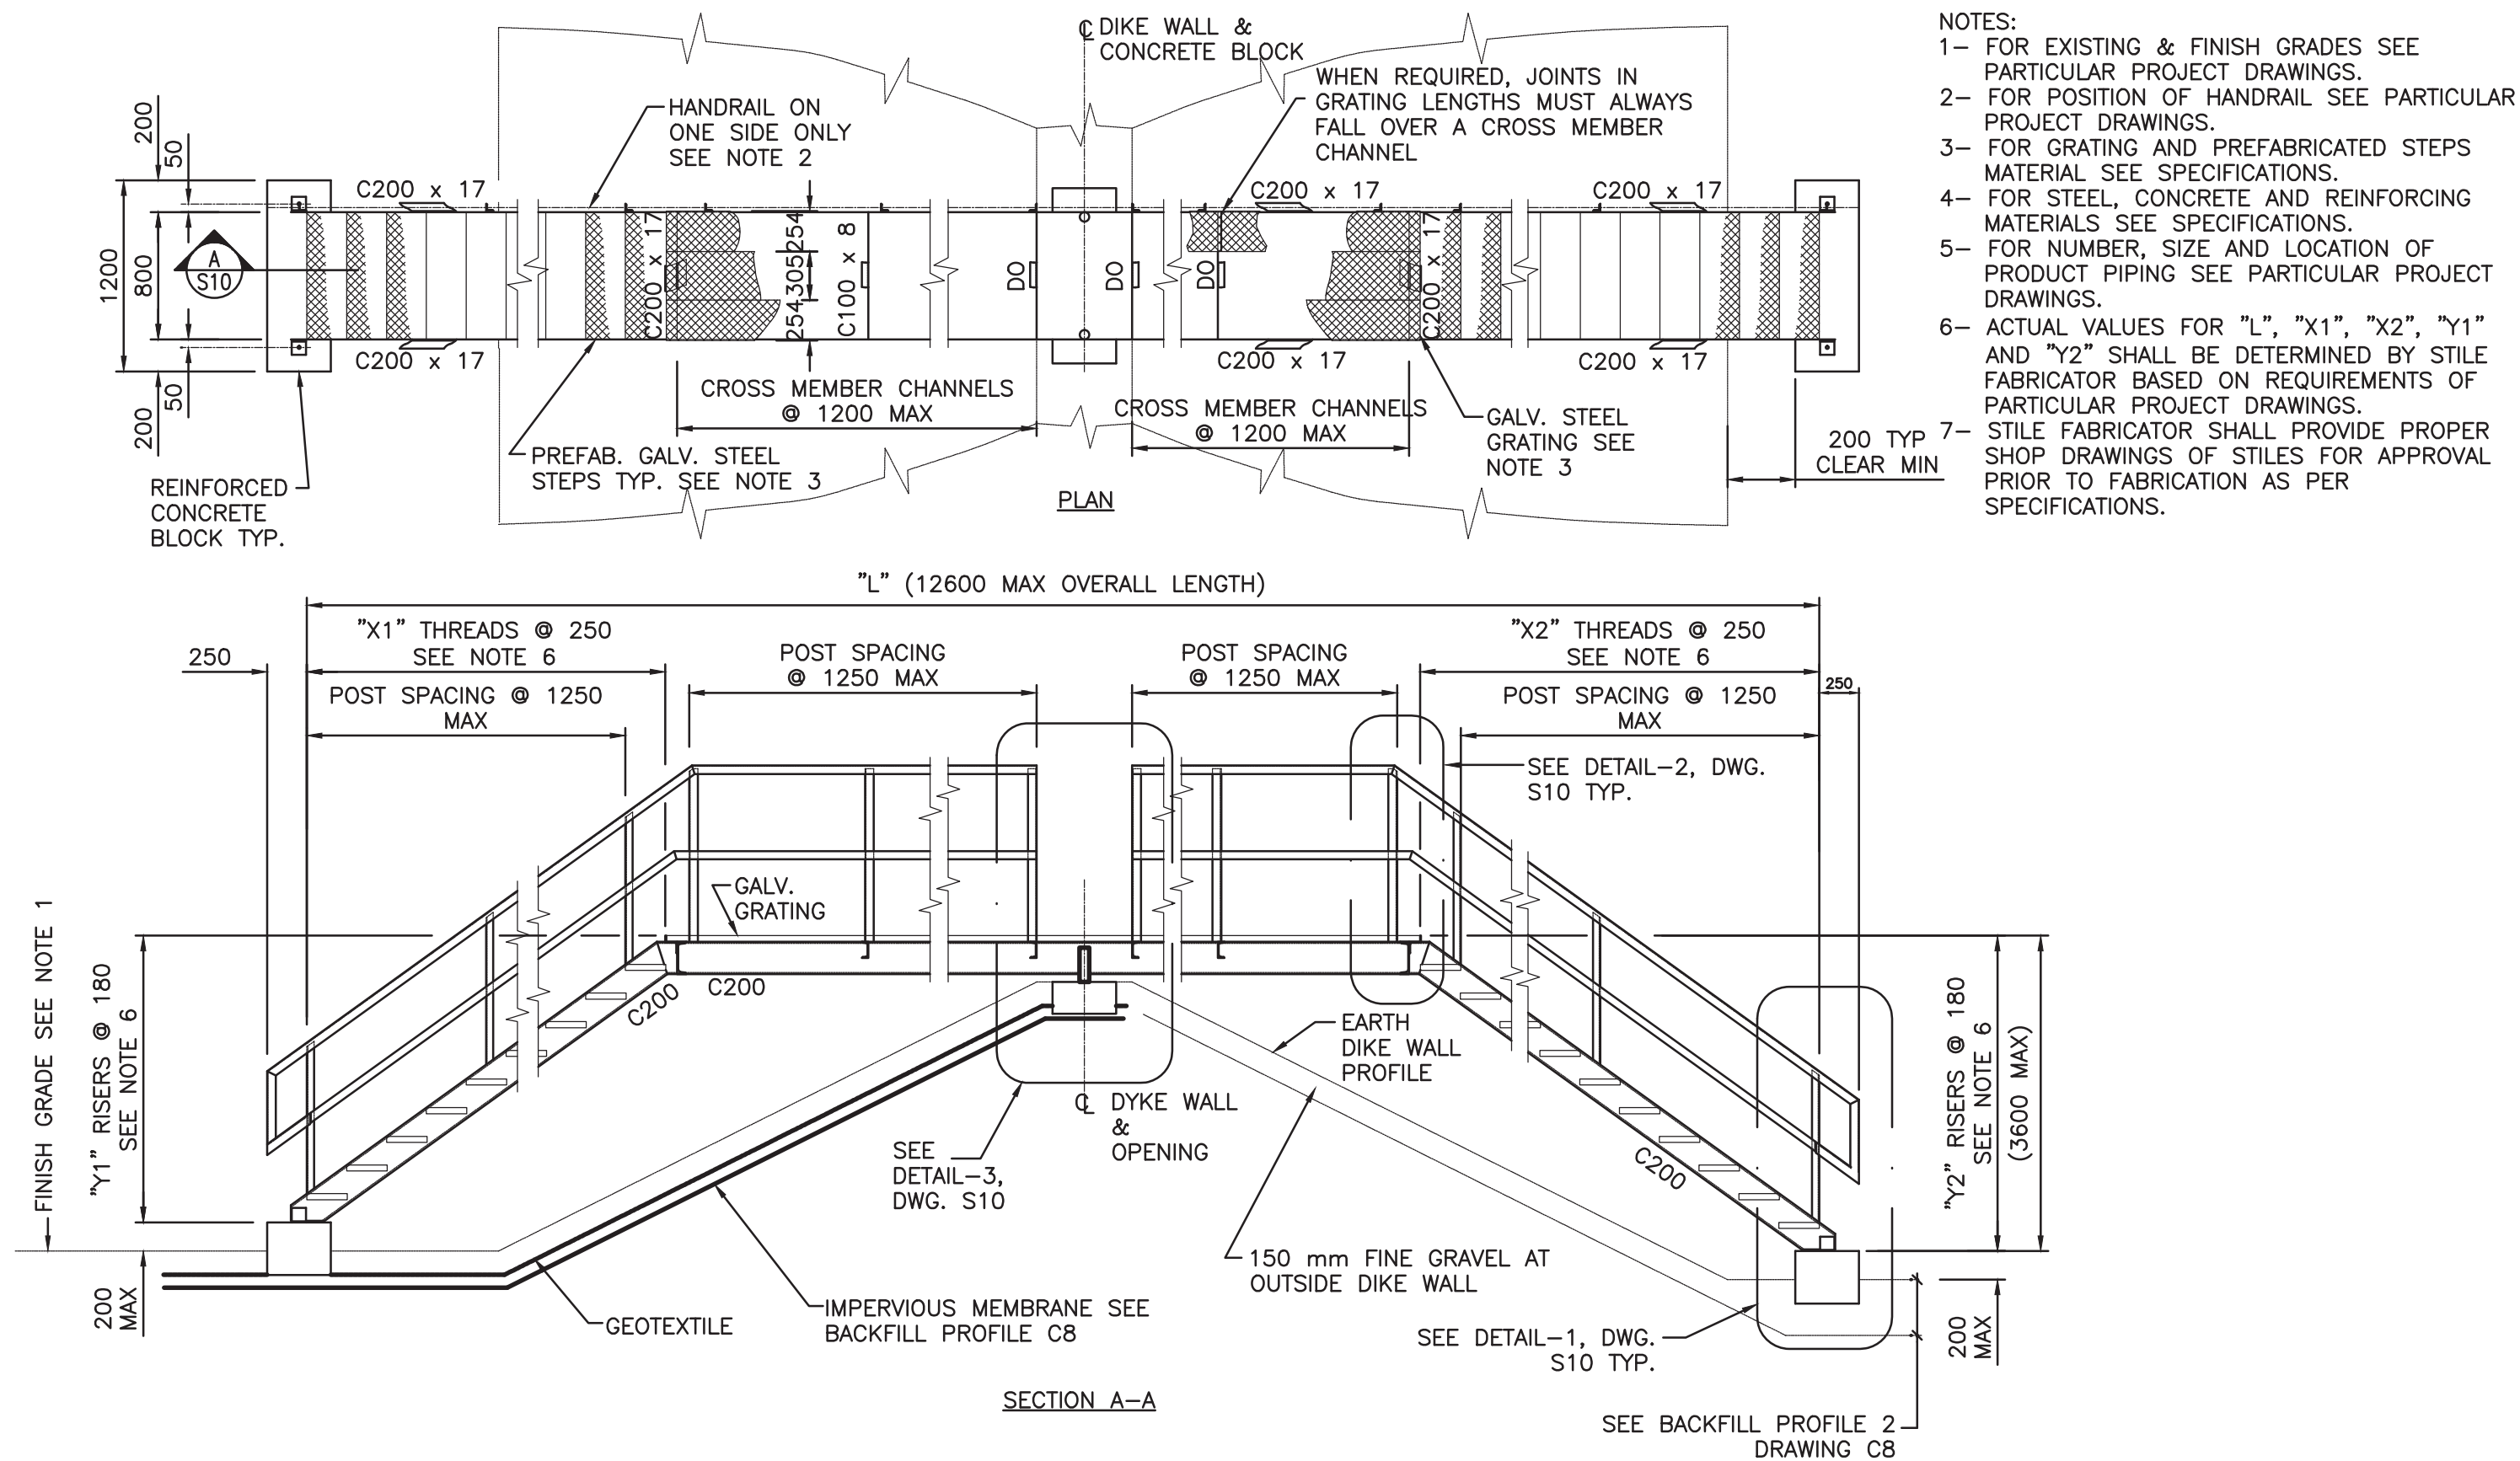

© Copyright Reserved 2011 by FSC Architects & Engineers
The information contained in this drawing is copyright and has been prepared for the sole purpose of the project described herein and for the sole benefit of the Owner. Any unauthorized use of this information will be considered a breach of copyright and may be pursued as such. Use of this information for any purpose other than the project described herein is at the sole risk of the user.


Record Drawing

These drawings have been prepared based on information provided by Inukshuk Construction with a construction completion date of 20.02.2014. Stantec has not verified the accuracy and/or completeness of this information and shall not be responsible for any errors or omissions which may be incorporated herein as a result.

DRAWING 1: STD DWG NT-S32
DRAWING 2: STD DWG NT-S34

NO.	REVISION DESCRIPTION	DATE ISSUED
03	RECORD DRAWINGS	2013/11/01
02	ISSUED FOR TENDER	2011/06/08
01	ISSUED FOR 95% REVIEW	2011/03/25
00	ISSUED FOR 50% REVIEW	2011/02

PROFESSIONAL SEAL / PERMIT TO PRACTICE

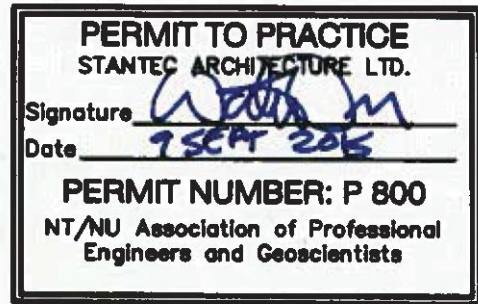

FSC
ARCHITECTS & ENGINEERS
Unit C, 1088 Mivik Street, Box 1779
Iqaluit, NU, X0A 0H0, Canada
T 867.979.0555 | F 867.979.5711

PROJECT TITLE

FUEL STORAGE FACILITY UPGRADES

LOCATION
CHESTERFIELD INLET, NU

STRUCTURAL ASSORTED DETAILS SHEET 2

DRAWN BY: AF
CHECKED BY: WO
SCALE: AS NOTED
CLIENT PROJECT NO.: 10-3018

FSC PROJECT NO.: 2010-1160

DRAWING NO.

S10

