

D


0 10 20 30 40 50 60 70 80 90 100mm

A

ORIENTATION PLAN – NEW LSDL VERTICAL TANK

LIST OF REQUIRED APPURTENANCES FOR VERTICAL TANKS					
ITEM	SIZE	ELEV. ABOVE BASE RING	DESCRIPTION	Comments	ANGULAR LOCATION – CW DECIMAL DEGREES
SN1	150 ø	325	LOB cast steel gate valve, tank inlet/outlet	Nozzle. See Specification for Details	0
SMH1	610 ø	740	Manhole Access, c/w Cover 810 ø, Neck 610 ø, flange thickness 11 mm, Cover thickness 13 mm, 28 bolts, two handles 165 x 90 x 16 mm	See Specification for Details	322
SN2	50 ø	250	Water Drain Valve	See Standard Detail Drawing 3–M10 and Specifications for Details	277
SB2	–	–	Automatic tape type level gauge, metric units tape	See Standard Detail Drawing 1–M10 and Specifications for Details	219
–	–	–	Beginning of Tank Stairs (Clockwise Run)	See Standard Detail Drawing 2–M9 and Specifications for Details	232
SN3	50 ø	250	Water Drain Valve	See Standard Detail Drawing 3–M10 and Specifications for Details	37
SB1	–	5,867	Tank Stair Light Bracket	See Standard Detail Drawing 4–M9 and Specifications for Details	280
SMH2	610 ø	740	Manhole Access, c/w Cover 810 ø, Neck 610 ø, flange thickness 11 mm, Cover thickness 13 mm, 28 bolts, two handles 165 x 90 x 16 mm	See Specification for Details	142
–	–	–	Beginning of upper deck	See Standard Detail Drawing 2–M9 and Specifications for Details	321
–	–	–	End of upper deck	See Standard Detail Drawing 2–M9 and Specifications for Details	328
SN4	50 ø	250	Water Drain Valve	See Standard Detail Drawing 3–M10 and Specifications for Details	157
SN5	25 ø	516	Pressure Relief Valve	See Standard Detail Drawing 2–M10 and Specifications for Details	0

LIST OF ROOF APPURTENANCES FOR VERTICAL TANKS					
ITEM	SIZE	HOR. LOCATION FROM EDGE OF SHELL (To CL)	DESCRIPTION	Comments	ANGULAR LOCATION – CW DECIMAL DEGREES
RN1	150 ø	900	150 ø Flanged gauge hatch	See Specification for Details	325
RN2	150 ø	1,500	PV Vent	See Specification for Details	336
RN3	varies	450	Connections for automatic level gauge	See Standard Detail Drawing 1–M10 and Specifications for Details	219
RMH1	610 ø	1,100	Roof Manhole, Cover 810 ø m, Neck 610 ø, flange thickness 11 mm, Cover thickness 13 mm, 28 bolts	See Specification for Details	219
RB1	100 ø	Middle of tank	Cable support post	–	–
RN4	75 ø	450	Coupling for future electronic level gauge	See Standard Detail Drawing 4–M10 and Specifications for Details	332
RB2	–	180	Socket for Light Fixture Post	See Standard Detail Drawing 5–M9 and Specifications for Details	329

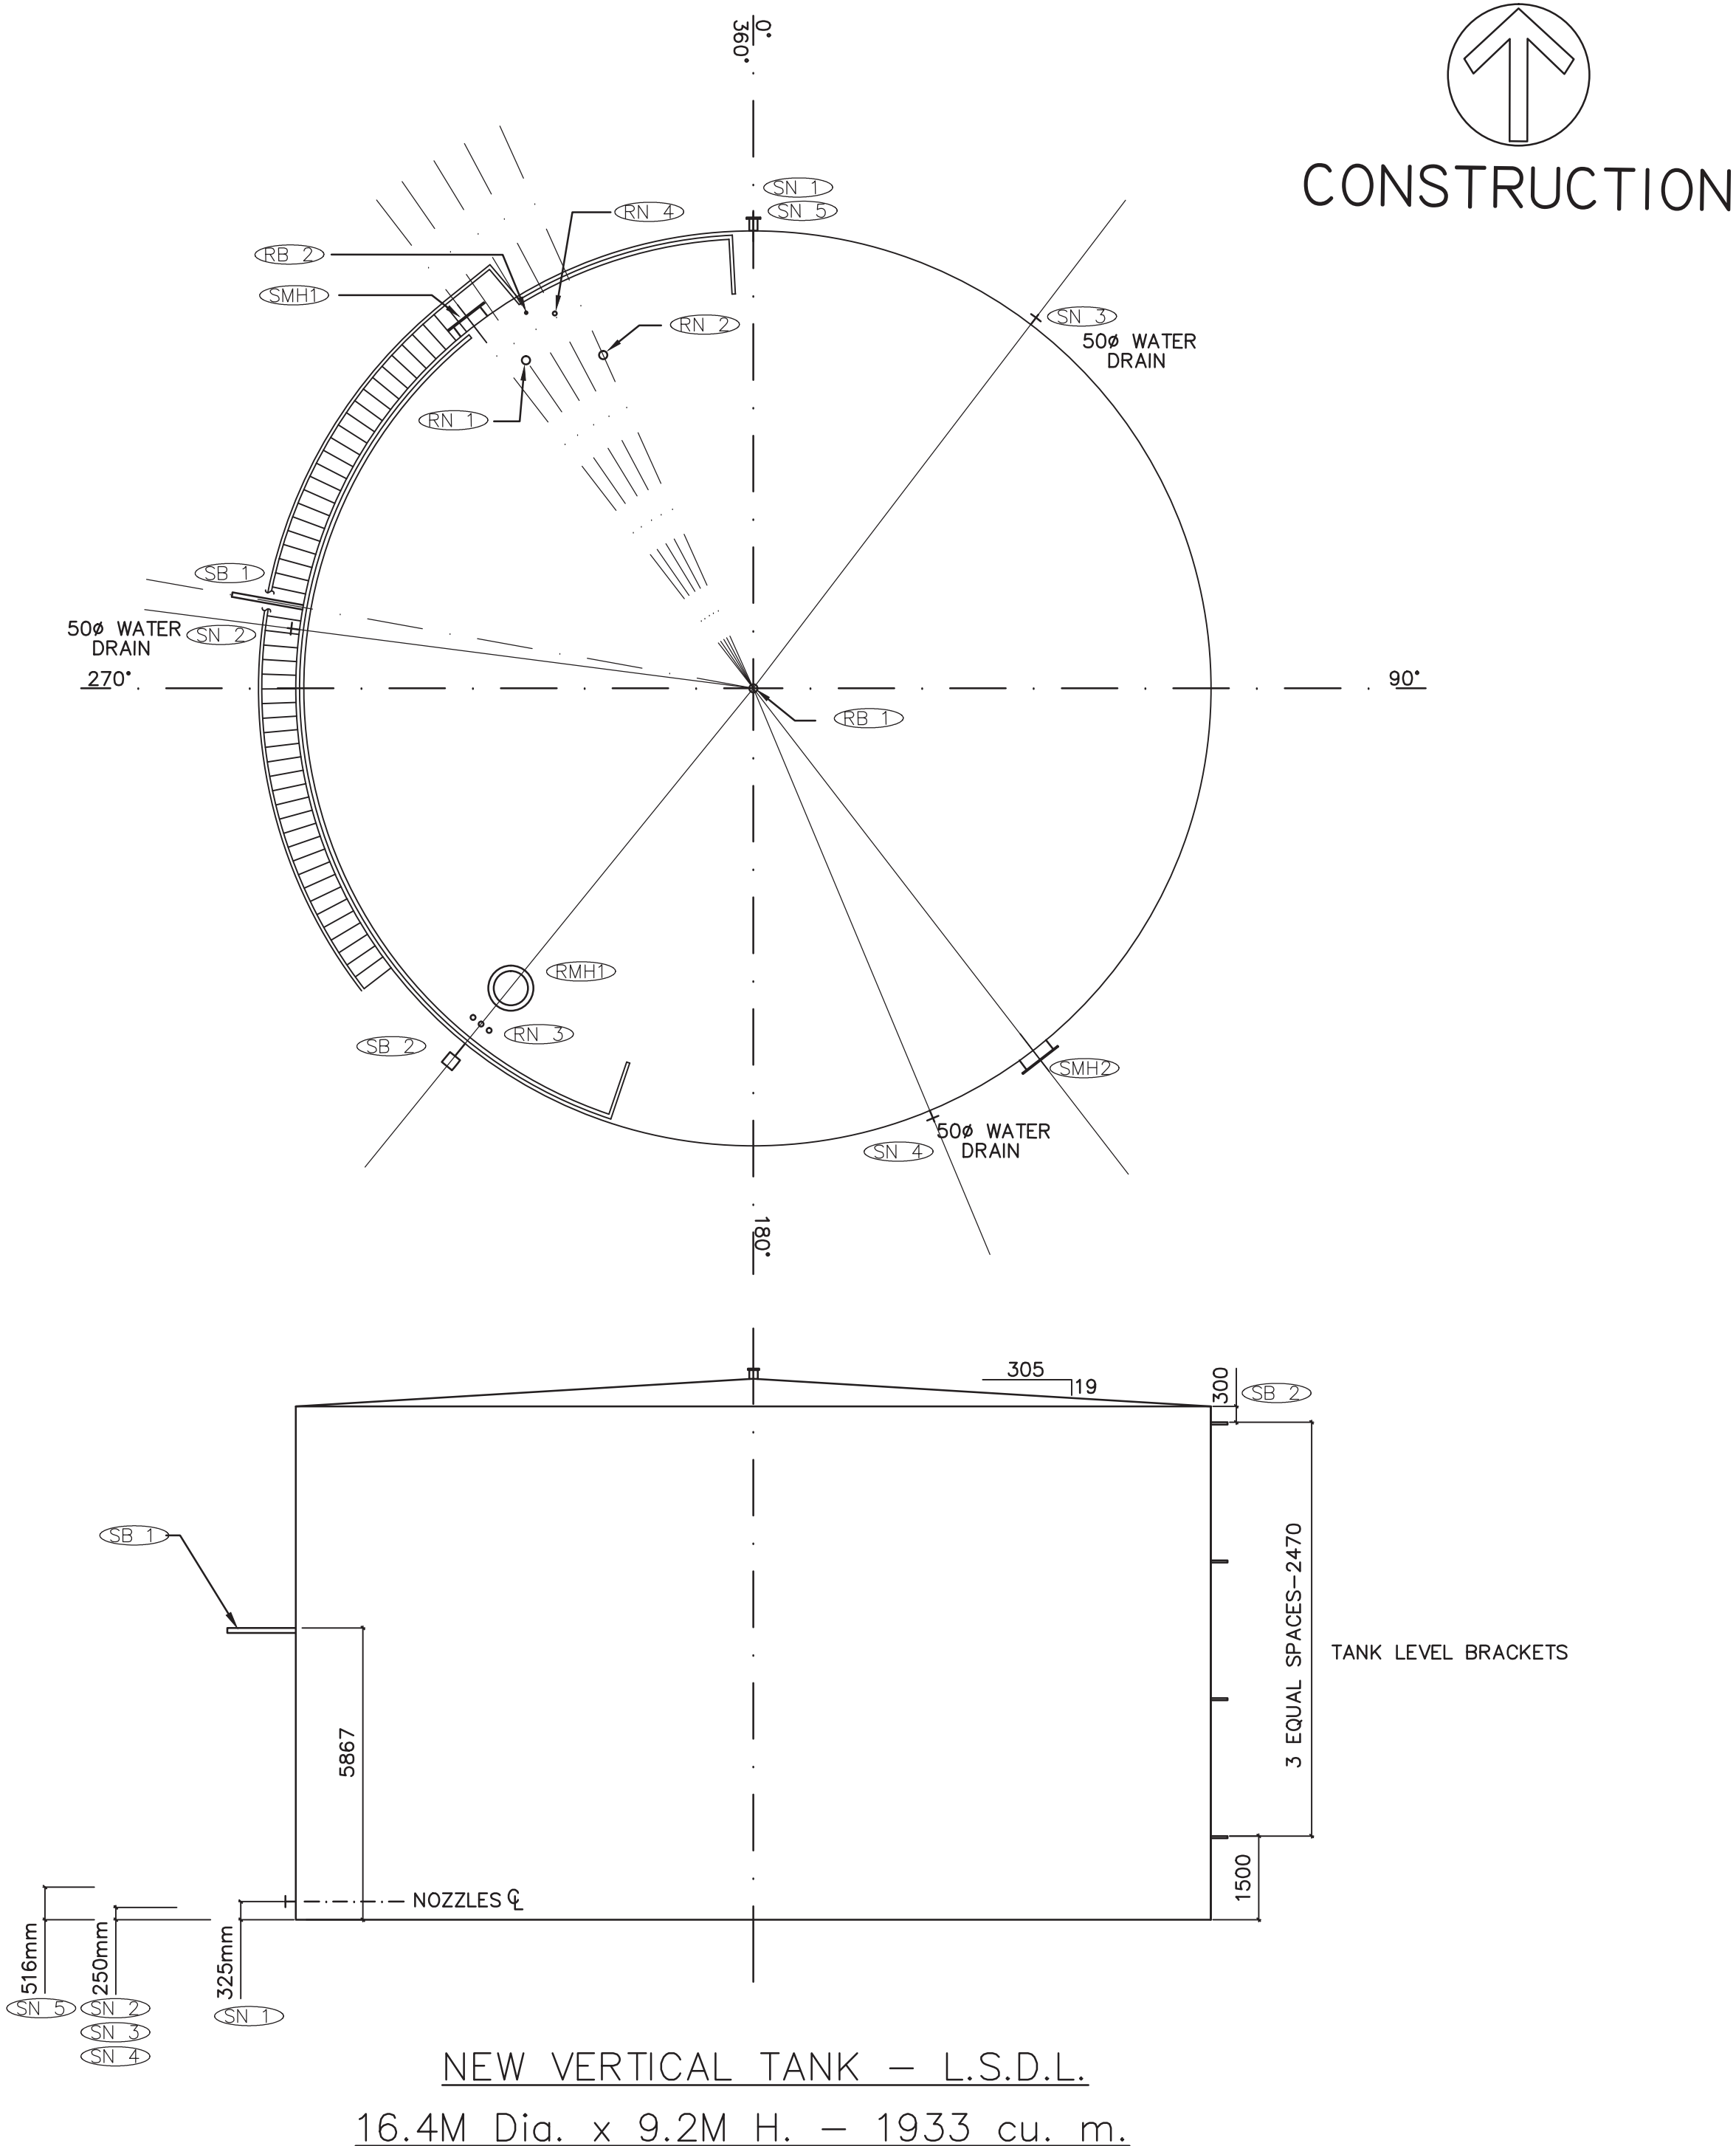


© Copyright Reserved 2011 by FSC Architects & Engineers
The information contained in this drawing is copyright and has been prepared for the sole purpose of the project described herein and for the sole benefit of the Owner. Any unauthorized use of this information will be considered a breach of copyright and may be pursued as such. Use of this information for any purpose other than the project described herein is at the sole risk of the user.

Record Drawing

These drawings have been prepared based on information provided by Inukshuk Construction with a construction completion date of 20/02/2014. Stantec has not verified the accuracy and/or completeness of this information and shall not be responsible for any errors or omissions which may be incorporated herein as a result.

NO.	REVISION DESCRIPTION	DATE ISSUED
03	RECORD DRAWINGS	2013/11/01
02	ISSUED FOR TENDER	2011/06/08
01	ISSUED FOR 95% REVIEW	2011/03/25
00	ISSUED FOR 50% REVIEW	2011/02

PROFESSIONAL SEAL / PERMIT TO PRACTICE

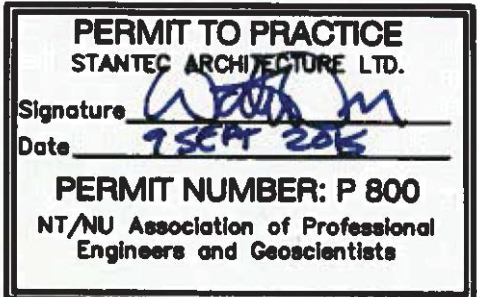

PROJECT TITLE
FUEL STORAGE FACILITY UPGRADES
LOCATION
CHESTERFIELD INLET, NU
DRAWING TITLE
NEW LSDL VERTICAL TANK

DRAWN BY AF	SCALE 1:100
CHECKED BY WO	CLIENT PROJECT NO. 10-3018

FSC PROJECT NO.
2010-1160

DRAWING NO.
M1

OF 45

D


0 10 20 30 40 50 60 70 80 90 100mm

A

ORIENTATION PLAN – NEW GASOLINE VERTICAL TANK

LIST OF REQUIRED APPURTENANCES FOR VERTICAL TANKS					
ITEM	SIZE	ELEV. ABOVE BASE RING	DESCRIPTION	Comments	ANGULAR LOCATION – CW DECIMAL DEGREES
SN1	100 ø	300	LCB cast steel gate valve, tank inlet/outlet	Nozzle. See Specification for Details	270
SMH1	610 ø	740	Manhole Access, c/w Cover 810 ø, Neck 610 ø, flange thickness 11 mm, Cover thickness 13 mm, 28 bolts, two handles 165 x 90 x 16 mm	See Specification for Details	45
SN2	50 ø	250	Water Drain Valve	See Standard Detail Drawing 3–M10 and Specifications for Details	0
SB2	–	–	Automatic tape type level gauge, metric units tape	See Standard Detail Drawing 1–M10 and Specifications for Details	302
			Beginning of Tank Stairs (Clockwise Run)	See Standard Detail Drawing 2–M9 and Specifications for Details	45
SN3	50 ø	250	Water Drain Valve	See Standard Detail Drawing 3–M10 and Specifications for Details	120
SB1		5,867	Tank Stair Light Bracket	See Standard Detail Drawing 4–M9 and Specifications for Details	3
SMH2	610 ø	740	Manhole Access, c/w Cover 810 ø, Neck 610 ø, flange thickness 11 mm, Cover thickness 13 mm, 28 bolts, two handles 165 x 90 x 16 mm	See Specification for Details	225
			Beginning of upper deck	See Standard Detail Drawing 2–M9 and Specifications for Details	38
			End of upper deck	See Standard Detail Drawing 2–M9 and Specifications for Details	50
SN4	50 ø	250	Water Drain Valve	See Standard Detail Drawing 3–M10 and Specifications for Details	240
SN5	25 ø	516	Pressure Relief Valve	See Standard Detail Drawing 2–M10 and Specifications for Details	270

LIST OF ROOF APPURTENANCES FOR VERTICAL TANKS					
ITEM	SIZE	HOR. LOCATION FROM EDGE OF SHELL (To CL)	DESCRIPTION	Comments	ANGULAR LOCATION – CW DECIMAL DEGREES
RN1	150 ø	900	150 ø Flanged gauge hatch	See Specification for Details	48
RN2	150 ø	1,500	PV Vent	See Specification for Details	58
RN3	varies	450	Connections for automatic level gauge	See Standard Detail Drawing 1–M10 and Specifications for Details	302
RMH1	610 ø	1,100	Roof Manhole, Cover 810 ø m, Neck 610 ø, flange thickness 11 mm, Cover thickness 13 mm, 28 bolts	See Specification for Details	302
RB1	100 ø	Middle of tank	Cable support post		–
RN4	75 ø	450	Coupling for future electronic level gauge	See Standard Detail Drawing 4–M10 and Specifications for Details	54
RB2		180	Socket for Light Fixture Post	See Standard Detail Drawing 5–M9 and Specifications for Details	51

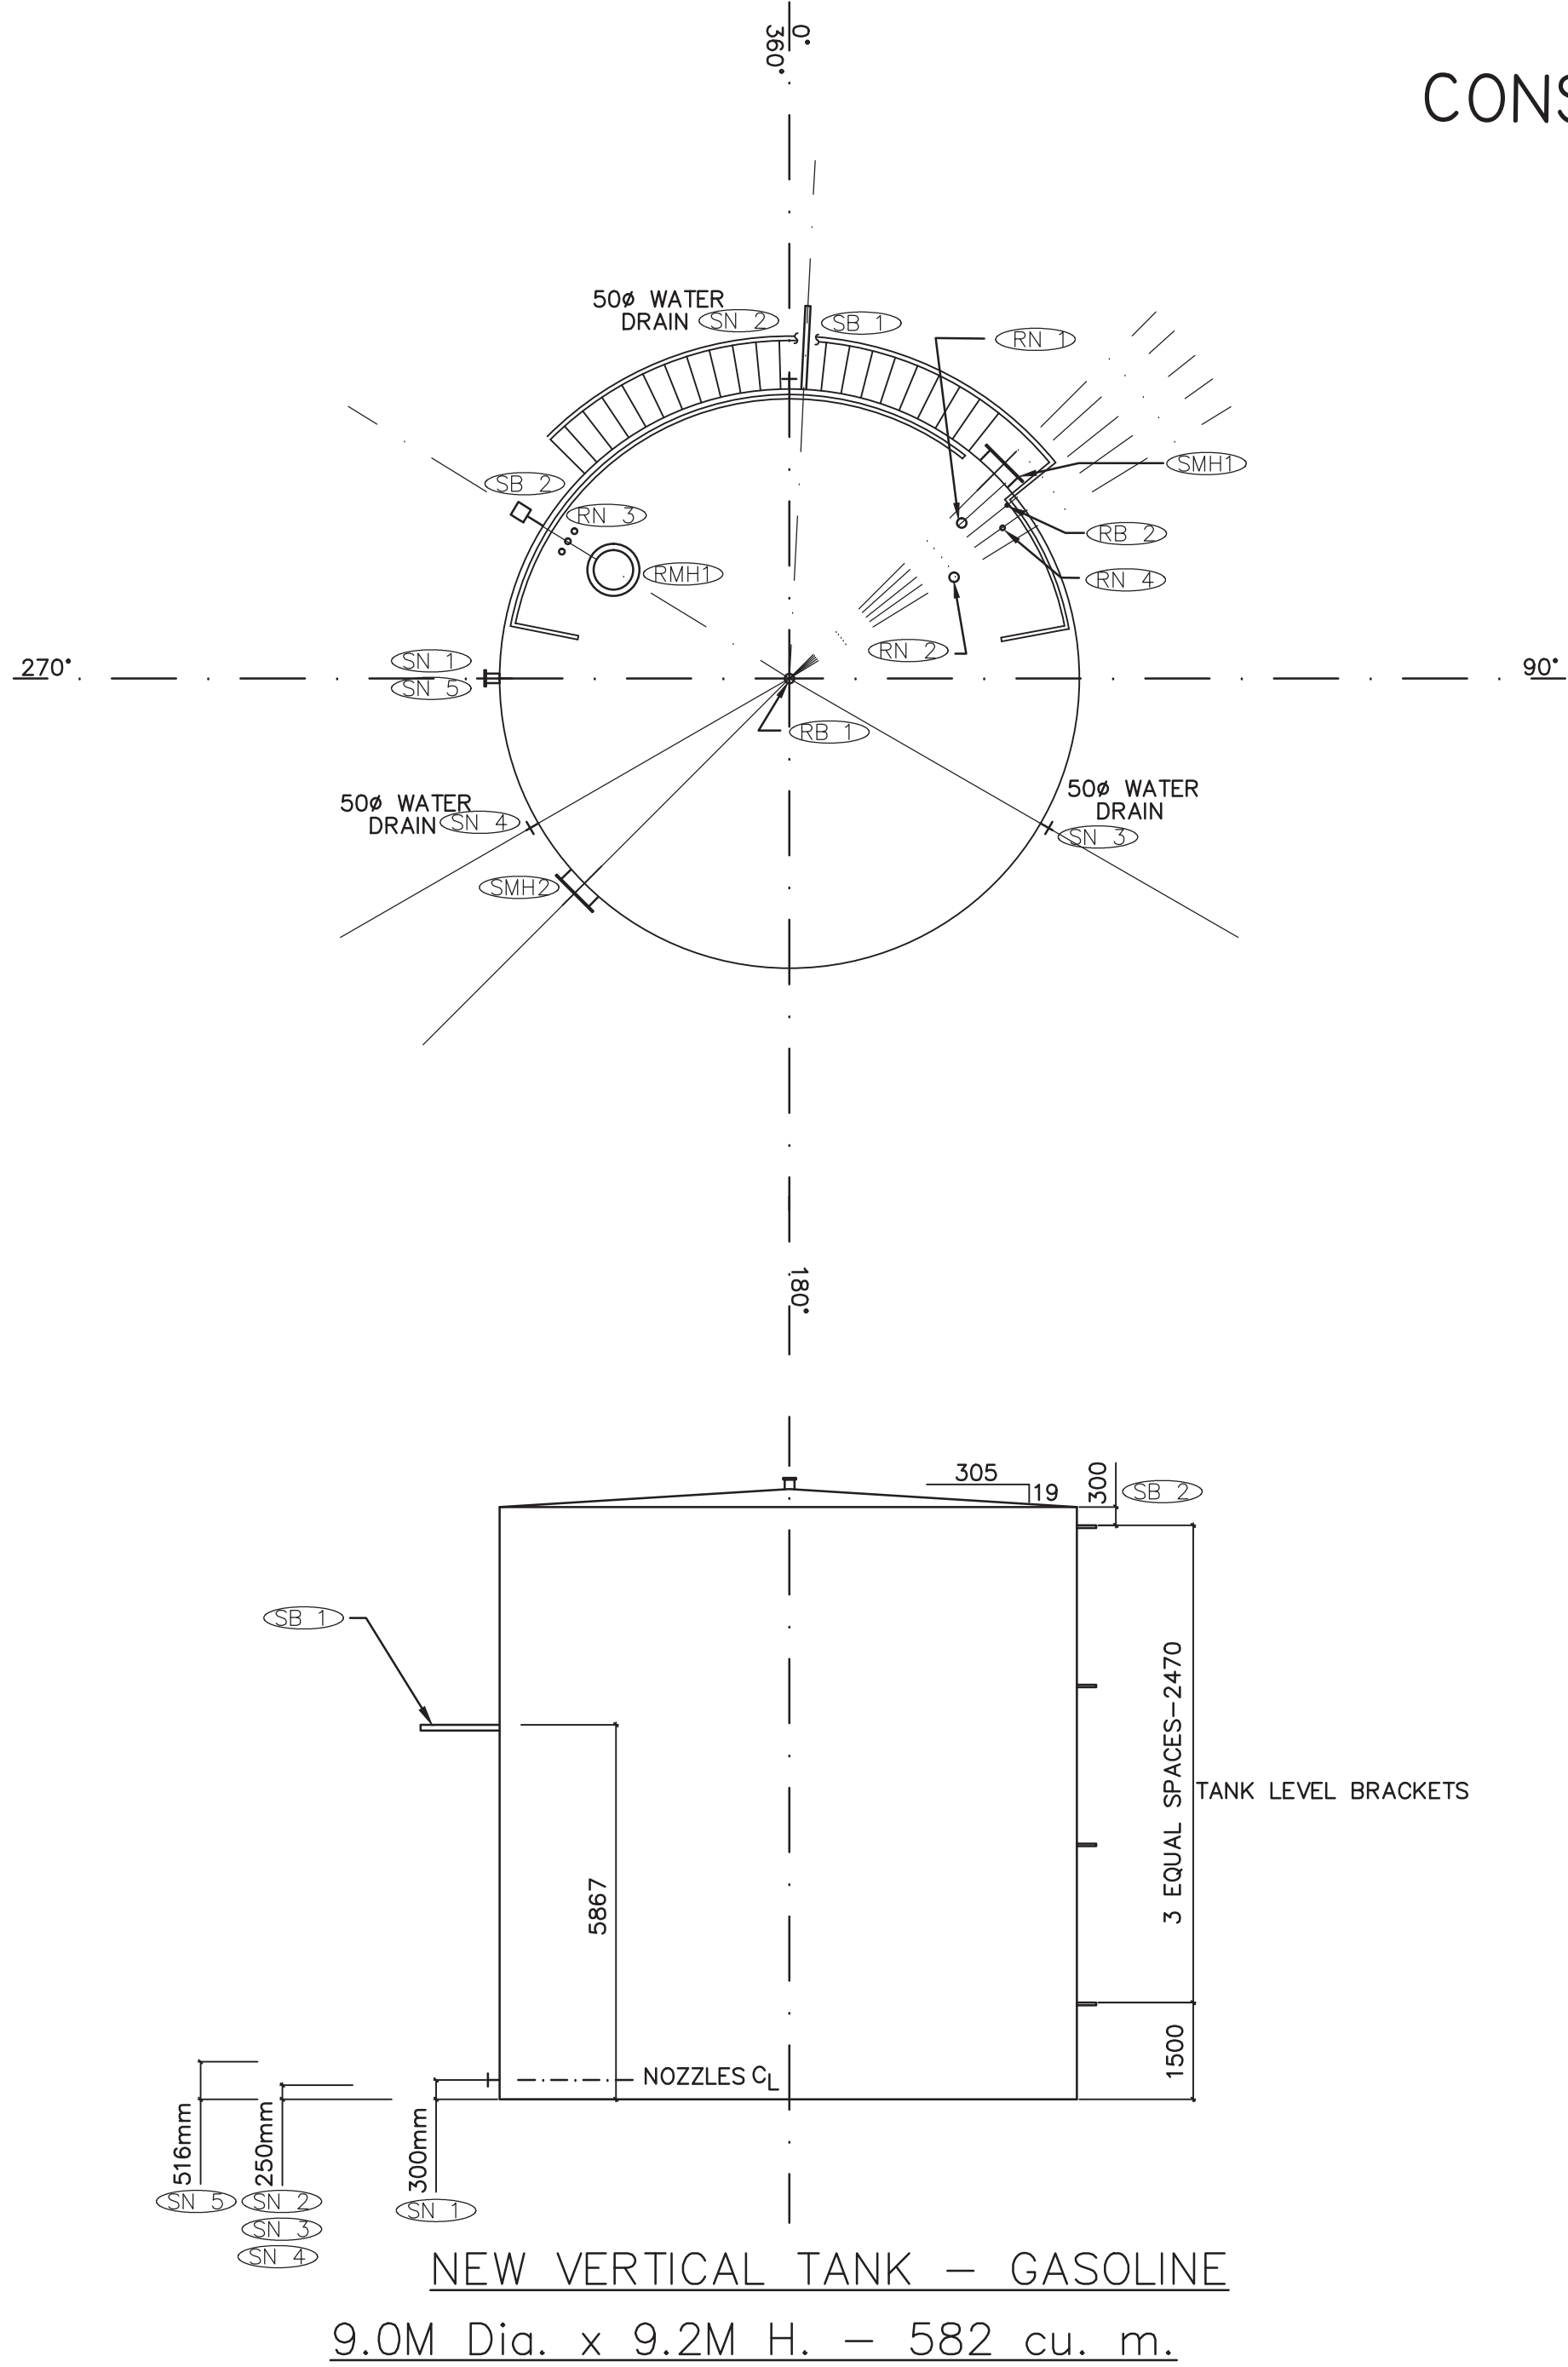

NEW VERTICAL TANK – GASOLINE
9.0M Dia. x 9.2M H. – 582 cu. m.





© Copyright Reserved 2011 by FSC Architects & Engineers
The information contained in this drawing is copyright and has been prepared for the sole purpose of the project described herein and for the sole benefit of the Owner. Any unauthorized use of this information will be considered a breach of copyright and may be pursued as such. Use of this information for any purpose other than the project described herein is at the sole risk of the user.

Record Drawing

These drawings have been prepared based on information provided by Inuksuk Construction with a construction completion date of 20.02.2014. Stantec has not verified the accuracy and/or completeness of this information and shall not be responsible for any errors or omissions which may be incorporated herein as a result.

NO.	REVISION DESCRIPTION	DATE ISSUED
03	RECORD DRAWINGS	2013/11/01
02	ISSUED FOR TENDER	2011/06/08
01	ISSUED FOR 95% REVIEW	2011/03/25
00	ISSUED FOR 50% REVIEW	2011/02

PROFESSIONAL SEAL / PERMIT TO PRACTICE

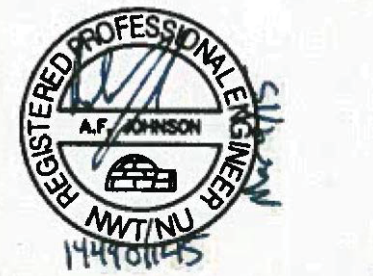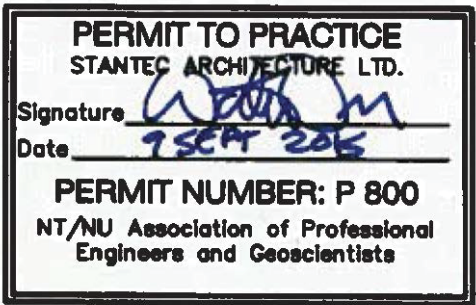

PROJECT TITLE

FUEL STORAGE
FACILITY
UPGRADES

LOCATION

CHESTERFIELD INLET, NU

DRAWING TITLE

NEW GASOLINE
VERTICAL TANK

DRAWN BY	AF	SCALE	1:100
CHECKED BY	WO	CLIENT PROJECT NO.	10-3018

FSC PROJECT NO.
2010-1160

DRAWING NO.

M2

OF 45

D

100mm
90
80
70
60
50
40
30
20
10
0

A


ORIENTATION PLAN – RELOCATED VERTICAL TANK

LIST OF SIDE APPURTENANCES FOR VERTICAL TANK

ITEM	SIZE	ELEV. ABOVE BASE RING	DESCRIPTION	Comments	ANGULAR LOCATION – CW DECIMAL DEGREES
SN1	–	–	Water Drain Valve	Replace with New Valve – See Specification for Details	129
SMH1	800 ø	–	Manhole Access	Existing	148
SN2	150 ø	–	Existing Tank Inlet/Outlet	Existing Valve – Cap. See Specifications for Details	180
SB1	–	–	Automatic Tank Gauge	Replace with New – See Specification for Details	212
SN3	150 ø	275	New LGB Cast Steel Gate Valve, Tank Inlet/Outlet	New Valve – See Specification for Details	270
SMH1	800 ø	–	Manhole Access	Existing	331

LIST OF ROOF APPURTENANCES FOR VERTICAL TANK

ITEM	SIZE	HOR. LOCATION FROM EDGE OF SHELL (To CL)	DESCRIPTION	Comments	ANGULAR LOCATION – CW DECIMAL DEGREES
RN1	–	1060	PV Vent	Existing	304
RMH1	–	1060	Roof Manhole	Existing	318
–	–	–	Beginning of Stair Landing	Existing	322
RN2	100 ø	900	Gauge Hatch	Existing	328
–	–	–	End of Stair Landing	Existing	331

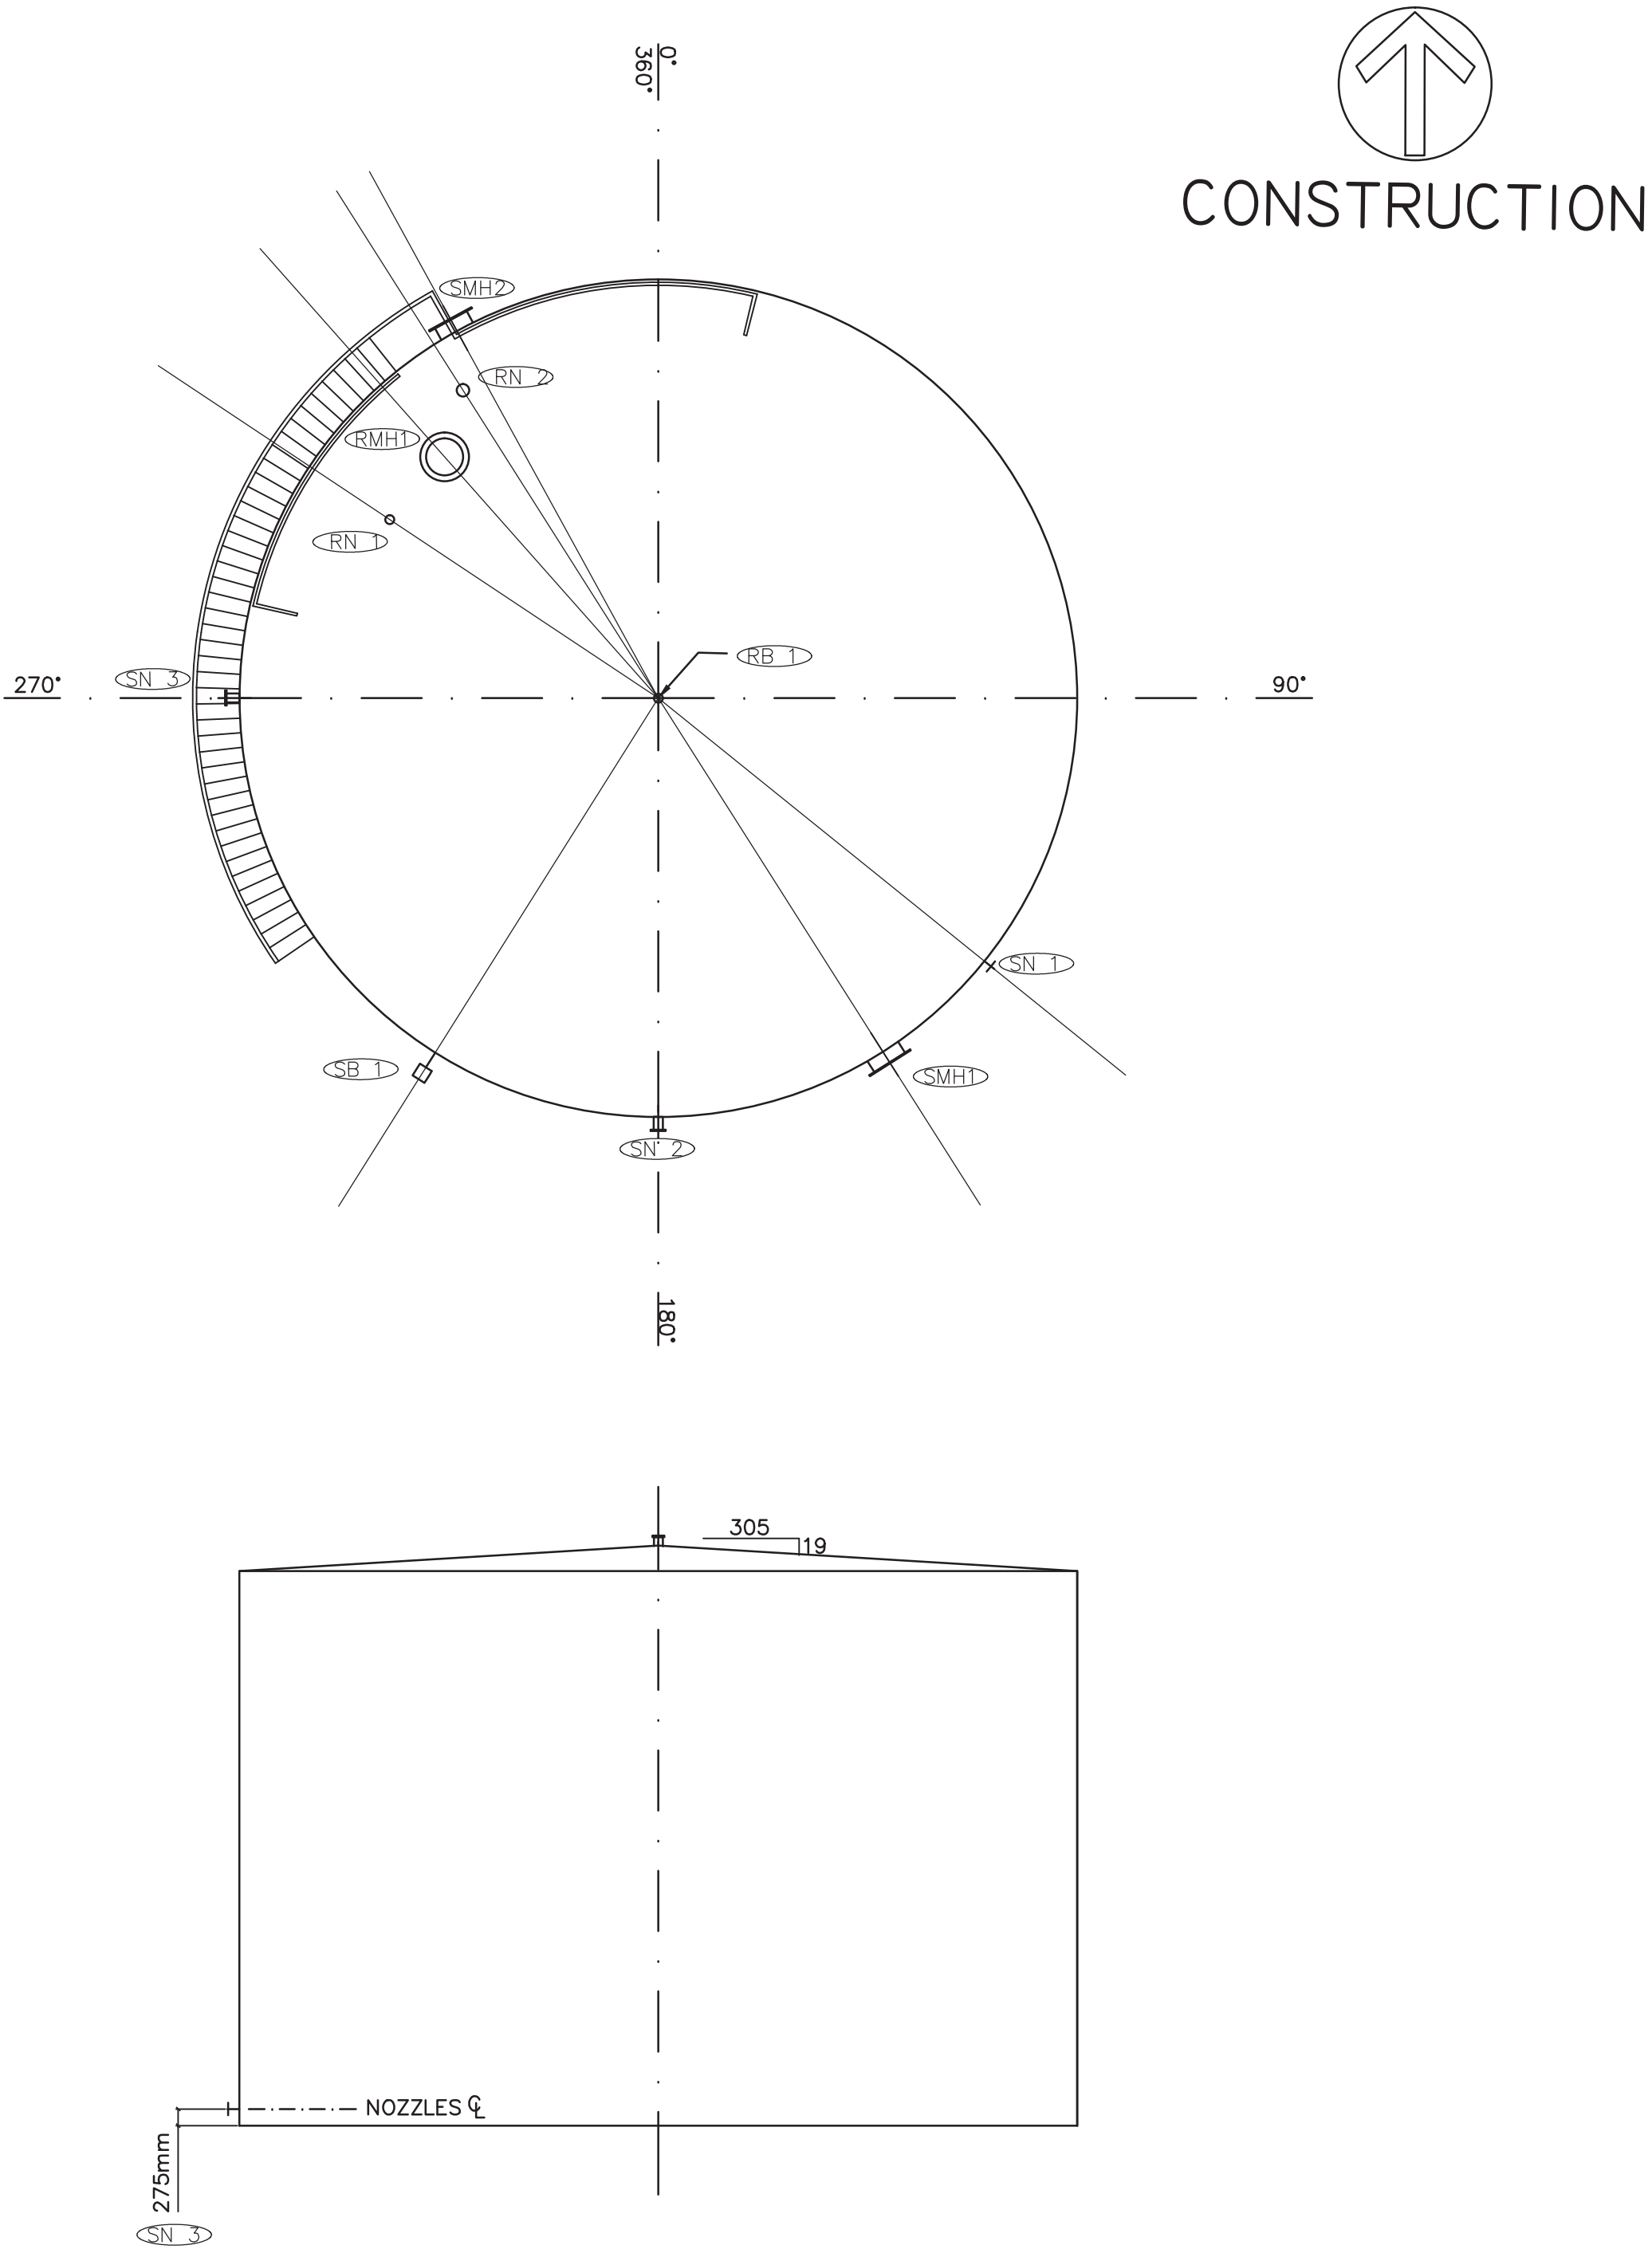

RELOCATED VERTICAL TANK #1– L.S.D.L.
13.9M Dia. x 9.2M H. – 1379 cu. m.





© Copyright Reserved 2011 by FSC Architects & Engineers
The information contained in this drawing is copyright and has been prepared for the sole purpose of the project described herein and for the sole benefit of the Owner. Any unauthorized use of this information will be considered a breach of copyright and may be pursued as such. Use of this information for any purpose other than the project described herein is at the sole risk of the user.

Record Drawing

These drawings have been prepared based on information provided by Inukshuk Construction with a construction completion date of 20.02.2014. Stantec has not verified the accuracy and/or completeness of this information and shall not be responsible for any errors or omissions which may be incorporated herein as a result.

NO.	REVISION DESCRIPTION	DATE ISSUED
03	RECORD DRAWINGS	2013/11/01
02	ISSUED FOR TENDER	2011/06/08
01	ISSUED FOR 95% REVIEW	2011/03/25
00	ISSUED FOR 50% REVIEW	2011/02

PROFESSIONAL SEAL / PERMIT TO PRACTICE

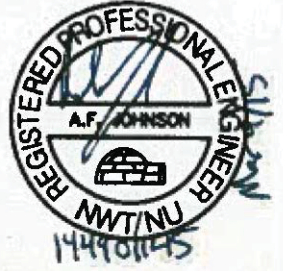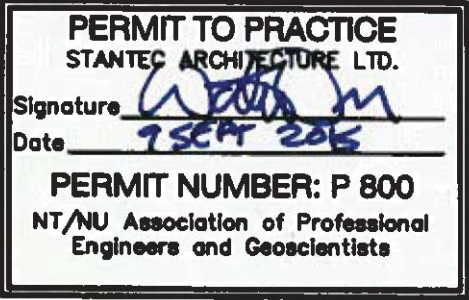

FSC
ARCHITECTS & ENGINEERS
Unit C, 1088 Mivvik Street, Box 1779
Iqaluit, NU, X0A 0H0, Canada
T 867.979.0555 | F 867.979.5711


PROJECT TITLE
FUEL STORAGE FACILITY UPGRADES
LOCATION
CHESTERFIELD INLET, NU

DRAWING TITLE
RELOCATED VERTICAL TANK

DRAWN BY AF	SCALE 1:100
CHECKED BY WO	CLIENT PROJECT NO. 10-3018

FSC PROJECT NO.
2010-1160

DRAWING NO.
M3
of 45

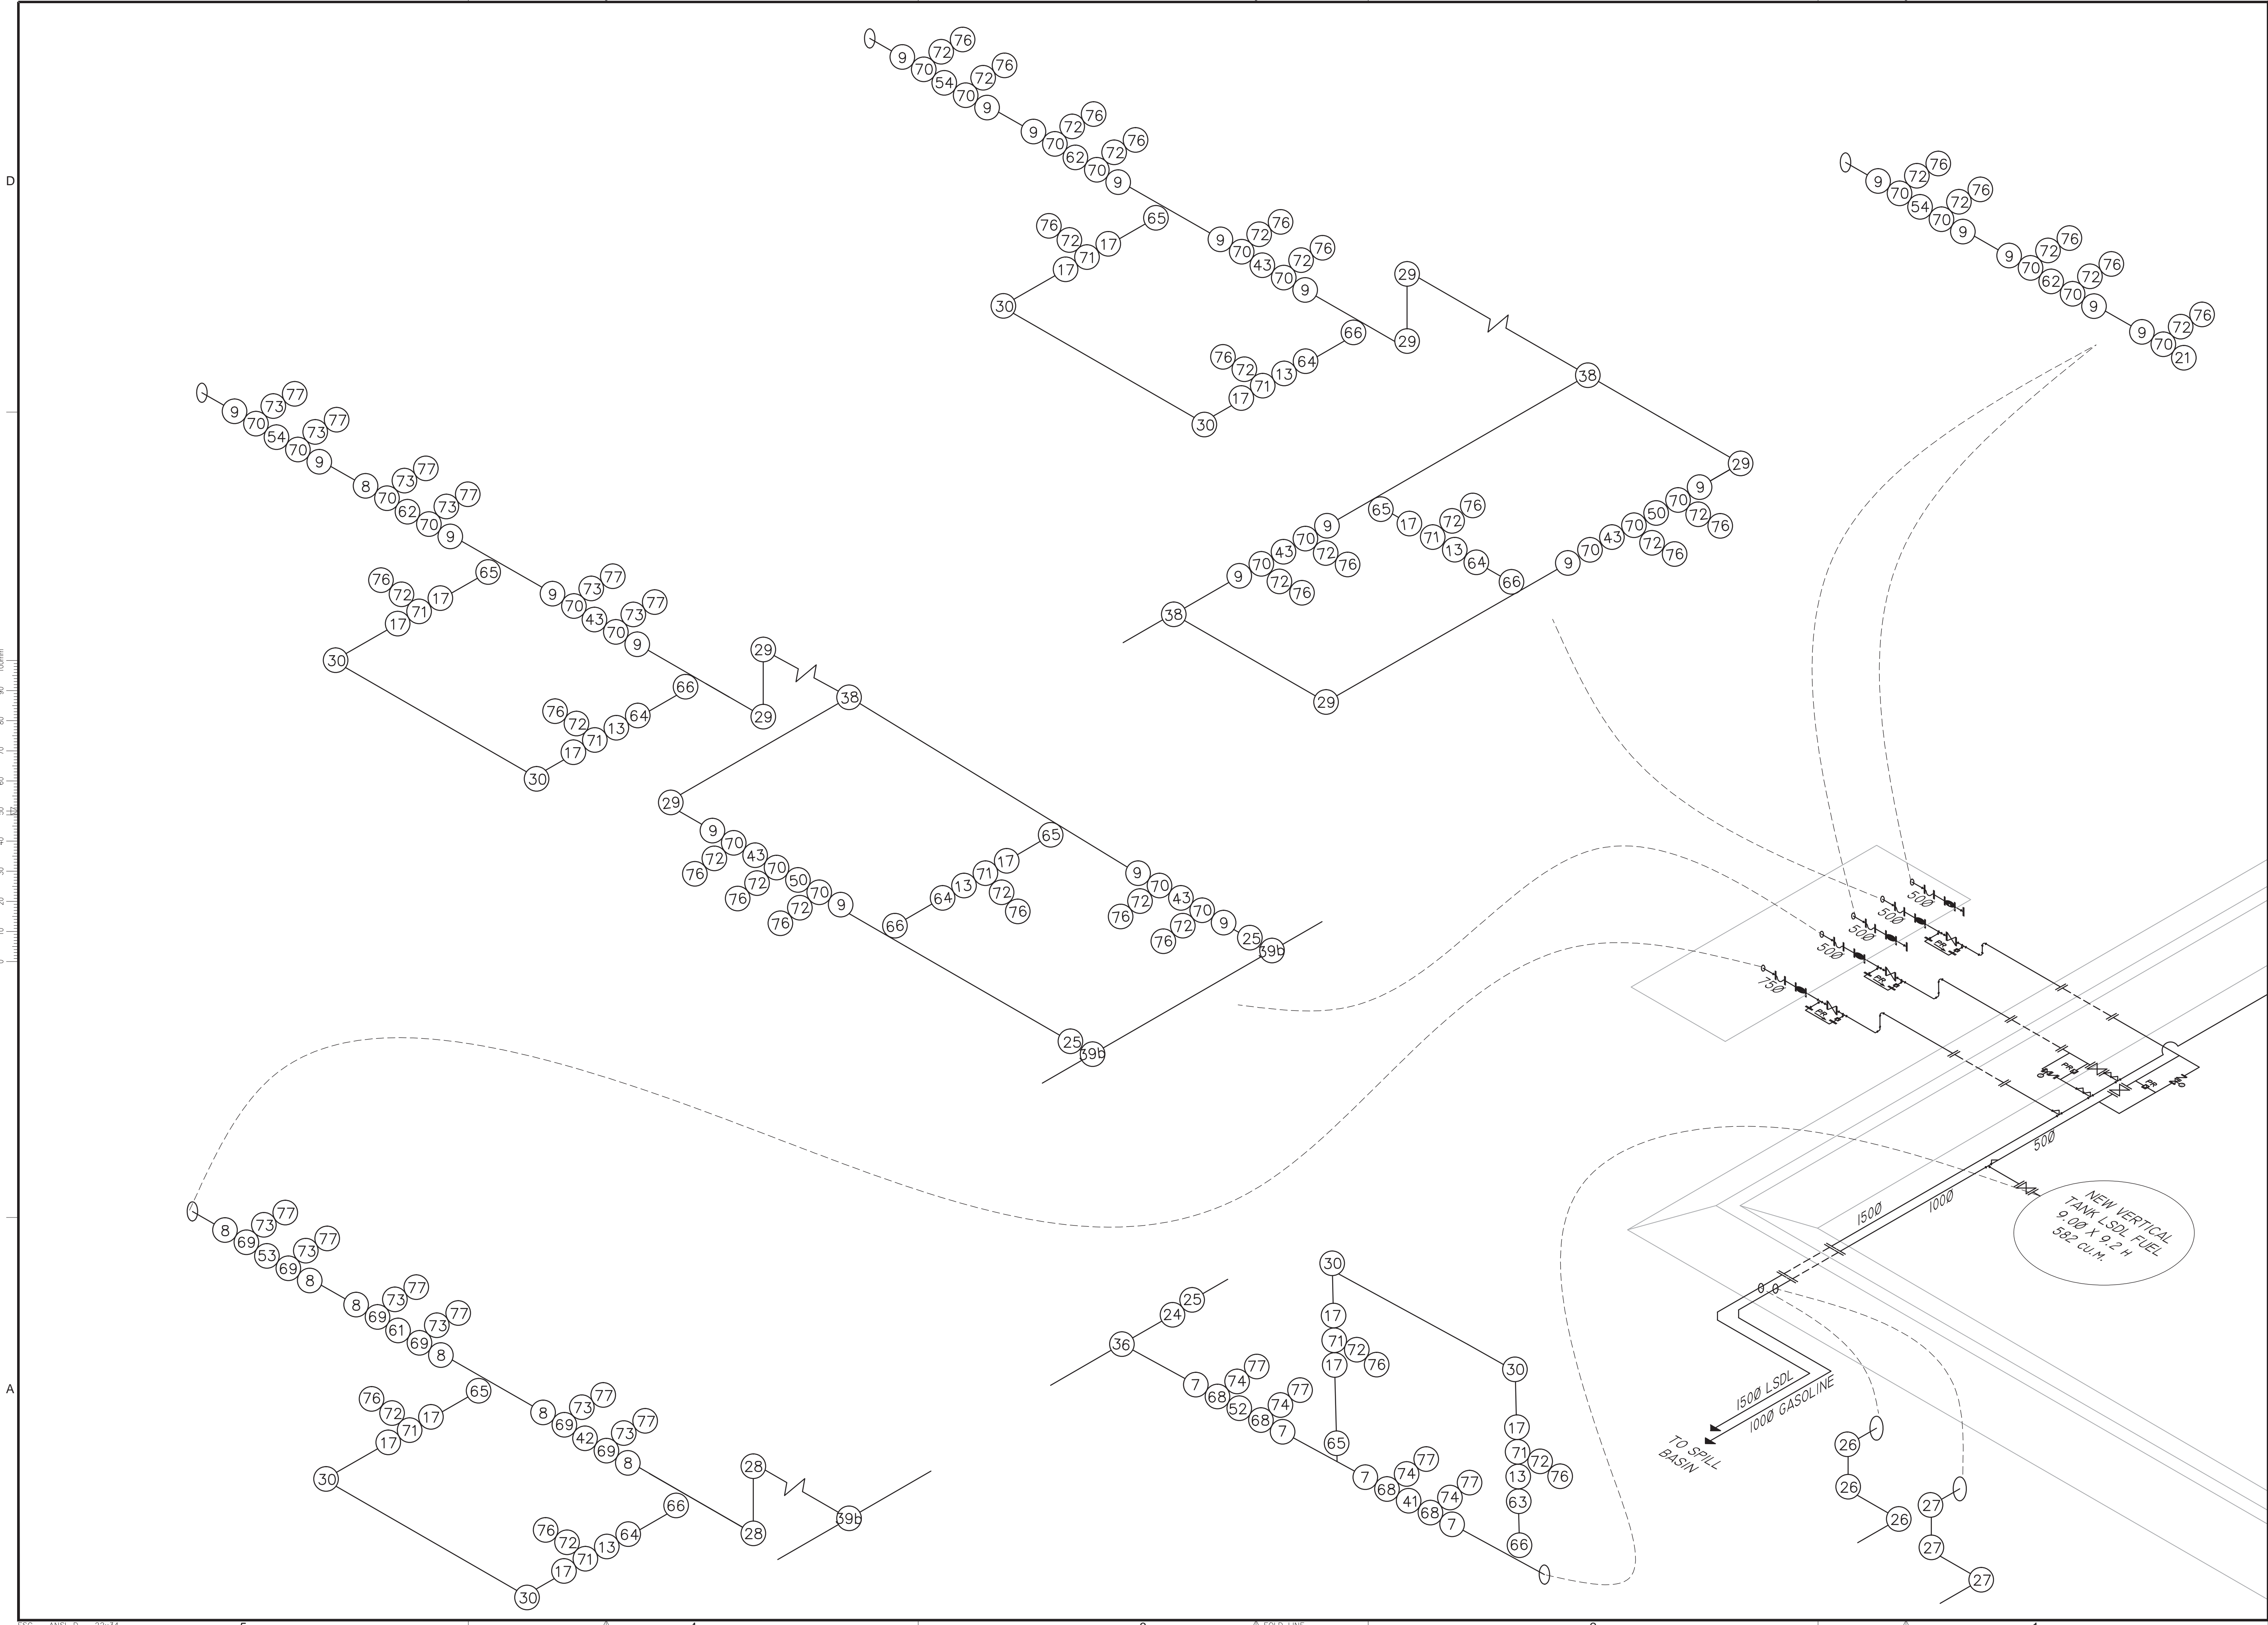



© Copyright Reserved 2011 by FSC Architects & Engineers
The information contained in this drawing is copyright and has been prepared for the sole purpose of the project described herein and for the sole benefit of the Owner. Any unauthorized use of this information will be considered a breach of copyright and may be pursued as such. Use of this information for any purpose other than the project described herein is at the sole risk of the user.

Record Drawing

These drawings have been prepared based on information provided by Inukshuk Construction with a construction completion date of 20.02.2014. Stantec has not verified the accuracy and/or completeness of this information and shall not be responsible for any errors or omissions which may be incorporated herein as a result.

NO.	REVISION DESCRIPTION	DATE ISSUED
03	RECORD DRAWINGS	2013/11/01
02	ISSUED FOR TENDER	2011/06/08
01	ISSUED FOR 95% REVIEW	2011/03/25
00	ISSUED FOR 50% REVIEW	2010/02

PROFESSIONAL SEAL / PERMIT TO PRACTICE

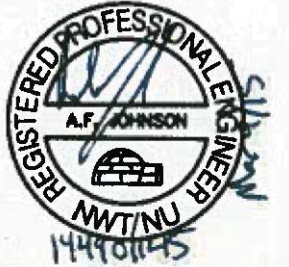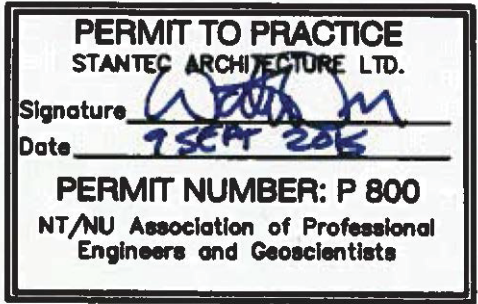

PROJECT TITLE

FUEL STORAGE
FACILITY
UPGRADES

LOCATION

CHESTERFIELD INLET, NU

DRAWING TITLE

TANK FARM PROPOSED
PIPING ISOMETRIC
NEAR DISPENSER
BUILDING

DRAWN BY

AF

SCALE

AS NOTED

CHECKED BY

WO

CLIENT PROJECT NO.

10-3018


FSC PROJECT NO.

2010-1160

DRAWING NO.

M5

OF 45

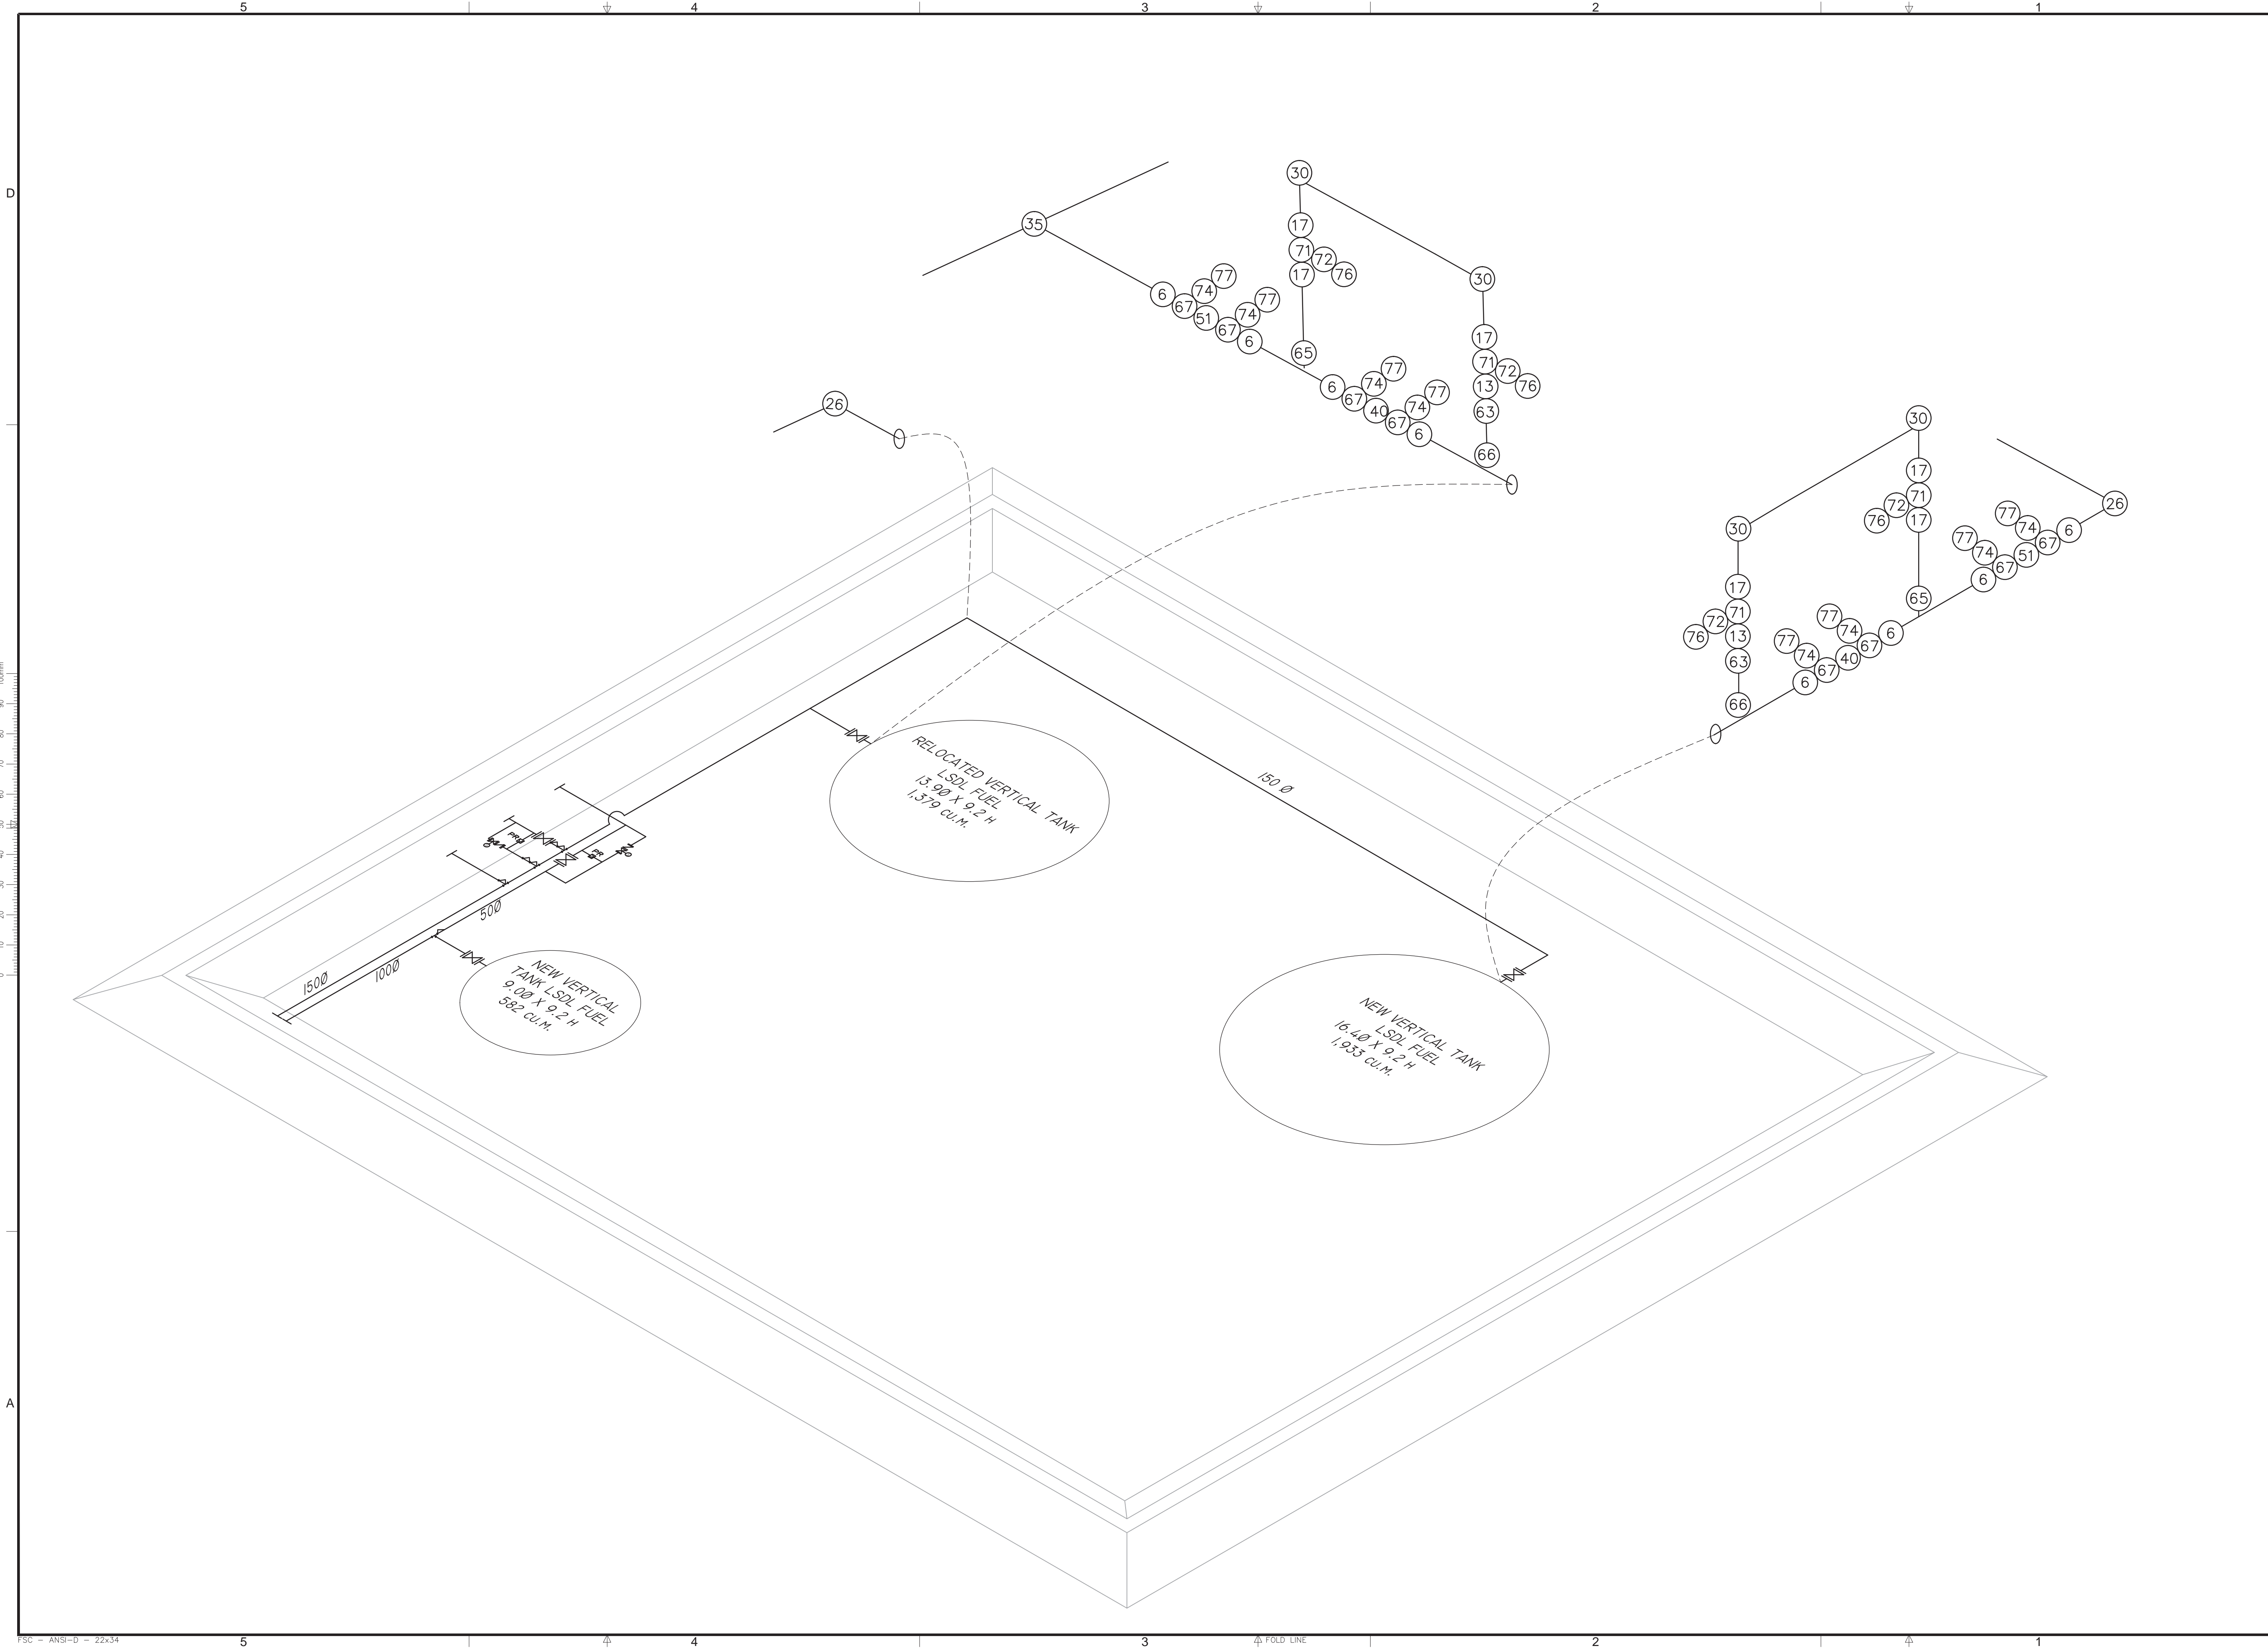


© Copyright Reserved 2011 by FSC Architects & Engineers
The information contained in this drawing is copyright and has been prepared for the sole purpose of the project described herein and for the sole benefit of the Owner. Any unauthorized use of this information will be considered a breach of copyright and may be pursued as such. Use of this information for any purpose other than the project described herein is at the sole risk of the user.

Record Drawing

These drawings have been prepared based on information provided by Inuksuk Construction with a construction completion date of 20.02.2014. Stantec has not verified the accuracy and/or completeness of this information and shall not be responsible for any errors or omissions which may be incorporated herein as a result.

NO.	REVISION DESCRIPTION	DATE ISSUED
03	RECORD DRAWINGS	2013/11/01
02	ISSUED FOR TENDER	2011/06/08
01	ISSUED FOR 95% REVIEW	2011/03/25
00	ISSUED FOR 50% REVIEW	2010/02

PROFESSIONAL SEAL / PERMIT TO PRACTICE

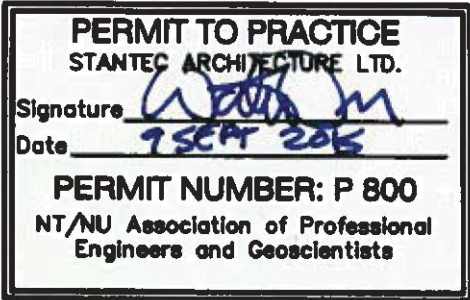

PROJECT TITLE
FUEL STORAGE FACILITY UPGRADES
LOCATION
CHESTERFIELD INLET, NU

DRAWING TITLE
TANK FARM PROPOSED PIPING ISOMETRIC NEAR NEW LSDL TANK

DRAWN BY AF	SCALE AS NOTED
CHECKED BY WO	CLIENT PROJECT NO. 10-3018

FSC PROJECT NO.
2010-1160

DRAWING NO.
M6

D

100mm
90
80
70
60
50
40
30
20
10
0

A

Bill of Materials – Chesterfield Inlet Fuel Storage Piping

No.	Nom. Size	Description	Spec
1	150 Ø	Pipe, SMLS, C.S., SCH. 40	A 53 GR. B
2	100 Ø	Pipe, SMLS, C.S., SCH. 40	
3	75 Ø	Pipe, SMLS, C.S., SCH. 40	
4	50 Ø	Pipe, SMLS, C.S., SCH. 40	
5	25 Ø	Pipe, SMLS, C.S., SCH. 80	
6	150 Ø	W.N. FLANGE, F.R. 1034 kPa, FORGED STEEL, F. & D.	ASTM A350 GR. LF2
7	100 Ø	W.N. FLANGE, F.R. 1034 kPa, FORGED STEEL, F. & D.	
8	75 Ø	W.N. FLANGE, F.R. 1034 kPa, FORGED STEEL, F. & D.	
9	50 Ø	W.N. FLANGE, F.R. 1034 kPa, FORGED STEEL, F. & D.	
11	75 Ø	THREADED FLANGE, 1034 kPa, FORGED STEEL, R.F., F.& D.	
12	50 Ø	THREADED FLANGE, 1034 kPa, FORGED STEEL, R.F., F.& D.	
13	25 Ø	THREADED FLANGE, 1034 kPa, FORGED STEEL, R.F., F.& D.	
17	25 Ø	SLIP ON FLANGE, 1034 kPa, FORGED STEEL, R.F., F.& D.	
18	150 Ø	BLIND FLANGE, 1034 kPa, FORGED STEEL, R.F., F.& D.	
19	100 Ø	BLIND FLANGE, 1034 kPa, FORGED STEEL, R.F., F.& D.	
20	75 Ø	BLIND FLANGE, 1034 kPa, FORGED STEEL, R.F., F.& D.	
21	50 Ø	BLIND FLANGE, 1034 kPa, FORGED STEEL, R.F., F.& D.	
22	25 Ø	BLIND FLANGE, 1034 kPa, FORGED STEEL, R.F., F.& D.	
23	150 Ø – 100 Ø	ECCENTRIC REDUCER, SMLS, C.S., B.W., SCH. 40	A234 GR. B
24	100 Ø – 75 Ø	ECCENTRIC REDUCER, SMLS, C.S., B.W., SCH. 40	
25	75 Ø – 50 Ø	ECCENTRIC REDUCER, SMLS, C.S., B.W., SCH. 40	
26	150 Ø	ELBOW, 90 deg., L.R., SMLS, C.S., B.W., SCH. 40	
27	100 Ø	ELBOW, 90 deg., L.R., SMLS, C.S., B.W., SCH. 40	
28	75 Ø	ELBOW, 90 deg., L.R., SMLS, C.S., B.W., SCH. 40	
29	50 Ø	ELBOW, 90 deg., L.R., SMLS, C.S., B.W., SCH. 40	
30	25 Ø	ELBOW, 90 deg., SOCKET WELD, FRG'D STEEL, 20680 kPa, SCH. 80	ASTM A350 GR. LF2
31	150 Ø	ELBOW, 45 deg., L.R., SMLS, C.S., B.W., SCH. 40	A234 GR. B
32	100 Ø	ELBOW, 45 deg., L.R., SMLS, C.S., B.W., SCH. 40	
33	75 Ø	ELBOW, 45 deg., L.R., SMLS, C.S., B.W., SCH. 40	
34	50 Ø	ELBOW, 45 deg., L.R., SMLS, C.S., B.W., SCH. 40	
35	150 Ø	STRAIGHT TEE, SMLS, C.S., B.W., SCH. 40	
36	100 Ø	STRAIGHT TEE, SMLS, C.S., B.W., SCH. 40	
37	75 Ø	STRAIGHT TEE, SMLS, C.S., B.W., SCH. 40	
38	50 Ø	STRAIGHT TEE, SMLS, C.S., B.W., SCH. 40	
39	100 Ø – 50 Ø	REDUCING TEE, SMLS, C.S., B.W., SCH. 40	
39a	100 Ø – 75 Ø	REDUCING TEE, SMLS, C.S., B.W., SCH. 40	
39b	150 Ø – 75 Ø	REDUCING TEE, SMLS, C.S., B.W., SCH. 40	
40	150 Ø	GATE VALVE, 1034 kPa, FORGED STEEL, R.F., FLEX. DISC., OS & Y. (SEE SPECS)	ASTM A350 GR. LCB
41	100 Ø	GATE VALVE, 1034 kPa, FORGED STEEL, R.F., FLEX. DISC., OS & Y. (SEE SPECS)	
42	75 Ø	GATE VALVE, 1034 kPa, FORGED STEEL, R.F., FLEX. DISC., OS & Y. (SEE SPECS)	
43	50 Ø	GATE VALVE, 1034 kPa, FORGED STEEL, R.F., FLEX. DISC., OS & Y. (SEE SPECS)	
45	150 Ø	CHECK VALVE, 1034 kPa, FORGED STEEL, R.F., (SEE SPECS)	
46	100 Ø	CHECK VALVE, 1034 kPa, FORGED STEEL, R.F., (SEE SPECS)	
47	75 Ø	CHECK VALVE, 1034 kPa, FORGED STEEL, R.F., (SEE SPECS)	
48	50 Ø	CHECK VALVE, 1034 kPa, FORGED STEEL, R.F., (SEE SPECS)	
49	25 Ø	CHECK VALVE, 1034 kPa, FORGED STEEL, R.F., (SEE SPECS)	

50	50 Ø	2 WAY SOLENOID VALVE, FLANGED S.S. BODY, c/w S.S. INTERNALS SUITABLE FOR PETROLEUM PRODUCTS, NORMALLY CLOSED, EXPLOSION PROOF, GROUP D, 120 V 60 Hz, 12 NTP CONDUIT HOUSING	SNAP–TITE SEE SPECS
51	150 Ø	FLEXIBLE CONNECTOR, 309 LG, FLG'D, 1034 kPa, F.S., R.F., S.S. METAL HOSE, DOUBLE BRAIDED, TYPE RF–45	SEE SPECS
52	100 Ø	FLEXIBLE CONNECTOR, 309 LG, FLG'D, 1034 kPa, F.S., R.F., S.S. METAL HOSE, DOUBLE BRAIDED, TYPE RF–45	
53	75 Ø	FLEXIBLE CONNECTOR, 309 LG, FLG'D, 1034 kPa, F.S., R.F., S.S. METAL HOSE, DOUBLE BRAIDED, TYPE RF–81	
54	50 Ø	FLEXIBLE CONNECTOR, 309 LG, FLG'D, 1034 kPa, F.S., R.F., S.S. METAL HOSE, DOUBLE BRAIDED, TYPE RF–81	
55			
56			
57	100 Ø	KAMLOK ADAPTOR, OPW NO. 633–F, HOSE TO PIPE, MALE NPT, STAINLESS STEEL, C/W 634–BK CAP	
58			
59	75 Ø	KAMLOK ADAPTOR, OPW NO. 633–F, HOSE TO PIPE, MALE NPT, STAINLESS STEEL, C/W 634–BK CAP	
60	100 Ø	STRAINER FLG'D, R.F., 1034 kPa, FAB. STL. HOUSING, ALL IRON TRIM, DRAIN PLUG, A.O. SMITH MODEL #22–E3 EXPANDED STEEL OUTER BASKET, & 40 MESH S.S. INNER BASKET FOR GASOLINE OR JET A–1 SERVICE	
61	75 Ø	STRAINER FLG'D, R.F., 1034 kPa, FAB. STL. HOUSING, ALL IRON TRIM, DRAIN PLUG, A.O. SMITH MODEL #22–E3 EXPANDED STEEL OUTER BASKET, & 40 MESH S.S. INNER BASKET FOR GASOLINE OR JET A–1 SERVICE	
62	50 Ø	STRAINER FLG'D, R.F., 1034 kPa, FAB. STL. HOUSING, ALL IRON TRIM, DRAIN PLUG, A.O. SMITH MODEL #22–E3 EXPANDED STEEL OUTER BASKET, & 40 MESH S.S. INNER BASKET FOR GASOLINE OR JET A–1 SERVICE	
63	25 Ø	THERMAL PRESSURE RELIEF VALVE, EMCO–WHEATON MODEL E–0153, THREADED ENDS, PRESET AT 517 kPa (75 P.S.I.)	
64	25 Ø	THERMAL PRESSURE RELIEF VALVE, EMCO–WHEATON MODEL E–0153, THREADED ENDS, PRESET AT 172 kPa (25 P.S.I.)	
65	25 Ø	HALF COUPLING, FRG'D STEEL, 20680 kPa, SOCKET WELD, SCHED. 80	ASTM A350 GR. LF2
66	25 Ø	HALF COUPLING, FRG'D STEEL, 20680 kPa, SCREWED, SCHED. 80	
67	150 Ø	GASKET, 1034 kPa, 1.6 THICK FLAT RING TYPE	JOHN CRANE STYLE 2160
68	100 Ø	GASKET, 1034 kPa, 1.6 THICK FLAT RING TYPE	SEE SPECS
69	75 Ø	GASKET, 1034 kPa, 1.6 THICK FLAT RING TYPE	
70	50 Ø	GASKET, 1034 kPa, 1.6 THICK FLAT RING TYPE	
71	25 Ø	GASKET, 1034 kPa, 1.6 THICK FLAT RING TYPE	
72	12 Ø x 65 lg	STUD BOLTS, ALLOY STEEL	ASTM A320 GR. L7
73	16 Ø x 76 lg	STUD BOLTS, ALLOY STEEL	
74	16 Ø x 89 lg	STUD BOLTS, ALLOY STEEL	
75	19 Ø x 94 lg	STUD BOLTS, ALLOY STEEL	
76	12 Ø	NUTS, SEMI FINISHED, HEXAGONAL, ALLOY STEEL	ASTM A194 GR. 4
77	16 Ø	NUTS, SEMI FINISHED, HEXAGONAL, ALLOY STEEL	
78	19 Ø	NUTS, SEMI FINISHED, HEXAGONAL, ALLOY STEEL	
79	38 Ø	BREAK AWAY AUTOMATIC SHUT OFF, OPW MODEL 10BF–5725 C/W OPW 10S STABILIZER BAR ASSEMBLY	SEE SPECS




© Copyright Reserved 2011 by FSC Architects & Engineers
The information contained in this drawing is copyright and has been prepared for the sole purpose of the project described herein and for the sole benefit of the Owner. Any unauthorized use of this information will be considered a breach of copyright and may be pursued as such. Use of this information for any purpose other than the project described herein is at the sole risk of the user.

Record Drawing

These drawings have been prepared based on information provided by Inukshuk Construction with a construction completion date of 20.02.2014. Stantec has not verified the accuracy and/or completeness of this information and shall not be responsible for any errors or omissions which may be incorporated herein as a result.

03	RECORD DRAWINGS	2013/11/01
02	ISSUED FOR TENDER	2011/06/08
01	ISSUED FOR 95% REVIEW	2011/03/25
00	ISSUED FOR 50% REVIEW	2011/02
NO.	REVISION DESCRIPTION	DATE ISSUED

PROFESSIONAL SEAL / PERMIT TO PRACTICE

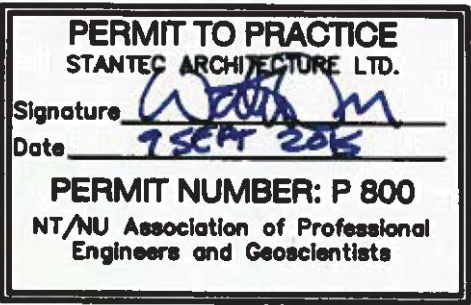

PROJECT TITLE

FUEL STORAGE
FACILITY
UPGRADES

LOCATION

CHESTERFIELD INLET, NU

DRAWING TITLE

PIPING BILL OF
MATERIALS

DRAWN BY	AF	SCALE	AS NOTED
CHECKED BY	WO	CLIENT PROJECT NO.	10-3018

FSC PROJECT NO.	2010-1160
-----------------	-----------

DRAWING NO.	M7	of 45
-------------	----	-------

D

A


5

4


3

2

1

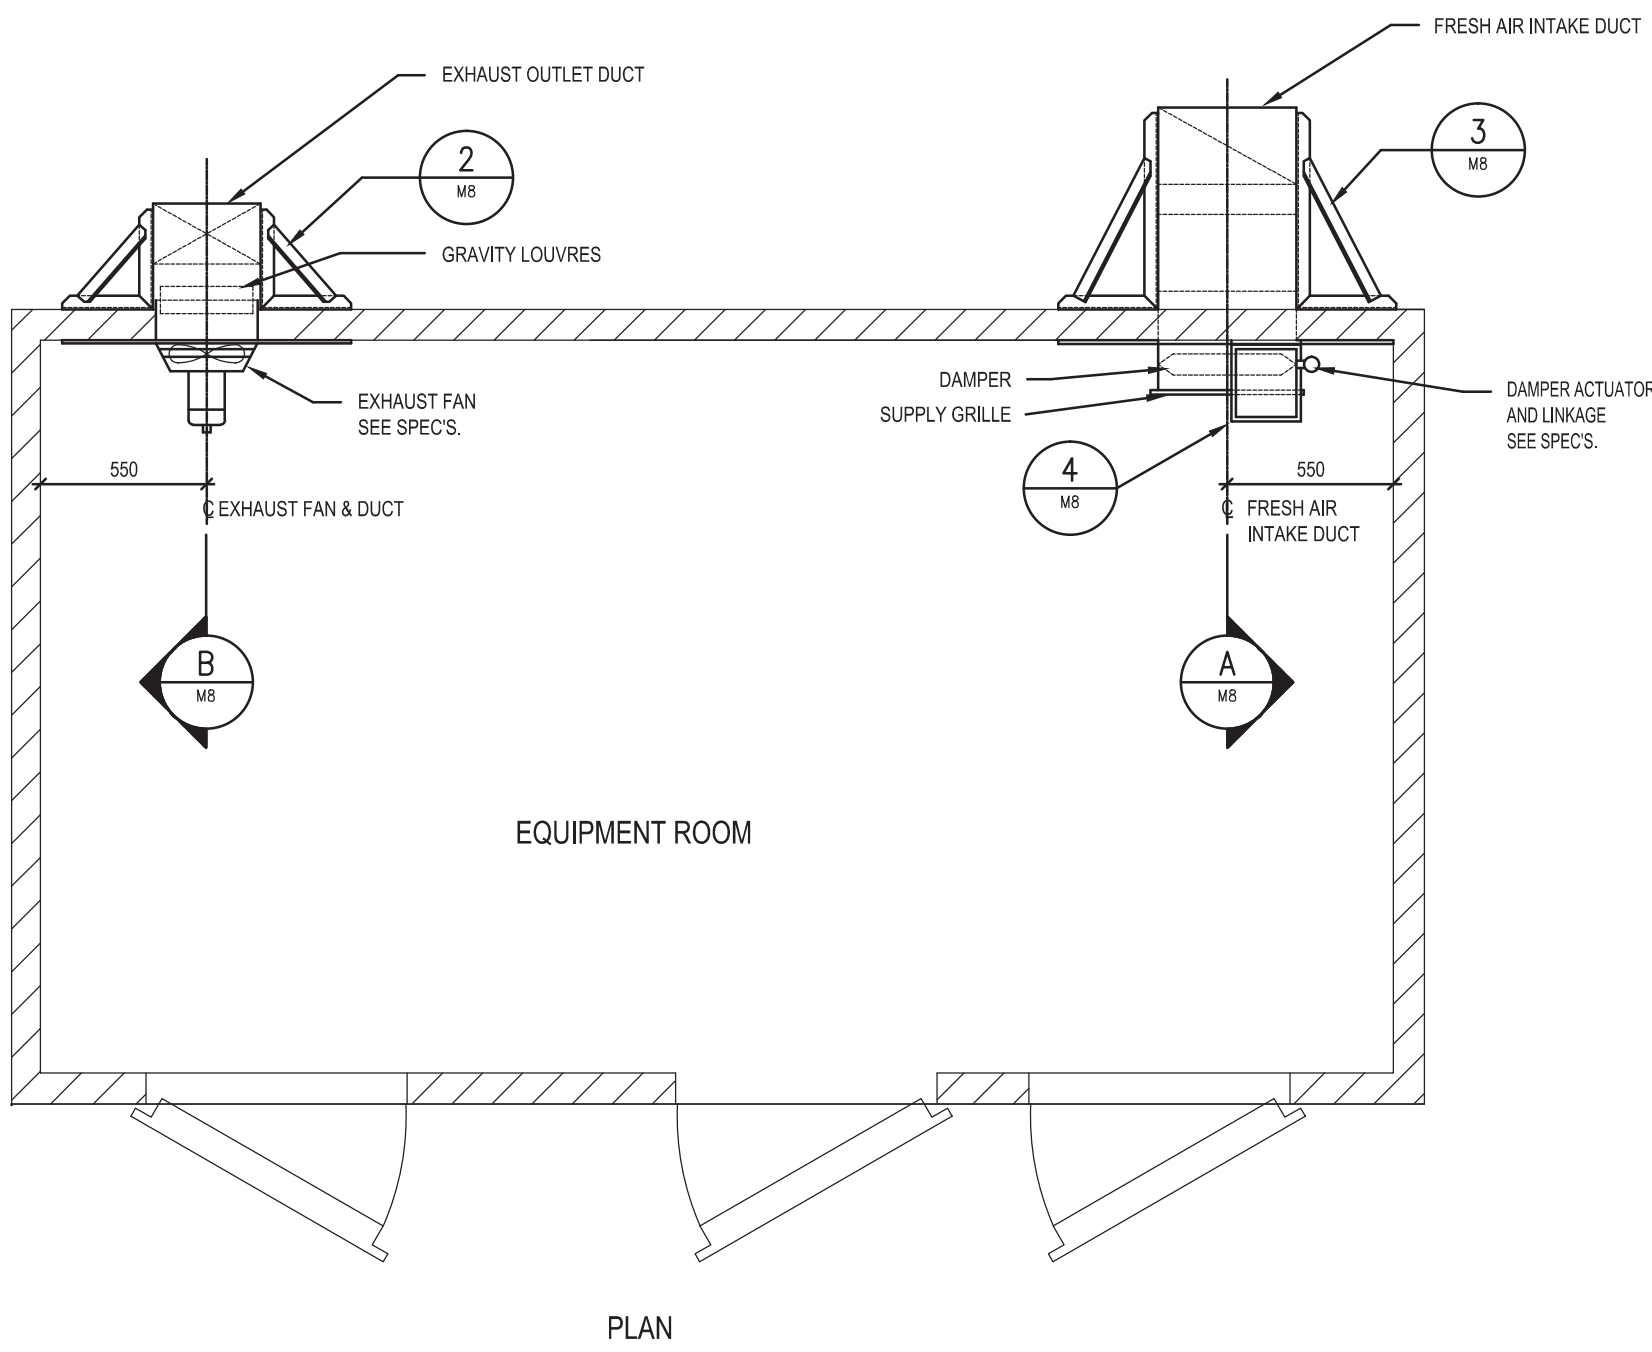


1 M8 1:25
DETAIL

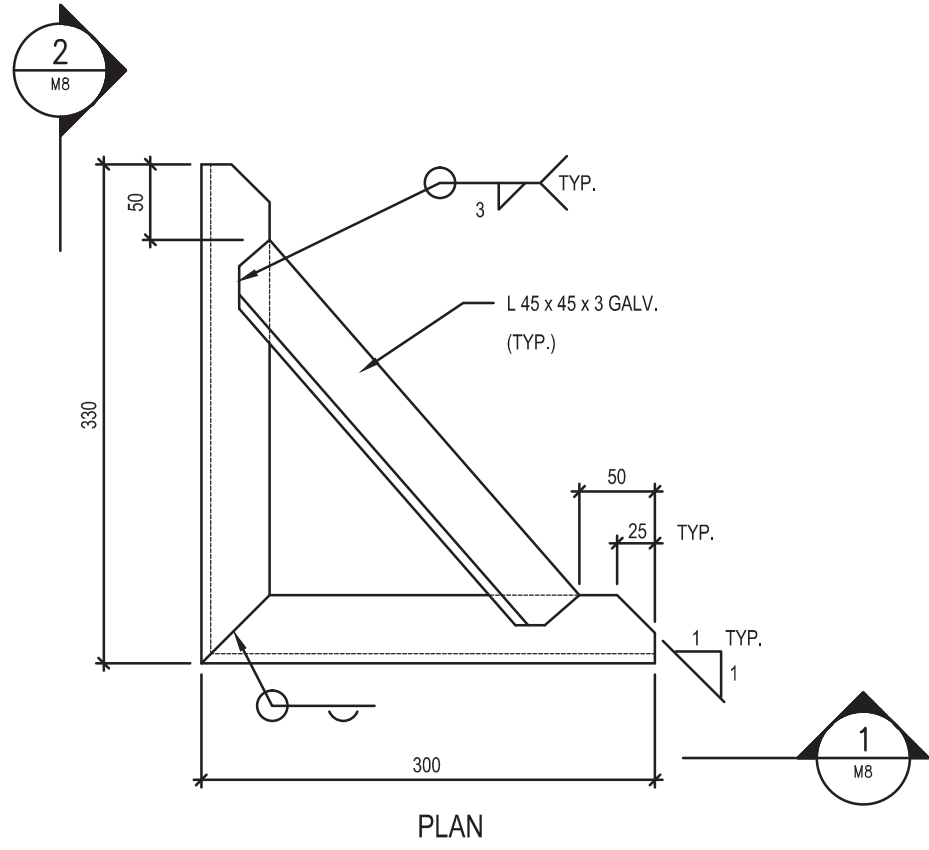





2 M8 1:5
DETAIL - BRACKET TYPE "A"

(RIGHT HAND SHOWN - ONE EACH HAND REQ'D)

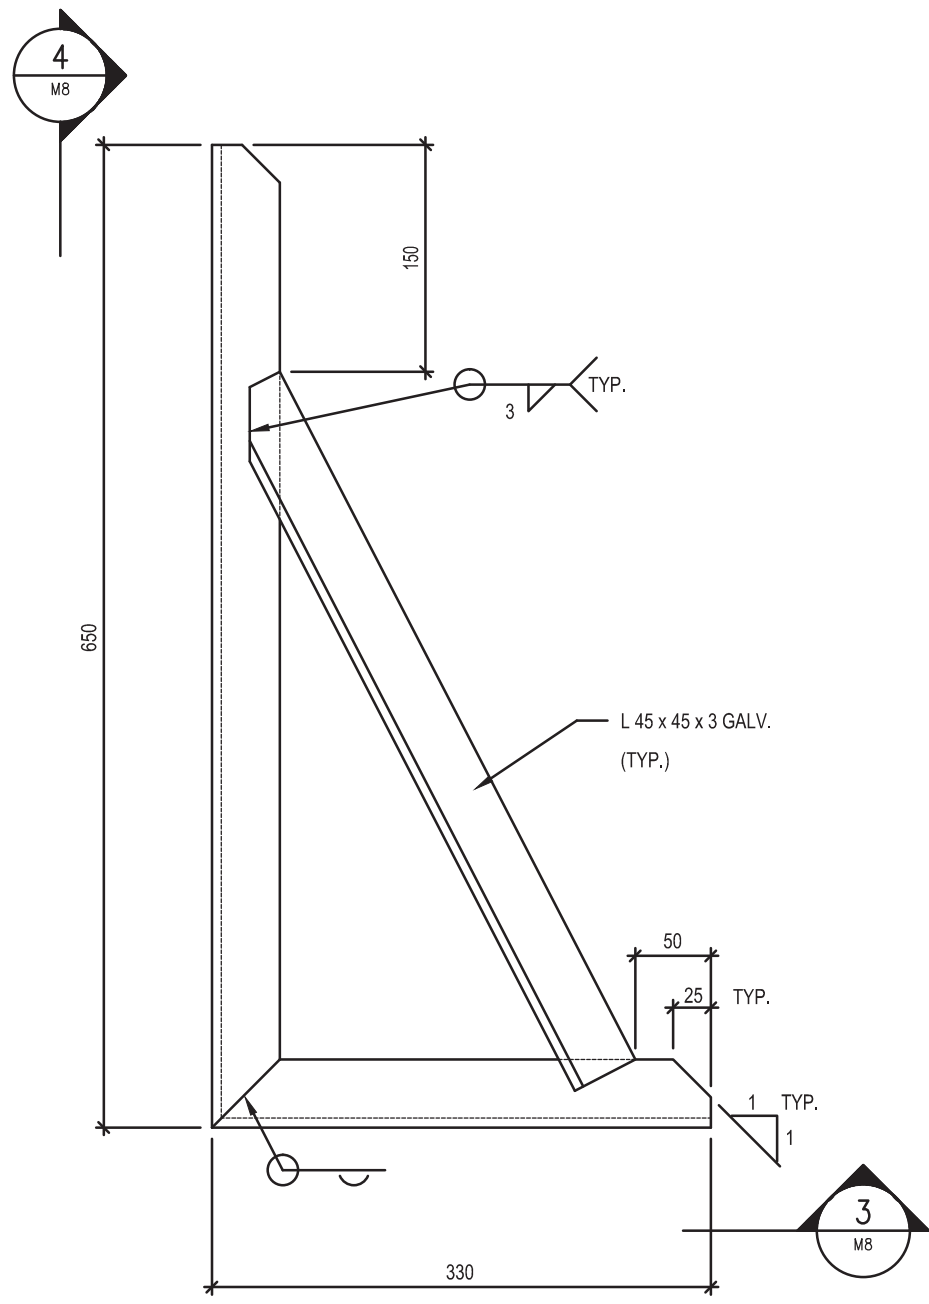


3 M8 1:5
DETAIL - BRACKET TYPE "B"

(RIGHT HAND SHOWN - ONE EACH HAND REQ'D)

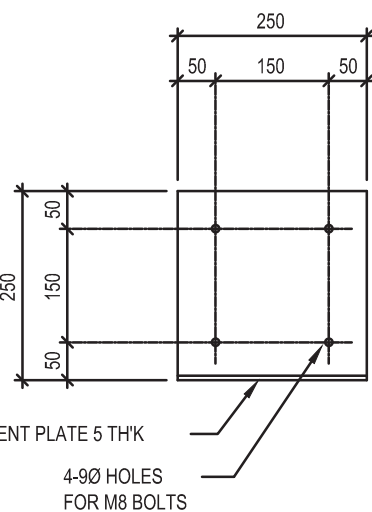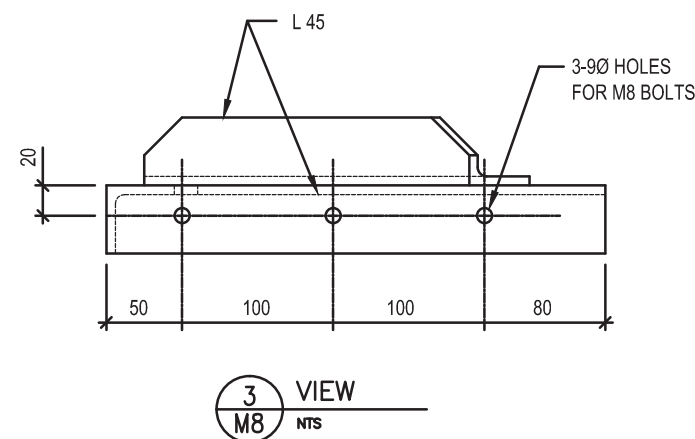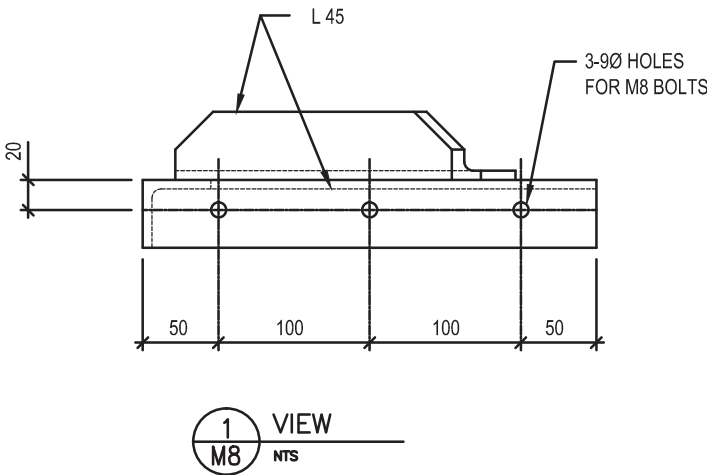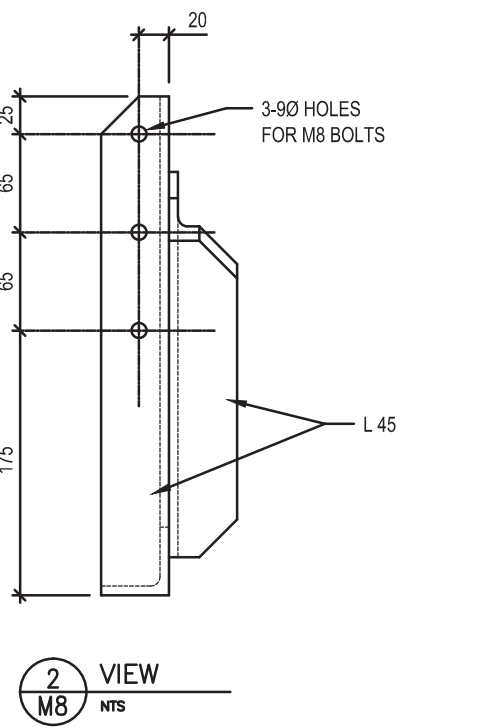





FRONT

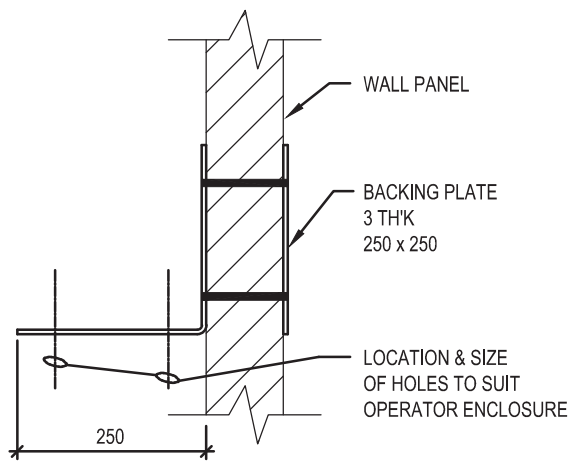

ELEVATION

4 M8 1:10
DETAIL - BRACKET FOR DAMPER OPERATOR

SPLIT FRAME ISOMETRIC AT WALL
(TYPICAL AT INTAKE & EXHAUST DUCTS)

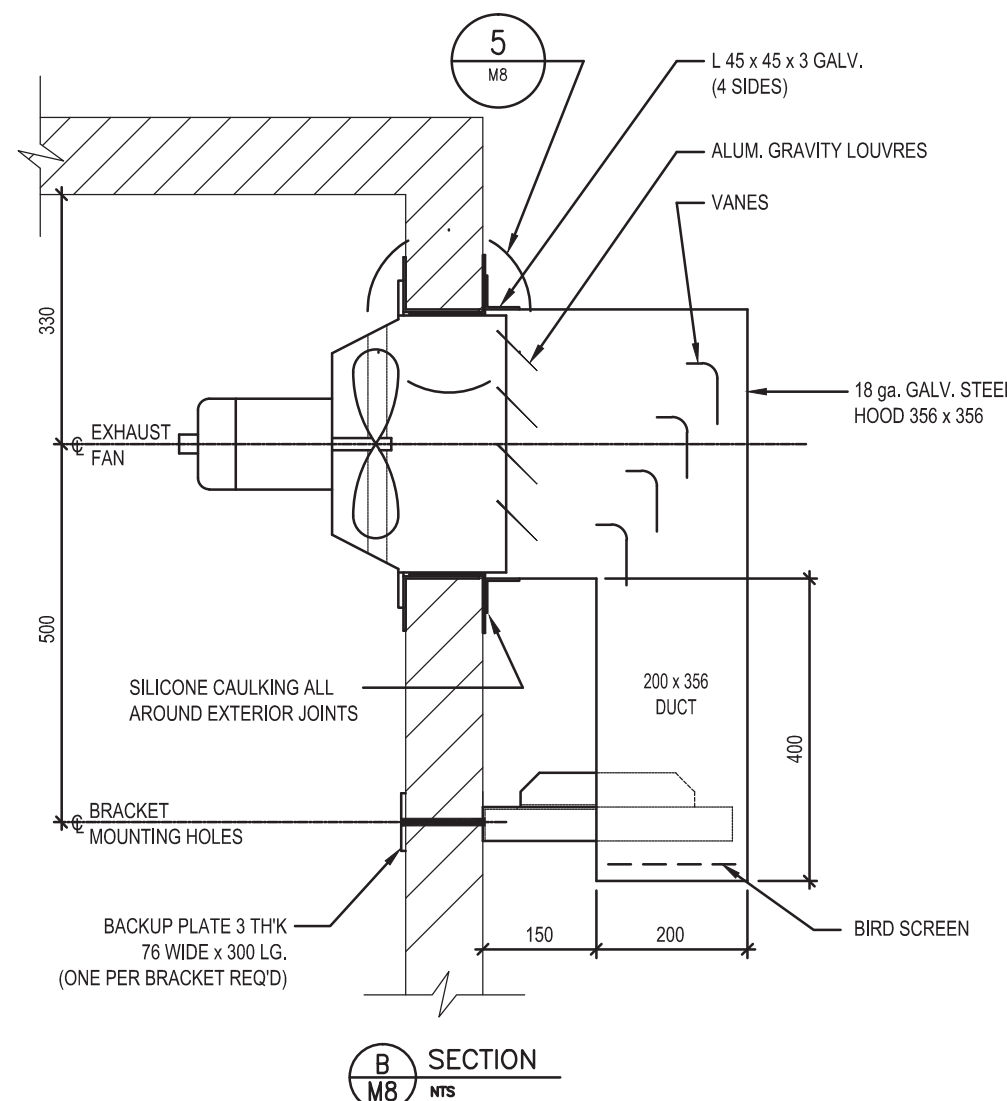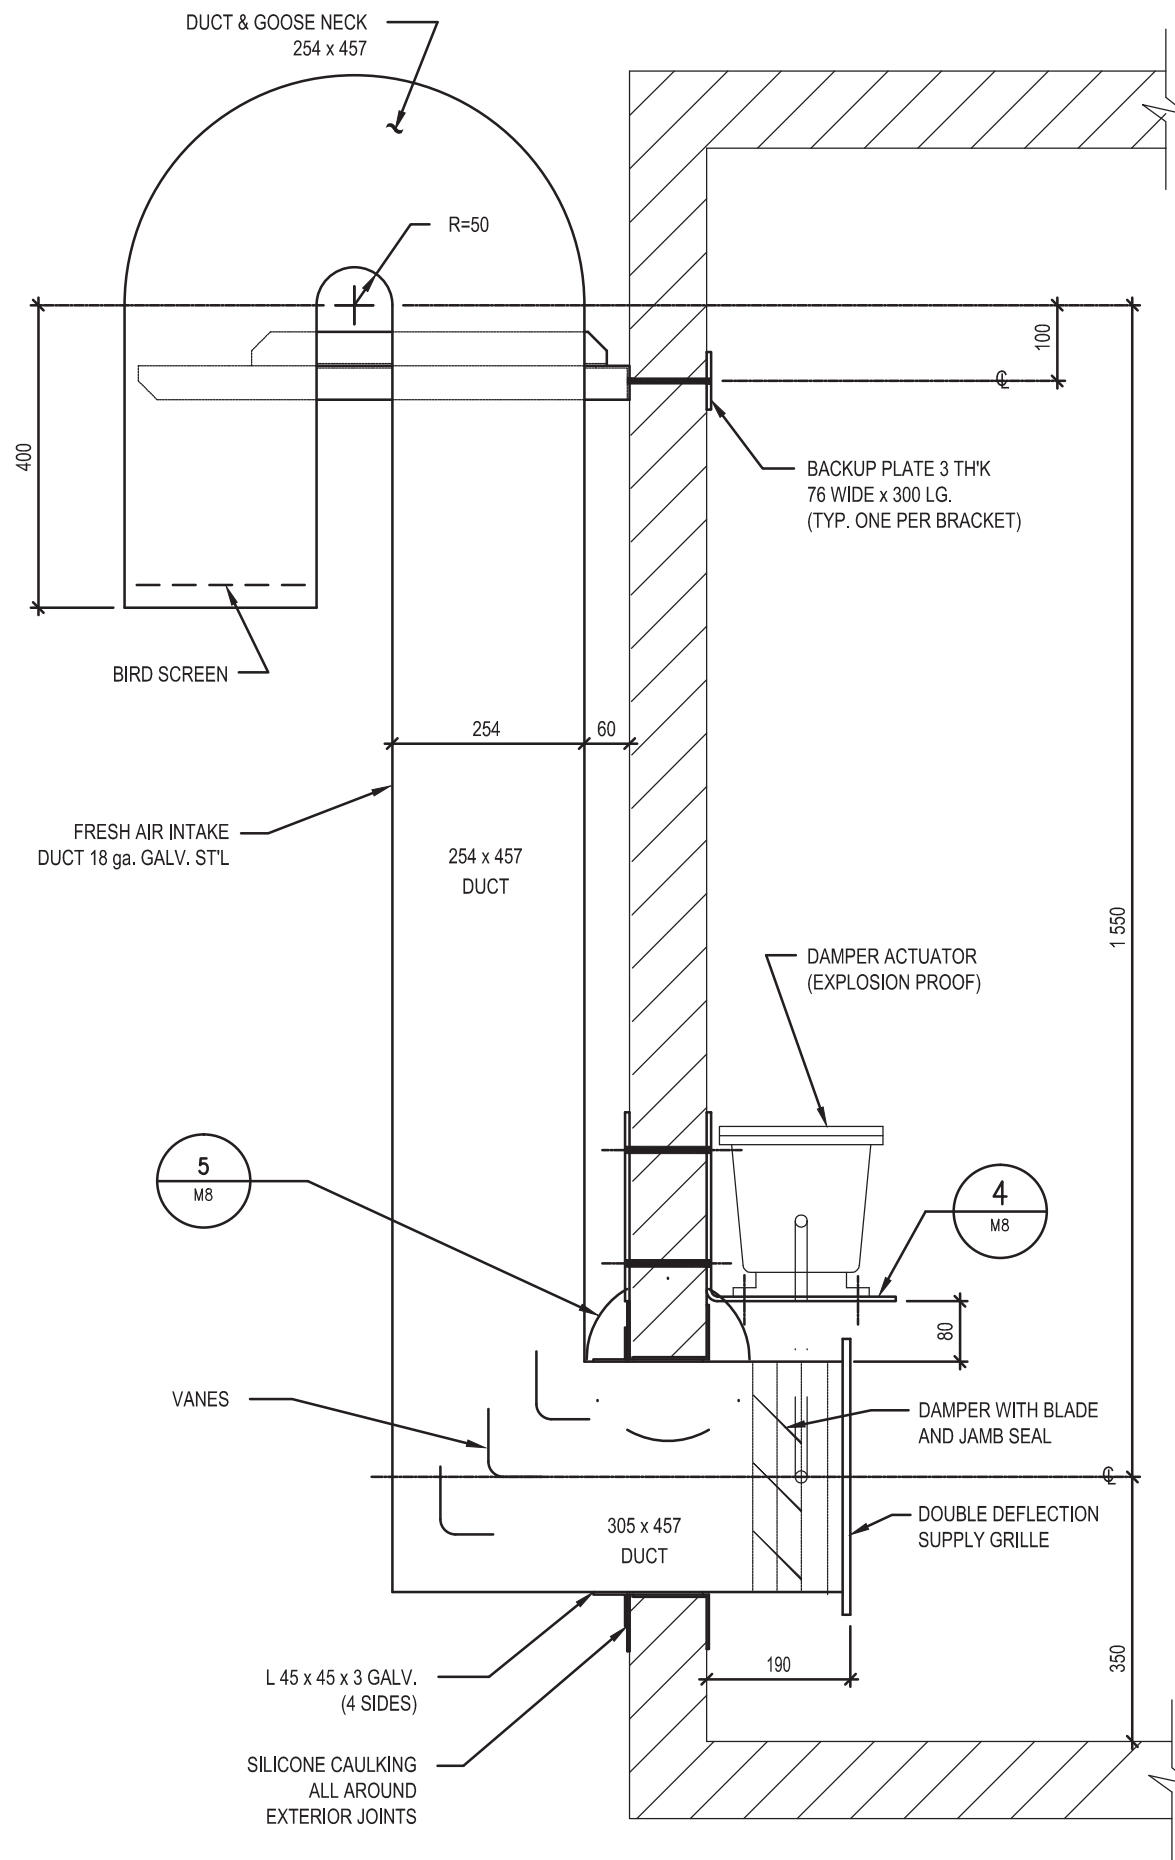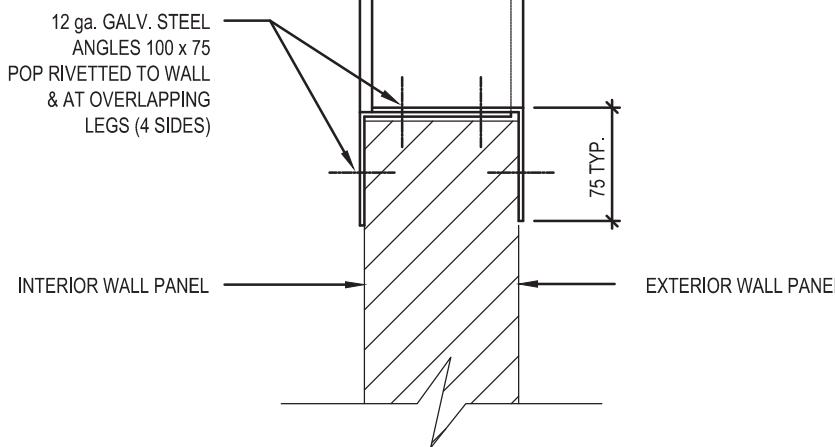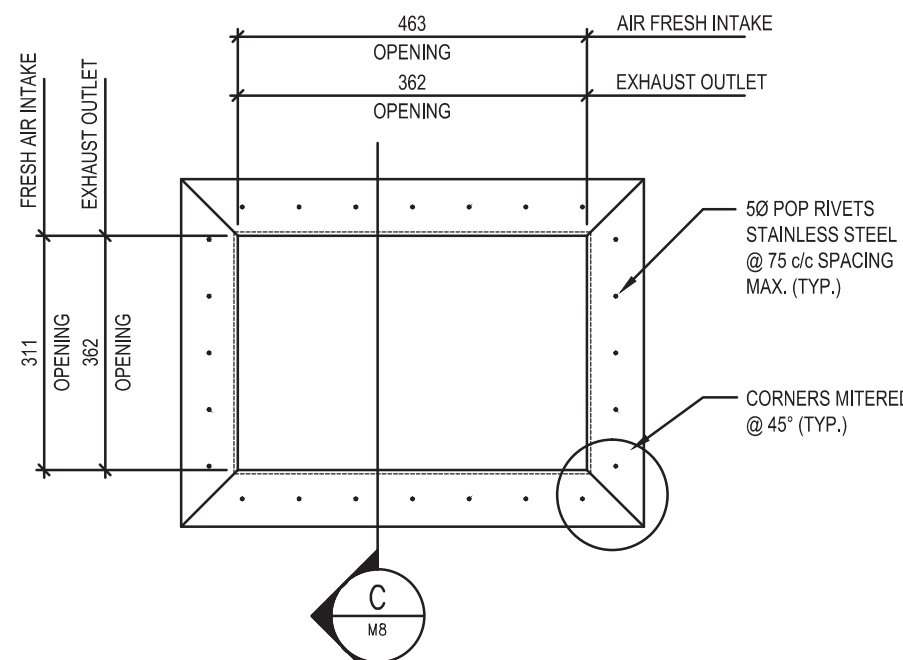



© Copyright Reserved 2011 by FSC Architects & Engineers
The information contained in this drawing is copyright and has been prepared for the sole purpose of the project described herein and for the sole benefit of the Owner. Any unauthorized use of this information will be considered a breach of copyright and may be pursued as such. Use of this information for any purpose other than the project described herein is at the sole risk of the user.

Record Drawing

These drawings have been prepared based on information provided by Inukshuk Construction with a construction completion date of 2012/2014. Stantec has not verified the accuracy and/or completeness of this information and shall not be responsible for any errors or omissions which may be incorporated herein as a result.

NO.	REVISION DESCRIPTION	DATE ISSUED
03	RECORD DRAWINGS	2013/11/01
02	ISSUED FOR TENDER	2011/06/08
01	ISSUED FOR 95% REVIEW	2011/03/25
00	ISSUED FOR 50% REVIEW	2011/02

PROFESSIONAL SEAL / PERMIT TO PRACTICE

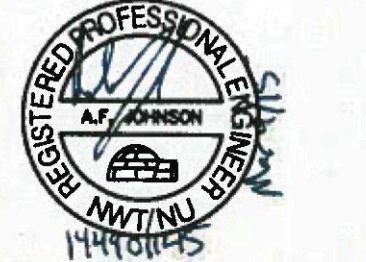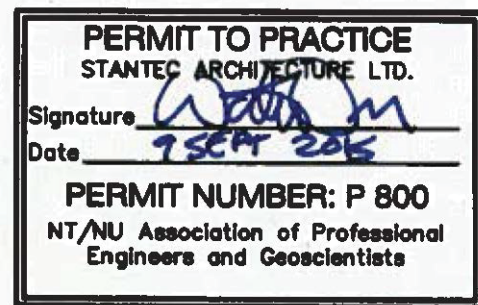

FSC
ARCHITECTS & ENGINEERS
Unit C, 1088 Mivvik Street, Box 1779
Iqaluit, NU, X0A 0H0, Canada
T 867.979.0555 | F 867.979.5711

PROJECT TITLE

FUEL STORAGE FACILITY UPGRADES

LOCATION

CHESTERFIELD INLET, NU

DRAWING TITLE

LSDL/GASOLINE DISPENSER BUILDING VENTILATION PLAN, SECTIONS, AND DETAILS

DRAWN BY

AF

SCALE

AS NOTED

CHECKED BY

WO

CLIENT PROJECT NO.

10-3018

FSC PROJECT NO.

2010-1160

DRAWING NO.


M8

OF 45

D

100mm
90
80
70
60
50
40
30
20
10
0

A

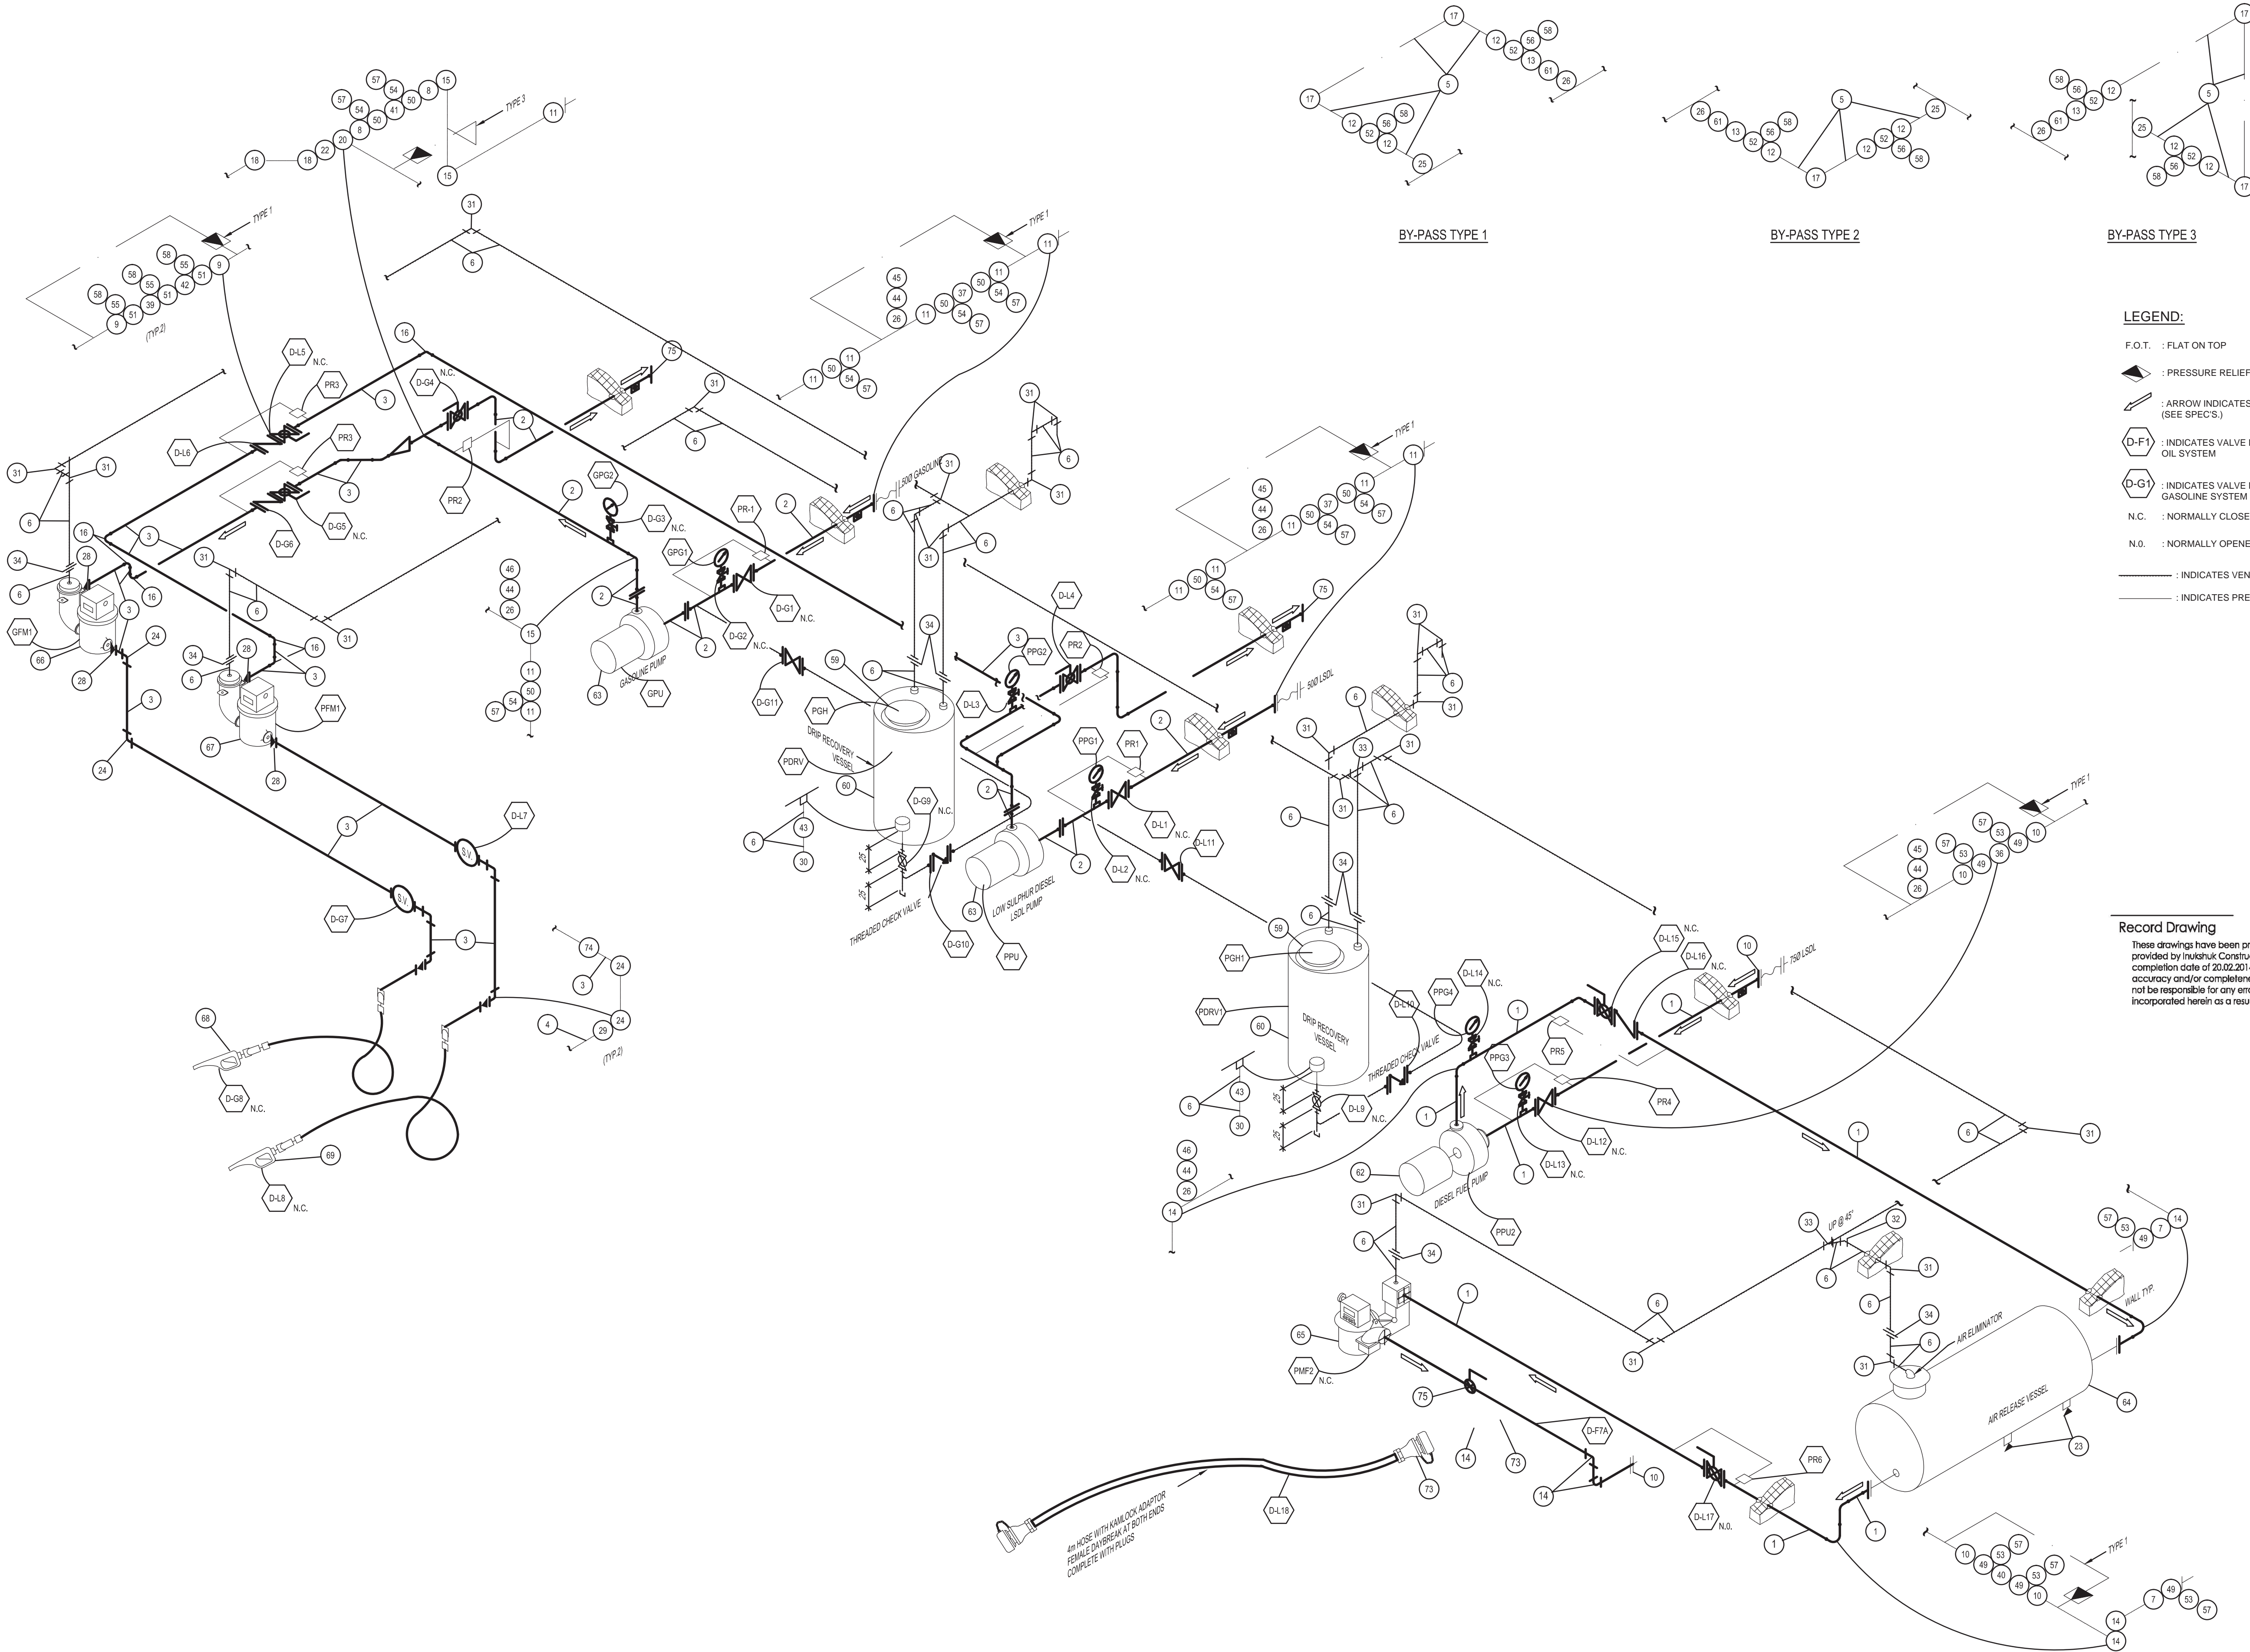

SCHEMATIC ISOMETRIC GASOLINE & DIESEL FUEL DISPENSING SYSTEMS

(NO SCALE)

BY-PASS TYPE 1

BY-PASS TYPE 2

BY-PASS TYPE 3

LEGEND:

F.O.T. : FLAT ON TOP

▲ : PRESSURE RELIEF VALVE

→ : ARROW INDICATES DIRECTION OF FLOW (SEE SPEC'S.)

D-F1 : INDICATES VALVE NUMBER ON P-50 FUEL OIL SYSTEM

D-G1 : INDICATES VALVE NUMBER ON GASOLINE SYSTEM

N.C. : NORMALLY CLOSED

N.O. : NORMALLY OPENED

— : INDICATES VENT PIPING LINE.

— : INDICATES PRESSURE RELIEF LINE.

Record Drawing

These drawings have been prepared based on information provided by Inukshuk Construction with a construction completion date of 20.02.2014. Stantec has not verified the accuracy and/or completeness of this information and shall not be responsible for any errors or omissions which may be incorporated herein as a result.




© Copyright Reserved 2011 by FSC Architects & Engineers
The information contained in this drawing is copyright and has been prepared for the sole purpose of the project described herein and for the sole benefit of the Owner. Any unauthorized use of this information will be considered a breach of copyright and may be pursued as such. Use of this information for any purpose other than the project described herein is at the sole risk of the user.

NOTES:

- FOR DESCRIPTION OF CIRCLED NUMBERS REFER TO DRAWING M11.
- NOZZLE AND DRY-BREAK ADAPTER ASSEMBLY TO BE REMOVED AFTER SHOP TESTING, SHIPPED WITH DISPENSER AND REINSTALLED IN FIELD AS DIRECTED.
- THERMAL PRESSURE TO BE RELIED IN DIRECTION OF ARROW (TOWARDS STORAGE TANKS). FOR PRESSURE SETTING OF PRESSURE RELIEF VALVES REFER TO SPECIFICATION.
- ALL DIMENSIONS ARE SHOWN IN MILLIMETRES
- WELDING TO CONFORM TO CAN/CSA-B51-M, BOILER, PRESSURE VESSEL AND PIPING PRESSURE CODE. ALL ELECTRODES TO BE E70XX. SEE SPEC'S
- FOR PAINTING, REFER TO SPECIFICATIONS
- SUPPLY AND INSTALL ARROWS ON PIPES SHOWING DIRECTION OF FLOW, REFER TO SPECIFICATIONS.
- SEE LSDL/GAS DISPENSER BUILDING BILL OF MATERIALS DRAWING M8.

NO.	REVISION DESCRIPTION	DATE ISSUED
03	RECORD DRAWINGS	2013/11/01
02	ISSUED FOR TENDER	2011/06/08
01	ISSUED FOR 95% REVIEW	2011/03/25
00	ISSUED FOR 50% REVIEW	2011/02

PROFESSIONAL SEAL / PERMIT TO PRACTICE

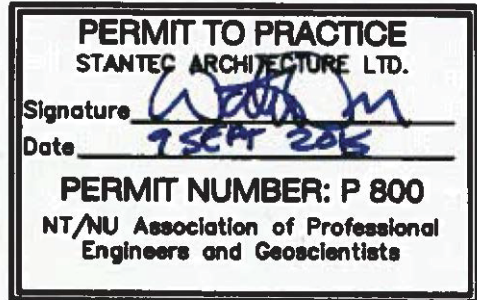

FSC
ARCHITECTS & ENGINEERS
Unit C, 1088 Mivvik Street, Box 1779
Iqaluit, NU, X0A 0H0, Canada
T 867.979.0555 | F 867.979.5711


PROJECT TITLE
FUEL STORAGE FACILITY UPGRADES
LOCATION
CHESTERFIELD INLET, NU
DRAWING TITLE
LSDL/GASOLINE DISPENSER BUILDING PIPING ISOMETRIC

DRAWN BY AF	SCALE AS NOTED
CHECKED BY WO	CLIENT PROJECT NO. 10-3018
FSC PROJECT NO. 2010-1160	
DRAWING NO. M10	


D

100mm
90
80
70
60
50
40
30
20
10
0


A

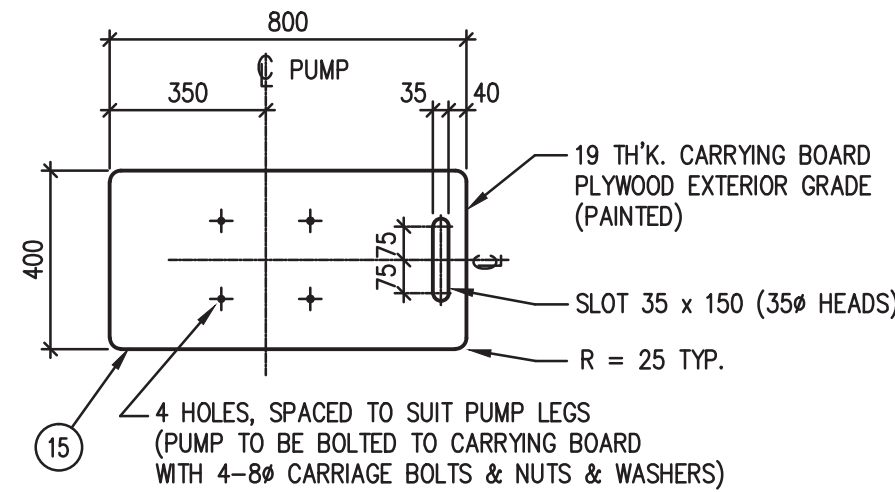

DETAIL - 2 PUMP CARRYING BOARD

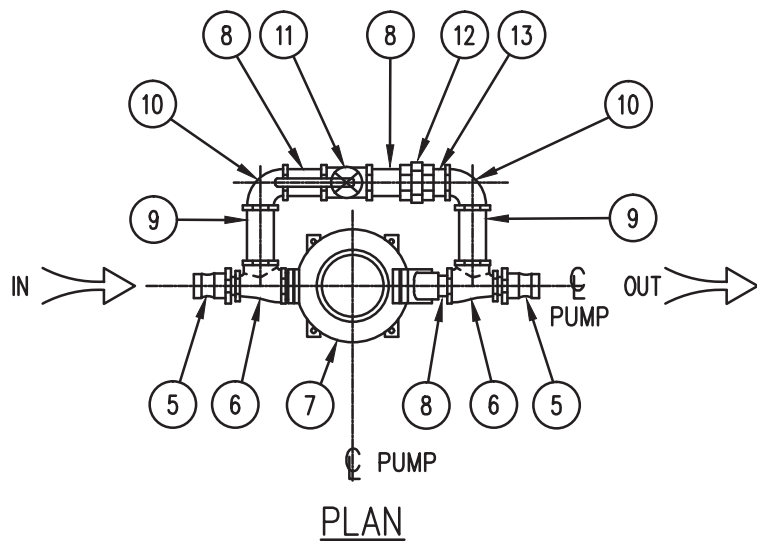

PLAN

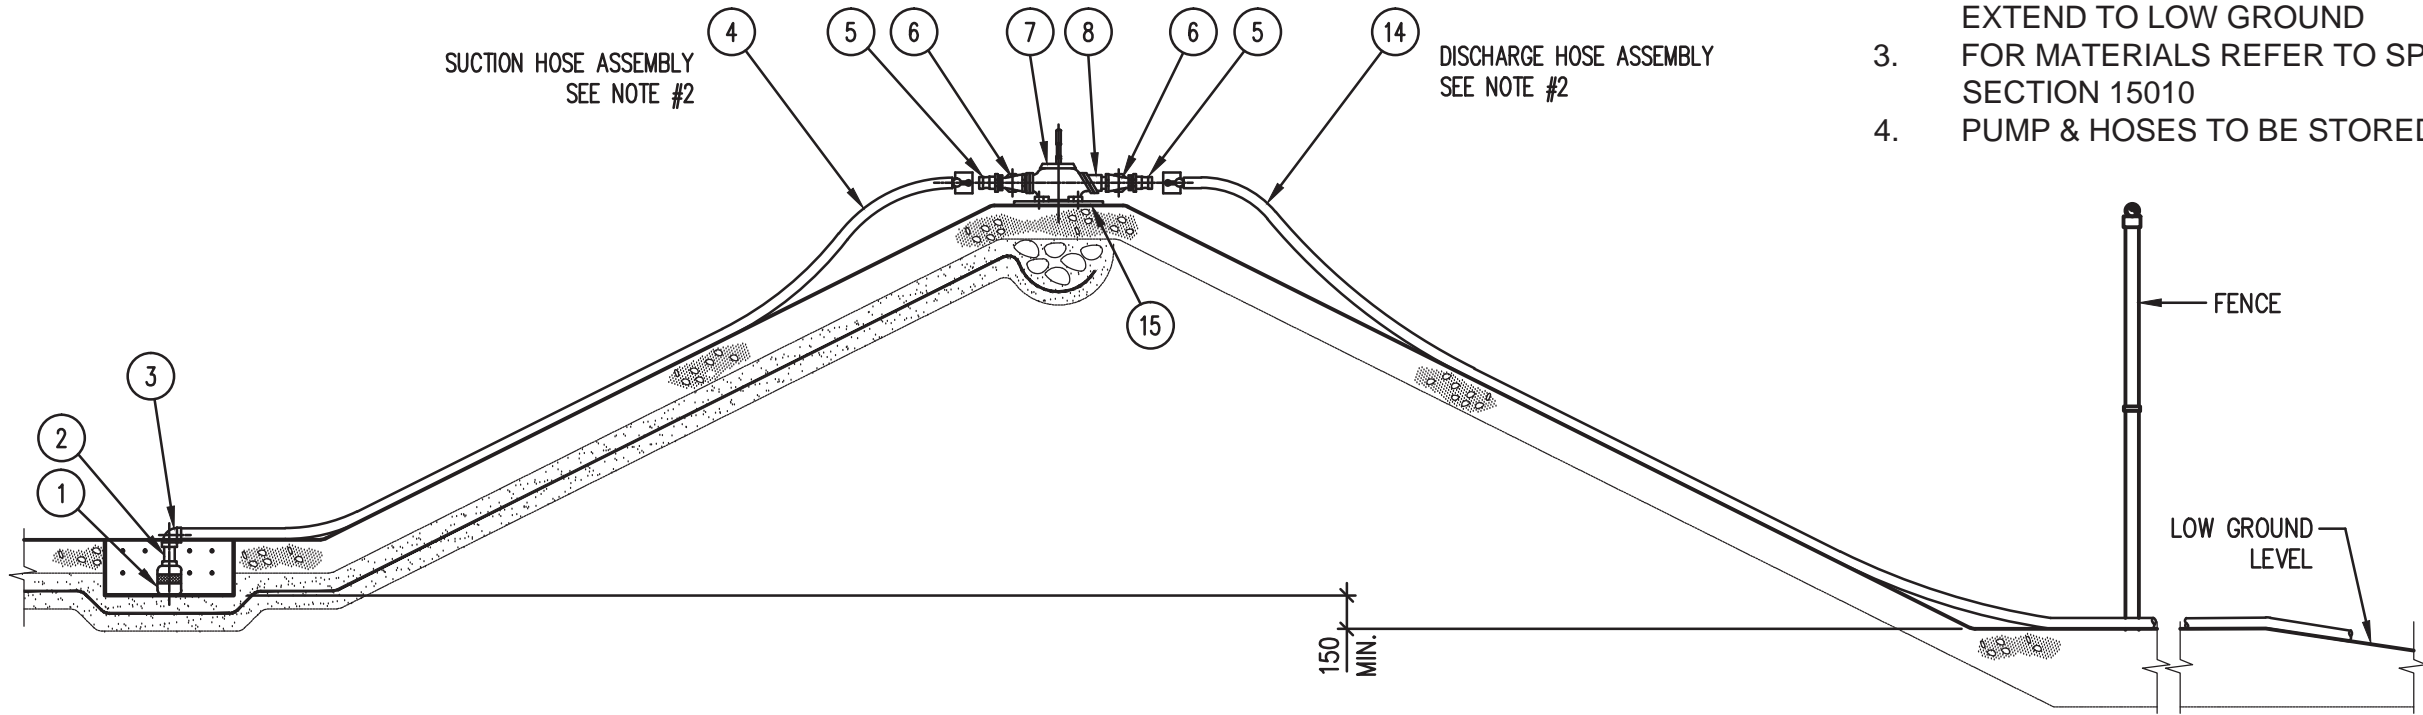

DETAIL - 1 DIKE DRAIN PUMP ASSEMBLY INSTALLATION

LIST OF MATERIAL FOR DIKE DRAIN PUMP ASSEMBLY *		
ITEM	SIZE (S.I.)	DESCRIPTION
1	50#	SUCTION STUB STRAINER.
2	50# x 100 LG.	WELDED STEEL PIPE NIPPLE, THREADED ENDS, GALV'D.
3	50#	ELBOW 90°, M. I. GALV'D. THR'D.
4		SUCTION HOSE ASSEMBLY (SEE NOTE #2) & SPEC'S.
5		OPW KAMLOK #633-F ADAPTER.
6	50# x 50# x 50#	THREADED TEE, WITH ONE END OF RUN REDUCED, M. I. GALV'D.
7	50# x 50#	PROTEK DIAPHRAGM PUMP.
8	50# x 100 Lg.	WELDED STEEL PIPE NIPPLE, THREADED ENDS, GALV'D.
9	50# x 200 LG.	WELDED STEEL PIPE NIPPLE, THREADED ENDS, GALV'D.
10	50#	ELBOW 90°, M. I. THR'D. GALV'D.
11	50#	BALL VALVE, BRONZE, TH'D ENDS, FEMALE NPT
12	50#	UNION, M. I., CLASS 300 THR'D. GALV'D.
13	50# x TO SUIT	PIPE, ERW, GALV'D. THR'D.
14	50#	DISCHARGE HOSE ASSEMBLY (SEE NOTE #2) & SPEC'S.
15	-	PUMP CARRYING BOARD, SEE DETAIL-2

* FOR DESCRIPTION OF ITEMS SEE SPEC'S.

NOTES:

1. UNLESS OTHERWISE INDICATED ONE DIKE DRAIN PUMP ASSEMBLY TO BE PROVIDED
2. FOR LENGTH OF SUCTION & DISCHARGE HOSES REFER TO MECHANICAL & CIVIL DRAWINGS. DISCHARGE HOSE SHALL EXTEND TO LOW GROUND
3. FOR MATERIALS REFER TO SPECIFICATIONS, DIVISION 15, SECTION 15010
4. PUMP & HOSES TO BE STORED INDOORS WHEN NOT USED




© Copyright Reserved 2011 by FSC Architects & Engineers
The information contained in this drawing is copyright and has been prepared for the sole purpose of the project described herein and for the sole benefit of the Owner. Any unauthorized use of this information will be considered a breach of copyright and may be pursued as such. Use of this information for any purpose other than the project described herein is at the sole risk of the user.

Record Drawing

These drawings have been prepared based on information provided by Inukshuk Construction with a construction completion date of 20.02.2014. Stantec has not verified the accuracy and/or completeness of this information and shall not be responsible for any errors or omissions which may be incorporated herein as a result.

NO.	REVISION DESCRIPTION	DATE ISSUED
03	RECORD DRAWINGS	2013/11/01
02	ISSUED FOR TENDER	2011/06/08
01	ISSUED FOR 95% REVIEW	2011/03/25
00	ISSUED FOR 50% REVIEW	2011/02

PROFESSIONAL SEAL / PERMIT TO PRACTICE

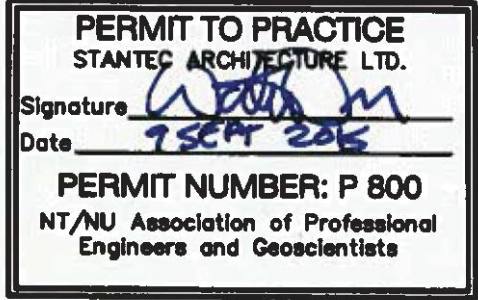

PROJECT TITLE

FUEL STORAGE FACILITY UPGRADES

LOCATION

CHESTERFIELD INLET, NU

DRAWING TITLE

DRAIN DYKE DETAILS

DRAWN BY	AF	SCALE	AS NOTED
CHECKED BY	WO	CLIENT PROJECT NO.	10-3018

FSC PROJECT NO. 2010-1160

DRAWING NO.

M14

of 45