




Drawn By: P.A.F.	Approved By: J.M.	Project No: 350600-508
Date: NOV. 2015	Scale: 1:3500	Drawing No: FIGURE 4


FIGURE 5A

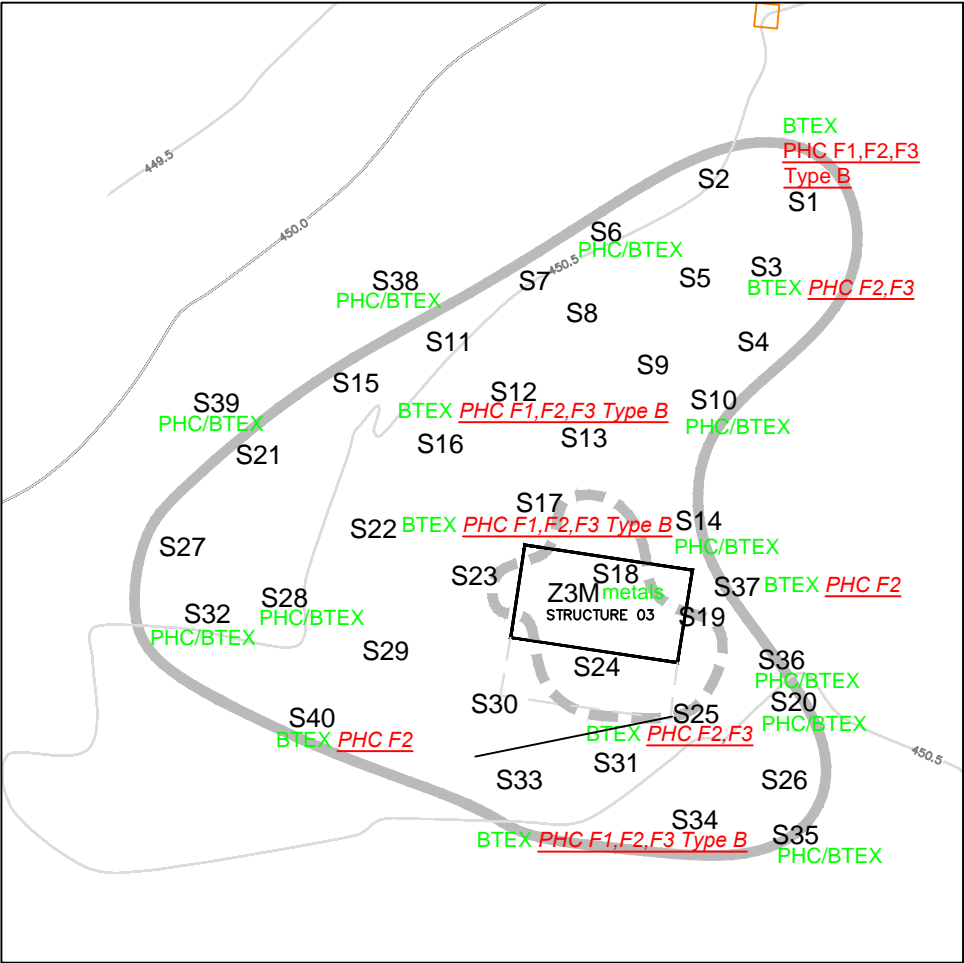

SOIL IMPACT ZONE 3 (Original sample level)

SCALE: 1:400


FIGURE 5B

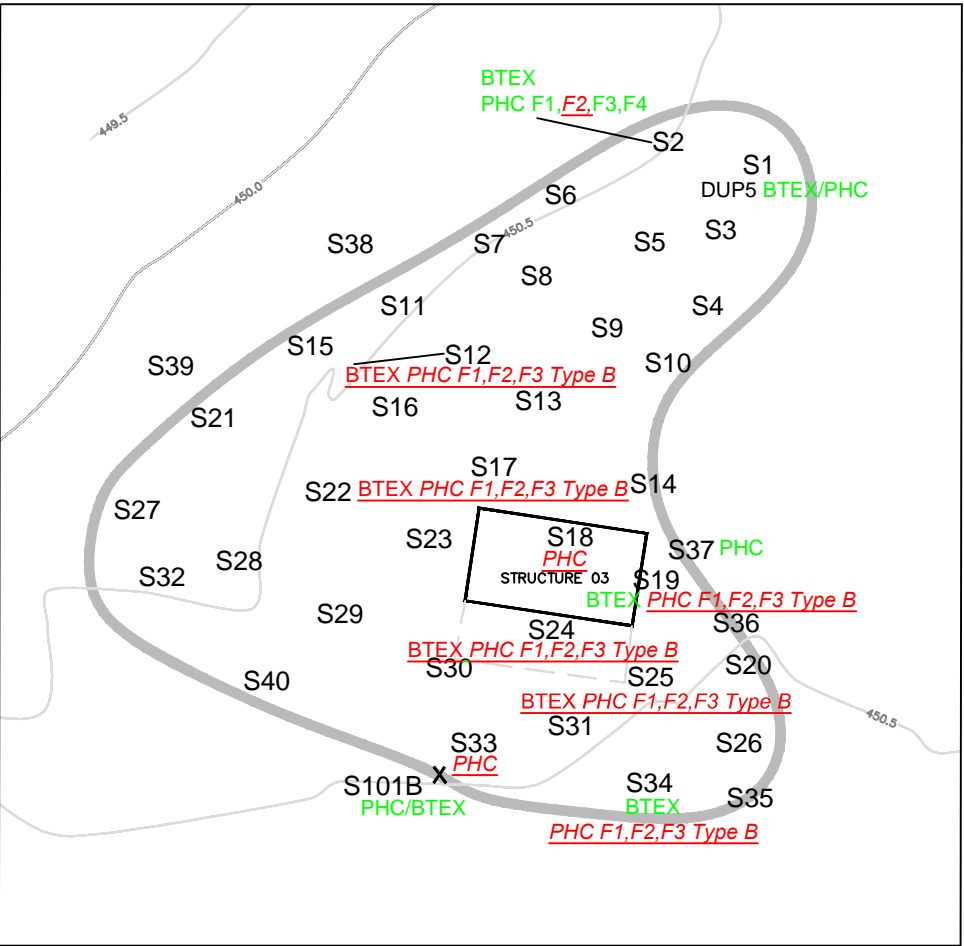

SOIL IMPACT ZONE 3 (Level B)

SCALE: 1:400

FIGURE 5C

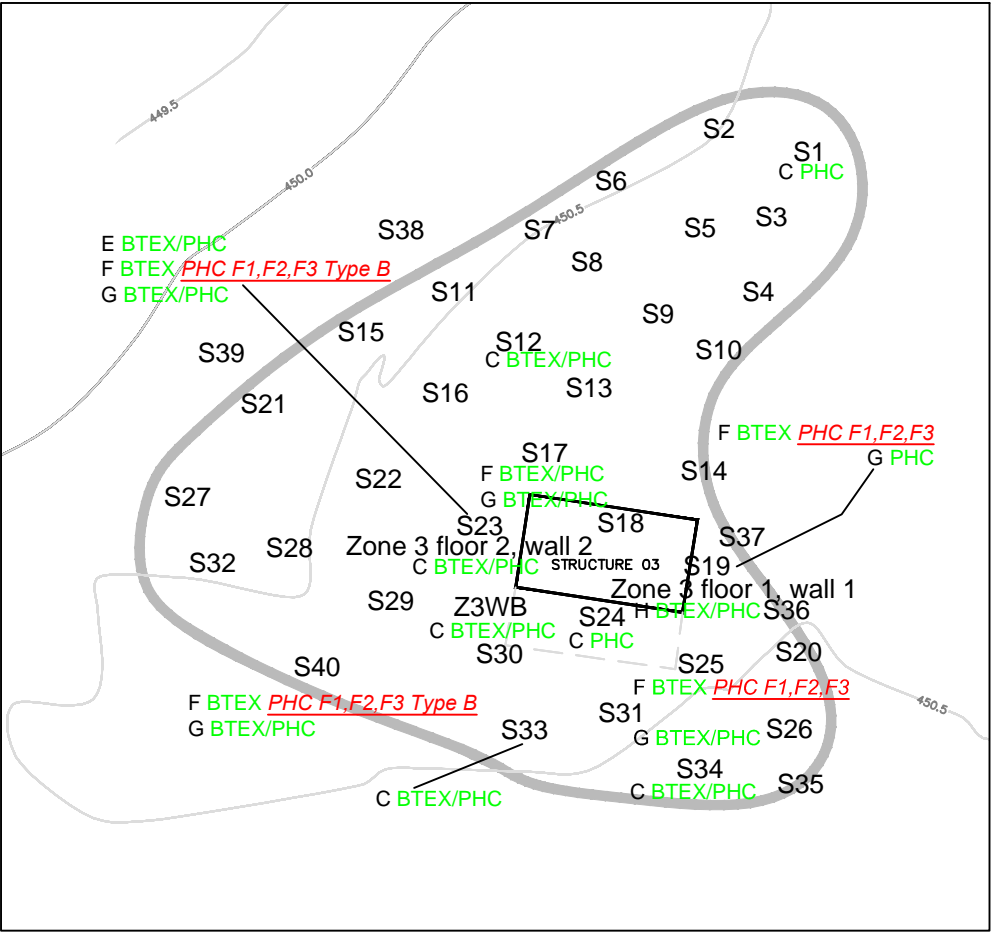

SOIL IMPACT ZONE 3 (Level C, E, F, G and H)

SCALE: 1:400

GENERAL NOTES:

1. ALL DIMENSIONS ARE IN METRES UNLESS NOTED OTHERWISE.
2. ALL COORDINATES ARE REFERENCED TO NAD83(CSRS). ELEVATIONS ARE REFERENCED TO MEAN SEA LEVEL, RELATIVE TO GEOID MODEL CANADIAN HT2_0.
3. ARCHAEOLOGICAL FEATURES LOCATED AS PER THE ARCHAEOLOGICAL IMPACT ASSESSMENT. RELICS AND ANTIQUITIES AND ITEMS OF HISTORICAL AND SCIENTIFIC INTEREST FOUND ON-SITE OR IN BUILDINGS TO BE DEMOLISHED WILL REMAIN WITH PROPERTY OF THE AUTHORITY HAVING JURISDICTION (AHJ). IF ARCHEOLOGICAL ITEMS ARE DISCOVERED, NOTIFY THE DEPARTMENTAL REPRESENTATIVE. PROTECT THE ARCHEOLOGICAL ITEMS.
4. CONTOUR INTERVAL IS 0.5 m.

LEGEND:

- MAJOR CONTOUR LINES
- MINOR CONTOUR LINES
- BUILDING
- METALS SOIL IMPACT ZONE EXCAVATION
- PETROLEUM HYDROCARBONS (PHC) SOIL IMPACT ZONE EXCAVATION
- COINCIDENTAL METALS AND PHC SOIL IMPACT ZONES EXCAVATION
- TP-32 TEST PIT LOCATION, SENES 2012
- WK-SS-050 SOIL SAMPLE, WESA 2011
- S24 SOIL SAMPLE, SENES 2014
- PHC F2 DENOTES ELEVATED PARAMETER RESULT
- PHC/BTEX DENOTES PARAMETER TESTED AND MEETS CRITERIA



PWGSC

CONTWOYTO LAKE
REMEDATION PROJECT

REMEDIAL WORKS
ZONE 3 IMPACT ZONE DETAILS

Drawn By: P.A.F.	Approved By: J.M.	Project No: 350600-508
Date: NOV. 2015	Scale: 1:3500	Drawing No: FIGURE 5

Nov 03, 2015 -- 10:15am -- USER jsedore
Z:\350600-508 Contwoyto Lake Remed\NOV 2015\350600-508_REMED FIG. 6-7.dwg



GENERAL NOTES:

- 1. ALL DIMENSIONS ARE IN METRES UNLESS NOTED OTHERWISE.
- 2. ALL COORDINATES ARE REFERENCED TO NAD83(CSRS). ELEVATIONS ARE REFERENCED TO MEAN SEA LEVEL, RELATIVE TO GEOID MODEL CANADIAN HT2_0.
- 3. ARCHAEOLOGICAL FEATURES LOCATED AS PER THE ARCHAEOLOGICAL IMPACT ASSESSMENT. RELICS AND ANTIQUITIES AND ITEMS OF HISTORICAL AND SCIENTIFIC INTEREST FOUND ON-SITE OR IN BUILDINGS TO BE DEMOLISHED WILL REMAIN WITH PROPERTY OF THE AUTHORITY HAVING JURISDICTION (AHJ). IF ARCHEOLOGICAL ITEMS ARE DISCOVERED, NOTIFY THE DEPARTMENTAL REPRESENTATIVE. PROTECT THE ARCHEOLOGICAL ITEMS.
- 4. CONTOUR INTERVAL IS 0.5 m.


LEGEND

x 367 SOIL SAMPLE 2015



PWGSC
**CONTWOYTO LAKE
REMEDATION PROJECT**
SOIL TREATMENT CELL AS-BUILT

Drawn By: P.A.F.	Approved By: J.M.	Project No: 350600-508
Date: NOV. 2015	Scale: 1:600	Drawing No: FIGURE 6

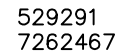

BEAR FENCE

C x

GATE

369 x

FC-2
x

x DC-2

FUEL CACHE

CAMP MUSTER AREA

 GREY WATER

529320
7262437

529281
7262456

BEAR FENCE

529309
7262426

GENERAL NOTES:

1. ALL DIMENSIONS ARE IN METRES UNLESS NOTED OTHERWISE.
2. ALL COORDINATES ARE REFERENCED TO NAD83(CSRs). ELEVATIONS ARE REFERENCED TO MEAN SEA LEVEL, RELATIVE TO GEOID MODEL CANADIAN HT2_0.
3. ARCHAEOLOGICAL FEATURES LOCATED AS PER THE ARCHAEOLOGICAL IMPACT ASSESSMENT. RELICS AND ANTIQUITIES AND ITEMS OF HISTORICAL AND SCIENTIFIC INTEREST FOUND ON-SITE OR IN BUILDINGS TO BE DEMOLISHED WILL REMAIN WITH PROPERTY OF THE AUTHORITY HAVING JURISDICTION (AHJ). IF ARCHEOLOGICAL ITEMS ARE DISCOVERED, NOTIFY THE DEPARTMENTAL REPRESENTATIVE. PROTECT THE ARCHEOLOGICAL ITEMS.
4. CONTOUR INTERVAL IS 0.5 m.

LEGEND

× 367 SOIL SAMPLE 2015



PWGSC

CONTWOYTO LAKE REMEDIATION PROJECT

TEMPORARY CAMP LAYOUT

Drawn By: P.A.F.	Approved By: J.M.	Project No: 350600-508
Date: NOV. 2015	Scale: 1:1500	Drawing No: FIGURE 7

Nov 03, 2015 - 10:18am - USER jsedore
Z:\350000 Series\350600-508 Contwoyto Lake\Remed\NOV 2015\350047-508 REMED FIG 8.dwg

