


APPENDIX 5: As Built Drawings CAM-F, Sarcpa Lake, Nunavut

B1 1000 x 707
Plot Date: Wednesday, April 29, 2009 12:55:07 PM
Dwg Filename: 413759-C00-R0.DWG



Public Works and
Government Services
Canada

Travaux publics et
Services gouvernementaux
Canada

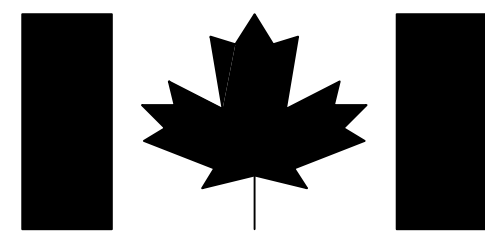

Indian and Northern
Affairs Canada


Affaires indiennes
et du Nord Canada

REAL PROPERTY SERVICES
Western Region

Canada

INTERMEDIATE DEW LINE SITE RESTORATION

DRAWING INDEX			
DRAWING No.	TITLE		DRAWING No. TITLE
CIVIL		CIVIL	
413759 C01	OVERALL SITE PLAN		413759 C09 BEACH AREA SITE PLAN
413759 C02	PROJECT LAYOUT		413759 C10 UPPER STATION GARAGE DUMP PLAN AND CROSS SECTIONS
413759 C03	UPPER STATION AREA SITE PLAN		413759 C11 MIDSTATION DUMP LOBE B EXCAVATION PLAN AND CROSS SECTION
413759 C04	NORTH MIDSTATION AREA SITE PLAN		413759 C12 LOWER SITE NON-HAZARDOUS WASTE LANDFILL PLAN AND CROSS SECTION
413759 C05	SOUTH MIDSTATION AREA SITE PLAN		413759 C13 MISCELLANEOUS DETAILS SHEET 1
413759 C06	LAKE AREA SITE PLAN		413759 C14 MISCELLANEOUS DETAILS SHEET 2
413759 C07	LOWER SITE NON-HAZARDOUS WASTE LANDFILL AREA SITE PLAN		STRUCTURAL
413759 C08	LOWER SITE AREA SITE PLAN		413759 S01 UPPER STATION AREA AND BEACH AREA DEMOLITION SITE PLANS

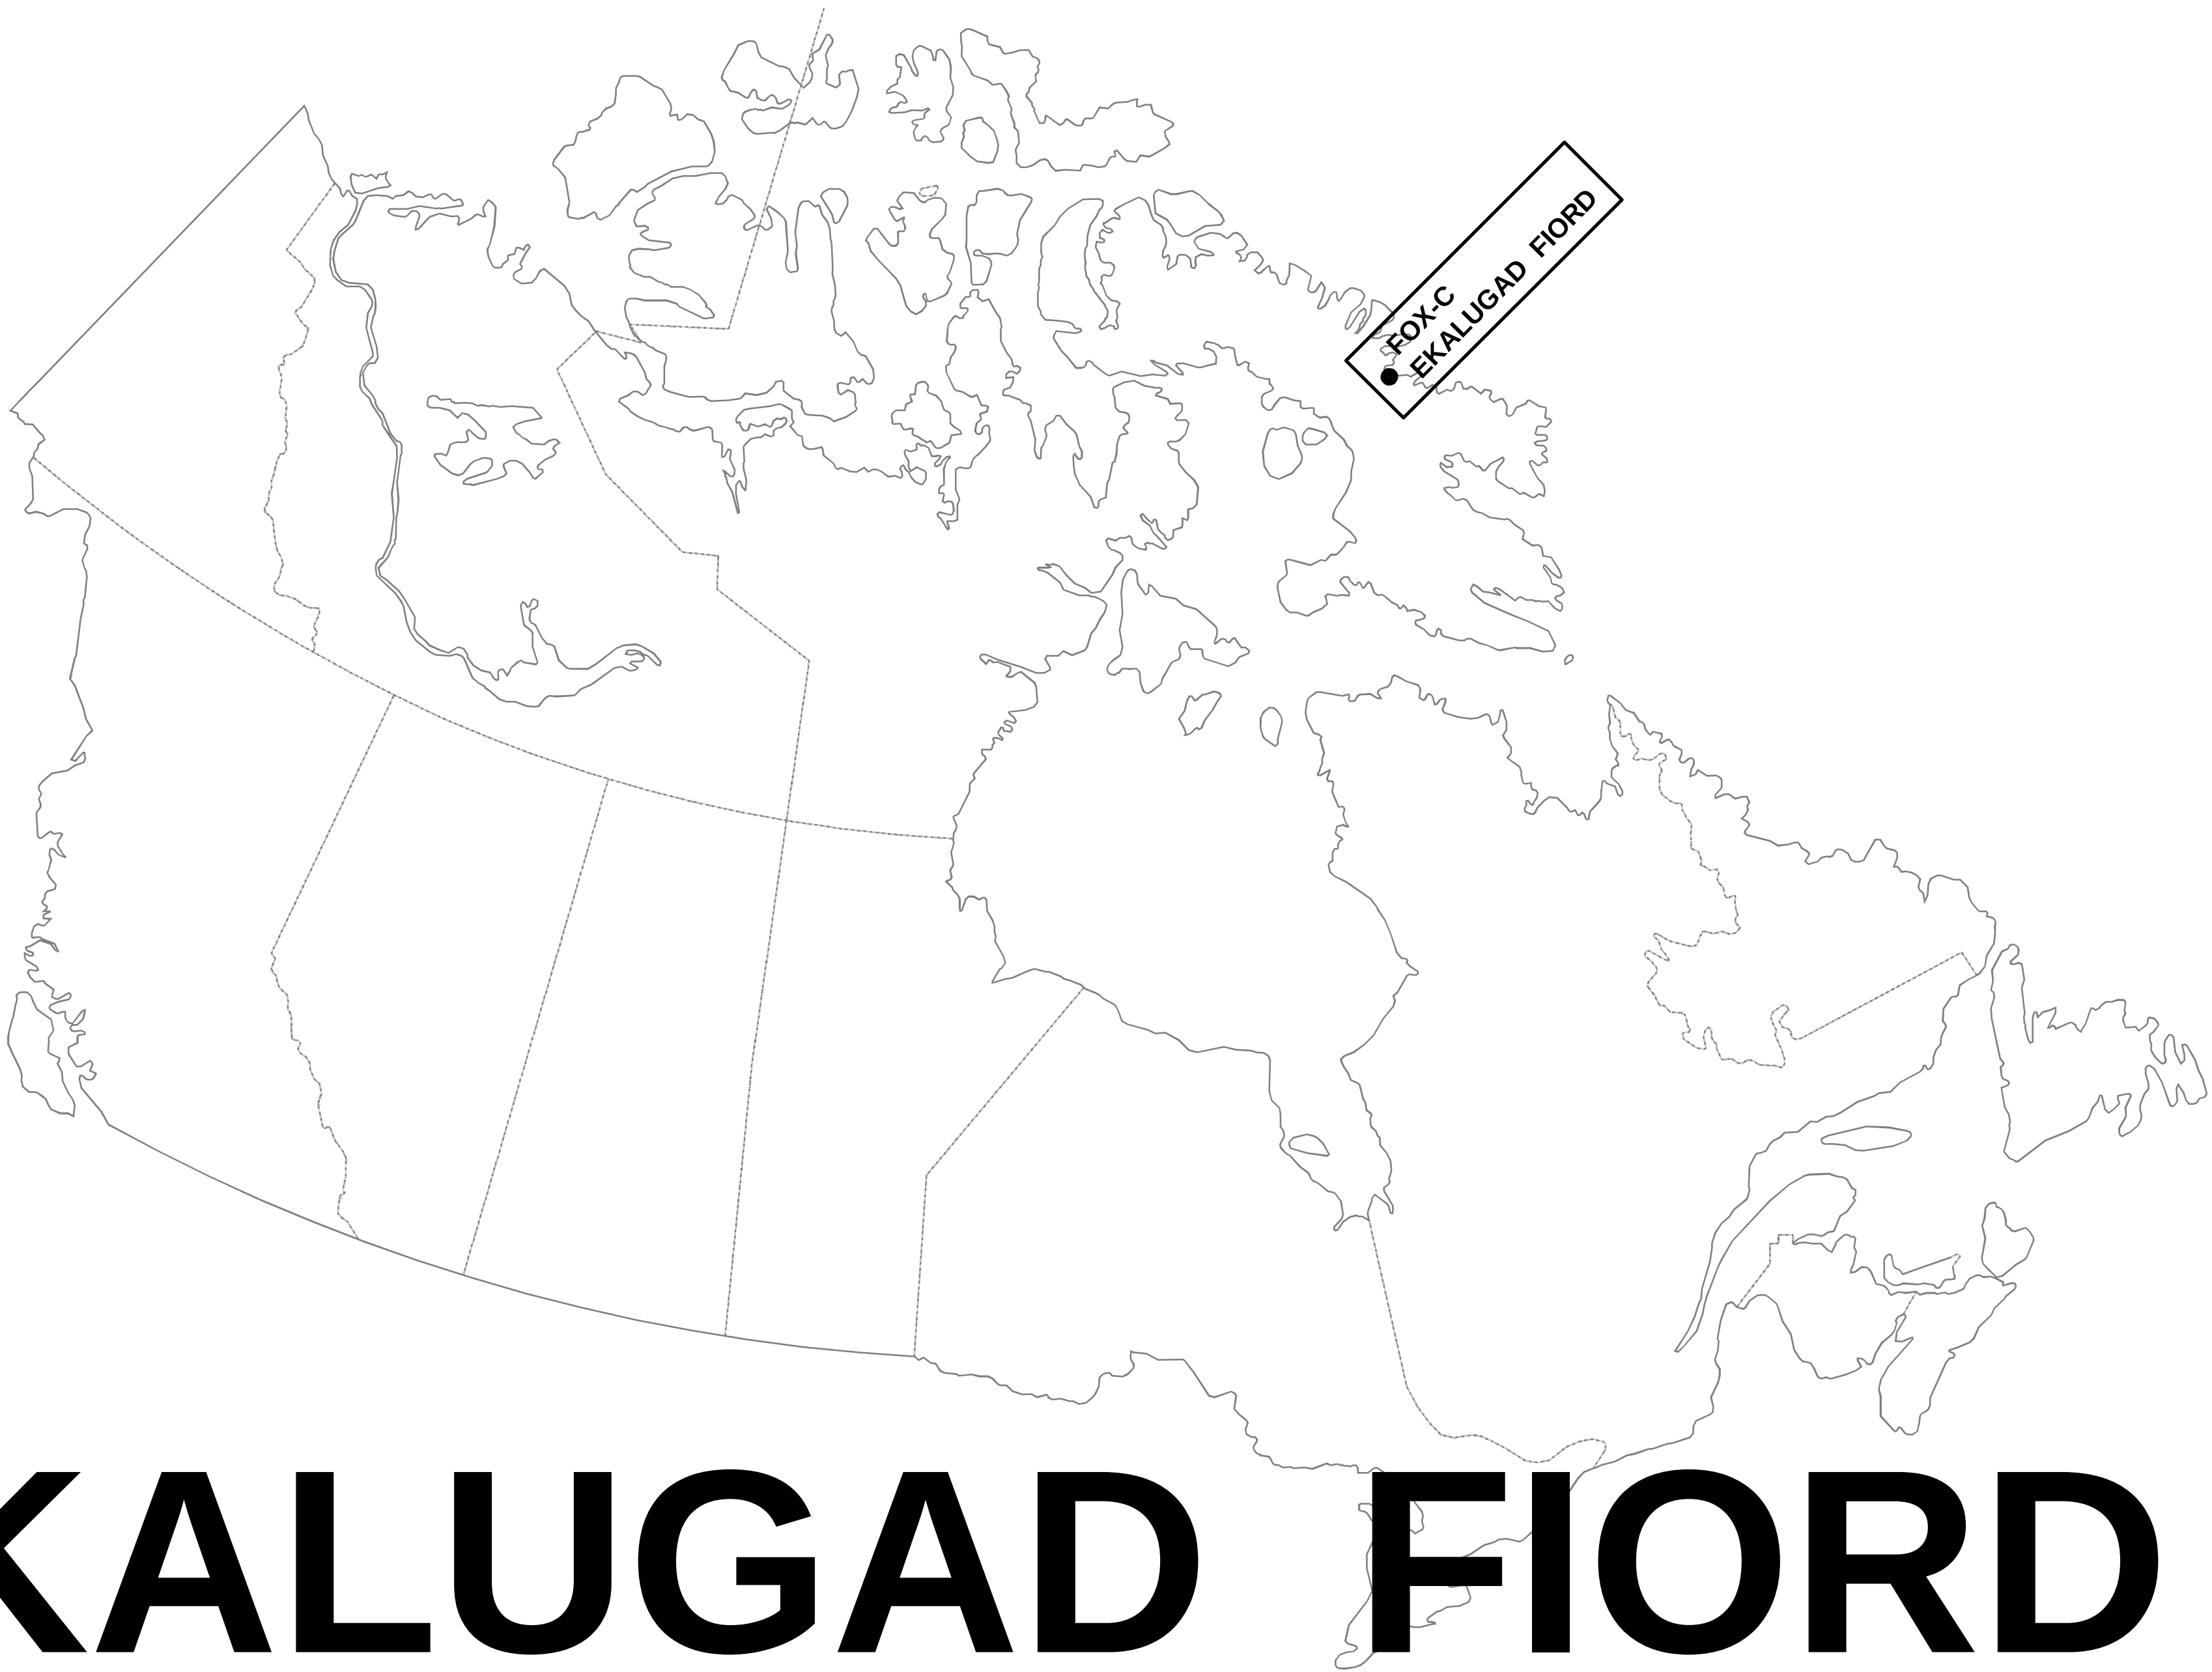

FOX-C EKALUGAD FIORD
AS-BUILT DRAWINGS




APRIL, 2009



General Notes:

1. ALL COORDINATES ARE REFERENCED TO NAD83 CRS, UTM ZONE 19. ELEVATIONS ARE REFERENCED TO MEAN SEA LEVEL, RELATIVE TO GEID MD EGM96.
2. SITE PLANS AND TOPOGRAPHIC INFORMATION ARE BASED ON AIR PHOTOS AND SURVEYS. CURRENT CONDITIONS MAY NOT BE EXACTLY AS SHOWN.
3. ALL DIMENSIONS ARE IN METRES UNLESS NOTED OTHERWISE.
4. EXTENT OF BORROW AREAS SHOWN ON THE DRAWINGS WERE PROVIDED BY EBA ENGINEERING CONSULTANTS LTD.
5. ALL NON-HAZARDOUS DEBRIS REMOVED WITHIN THE PLAN AREA WAS PLACED IN THE LOWER SITE NON-HAZARDOUS WASTE LANDFILL.

Legend:

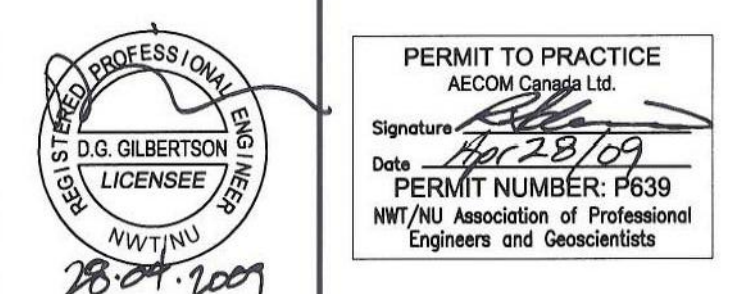 APPROXIMATE EXTENT OF BORROW AREA

UMA
An AECOM Company

1	ISSUED FOR AS-BUILT	09/04/28
0	ISSUED FOR CONSTRUCTION	05/07/25
REVISIONS	DESCRIPTION	DATE

A detail number
number du détail

B source drawing no.
de dessin no.

C detail on drawing no.
détail sur dessin no.

project title titre du projet
FOX-C Intermediate DEW Line Site
EKALUGAD FIORD
Site Restoration

Nunavut

drawing title titre du dessin

OVERALL SITE PLAN

designed by **B. FEDORAK** conçu par

drawn by dessine par
L. VARGAS



approved by R. SCHMIDTKE approve par

PWGSC Project Manager
Administrateur de Projets TPSGC

scale	echelle	sheet	feuille
1:7500			

project no.	413759	project no.	C01
-------------	--------	-------------	-----

APRIL, 2009

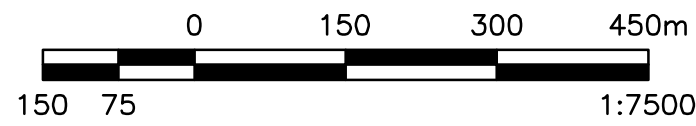
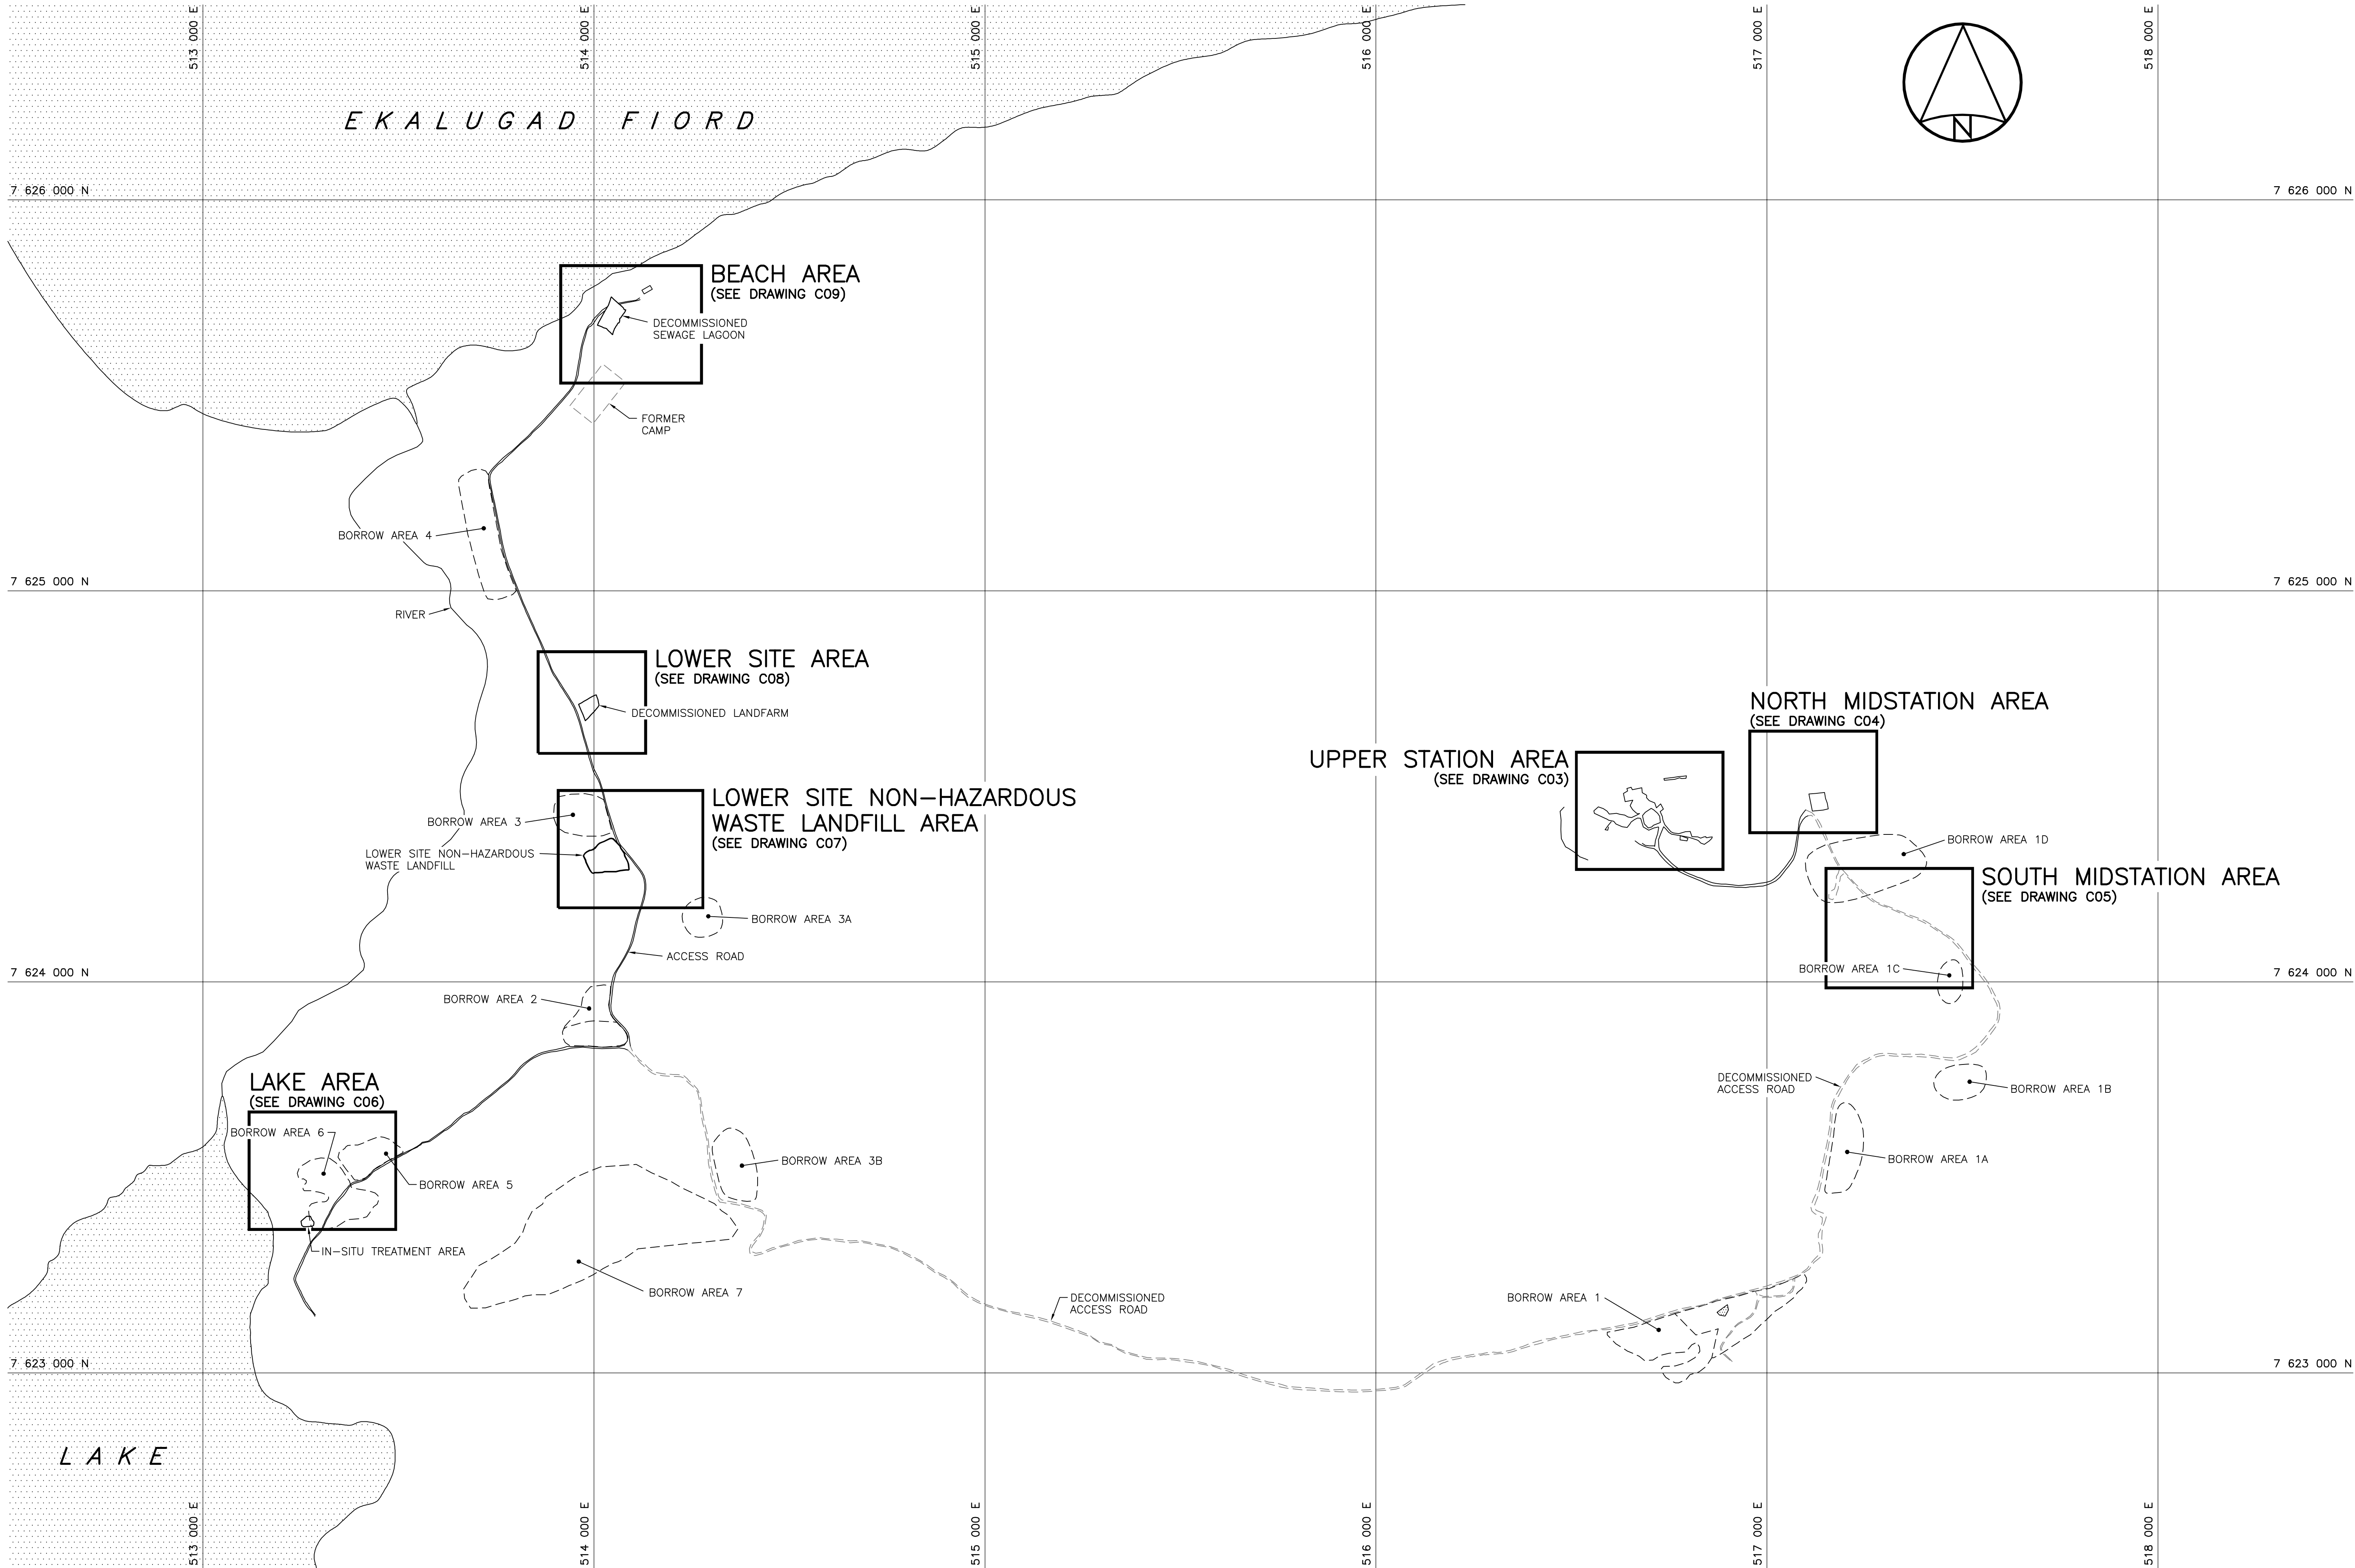


General Notes:

1. ALL COORDINATES ARE REFERENCED TO NAD83 CSRS, UTM ZONE 19. ELEVATIONS ARE REFERENCED TO MEAN SEA LEVEL, RELATIVE TO GEOD MODEL EGM96.
2. SITE PLANS AND TOPOGRAPHIC INFORMATION ARE BASED ON AIR PHOTOS AND SURVEYS. CURRENT CONDITIONS MAY NOT BE EXACTLY AS SHOWN.
3. ALL DIMENSIONS ARE IN METRES UNLESS NOTED OTHERWISE.

Legend:

- APPROXIMATE EXTENT OF BORROW AREA
- BODY OF WATER

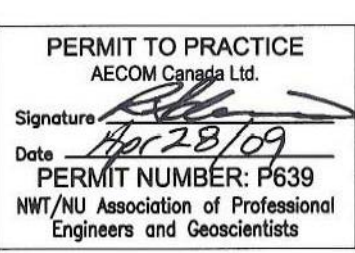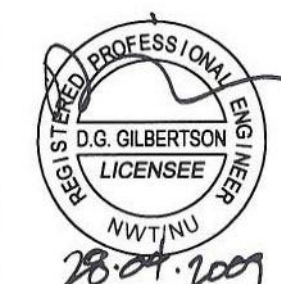

1	ISSUED FOR AS-BUILT	09/04/28
0	ISSUED FOR CONSTRUCTION	08/07/25

REVISIONS	DESCRIPTION	DATE
A	detail number	
B	source drawing no.	
C	detail on drawing no.	

project title
FOX-C Intermediate DEW Line Site EKALUGAD FIORD Site Restoration

Nunavut

drawing title
PROJECT LAYOUT

designed by
B. FEDORAK

drawn by
L. VARGAS

approved by
R. SCHMIDTKE

PWSC Project Manager
B. THOMPSON


scale
1:7500

project no.
413759

date
APRIL, 2009

sheet
C02

OF 14

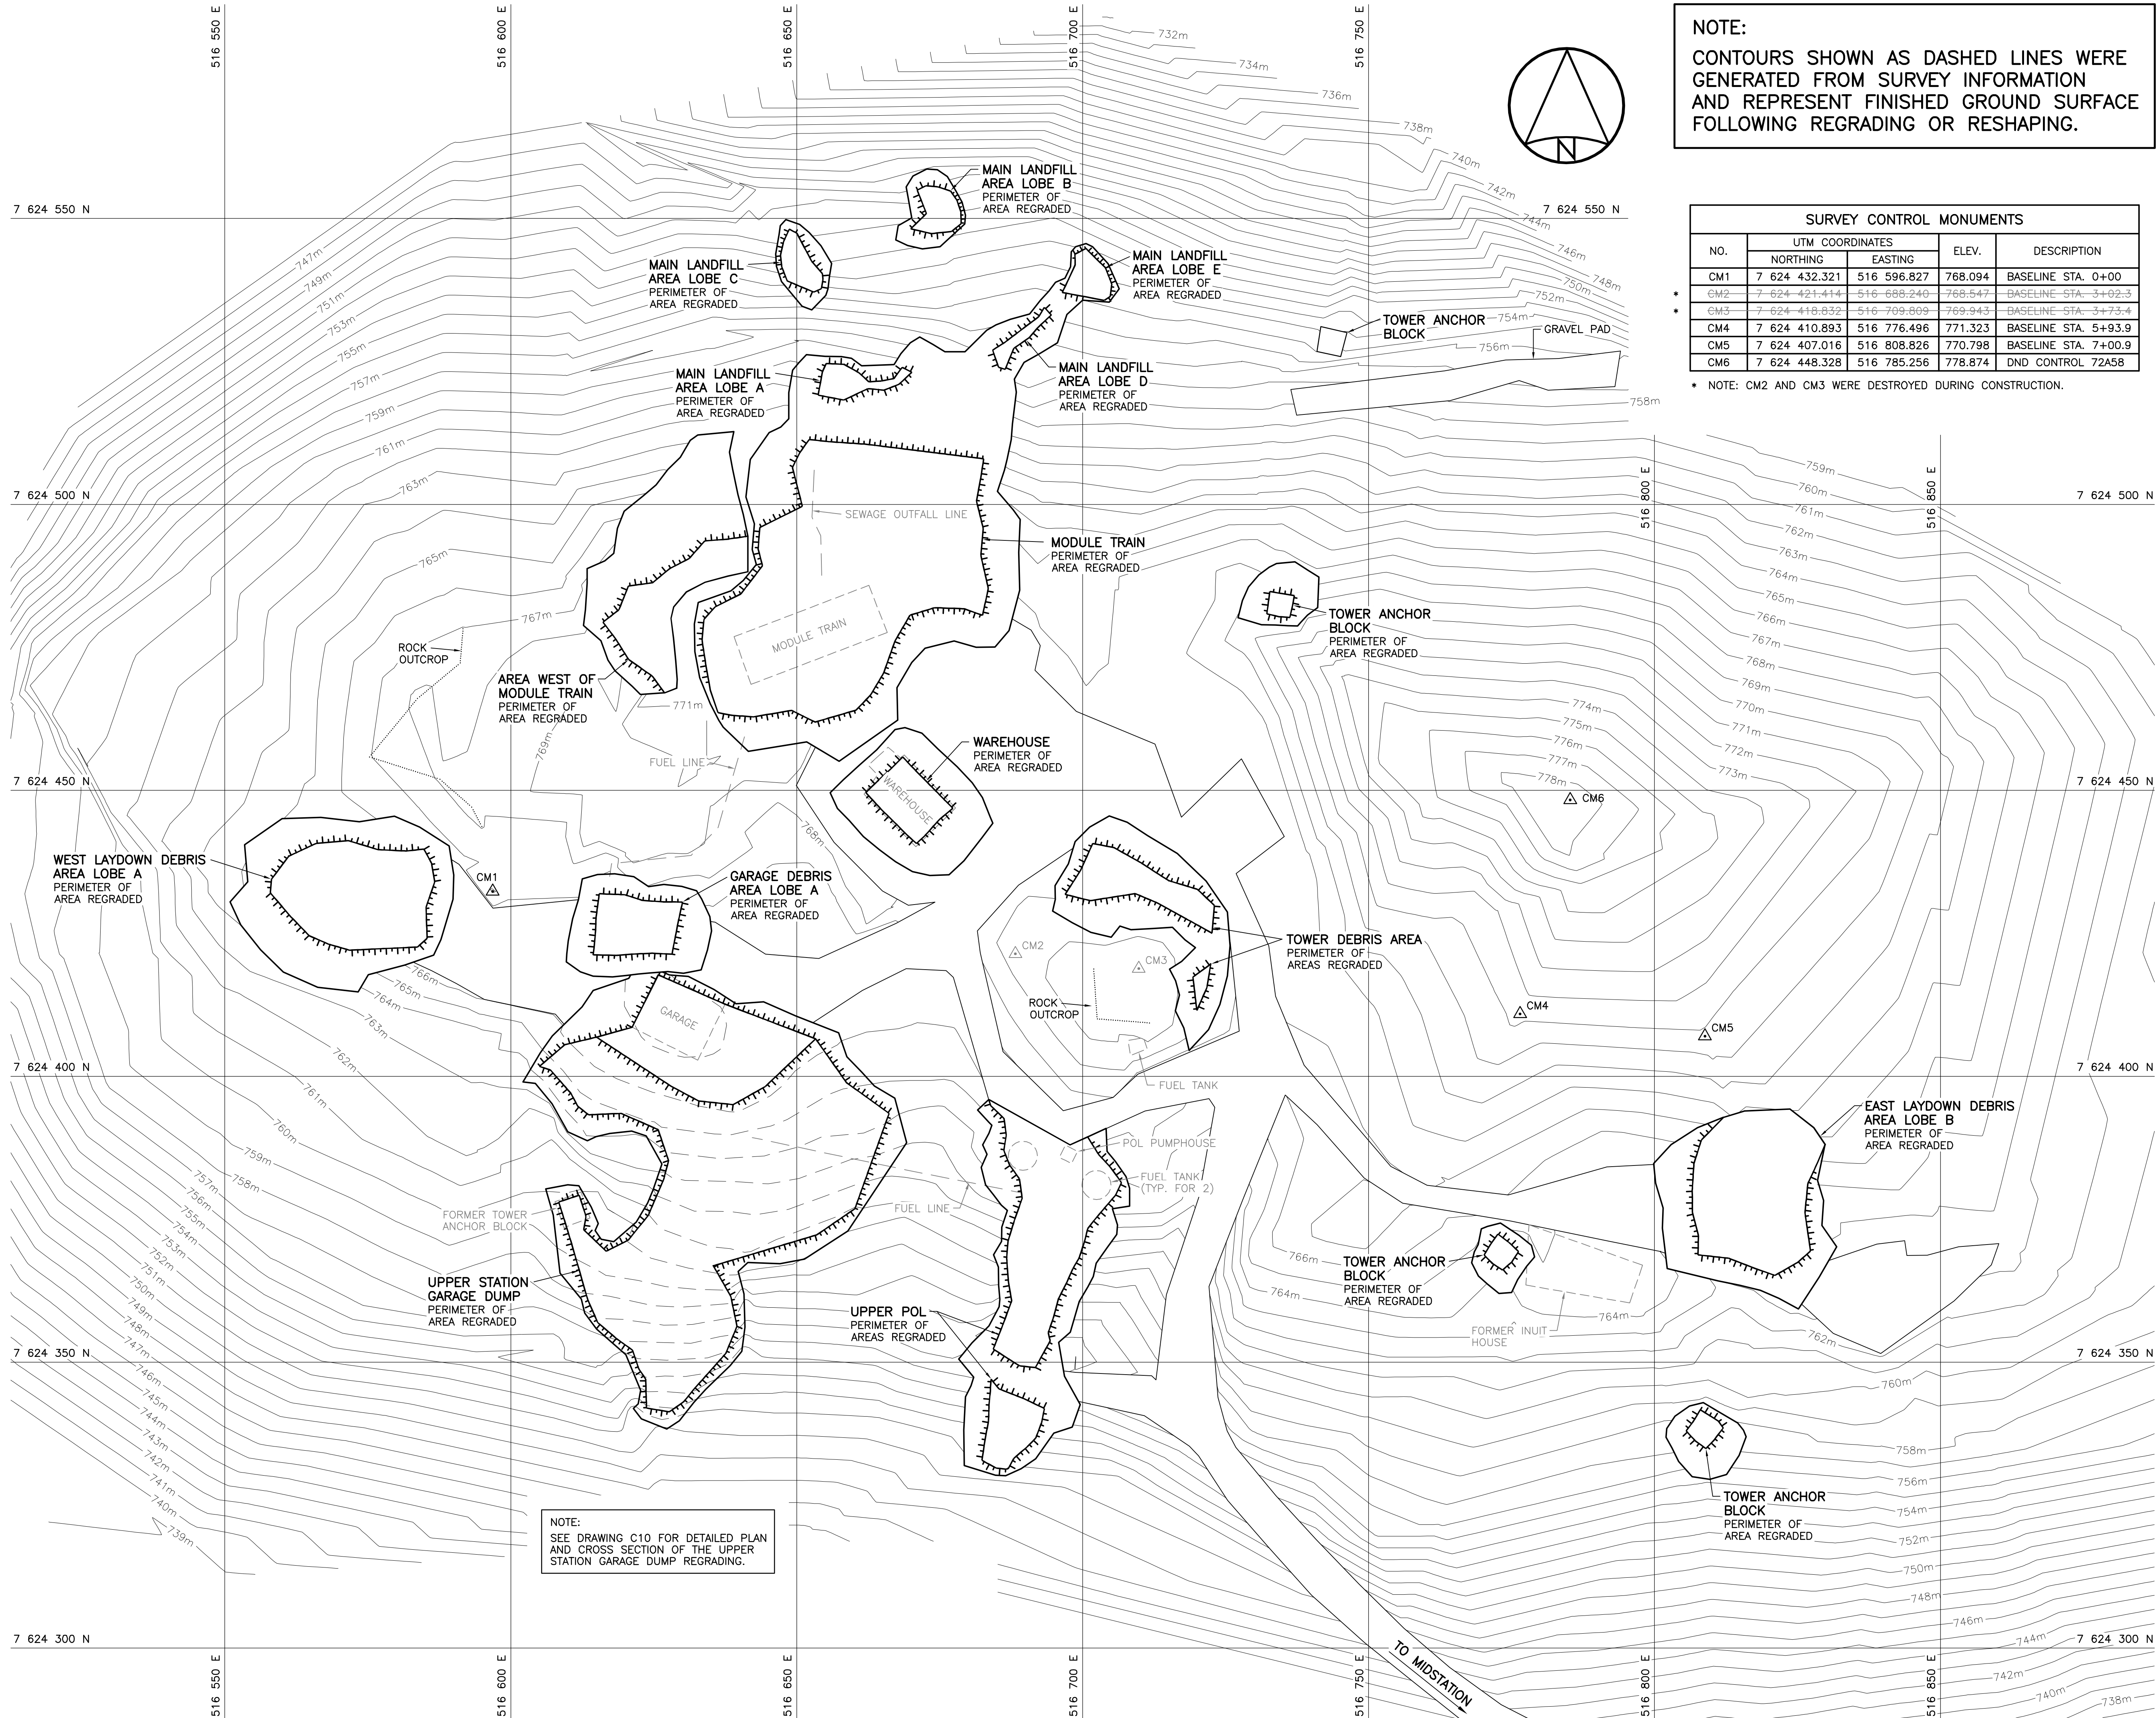

NOTE:
CONTOURS SHOWN AS DASHED LINES WERE
GENERATED FROM SURVEY INFORMATION
AND REPRESENT FINISHED GROUND SURFACE
FOLLOWING REGRADING OR RESHAPING.

NO.	UTM COORDINATES		ELEV.	DESCRIPTION
	NORTHING	EASTING		
CM1	7 624 432.321	516 596.827	768.094	BASLINE STA. 0+00
CM2	7 624 421.414	516 688.249	768.542	BASLINE STA. 3+02.3
CM3	7 624 418.832	516 709.809	769.943	BASLINE STA. 3+73.4
CM4	7 624 410.893	516 776.496	771.323	BASLINE STA. 5+93.9
CM5	7 624 407.016	516 808.826	770.798	BASLINE STA. 7+00.9
CM6	7 624 448.328	516 785.256	778.874	DND CONTROL 72A58

* NOTE: CM2 AND CM3 WERE DESTROYED DURING CONSTRUCTION.

General Notes:

1. ALL COORDINATES ARE REFERENCED TO NAD83 CSRS, UTM ZONE 19. ELEVATIONS ARE REFERENCED TO MEAN SEA LEVEL, RELATIVE TO GEOD MODEL EGM96.
2. SITE PLANS AND TOPOGRAPHIC INFORMATION ARE BASED ON AIR PHOTOS AND SURVEYS. CURRENT CONDITIONS MAY NOT BE EXACTLY AS SHOWN.
3. ALL DIMENSIONS ARE IN METRES UNLESS NOTED OTHERWISE.

Legend:

- △ SURVEY CONTROL MONUMENT
- FORMER BUILDING, STRUCTURE OR TANK LOCATION

PERMIT TO PRACTICE
AECOM Group Ltd.
Signature: *[Signature]*
Date: *20-04-2009*
PERMIT NUMBER: P639
NWT/NU Association of Professional Engineers and Geoscientists

uma
An AECOM Company

1	ISSUED FOR AS-BUILT	09/04/28
0	ISSUED FOR CONSTRUCTION	06/07/25

REVISIONS	DESCRIPTION	DATE
A	detail number	
B	source drawing no.	
C	detail on drawing no.	

project title
**FOX-C Intermediate DEW Line Site
EKALUGAD FIORD
Site Restoration**

Nunavut

drawing title
**UPPER STATION AREA
SITE PLAN**

designed by
B. FEDORAK

drawn by
L. VARGAS

approved by
R. SCHMIDTKE

PWSC Project Manager
B. THOMPSON


scale
1:500

project no.
413759

date
APRIL, 2009


sheet
C03

of 14

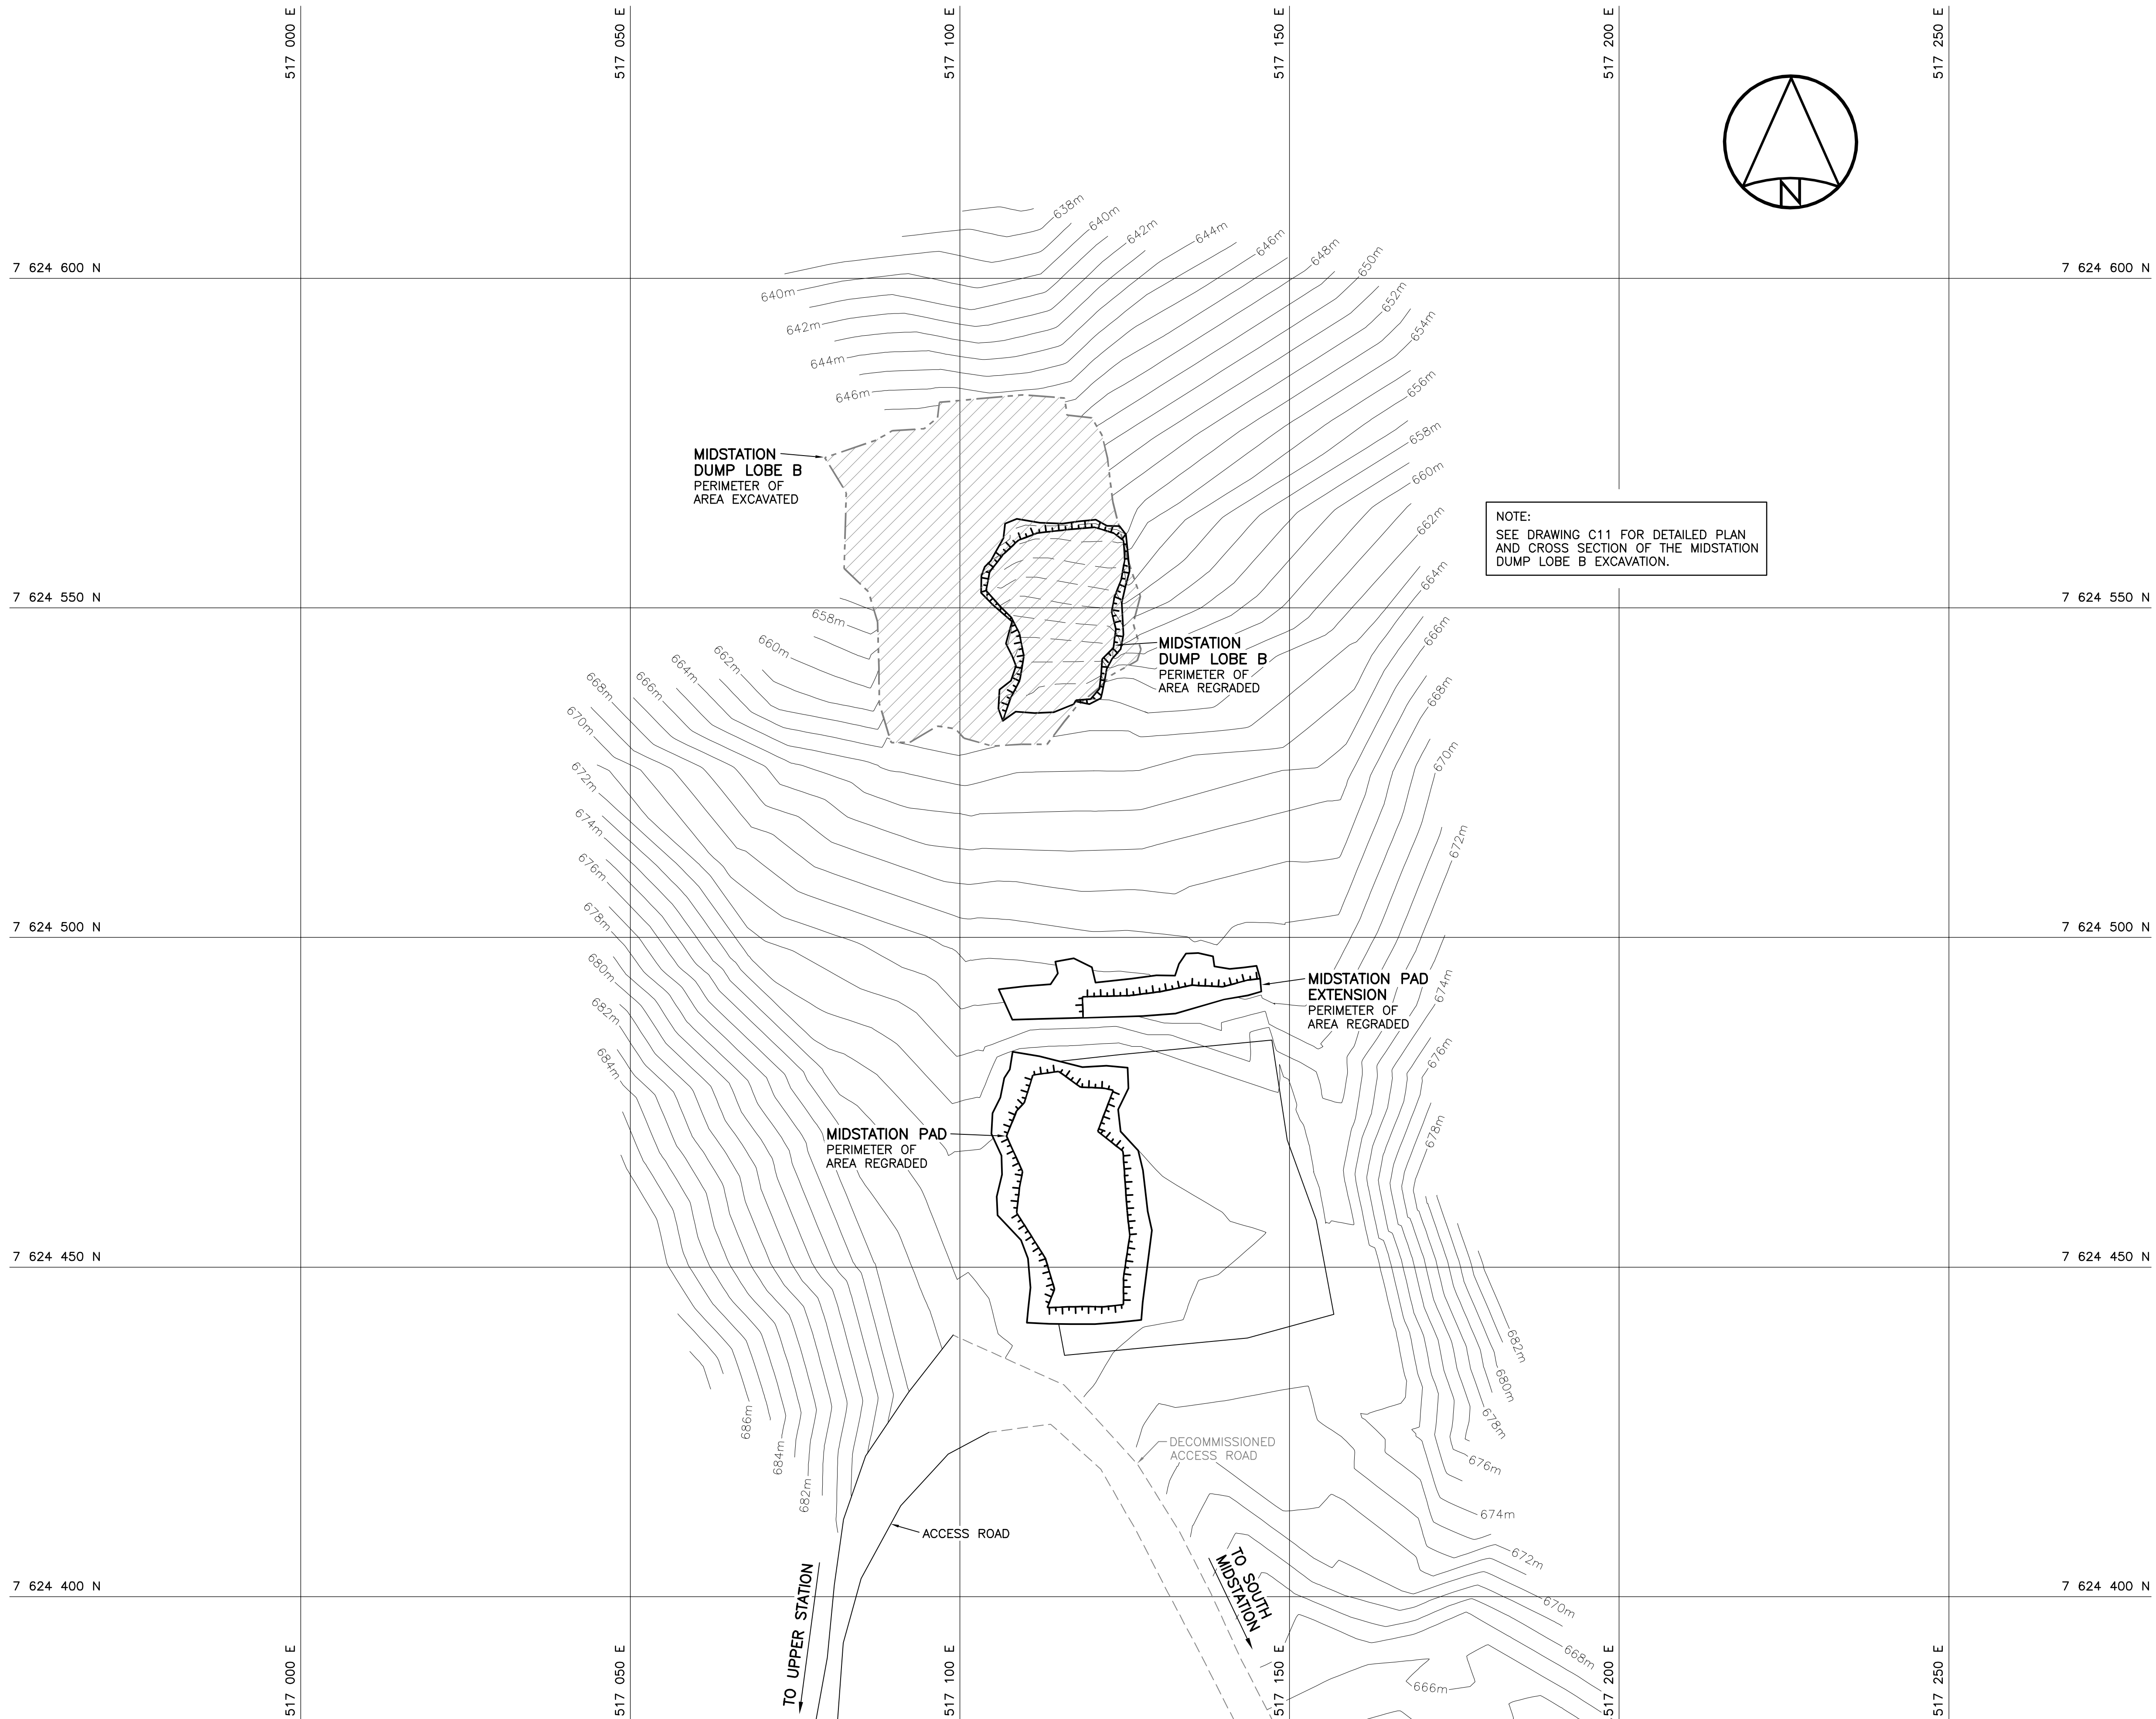



Public Works and
Government Services
Canada

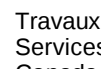

Travaux publics et
Services gouvernementaux
Canada

REAL PROPERTY SERVICES

Western Region

Client



Indian and Northern
Affairs Canada



Affaires indiennes
et du Nord Canada

Canada

Nunavut Regional Office
Iqaluit, Nunavut

Client

Client


General Notes:

1. ALL COORDINATES ARE REFERENCED TO NAD83 CSRS, UTM ZONE 19. ELEVATIONS ARE REFERENCED TO MEAN SEA LEVEL, RELATIVE TO GEOD MODEL EGM96.
2. SITE PLANS AND TOPOGRAPHIC INFORMATION ARE BASED ON AIR PHOTOS AND SURVEYS. CURRENT CONDITIONS MAY NOT BE EXACTLY AS SHOWN.
3. ALL DIMENSIONS ARE IN METRES UNLESS NOTED OTHERWISE.


Legend:



EXCAVATION AREA

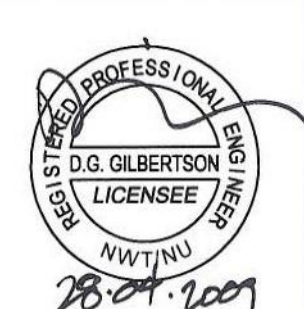

O.G. GILBERTSON
LICENSEE
NWT/NU
26 Oct 2009

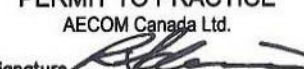PERMIT TO PRACTICE
AECOM Canada Ltd.
Signature: 
Date: 26-28/09
PERMIT NUMBER: P639
NWT/NU Association of Professional
Engineers and Geoscientists



An AECOM Company

0	ISSUED FOR AS-BUILT	09/04/28
REVISIONS	DESCRIPTION	DATE

A

C

A detail number
number du detail
B source drawing no.
de dessin no.
C detail on drawing no.
detail sur dessin no.

A

B

C

project title

titre du projet

FOX-C Intermediate DEW Line Site
EKALUGAD FIORD
Site Restoration

Nunavut

drawing title

titre du dessin

NORTH MIDSTATION AREA
SITE PLAN

designed by

conçu par

B. FEDORAK

drawn by

dessiné par

L. VARGAS

approved by

approuvé par

R. SCHMIDTKE

PWSC Project Manager

Administrateur de Projets TPSC

B. THOMPSON

scale

échelle

1:500

project no.

projet no.

413759

date

date

APRIL, 2009

sheet


feuille

C04

OF

14

413759-C04.DWG

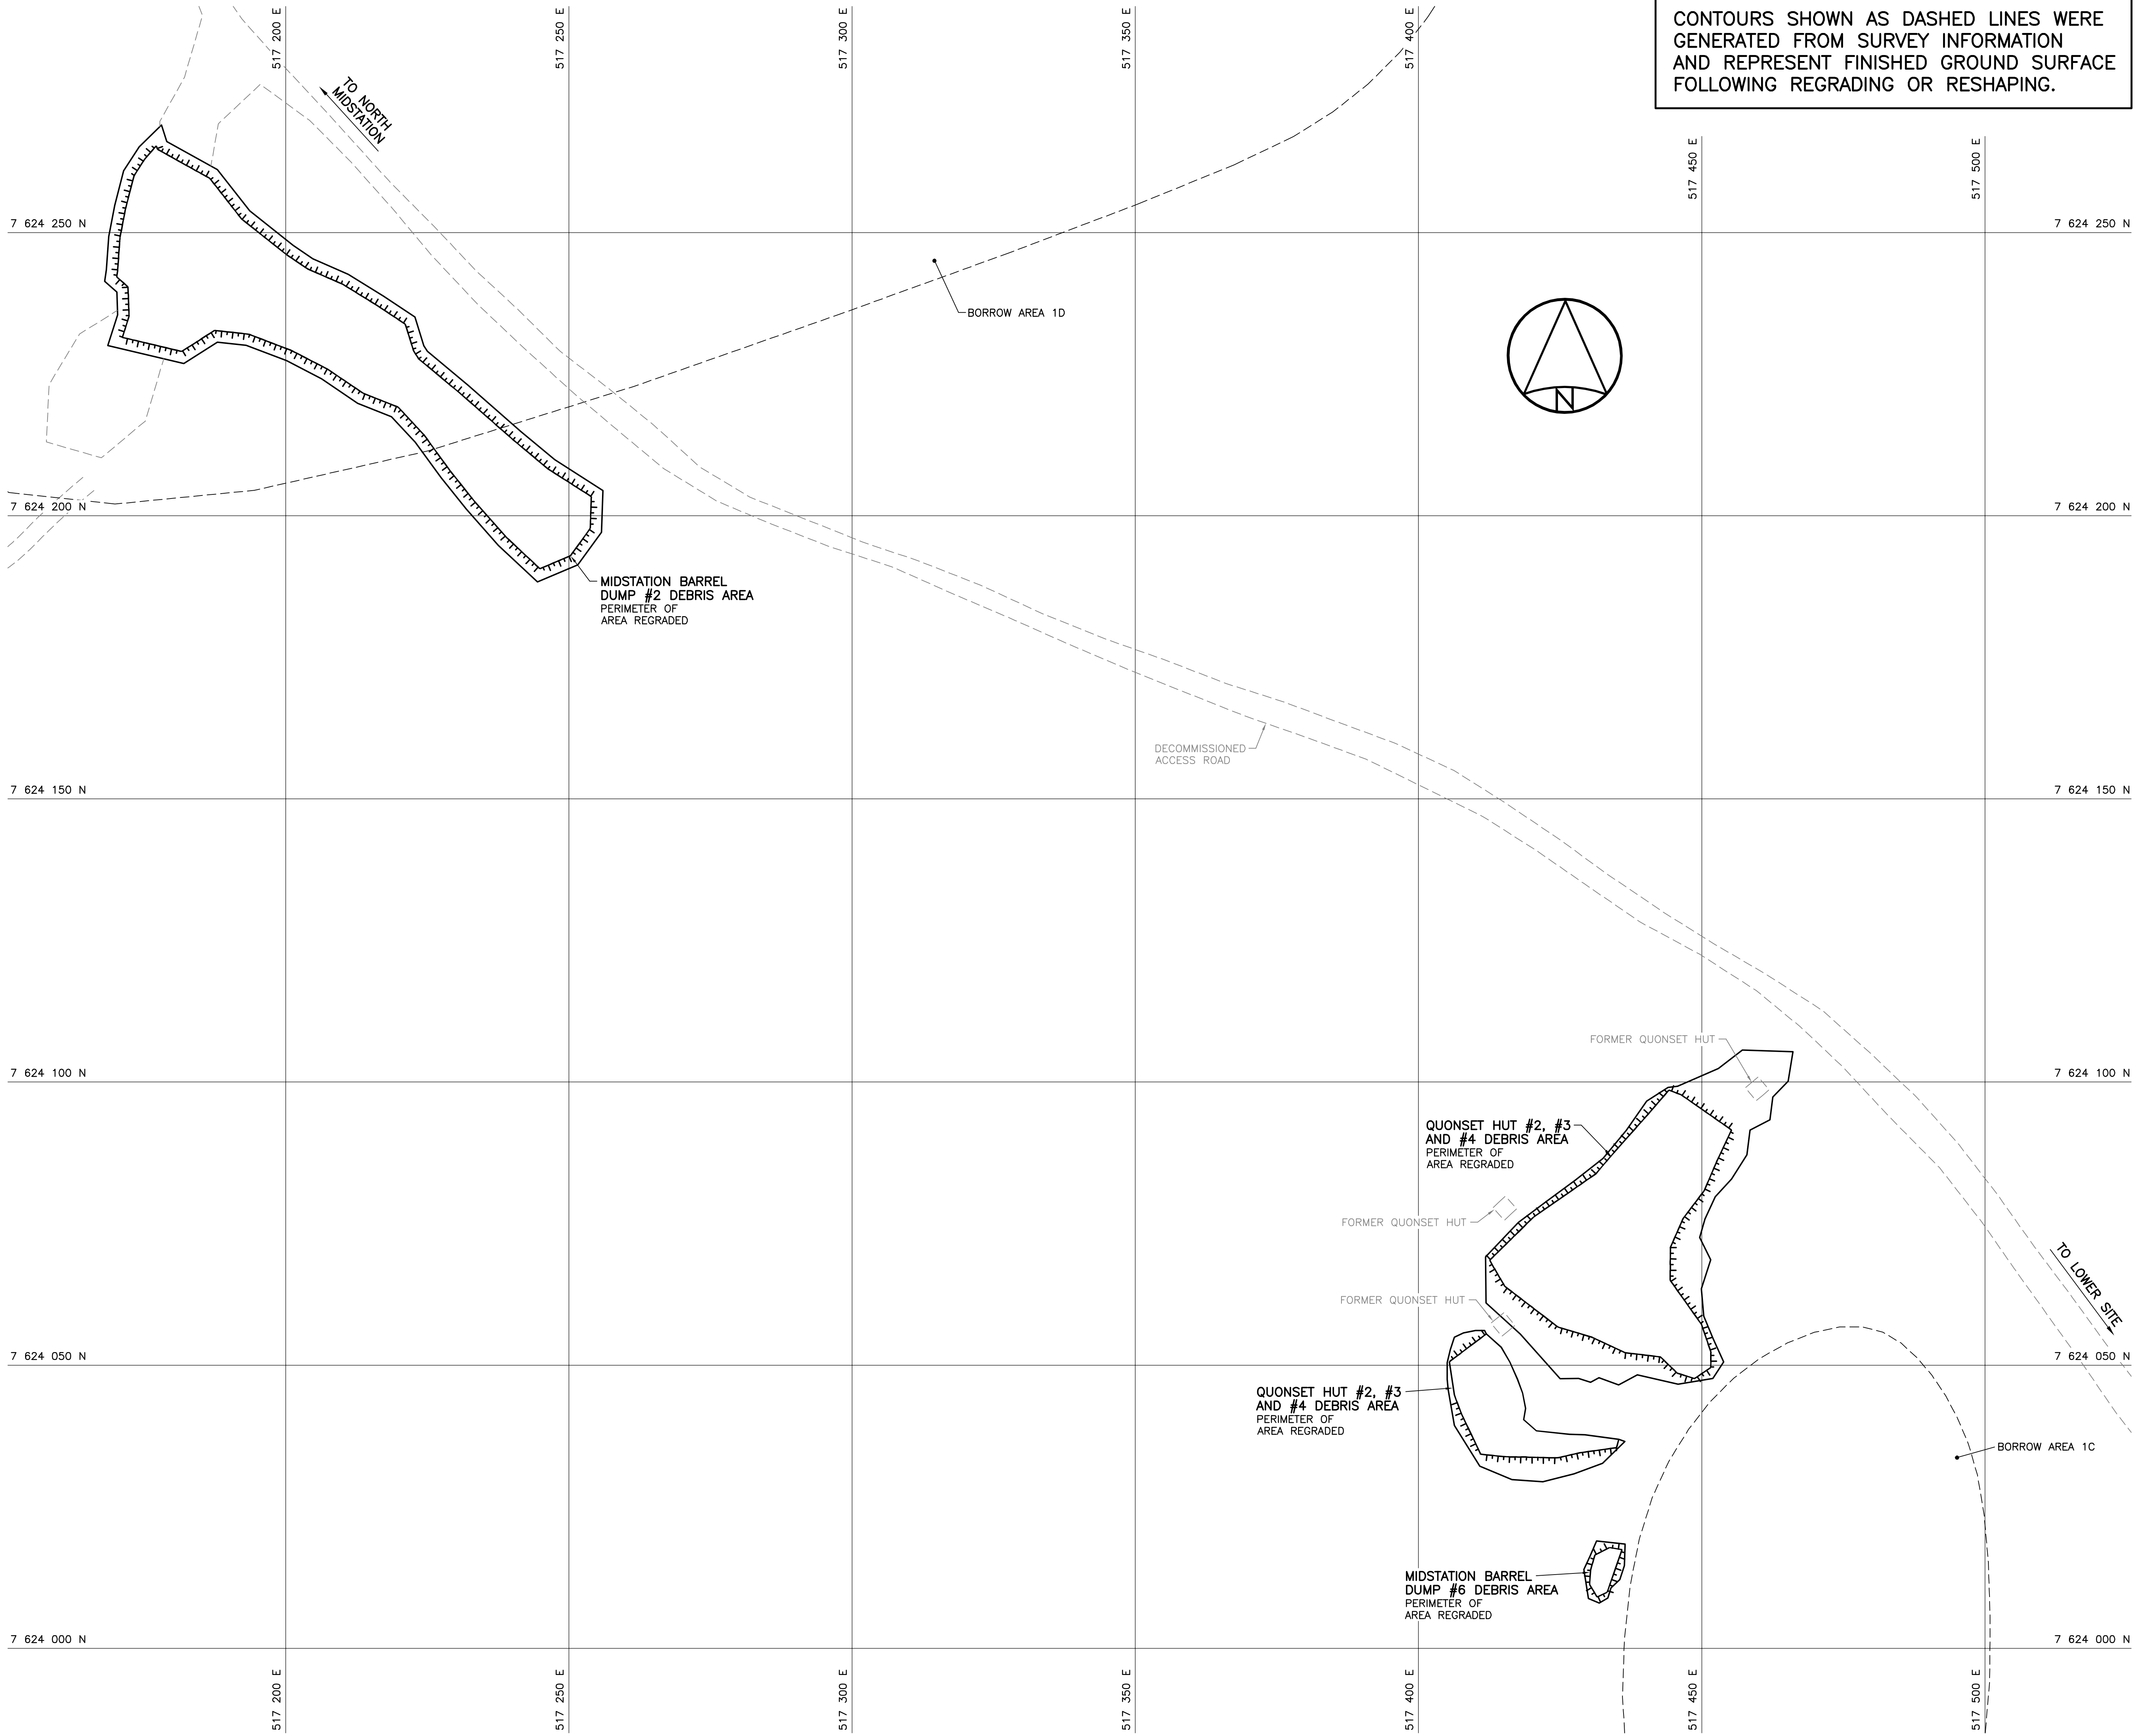


NOTE:
CONTOURS SHOWN AS DASHED LINES WERE
GENERATED FROM SURVEY INFORMATION
AND REPRESENT FINISHED GROUND SURFACE
FOLLOWING REGRADING OR RESHAPING.

General Notes:

1. ALL COORDINATES ARE REFERENCED TO NAD83 CSRS, UTM ZONE 19. ELEVATIONS ARE REFERENCED TO MEAN SEA LEVEL, RELATIVE TO GEOD MODEL EGM96.
2. SITE PLANS AND TOPOGRAPHIC INFORMATION ARE BASED ON AIR PHOTOS AND SURVEYS. CURRENT CONDITIONS MAY NOT BE EXACTLY AS SHOWN.
3. ALL DIMENSIONS ARE IN METRES UNLESS NOTED OTHERWISE.

Legend:

- FORMER BUILDING, STRUCTURE OR TANK LOCATION

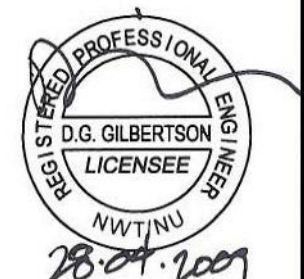

PERMIT TO PRACTICE
AECOM Canada Ltd.
Signature: [Signature]
Date: 26.04.2009
PERMIT NUMBER: P639
NWT/NU Association of Professional
Engineers and Geoscientists

uma
An AECOM Company

0	ISSUED FOR AS-BUILT	09/04/28
REVISIONS	DESCRIPTION	DATE


A	A detail number number du detail	A
B	B source drawing no. de dessin no.	B
C	C detail on drawing no. detail sur dessin no.	C

project title
**FOX-C Intermediate DEW Line Site
EKALUGAD FIORD
Site Restoration**

Nunavut

drawing title
**SOUTH MIDSTATION AREA
SITE PLAN**



designed by B. FEDORAK	conçu par
drawn by L. VARGAS	dessiné par
approved by R. SCHMIDTKE	approuvé par
PWOSC Project Manager B. THOMPSON	Administrateur de Projets TPSCC
scale 1:500	échelle
project no. 413759	projet no.
date APRIL, 2009	date
	sheet C05 OF 14

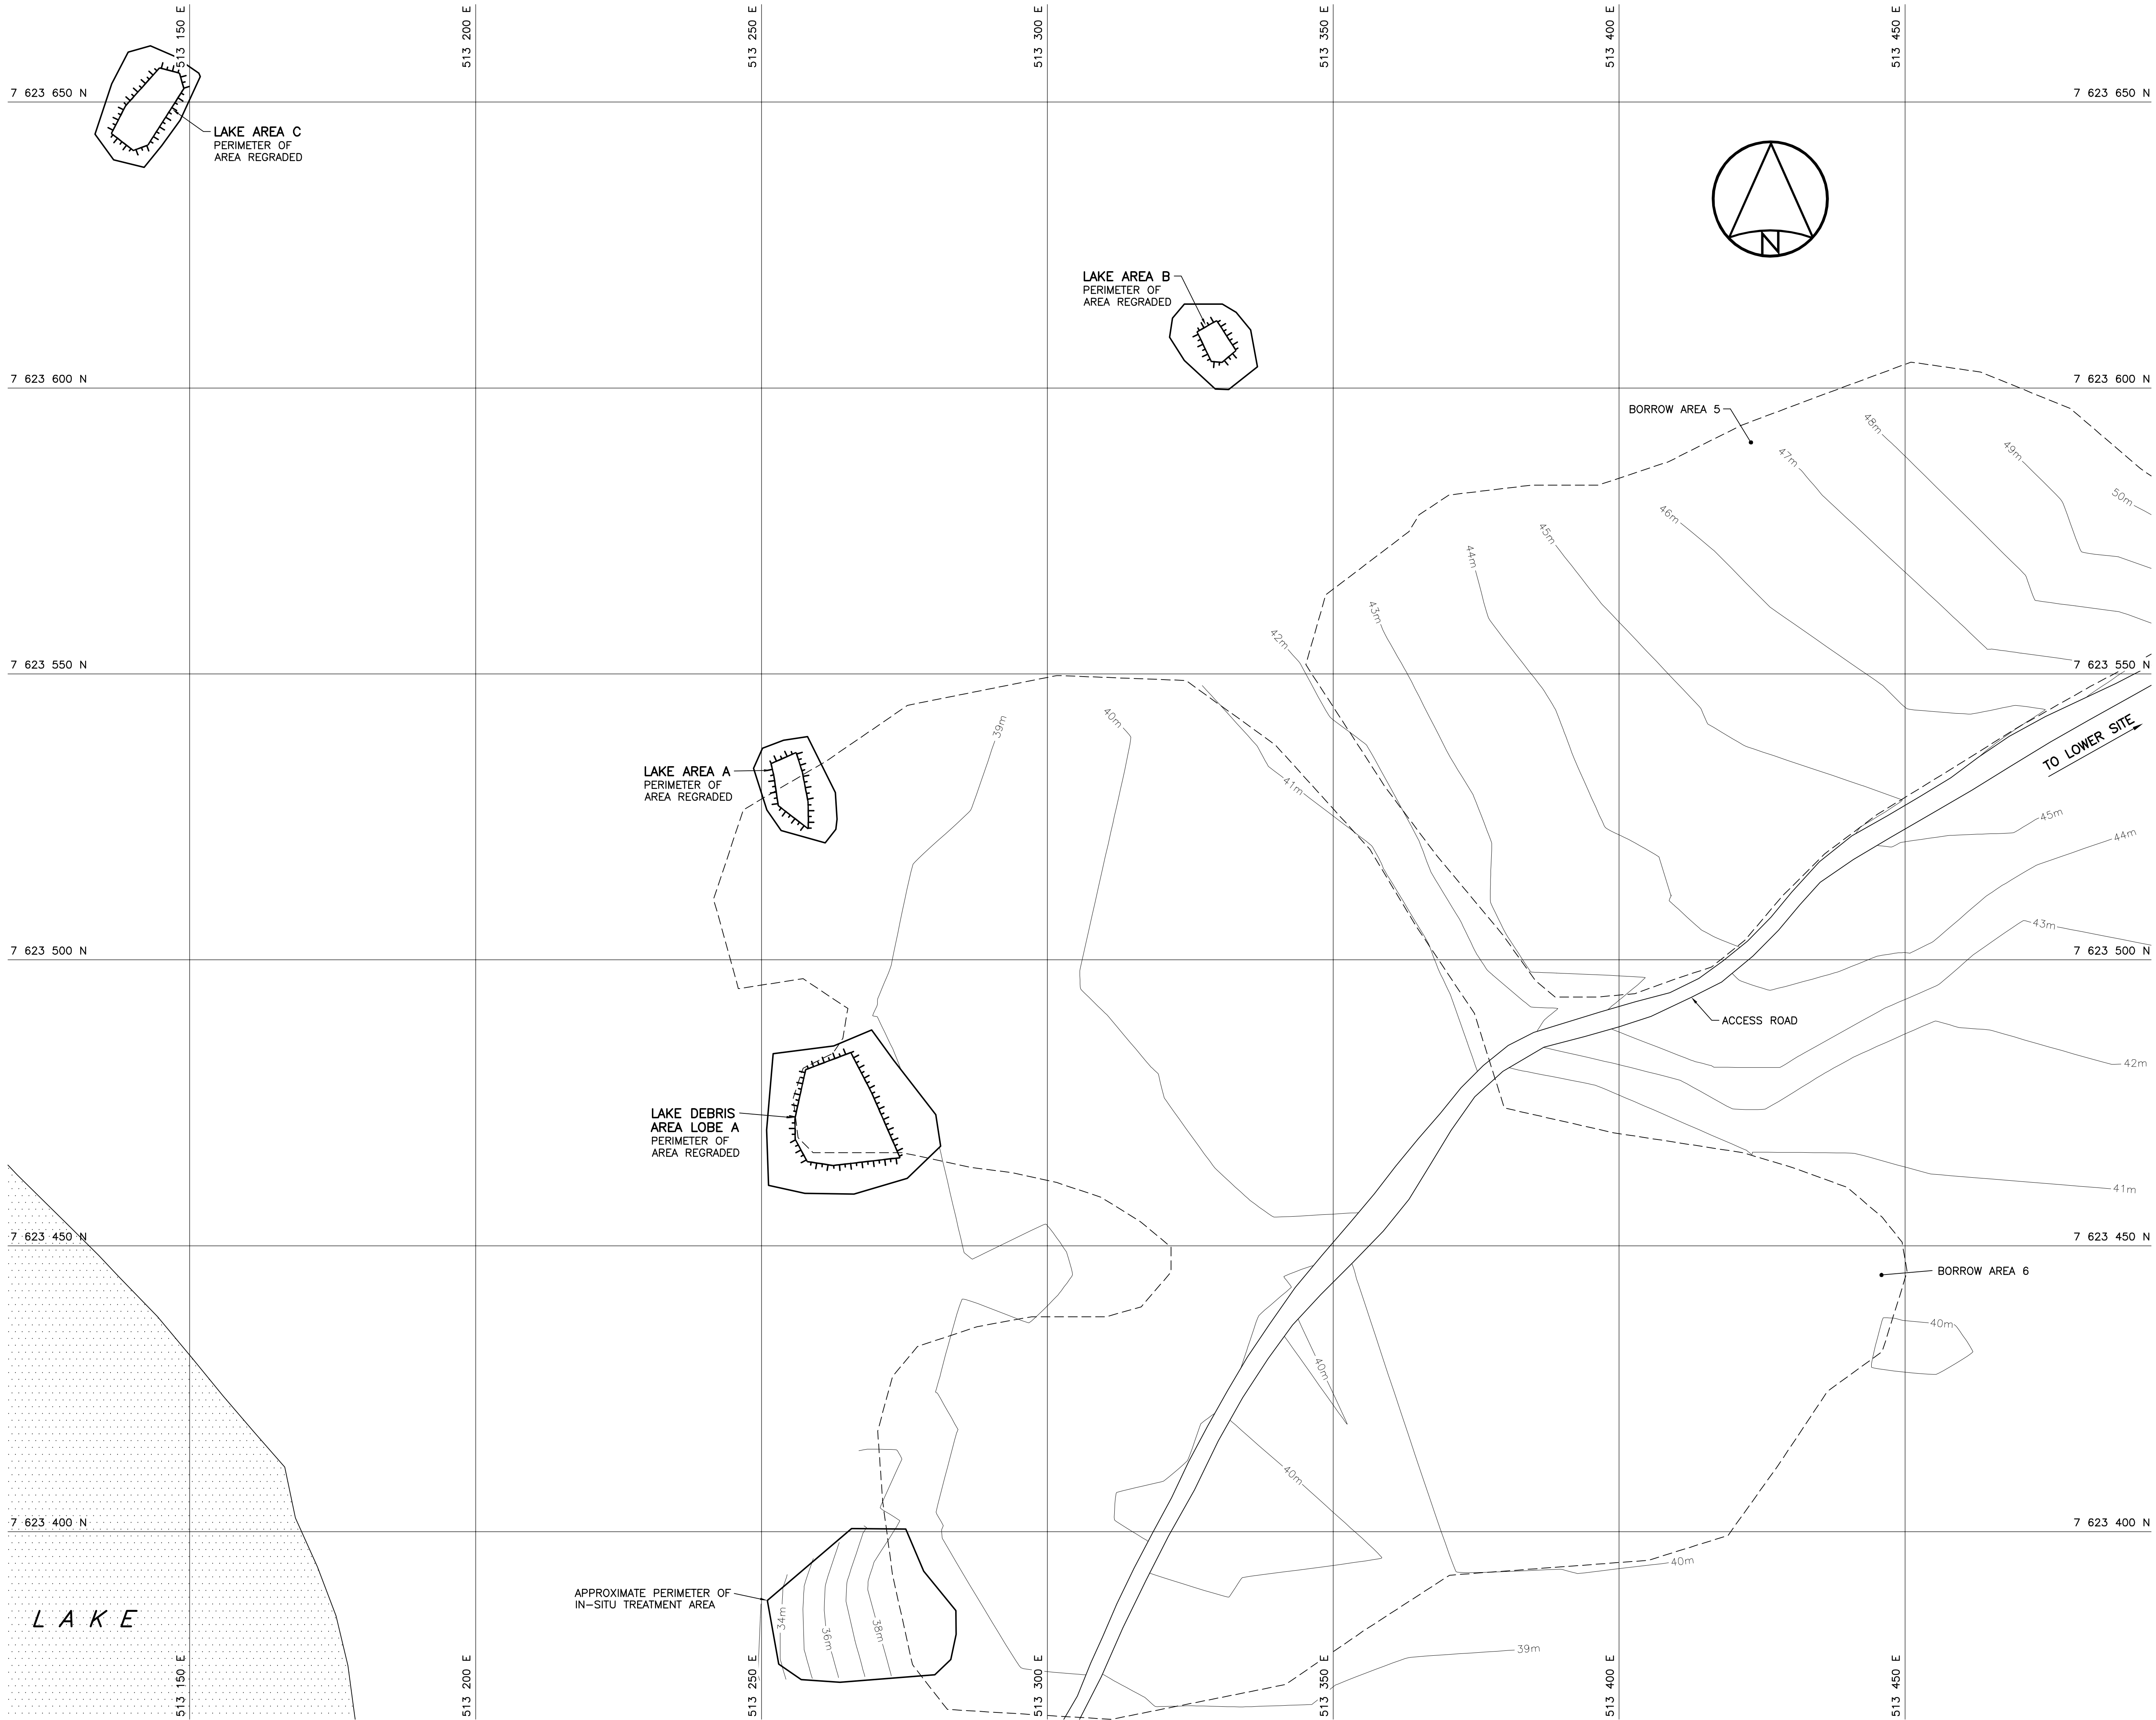

General Notes:

1. ALL COORDINATES ARE REFERENCED TO NAD83 CSRS, UTM ZONE 19. ELEVATIONS ARE REFERENCED TO MEAN SEA LEVEL, RELATIVE TO GEOD MODEL EGM96.
2. SITE PLANS AND TOPOGRAPHIC INFORMATION ARE BASED ON AIR PHOTOS AND SURVEYS. CURRENT CONDITIONS MAY NOT BE EXACTLY AS SHOWN.
3. ALL DIMENSIONS ARE IN METRES UNLESS NOTED OTHERWISE.

Legend:

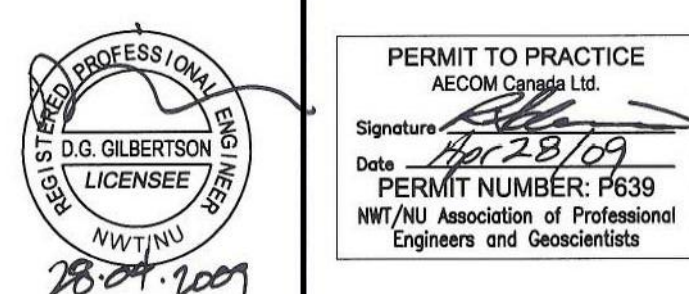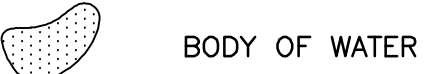

REVISIONS	DESCRIPTION	DATE
0	ISSUED FOR AS-BUILT	09/04/28

A	A detail number number du detail	A
C	B source drawing no. de dessin no.	B
	C detail on drawing no. detail sur dessin no.	C

project title
**FOX-C Intermediate DEW Line Site
EKALUGAD FORD
Site Restoration**

Nunavut

drawing title
**LAKE AREA
SITE PLAN**

designed by
B. FEDORAK

drawn by
L. VARGAS

approved by
R. SCHMIDTKE

PWOSC Project Manager
B. THOMPSON


scale
1:500

project no.
413759

date
APRIL, 2009

sheet
C06


OF 14

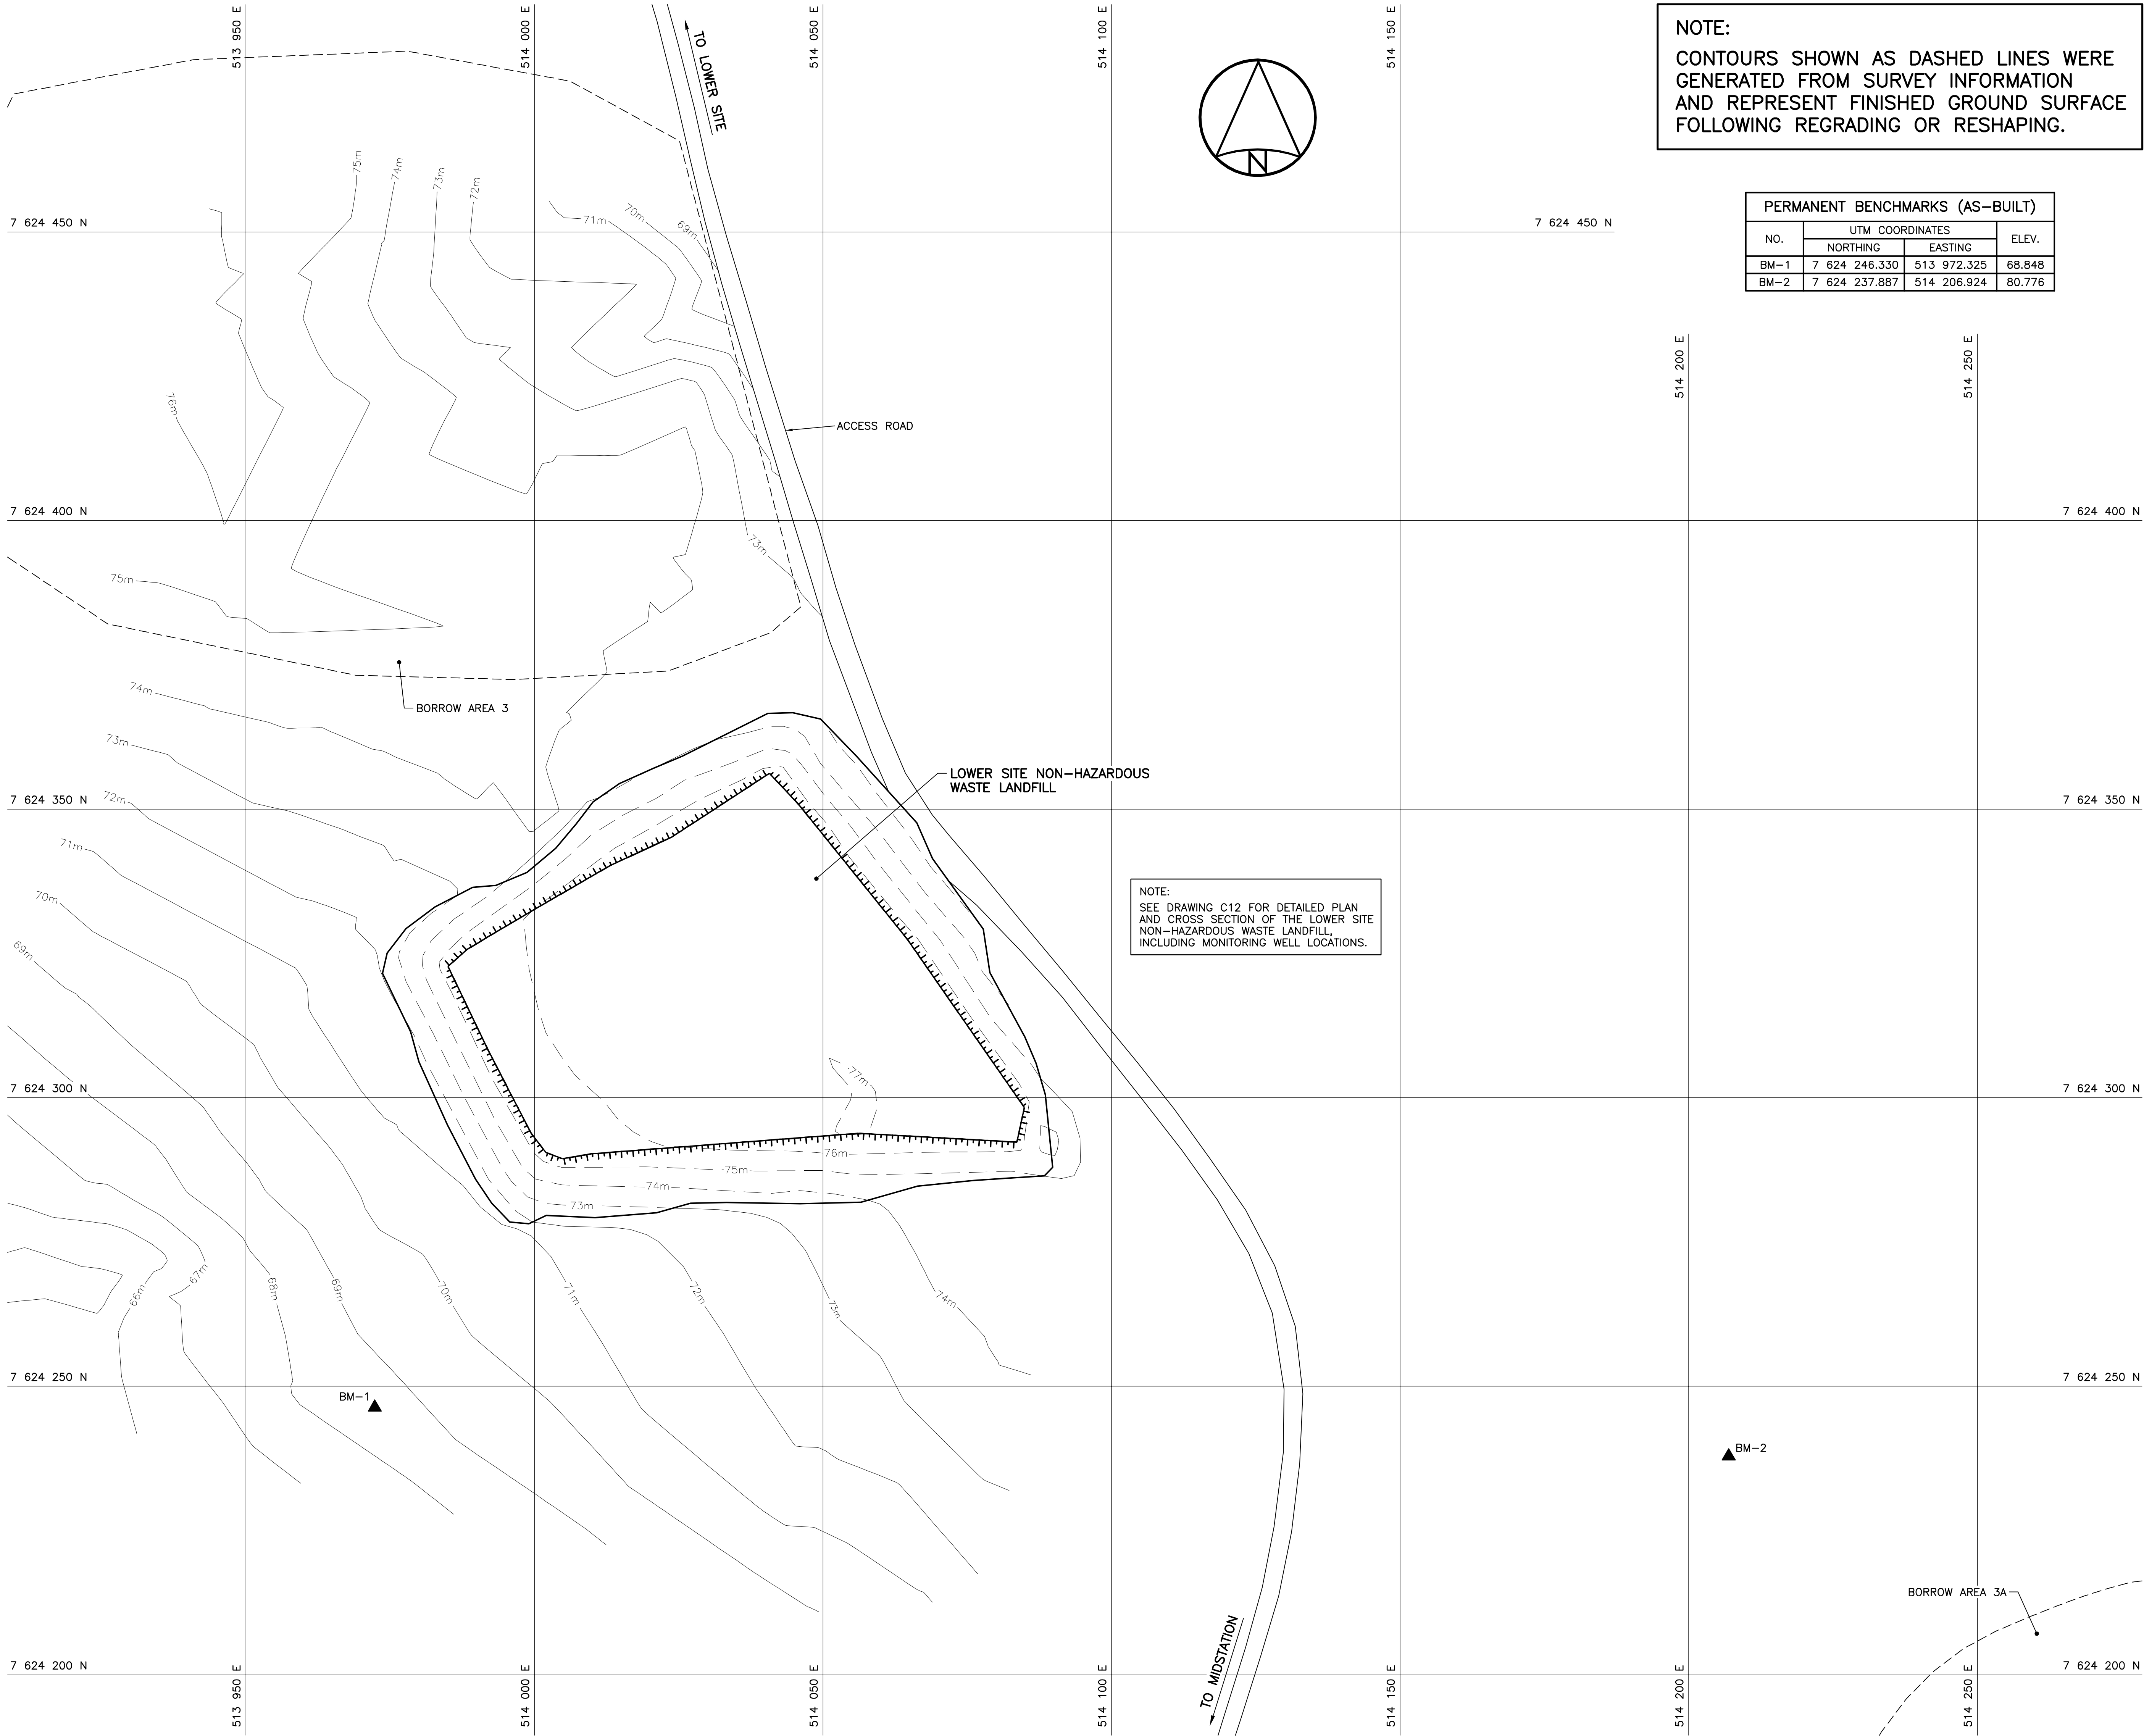

NOTE:
CONTOURS SHOWN AS DASHED LINES WERE
GENERATED FROM SURVEY INFORMATION
AND REPRESENT FINISHED GROUND SURFACE
FOLLOWING REGRADING OR RESHAPING.

PERMANENT BENCHMARKS (AS-BUILT)			
NO.	UTM COORDINATES		ELEV.
	NORTHING	EASTING	
BM-1	7 624 246.330	513 972.325	68.848
BM-2	7 624 237.887	514 206.924	80.776

NOTE:
SEE DRAWING C12 FOR DETAILED PLAN
AND CROSS SECTION OF THE LOWER SITE
NON-HAZARDOUS WASTE LANDFILL,
INCLUDING MONITORING WELL LOCATIONS.

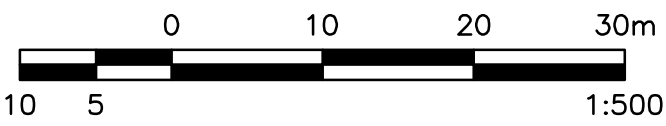



Public Works and
Government Services
Canada

Travaux publics et
Services gouvernementaux
Canada

REAL PROPERTY SERVICES
Western Region

Client



Indian and Northern
Affairs Canada

Client

Affaires indiennes
et du Nord Canada


CanadaTM
Nunavut Regional Office
Iqaluit, Nunavut

Client

Client

General Notes:
1. ALL COORDINATES ARE REFERENCED TO NAD83 CSRS, UTM_ZONE 19. ELEVATIONS ARE REFERENCED TO MEAN SEA LEVEL, RELATIVE TO GEOD MODEL EGM96.
2. SITE PLANS AND TOPOGRAPHIC INFORMATION ARE BASED ON AIR PHOTOS AND SURVEYS. CURRENT CONDITIONS MAY NOT BE EXACTLY AS SHOWN.
3. ALL DIMENSIONS ARE IN METRES UNLESS NOTED OTHERWISE.
4. FOR PERMANENT BENCHMARK INSTALLATION DETAILS, SEE DRAWING C13.

Legend:
▲ PERMANENT BENCHMARK LOCATION (2)

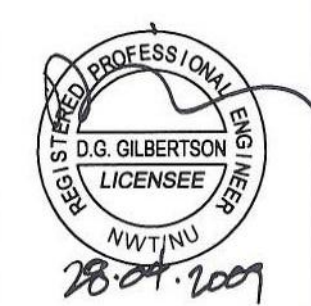

PERMIT TO PRACTICE
AECOM Group Ltd.
Signature: *[Signature]*
Date: 26.04.2009
PERMIT NUMBER: P639
NWT/NU Association of Professional
Engineers and Geoscientists



uma
An AECOM Company

0	ISSUED FOR AS-BUILT	09/04/28
REVISIONS	DESCRIPTION	DATE
A	detail number number du detail	A
B	source drawing no. de dessin no.	B
C	detail on drawing no. detail sur dessin no.	C

project title
titre du projet
FOX-C Intermediate DEW Line Site
EKALUGAD FIORD
Site Restoration
Nunavut

drawing title
titre du dessin
LOWER SITE NON-HAZARDOUS
WASTE LANDFILL AREA
SITE PLAN

designed by
conçu par
B. FEDORAK
drawn by
dessiné par
L. VARGAS
approved by
approuvé par
R. SCHMIDTKE
PWGSC Project Manager
Administrateur de Projets TPWGC
B. THOMPSON
scale
échelle
1:500
project no.
projet no.
413759
date
date
APRIL, 2009
sheet
feuille
C07
OF 14

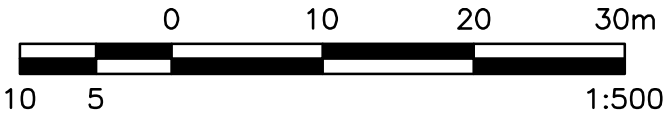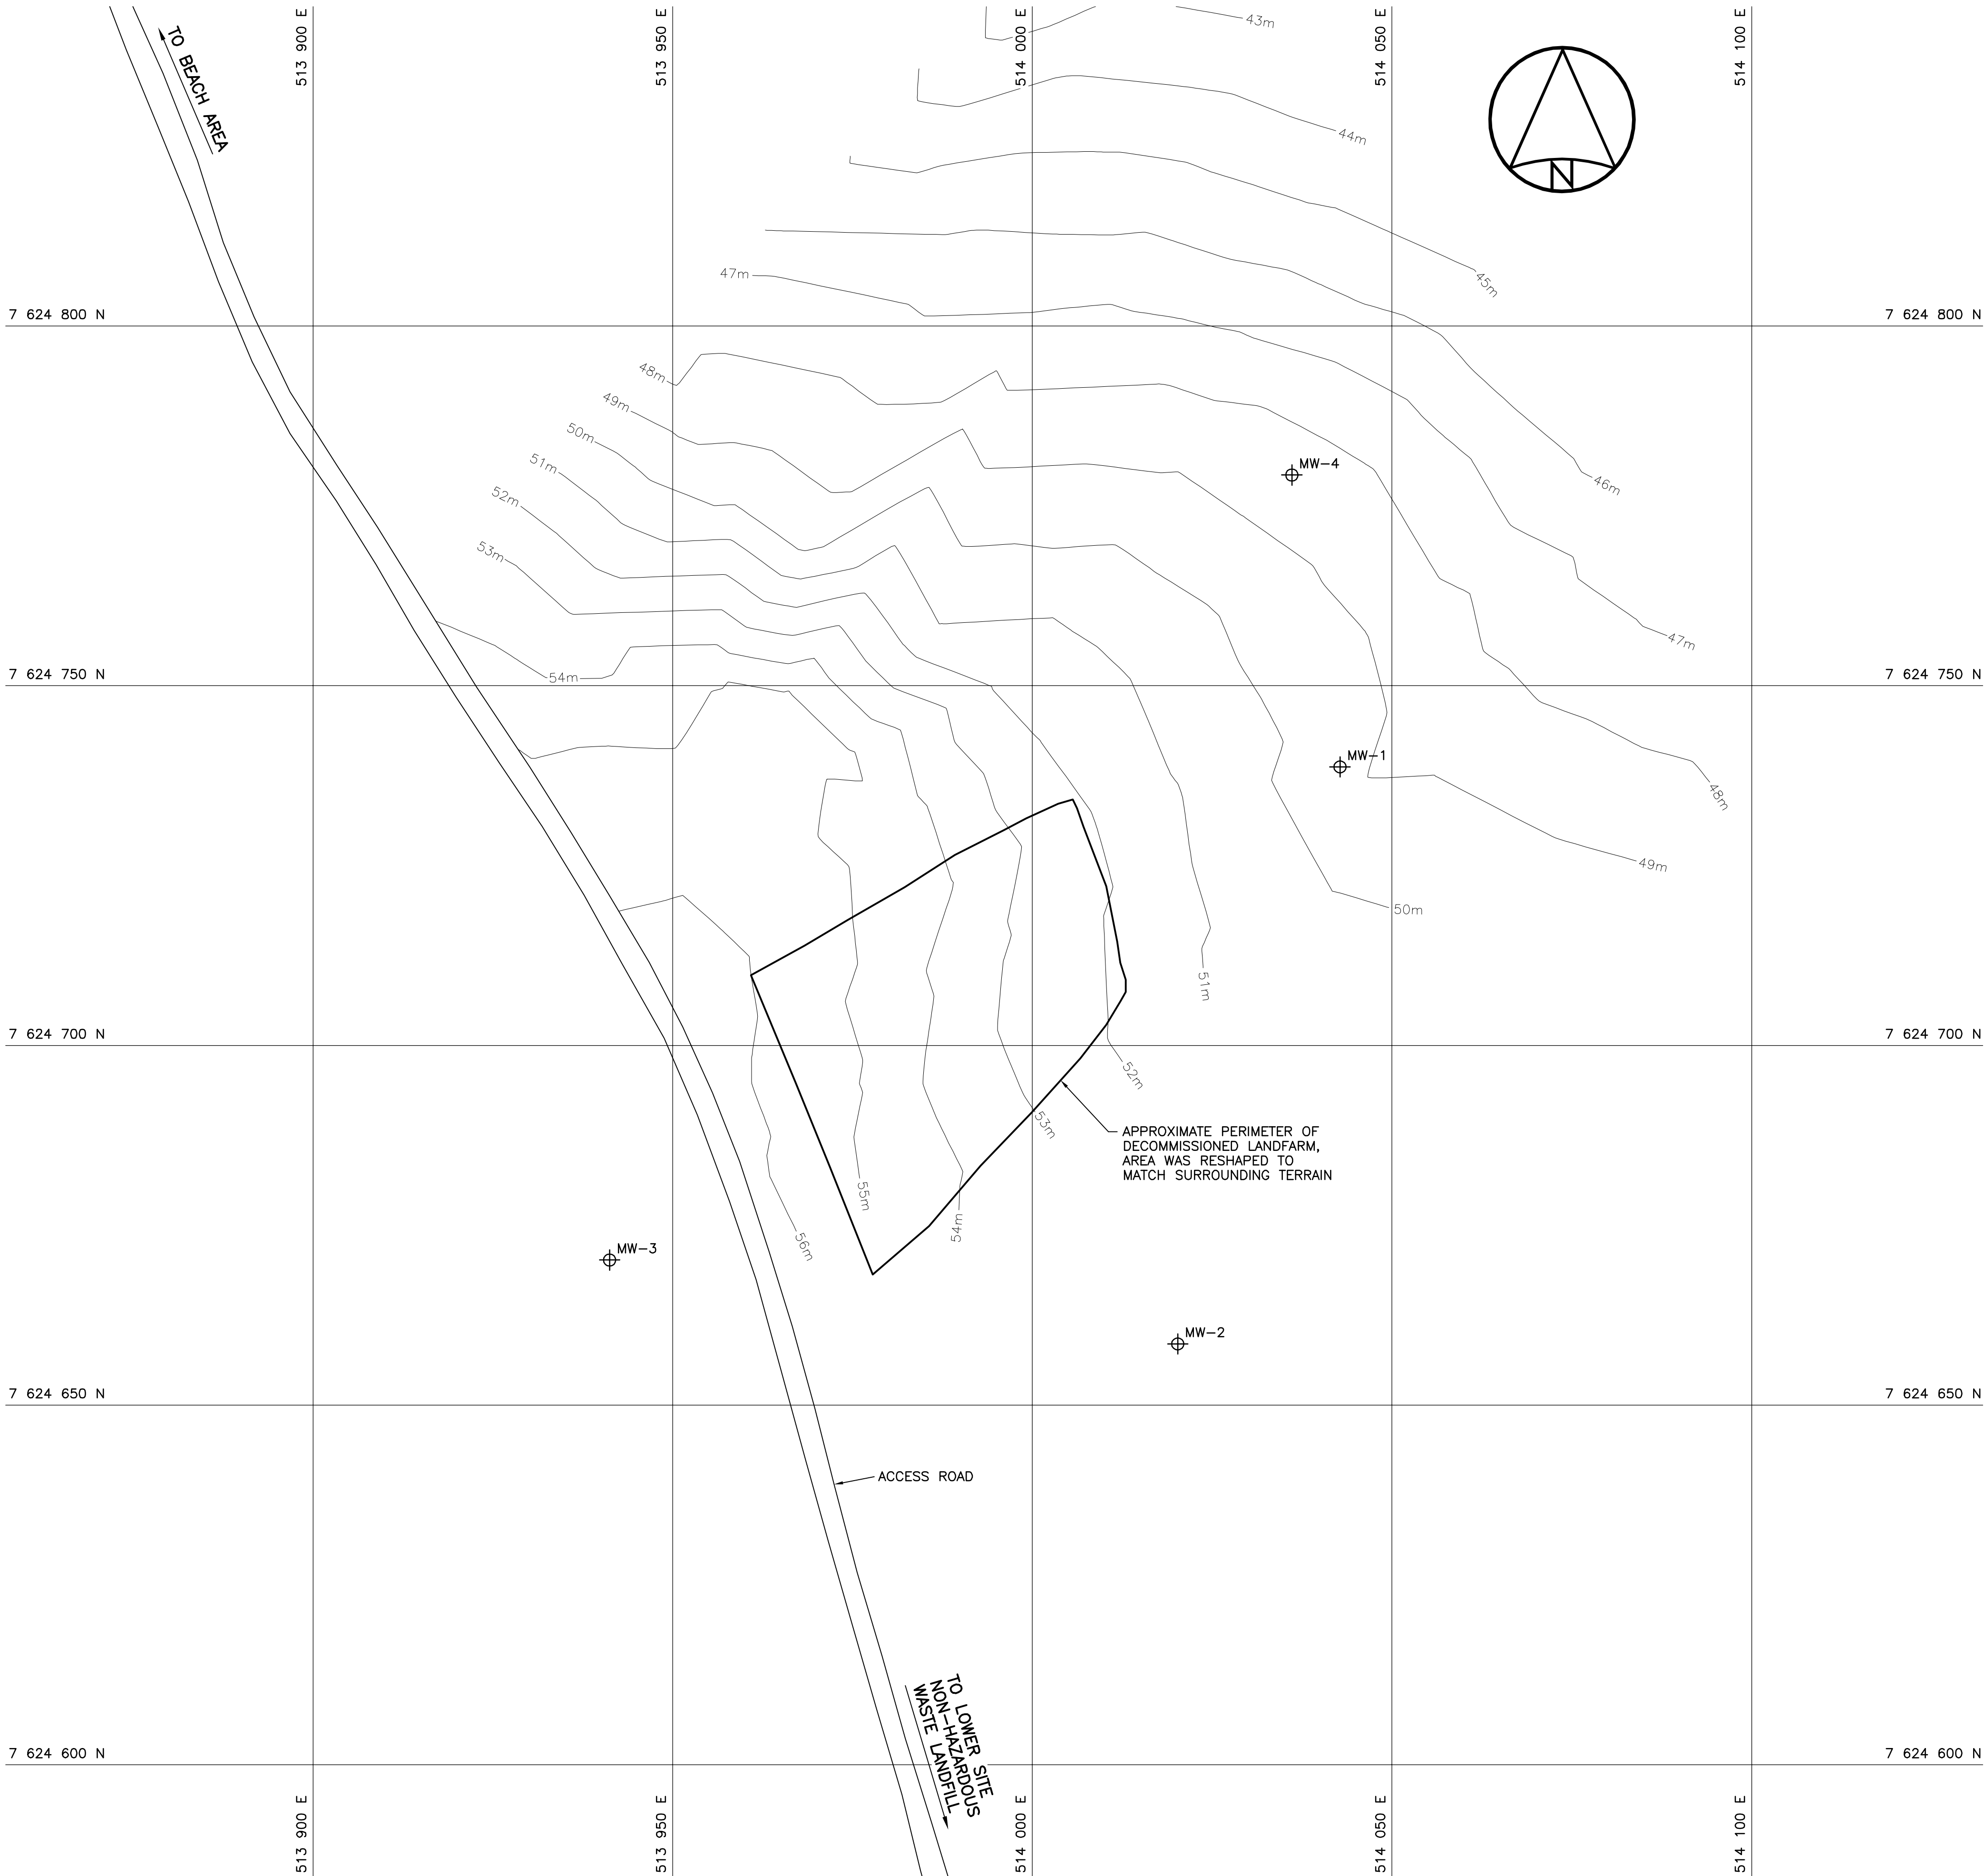

General Notes:

1. ALL COORDINATES ARE REFERENCED TO NAD83 CSRS, UTM ZONE 19. ELEVATIONS ARE REFERENCED TO MEAN SEA LEVEL, RELATIVE TO GEOD MODEL EGM96.
2. SITE PLANS AND TOPOGRAPHIC INFORMATION ARE BASED ON AIR PHOTOS AND SURVEYS. CURRENT CONDITIONS MAY NOT BE EXACTLY AS SHOWN.
3. ALL DIMENSIONS ARE IN METRES UNLESS NOTED OTHERWISE.

Legend:

- ⊕ MONITORING WELL LOCATION (4)
(DECOMMISSIONED)

PERMIT TO PRACTICE
AECOM Canada Ltd.
Signature: *[Signature]*
Date: *26.04.2009*
PERMIT NUMBER: P639
NWT/NU Association of Professional Engineers and Geoscientists

0	ISSUED FOR AS-BUILT	09/04/28
REVISIONS	DESCRIPTION	DATE

A	A detail number number du détail	A
B	B source drawing no. de dessin no.	B
C	C detail on drawing no. détail sur dessin no.	C

project title / titre du projet
**FOX-C Intermediate DEW Line Site
EKALUGAD FIOR
Site Restoration**

Nunavut

drawing title / titre du dessin
**LOWER SITE AREA
SITE PLAN**

designed by / conçu par B. FEDORAK	drawn by / dessiné par L. VARGAS	approved by / approuvé par R. SCHMIDTKE
PWSC Project Manager B. THOMPSON	Administrateur de Projets TPSC	
scale / échelle 1:500	sheet / feuille C08	project no. / projet no. 413759
date / date APRIL, 2009		OF 14





Public Works and
Government Services
Canada

Travaux publics et
Services gouvernementaux
Canada

REAL PROPERTY SERVICES
Western Region

Client



Indian and Northern
Affairs Canada

Client

Affaires indiennes
et du Nord Canada

Canada

Nunavut Regional Office
Iqaluit, Nunavut

Client

Client

General Notes:


1. ALL COORDINATES ARE REFERENCED TO
NAD83 CSRS, UTM_ZONE 19. ELEVATIONS
ARE REFERENCED TO MEAN SEA LEVEL,
RELATIVE TO GEOD MODEL EGM96.


2. SITE PLANS AND TOPOGRAPHIC INFORMATION
ARE BASED ON AIR PHOTOS AND SURVEYS.
CURRENT CONDITIONS MAY NOT BE EXACTLY
AS SHOWN.


3. ALL DIMENSIONS ARE IN METRES UNLESS
NOTED OTHERWISE.

Legend:

FORMER BUILDING, STRUCTURE OR
TANK LOCATION

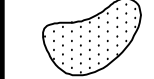BODY OF WATER

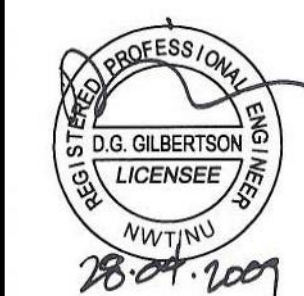

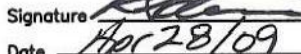PERMIT TO PRACTICE
AECOM Canada Ltd.
Signature: 
Date: 26/04/2009
PERMIT NUMBER: P639
NWT/NU Association of Professional
Engineers and Geoscientists

uma

An AECOM Company

0	ISSUED FOR AS-BUILT	09/04/28
REVISIONS	DESCRIPTION	DATE
A	detail number number du detail	A
B	source drawing no. de dessin no.	B
C	detail on drawing no. detail sur dessin no.	C

project title

titre du projet

FOX-C Intermediate DEW Line Site
EKALUGAD FIORD
Site Restoration

Nunavut

drawing title

titre du dessin

BEACH AREA
SITE PLAN

designed by

conçu par

B. FEDORAK

drawn by

dessiné par

L. VARGAS

approved by

approuvé par

R. SCHMIDTKE

PWSC Project Manager

Administrateur de Projets TPSCG

B. THOMPSON

scale

échelle

1:500

project no.

projet no.

413759

date

date

APRIL, 2009

sheet


feuille

C09

OF


14

413759-C09.DWG


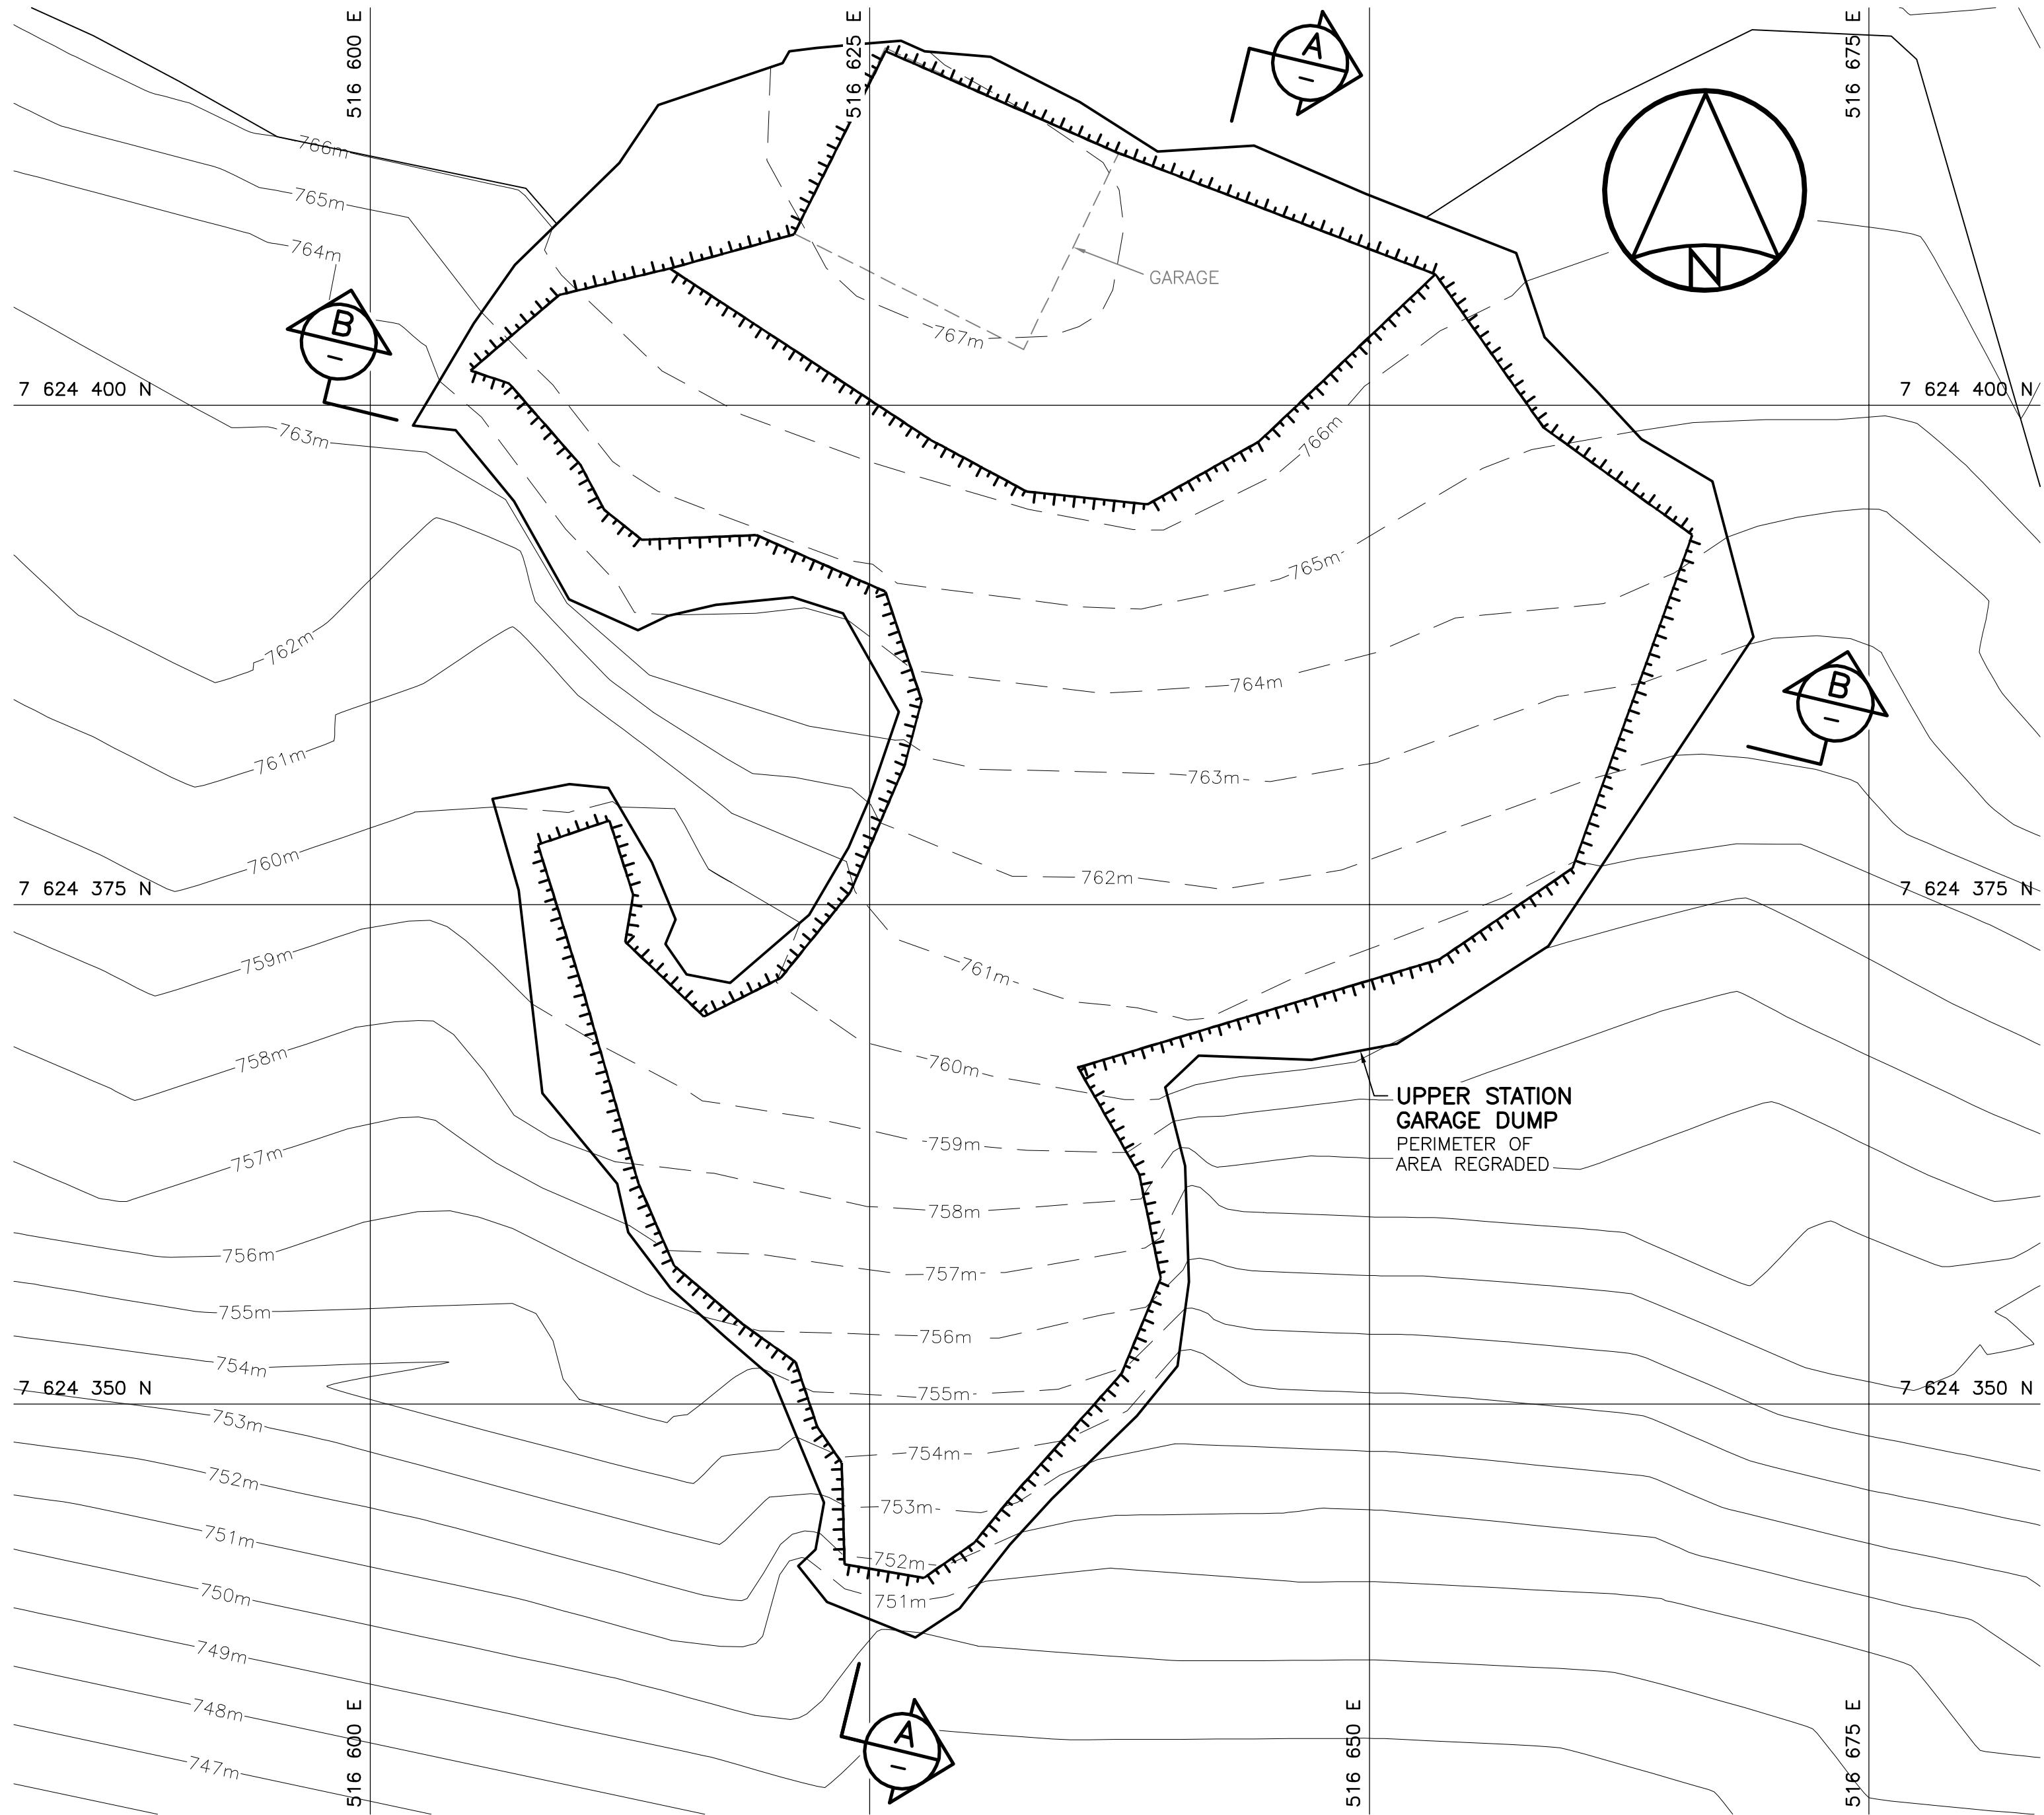


PLAN



NOTE:
CONTOURS SHOWN AS DASHED LINES WERE
GENERATED FROM SURVEY INFORMATION
AND REPRESENT FINISHED GROUND SURFACE
FOLLOWING REGRAIDING OR RESHAPING.

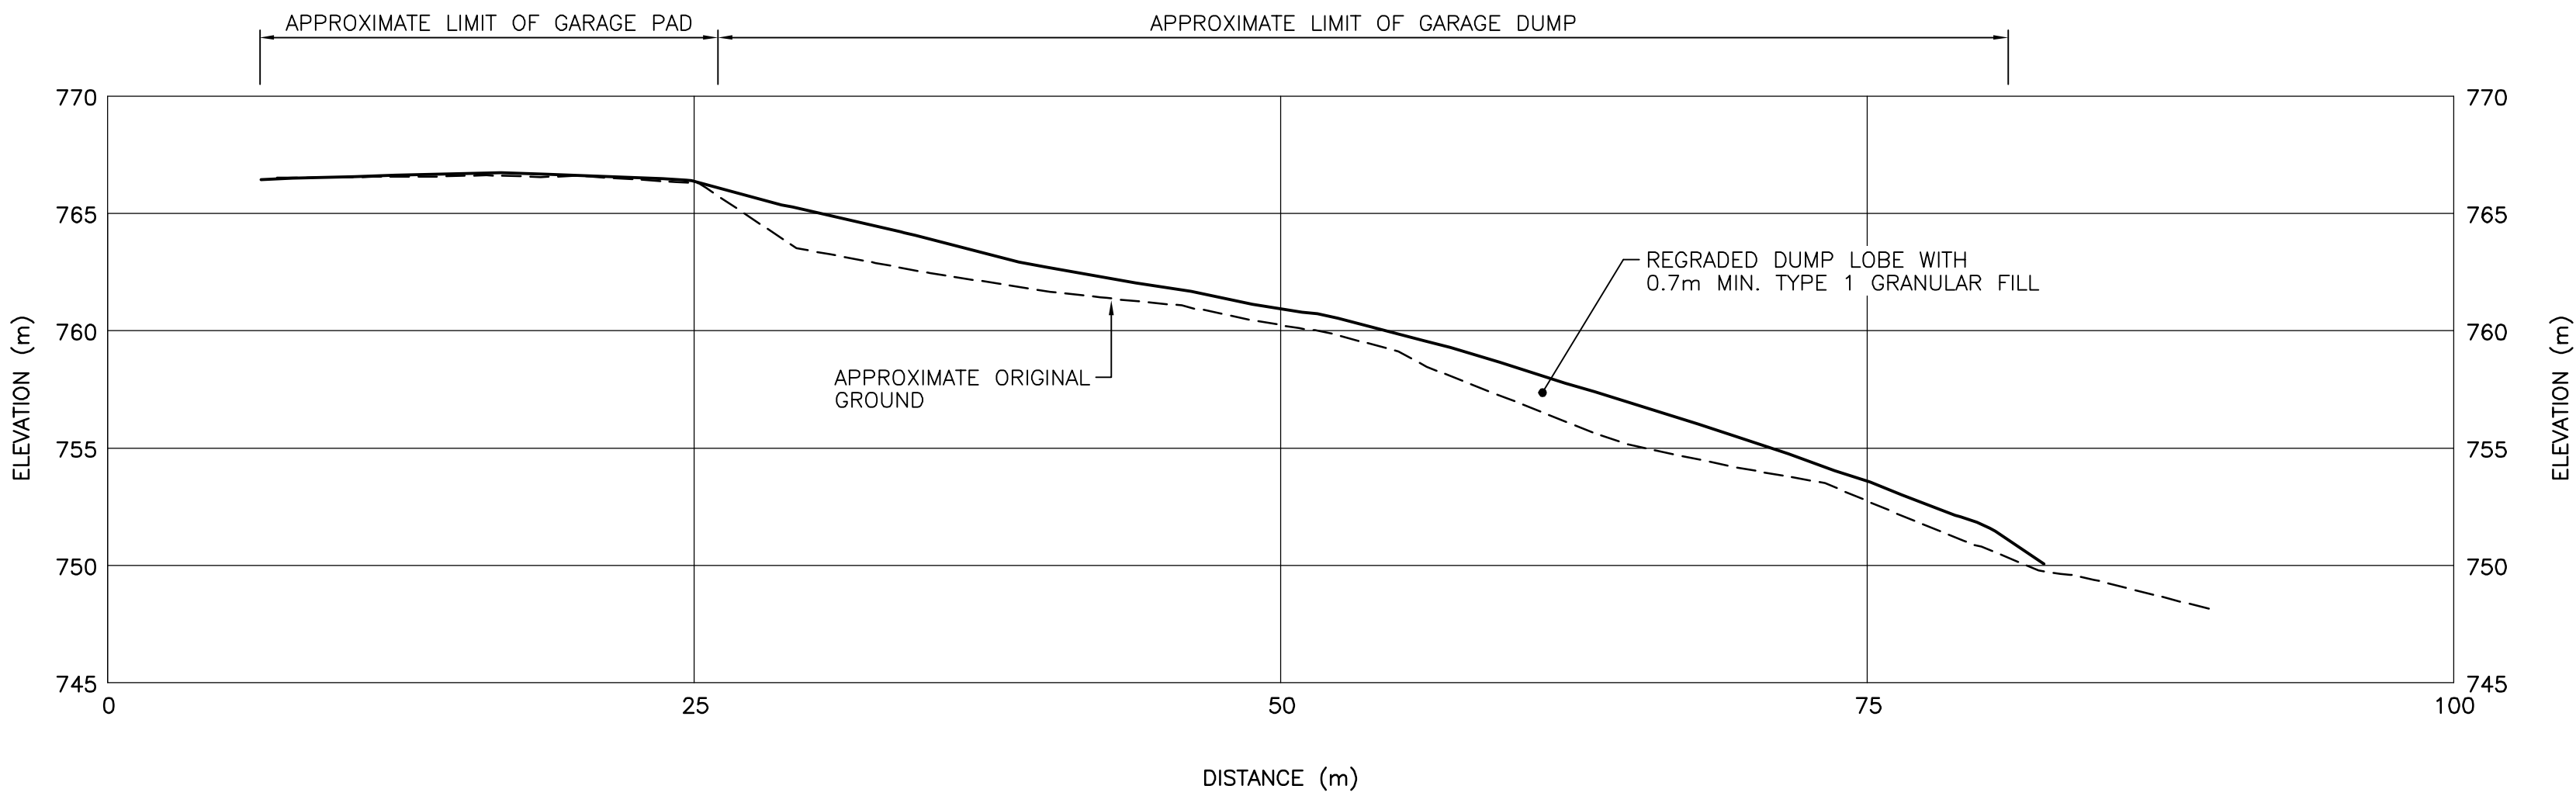

SECTION

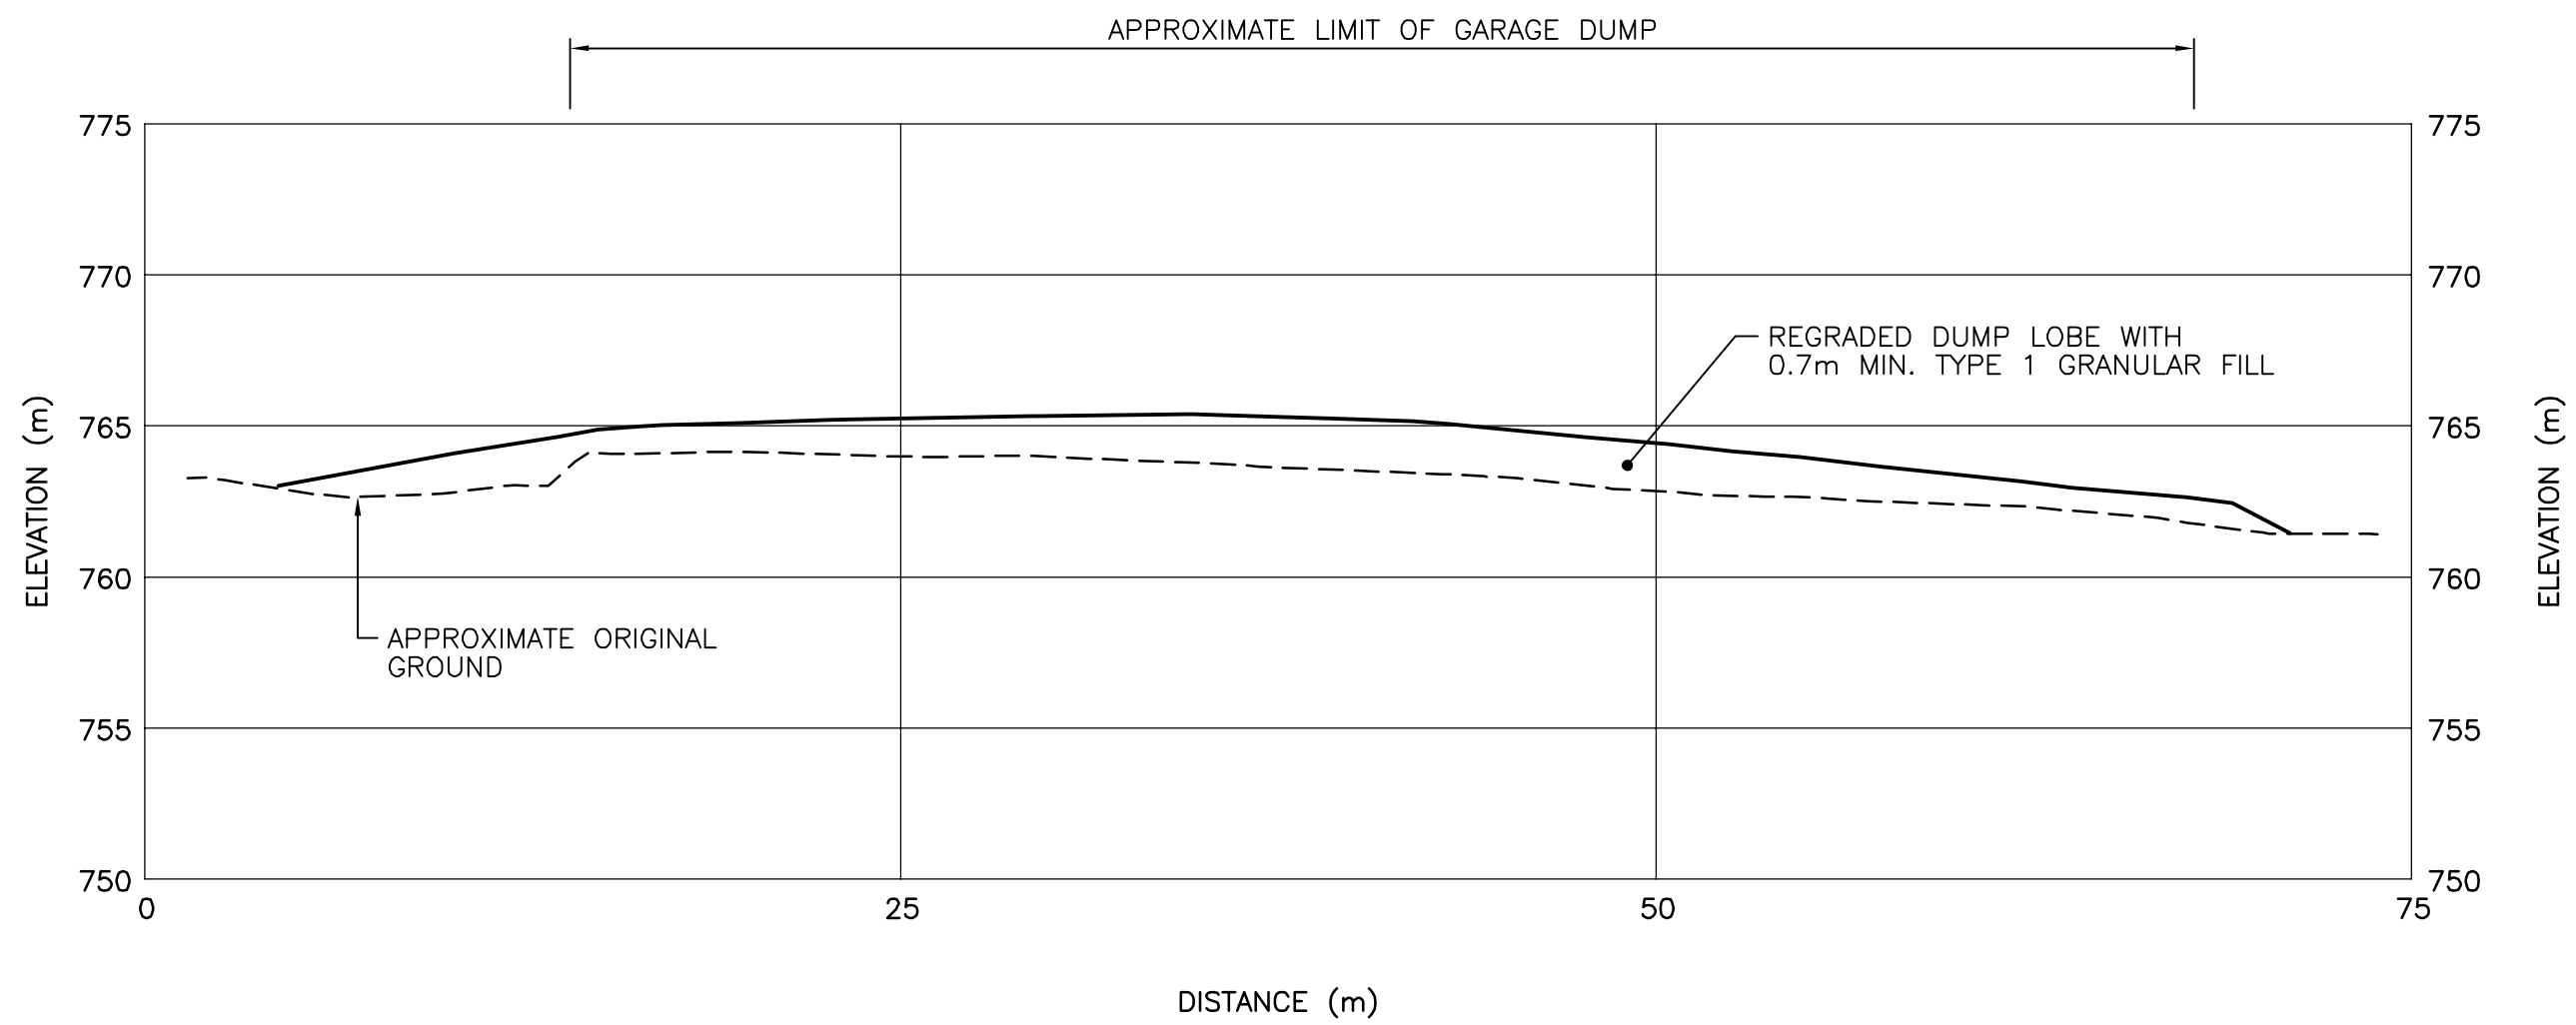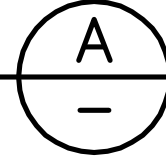

SECTION

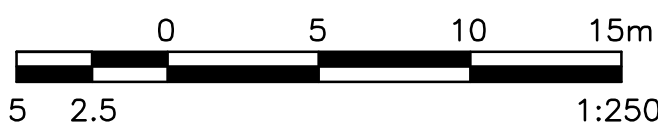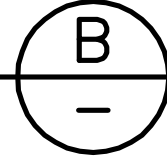


General Notes:

1. ALL COORDINATES ARE REFERENCED TO NAD83 CSRS, UTM, ZONE 19. ELEVATIONS ARE REFERENCED TO MEAN SEA LEVEL, RELATIVE TO GEOD. MODEL EGM96.
2. SITE PLANS AND TOPOGRAPHIC INFORMATION ARE BASED ON AIR PHOTOS AND SURVEYS. CURRENT CONDITIONS MAY NOT BE EXACTLY AS SHOWN.
3. ALL DIMENSIONS ARE IN METRES UNLESS NOTED OTHERWISE.

Legend:

- FORMER BUILDING, STRUCTURE OR TANK LOCATION

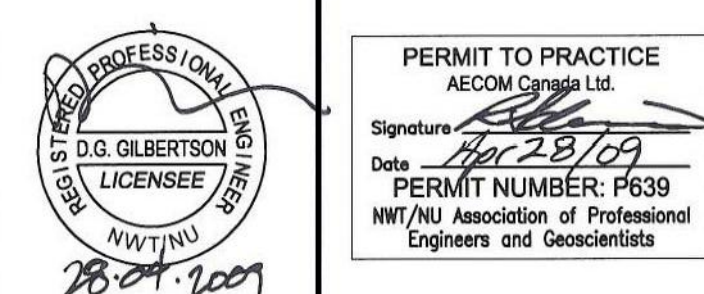

0	ISSUED FOR AS-BUILT	09/04/28
---	---------------------	----------



REVISIONS	DESCRIPTION	DATE
A	detail number number du detail	A
B	source drawing no. de dessin no.	B
C	detail on drawing no. detail sur dessin no.	C

project title / titre du projet
**FOX-C Intermediate DEW Line Site
EKALUGAD FIORD
Site Restoration**


Nunavut

drawing title / titre du dessin
**UPPER STATION GARAGE DUMP
PLAN AND CROSS SECTIONS**

designed by / conçu par B. FEDORAK	drawn by / dessiné par L. VARGAS	approved by / approuvé par R. SCHMIDTKE
PWOSC Project Manager B. THOMPSON	Administrateur de Projets TPSCG	
scale / échelle 1:250	sheet / feuille C10	project no. / projet no. 413759
date APRIL, 2009	date OF 14	

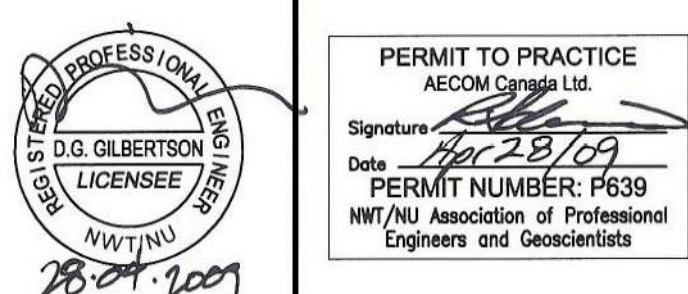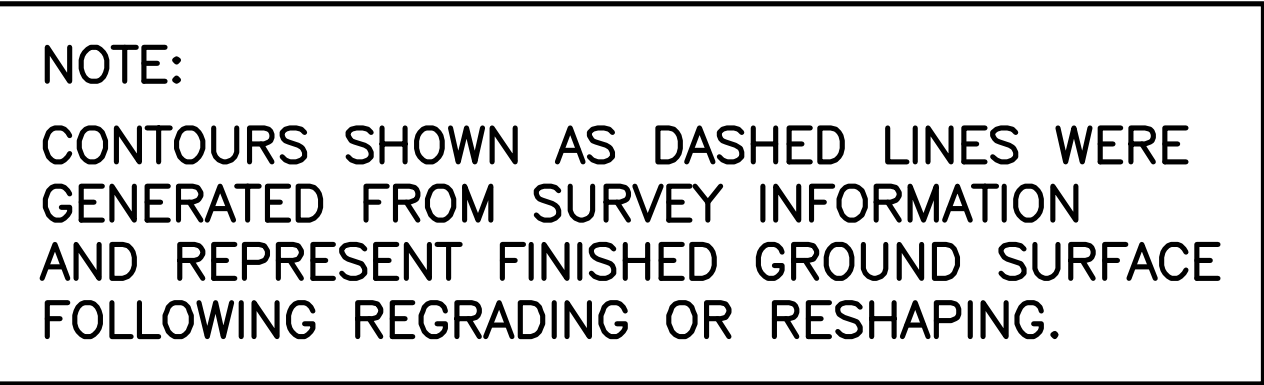

0	ISSUED FOR AS-BUILT	09/04/
PROVISIONS	DESCRIPTION	DATE

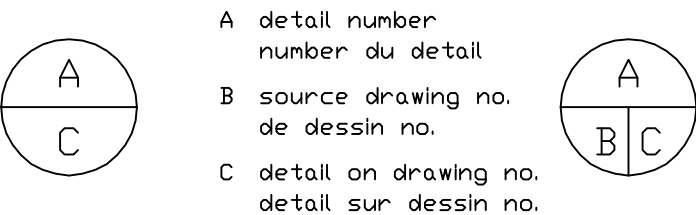

Project title
**FOX-C Intermediate DEW Line Site
 EKALUGAD FIORD
 Site Restoration**

Nunavut

**MIDSTATION DUMP LOBE B
EXCAVATION PLAN AND
CROSS SECTION**

designed by condu p
B. FEDORAK

rown by dessine p
L. VARGAS


approved by approuvé par
R. SCHMIDTKE

WGSC Project Manager Administrateur de Projets TPSC
B. THOMPSON



scale	echelle	sheet	feuille
AS SHOWN			

project no.	413759	project no.	C11
-------------	--------	-------------	-----


41250-015 (2)

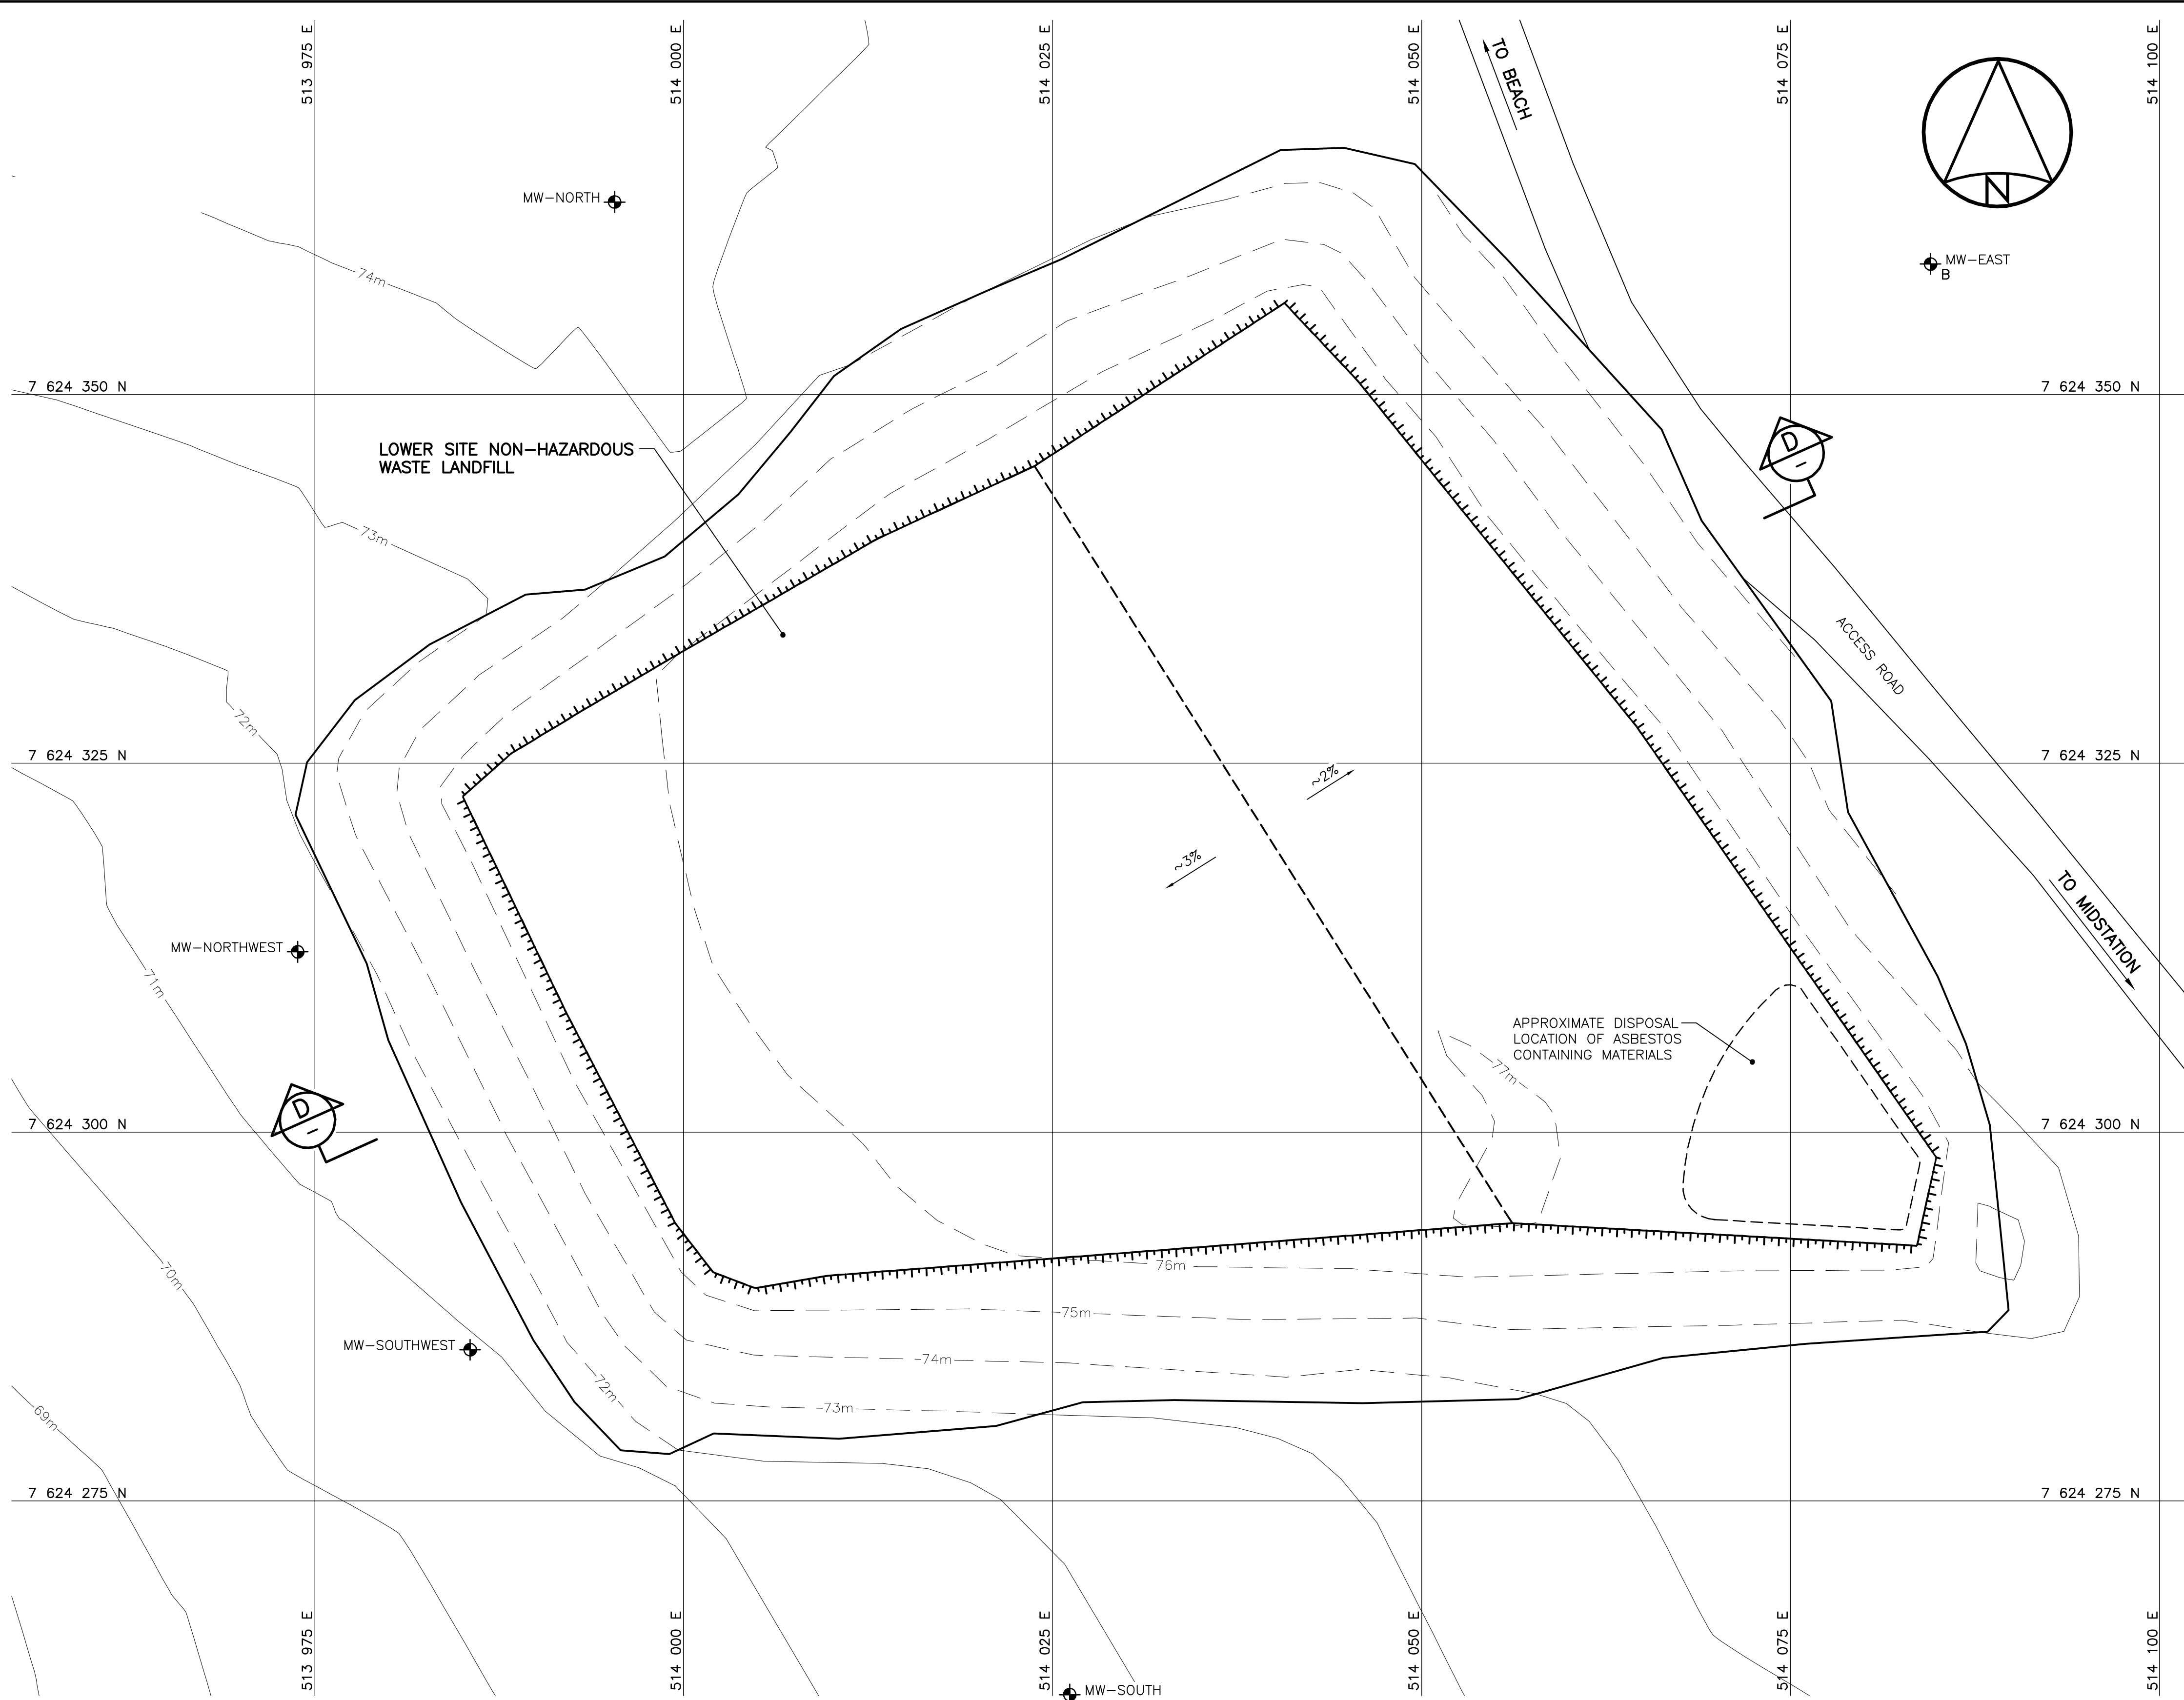

PLAN

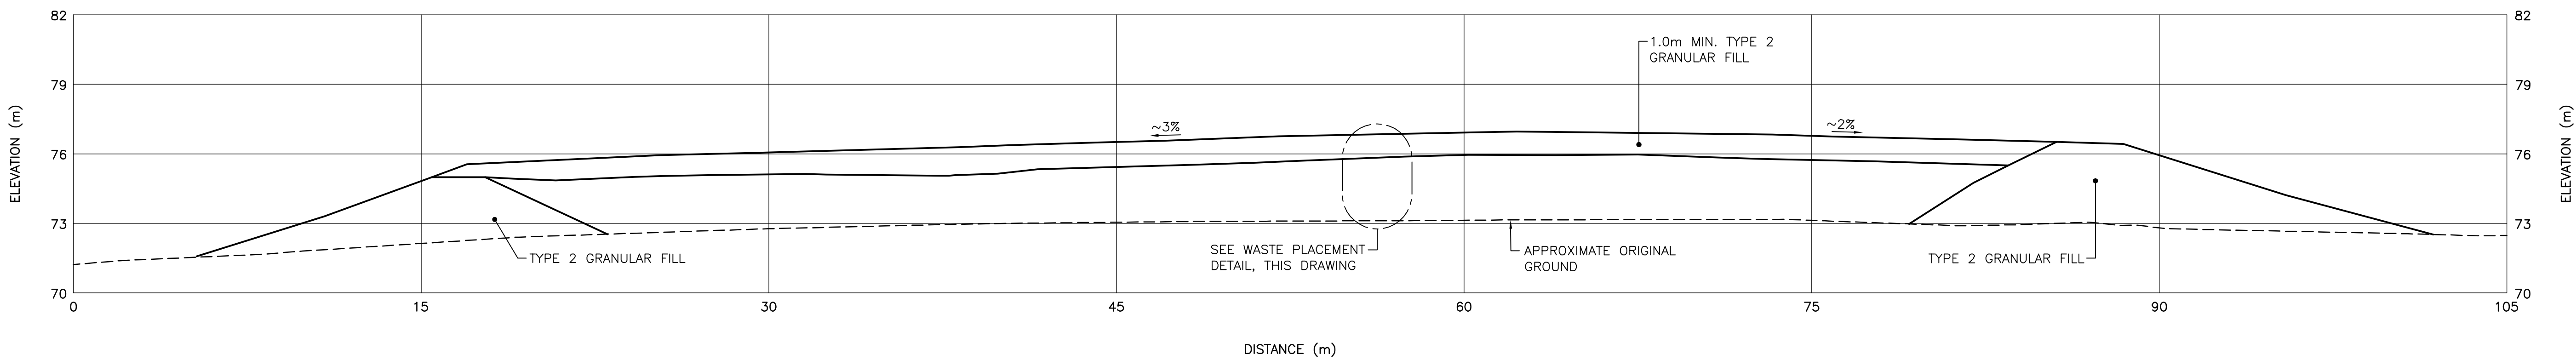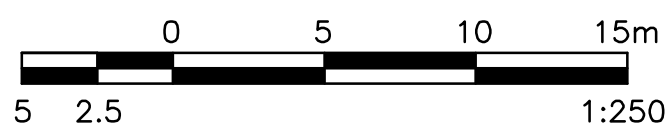

SECTION

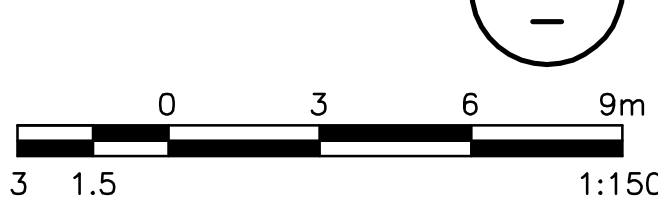


NOTE:

CONTOURS SHOWN AS DASHED LINES WERE GENERATED FROM SURVEY INFORMATION AND REPRESENT FINISHED GROUND SURFACE FOLLOWING REGRADING OR RESHAPING.

MONITORING WELLS (AS-BUILT)			
NO.	UTM COORDINATES		ELEV.*
	NORTHING	EASTING	
MW-NORTH	7 624 363.0	513 995.3	74.8
MW-EAST	7 624 358.8	514 084.5	69.8
MW-SOUTH	7 624 261.9	514 026.2	72.4
MW-SOUTHWEST	7 624 285.3	513 985.5	71.5
MW-NORTHWEST	7 624 312.2	513 973.8	72.0

* NOTE: ELEVATION IS TOP OF PIPE.

ADDITIONAL WASTE LAYERS, MAY HAVE BEEN REQUIRED, TO ACHIEVE THE NON-HAZARDOUS WASTE LANDFILL DESIGN ELEVATIONS.

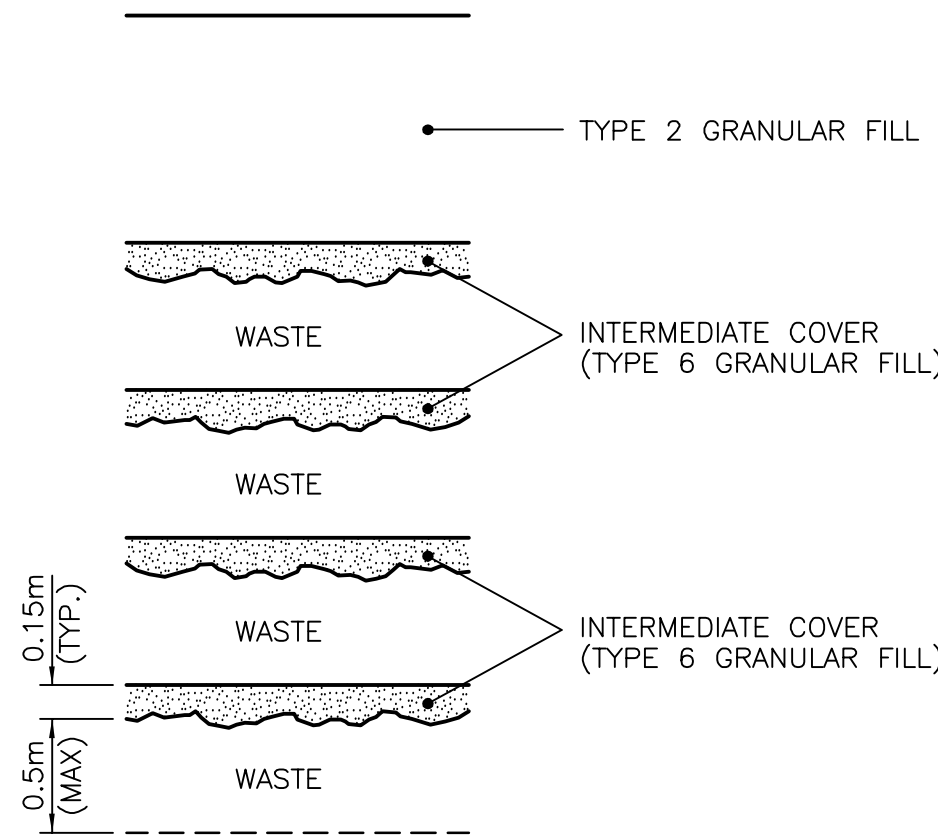

WASTE PLACEMENT DETAIL

SCALE: NTS

REAL PROPERTY SERVICES
Western Region

Canada


Nunavut Regional Office
Iqaluit, Nunavut

General Notes:

- ALL COORDINATES ARE REFERENCED TO NAD83 CSRS, UTM_ZONE 19. ELEVATIONS ARE REFERENCED TO MEAN SEA LEVEL, RELATIVE TO GEOID MODEL EGM96.
- SITE PLANS AND TOPOGRAPHIC INFORMATION ARE BASED ON AIR PHOTOS AND SURVEYS. CURRENT CONDITIONS MAY NOT BE EXACTLY AS SHOWN.
- ALL DIMENSIONS ARE IN METRES UNLESS NOTED OTHERWISE.
- FOR MONITORING WELL INSTALLATION DETAILS, SEE DRAWING C13 AND C14.

Legend:

- MONITORING WELL LOCATION (4)
- BACKGROUND MONITORING WELL LOCATION (1)

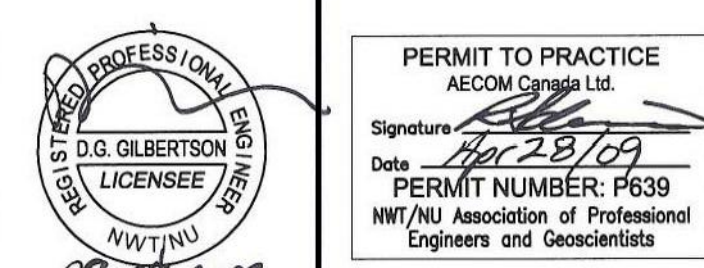

uma
An AECOM Company

REV	DESCRIPTION	DATE
2	ISSUED FOR AS-BUILT	09/04/28
1	LANDFILL REVISED AND ISSUED FOR APPROVAL	07/06/03
0	ISSUED FOR CONSTRUCTION	08/07/25


A	detail number number du detail	A
C	source drawing no. de dessin no.	B
	detail on drawing no. detail sur dessin no.	C

project title
titre du projet
**FOX-C Intermediate DEW Line Site
EKALUGAD FIORD
Site Restoration**

Nunavut


drawing title
titre du dessin
**LOWER SITE
NON-HAZARDOUS WASTE LANDFILL
PLAN AND CROSS SECTION**

designed by conçu par B. FEDORAK	drawn by dessiné par L. VARGAS	approved by approuvé par R. SCHMIDTKE
PWOSC Project Manager Administrateur de Projets TPSCC B. THOMPSON	scale échelle AS SHOWN	sheet feuille C12
project no. projet no. 413759	date date APRIL, 2009	OF 14

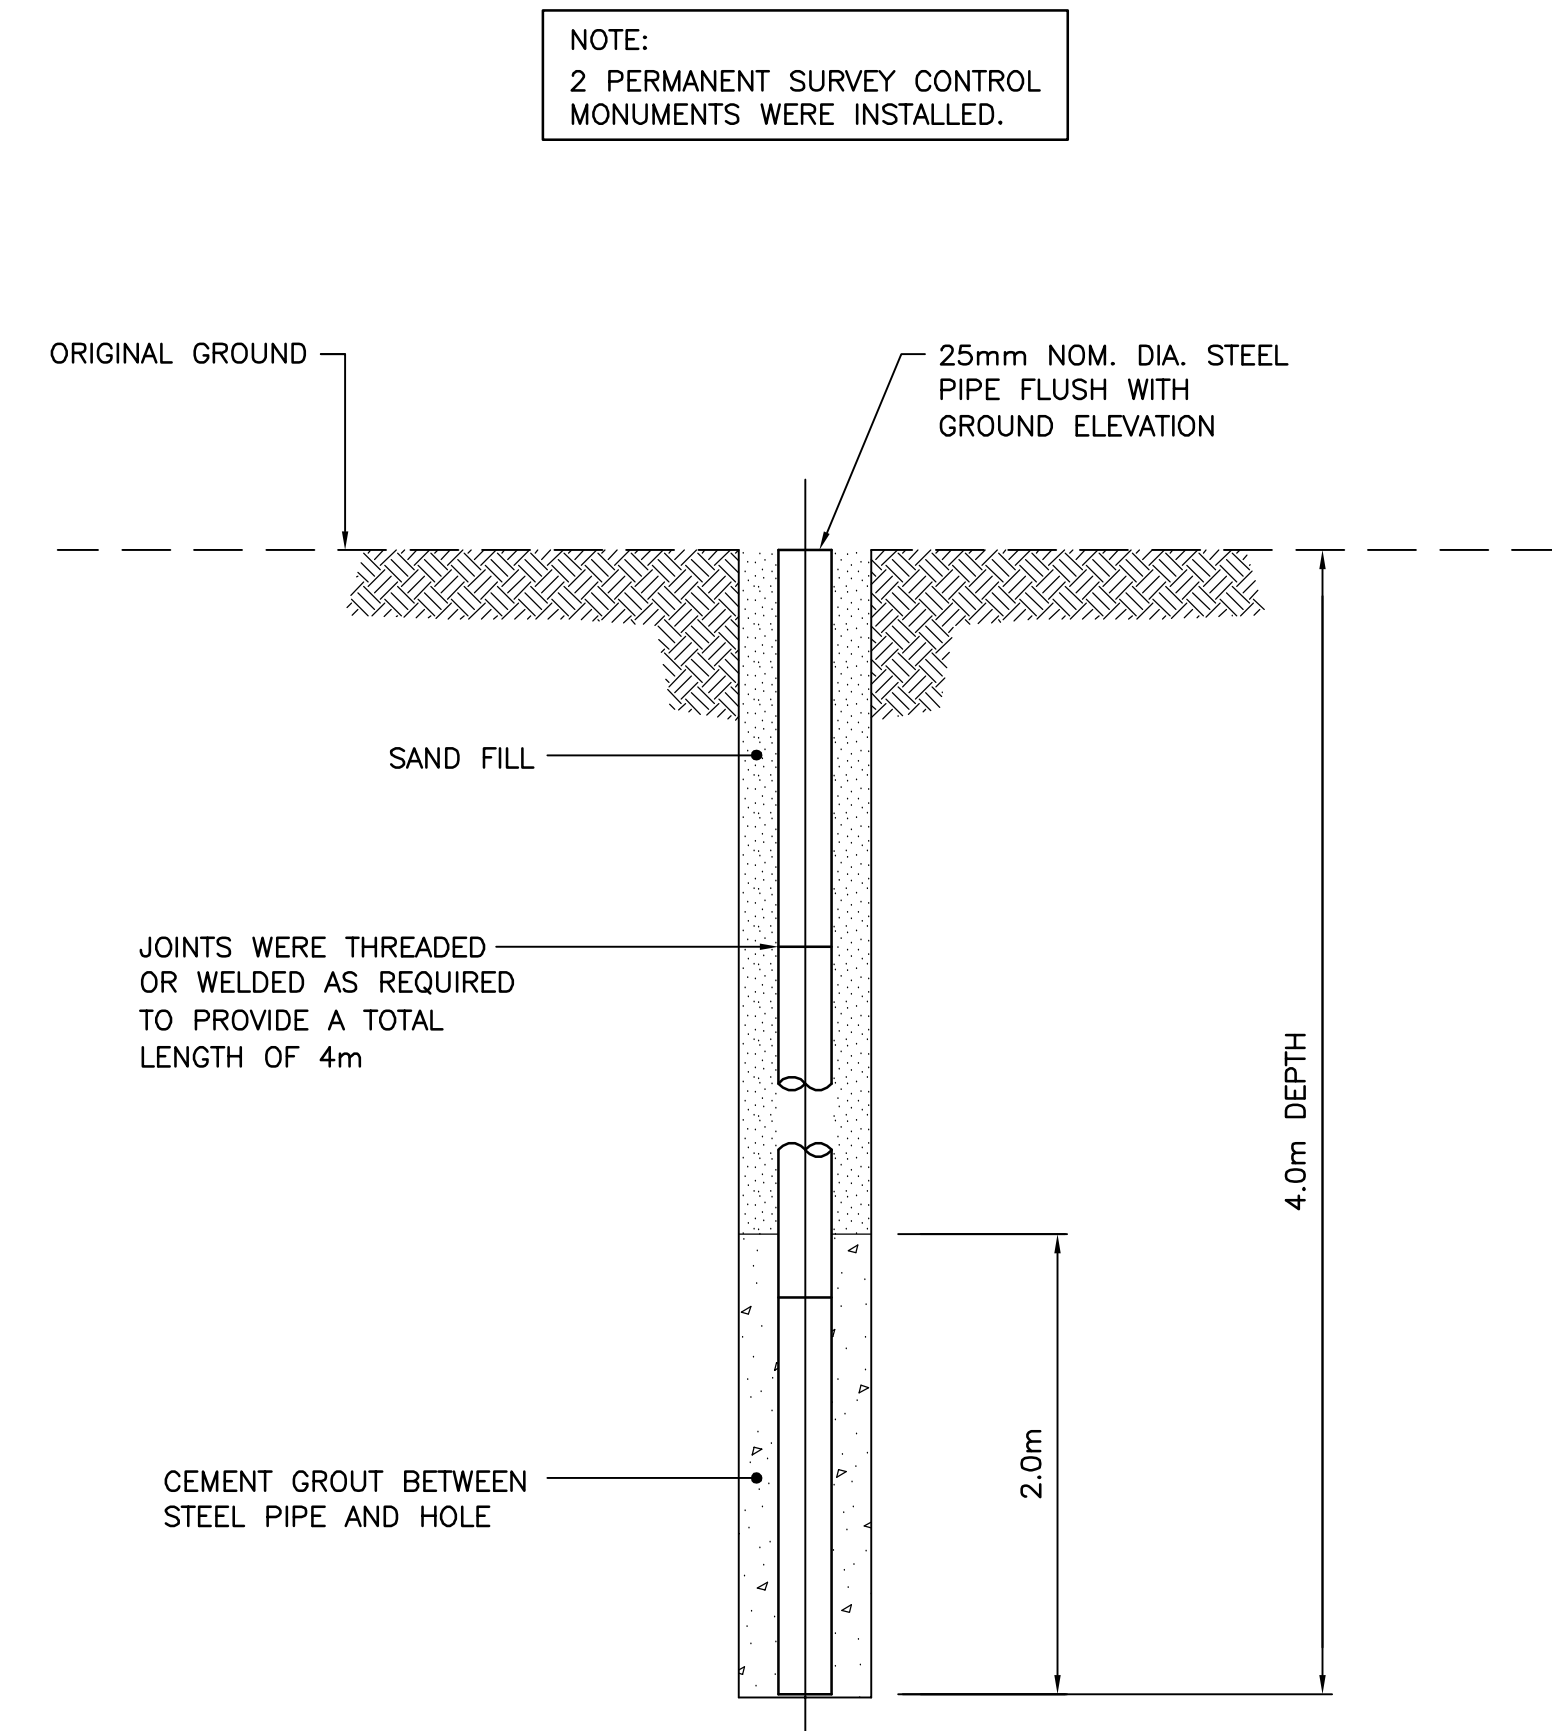

TYPICAL PERMANENT SURVEY CONTROL MONUMENT

SCALE: NTS

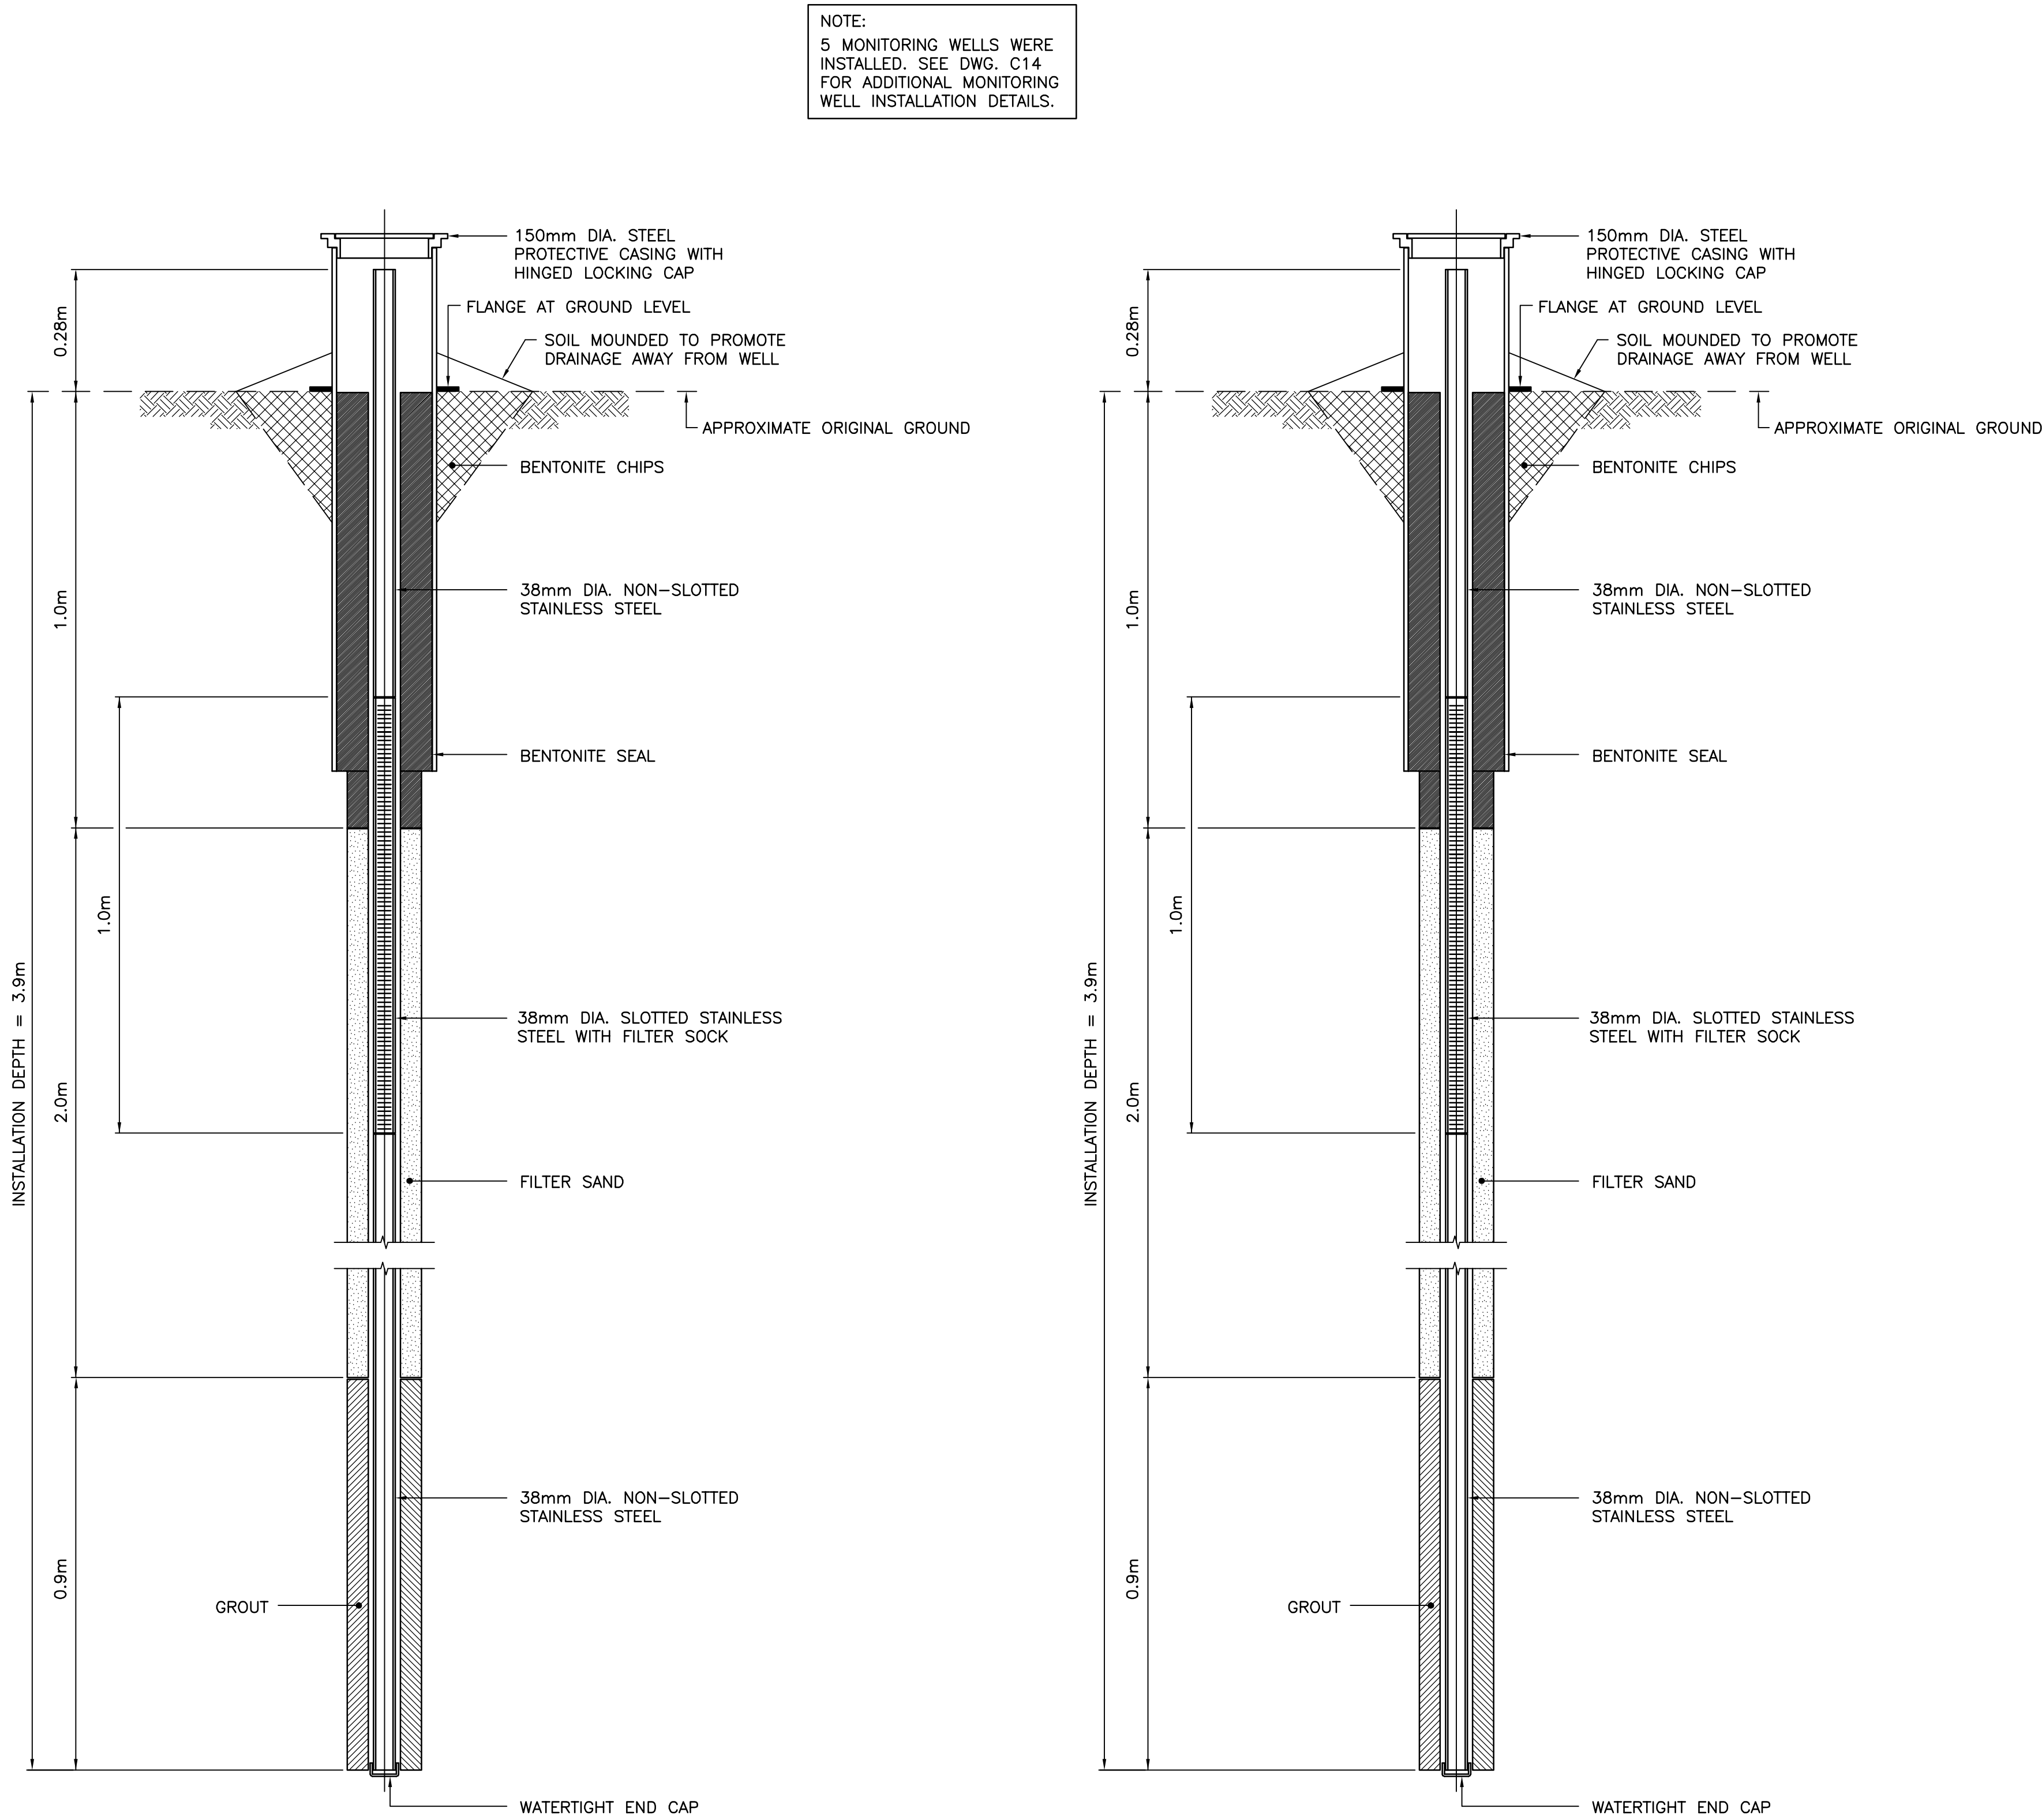

MW-NORTHWEST MONITORING WELL

SCALE: NTS

MW-SOUTHWEST MONITORING WELL

SCALE: NTS



Public Works and
Government Services
Canada

Travaux publics et
Services gouvernementaux
Canada

REAL PROPERTY SERVICES

Western Region

Client



Indian and Northern
Affairs Canada



Affaires indiennes
et du Nord Canada

Canada

Nunavut Regional Office
Iqaluit, Nunavut


Client


Client

General Notes:

1. ALL DIMENSIONS ARE IN METRES UNLESS NOTED OTHERWISE.

2. LOCATIONS FOR INSTRUMENTATION ARE SHOWN ON THE DRAWINGS.

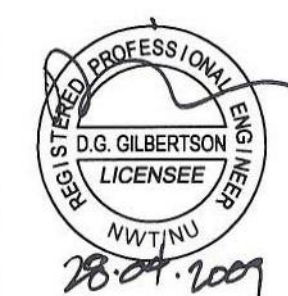

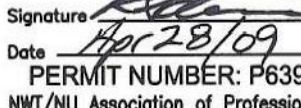PERMIT TO PRACTICE
AECOM Group Ltd.
Signature: 
Date: 09/04/28
PERMIT NUMBER: P639
NWT/NU Association of Professional
Engineers and Geoscientists

uma

An AECOM Company

0	ISSUED FOR AS-BUILT	09/04/28
REVISIONS	DESCRIPTION	DATE
A	detail number number du detail	A
B	source drawing no. de dessin no.	B
C	detail on drawing no. detail sur dessin no.	C

project title

titre du projet

FOX-C Intermediate DEW Line Site
EKALUGAD FIORD
Site Restoration

Nunavut

drawing title

titre du dessin

MISCELLANEOUS DETAILS
SHEET 1

designed by

conçu par

B. FEDORAK

drawn by

dessiné par

L. VARGAS

approved by

approuvé par

R. SCHMIDTKE

PWSC Project Manager

Administrateur de Projets TPSC

B. THOMPSON

scale

échelle

AS SHOWN

project no.

projet no.

413759

date

date


APRIL, 2009

sheet

feuille


C13
OF 14

413759-C13.DWG

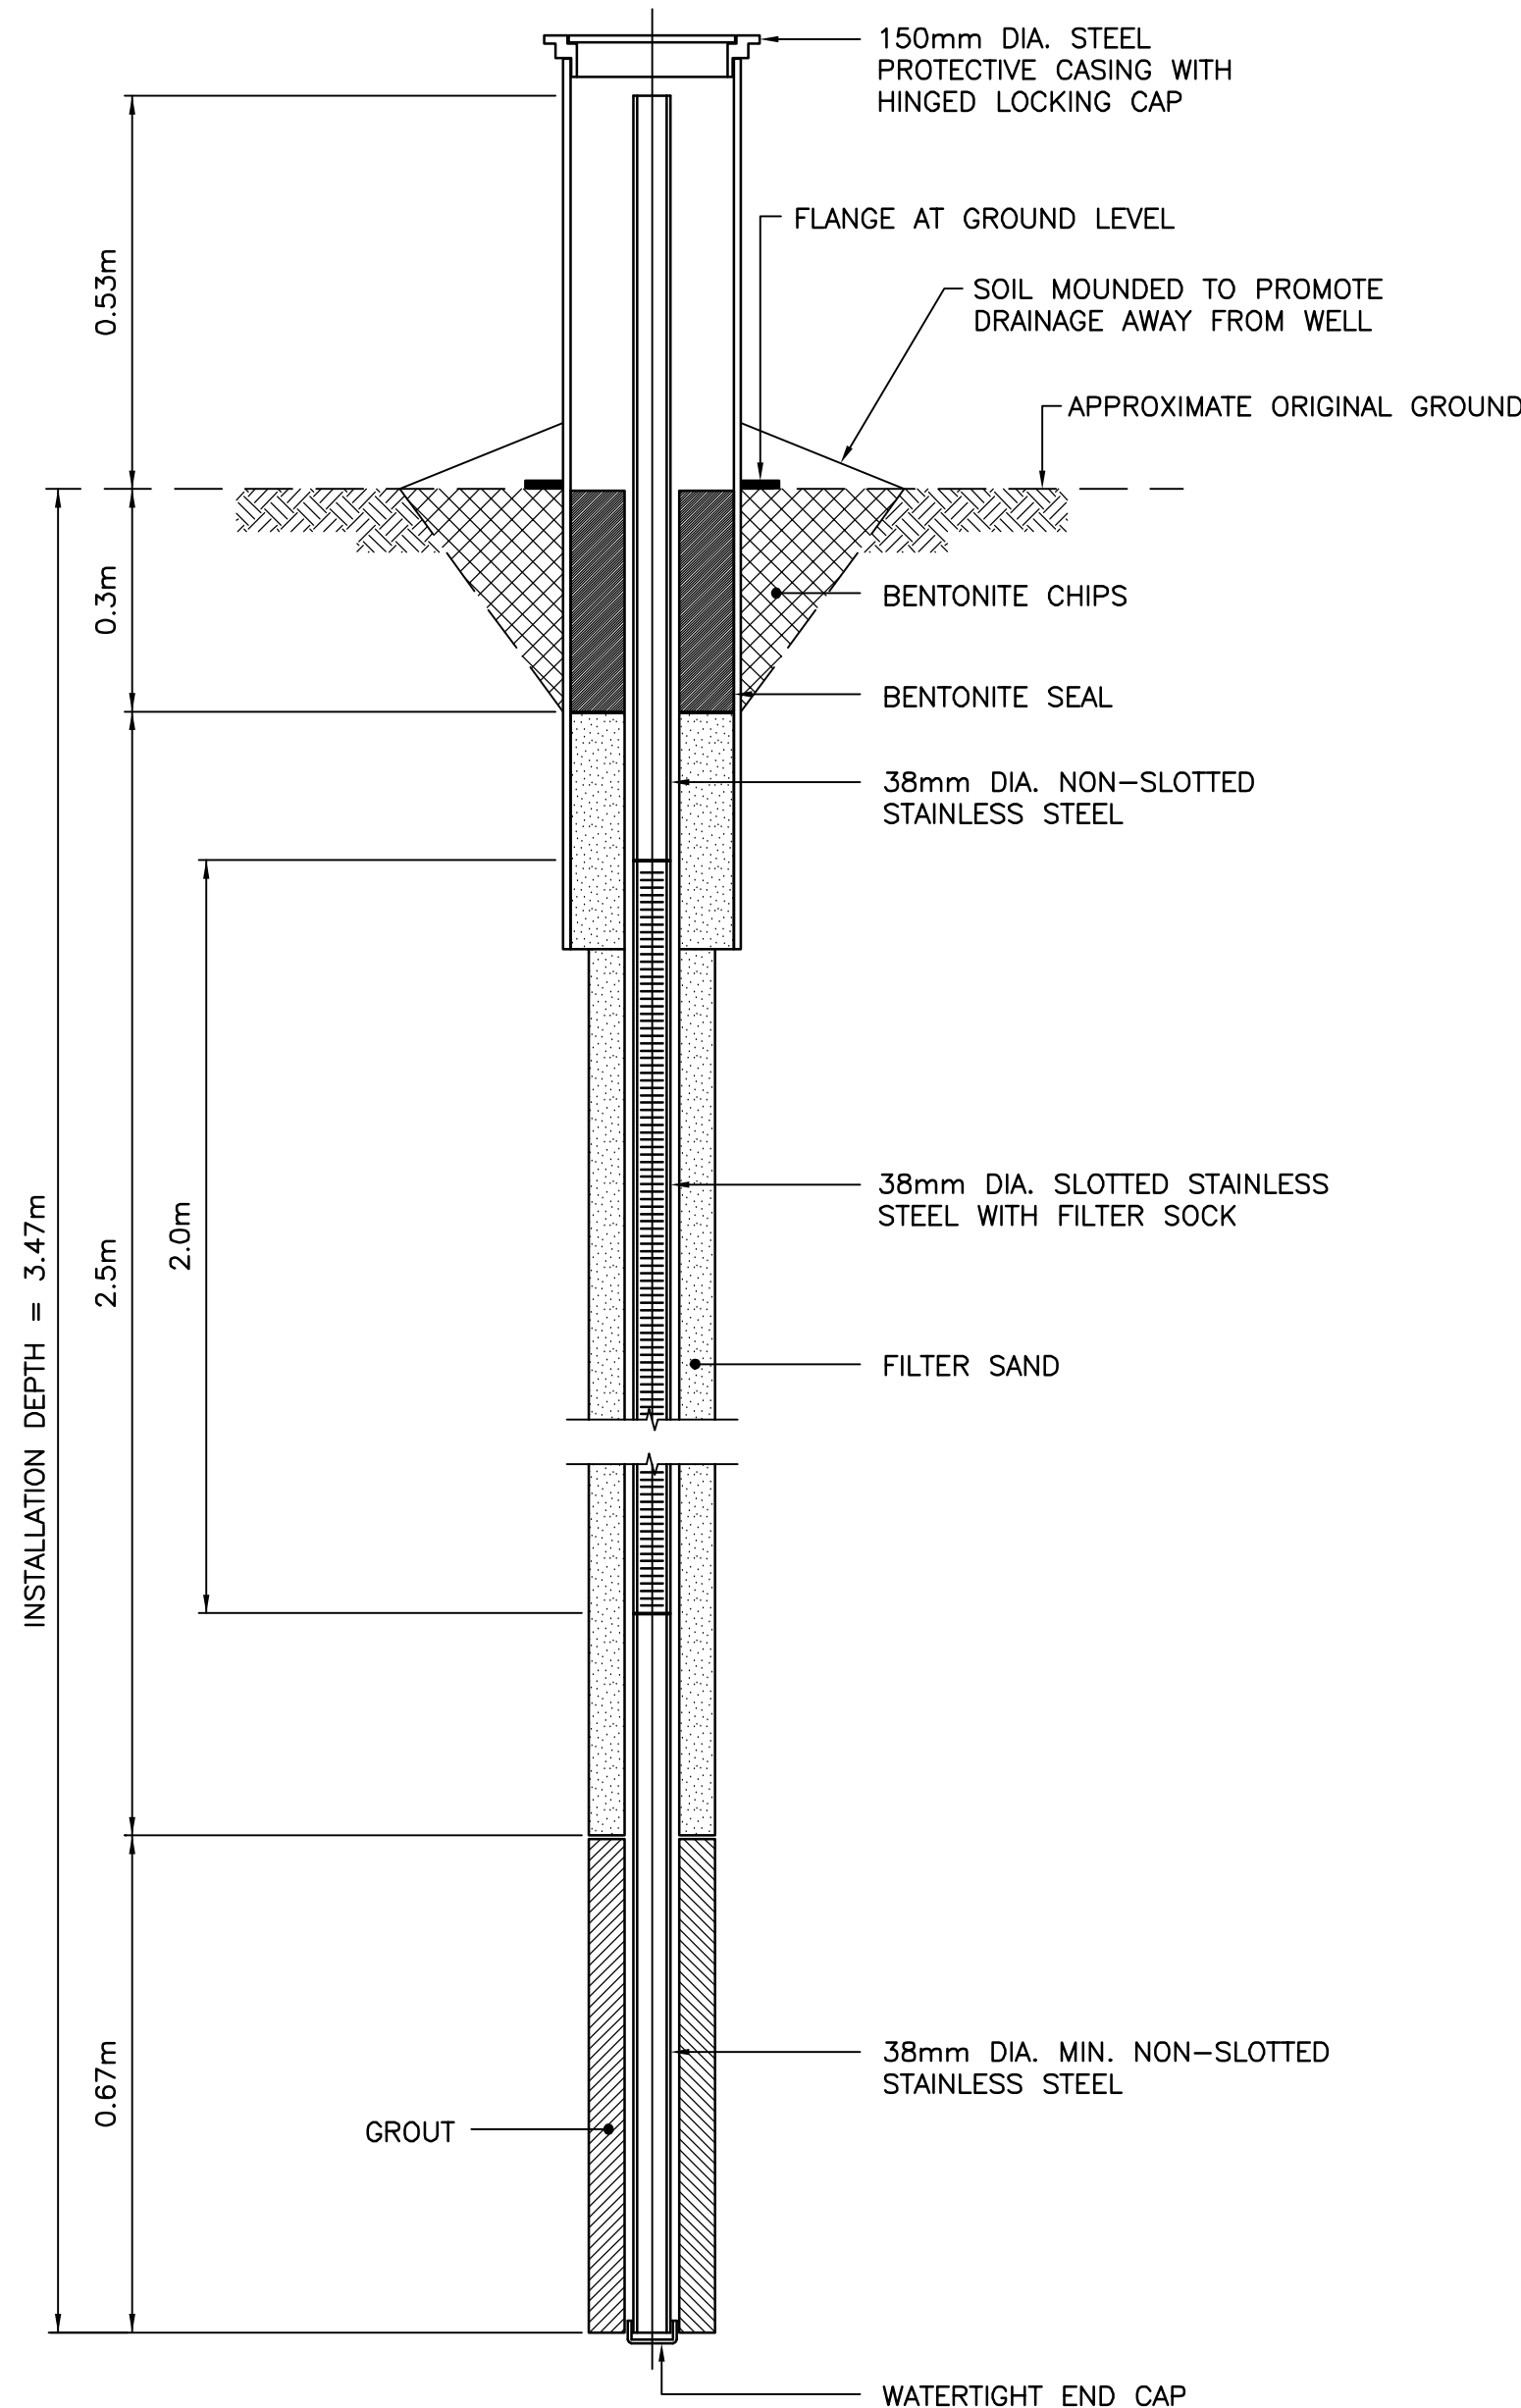


MW-NORTH MONITORING WELL

SCALE: NTS

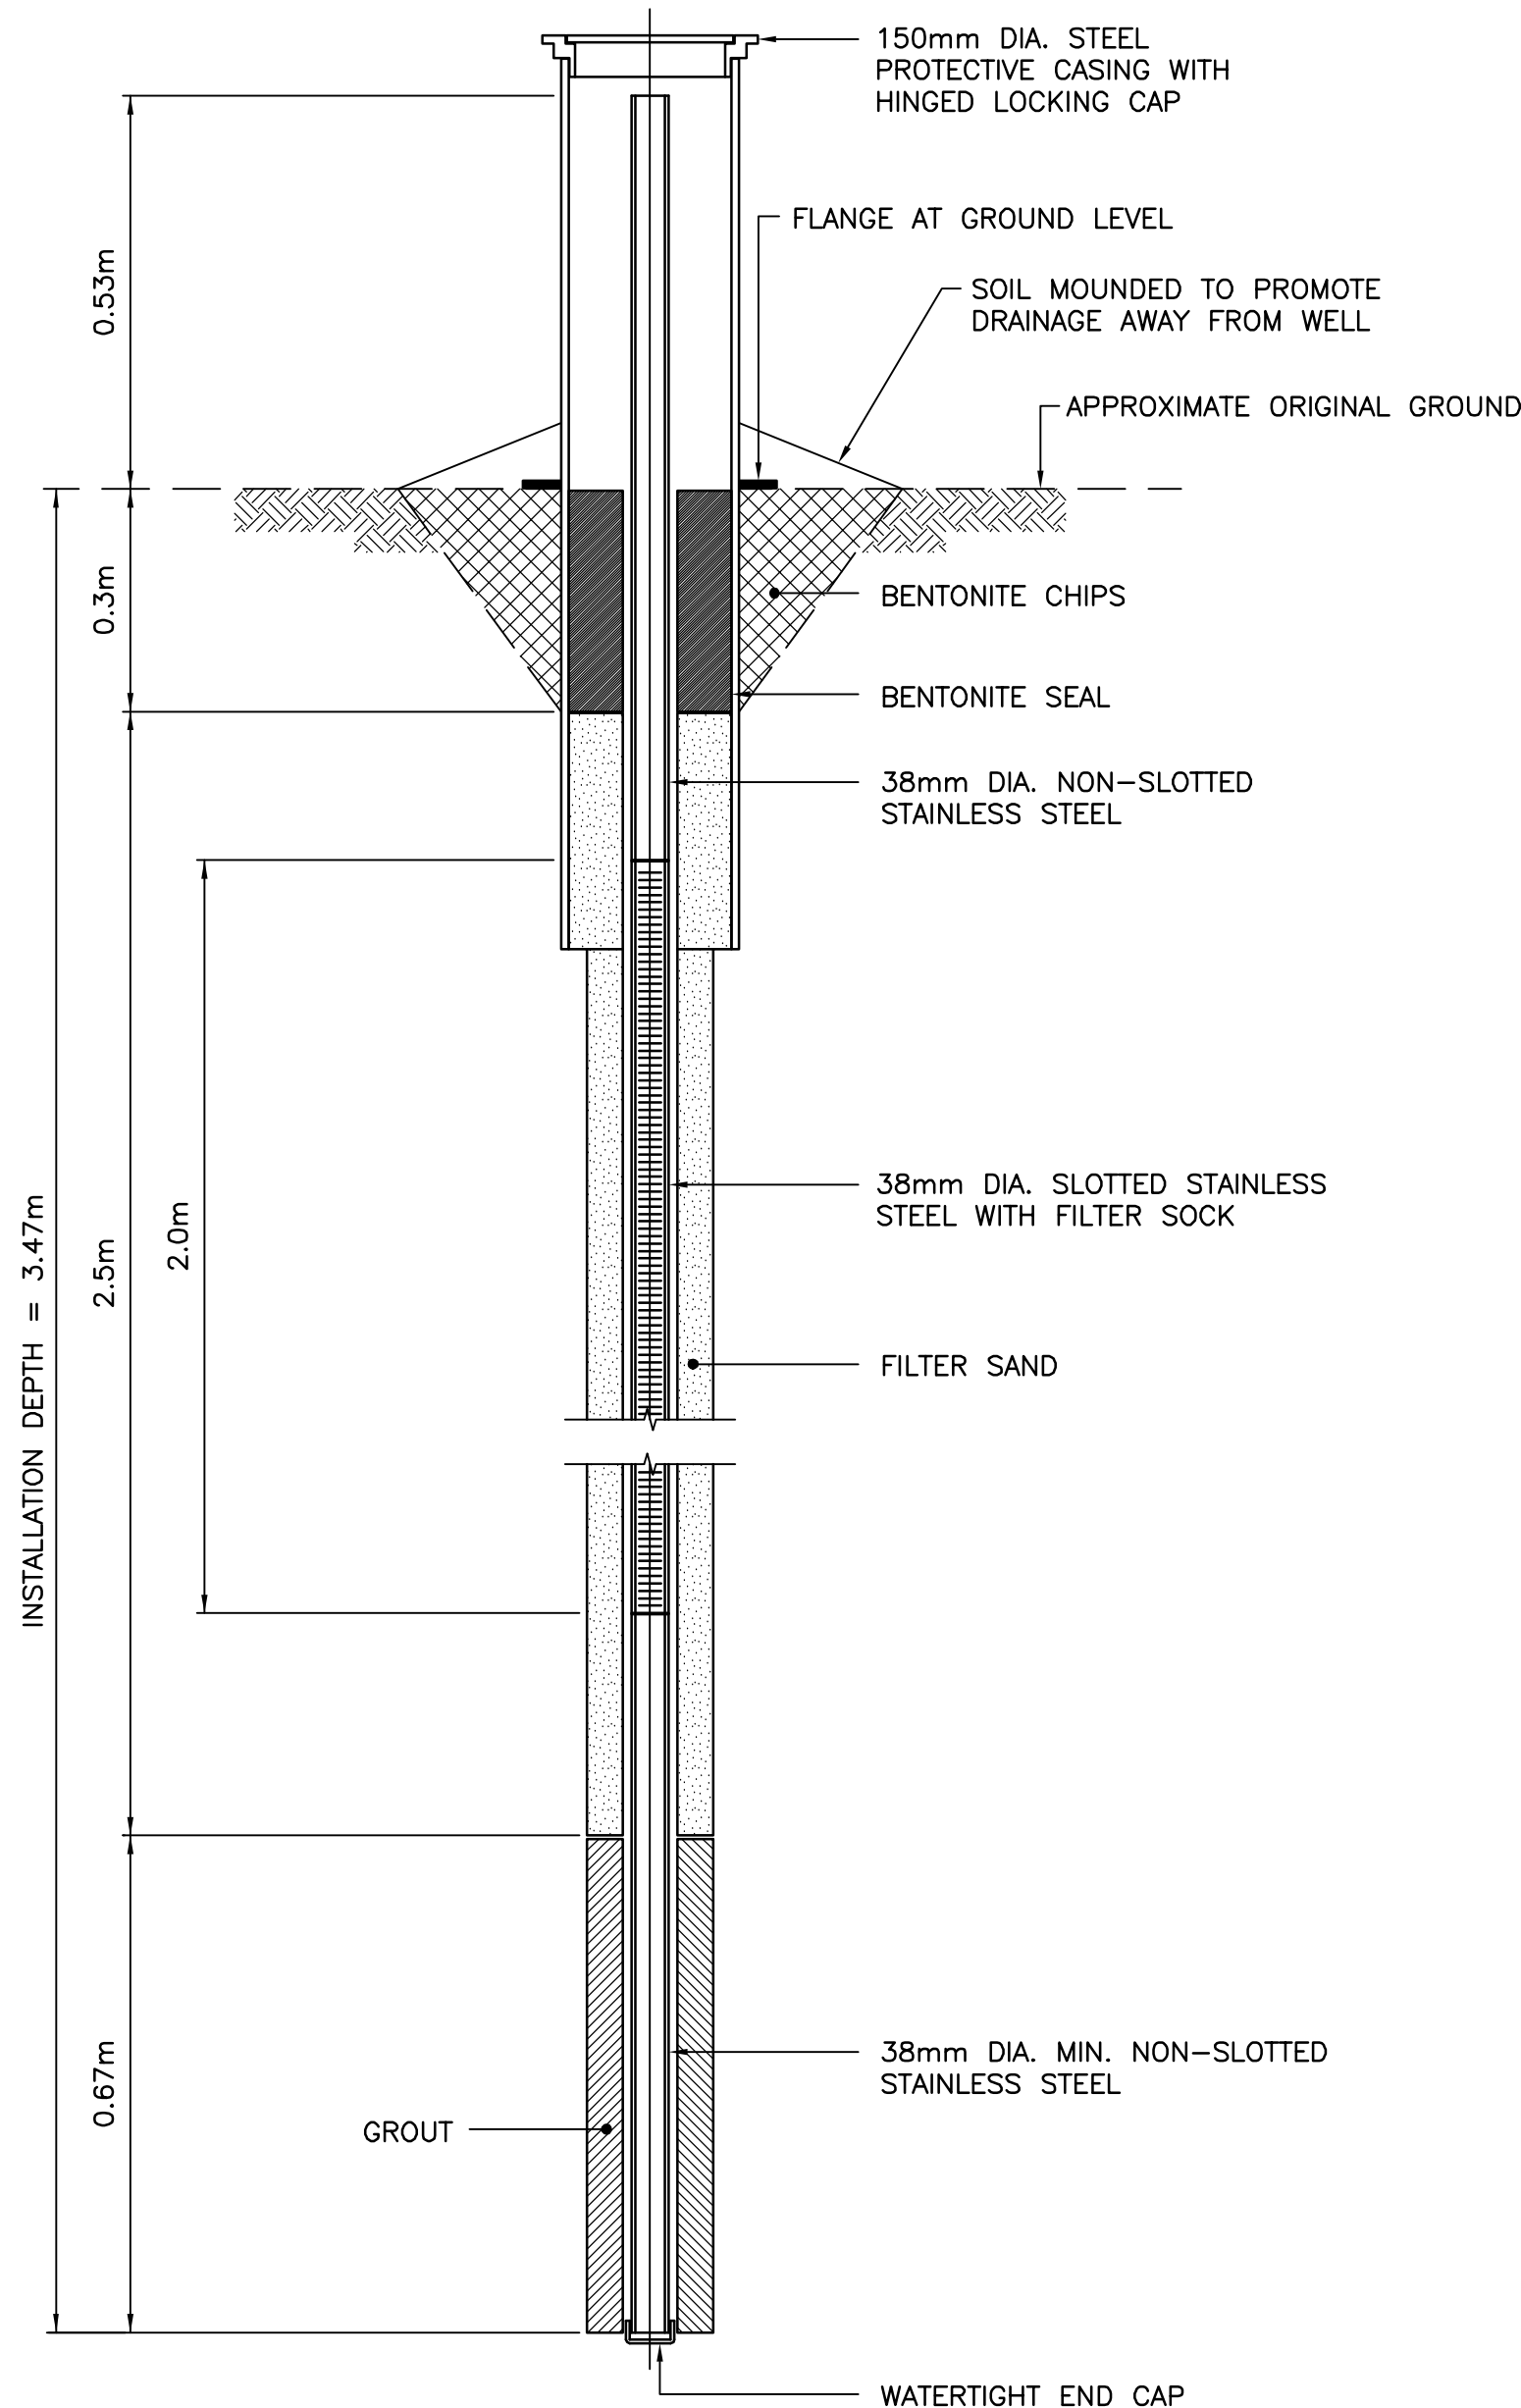

MW-EAST MONITORING WELL

SCALE: NTS

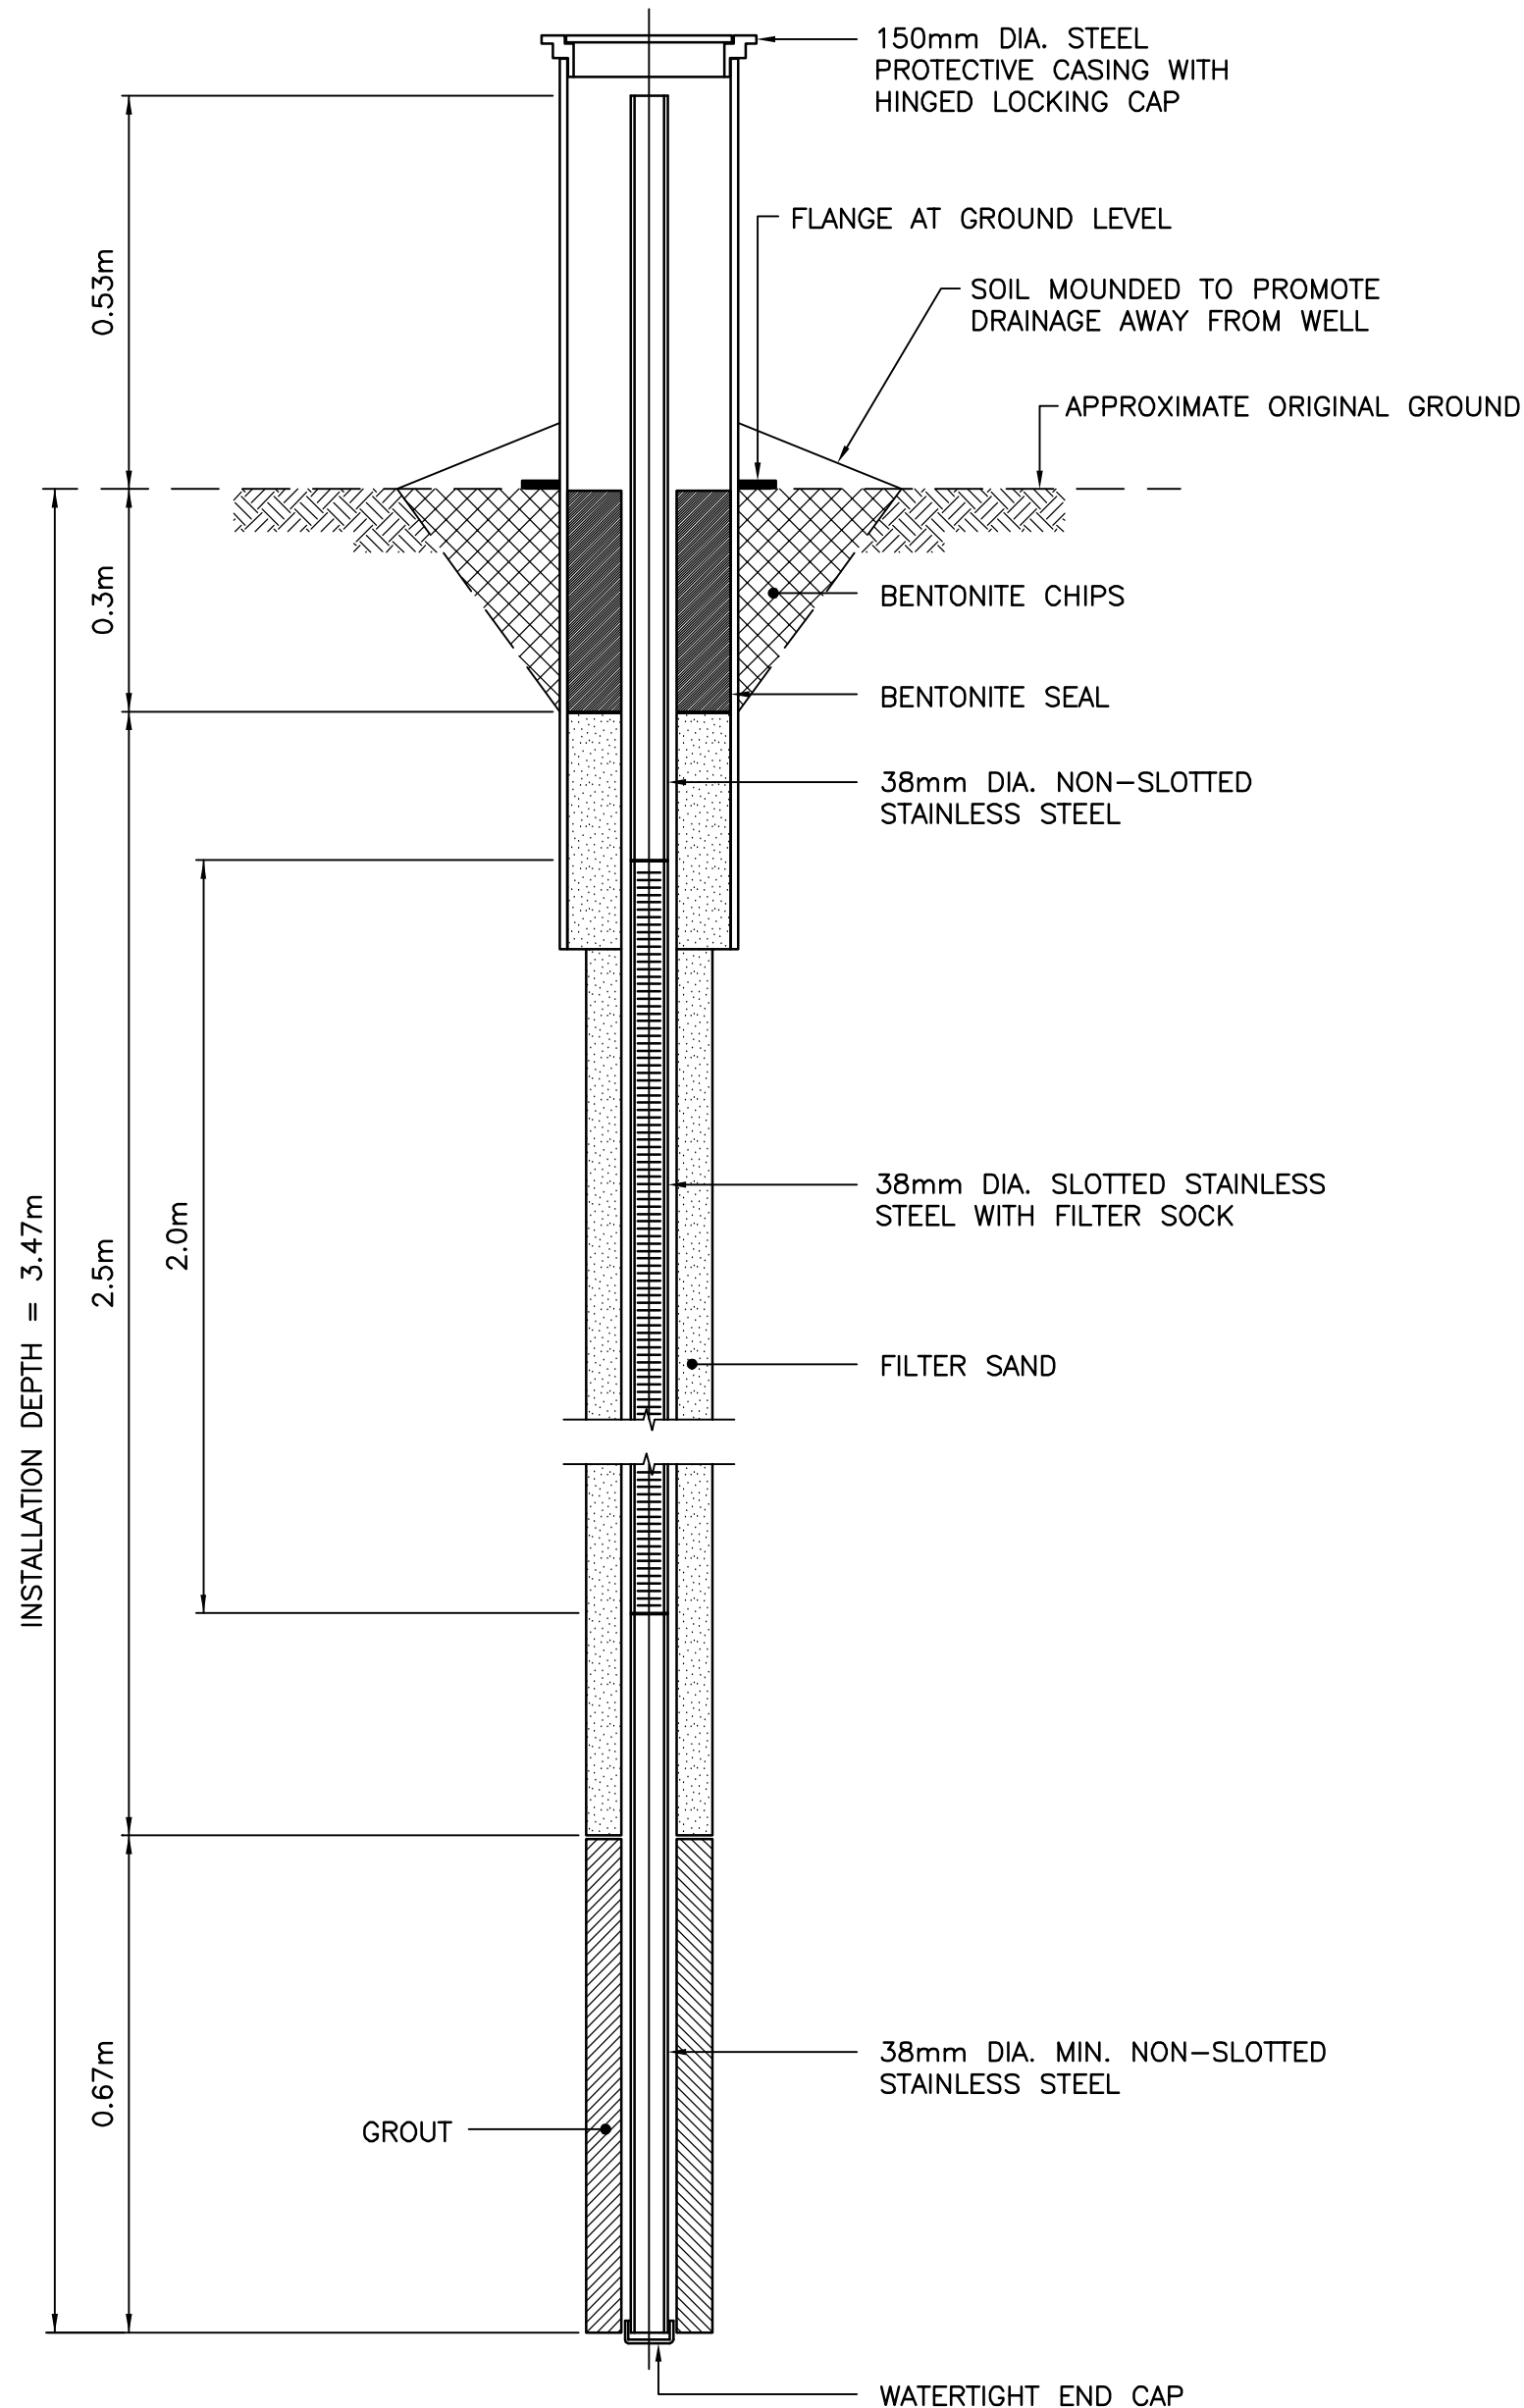


MW-SOUTH MONITORING WELL

SCALE: NTS

NOTE:
5 MONITORING WELLS WERE
INSTALLED. SEE DWG. C13
FOR ADDITIONAL MONITORING
WELL INSTALLATION DETAILS.



Public Works and
Government Services
Canada

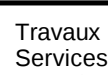

Travaux publics et
Services gouvernementaux
Canada

REAL PROPERTY SERVICES

Western Region

Client



Indian and Northern
Affairs Canada



Affaires indiennes
et du Nord Canada



Canada

Nunavut Regional Office
Iqaluit, Nunavut


Client

Client

General Notes:

1. ALL DIMENSIONS ARE IN METRES UNLESS NOTED OTHERWISE.

2. LOCATIONS FOR INSTRUMENTATION ARE SHOWN ON THE DRAWINGS.

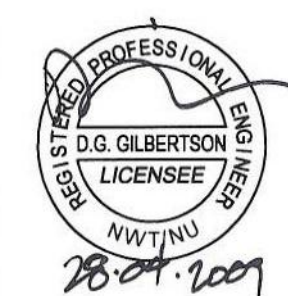

PERMIT TO PRACTICE
AECOM Canada Ltd.
Signature: 
Date: 04/28/09
PERMIT NUMBER: P639
NW/NU Association of Professional
Engineers and Geoscientists



An AECOM Company

0	ISSUED FOR AS-BUILT	09/04/28
REVISIONS	DESCRIPTION	DATE
A	detail number number du detail	A
B	source drawing no. de dessin no.	B
C	detail on drawing no. detail sur dessin no.	C

project title

titre du projet

FOX-C Intermediate DEW Line Site
EKALUGAD FIORD
Site Restoration

Nunavut

drawing title

titre du dessin

MISCELLANEOUS DETAILS
SHEET 2

designed by

conçu par

B. FEDORAK

drawn by

dessiné par

L. VARGAS

approved by

approuvé par

R. SCHMIDTKE

PWOSC Project Manager

Administrateur de Projets TPOSC

B. THOMPSON

scale

AS SHOWN

échelle

sheet

14

feuille

project no.

413759

projet no.

date



APRIL, 2009

date


C14

OF 14


413759-C14.DWG

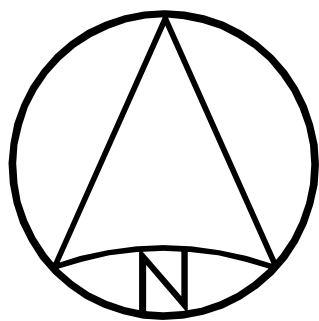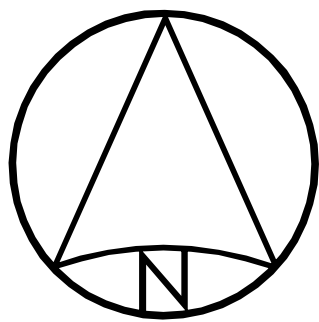

* NOTE: CM2 AND CM3 WERE DESTROYED DURING CONSTRUCTION.

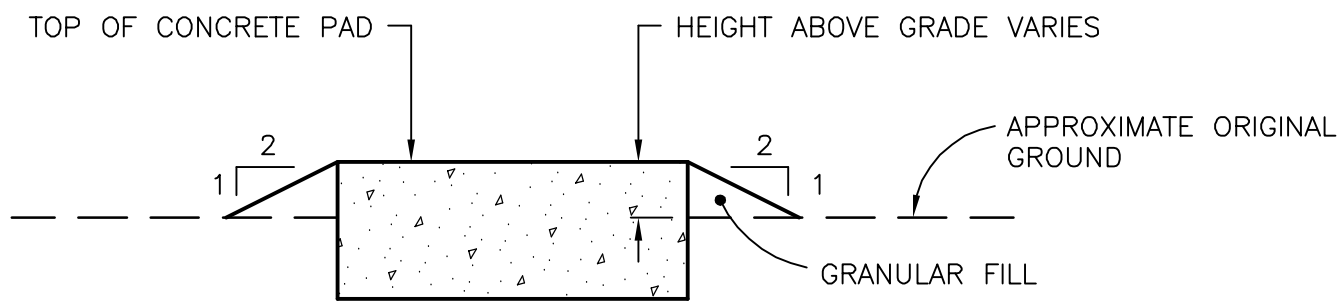

SECTION


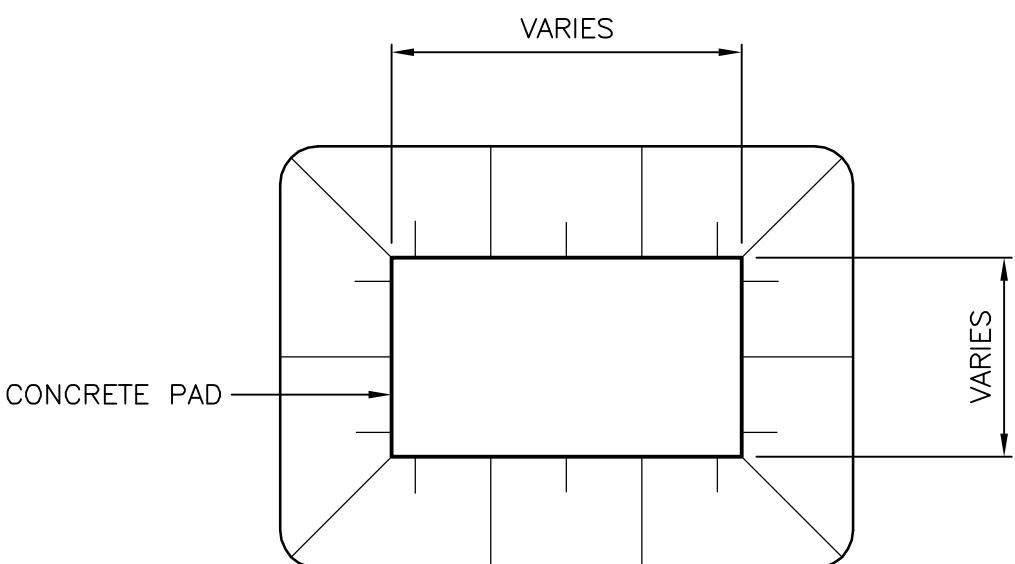


PLAN


SCALE: NTS

-

- SURVEY CONTROL MONUMENT
DEMOLISHED
BODY OF WATER

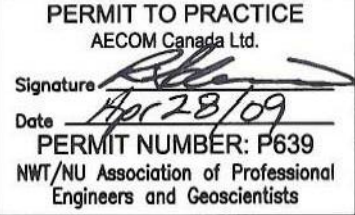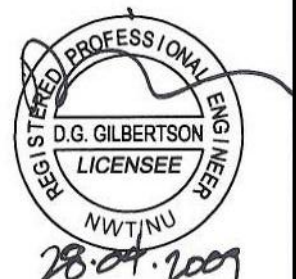

1	ISSUED FOR AS-BUILT	09/04/20
0	ISSUED FOR CONSTRUCTION	05/07/20
REVISIONS	DESCRIPTION	DATE

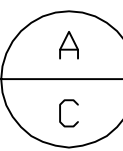

A	detail number number du detail
B	source drawing no. de dessin no.
C	detail on drawing n° detail sur dessin n°

project title	titre du projet
FOX-C Intermediate DEW Line Site EKALUGAD FIORD Site Restoration	

Nunavut

drawing title	titre du dessin
UPPER STATION AREA AND BEACH AREA DEMOLITION SITE PLANS	

designed by **B. FEDORAK** concu par

drawn by dessiné par
L. VARGAS

approved by approuvé par
R. SCHMIDTKE

PWGSC Project Manager
Administrateur de Projets TPSGC

B. THOMPSON

scale	echelle	sheet	feuille
1:500			

project no.	413759	project no.	S01
-------------	--------	-------------	-----

APRIL, 2009