


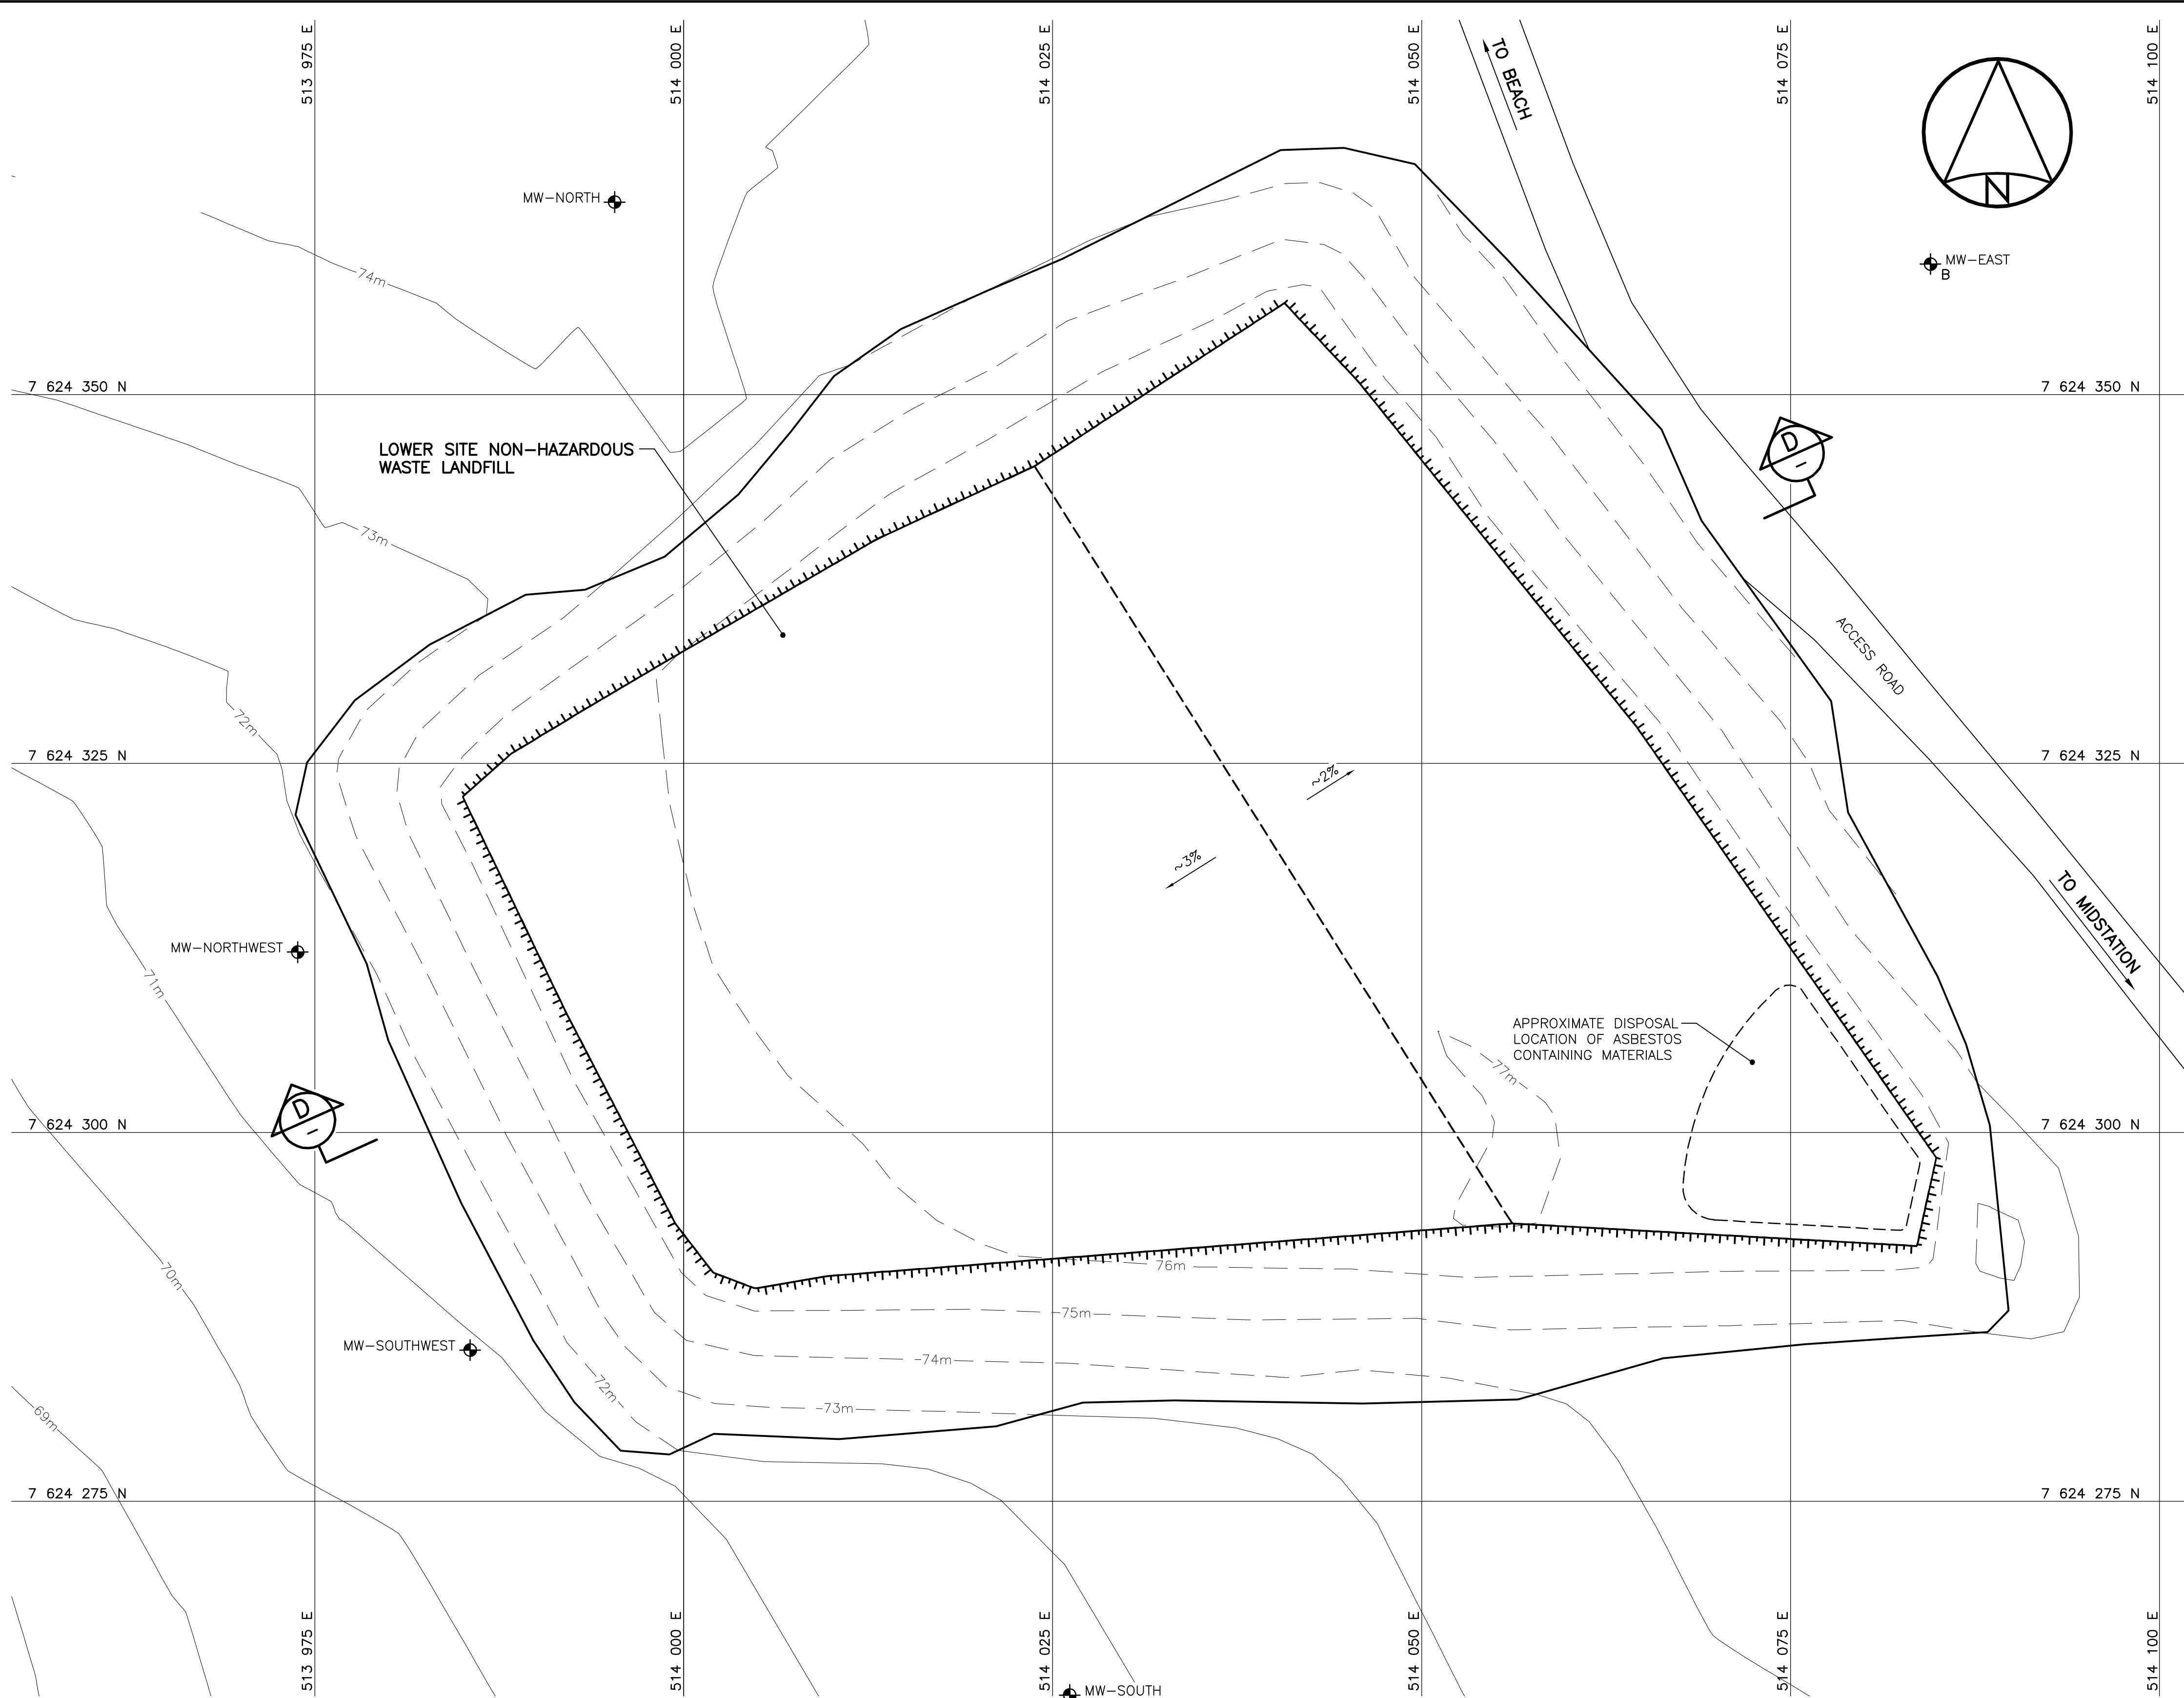


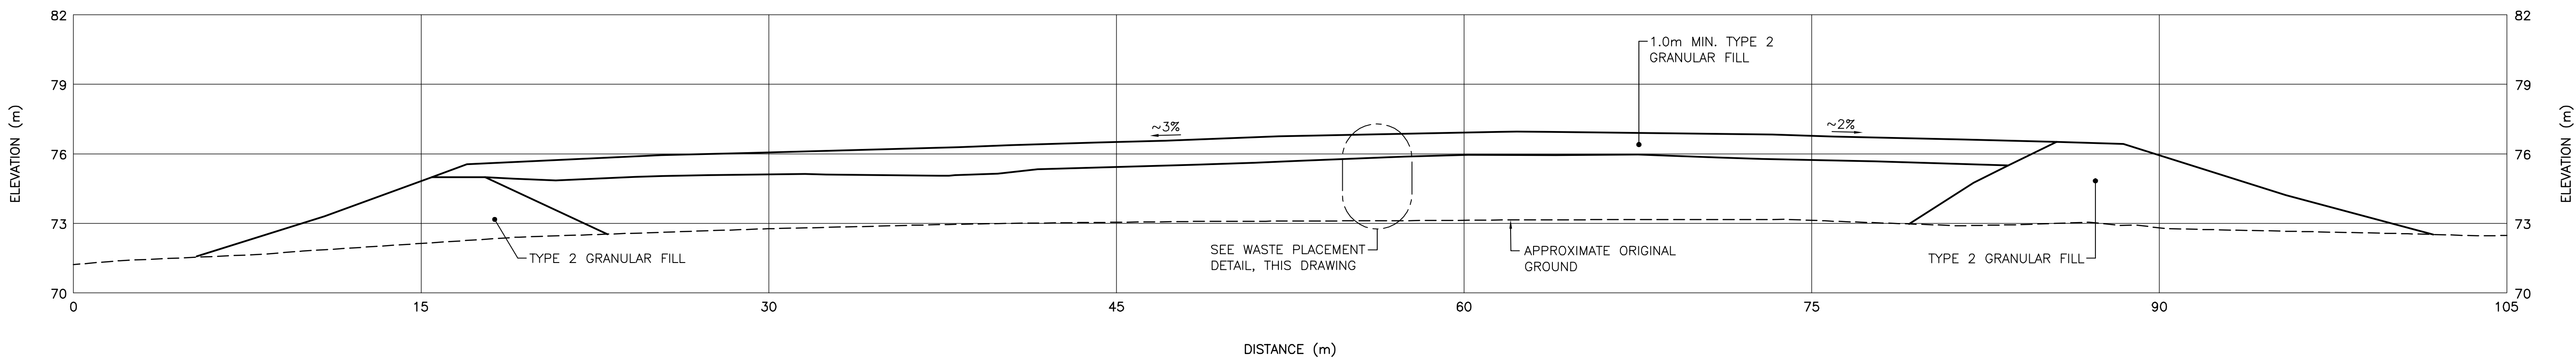

PLAN

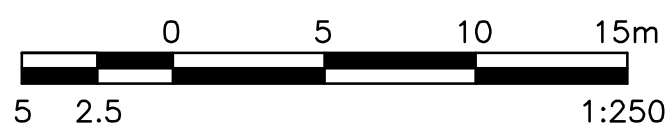

SECTION

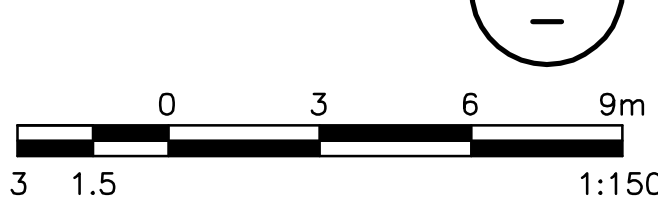


NOTE:

CONTOURS SHOWN AS DASHED LINES WERE GENERATED FROM SURVEY INFORMATION AND REPRESENT FINISHED GROUND SURFACE FOLLOWING REGRADING OR RESHAPING.

MONITORING WELLS (AS-BUILT)			
NO.	UTM COORDINATES		ELEV.*
	NORTHING	EASTING	
MW-NORTH	7 624 363.0	513 995.3	74.8
MW-EAST	7 624 358.8	514 084.5	69.8
MW-SOUTH	7 624 261.9	514 026.2	72.4
MW-SOUTHWEST	7 624 285.3	513 985.5	71.5
MW-NORTHWEST	7 624 312.2	513 973.8	72.0

* NOTE: ELEVATION IS TOP OF PIPE.

ADDITIONAL WASTE LAYERS, MAY HAVE BEEN REQUIRED, TO ACHIEVE THE NON-HAZARDOUS WASTE LANDFILL DESIGN ELEVATIONS.

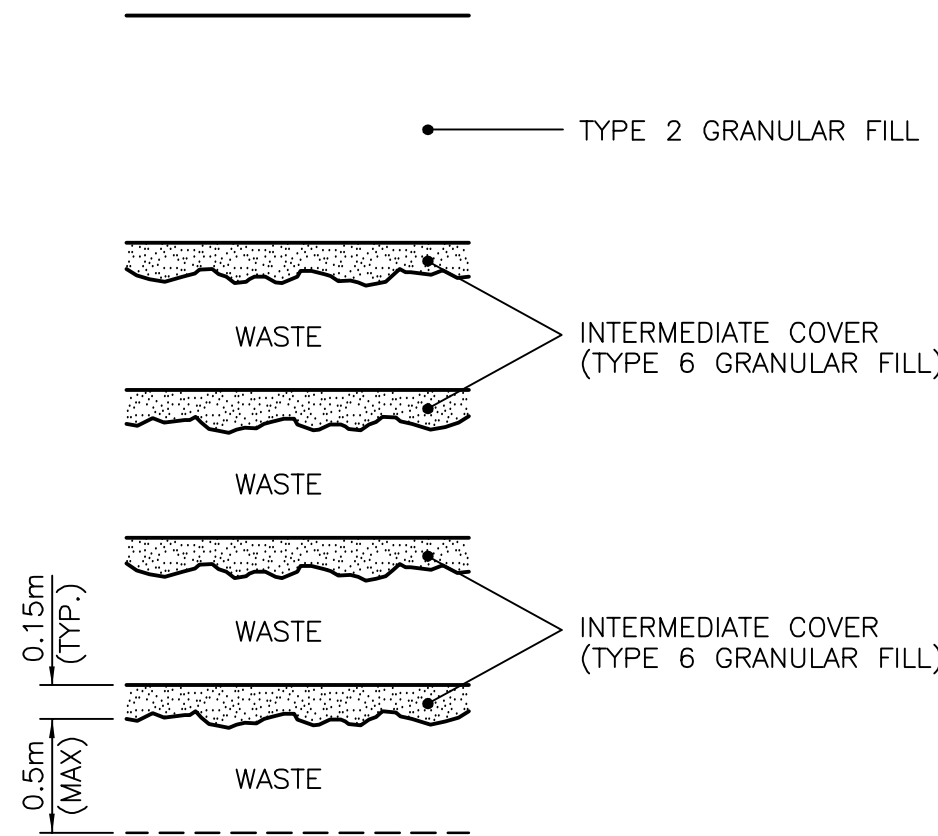

WASTE PLACEMENT DETAIL

SCALE: NTS

REAL PROPERTY SERVICES
Western Region

Canada


Nunavut Regional Office
Iqaluit, Nunavut

General Notes:

- ALL COORDINATES ARE REFERENCED TO NAD83 CSRS, UTM_ZONE 19. ELEVATIONS ARE REFERENCED TO MEAN SEA LEVEL, RELATIVE TO GEOID MODEL EGM96.
- SITE PLANS AND TOPOGRAPHIC INFORMATION ARE BASED ON AIR PHOTOS AND SURVEYS. CURRENT CONDITIONS MAY NOT BE EXACTLY AS SHOWN.
- ALL DIMENSIONS ARE IN METRES UNLESS NOTED OTHERWISE.
- FOR MONITORING WELL INSTALLATION DETAILS, SEE DRAWING C13 AND C14.

Legend:

- MONITORING WELL LOCATION (4)
- BACKGROUND MONITORING WELL LOCATION (1)

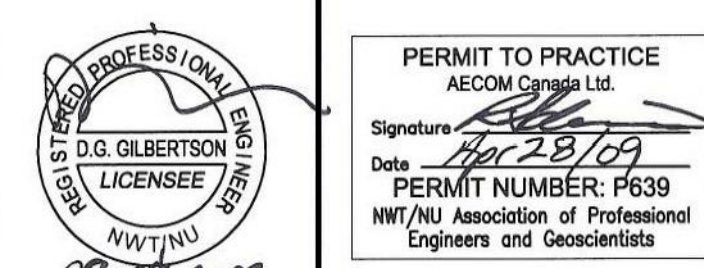

uma
An AECOM Company

REV	DESCRIPTION	DATE
2	ISSUED FOR AS-BUILT	09/04/28
1	LANDFILL REVISED AND ISSUED FOR APPROVAL	07/06/03
0	ISSUED FOR CONSTRUCTION	08/07/25

A	detail number number du detail	A
C	source drawing no. de dessin no.	B
	detail on drawing no. detail sur dessin no.	C

project title
titre du projet
**FOX-C Intermediate DEW Line Site
EKALUGAD FIORD
Site Restoration**

Nunavut

drawing title
titre du dessin
**LOWER SITE
NON-HAZARDOUS WASTE LANDFILL
PLAN AND CROSS SECTION**

designed by conçu par B. FEDORAK	drawn by dessiné par L. VARGAS	approved by approuvé par R. SCHMIDTKE
PWOSC Project Manager Administrateur de Projets TPSCC B. THOMPSON	scale échelle AS SHOWN	sheet feuille C12
project no. projet no. 413759	date date APRIL, 2009	OF 14