

October 25, 2012

Karen McIntyre
Land Administrator
Land Administration – Nunavut Regional Office
Aboriginal Affairs and Northern Development Canada
P.O. Box a00
Iqaluit, NU X0A 0H0

Dear Karen:

Project: FOX-3, Dewar Lakes


Regarding: Final Report for Land Use Permit N2007X0038

AECOM is providing the following Final report for the FOX-3, Dewar Lakes DEW Line site. The information is being submitted on behalf of Defence Construction Canada and the Department of National Defence.

The remediation construction work at FOX-3 was completed in September 2011. In April 2012, the construction camp, equipment and PCB material in temporary storage were removed from the site via cat-train. We have attached the as-built drawings for your reference. They are currently in draft form; when they are finalized, a copy can be sent to you for your records.

We trust the information provided is sufficient. Please feel free to contact the undersigned if you have any questions or comments.

Sincerely,
AECOM Canada Ltd.

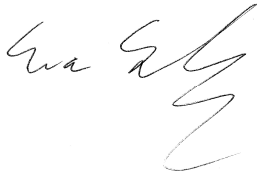

Eva Schulz, P.Ag.
Senior Environmental Scientist
Eva.Schulz@aecom.com

cc: Tamara Van Dyck, DCC
ENCL: Draft As-Built Drawings

DEW LINE CLEAN UP PROJECT

NOTE:
THIS DRAWING PACKAGE HAS BEEN
REVISED BASED ON INFORMATION
SUPPLIED BY DEFENCE CONSTRUCTION
CANADA IN 2009, 2010 AND 2011.

DRAWING INDEX					
DRAWING No.	TITLE	DRAWING No.	TITLE	DRAWING No.	TITLE
SITING		SITING		SITING	
H-D67/-9101-101	OVERALL SITE PLAN	H-D67/-9101-115	STATION AREA REGRAVING DETAILS SHEET 2	H-D67/-9101-128A	THERMOKARST POND CROSS SECTION
H-D67/-9101-102	PROJECT LAYOUT SHEET 1	H-D67/-9101-116	DANGER ZONE GRADING PLAN AND DETAIL	H-D67/-9101-129	MISCELLANEOUS DETAILS SHEET 1
H-D67/-9101-103	PROJECT LAYOUT SHEET 2	H-D67/-9101-117	LANDFARM CLOSURE CROSS SECTION	H-D67/-9101-130	MISCELLANEOUS DETAILS SHEET 2
H-D67/-9101-104	PROJECT LAYOUT SHEET 3	H-D67/-9101-118	NON-HAZARDOUS WASTE LANDFILL BERM CONSTRUCTION AND FINAL GRADING PLANS	STRUCTURAL	
H-D67/-9101-105	STATION AREA SITE PLAN SHEET 1	H-D67/-9101-119	NON-HAZARDOUS WASTE LANDFILL CROSS SECTION		
H-D67/-9101-106	STATION AREA SITE PLAN SHEET 2	H-D67/-9101-120	TIER II DISPOSAL FACILITY KEY TRENCH EXCAVATION PLAN & GRADING/INSTRUMENTATION PLAN	H-D67/-9101-202	ARSTRIP AREA DEMOLITION SITE PLAN
H-D67/-9101-107	STATION AREA SITE PLAN SHEET 3	H-D67/-9101-121	TIER II DISPOSAL FACILITY CROSS SECTION AND DETAIL	H-D67/-9101-203	ARSTRIP AREA DEMOLITION SITE PLAN PLAN SECTION AND ELEVATION
H-D67/-9101-108	MIDDLE SITE AREA SITE PLAN SHEET 1	H-D67/-9101-122	TIER II DISPOSAL FACILITY CROSS SECTION	H-D67/-9101-204	COMMUNICATION DISH ELEVATIONS
H-D67/-9101-109	MIDDLE SITE AREA SITE PLAN SHEET 2	H-D67/-9101-123	MISCELLANEOUS LANDFILL/BURIED DEBRIS REGRAVING & EXCAVATION DETAILS - SHEET 1	H-D67/-9101-205	COMMUNICATION DISH BOARD FRONTVIEW AND SUPPORT FRAME PLAN SECTION AND ELEVATIONS
H-D67/-9101-110	ARSTRIP AREA-SOUTH SITE PLAN	H-D67/-9101-124	MISCELLANEOUS LANDFILL/BURIED DEBRIS REGRAVING DETAILS SHEET 2	H-D67/-9101-206	FUEL TANKS ELEVATIONS
H-D67/-9101-111	HEATED VEHICLE STORAGE AREA SITE PLAN	H-D67/-9101-125	MISCELLANEOUS LANDFILL/BURIED DEBRIS REGRAVING & EXCAVATION DETAILS - SHEET 3	© COPYRIGHT HER MAJESTY THE QUEEN IN RIGHT OF CANADA 2012, AS REPRESENTED BY THE MINISTER OF NATIONAL DEFENCE.	
H-D67/-9101-112	ARSTRIP AREA SITE PLAN SHEET 1	H-D67/-9101-126	MISCELLANEOUS LANDFILL REGRAVING DETAILS SHEET 4		
H-D67/-9101-113	ARSTRIP AREA SITE PLAN SHEET 2	H-D67/-9101-127	MISCELLANEOUS LANDFILL/BURIED DEBRIS REGRAVING & EXCAVATION DETAILS - SHEET 5		
H-D67/-9101-114	STATION AREA REGRAVING DETAILS SHEET 1	H-D67/-9101-128	THERMOKARST POND PLAN AND CROSS SECTION		



FOX-3 DEWAR LAKES AS-BUILT DRAWINGS



DRAFT

OCTOBER, 2012

National
Defence
Défense
nationale

Headquarters
Quartier général

General Notes:

1. ALL COORDINATES ARE REFERENCED TO NAD83 (GRS), UTM ZONE 19N. ALL ELEVATIONS REFER TO GEODETIC DATUM
2. ALL DIMENSIONS ARE IN METRES UNLESS NOTED OTHERWISE.
3. ALL NON-HAZAROUS DEBRIS REMOVED WITHIN THE PLAN AREA WAS PLACED IN THE NON-HAZAROUS WASTE LANDFILL.

Legend:

 APPROXIMATE LOCATION OF PROPERTY BOUNDARY
 APPROXIMATE EXTENT OF BORROW AREA
 BODY OF WATER

BODY OF WATER

0	12-10-22	AS-BUILT DRAWING		RFM
No.	DATE	REVISION	REVISION	APPR.

DRAFT

ALCOM **HATCH**

FOX-3 DEWAR LAKES

DEW LINE CLEAN UP

© COPYRIGHT
HER MAJESTY THE QUEEN IN RIGHT OF
CANADA 2012, AS REPRESENTED BY THE
MINISTER OF NATIONAL DEFENCE.





TRADE - METIER	DATE
SITTING	2007-08-24
SUBJECT - SUJET	

OVERALL SITE PLAN

PRODUCTION	CONCURRENCE – ASSESSMENT
DESIGNED <i>THE D/W</i>	DES OFF
ETUIQUE	AGENT CONCEPT
DRAWN	SECT HD
DESSINE	CHEF SECT
CHECKED	DES MOR
VERIFIE	DESI CONCEPT
COORDINATION	REVIEWED – REVU
<i>SMS</i>	

DWS. NO. – DESSUS NO.
H-067/1-9101-101

Canada

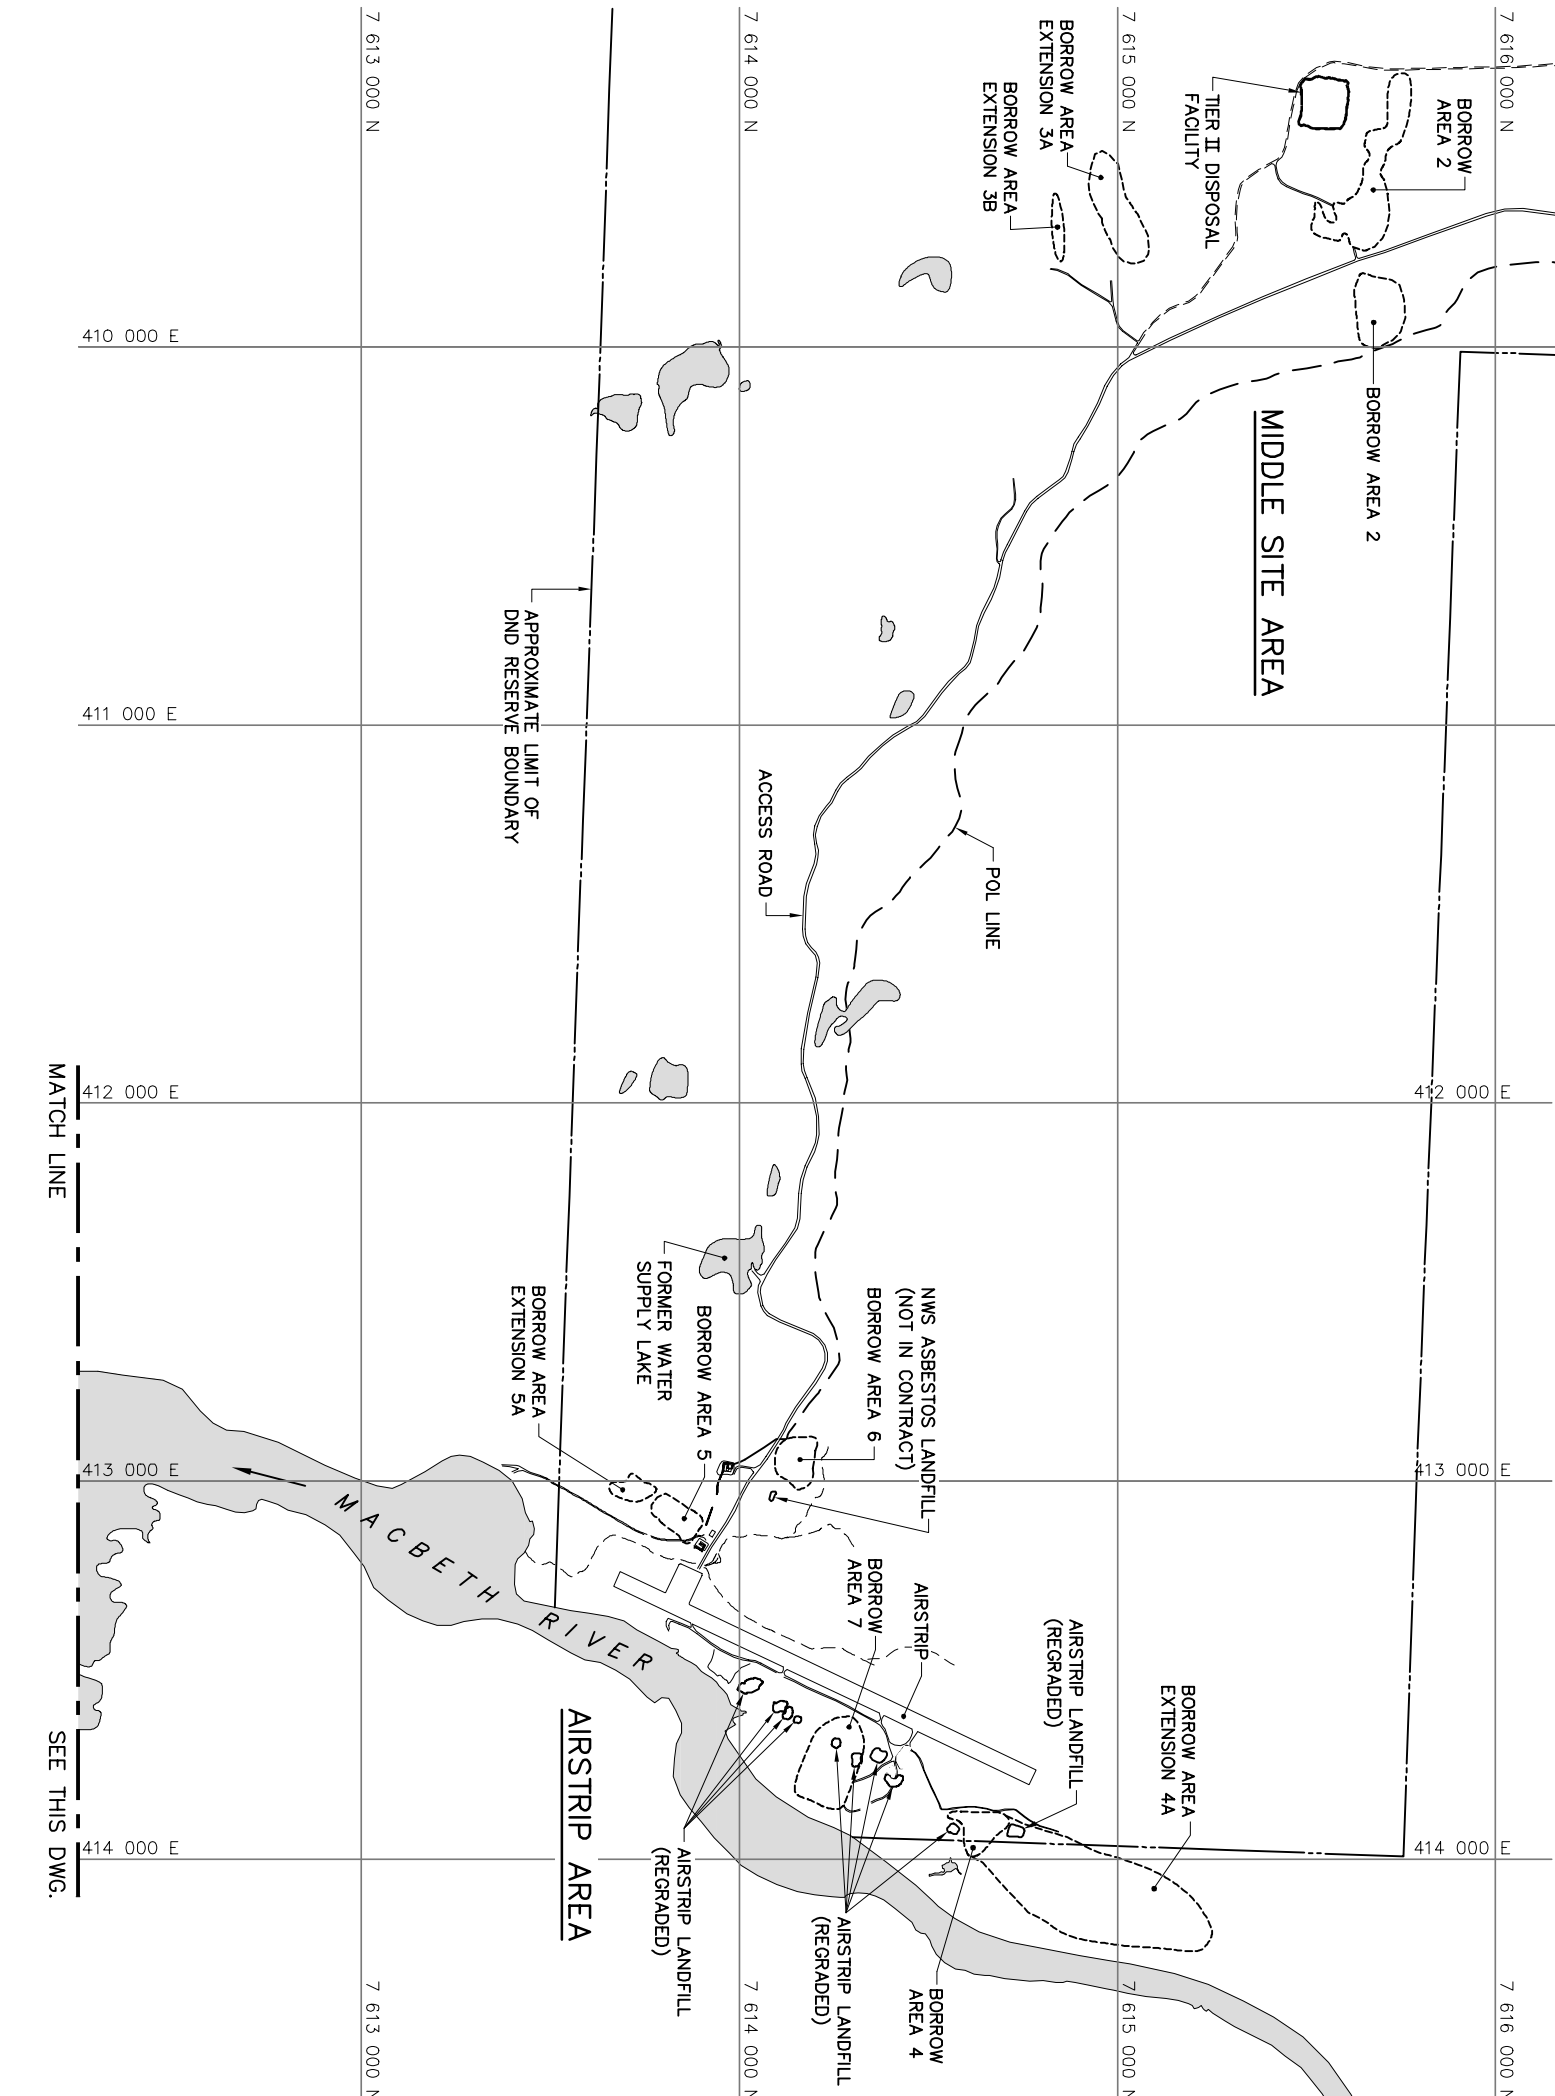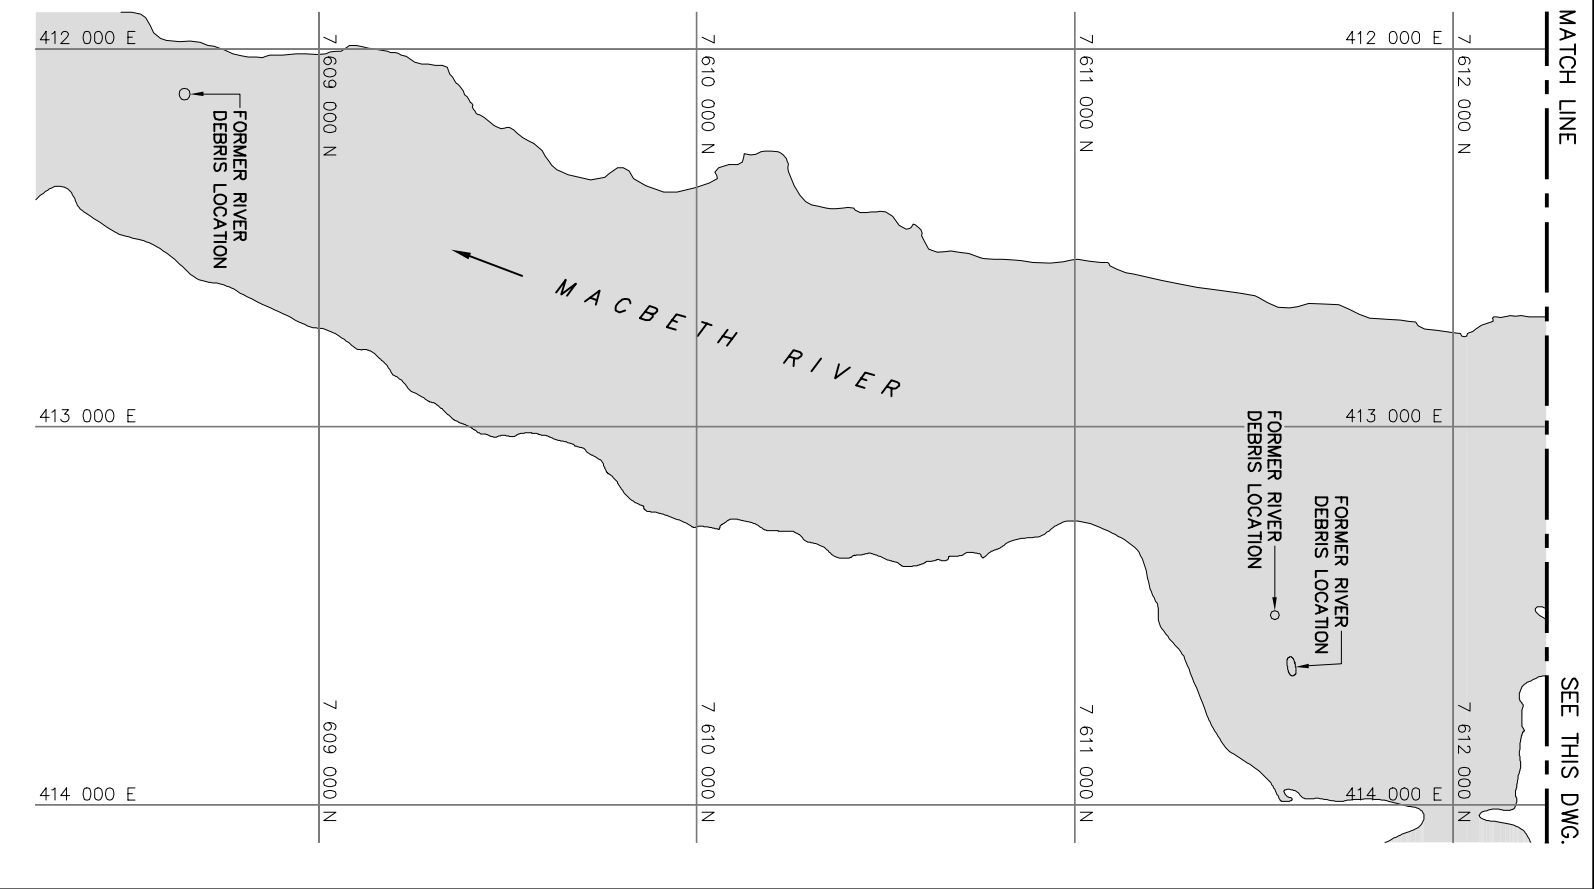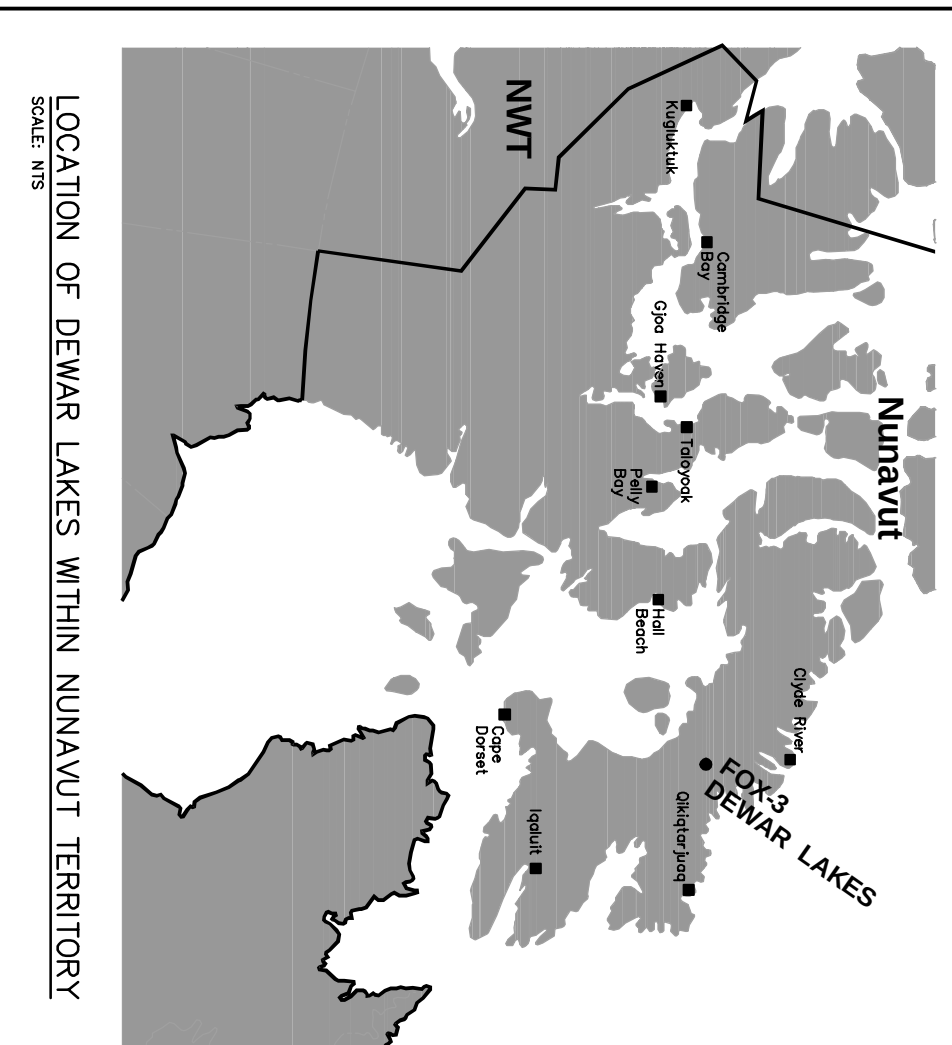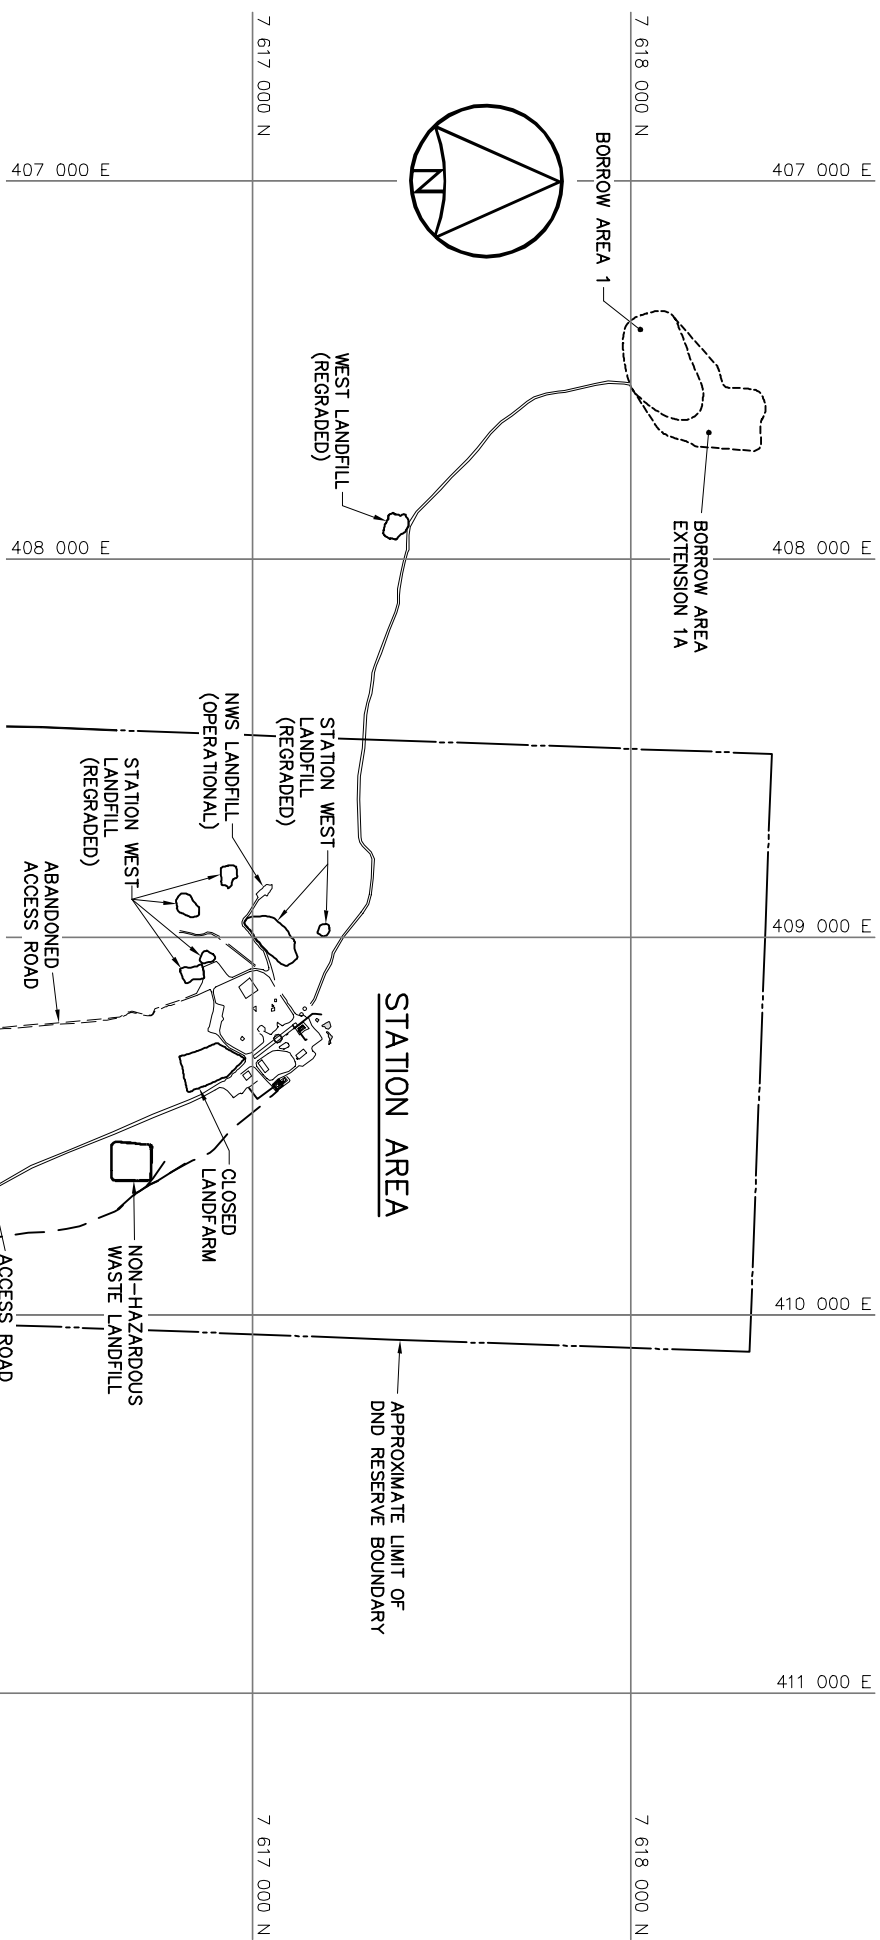

MATCH LINE

SEE THIS DWG.

- General Notes:
- ALL COORDINATES ARE REFERENCED TO NAD83 (GRS83). UTM ZONE 19N. ALL ELEVATIONS REFER TO GEODETIC DATUM. ALL DIMENSIONS ARE IN METRES UNLESS NOTED OTHERWISE.
 - ARCHAEOLOGICAL FEATURES LOCATED AS PER ARCHAEOLOGICAL STUDY A-102-3, DEWAR LAKES, BY THOMSON HERITAGE CONSULTANTS.
 - FOR PERMANENT SURVEY CONTROL MONUMENT INSTALLATION DETAIL, SEE DWG. H-D67/-9101-128.

- Legend:
- △ CMI1 SURVEY CONTROL MONUMENT
 - ▲ BM-1 PERMANENT BENCHMARK LOCATION (2)
 - APPROXIMATE LOCATION OF PROPERTY BOUNDARY
 - ARCHAEOLOGICAL FEATURES
 - BODY OF WATER

0	12-10-22	AS-BUILT DRAWING	RAM
No.	DATE	REVISION	REVISION

DRAFT

AECOM HATCH

SCALE - GRAPHIC 100 50 0 100 200 300m
PROJECT - PROJECT
FOX-3 DEWAR LAKES

DEW LINE CLEAN UP
© COPYRIGHT
HER MAJESTY THE QUEEN IN RIGHT OF
CANADA 2012, AS REPRESENTED BY THE
MINISTER OF NATIONAL DEFENCE.

TRADE - METER SITTING DATE 2007-08-24
SUBJECT - SILET

PROJECT LAYOUT
SHEET 1

PRODUCTION	CONCURRENCE - ASSENTMENT
DESIGNED <i>ME/JIM</i>	DES. OFF.
DRAWN <i>CM</i>	SECT. NO.
CHECKED <i>RAM</i>	CHEF. SECT.
VERIFIED <i>RAM</i>	DES. MGR.
COORDINATION <i>SMS</i>	GEST. CONCEPT
	REVIEWED - REVU



DWG. NO. - DESIGN NO.
H-D67/-9101-102

Canada

SURVEY CONTROL MONUMENTS				
NO.	UTM COORDINATES		ELEV.	DESCRIPTION
	NORTHING	EASTING		
CMI1	7 616 981.903	408 942.460	513.650	FOX-3 BASELINE STA. 0+00
CM2	7 617 076.192	409 081.577	517.980	FOX-3 BASELINE STA. 5+51.73
CM3	7 617 135.904	409 169.961	518.382	FOX-3 BASELINE STA. 9+01.38

NOTE: BASELINE STATIONS SHOWN ARE IN IMPERIAL UNITS.

PERMANENT BENCHMARK (AS-BUILT)				
NO.	UTM COORDINATES		ELEV.	DESCRIPTION
	NORTHING	EASTING		
BM-1	7 617 469.480	407 993.870	415.600	25mm DIA. STEEL PIPE
BM-2	7 616 550.650	409 501.940	498.460	25mm DIA. STEEL PIPE

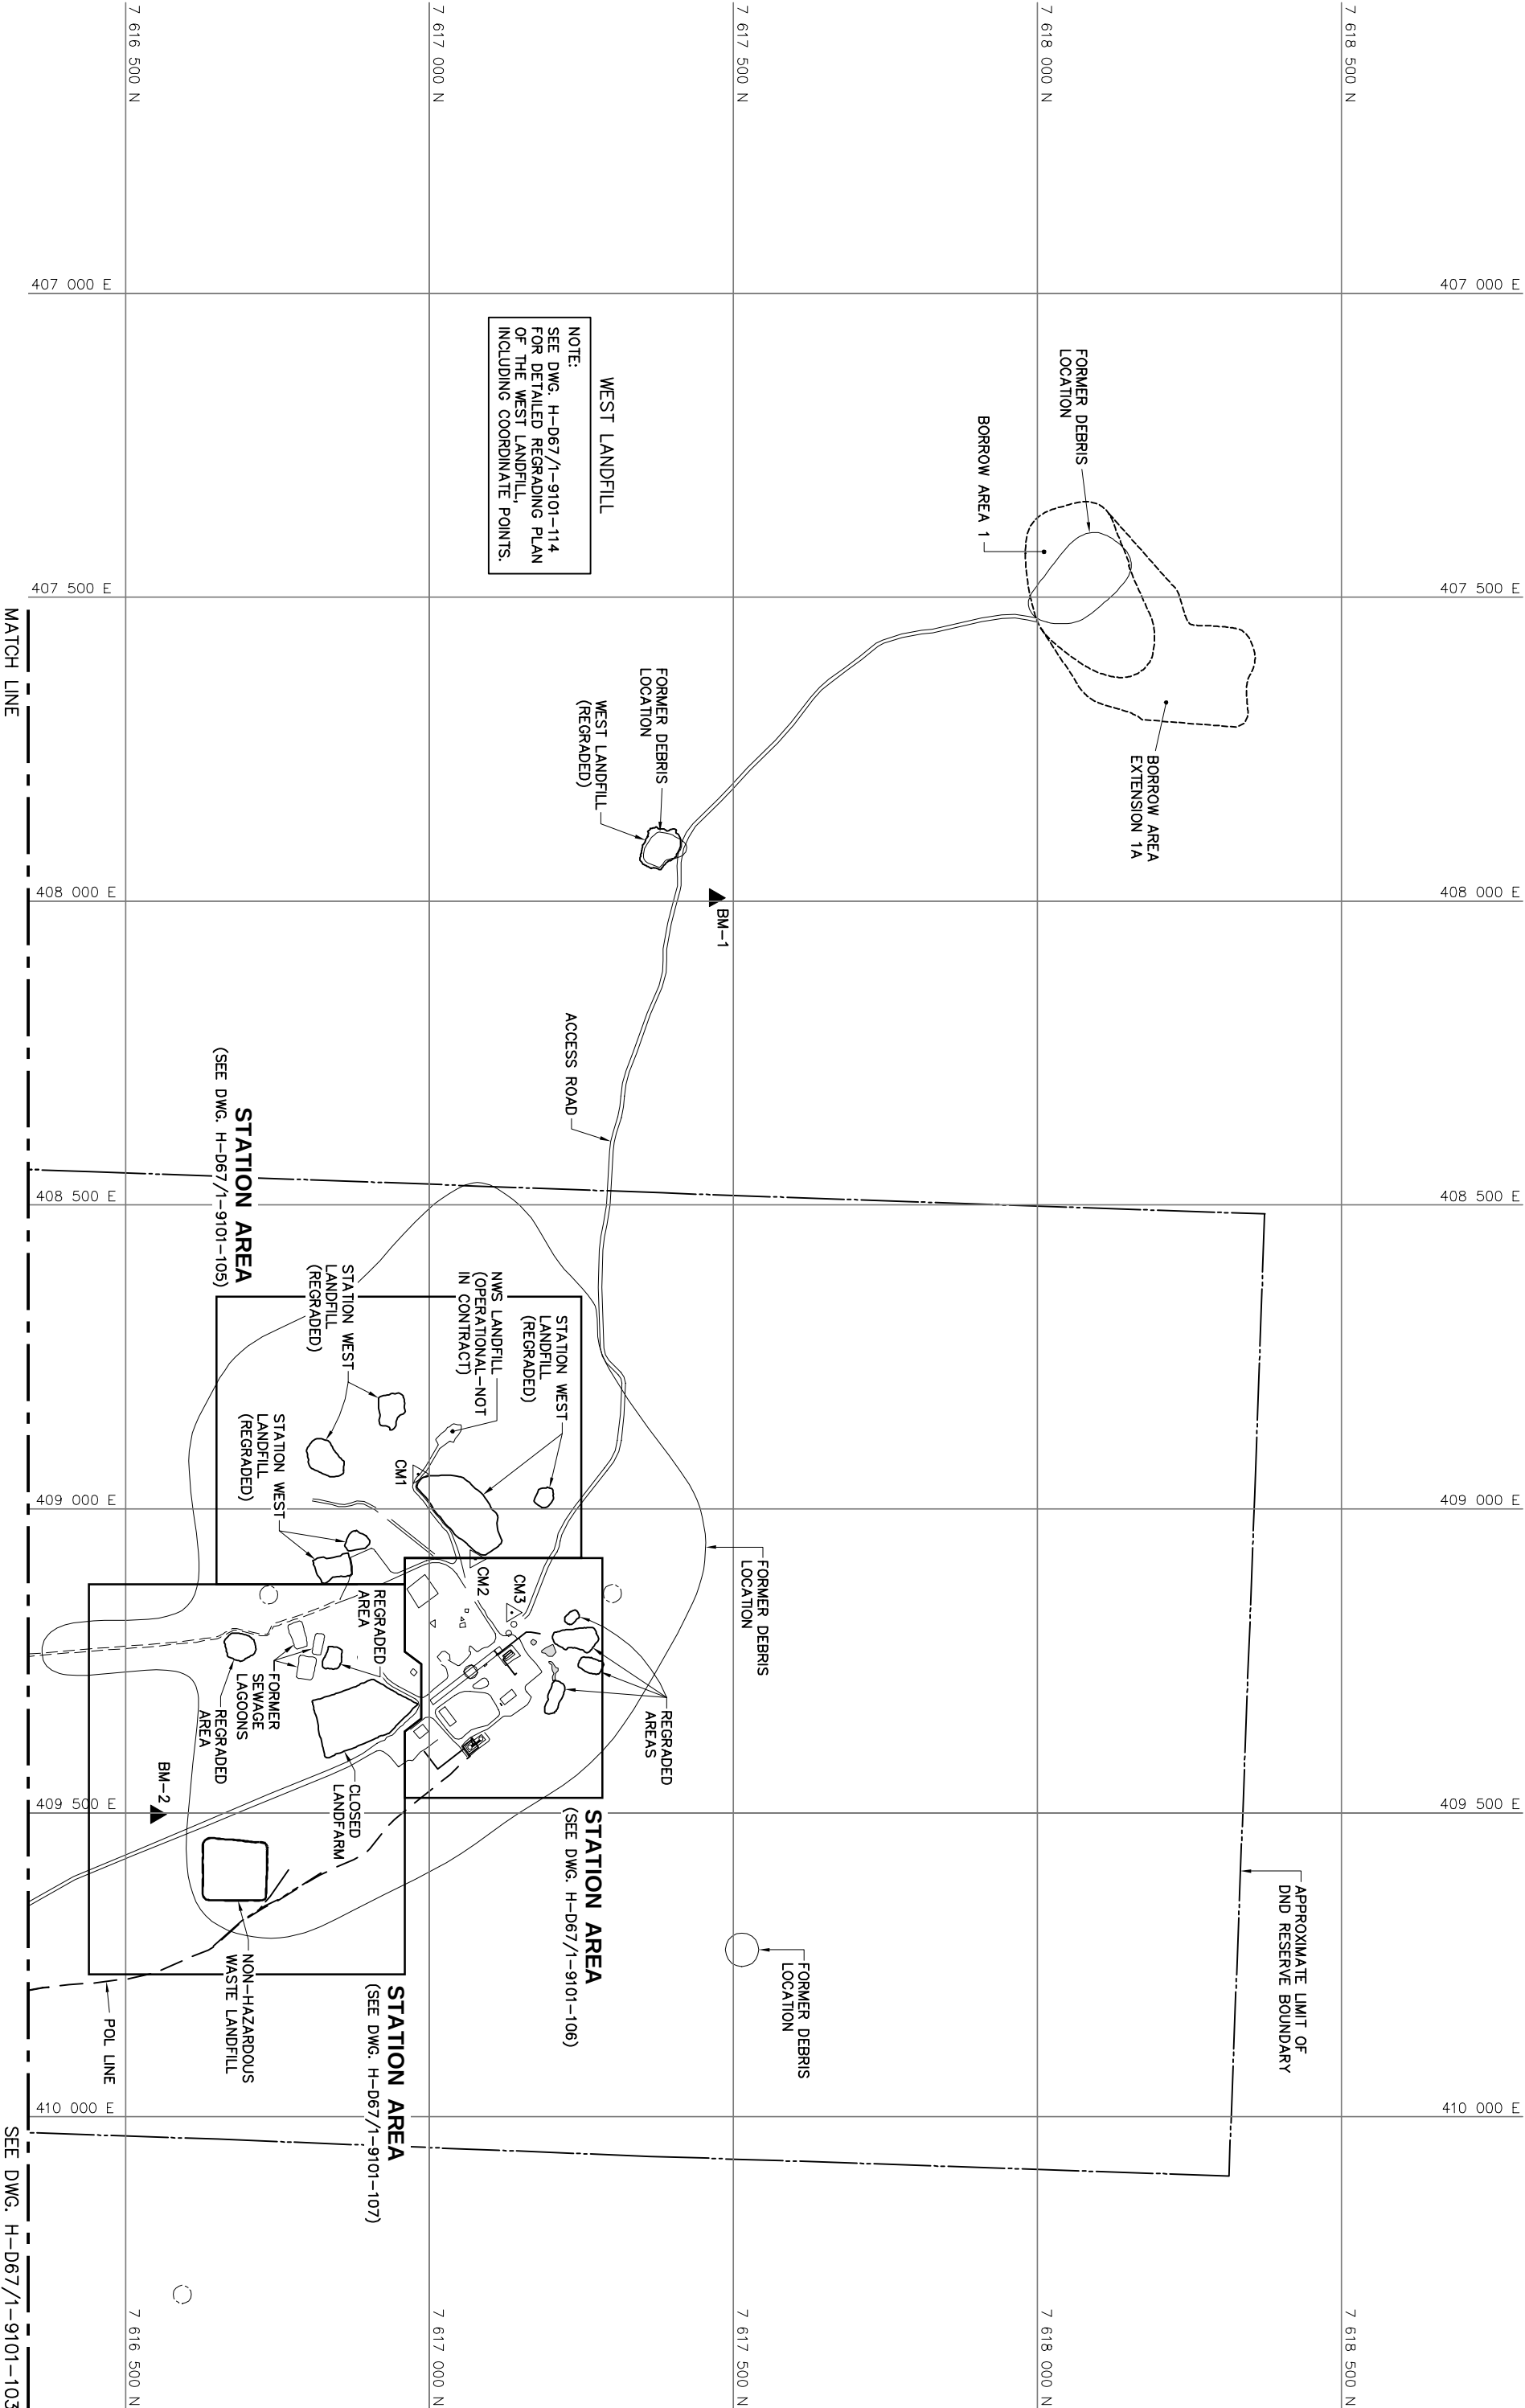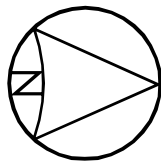

NOTE:
SEE DWG. H-D67/-9101-114
FOR DETAILED REGRADE PLAN
OF THE WEST LANDFILL,
INCLUDING COORDINATE POINTS.

General Notes:

1. ALL COORDINATES ARE REFERENCED TO MAD3 (CSPR), UTM ZONE 19N. ALL ELEVATIONS REFER TO GEOIDETIC DATUM.
2. ALL DIMENSIONS ARE IN METRES UNLESS NOTED OTHERWISE.
3. ARCHEOLOGICAL FEATURES LOCATED AS PER ARCHEOLOGICAL STUDY AT FOX-3, DEMAR LAKES, BY THOMSON HERITAGE CONSULTANTS.
4. FOR PERMANENT SURVEY CONTROL (BENCHMARK) INSTALLATION DETAIL, SEE DWG. H-DB07/1-9101-129.

Legend:

-  BM-3 PERMANENT BENCHMARK
 LOCATION (1)
 APPROXIMATE LOCATION OF
 PROPERTY BOUNDARY
 ARCHAEOLOGICAL FEATURES
 BODY OF WATER

SEE DWG. H-D67/1-9101-104

0	12-10-22	AS-BUILT DRAWING		RM
No.	DATE	REVISION	REVISION	APPR.

DRAFT



AECOM **HATCH**

SCALE - ECHELLE 100 50 0 100 200 300m

FOX-3 DEWAR LAKES

DEW LINE CLEAN UP

© COPYRIGHT
HER MAJESTY THE QUEEN IN RIGHT OF
CANADA 2012, AS REPRESENTED BY THE
MINISTER OF NATIONAL DEFENCE.


TRADE - METIER	DATE
SITTING	2007-08-24
SUBJECT - SUJET	

PROJECT LAYOUT
SHEET 2

PRODUCTION	CONCURRENCE - ASSIGNMENT	
DESIGNED <i>THE DDM</i>	DES OFF	
ETUIE	AGENT CONCEPT	
DRAWN	SECT HD	
<i>CAC</i>	CHEF SECT	
DESIGNED		
CHECKED <i>REM</i>	DES MOR	
VERNIE	GEST CONCEPT	
COORDINATION <i>SMS</i>	REVIEWED - REVU	

DWG. NO. - DESSIN NO.
H-D67/1-9101-103

Canada

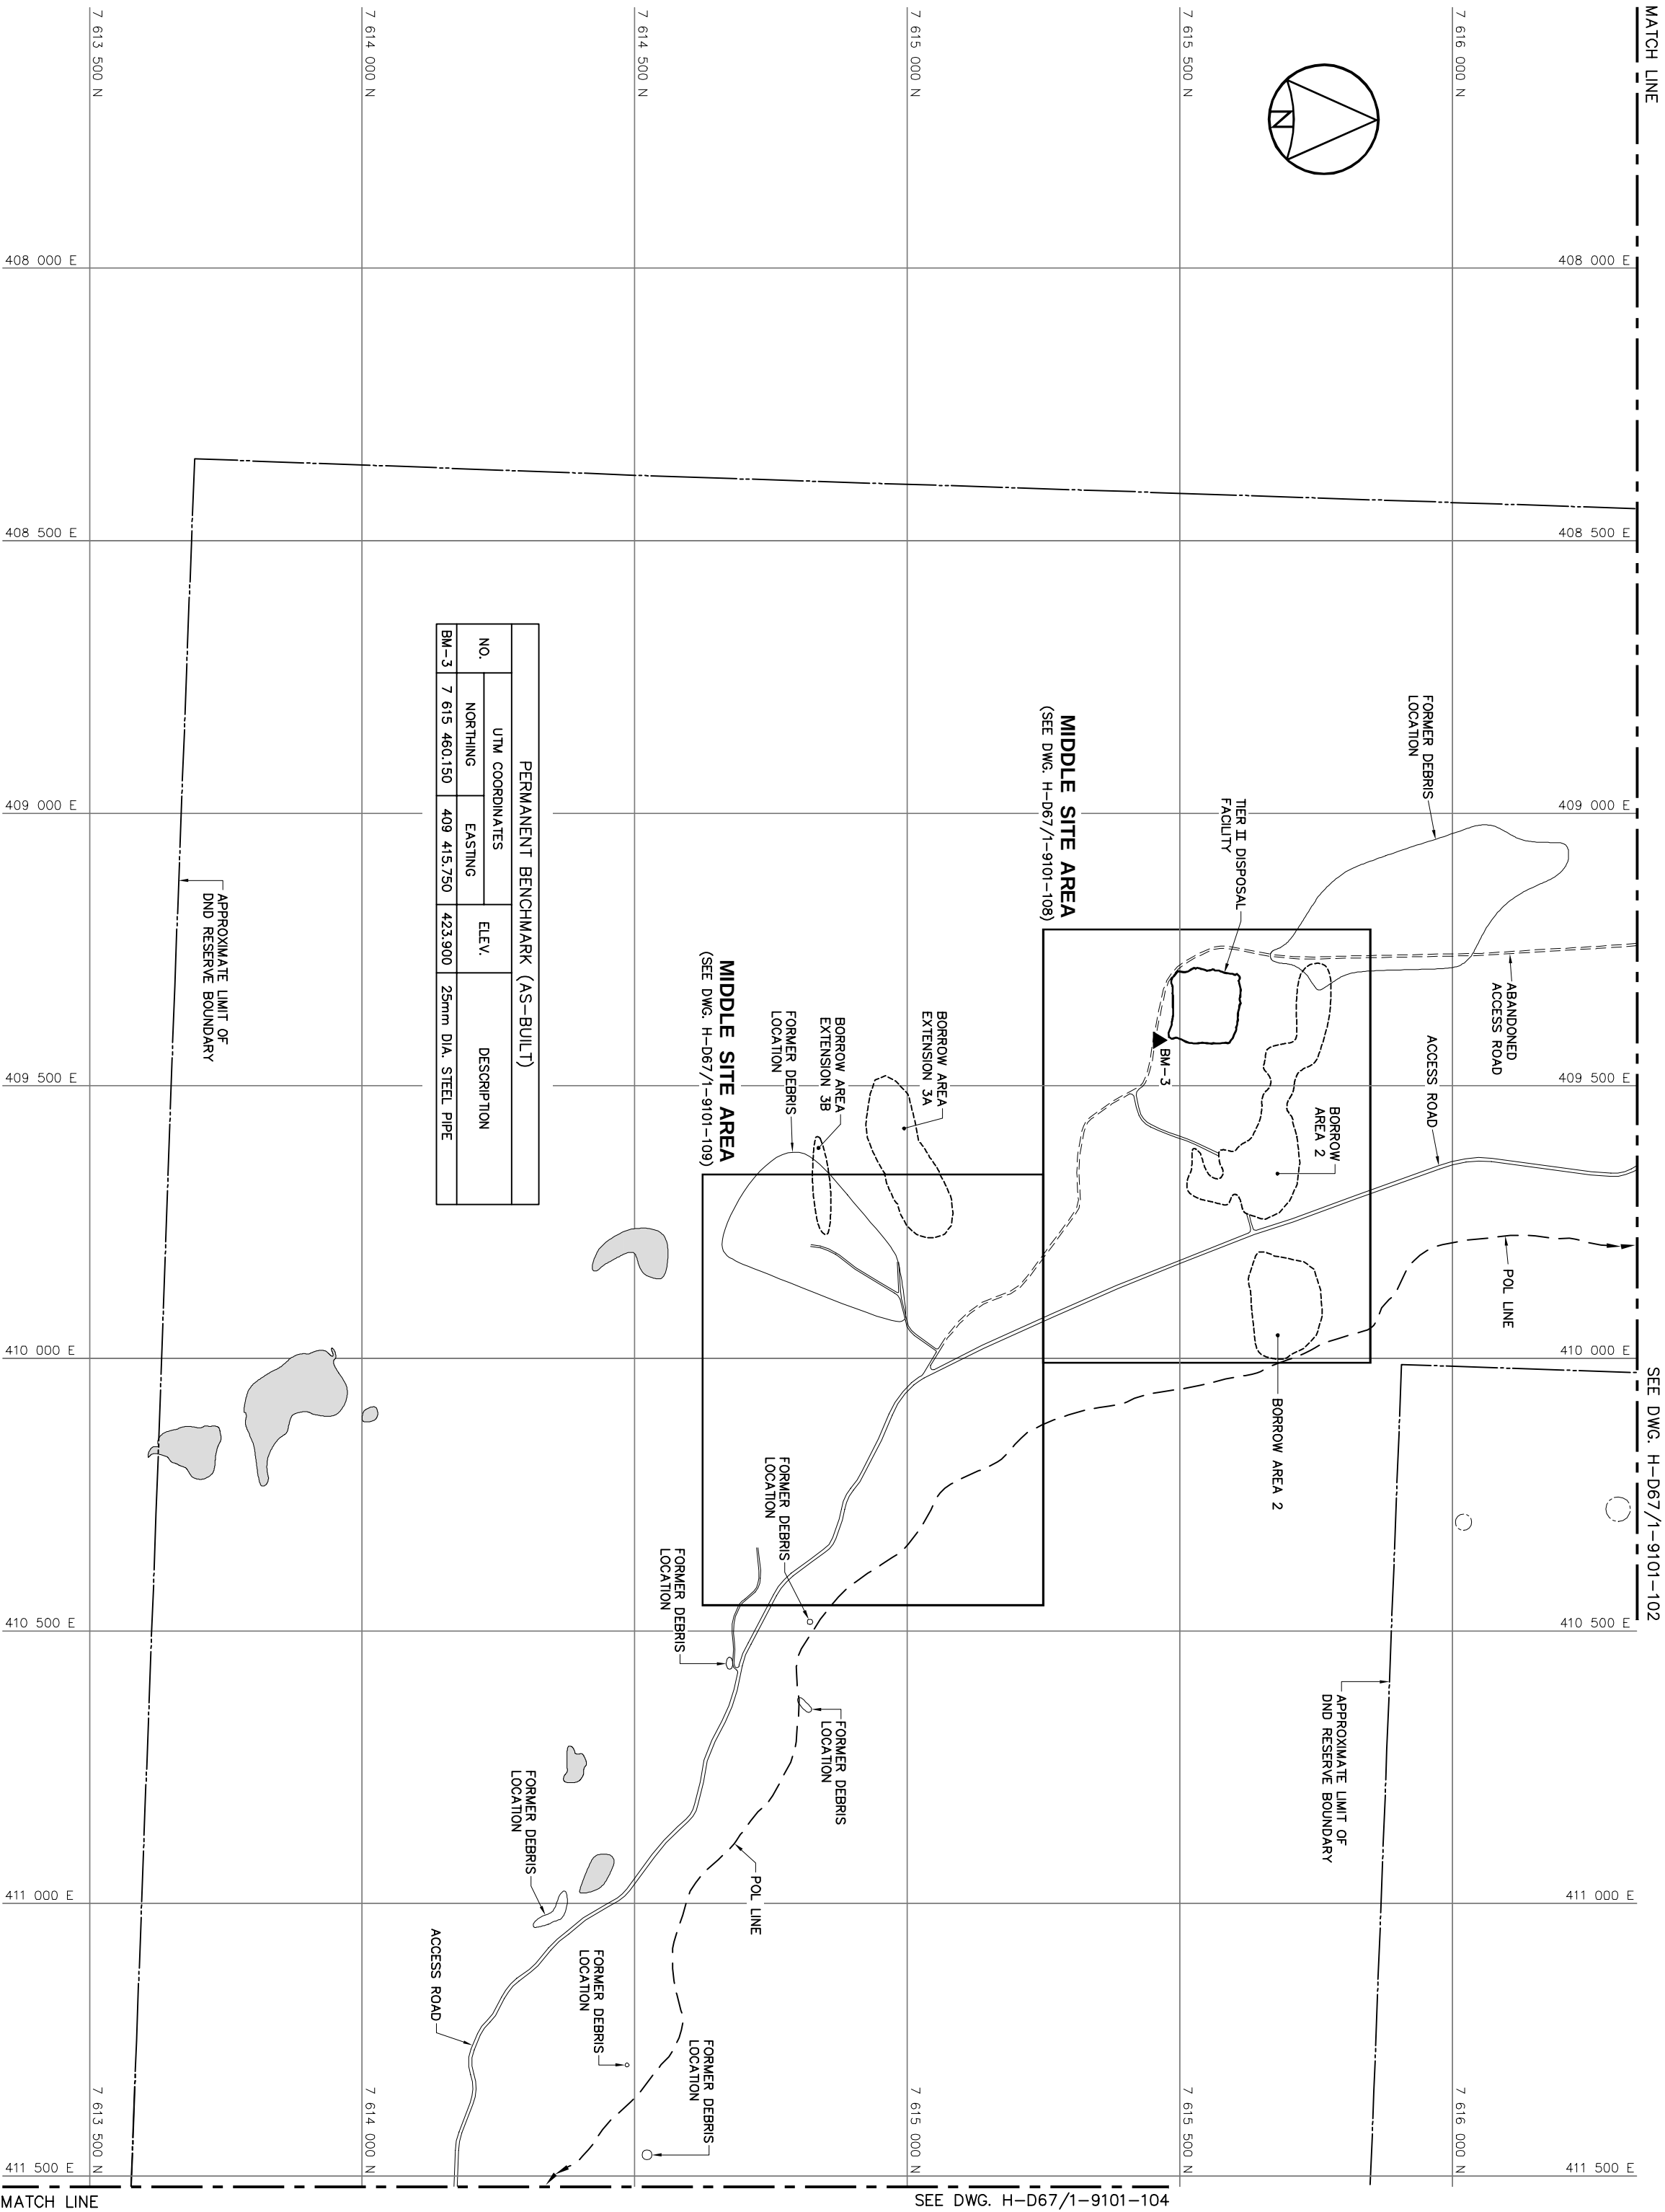

1. ALL COORDINATES ARE REFERENCED TO NAD83 (GSPR). UTM ZONE 19N. ALL ELEVATIONS REFER TO GEODETIC DATUM.
2. ALL DIMENSIONS ARE IN METERS UNLESS NOTED OTHERWISE.
3. ARCHAEOLOGICAL FEATURES LOCATED AS PER ARCHAEOLOGICAL STUDY AT FOX-3, DEWAR LAKES, BY THOMSON HERITAGE CONSULTANTS.
4. FOR PERMANENT SURVEY CONTROL (BENCHMARK) INSTALLATION DETAIL, SEE DWG. H-DBF/1-9101-129.

1. ALL COORDINATES ARE REFERENCED TO NAD83 (GSPR). UTM ZONE 19N. ALL ELEVATIONS REFER TO GEODETIC DATUM.
2. ALL DIMENSIONS ARE IN METERS UNLESS NOTED OTHERWISE.
3. ARCHAEOLOGICAL FEATURES LOCATED AS PER ARCHAEOLOGICAL STUDY AT FOX-3, DEWAR LAKES, BY THOMSON HERITAGE CONSULTANTS.
4. FOR PERMANENT SURVEY CONTROL (BENCHMARK) INSTALLATION DETAIL, SEE DWG. H-DBF/1-9101-129.

BM-4
 PERMANENT BENCHMARK
 LOCATION (2)

 APPROXIMATE LOCATION OF
 CONTRACTORS COMMEMORATIVE
 PLAQUE

 APPROXIMATE LOCATION OF
 PROPERTY BOUNDARY

 BODY OF WATER

 ARCHAEOLOGICAL FEATURES

DRAFT

Age Group	Percentage
100	100
50	100
0	100
100	100
200	100
300	100

DEW LINE CLEAN UP

© COPYRIGHT
HER MAJESTY THE QUEEN IN RIGHT OF
CANADA 2012, AS REPRESENTED BY THE
MINISTER OF NATIONAL DEFENCE.

PROJECT LAYOUT
SHEET 3

PROJECT LAYOUT
SHEET 3

DWG. NO. - DESSIN NO.
H-D67/1-9101-104


Canada

SURVEY CONTROL MONUMENTS			
NO.	UTM COORDINATES		DESCRIPTION
	NORTHING	EASTING	
CM1	7 616 981.903	408 942.460	513.650 FOX-3 BASELINE STA. 0+00

NOTE: BASELINE STATIONS SHOWN ARE IN IMPERIAL UNITS.

NOTE:
FOR DETAILS REGARDING CONFIRMATORY TESTING INFORMATION, REFER TO FINAL REPORT PREPARED BY THE ENVIRONMENTAL SCIENCES GROUP, ROYAL MILITARY COLLEGE.

NOTE:
CONTOURS SHOWN AS DASHED LINES WERE GENERATED FROM SURVEY INFORMATION AND REPRESENT FINISHED GROUND SURFACE FOLLOWING REGRAIDING OR RESHAPING.

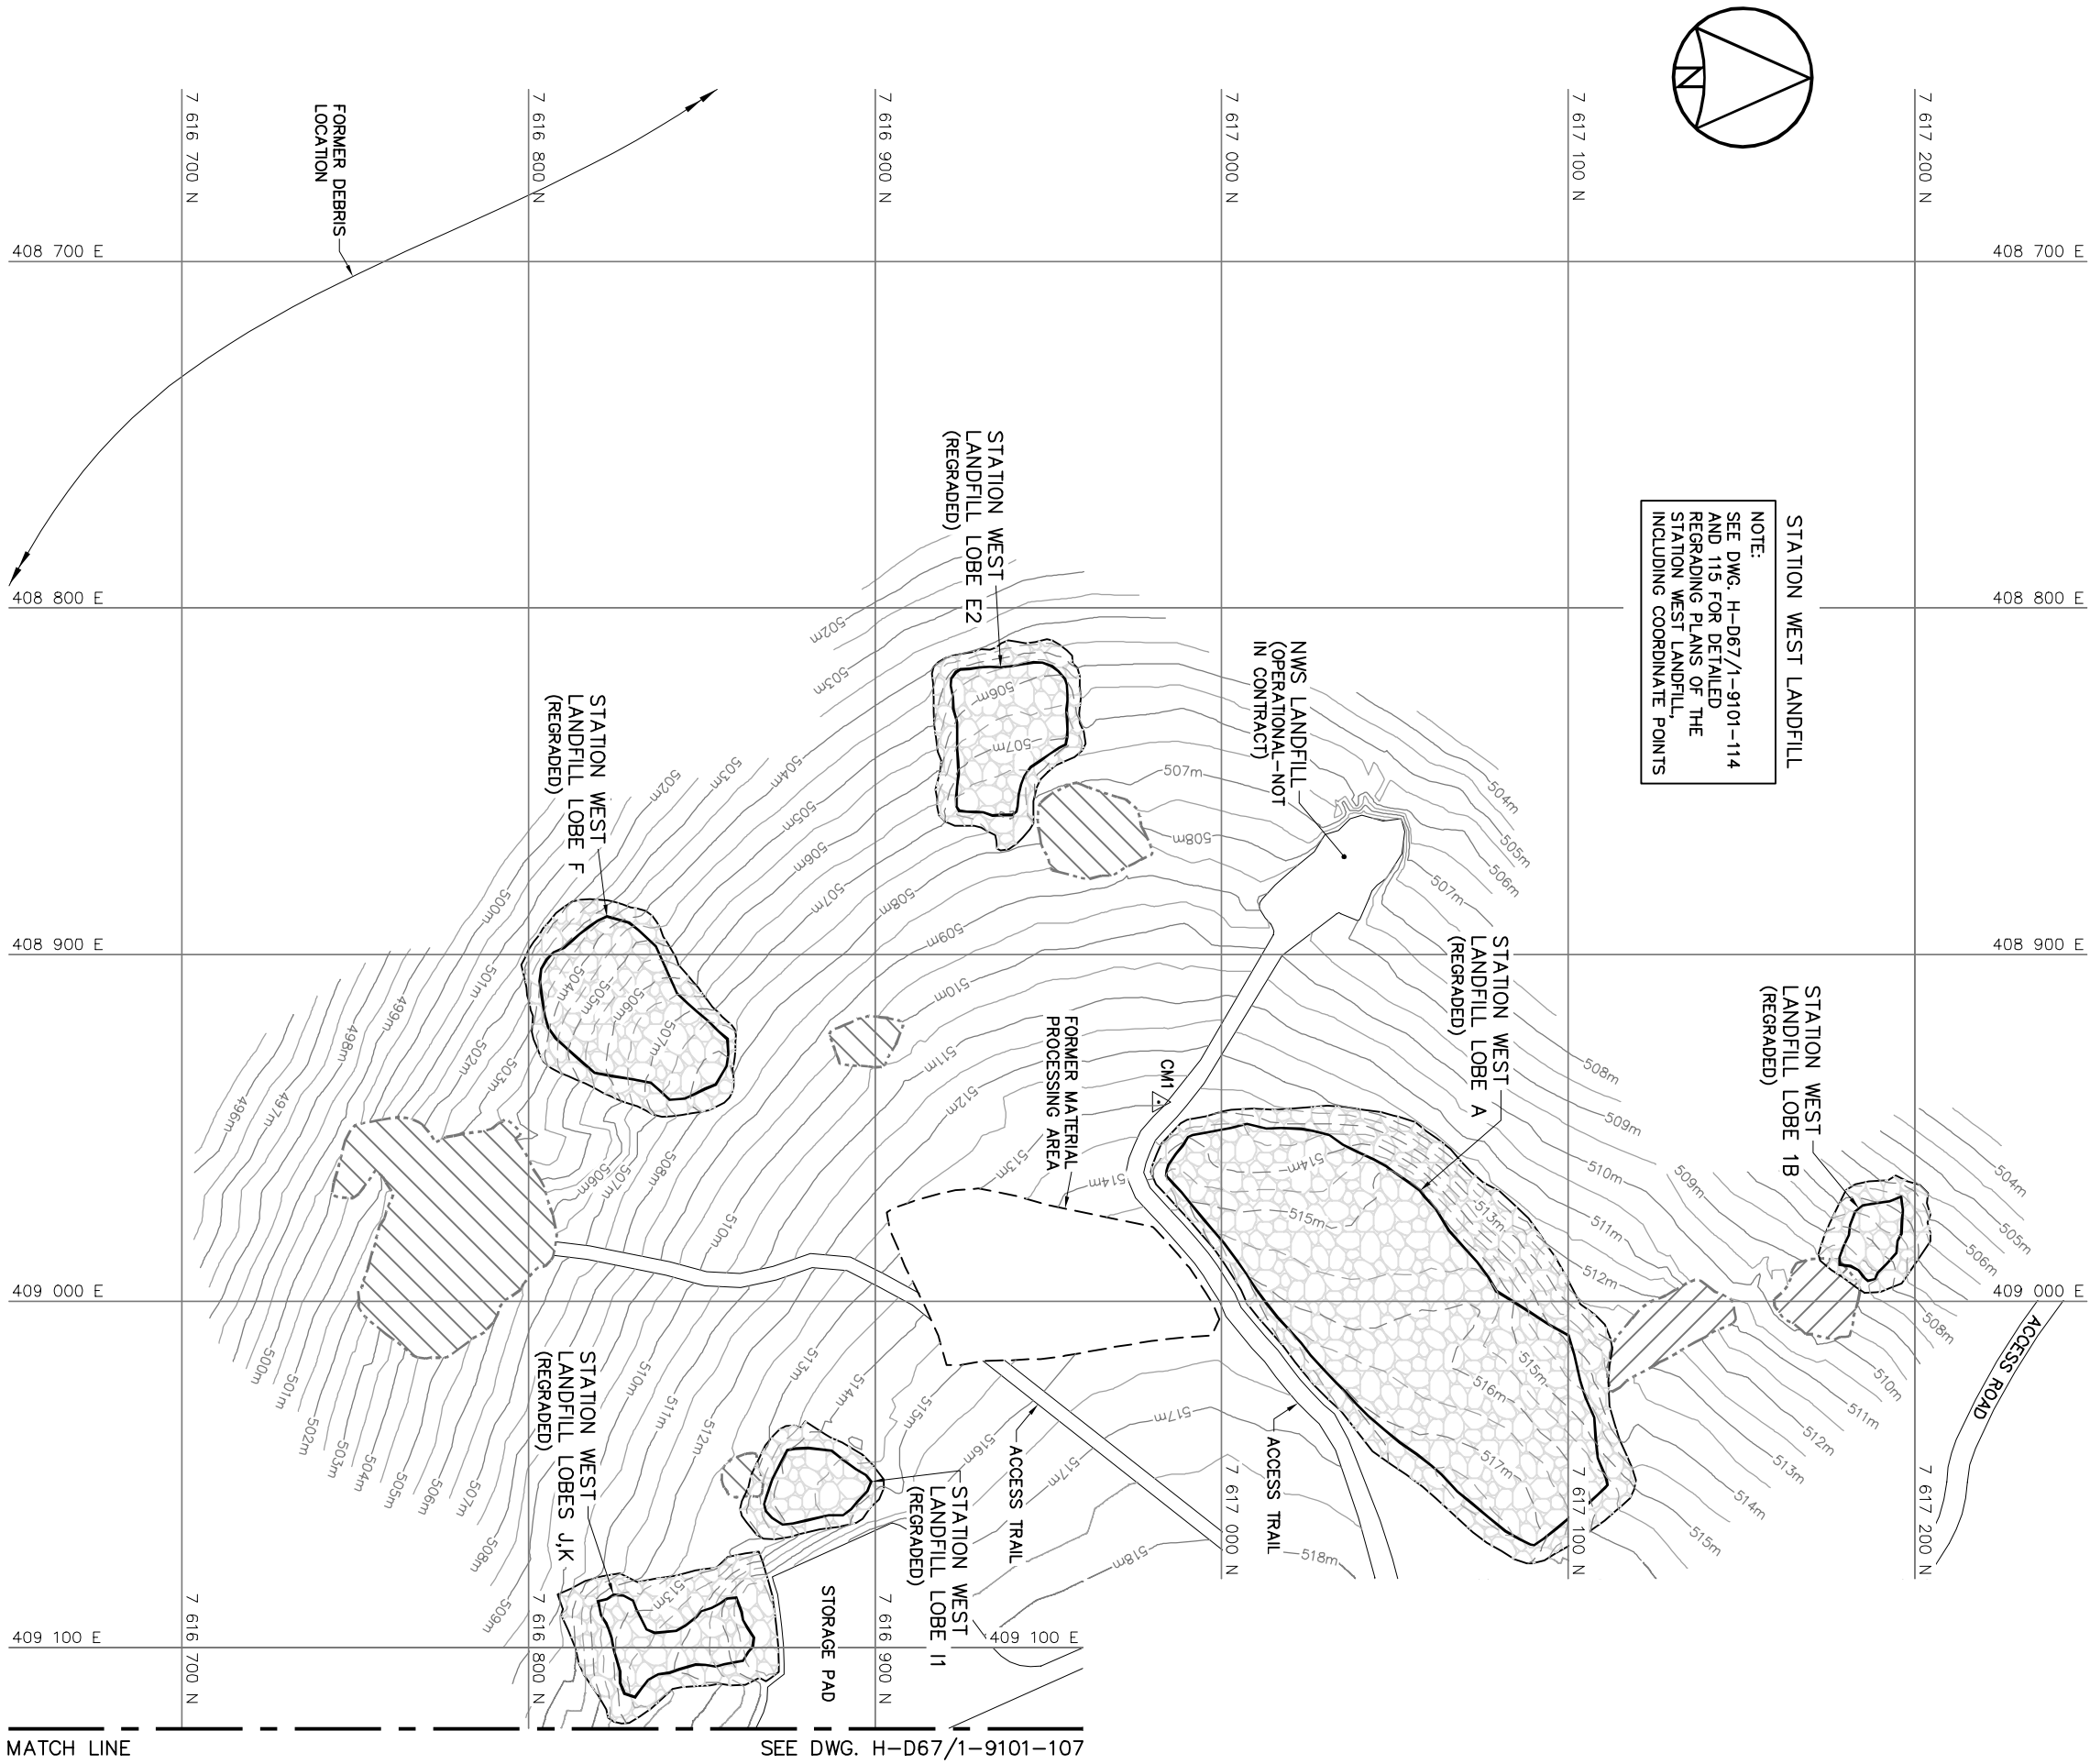

- General Notes:
1. ALL COORDINATES ARE REFERENCED TO NAD83 (GRS83) UTM ZONE 18N. ALL ELEVATIONS REFER TO GEODETIC DATUM.
 2. ALL DIMENSIONS ARE IN METRES UNLESS NOTED OTHERWISE.

- Legend:
- CM1 SURVEY CONTROL MONUMENT
 - COMPLETED LANDFILL OR BURIED DEBRIS EXCAVATION

0	12-10-22	AS-BUILT DRAWING	
NO.	DATE	REVISION	REVISION
			<i>RAM</i>

DRAFT

AECOM **HATCH**

SCALE - GRAPHIC 20 10 0 20 40 60m

PROJECT - PROJECT
FOX-3 DEWAR LAKES

DEW LINE CLEAN UP

© COPYRIGHT
HER MAJESTY THE QUEEN IN RIGHT OF
CANADA 2012, AS REPRESENTED BY THE
MINISTER OF NATIONAL DEFENCE.

TRADE - METER SITING DATE 2007-08-24

STATION AREA
SITE PLAN
SHEET 1

PRODUCTION		CONCURRENCE - ASSSIGNMENT	
DESIGNED <i>HME/DJM</i>		DES. OFF.	
DRAWN <i>CMF</i>		AGENT CONCEPT	
DRAWN <i>CMF</i>		DESIGN	
CHECKED <i>RAM</i>		CHEF. SECT	
VERIFIED <i>RAM</i>		DES. MGR	
COORDINATION <i>SMS</i>		DEPT. CONCEPT	
		REVIEWED - REVU	

DWG. NO. - DESIGN NO.
H-D67/1-9101-105

Canada

General Notes:

- ALL COORDINATES ARE REFERENCED TO NAD83 (GRS83). UTM ZONE 19N. ALL ELEVATIONS REFER TO GEODETIC DATUM.
- ALL DIMENSIONS ARE IN METRES UNLESS NOTED OTHERWISE.
- AS-BUILT SURVEY NOT SUBMITTED FOR FINAL SURFACE OF TYPE 2 GRANULAR FILL.

SURVEY CONTROL MONUMENTS

NO.	UTM COORDINATES		DESCRIPTION
	NORTHING	EASTING	
CM2	7 617 076.152	409 081.577	FOX-3 BASELINE STA. 5+51.73
CM3	7 617 135.904	409 169.961	FOX-3 BASELINE STA. 9+01.36

NOTE: BASELINE STATIONS SHOWN ARE IN IMPERIAL UNITS.

NOTE:

FOR DETAILS REGARDING CONFIRMATORY TESTING INFORMATION, REFER TO FINAL REPORT PREPARED BY THE ENVIRONMENTAL SCIENCES GROUP, ROYAL MILITARY COLLEGE.

NOTE:

CONTOURS SHOWN AS DASHED LINES WERE GENERATED FROM SURVEY INFORMATION AND REPRESENT FINISHED GROUND SURFACE FOLLOWING REGRADED OR RESHAPING.

GARAGE DEBRIS AREA (LOBE A)
REGRADED (AS-BUILT)

NO.	UTM COORDINATES		ELEV.
	NORTHING	EASTING	
101	7 617 235.6	409 172.0	514.4
102	7 617 242.3	409 176.9	514.4
103	7 617 230.4	409 186.2	515.2
104	7 617 227.9	409 183.2	515.2
105	7 617 226.9	409 179.0	515.0

GARAGE DEBRIS AREA
(LOBES B,C)
AREA REGRADED WITH 0.4m
TYPE 1 GRANULAR FILL OVER
0.4m TYPE 2 GRANULAR FILL
(ASSUMED SEE NOTE 3)

NO.	UTM COORDINATES		ELEV.
	NORTHING	EASTING	
110	7 617 272.6	409 205.3	513.2
111	7 617 274.8	409 215.5	512.9
112	7 617 257.7	409 230.6	514.7
113	7 617 242.6	409 218.7	515.6
114	7 617 222.6	409 225.1	516.3
115	7 617 207.4	409 216.9	516.5
116	7 617 207.1	409 211.8	516.8
117	7 617 212.5	409 207.2	516.6
118	7 617 242.7	409 208.7	515.7
119	7 617 246.8	409 204.1	515.6

GARAGE DEBRIS AREA
(LOBES E,F)
AREA REGRADED WITH 0.4m
TYPE 1 GRANULAR FILL OVER
0.4m TYPE 2 GRANULAR FILL
(ASSUMED SEE NOTE 3)

NO.	UTM COORDINATES		ELEV.
	NORTHING	EASTING	
120	7 617 277.1	409 255.0	513.9
121	7 617 275.9	409 262.5	514.4
122	7 617 271.7	409 266.3	514.5
123	7 617 263.4	409 266.2	514.6
124	7 617 255.6	409 260.9	515.5
125	7 617 251.1	409 256.7	515.5
126	7 617 253.2	409 249.3	515.1
127	7 617 265.1	409 253.4	514.7
128	7 617 271.7	409 253.2	514.2

GARAGE DEBRIS AREA (LOBE D)
REGRADED (AS-BUILT)


NO.	UTM COORDINATES		ELEV.
	NORTHING	EASTING	
120	7 617 277.1	409 255.0	513.9
121	7 617 275.9	409 262.5	514.4
122	7 617 271.7	409 266.3	514.5
123	7 617 263.4	409 266.2	514.6
124	7 617 255.6	409 260.9	515.5
125	7 617 251.1	409 256.7	515.5
126	7 617 253.2	409 249.3	515.1
127	7 617 265.1	409 253.4	514.7
128	7 617 271.7	409 253.2	514.2

GARAGE DEBRIS AREA (LOBES E,F)
REGRADED (AS-BUILT)

NO.	UTM COORDINATES		ELEV.
	NORTHING	EASTING	
130	7 617 219.4	409 293.3	516.5
131	7 617 204.8	409 329.8	516.8
132	7 617 197.4	409 331.7	517.2
133	7 617 194.1	409 326.9	517.1
134	7 617 210.0	409 289.8	516.8

GARAGE DEBRIS AREA (LOBES B,C)
REGRADED (AS-BUILT)

NO.	UTM COORDINATES		ELEV.
	NORTHING	EASTING	
110	7 617 272.6	409 205.3	513.2
111	7 617 274.8	409 215.5	512.9
112	7 617 257.7	409 230.6	514.7
113	7 617 242.6	409 218.7	515.6
114	7 617 222.6	409 225.1	516.3
115	7 617 207.4	409 216.9	516.5
116	7 617 207.1	409 211.8	516.8
117	7 617 212.5	409 207.2	516.6
118	7 617 242.7	409 208.7	515.7
119	7 617 246.8	409 204.1	515.6

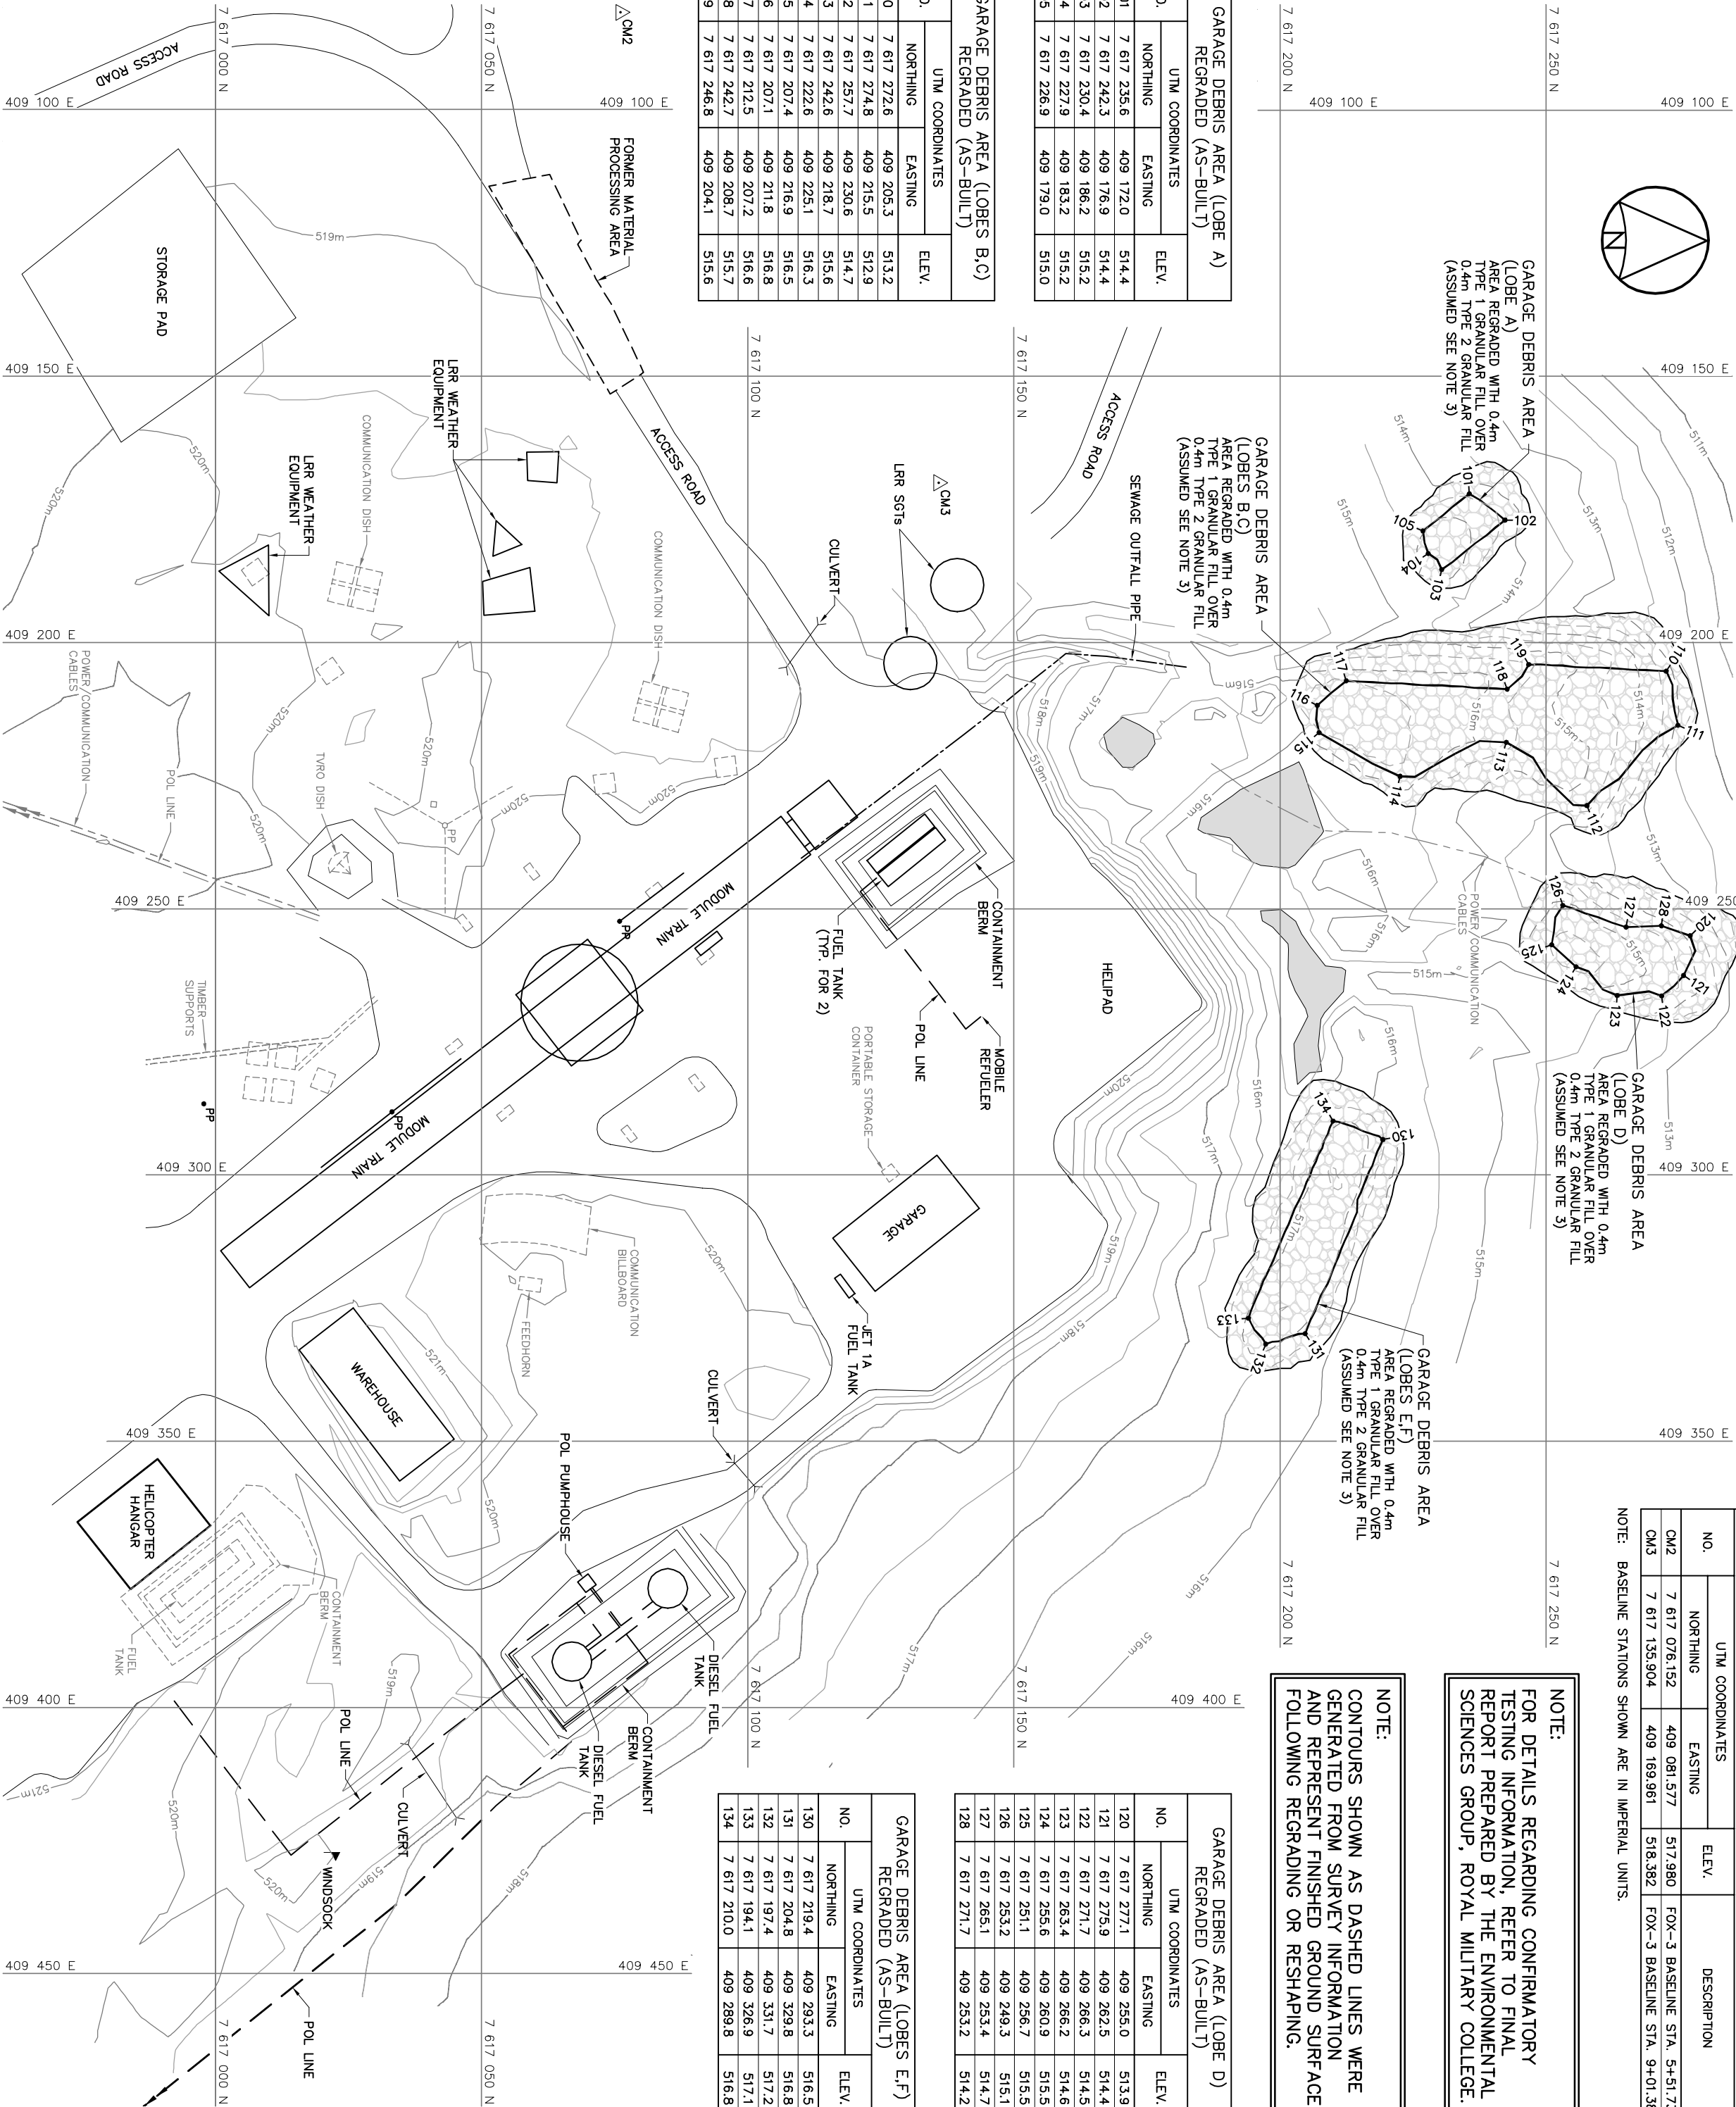

DRAFT

AECOM HATCH

SCALE - GRAPHIC 10 5 0 10 20 30m

PROJECT - PROJECT FOX-3 DEWAR LAKES

DEW LINE CLEAN UP

© COPYRIGHT HER MAJESTY THE QUEEN IN RIGHT OF CANADA 2012, AS REPRESENTED BY THE MINISTER OF NATIONAL DEFENCE.

TRADE - METER SITTING DATE 2007-08-24

STATION AREA
SITE PLAN
SHEET 2

PRODUCTION		CONCURRENCE - ASSIGNMENT	
DESIGNED	THE/DJM	DES. OFF.	
DRAWN	ONE	SECT. HD.	
CHECKED	ONE	CHEF. SECT.	
VERIFIED	ONE	DES. MGR.	
COORDINATION	ONE	DEPT. CONCEPT	
DWG. NO. - DESIGN NO.		H-0677/-9101-106	

Canada

NOTE: CONTOURS SHOWN AS DASHED LINES WERE GENERATED FROM SURVEY INFORMATION AND REPRESENT FINISHED GROUND SURFACE FOLLOWING REGRADEING OR RESHAPING.

General Notes:

1. ALL COORDINATES ARE REFERENCED TO NAD83 (GSR5), UTM ZONE 19N. ALL ELEVATIONS REFER TO GEODETIC DATUM.
2. ALL DIMENSIONS ARE IN METRES UNLESS NOTED OTHERWISE.
3. FOR PERMANENT SURVEY CONTROL (BENCHMARK) INSTALLATION DETAIL, SEE DWG. H-D67/-9101-129.

(BENCHMARK) INSTALLATION DETAIL, SEE DWG. H-D67/1-9101-129.

Legend:

- 
PERMANENT BENCHMARK LOCATION (1)

FORMER BUILDING, STRUCTURE OR TANK LOCATION

COMPLETED LANDFILL OR BURIED DEBRIS EXCAVATION

DRAFT

ALCOM **HATCH**

SCALE - ECHELLE 20 10 0 20 40 60m

FOX-3 DEWAR LAKES

DEW LINE CLEAN UP

© COPYRIGHT
HER MAJESTY THE QUEEN IN RIGHT OF
CANADA 2012, AS REPRESENTED BY THE
MINISTER OF NATIONAL DEFENCE.

GRADE - MILLER	SITING	DATE
		2007-08-24

STATION AREA

SHEET 3

PRODUCTION	CONCURRENCE - ASSEMBLAGE

TIME / DTN	AGENT CONCE
ETUDE	

CAE	CHIEF SECT
DESSINE	

VERIFIABLE CLAIM	GEST CONCEPT
COORDINATION	DEFERRED DEBT

SMS	DWG NO - DESSIN NO
-----	--------------------

H-D67/1-9101-107

Canada

General Notes:

1. ALL COORDINATES ARE REFERENCED TO MA083 (GSR5), UTM ZONE 19N. ALL ELEVATIONS REFER TO GEODETIC DATUM.
2. ALL DIMENSIONS ARE IN METRES UNLESS NOTED OTHERWISE.
3. FOR PERMANENT SURVEY CONTROL (BENCHMARK) INSTALLATION DETAIL, SEE DWG. H-D67/-1-9101-129.

BM-3
PERMANENT BENCHMARK
LOCATION (1)

DRAFT

DEW LINE CLEAN UP

© COPYRIGHT
HER MAJESTY THE QUEEN IN RIGHT OF
CANADA 2012, AS REPRESENTED BY THE
MINISTER OF NATIONAL DEFENCE.

SUBJECT - SHEET
MIDDLE SITE AREA
SITE PLAN
SHEET 1

Canada

1. ALL COORDINATES ARE REFERENCED TO NAD83 (CSRS), UTM ZONE 19N. ALL ELEVATIONS REFER TO GEODETIC DATUM.
2. ALL DIMENSIONS ARE IN METRES UNLESS NOTED OTHERWISE.

 COMPLETED LANDFILL OR BURIED DEBRIS EXCAVATION

DRAFT

DEW LINE CLEAN UP

© COPYRIGHT
HER MAJESTY THE QUEEN IN RIGHT OF
CANADA 2012, AS REPRESENTED BY THE
MINISTER OF NATIONAL DEFENCE.

MIDDLE SITE AREA
SITE PLAN
SHEET 2

DWG. NO. - DESSIN NO.
H-D67/1-9101-109

1. ALL COORDINATES ARE REFERENCED TO NAD83 (CSRS), UTM ZONE 19N. ALL ELEVATIONS REFER TO GEODETIC DATUM.
2. ALL DIMENSIONS ARE IN METRES UNLESS NOTED OTHERWISE

COMPLETED LANDFILL OR BURIED
DEBRIS EXCAVATION

BODY OF WATER

DRAFT

DEW LINE CLEAN UP

TRADE - METIER	DATE
SITTING	2007-08-24
SUBJECT - SUJET	

PRODUCTION	CONCURRENCE - ASSENTMENT
------------	--------------------------

DWG. NO. - DESSIN NO.
H-D67/1-9101-110

Canada



NOTE: CONTOURS SHOWN AS DASHED LINES WERE GENERATED FROM SURVEY INFORMATION AND REPRESENT FINISHED GROUND SURFACE FOLLOWING REGRADING OR RESHAPING.

General Notes:

1. ALL COORDINATES ARE REFERENCED TO MAD83 (CNS3), UTM ZONE 19N. ALL ELEVATIONS REFER TO GEODETIC DATUM.
2. ALL DIMENSIONS ARE IN METRES UNLESS NOTED OTHERWISE.
3. DEBRIS REMOVED FROM THERMOKARST POND PRIOR TO GRANULAR FILL PLACEMENT.

0	12-10-22	AS-BUILT DRAWING	RM
No.	DATE	REVISION	REVISION
			APPR.

Legend:

- COMPLETED LANDFILL OR BURED
DEBRIS EXCAVATION
FORMER BUILDING, STRUCTURE OR
TANK LOCATION
BODY OF WATER

DRAFT

AECOM **HATCH**

SCALE - ECHELLE 20 10 0 20 40 60m

FOX-3 DEWAR LAKES

DEW LINE CLEAN UP

© COPYRIGHT
HER MAJESTY THE QUEEN IN RIGHT OF
CANADA 2012, AS REPRESENTED BY THE
MINISTER OF NATIONAL DEFENCE.

TRADE - METTER	DATE
SITING	2007-08-24

AIRSTrip AREA
SITE PLAN

SHEET 1

PRODUCTION	CONCURRENCE – ASSIGNMENT
DESIGNED <i>ME/DIM</i> ETUDE	DES OFF AGENT CONCEPT
DRAWN <i>CAE</i> DESINNE	SECT HD CHIEF SECT
CHECKED <i>RMH</i> VERIFIE	DES MGR DES CONCEPT
COORDINATION <i>JMS</i>	REVIEWED – <i>REU</i>


DWG. NO. – DESSIN NO.
H-DE67/1-9101-112

Canada

PERMANENT BENCHMARK (AS-BUILT)			
NO.	UTM COORDINATES		DESCRIPTION
	NORTHING	EASTING	
BW-5	7 614 625 710	413 744,760	186,730 25mm DIA. STEEL PIPE

NOTE:
FOR DETAILS REGARDING CONFIRMATORY TESTING INFORMATION, REFER TO FINAL REPORT PREPARED BY THE ENVIRONMENTAL SCIENCES GROUP, ROYAL MILITARY COLLEGE.

NOTE:
CONTOURS SHOWN AS DASHED LINES WERE GENERATED FROM SURVEY INFORMATION AND REPRESENT FINISHED GROUND SURFACE FOLLOWING REGRADING OR RESHAPING.

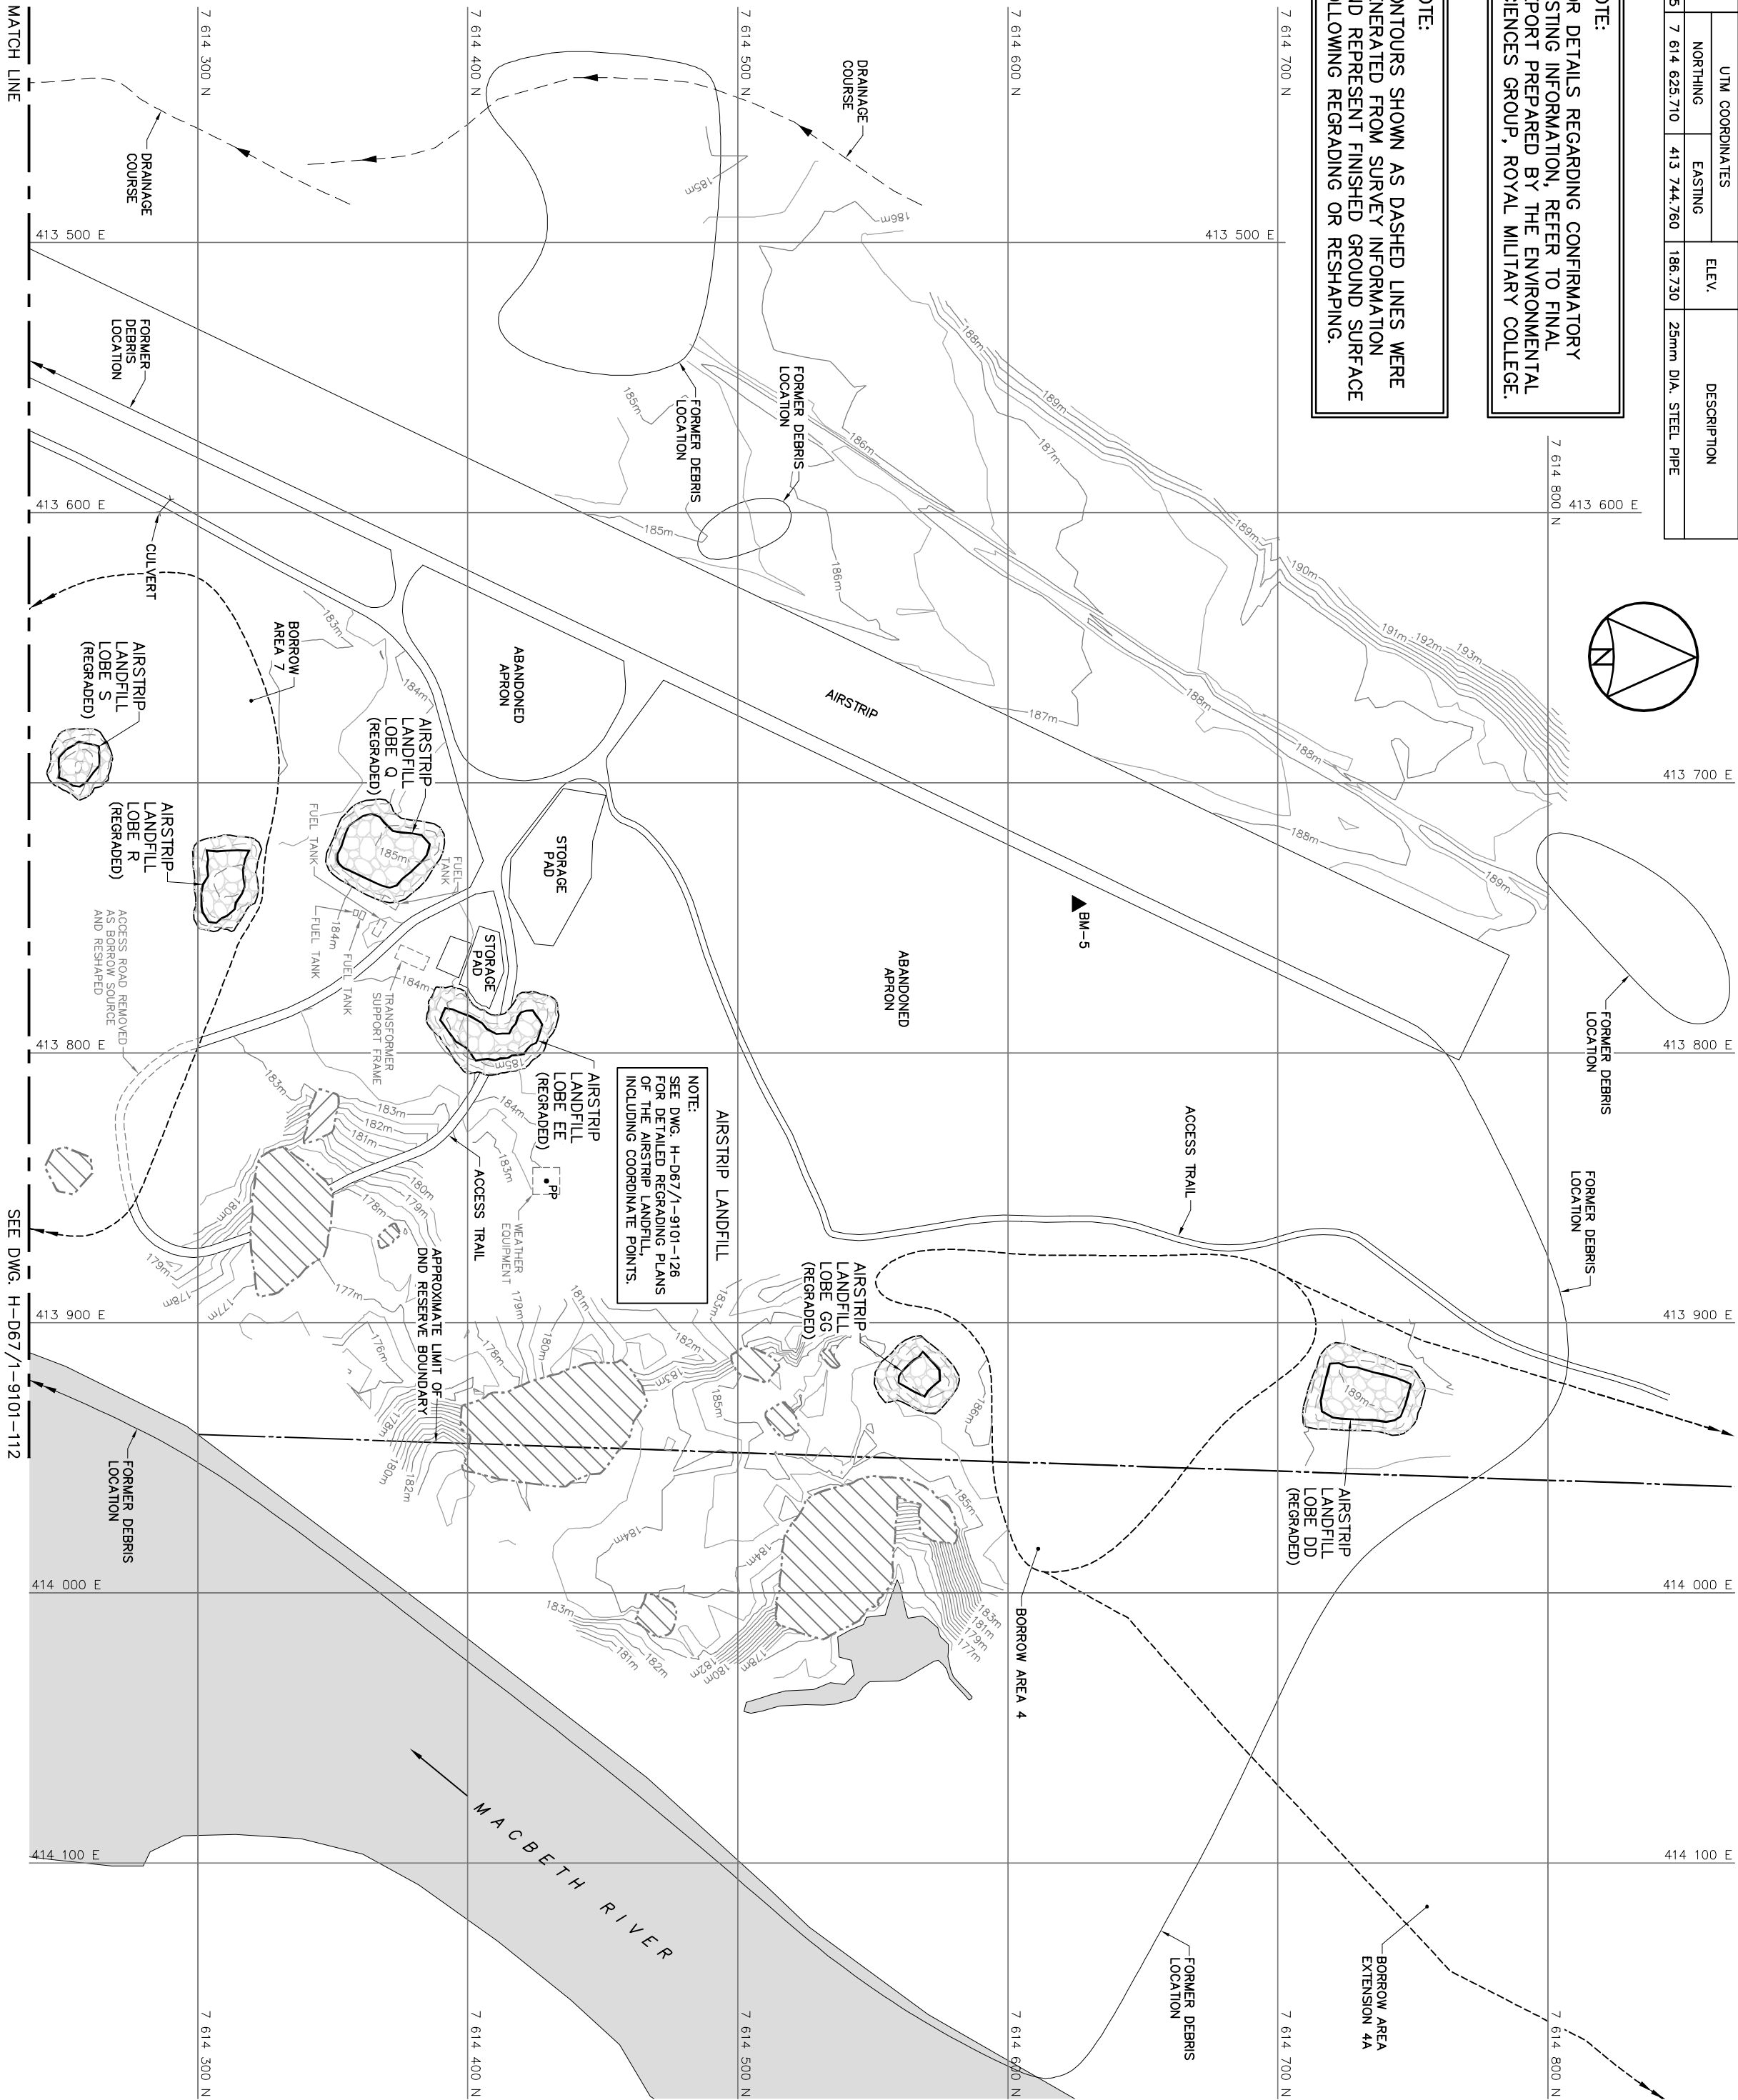

- General Notes:
1. ALL COORDINATES ARE REFERENCED TO NAD83 (GRS) UTM ZONE 18N. ALL ELEVATIONS REFER TO GEODETIC DATUM.
 2. ALL DIMENSIONS ARE IN METRES UNLESS NOTED OTHERWISE.
 3. FOR PERMANENT SURVEY CONTROL (BENCHMARK) INSTALLATION DETAIL, SEE DWG. H-067/1-9101-123.

- Legend:
- ▲ BW-5 PERMANENT BENCHMARK LOCATION (1)
 - PP UTILITY POLE
 - FORMER BUILDING, STRUCTURE OR TANK LOCATION
 - ▨ COMPLETED LANDFILL OR BURIED DEBRIS EXCAVATION
 - ☪ BODY OF WATER

0	12-00-22	AS-BUILT DRAWING	REV
No.	DATE	REVISION	APPR.

DRAFT

AECOM **HATCH**

SCALE - ESCHALE 20 10 0 20 40 60m

PROJECT - PROJET
FOX-3 DEVAR LAKES

DEW LINE CLEAN UP

© COPYRIGHT
HER MAJESTY THE QUEEN IN RIGHT OF
CANADA 2012, AS REPRESENTED BY THE
MINISTER OF NATIONAL DEFENCE.

TRADE - METER SITTING DATE 2007-08-24


AIRSTRIP AREA
SITE PLAN
SHEET 2

PRODUCTION		CONCURRENCE - ASSÉMBLEMENT	
DESIGNED	THE/DIM	DES. OFF.	
DRAWN	ONE	SECT. NO.	
CHECKED	ONE	CHEF. SECT.	
VERIFIED	ONE	DES. MGR.	
COORDINATION	ONE	DES. CONCEPT	
REVIEWED	REVU		

DWG. NO. - DESSIN NO.
H-067/1-9101-113


General Notes:

- ALL COORDINATES ARE REFERENCED TO NAD83 (GRS83). UTM ZONE 18N. ALL ELEVATIONS REFER TO GEODETIC DATUM.
- ALL DIMENSIONS ARE IN METRES UNLESS NOTED OTHERWISE.
- AS-BUILT SURVEY NOT SUBMITTED FOR FINAL SURFACE OF TYPE 2 GRANULAR FILL.

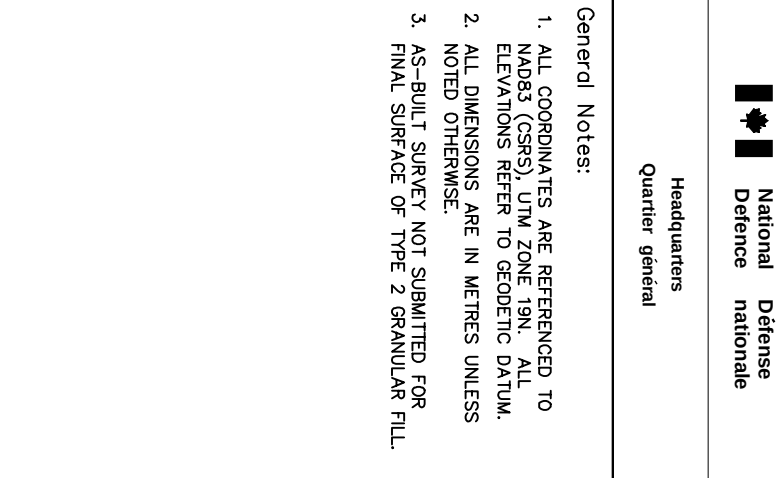

INUIT HOUSE PAD DEBRIS AREA (LOBE A) REGRADED (AS-BUILT)			
NO.	UTM COORDINATES		ELEV.
	NORTHING	EASTING	
240	7 616 705.8	409 223.3	505.7
241	7 616 708.3	409 228.5	506.1
242	7 616 704.4	409 232.6	506.4
243	7 616 689.0	409 239.3	504.7
244	7 616 671.9	409 235.3	502.7
245	7 616 670.7	409 224.8	502.3
246	7 616 671.8	409 220.0	502.0
247	7 616 677.9	409 211.1	502.3
248	7 616 695.7	409 215.2	504.6

WEST LANDFILL (LOBES A,B) REGRADED (AS-BUILT)			
NO.	UTM COORDINATES		ELEV.
	NORTHING	EASTING	
201	7 617 399.3	407 895.6	415.6
202	7 617 402.7	407 910.1	415.5
203	7 617 385.8	407 939.4	416.1
204	7 617 377.8	407 943.0	417.0
205	7 617 364.0	407 936.8	419.6
206	7 617 353.7	407 930.0	420.5
207	7 617 352.9	407 921.0	419.4
208	7 617 371.7	407 888.7	416.7
209	7 617 382.9	407 884.2	416.7

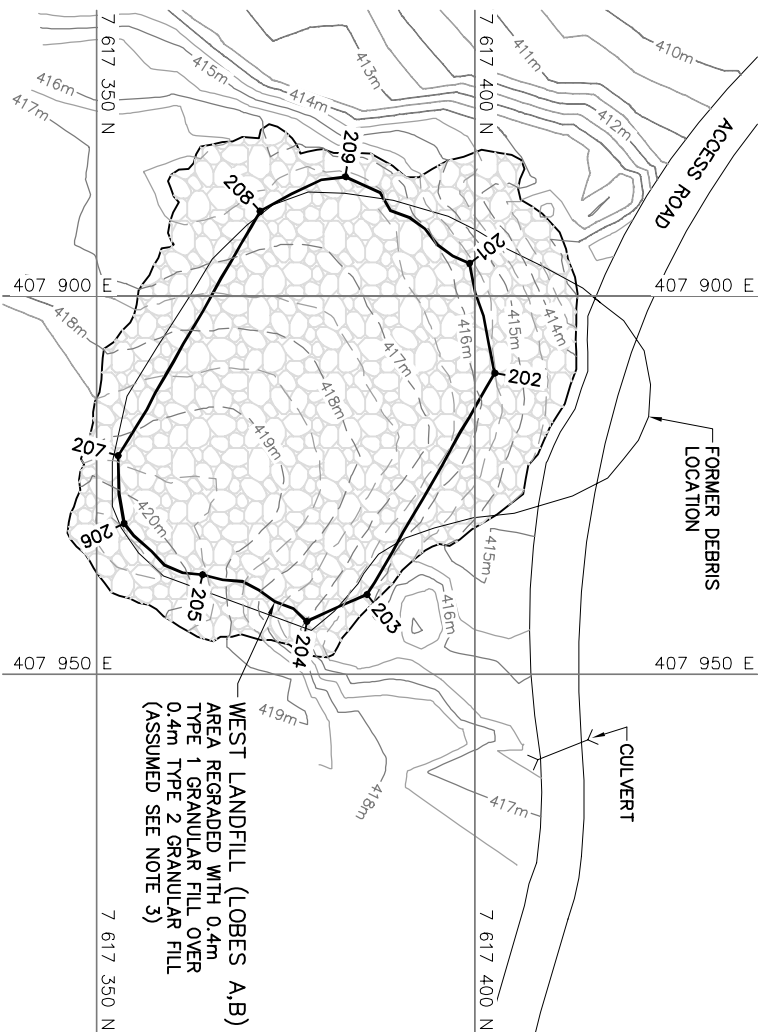

WEST LANDFILL (LOBES A,B)
(DWG. 102)


INUIT HOUSE PAD DEBRIS AREA (LOBE A)
(DWG. 107)

- Legend:**
-  **COORDINATE POINT**
 -  **COMPLETED LANDFILL OR BURIED DEBRIS EXCAVATION**

STATION WEST LANDFILL (LOBE F) REGRADED (AS-BUILT)			
NO.	UTM COORDINATES		ELEV.
	NORTHING	EASTING	
210	7 616 857.5	408 924.3	507.8
211	7 616 854.2	408 937.5	508.3
212	7 616 840.9	408 941.8	507.6
213	7 616 835.4	408 936.9	507.1
214	7 616 819.1	408 934.0	505.6
215	7 616 805.8	408 921.0	503.9
216	7 616 803.8	408 904.1	502.8
217	7 616 822.7	408 888.9	503.3
218	7 616 835.8	408 897.5	505.1
219	7 616 842.9	408 911.1	506.5

STATION WEST LANDFILL (LOBE I1) REGRADED (AS-BUILT)			
NO.	UTM COORDINATES		ELEV.
	NORTHING	EASTING	
220	7 616 899.0	409 052.0	514.8
221	7 616 890.9	409 061.7	514.7
222	7 616 873.4	409 064.4	513.9
223	7 616 868.1	409 058.6	513.7
224	7 616 874.8	409 042.9	514.0
225	7 616 887.5	409 043.0	514.4

STATION WEST LANDFILL (LOBES JK) REGRADED (AS-BUILT)			
NO.	UTM COORDINATES		ELEV.
	NORTHING	EASTING	
230	7 616 860.1	409 085.4	515.5
231	7 616 865.1	409 097.0	515.9
232	7 616 862.0	409 103.8	515.4
233	7 616 837.5	409 107.6	513.6
234	7 616 830.9	409 114.2	513.6
235	7 616 827.8	409 113.2	513.3
236	7 616 820.2	409 086.5	512.2
237	7 616 827.5	409 084.9	512.6
238	7 616 834.2	409 094.6	513.3
239	7 616 842.7	409 095.1	513.6

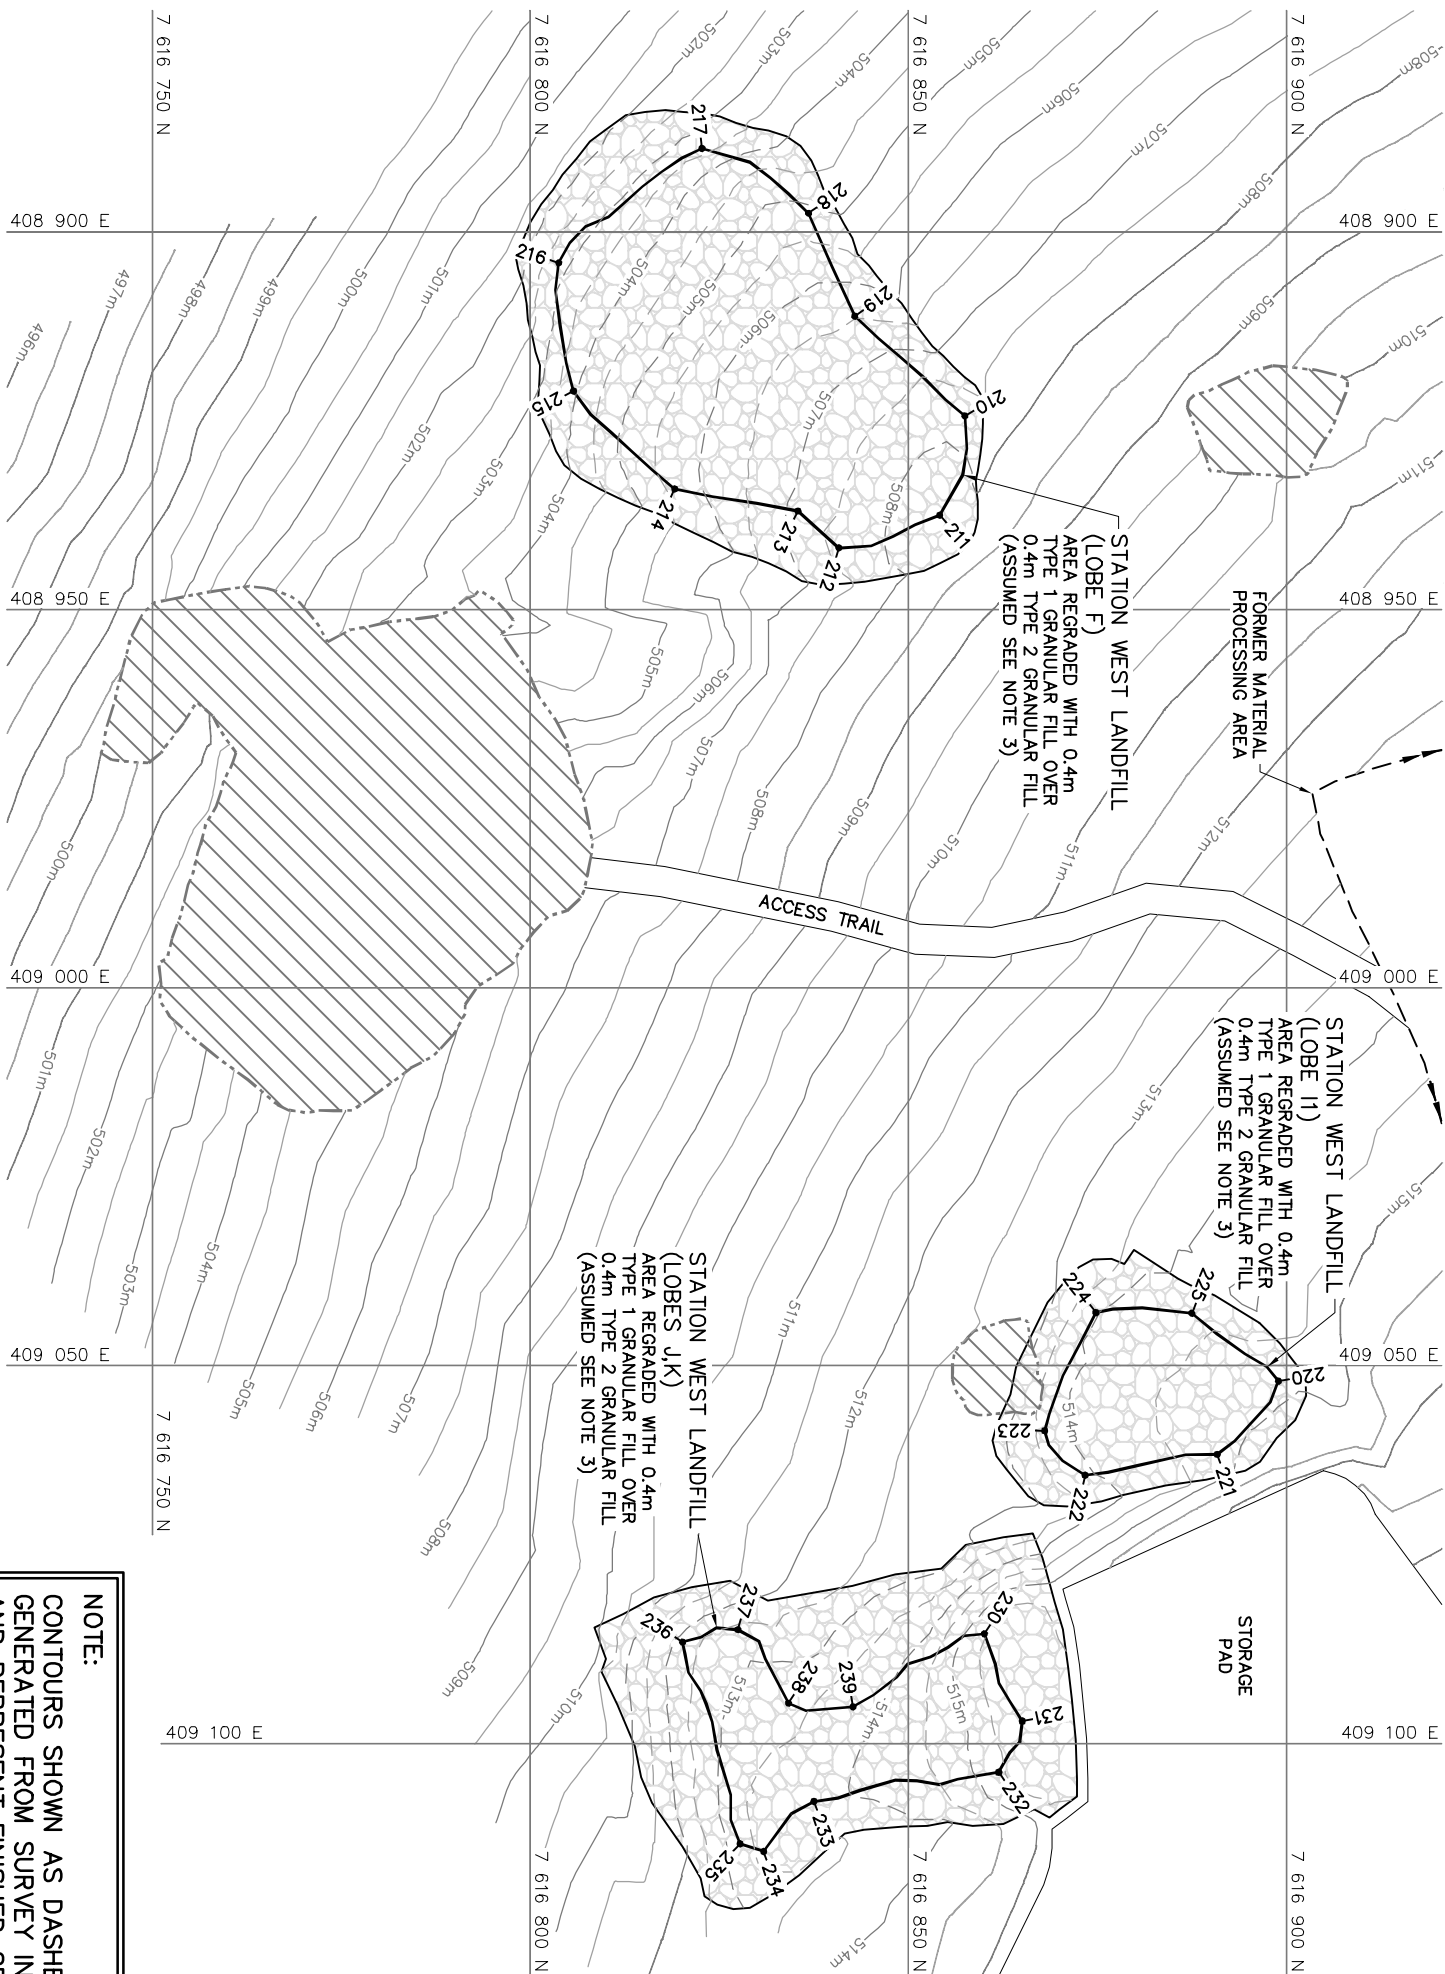

STATION WEST LANDFILL (LOBES F,I1,JK)
(DWG. 103)

NOTE:
CONTOURS SHOWN AS DASHED LINES WERE GENERATED FROM SURVEY INFORMATION AND REPRESENT FINISHED GROUND SURFACE FOLLOWING REGRAIDING OR RESHAPING.

NOTE:
FOR DETAILS REGARDING CONFIRMATORY TESTING INFORMATION, REFER TO FINAL REPORT PREPARED BY THE ENVIRONMENTAL SCIENCES GROUP, ROYAL MILITARY COLLEGE.

PRODUCTION		CONCURRENCE – ASSIGNMENT	
DESIGNED <i>ME/DM</i>	DES. OFF.	DES. OFF.	DES. OFF.
DRAWN <i>DM</i>	SECT. NO.	SECT. NO.	SECT. NO.
CHECKED <i>DM</i>	CHEF. SECT.	CHEF. SECT.	CHEF. SECT.
VERIFIED <i>DM</i>	DES. MGR.	DES. MGR.	DES. MGR.
COORDINATION <i>DM</i>	REVIEWED – REVU	REVIEWED – REVU	REVIEWED – REVU
DWG. NO. – DESIGN NO. H-0677/-9101-114		DATE 2007-08-24	

General Notes:

- ALL COORDINATES ARE REFERENCED TO NAD83 (GRS83) UTM ZONE 18N. ALL ELEVATIONS REFER TO GEODETIC DATUM.
- ALL DIMENSIONS ARE IN METRES UNLESS NOTED OTHERWISE.
- AS-BUILT SURVEY NOT SUBMITTED FOR FINAL SURFACE OF TYPE 2 GRANULAR FILL.

Legend:

- SURVEY CONTROL MONUMENT
- COMPLETED LANDFILL OR BURIED DEBRIS EXCAVATION

0	12-10-22	AS-BUILT DRAWING	<i>KAM</i>
No.	DATE	REVISION	APPROVAL

DRAFT

AECOM HATCH

SCALE - ÉCHELLE 10 5 0 10 20 30m

PROJECT - PROJET
FOX-3 DEVAR LAKES

DEW LINE CLEAN UP



© COPYRIGHT
HER MAJESTY THE QUEEN IN RIGHT OF
CANADA 2012, AS REPRESENTED BY THE
MINISTER OF NATIONAL DEFENCE.

TRADE - MÉTIER
SHEET - FEUILLE
DATE 2007-08-24

STATION AREA
REGRAIDING DETAILS
SHEET 2

PRODUCTION	CONCURRENCE - ASSÉMBLEMENT
DESIGNED <i>ME/DJM</i>	DES. DRT.
DRAWN <i>CM</i>	AGENT CONCEPT
CHECKED <i>KAM</i>	CHÉF DRT.
VERIFIED <i>KAM</i>	DÉS. MGR.
COORDINATION <i>SMS</i>	GEST. CONCEPT
DWG. NO. - DESSIN NO. H--D677/J--9101-115	REVIEWED - REVU

Canada

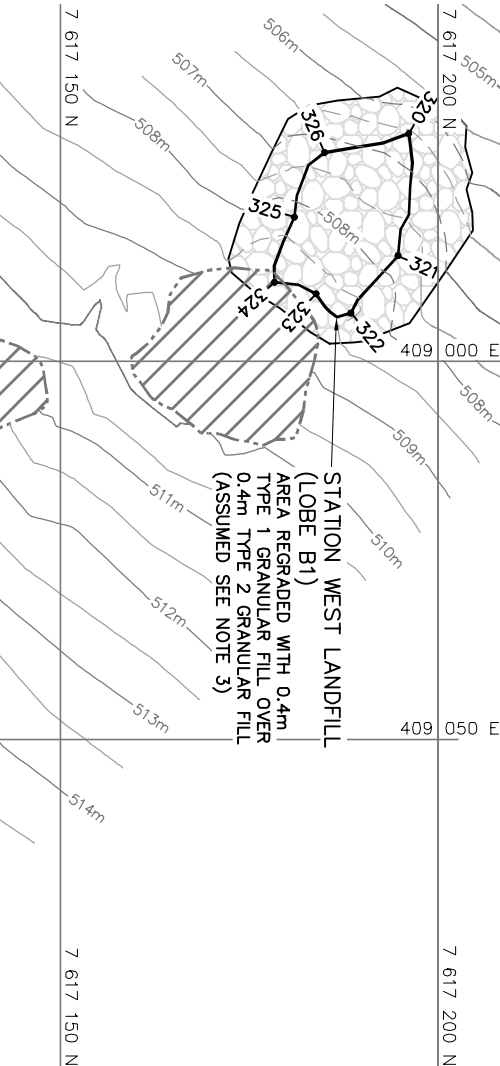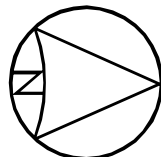


STATION WEST LANDFILL (LOBE A) REGRADED (AS-BUILT)			
UTM COORDINATES		ELEV.	
NO.	NORTHING	EASTING	ELEV.
301	7 617 100.2	409 009.9	513.9
302	7 617 107.5	409 033.5	514.7
303	7 617 111.3	409 053.0	515.6
304	7 617 080.3	409 070.3	517.2
305	7 617 072.2	409 058.2	517.7
306	7 617 029.8	409 019.9	516.8
307	7 616 984.1	408 963.8	514.5
308	7 616 990.4	408 952.6	514.0
309	7 617 007.3	408 948.8	513.5
310	7 617 031.2	408 952.0	513.6
311	7 617 054.1	408 965.7	515.1
312	7 617 061.9	408 973.3	515.0
313	7 617 079.3	408 997.0	515.5

SURVEY CONTROL MONUMENTS			
NO.	UTM COORDINATES		DESCRIPTION
	NORTHING	EASTING	
CM1	7 616 981.903	408 942.460	FOX-3 BASELINE STA. 0+00
CM2	7 617 076.152	409 081.577	FOX-3 BASELINE STA. 5+51.73

NOTE:
CONTOURS SHOWN AS DASHED LINES WERE
GENERATED FROM SURVEY INFORMATION
AND REPRESENT FINISHED GROUND SURFACE
FOLLOWING REGRAIDING OR RESHAPING.

NOTE:
FOR DETAILS REGARDING CONFIRMATORY
TESTING INFORMATION, REFER TO FINAL
REPORT PREPARED BY THE ENVIRONMENTAL
SCIENCES GROUP, ROYAL MILITARY COLLEGE.

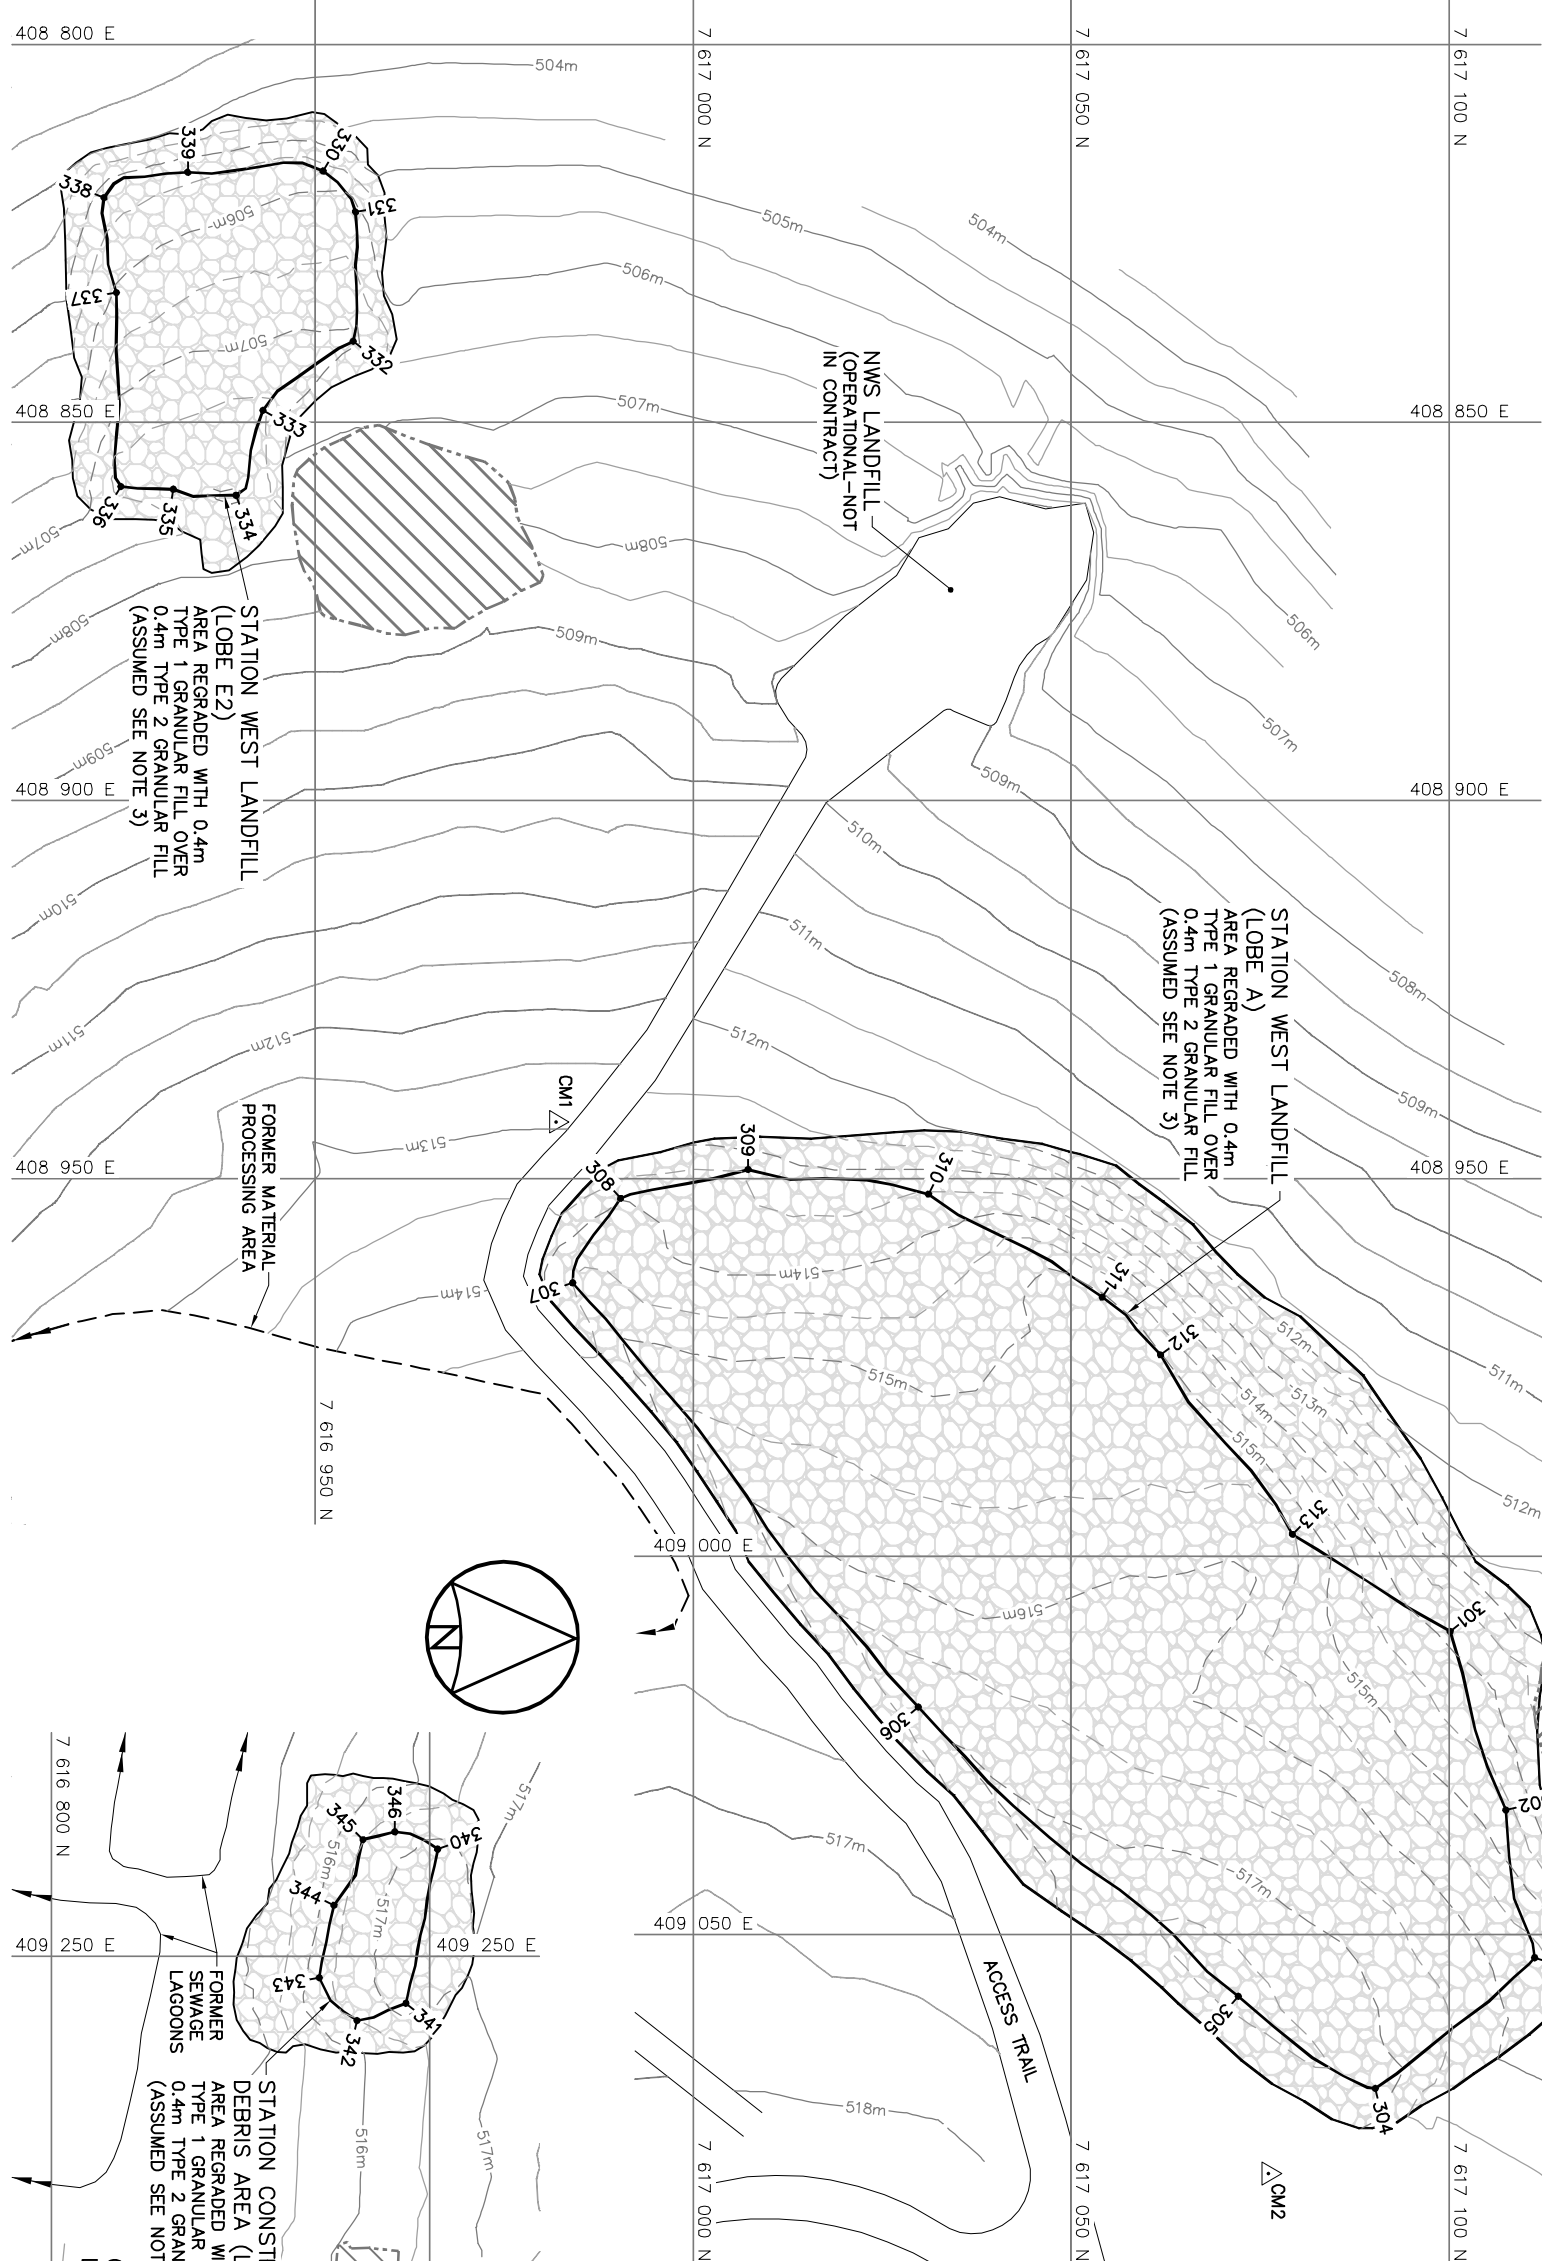

STATION WEST LANDFILL (LOBE B1) REGRADED (AS-BUILT)			
UTM COORDINATES		ELEV.	
NO.	NORTHING	EASTING	ELEV.
320	7 617 196.1	408 969.8	506.6
321	7 617 194.8	408 986.0	507.8
322	7 617 188.5	408 993.6	508.6
323	7 617 183.9	408 991.0	508.7
324	7 617 178.4	408 989.5	508.9
325	7 617 181.0	408 980.9	508.2
326	7 617 185.0	408 972.3	507.3




STATION WEST LANDFILL (LOBE E2) REGRADED (AS-BUILT)			
UTM COORDINATES		ELEV.	
NO.	NORTHING	EASTING	ELEV.
330	7 616 951.1	408 816.7	505.7
331	7 616 955.4	408 822.1	506.1
332	7 616 955.1	408 839.2	507.1
333	7 616 943.1	408 848.4	507.6
334	7 616 939.6	408 859.6	508.0
335	7 616 931.3	408 858.8	508.0
336	7 616 924.4	408 858.4	507.7
337	7 616 923.8	408 832.8	506.1
338	7 616 922.1	408 820.2	505.2
339	7 616 933.2	408 816.9	505.3

STATION CONSTRUCTION CAMP DEBRIS AREA (LOBES A,B) REGRADED (AS-BUILT)			
UTM COORDINATES		ELEV.	
NO.	NORTHING	EASTING	ELEV.
340	7 616 851.1	409 235.8	517.2
341	7 616 846.9	409 256.2	517.2
342	7 616 840.4	409 256.5	516.3
343	7 616 835.5	409 252.8	516.3
344	7 616 837.4	409 243.2	516.3
345	7 616 841.2	409 234.5	516.5
346	7 616 845.4	409 233.5	516.7

STATION CONSTRUCTION CAMP DEBRIS AREA (LOBES A,B)
(DWG. 107)

STATION WEST LANDFILL (LOBES A,B1,E2)
(DWG. 105)

- General Notes:
- ALL COORDINATES ARE REFERENCED TO NAD83 (CSRS) UTM ZONE 19N. ALL ELEVATIONS REFER TO GEODETIC DATUM.
 - ALL DIMENSIONS ARE IN METRES UNLESS NOTED OTHERWISE.

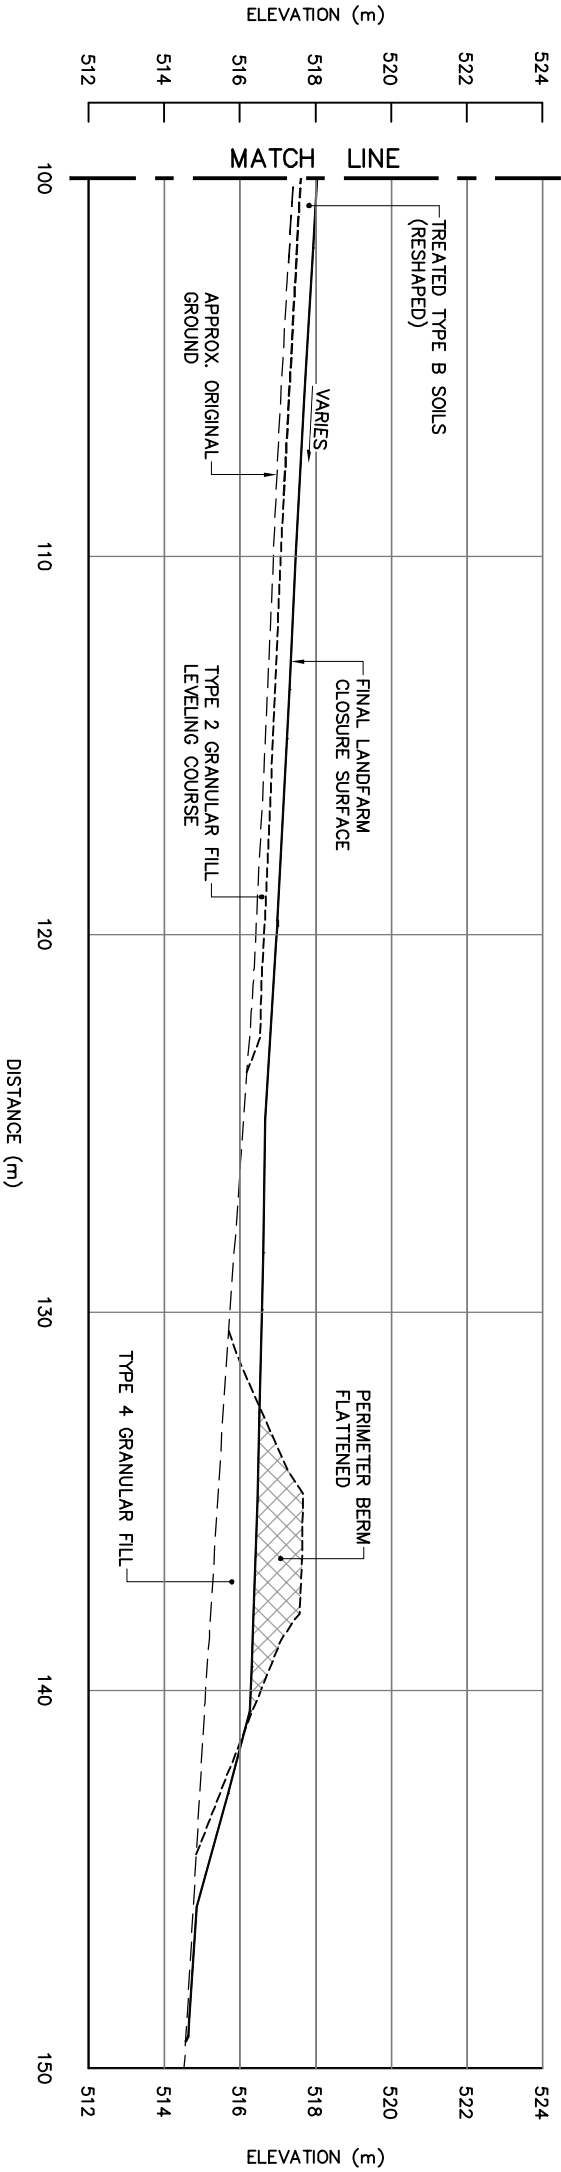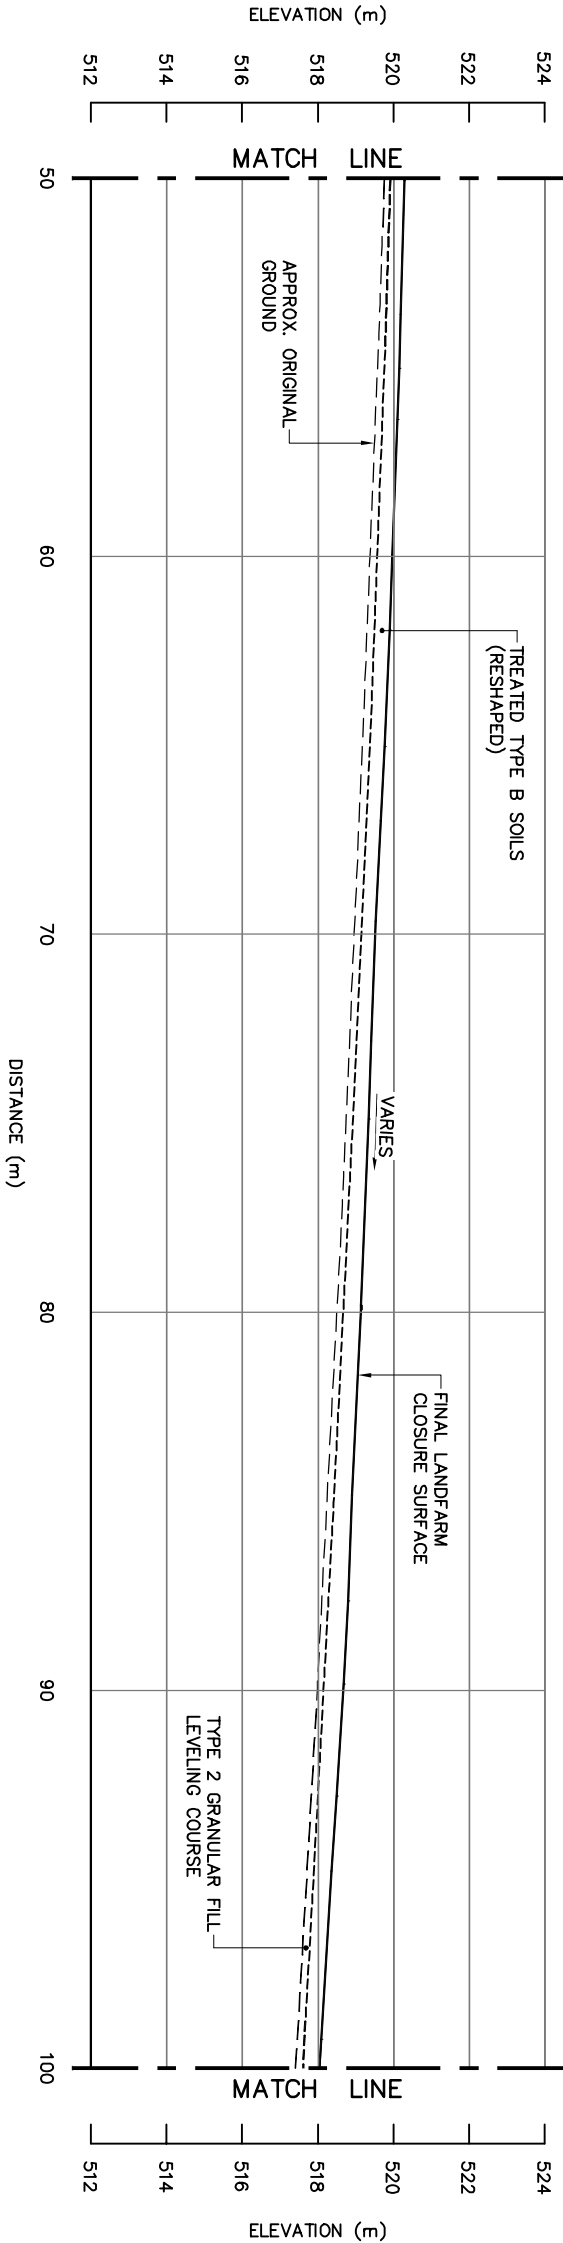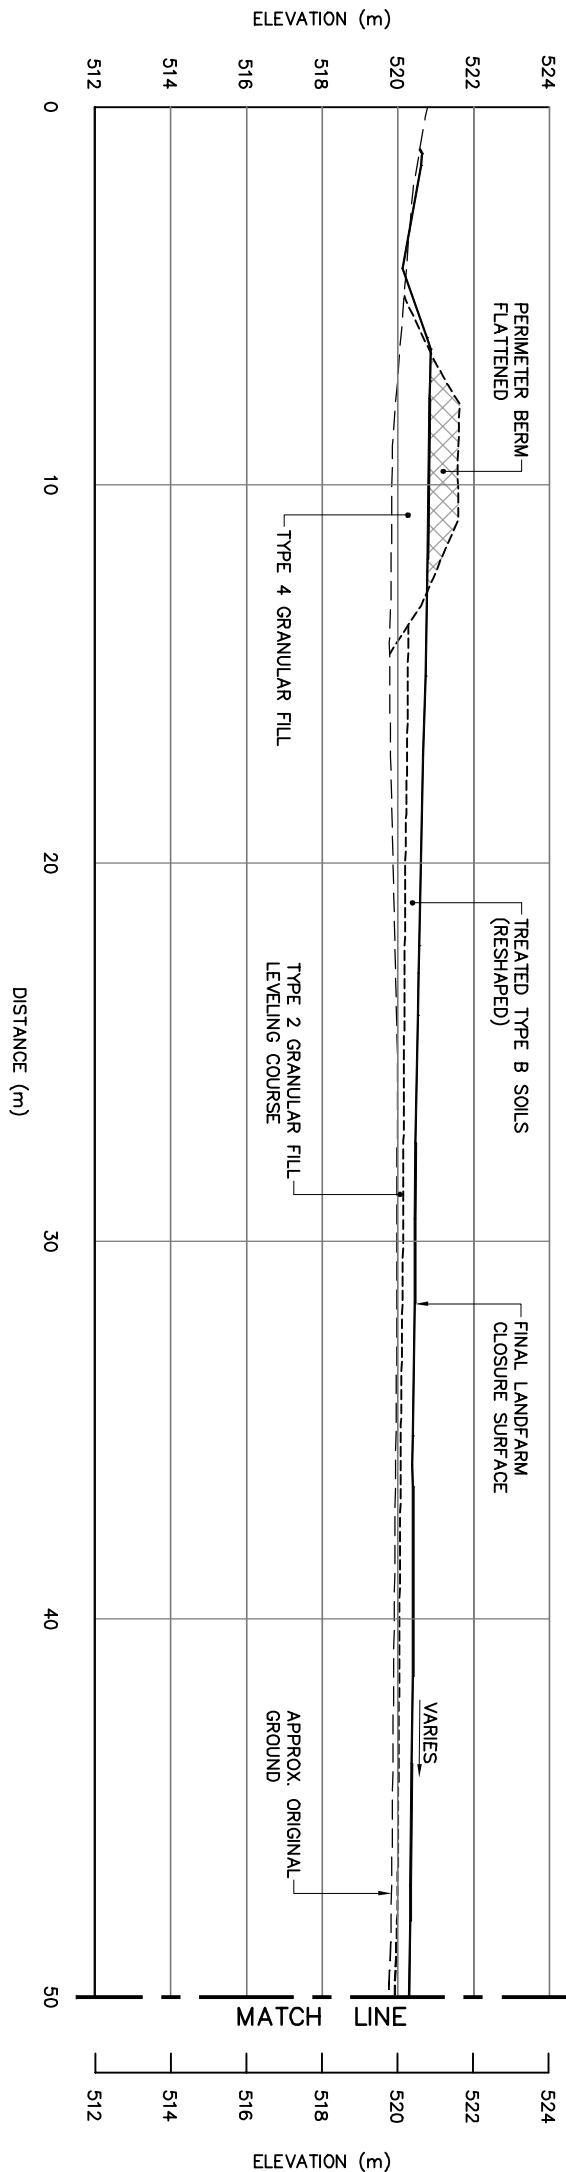

SECTION
A
107

Legend:

————— GENERATED BASED ON FINAL
AS—BUILT SURVEY INFORMATION

----- GENERATED BASED ON INTERMEDIATE
AS—BUILT SURVEY INFORMATION

No.	DATE	REVISION	REVISION	APPR.
0	12-10-21	AS—BUILT DRAWING		KAM

DRAFT

AECOM HATCH

SCALE — ECHELLE 2 1 0 2 4 6m

PROJECT — PROJET
FOX-3 DEWAR LAKES

DEW LINE CLEAN UP

© COPYRIGHT
HER MAJESTY THE QUEEN IN RIGHT OF
CANADA 2012, AS REPRESENTED BY THE
MINISTER OF NATIONAL DEFENCE.

TRADE — MÉTIER	SITING	DATE
SUBJECT — SUJET		2007-08-24

LANDFARM CLOSURE
CROSS SECTION

PRODUCTION	CONCURRENCE — ASSÉNIEMENT
DESIGNED — <i>HE/DIM</i>	DES. OFF.
ETUDE — <i>HE/DIM</i>	AGENCY CONCEPT
DRAWN — <i>CM</i>	SECT. NO.
DRESSING — <i>CM</i>	CHEF. SECT.
CHECKED — <i>KAM</i>	DES. MGR.
VERIFIED — <i>KAM</i>	TEST CONCEPT
COORDINATION — <i>SMS</i>	REVIEWED — REVU
DWG. NO. — DESIGN NO. H--D677/J--9101-117	

- General Notes:
1. ALL COORDINATES ARE REFERENCED TO NAD83 (GRS), UTM ZONE 19N. ALL ELEVATIONS REFER TO GEODETIC DATUM.
 2. ALL DIMENSIONS ARE IN METRES UNLESS NOTED OTHERWISE.
 3. FOR MONITORING WELL INSTALLATION DETAILS, SEE DWG. H-D67/1-9101-129.

- Legend:
- 401 COORDINATE POINT
 - MW-06 MONITORING WELL LOCATION (3)
 - MW-05 BACKGROUND MONITORING WELL LOCATION (1)

0	12-01-22	AS-BUILT DRAWING	RAM
No.	DATE	REVISION	APPR.

DRAFT

AECOM HATCH

SCALE - ÉCHELLE 10 5 0 10 20 30m

PROJECT - PROJET
FOX-3 DEVAR LAKES

DEW LINE CLEAN UP


© COPYRIGHT
HER MAJESTY THE QUEEN IN RIGHT OF
CANADA 2012, AS REPRESENTED BY THE
MINISTER OF NATIONAL DEFENCE.

TRADE - MÉTIER SITTING DATE 2007-08-24

NON-HAZARDOUS WASTE LANDFILL
BERM CONSTRUCTION AND
FINAL GRADING PLANS

PRODUCTION	CONCURRENCE - ASSESSMENT
DESIGNED <i>HME/JHM</i>	DES. OFF.
DRAWN <i>CM</i>	AGENT CONCEPT
DRAWN <i>CM</i>	SECT. NO.
CHECKED <i>RAM</i>	CHEF. SECT.
VERIFIED <i>RAM</i>	DES. MGR.
COORDINATION <i>SMS</i>	GEST. CONCEPT
	REVIEWED - REVU
	DWG. NO. - DESSIN NO. H-D67/1-9101-118

Canada

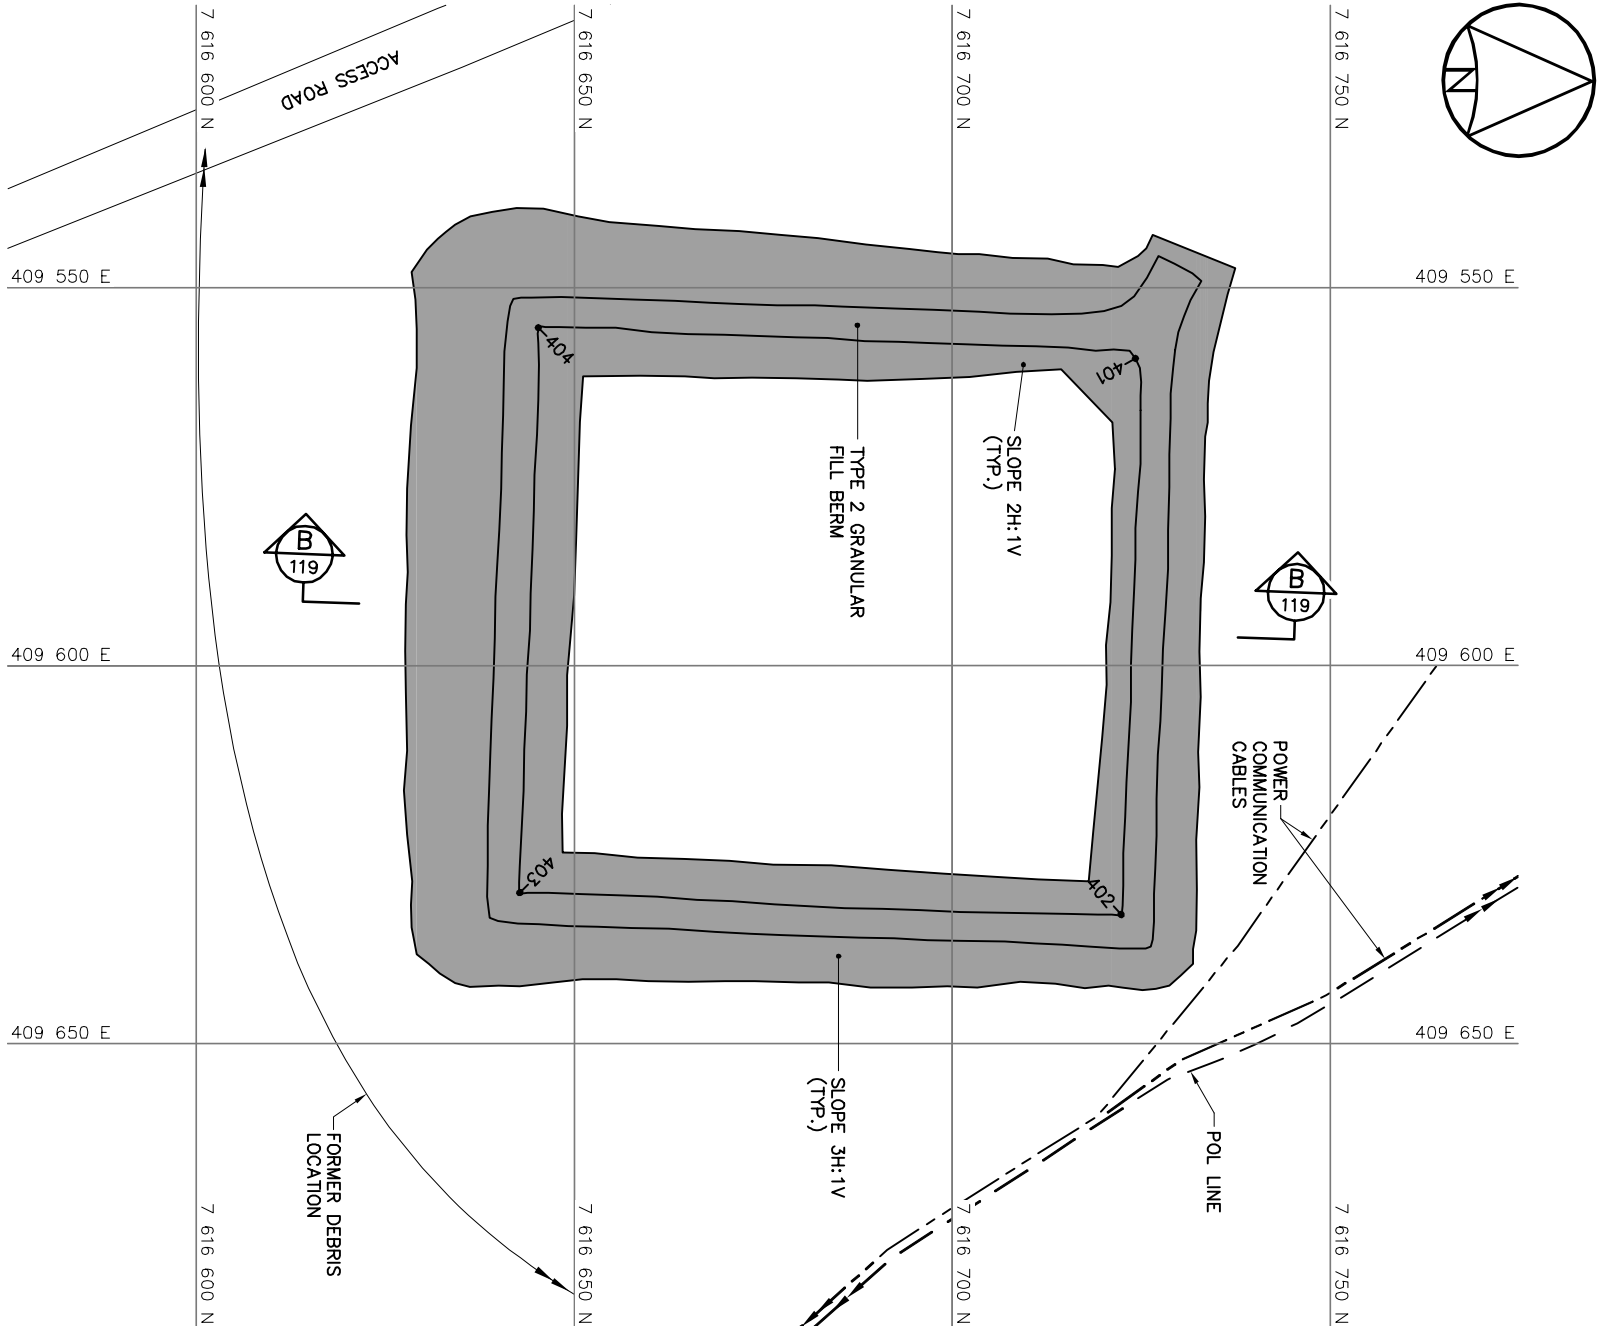


BERM CONSTRUCTION PLAN

NON-HAZARDOUS WASTE LANDFILL BERM CONSTRUCTION (AS-BUILT)			
NO.	UTM COORDINATES		ELEV.
	NORTHING	EASTING	
401	7 616 724.2	409 559.4	510.5
402	7 616 722.4	409 632.9	510.5
403	7 616 642.9	409 630.0	507.4
404	7 616 645.3	409 555.3	507.4

NOTE:
FOR DETAILS REGARDING CONFIRMATORY
TESTING INFORMATION, REFER TO FINAL
REPORT PREPARED BY THE ENVIRONMENTAL
SCIENCES GROUP, ROYAL MILITARY COLLEGE.

NOTE:
CONTOURS SHOWN AS DASHED LINES WERE
GENERATED FROM SURVEY INFORMATION
AND REPRESENT FINISHED GROUND SURFACE
FOLLOWING REGRAIDING OR RESHAPING.

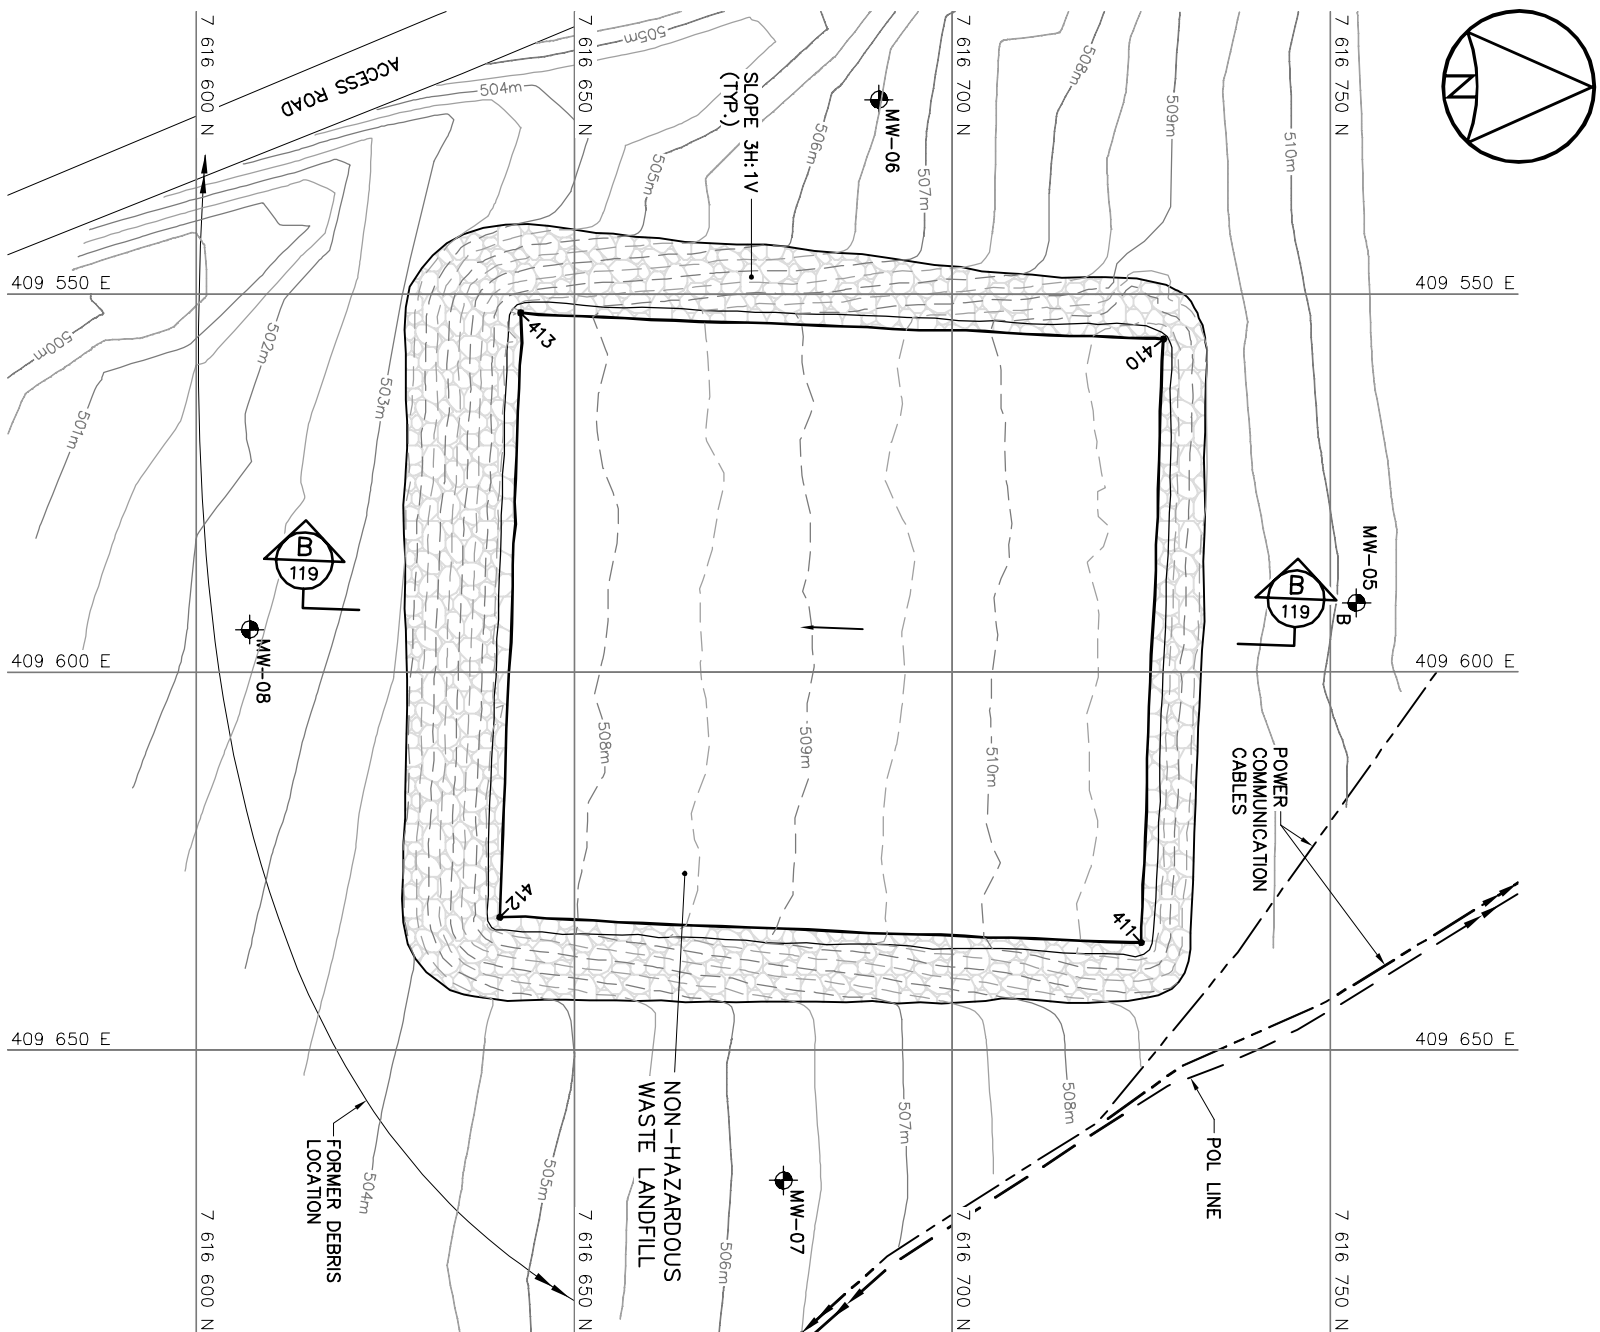


FINAL GRADING/INSTRUMENTATION PLAN

NON-HAZARDOUS WASTE LANDFILL FINAL GRADING (AS-BUILT)			
NO.	UTM COORDINATES		ELEV.
	NORTHING	EASTING	
410	7 616 728.0	409 555.9	510.7
411	7 616 725.0	409 635.7	510.9
412	7 616 643.0	409 632.4	507.6
413	7 616 643.0	409 552.5	507.5



NON-HAZARDOUS WASTE LANDFILL MONITORING WELLS (AS-BUILT)			
NO.	UTM COORDINATES		ELEV.
	NORTHING	EASTING	
MW-05	7 616 753.5	409 590.8	510.0
MW-06	7 616 690.3	409 524.3	506.7
MW-07	7 616 677.7	409 667.2	506.4
MW-08	7 616 607.1	409 594.3	502.5

NOTE:
COORDINATE POINTS AND ELEVATIONS PROVIDED ARE
TO THE FINAL GRADE OF TYPE 2 GRANULAR FILL
PRIOR TO PLACEMENT OF TYPE 1 GRANULAR FILL
ON SIDE SLOPES.

- General Notes:
- ALL COORDINATES ARE REFERENCED TO NAD83 (GSR8). UTM ZONE 19N. ALL ELEVATIONS REFER TO GEODETIC DATUM.
 - ALL DIMENSIONS ARE IN METRES UNLESS NOTED OTHERWISE.

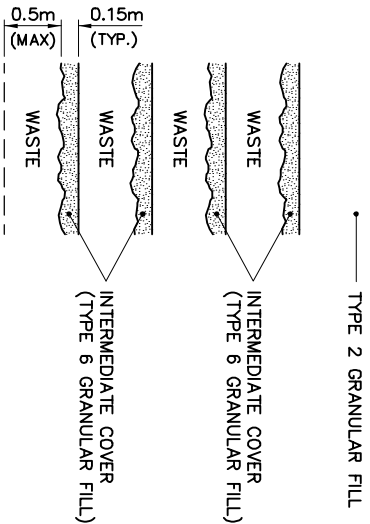

WASTE PLACEMENT DETAIL
SCALE: NTS

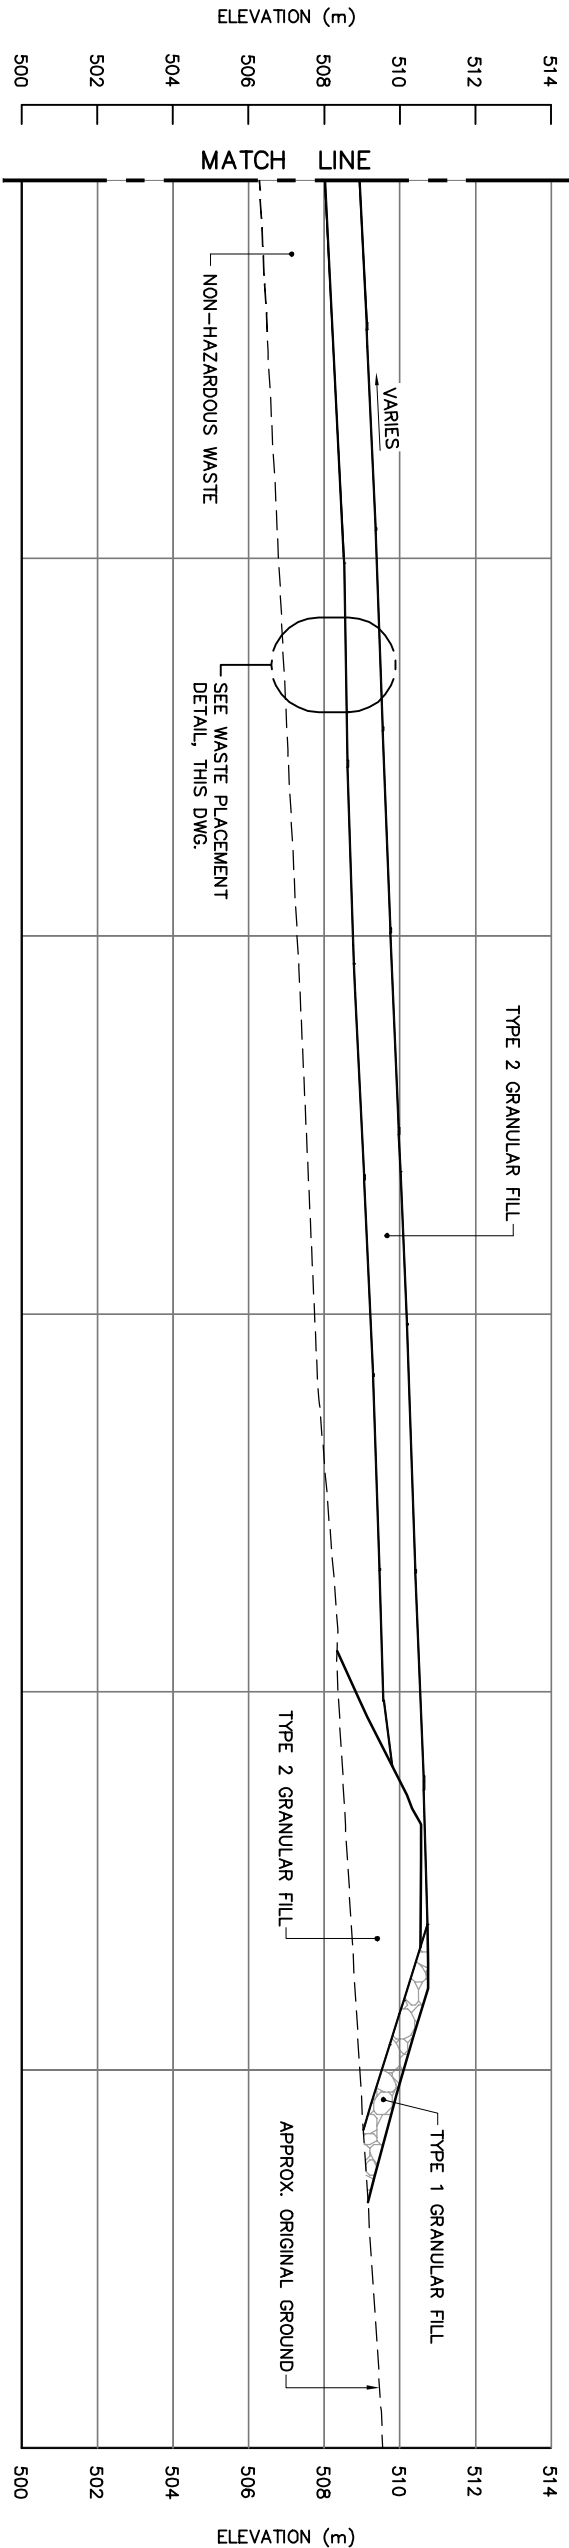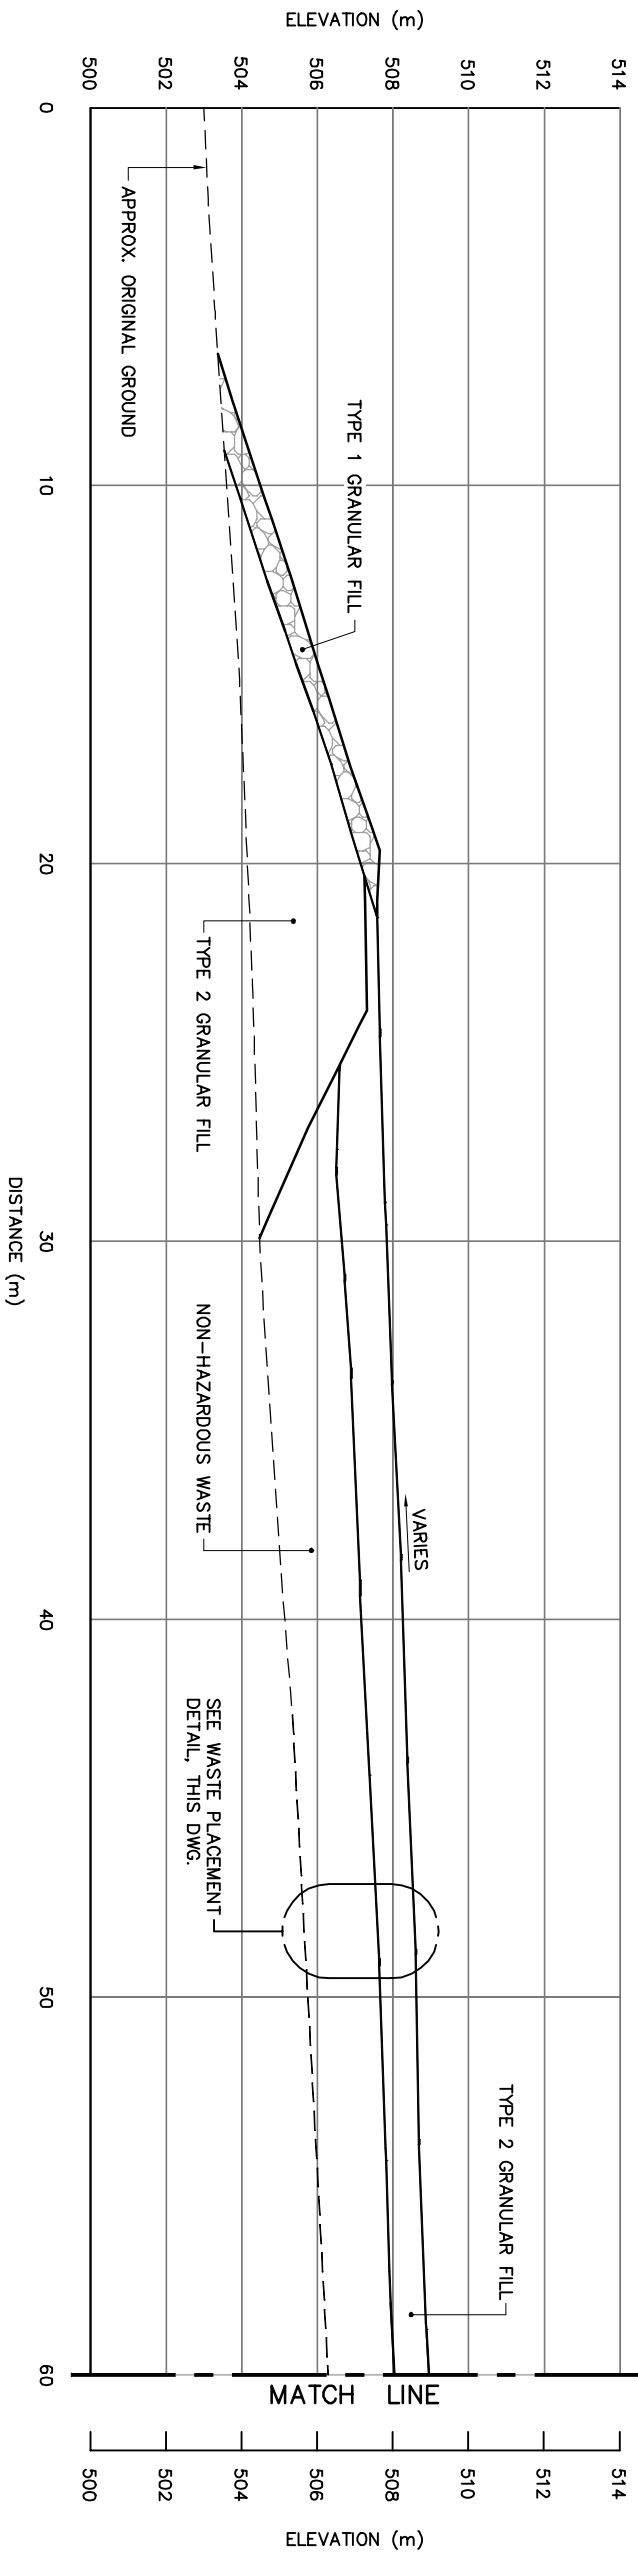

SECTION B
118

Legend:
GENERATED BASED ON AS-BUILT
SURVEY INFORMATION

0	12-10-22	AS-BUILT DRAWING	RAM
No.	DATE	REVISION	REVISION

DRAFT

AECOM HATCH

SCALE - ÉCHELLE 2 1 0 2 4 6m

PROJECT - PROJET
FOX-3 DEWAR LAKES

DEW LINE CLEAN UP

© COPYRIGHT
HER MAJESTY THE QUEEN IN RIGHT OF
CANADA 2012, AS REPRESENTED BY THE
MINISTER OF NATIONAL DEFENCE

TRADE - MÉTIER	SITING	DATE
SUBJECT - SUJET		2007-08-20

NON-HAZARDOUS WASTE LANDFILL
CROSS SECTION

PRODUCTION	CONCURRENCE - ASSÉMBLEMENT
DESIGNED - <i>HE/DJM</i>	DES. OFT.
ETUDE	AGENT CONCEPT
DRAWN - <i>CM</i>	SECT. NO.
DRESSING	CHEF SECT.
CHECKED - <i>RAM</i>	DES. MGR.
VERIFIE	GEST. CONCEPT
COORDINATION	REVIEWED - REVU
<i>SMS</i>	

DWG. NO. - DESSIN NO.
H--D677/J--910T-119

Canada

General Notes:

1. ALL COORDINATES ARE REFERENCED TO NAD83 (CGRS). UTM ZONE 19N. ALL ELEVATIONS REFER TO GEODETIC DATUM.
2. ALL DIMENSIONS ARE IN METRES UNLESS NOTED OTHERWISE.
3. KEY TRENCH WAS EXCAVATED TO SATURATED SOUND BEDROCK. EXCAVATION DEPTH WAS FIELD CONFIRMED BY THE SITE ENGINEER.
4. FOR MONITORING WELL INSTALLATION DETAILS, SEE DWG. H-067/1-9101-129.
5. FOR GROUND TEMPERATURE CABLE INSTALLATION DETAIL, SEE DWG. H-067/1-9101-129.
6. 150mm DRAINAGE PIPE FOR DE-WATERING DURING CONSTRUCTION, CUT OFF AT TOP AND FILL THE GRANULAR FILL BERM AND FILLED WITH SAND.

Legend:

- Legend:
- S01 COORDINATE POINT
 - MW-02 MONITORING WELL LOCATION (3)
 - MW-01 BACKGROUND MONITORING WELL LOCATION (1)
 - VT-1 GROUND TEMPERATURE CABLE LOCATION (4)

0	12-01-21	AS-BUILT DRAWING	RAM
No.	DATE	REVISION	APPR.

DRAFT

AECOM HATCH

SCALE - ECHELLE 10 5 0 10 20 30m
PROJECT - PROJECT
FOX-3 DEVAR LAKES


DEW LINE CLEAN UP
© COPYRIGHT
HER MAJESTY THE QUEEN IN RIGHT OF
CANADA 2012, AS REPRESENTED BY THE
MINISTER OF NATIONAL DEFENCE

TRADE - METER SITTING DATE 2007-08-24
SUBJECT - SUEIT

TIER II DISPOSAL FACILITY
KEY TRENCH EXCAVATION PLAN &
GRADING/INSTRUMENTATION PLAN


PRODUCTION	CONCURRENCE - ASSÉNTIMENT
DESIGNED <i>HME/JIM</i>	DES. OFF. AGENT CONCEPT
DRAWN <i>DAE</i>	SECT. NO. CHÉF SECT.
CHECKED <i>RAM</i>	DES. MGR. GÉST. CONCEPT
COORDINATION <i>SMS</i>	REVIEWED - REVU
DWG. NO. - DESSIN NO. H-067/1-9101-120	

Canada

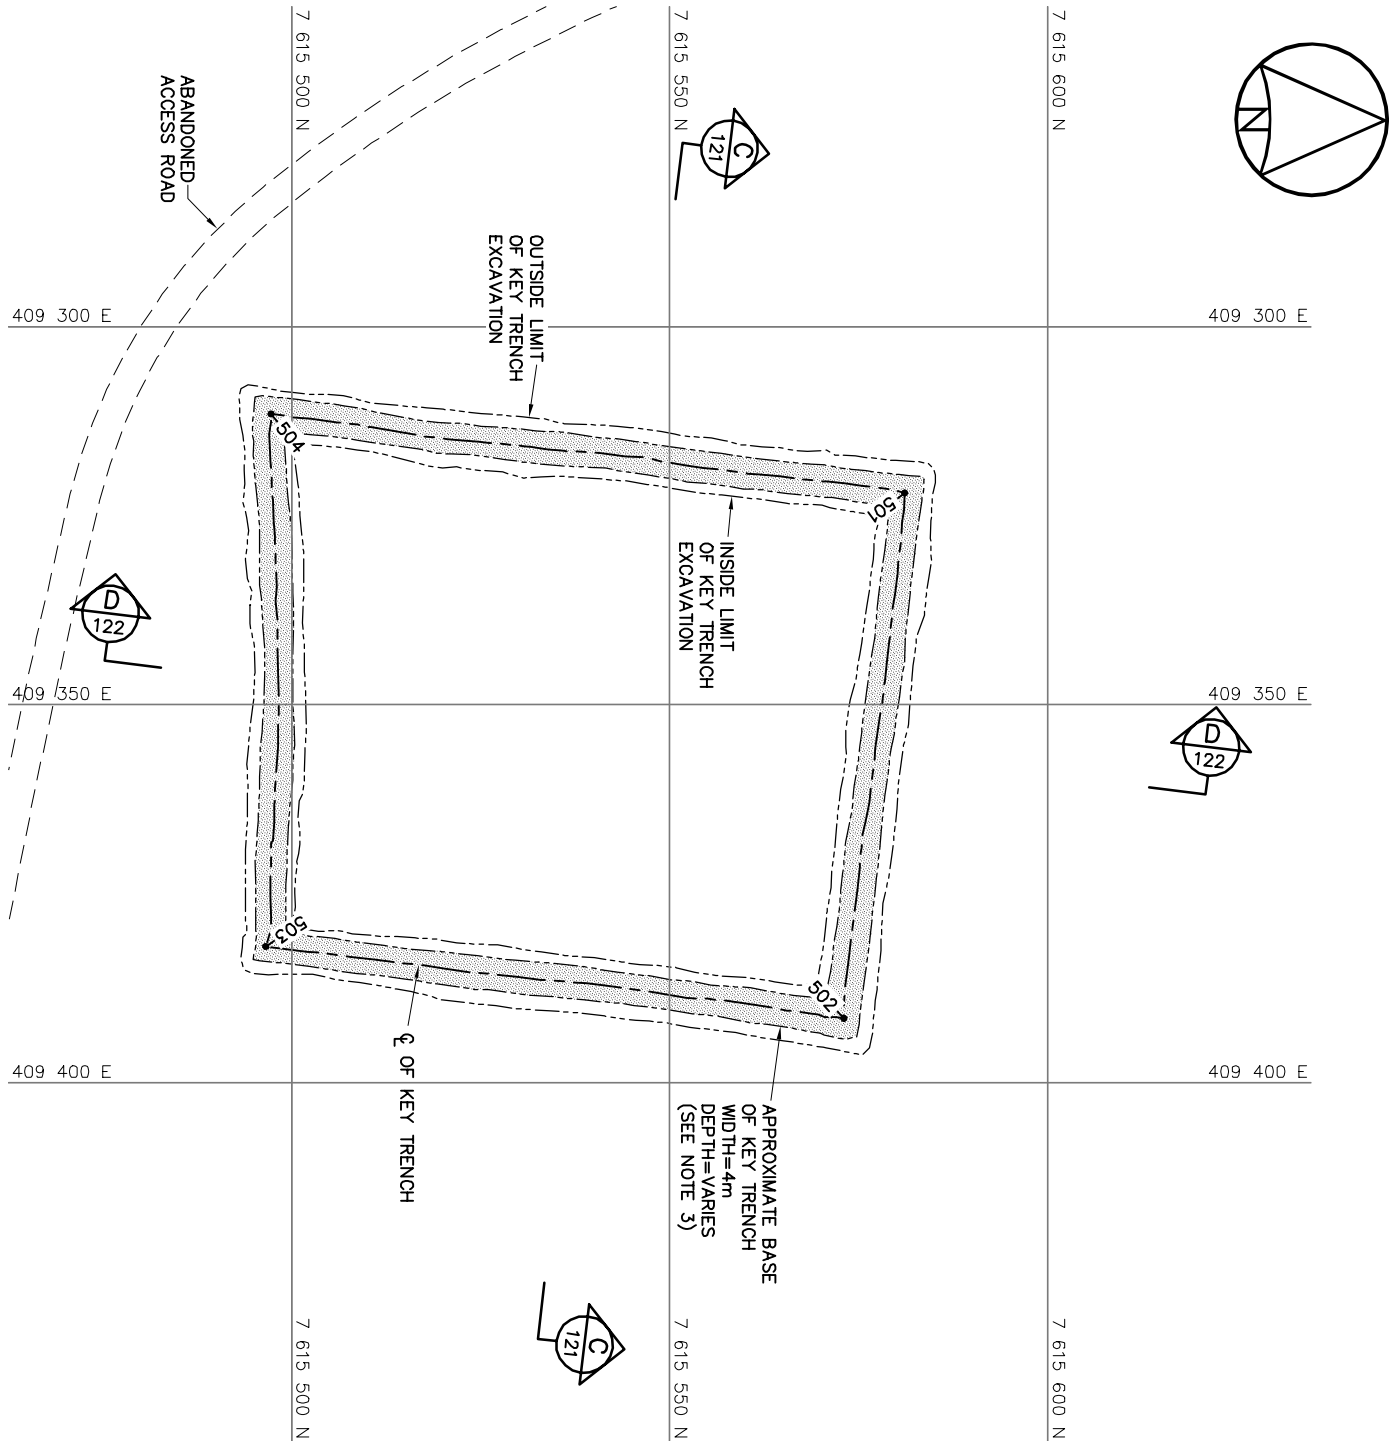

KEY TRENCH EXCAVATION PLAN

TIER II DISPOSAL FACILITY KEY TRENCH EXCAVATION (AS-BUILT)			
NO.	UTM COORDINATES		ELEV.
	NORTHING	EASTING	
501	7 615 581.2	409 322.0	416.0
502	7 615 573.1	409 391.4	415.3
503	7 615 496.6	409 381.9	415.9
504	7 615 497.3	409 311.5	416.0

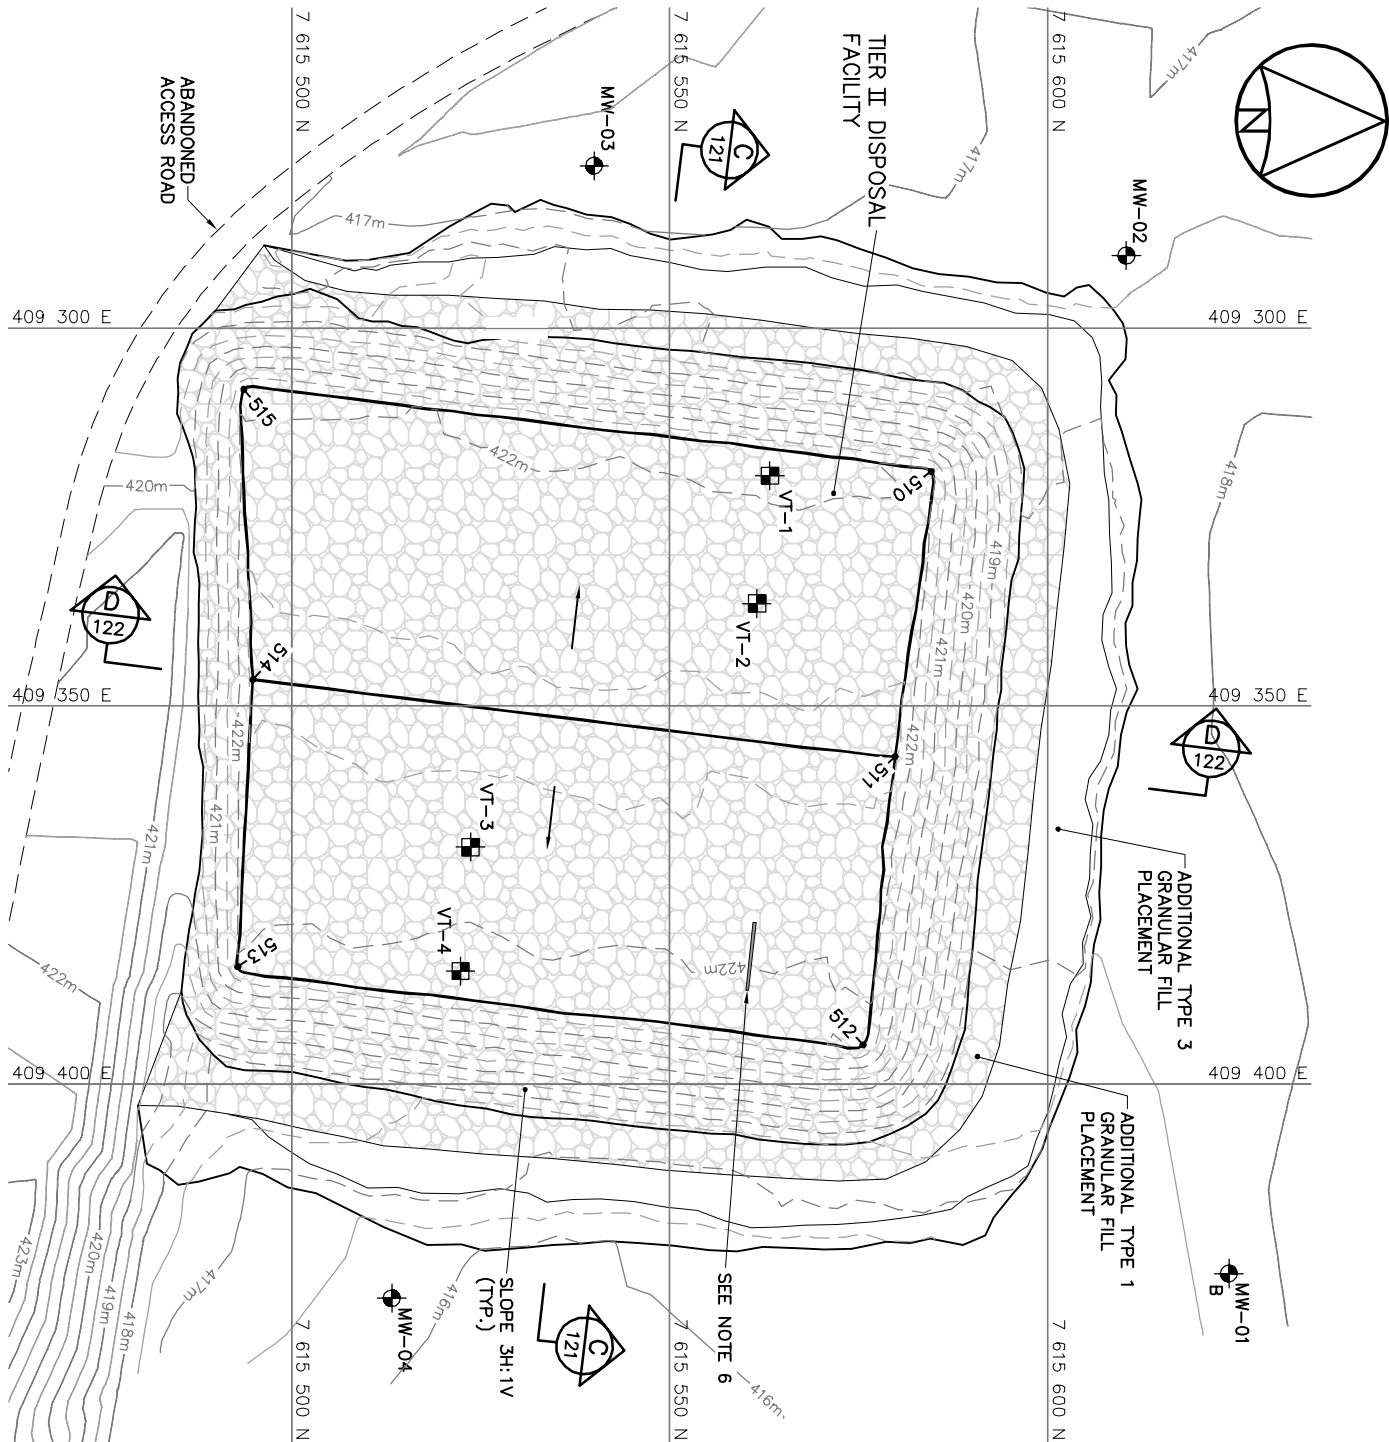

FINAL GRADING/INSTRUMENTATION PLAN

TIER II DISPOSAL FACILITY FINAL GRADING (AS-BUILT)			
NO.	UTM COORDINATES		ELEV.
	NORTHING	EASTING	
510	7 615 584.6	409 318.9	422.0
511	7 615 579.8	409 386.7	422.6
512	7 615 575.6	409 394.8	422.0
513	7 615 492.9	409 384.4	422.0
514	7 615 495.0	409 346.4	422.6
515	7 615 493.7	409 308.1	421.8

TIER II DISPOSAL FACILITY MONITORING WELLS (AS-BUILT)			
NO.	UTM COORDINATES		ELEV.
	NORTHING	EASTING	
MW-01	7 615 624.0	409 425.0	417.7
MW-02	7 615 610.5	409 290.4	417.5
MW-03	7 615 540.1	409 278.5	416.8
MW-04	7 615 513.3	409 428.3	416.3

TIER II DISPOSAL FACILITY GROUND TEMPERATURE CABLES (AS-BUILT)			
NO.	UTM COORDINATES		ELEV.
	NORTHING	EASTING	
VT-1	7 615 563.3	409 319.5	422.0
VT-2	7 615 561.6	409 336.4	422.4
VT-3	7 615 523.7	409 366.6	422.3
VT-4	7 615 522.4	409 385.0	422.0

NOTE:
FOR DETAILS REGARDING CONFIRMATORY
TESTING INFORMATION, REFER TO FINAL
REPORT PREPARED BY THE ENVIRONMENTAL
SCIENCES GROUP, ROYAL MILITARY COLLEGE.

NOTE:
CONTOURS SHOWN AS DASHED LINES WERE
GENERATED FROM SURVEY INFORMATION
AND REPRESENT FINISHED GROUND SURFACE
FOLLOWING REGRAIDING OR RESHAPING.


1. ALL COORDINATES ARE REFERENCED TO NAD83 (GSR), UTM ZONE 19N. ALL ELEVATIONS REFER TO GEODETIC DATUM.
2. ALL DIMENSIONS ARE IN METRES UNLESS NOTED OTHERWISE.
3. KEY TRENCH WAS EXCAVATED TO SATURATED GROUND, ICE SATURATED PERMAFROST OR SOUND BEDROCK. EXCAVATION DEPTH WAS FIELD CONFIRMED BY THE SITE ENGINEER.

GENERATED BASED ON AS-BUILT
SURVEY INFORMATION

CONSTRUCTED AS PER DESIGN,
NO AS-BUILT SURVEY INFORMATION

0	12-10-22	AS-BUILT DRAWING	RRH
No.	DATE	REVISION	REVISION
			APP

ALCOM **HATCH**

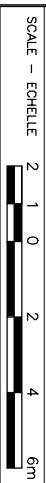

DEW LINE CLEAN UP


© COPYRIGHT
HER MAJESTY THE QUEEN IN RIGHT OF
CANADA 2012, AS REPRESENTED BY THE
MINISTER OF NATIONAL DEFENCE.

TRADE - METTIER	DATE
SITING	2007-08-24


PRODUCTION	CONCURRENCE – ASSIGNMENT	
DESIGNED ETUDE	DES OFF AGENT CONCEPT	
DRAWN DESSINE	SECT HD CHET SECT	
CHECKED VERIFIE	DES MGR GEST CONCEPT	
COORDINATION	REVIEWED – REVU	

DWG. NO. - DESSIN NO.
H-D67/1-9101-12

Canada

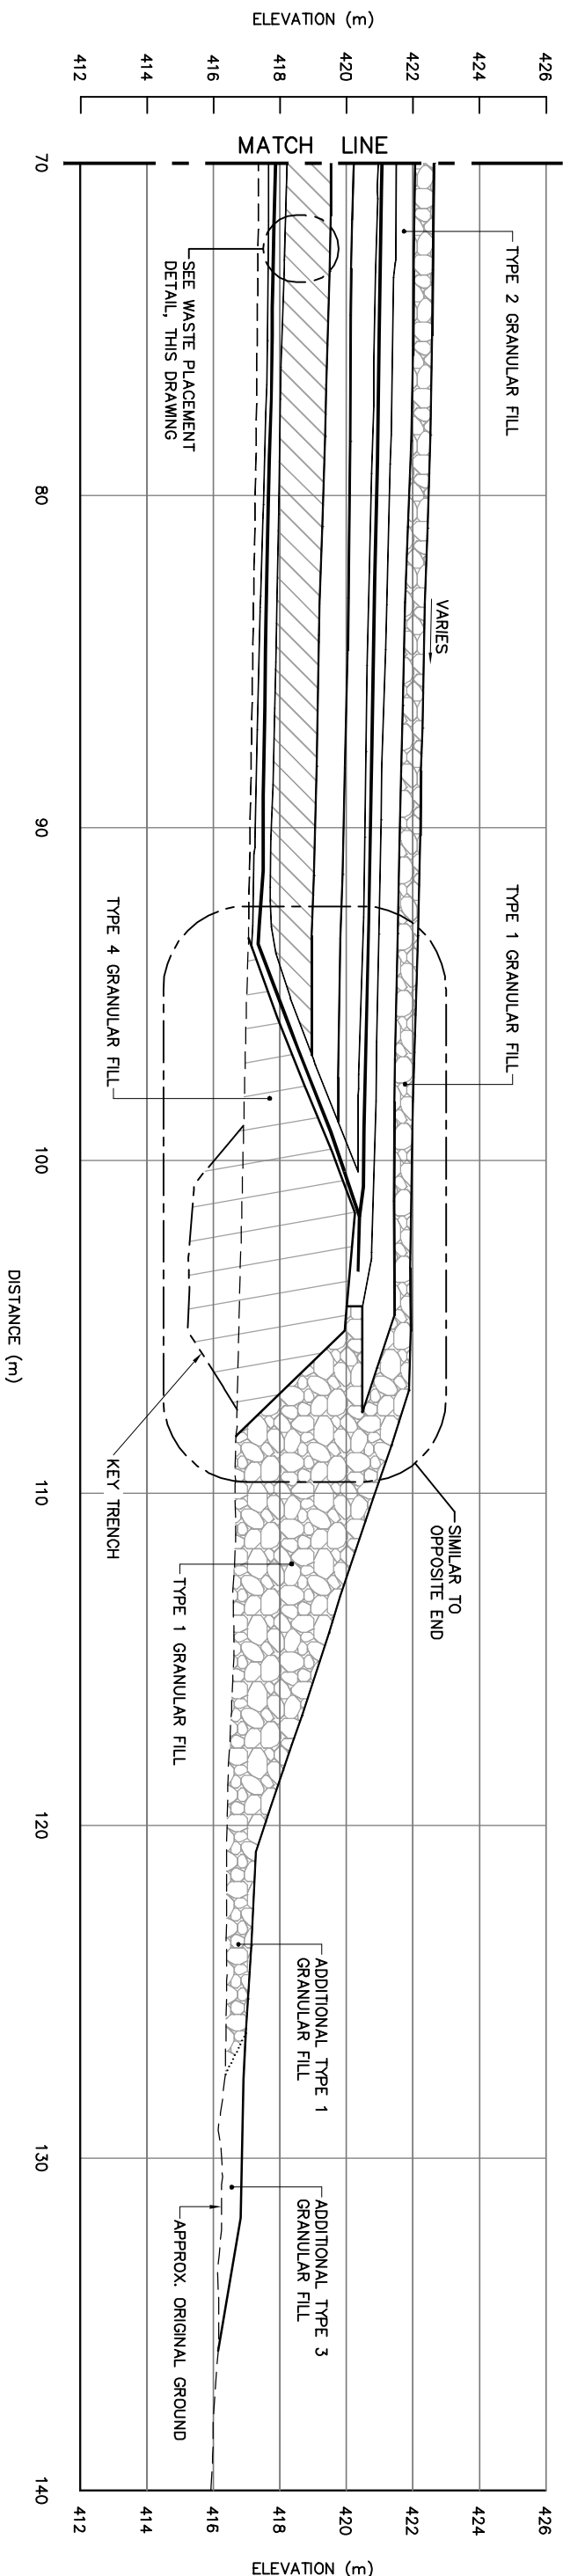

NOTE:
GEOMEMBRANE LINERS WERE PROTECTED
DURING INTERIM CONSTRUCTION.

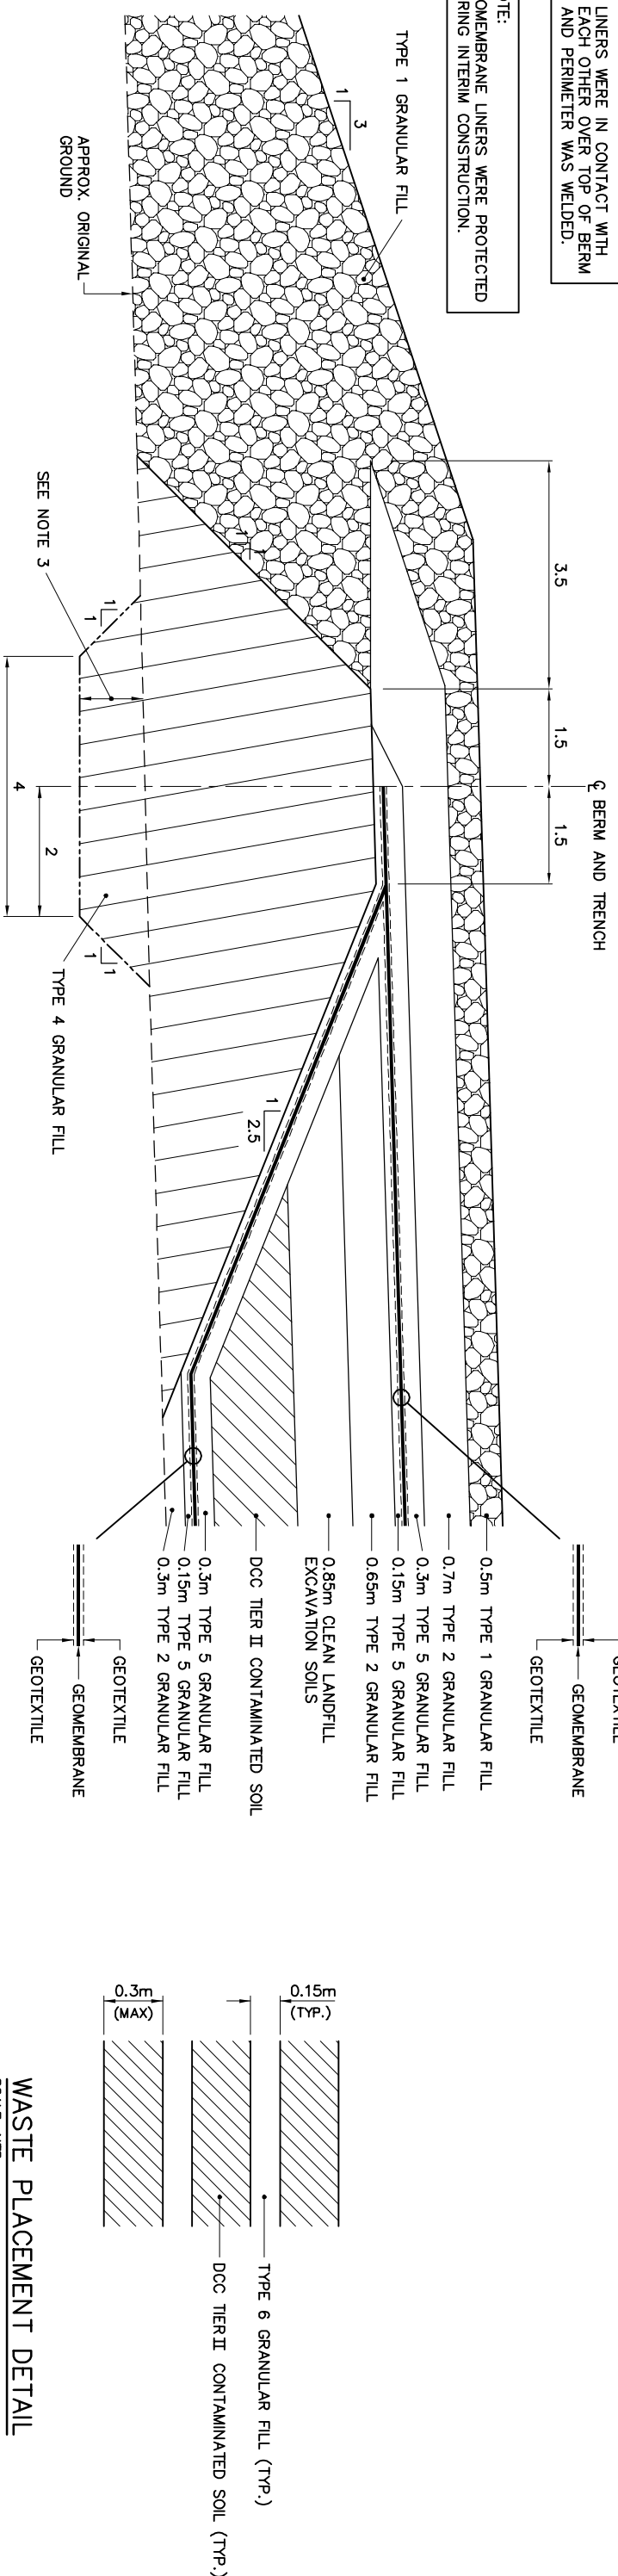

SCALE: NTS

$$\left(\frac{1}{121} \right)$$

General Notes:

- ALL COORDINATES ARE REFERENCED TO NAD83 (CSRS) UTM ZONE 19N. ALL ELEVATIONS REFER TO GEODETIC DATUM.
- ALL DIMENSIONS ARE IN METRES UNLESS NOTED OTHERWISE.
- KEY TRENCH WAS EXCAVATED TO SATURATED SOIL. USE OF EXCAVATED MATERIAL FOR FILL CONFORMED BY THE SITE ENGINEER.

Legend:

- GENERATED BASED ON AS-BUILT SURVEY INFORMATION
- CONSTRUCTED AS PER DESIGN.
- NO AS-BUILT SURVEY INFORMATION

0	12-10-22	AS-BUILT DRAWING	RAM
No.	DATE	REVISION	APPR.

DRAFT

AECOM HATCH

SCALE - ÉCHELLE 2 1 0 2 4 6m

PROJECT - PROJET
FOX-3 DEWAR LAKES

DEW LINE CLEAN UP

© COPYRIGHT
HER MAJESTY THE QUEEN IN RIGHT OF
CANADA 2012, AS REPRESENTED BY THE
MINISTER OF NATIONAL DEFENCE.



TRADE - MÉTIER	SITING	DATE
SUBJECT - SUJET		2007-08-24

TIER II DISPOSAL FACILITY
CROSS SECTION

PRODUCTION	CONCURRENCE - ASSÉNIEMENT
DESIGNED ETUDED DRAWN DRESSÉ CHECKED VÉRIFIÉ COORDINATION	DES. OFF. AGENT CONCEPT SECT. NO. CHÉF SECT. DES. MGR. GEST. CONCEPT REVIEWED - REVU
DESIGNED ETUDED DRAWN DRESSÉ CHECKED VÉRIFIÉ COORDINATION	DES. OFF. AGENT CONCEPT SECT. NO. CHÉF SECT. DES. MGR. GEST. CONCEPT REVIEWED - REVU
DESIGNED ETUDED DRAWN DRESSÉ CHECKED VÉRIFIÉ COORDINATION	DES. OFF. AGENT CONCEPT SECT. NO. CHÉF SECT. DES. MGR. GEST. CONCEPT REVIEWED - REVU

DWG. NO. - DESSIN NO.
H-D67/1-9101-122

Canada

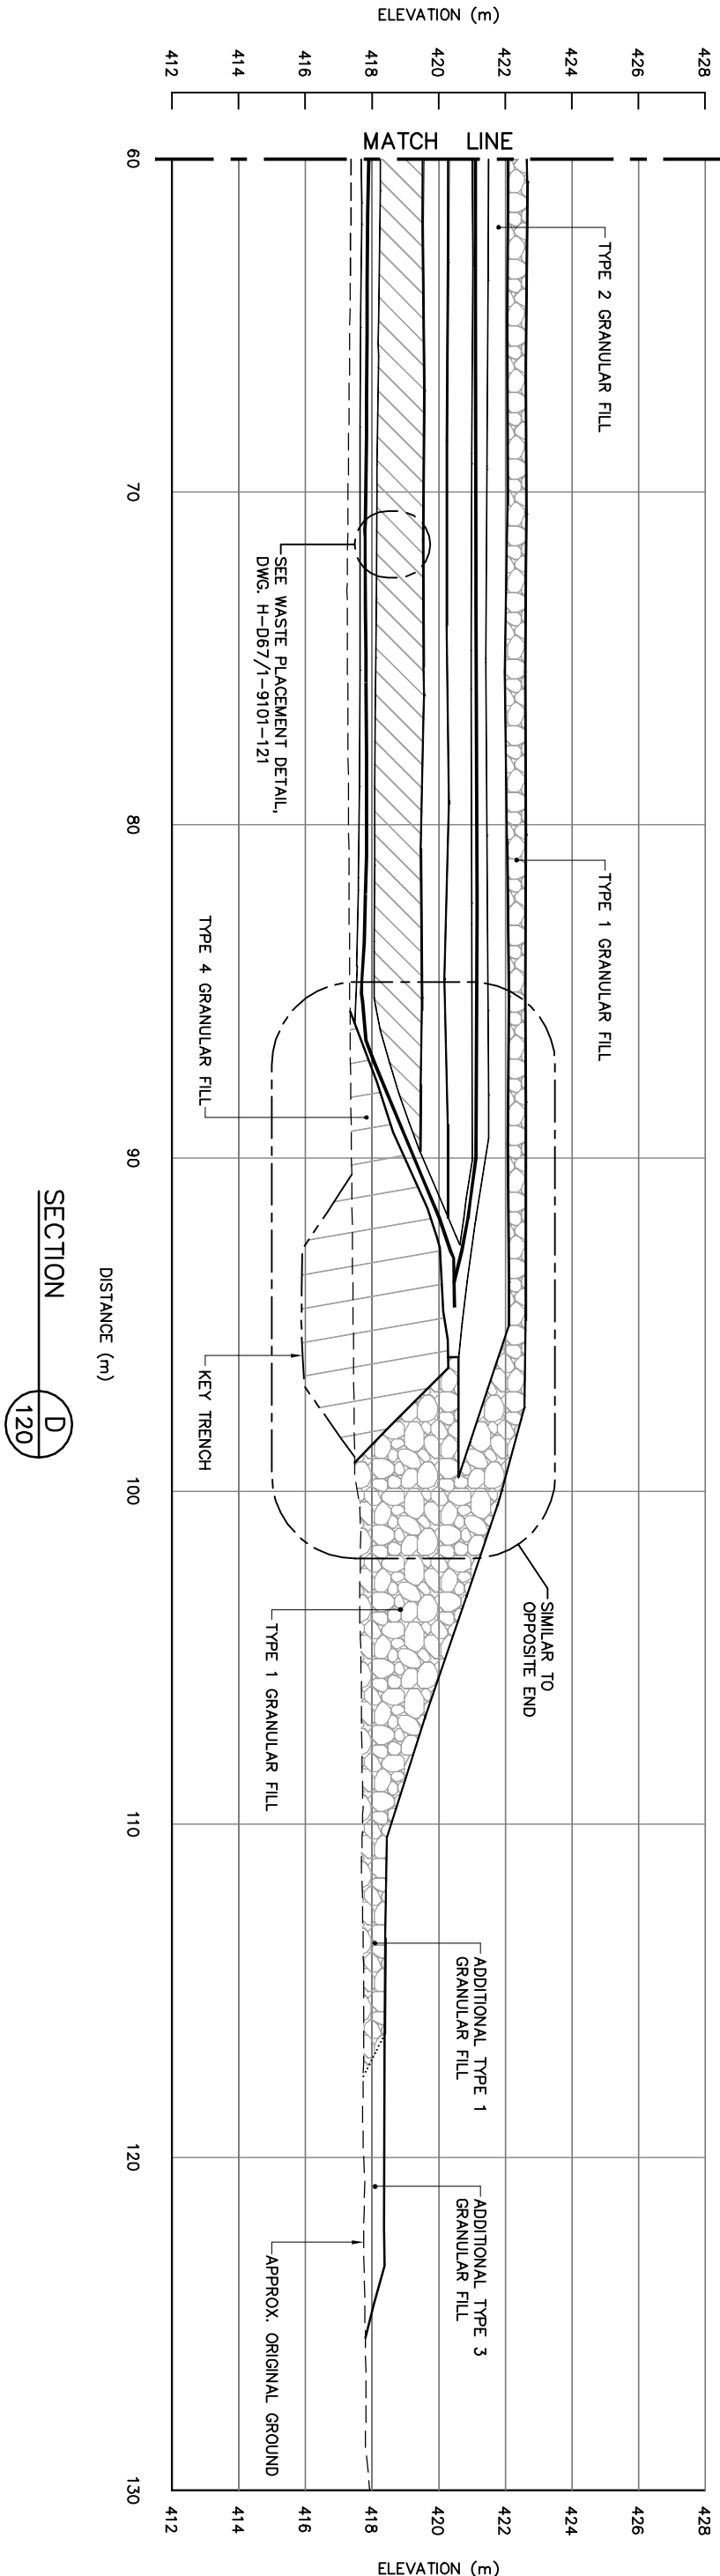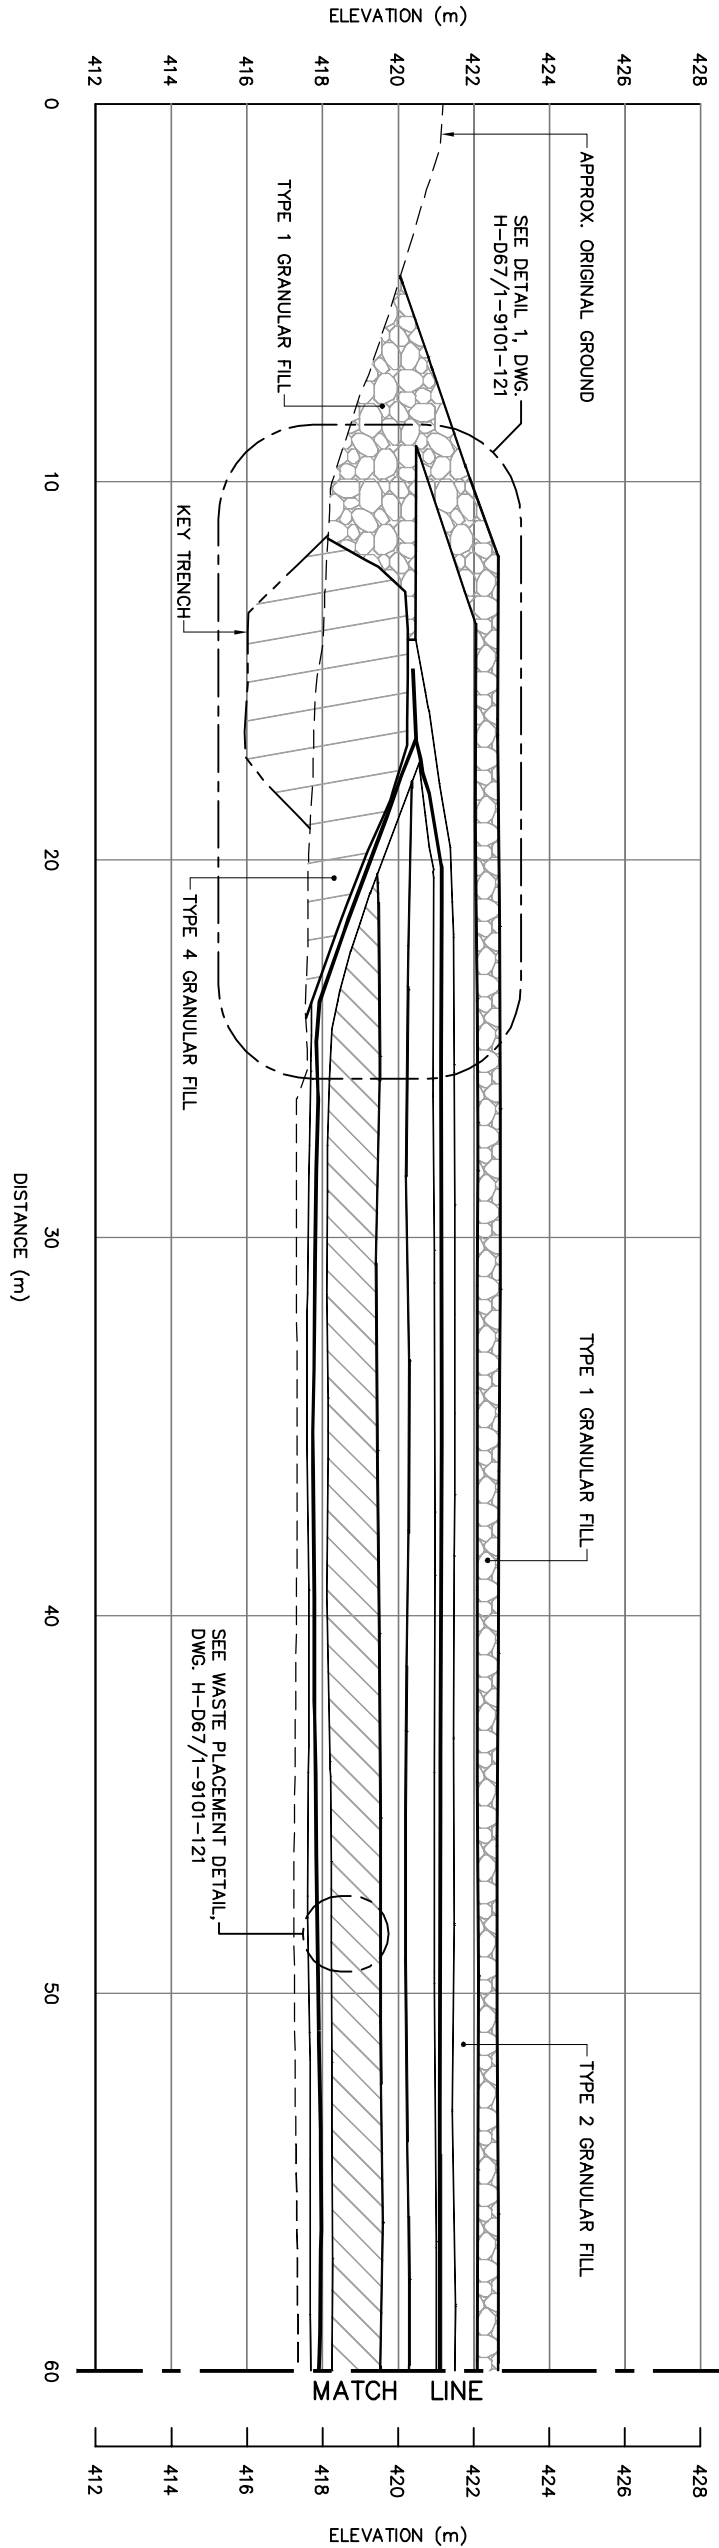

- General Notes:
- ALL COORDINATES ARE REFERENCED TO NAD83 (GRS83). UTM ZONE 18N. ALL ELEVATIONS REFER TO GEODETIC DATUM.
 - ALL DIMENSIONS ARE IN METRES UNLESS NOTED OTHERWISE.

AIRSTRIp LANDFILL (LOBE F) REGRADED (AS-BUILT)			
NO.	UTM COORDINATES		ELEV.
	NORTHING	EASTING	
620	7 614 048.1	413 527.7	179.0
621	7 614 051.4	413 531.7	179.2
622	7 614 050.7	413 539.2	179.4
623	7 614 043.9	413 545.9	179.6
624	7 614 037.6	413 546.5	179.3
625	7 614 030.6	413 552.0	179.3
626	7 614 023.7	413 547.1	178.0
627	7 614 019.2	413 547.8	177.5
628	7 614 015.3	413 551.3	177.3
629	7 614 008.1	413 552.5	176.0
630	7 614 002.6	413 546.8	175.3
631	7 614 005.9	413 541.1	176.0
632	7 614 011.4	413 536.6	176.4
633	7 614 021.0	413 533.7	177.7
634	7 614 023.3	413 529.5	178.8
635	7 614 029.4	413 526.0	179.1
636	7 614 043.4	413 528.8	178.8


AIRSTRIp LANDFILL (LOBE I) REGRADED (AS-BUILT)			
NO.	UTM COORDINATES		ELEV.
	NORTHING	EASTING	
640	7 614 122.2	413 588.8	181.0
641	7 614 122.1	413 593.3	180.8
642	7 614 114.8	413 597.9	180.5
643	7 614 103.5	413 598.6	180.2
644	7 614 099.5	413 592.1	180.3
645	7 614 101.4	413 589.1	180.5
646	7 614 114.2	413 585.9	180.9

AIRSTRIp LANDFILL (LOBE L) REGRADED (AS-BUILT)			
NO.	UTM COORDINATES		ELEV.
	NORTHING	EASTING	
650	7 614 137.6	413 603.3	180.4
651	7 614 138.2	413 608.0	180.0
652	7 614 137.6	413 619.6	178.2
653	7 614 132.1	413 625.4	177.9
654	7 614 125.4	413 626.0	177.9
655	7 614 123.9	413 621.7	178.1
656	7 614 128.6	413 603.2	180.0
657	7 614 134.8	413 601.5	180.4

AIRSTRIp LANDFILL (LOBE M) REGRADED (AS-BUILT)			
NO.	UTM COORDINATES		ELEV.
	NORTHING	EASTING	
660	7 614 161.1	413 626.8	178.6
661	7 614 162.1	413 631.5	178.3
662	7 614 160.2	413 633.8	178.0
663	7 614 156.1	413 636.8	177.6
664	7 614 147.3	413 633.8	177.1
665	7 614 148.8	413 626.5	178.0



NOTE:
FOR DETAILS REGARDING CONFIRMATORY TESTING INFORMATION, REFER TO FINAL REPORT PREPARED BY THE ENVIRONMENTAL SCIENCES GROUP, ROYAL MILITARY COLLEGE.

NOTE:
CONTOURS SHOWN AS DASHED LINES WERE GENERATED FROM SURVEY INFORMATION AND REPRESENT FINISHED GROUND SURFACE FOLLOWING REGRAIDING OR RESHAPING.

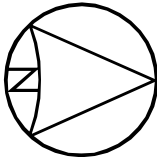


BORROW AREA 5 DEBRIS AREA (LOBE A) REGRADED (AS-BUILT)			
NO.	UTM COORDINATES		ELEV.
	NORTHING	EASTING	
601	7 613 762.9	413 146.1	177.2
602	7 613 763.3	413 158.5	176.5
603	7 613 751.4	413 156.0	176.7
604	7 613 751.8	413 143.9	177.1

BORROW AREA 5 DEBRIS AREA (LOBE B) REGRADED (AS-BUILT)			
NO.	UTM COORDINATES		ELEV.
	NORTHING	EASTING	
610	7 613 782.3	413 110.6	178.7
611	7 613 771.0	413 126.5	178.0
612	7 613 768.1	413 120.4	178.2
613	7 613 770.9	413 106.7	178.7
614	7 613 773.3	413 104.3	178.8
615	7 613 777.2	413 105.4	179.0

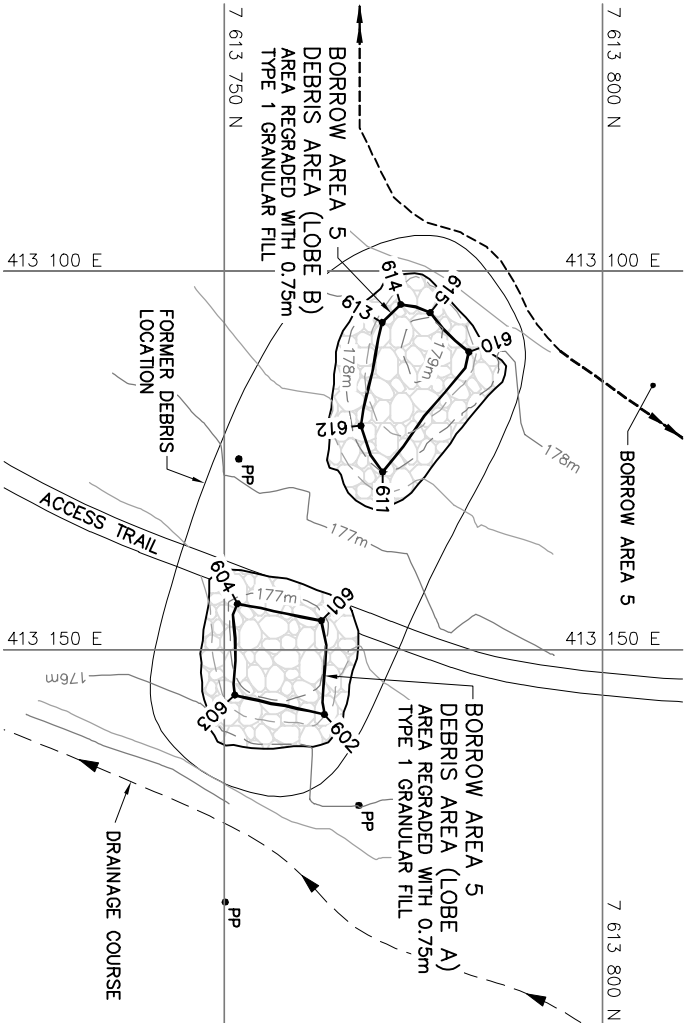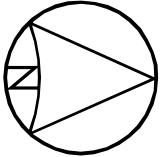

BORROW AREA 5 DEBRIS AREA (LOBES A,B)
(DWG. 111)

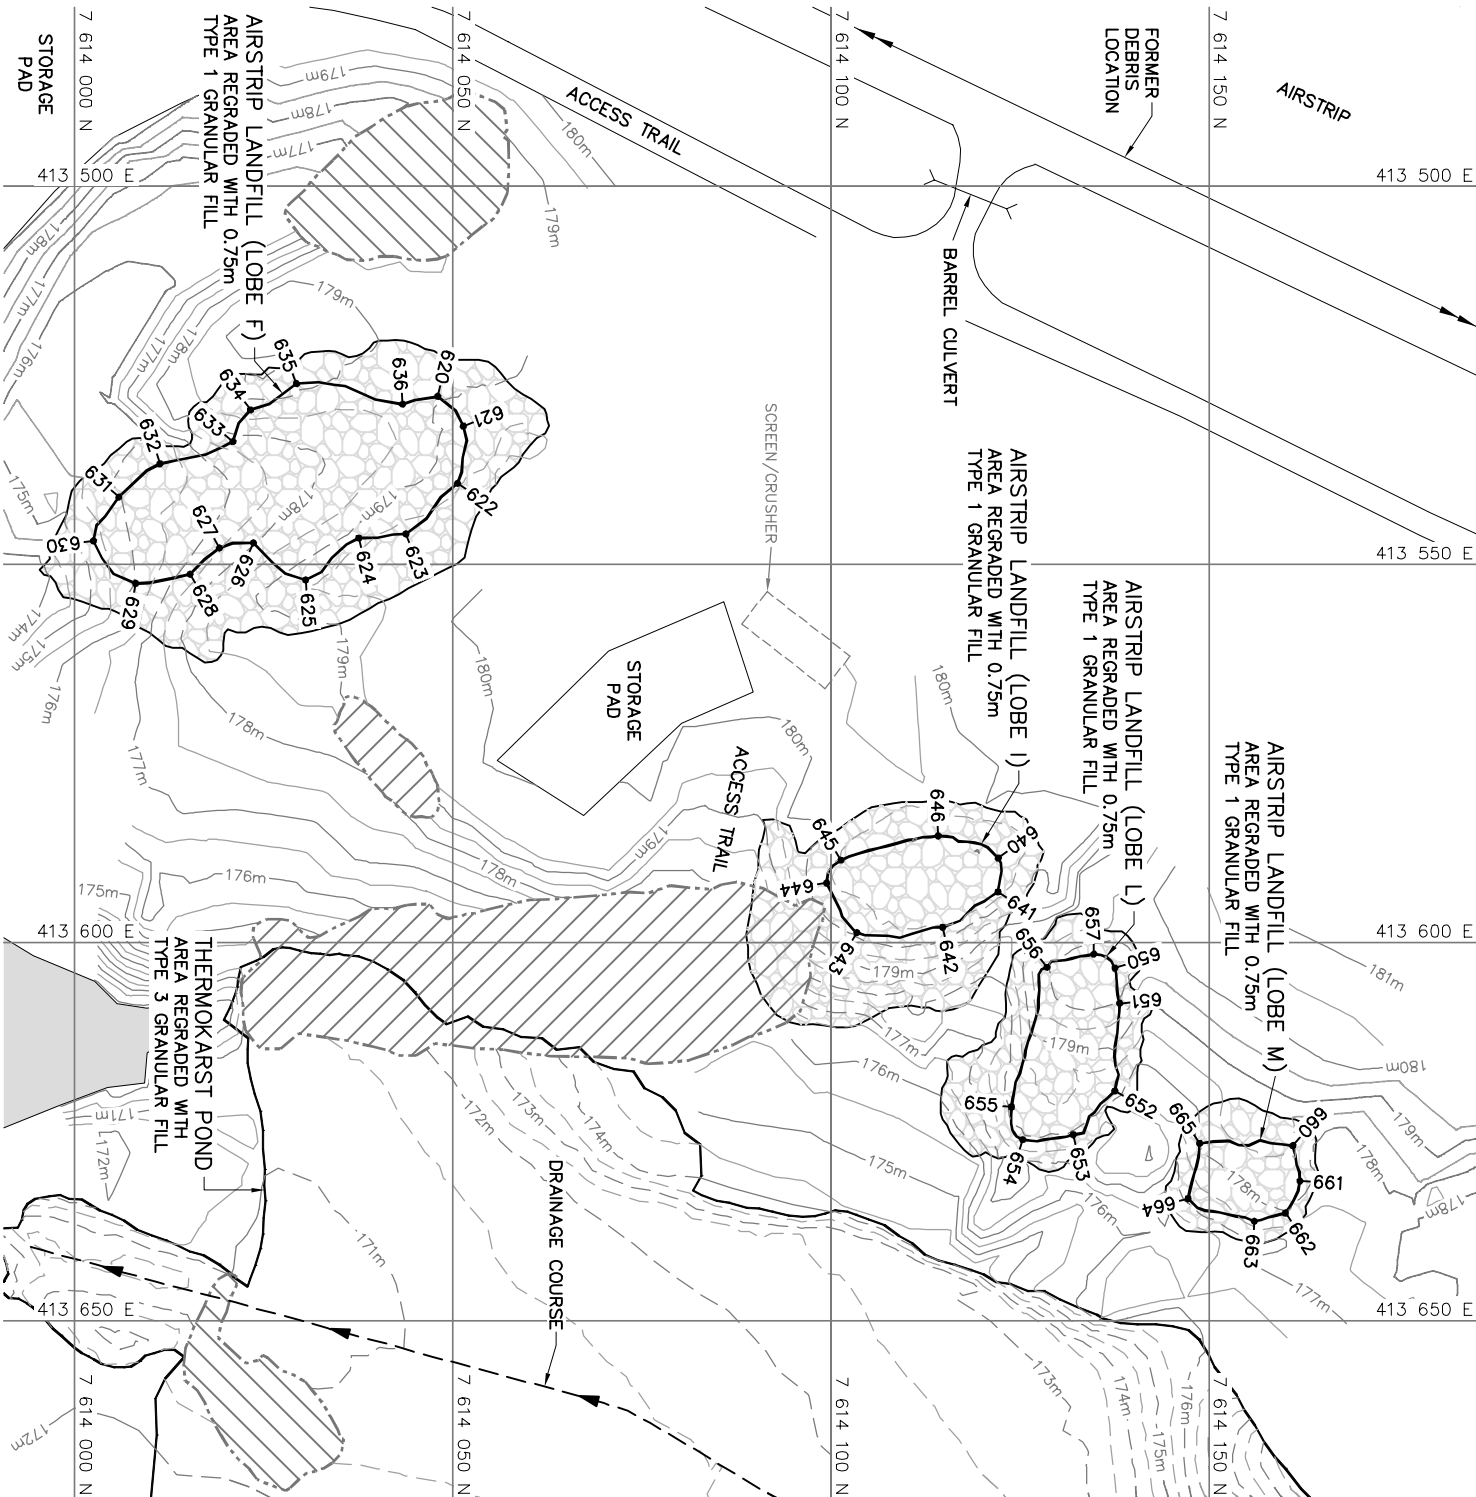

AIRSTRIp LANDFILL (LOBES F,I,L,M)
(DWG. 112)

- Legend:
- 60' COORDINATE POINT
 - COMPLETED LANDFILL OR BURIED DEBRIS EXCAVATION
 - FORMER BUILDING, STRUCTURE OR TANK LOCATION
 - BODY OF WATER

0	12-10-22	AS-BUILT DRAWING	RAM
No.	DATE	REVISION	APPR.

DRAFT

AECOM HATCH

SCALE - GRAPHIC 10 5 0 10 20 30m

PROJECT - PROJECT
FOX-3 DEWAR LAKES

DEW LINE CLEAN UP

© COPYRIGHT
HER MAJESTY THE QUEEN IN RIGHT OF
CANADA 2012, AS REPRESENTED BY THE
MINISTER OF NATIONAL DEFENCE.

TRADE - METER SITTING DATE 2007-08-24

MISCELLANEOUS LANDFILL/BURIED
DEBRIS REGRAIDING DETAILS
SHEET 2

PRODUCTION		CONCURRENCE - ASSIGNMENT	
DESIGNED	THE/DIM	DES. OFF.	AGENCY CONCEPT
DRAWN	ONE	SECT. NO.	CHEF. SECT.
CHECKED	ONE	DES. MGR.	DES. MGR.
VERIFIED	ONE	TEST CONCEPT	TEST CONCEPT
COORDINATION	ONE	REVIEWED	REV. NO.

DWG. NO. - DESIGN NO.
H-0677/-9101-124

Canada

General Notes:
1. ALL COORDINATES ARE REFERENCED TO NAD83 (GRS83) UTM ZONE 19N. ALL ELEVATIONS REFER TO GEODETIC DATUM.
2. ALL DIMENSIONS ARE IN METRES UNLESS NOTED OTHERWISE.



AIRSTRIp LANDFILL (LOBE Q) REGRADED (AS-BUILT)			
UTM COORDINATES		ELEV.	
NO.	NORTHING	EASTING	ELEV.
701	7 614 383.0	413 719.4	185.3
702	7 614 385.6	413 724.4	185.4
703	7 614 379.1	413 733.0	184.9
704	7 614 371.2	413 738.8	184.7
705	7 614 354.0	413 731.5	184.7
706	7 614 351.8	413 726.3	184.7
707	7 614 356.2	413 715.6	184.5
708	7 614 364.7	413 711.5	184.5
709	7 614 372.3	413 717.8	185.2

AIRSTRIp LANDFILL (LOBE R) REGRADED (AS-BUILT)			
UTM COORDINATES		ELEV.	
NO.	NORTHING	EASTING	ELEV.
710	7 614 319.0	413 725.0	183.8
711	7 614 316.5	413 741.0	184.0
712	7 614 311.1	413 749.1	183.6
713	7 614 304.1	413 751.6	183.2
714	7 614 301.5	413 745.7	183.4
715	7 614 304.0	413 734.5	183.9
716	7 614 303.4	413 725.0	183.6

AIRSTRIp LANDFILL (LOBE S) REGRADED (AS-BUILT)			
UTM COORDINATES		ELEV.	
NO.	NORTHING	EASTING	ELEV.
720	7 614 263.5	413 686.5	182.4
721	7 614 263.7	413 693.6	182.5
722	7 614 256.4	413 701.4	183.2
723	7 614 248.7	413 698.1	183.1
724	7 614 248.7	413 690.6	182.6
725	7 614 256.1	413 684.8	182.4



AIRSTRIp LANDFILL (LOBE EE) REGRADED (AS-BUILT)			
UTM COORDINATES		ELEV.	
NO.	NORTHING	EASTING	ELEV.
730	7 614 421.9	413 784.3	185.8
731	7 614 426.6	413 787.7	185.8
732	7 614 425.4	413 796.3	185.3
733	7 614 420.9	413 800.5	185.4
734	7 614 403.1	413 802.8	185.0
735	7 614 389.9	413 787.8	184.8
736	7 614 391.7	413 783.4	184.9
737	7 614 401.2	413 786.5	185.7
738	7 614 407.2	413 791.1	185.7
739	7 614 415.4	413 792.8	185.7

AIRSTRIp LANDFILL (LOBE DD) REGRADED (AS-BUILT)			
UTM COORDINATES		ELEV.	
NO.	NORTHING	EASTING	ELEV.
740	7 614 749.3	413 922.6	189.1
741	7 614 745.6	413 934.5	188.8
742	7 614 740.2	413 936.6	188.9
743	7 614 720.4	413 935.0	188.8
744	7 614 716.0	413 928.7	188.7
745	7 614 719.3	413 915.0	188.8
746	7 614 732.5	413 917.3	189.1

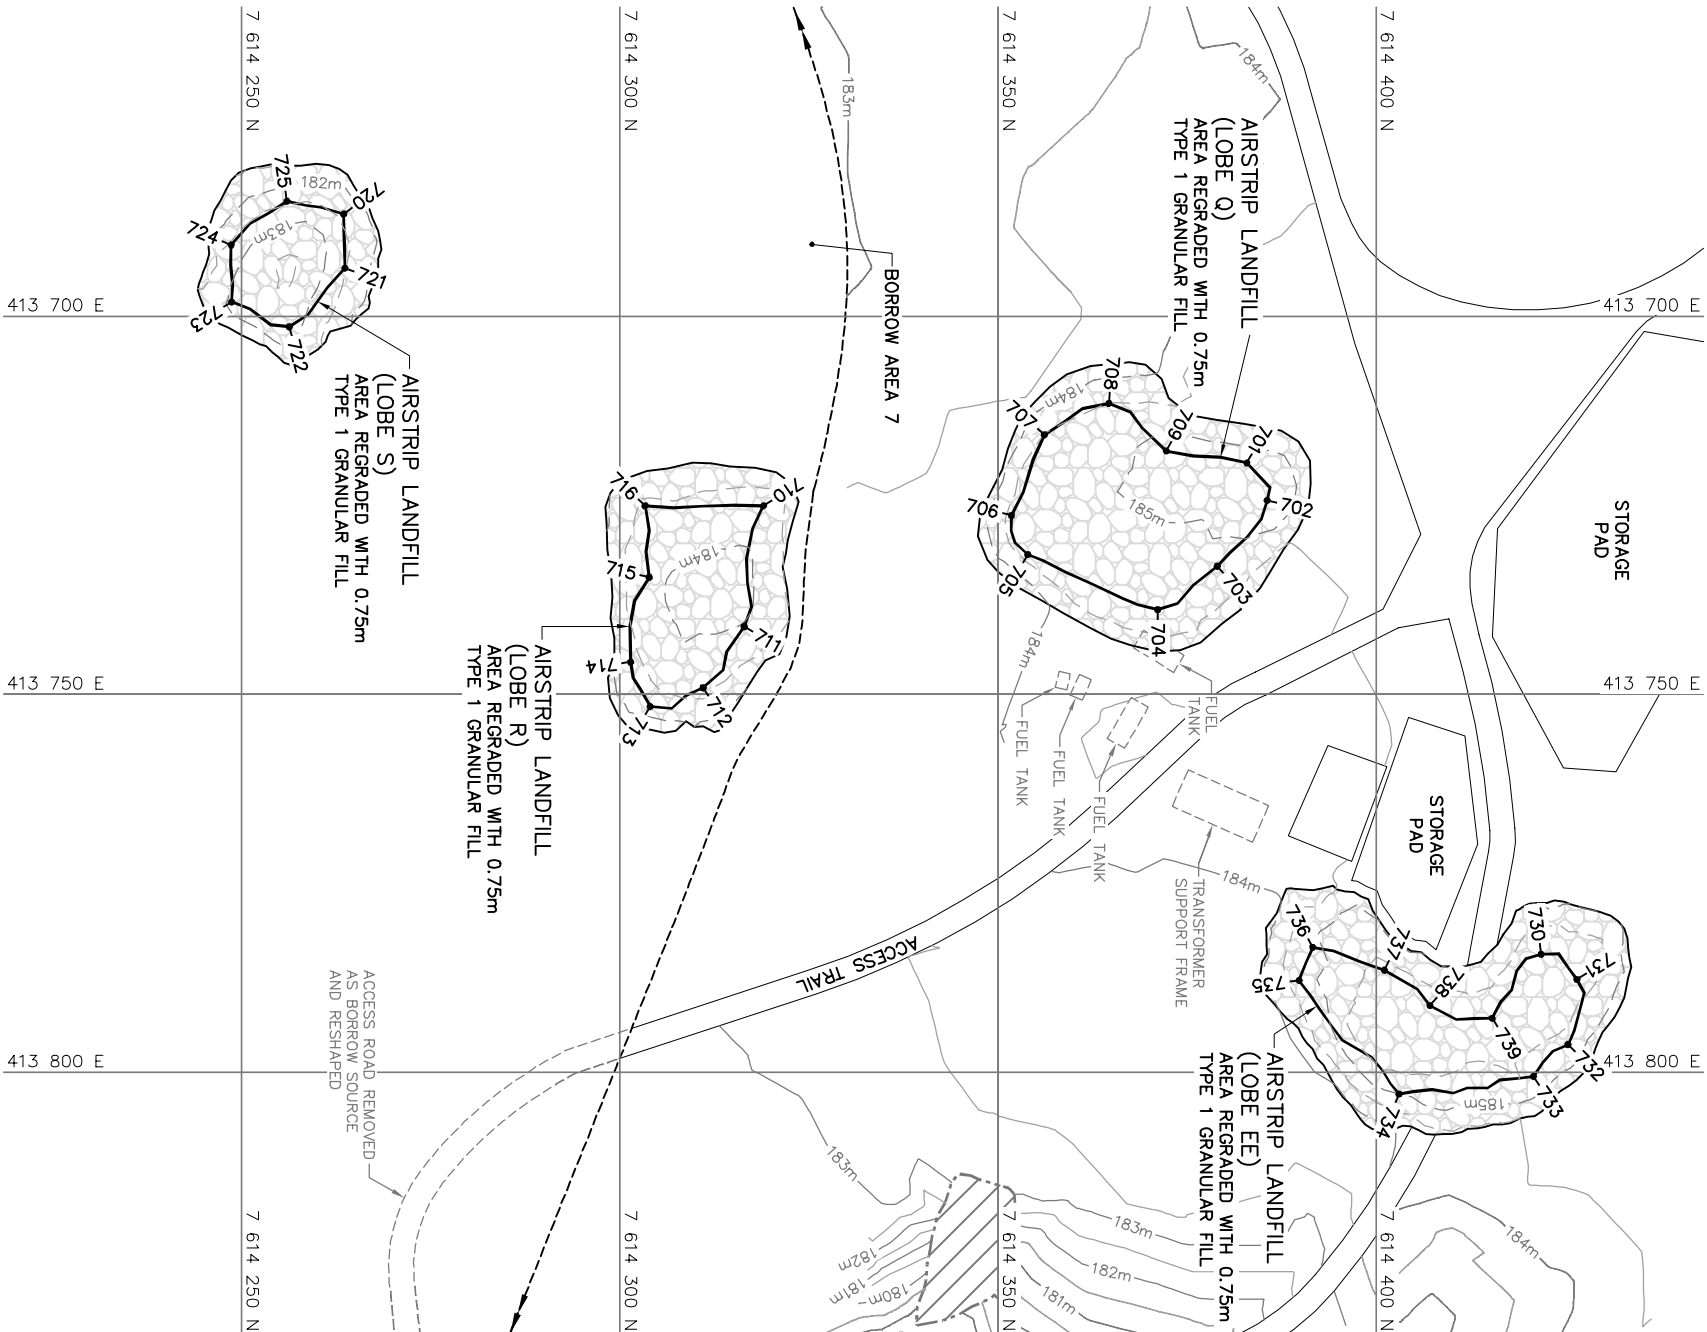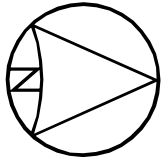



NOTE:
FOR DETAILS REGARDING CONFIRMATORY TESTING INFORMATION, REFER TO FINAL REPORT PREPARED BY THE ENVIRONMENTAL SCIENCES GROUP, ROYAL MILITARY COLLEGE.

NOTE:
CONTOURS SHOWN AS DASHED LINES WERE GENERATED FROM SURVEY INFORMATION AND REPRESENT FINISHED GROUND SURFACE FOLLOWING REGRADED OR RESHAPING.

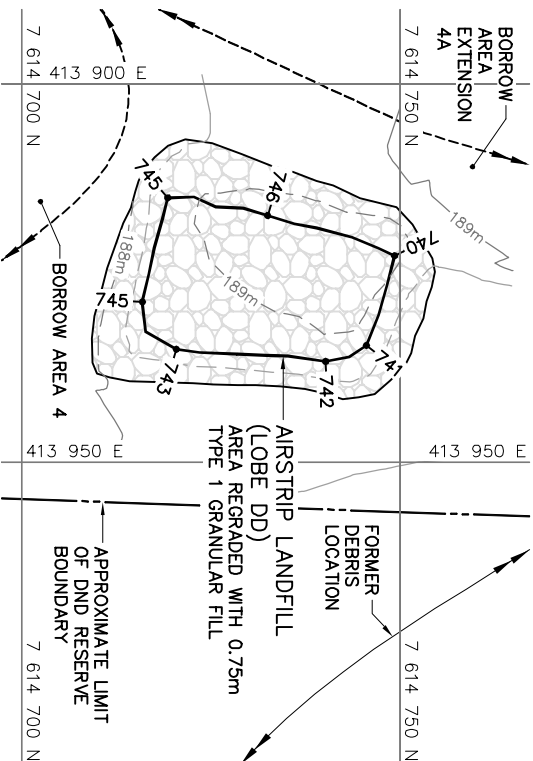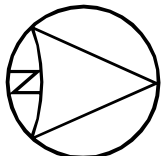

AIRSTRIp LANDFILL (LOBE DD)
(DWG. 113)

AIRSTRIp LANDFILL (LOBE GG) REGRADED (AS-BUILT)			
UTM COORDINATES		ELEV.	
NO.	NORTHING	EASTING	ELEV.
750	7 614 574.7	413 917.5	187.1
751	7 614 574.9	413 921.3	187.3
752	7 614 569.3	413 927.2	187.1
753	7 614 559.6	413 922.2	186.6
754	7 614 560.9	413 917.9	187.0
755	7 614 568.5	413 910.6	186.9

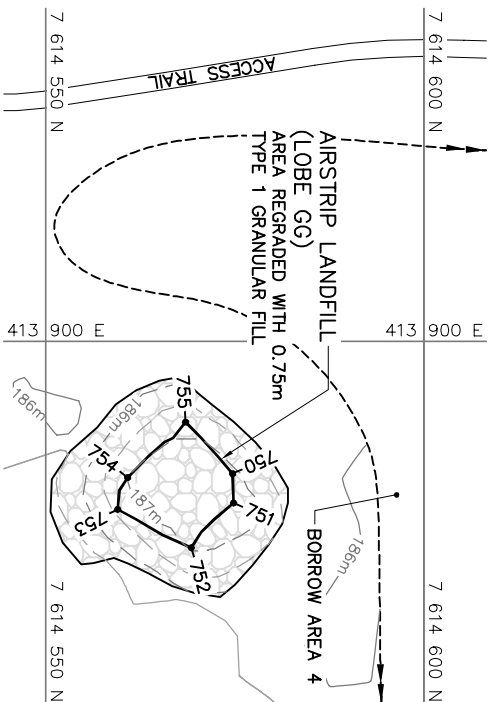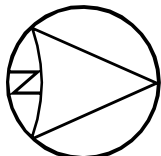

AIRSTRIp LANDFILL (LOBE GG)
(DWG. 113)

0	12-10-22	AS-BUILT DRAWING	RAM
No.	DATE	REVISION	REVISION
DRAFT			
AECOM HATCH			
PROJECT - PROJECT FOX-3 DEWAR LAKES			
SCALE - ECHELLE 10 5 0 10 20 30m			
TRADE - METER SITTING DATE 2007-08-24			
SHEET - SHEET MISCELLANEOUS LANDFILL REGRADED DETAILS SHEET 4			
PRODUCTION		CONCURRENCE - ASSIGNMENT	
DESIGNED BY/ME/DIM	DES. OFF.	DES. OFF.	DES. OFF.
DRAWN BY/ME/DIM	AGENT CONCEPT	AGENT CONCEPT	AGENT CONCEPT
CHECKED BY/ME/DIM	CHEF SCOT	CHEF SCOT	CHEF SCOT
VERIFIED BY/ME/DIM	DES. MGR	DES. MGR	DES. MGR
COORDINATION	REVIEWED - REVU	REVIEWED - REVU	REVIEWED - REVU
DWG. NO. - DESSIN NO. H-0677/-9101-126			

- General Notes:
1. ALL COORDINATES ARE REFERENCED TO NAD83 (CSRS) UTM ZONE 18N. ALL ELEVATIONS REFER TO GEODETIC DATUM.
 2. ALL DIMENSIONS ARE IN METRES UNLESS NOTED OTHERWISE.
 3. DEBRIS REMOVED FROM THERMOKARST POND PRIOR TO GRANULAR FILL PLACEMENT.

Legend:

- GENERATED BASED ON AS-BUILT SURVEY INFORMATION
COMPLETED LANDFILL OR BURIED DEBRIS EXCAVATION
BODY OF WATER

0	12-10-22	AS-BUILT DRAWING	
No.	DATE	REVISION	REVISION
			<i>KRM</i>

DRAFT

AECOM **HATCH**

SCALE - ECHELLE AS SHOWN

PROJECT - PROJECT FOX-3 DEWAR LAKES




DEW LINE CLEAN UP
© COPYRIGHT
HER MAJESTY THE QUEEN IN RIGHT OF
CANADA 2012, AS REPRESENTED BY THE
MINISTER OF NATIONAL DEFENCE.

TRADE - METIER	SITING	DATE
SUBJECT - SUJET		2007-08-24

THERMOKARST POND
PLAN AND CROSS SECTION

PRODUCTION	CONCURRENCE - ASSÉMBLEMENT
DESIGNED <i>HE/DJM</i>	DES. OFT.
DRAWN <i>CM</i>	AGENT CONCEPT
CHECKED <i>KRM</i>	CHEF SECT.
VERIFIED <i>KRM</i>	DES. MGR.
COORDINATION <i>SMG</i>	TEST CONCEPT
	REVIEWED - REVU
	DWG. NO. - DESSIN NO.
	H-0677/-9101-128

Canada

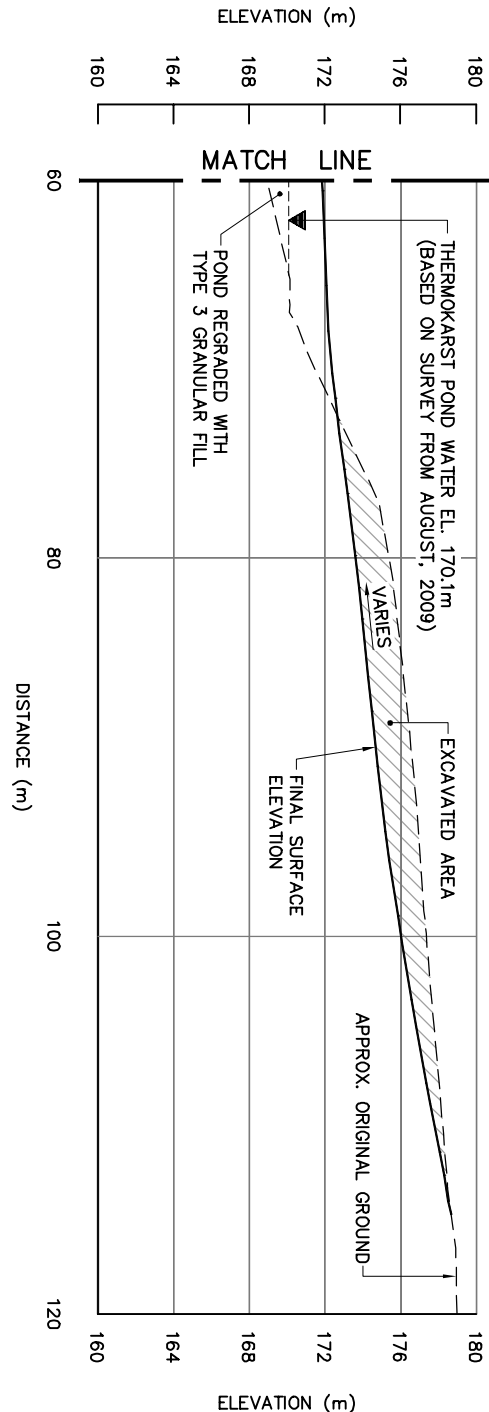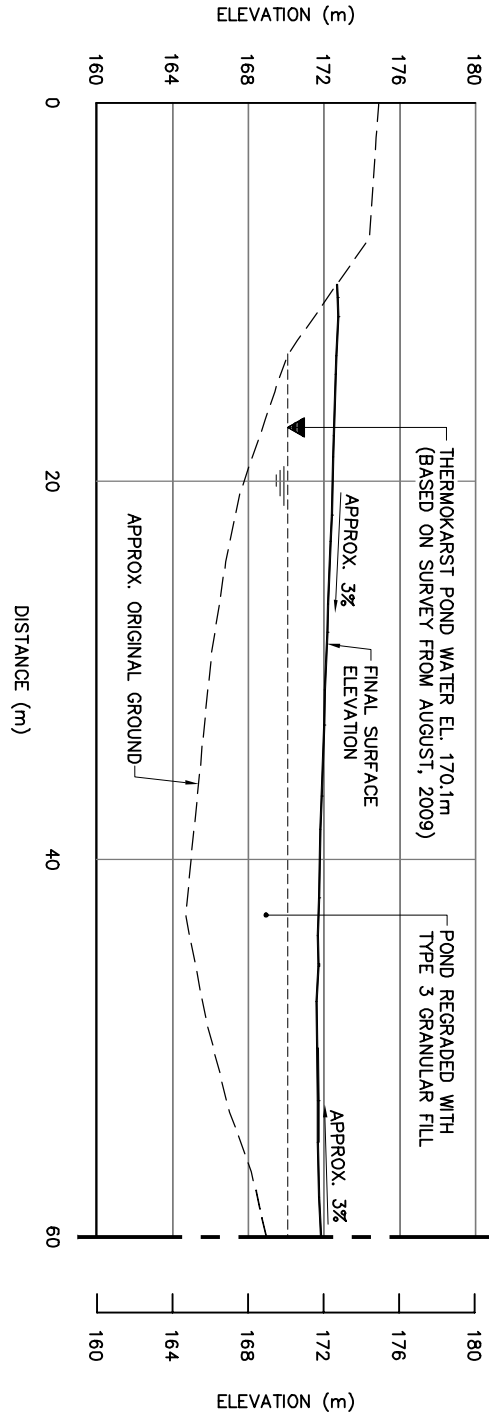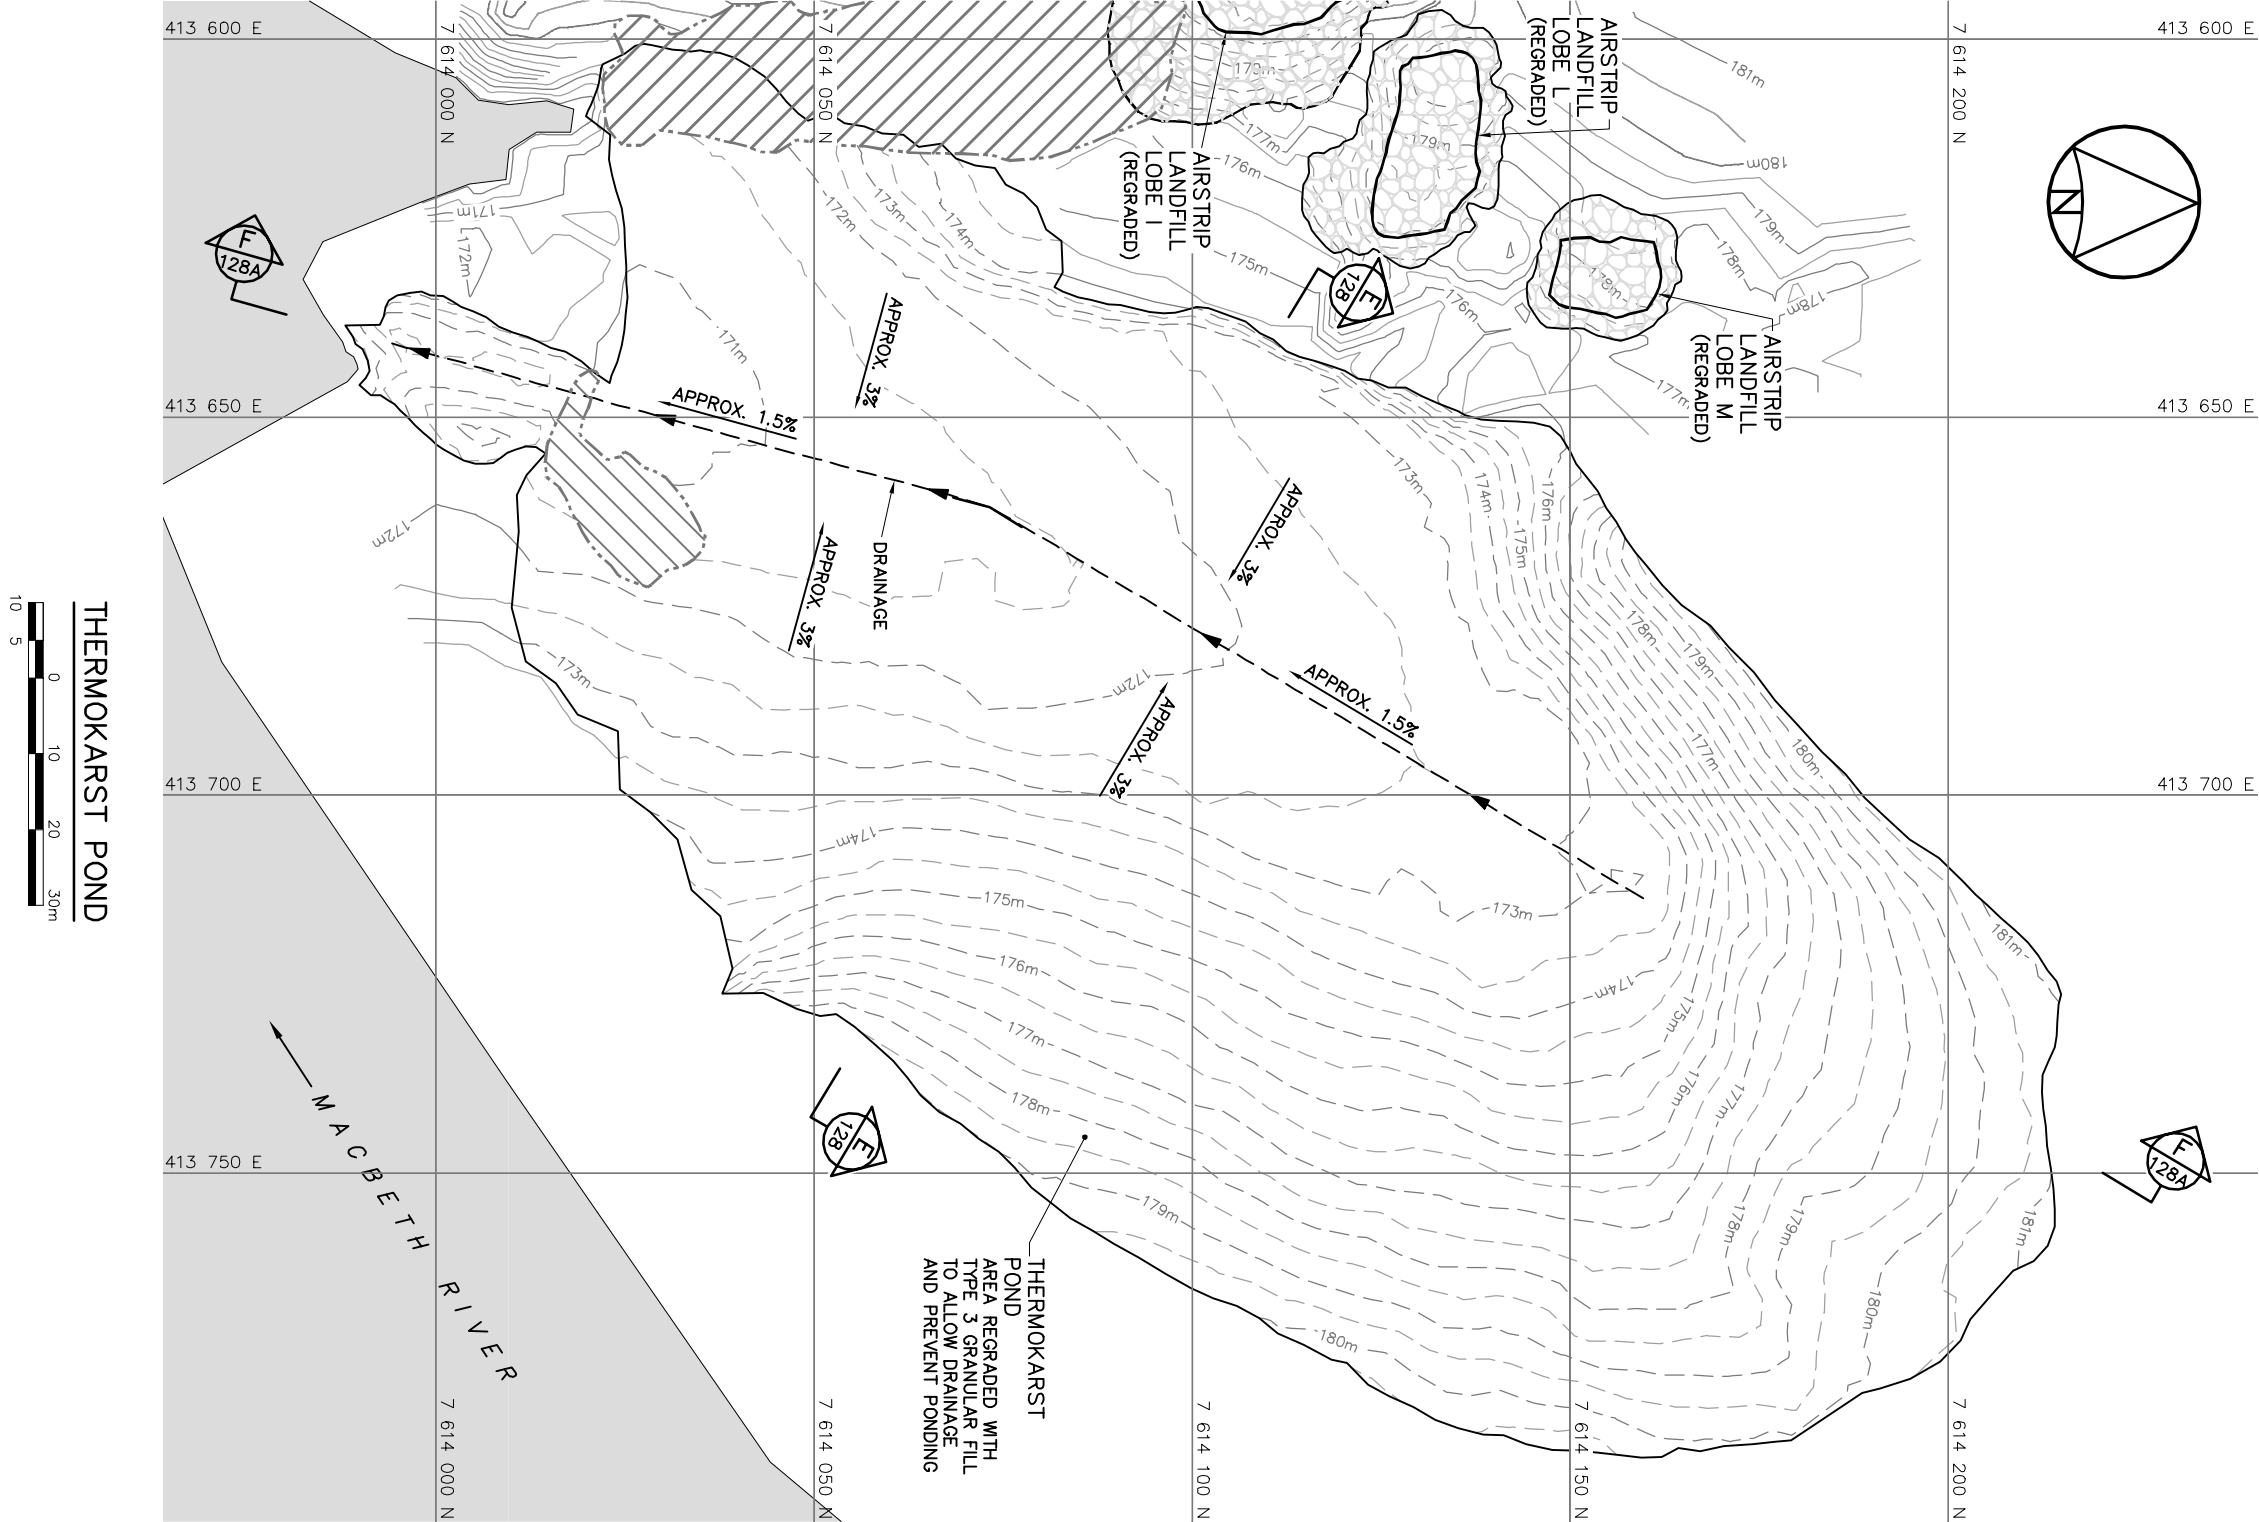

- General Notes:
- ALL COORDINATES ARE REFERENCED TO NAD83 (GSR8). UTM ZONE 18N. ALL ELEVATIONS REFER TO GEODETIC DATUM.
 - ALL DIMENSIONS ARE IN METRES UNLESS NOTED OTHERWISE.
 - DEBRIS REMOVED FROM THERMOKARST POND PRIOR TO GRANULAR FILL PLACEMENT.

Legend:

GENERATED BASED ON AS-BUILT
SURVEY INFORMATION

0 12-10-22 AS-BUILT DRAWING				RAM
No.	DATE	REVISION	REVISION	Appr.

DRAFT

AECOM HATCH

SCALE - ÉCHELLE 4 2 0 4 8 12m

PROJECT - PROJET
FOX-3 DEWAR LAKES

DEW LINE CLEAN UP

© COPYRIGHT
HER MAJESTY THE QUEEN IN RIGHT OF
CANADA 2012, AS REPRESENTED BY THE
MINISTER OF NATIONAL DEFENCE.

TRADE - MÉTIER	SITING	DATE
SUBJECT - SUJET		2012-08-27

THERMOKARST POND
CROSS SECTION

PRODUCTION		CONCURRENCE - ASSAIGNMENT	
DESIGNED ETUDE	D/M	DES. OFF. AGENT CONCEPT	
DRAWN DESSINÉ	K	SECT. NO. CHÉF SECT.	
CHECKED VÉRIFIÉ	B/M	DES. MGR. GEST. CONCEPT	
COORDINATION	R/M	REVIEWED - REVU	

DWG. NO. - DESIGN NO.
H-D67/1-9101-128A

Canada





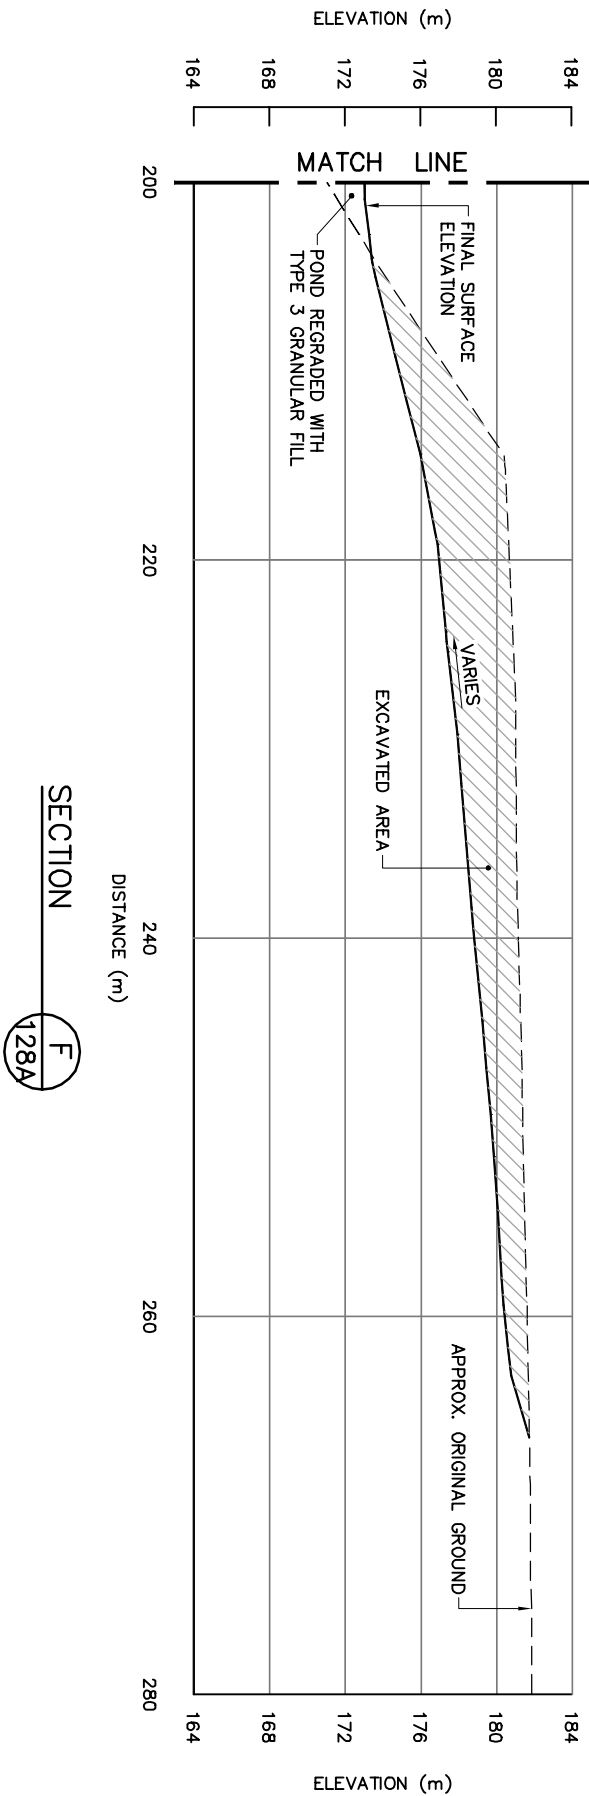


TABLE 1 GROUND TEMPERATURE CABLE INSTALLATION		
INSTRUMENT No.	APPROXIMATE DEPTH BELOW FINAL GRADE (m)	COMMENTS
TIER II DISPOSAL FACILITY		
VT-1	5.79	INSTALLED THROUGH CENTRELINE BERM TO INVERT OF KEY TRENCH
VT-2	3.58	INSTALLED TO 1.0m ABOVE ELEVATION OF BOTTOM LINER
VT-3	3.70	INSTALLED TO 1.0m ABOVE ELEVATION OF BOTTOM LINER
VT-4	5.95	INSTALLED THROUGH CENTRELINE BERM TO INVERT OF KEY TRENCH

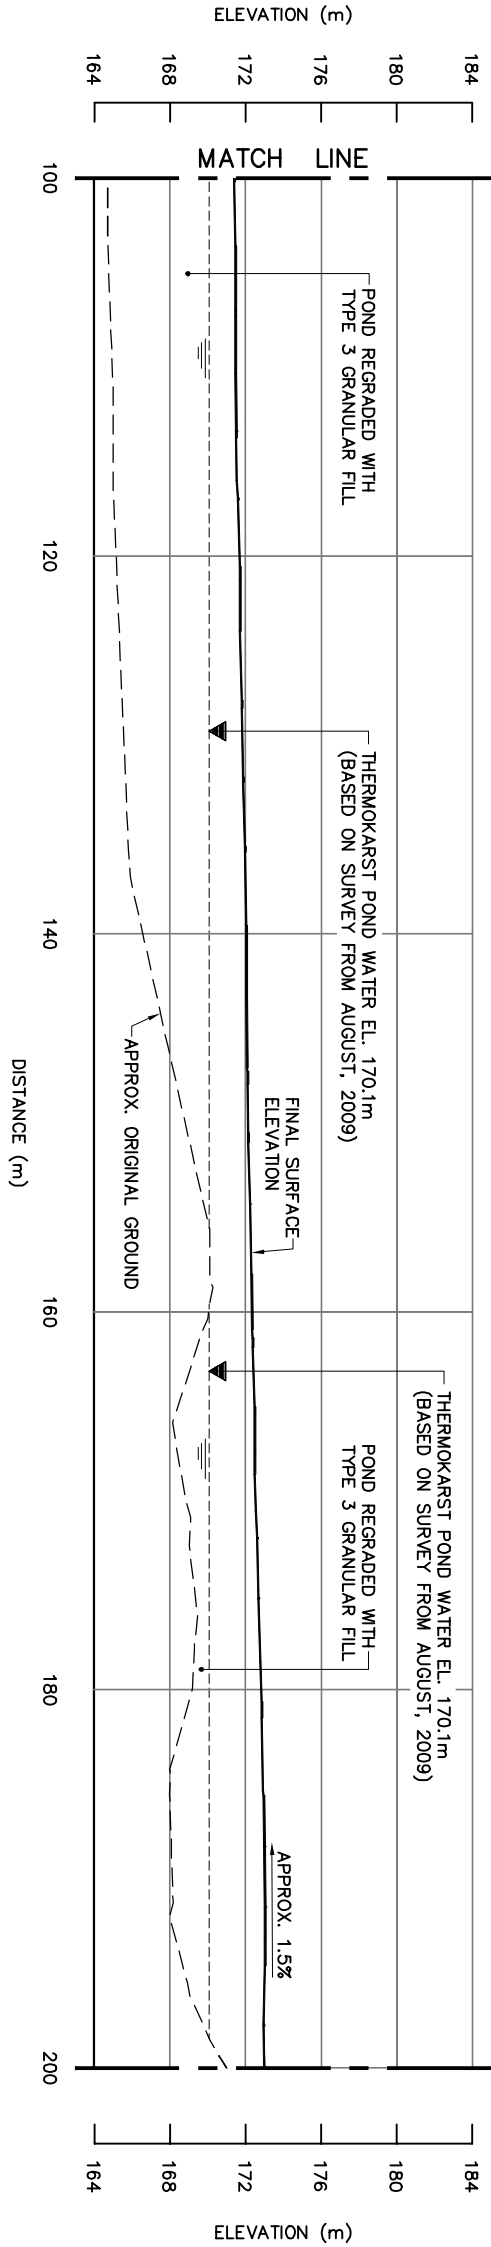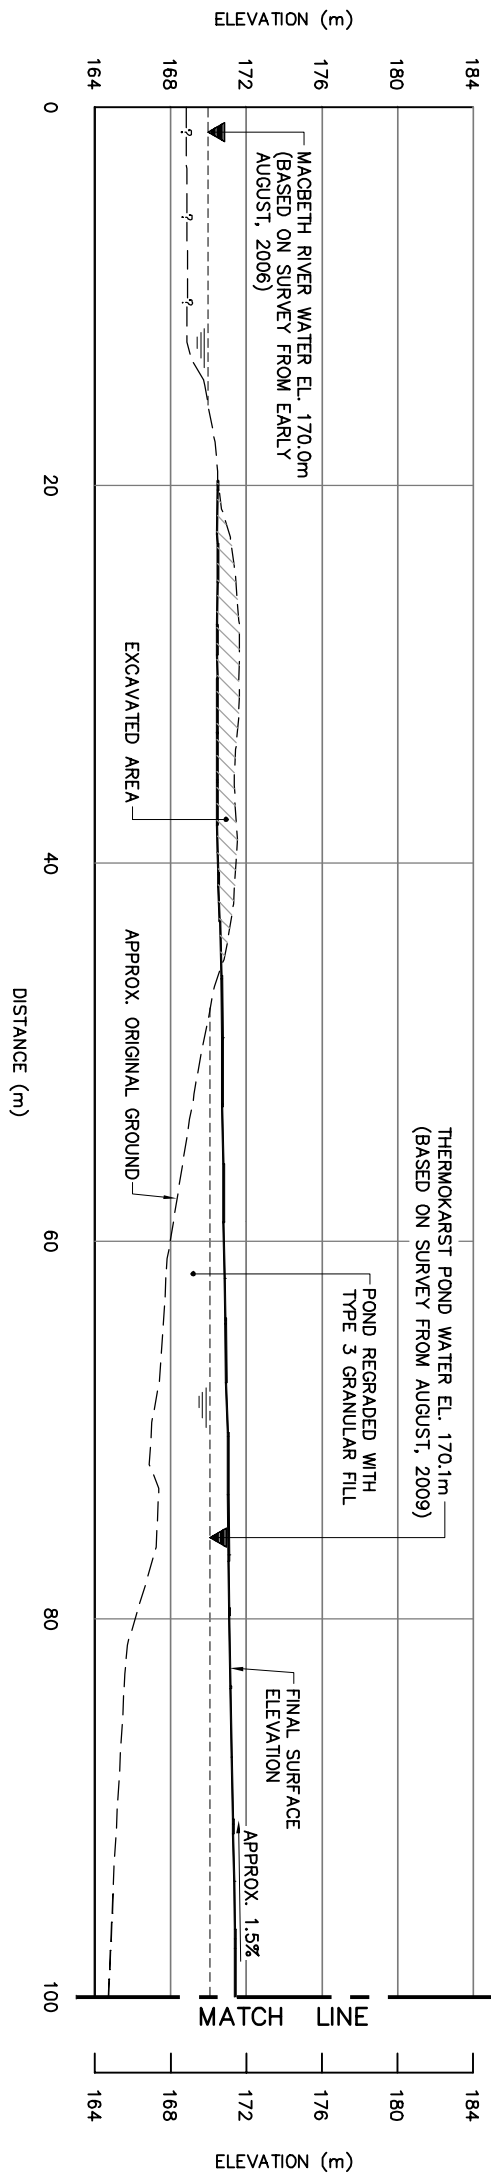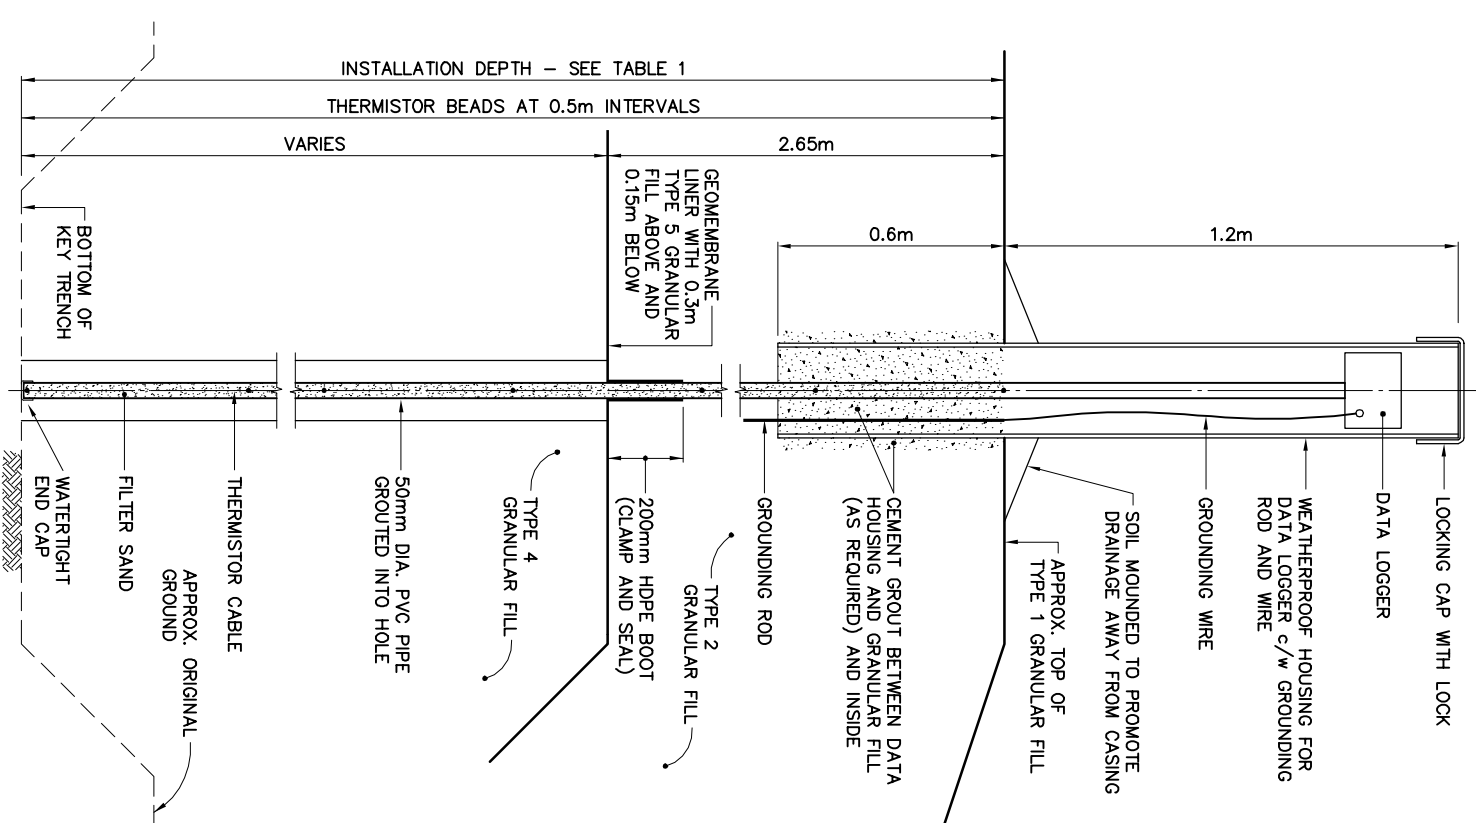


TYPICAL GROUND TEMPERATURE CABLE

SCALE: NTS

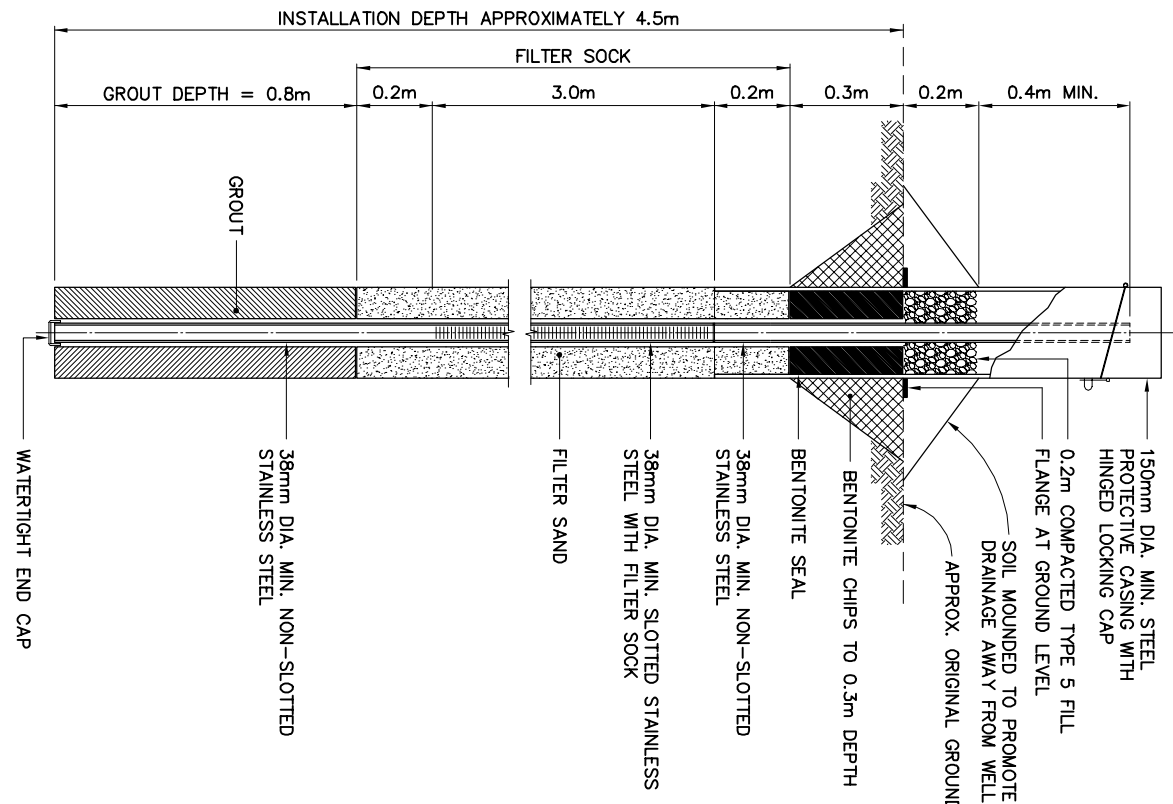


TYPICAL MONITORING WELL

SCALE: NTS
FOR BEDROCK DEPTH > 0.7m
INCLUDING TYPICAL BACKGROUND MONITORING WELL INSTALLATION

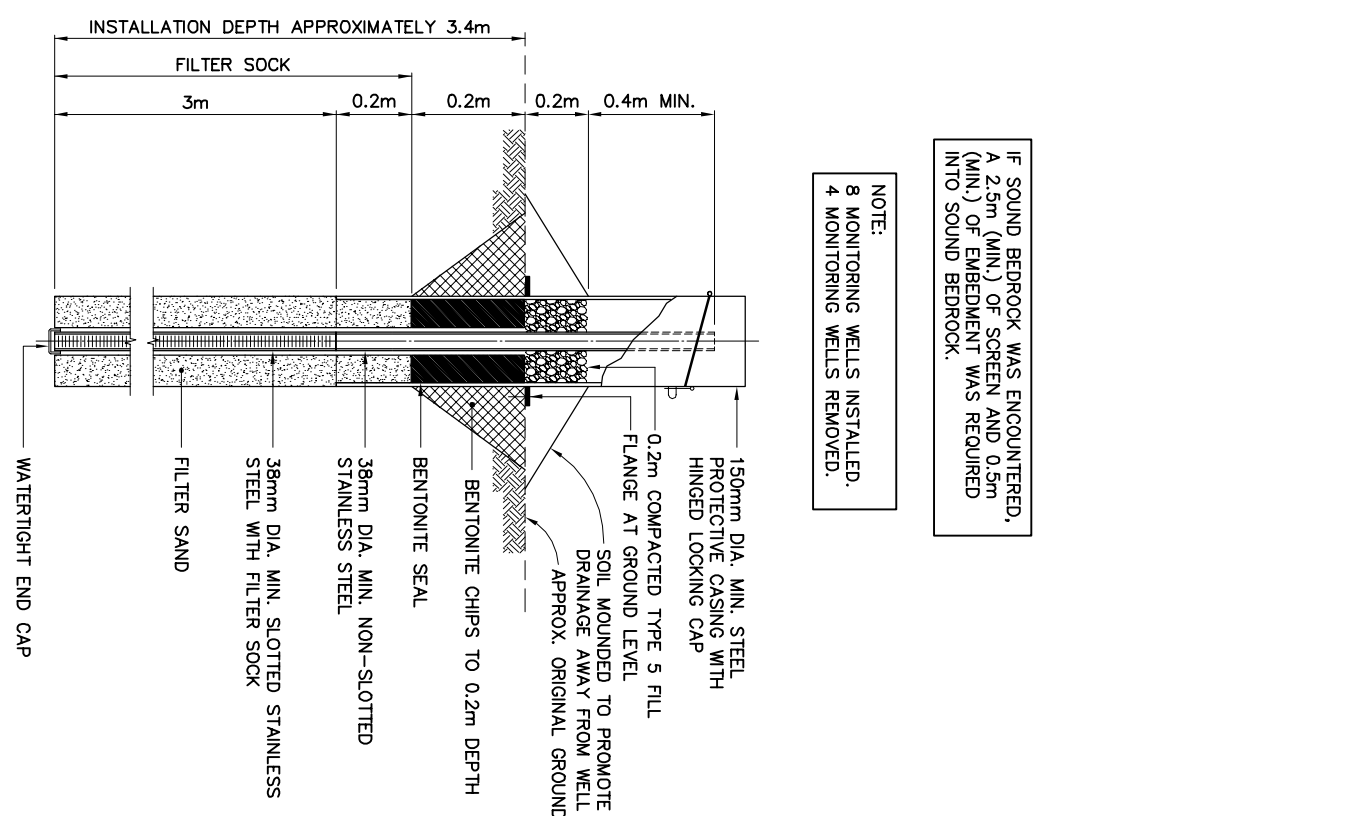

TYPICAL MONITORING WELL

SCALE: NTS
FOR BEDROCK DEPTH < 0.7m
INCLUDING TYPICAL BACKGROUND MONITORING WELL INSTALLATION

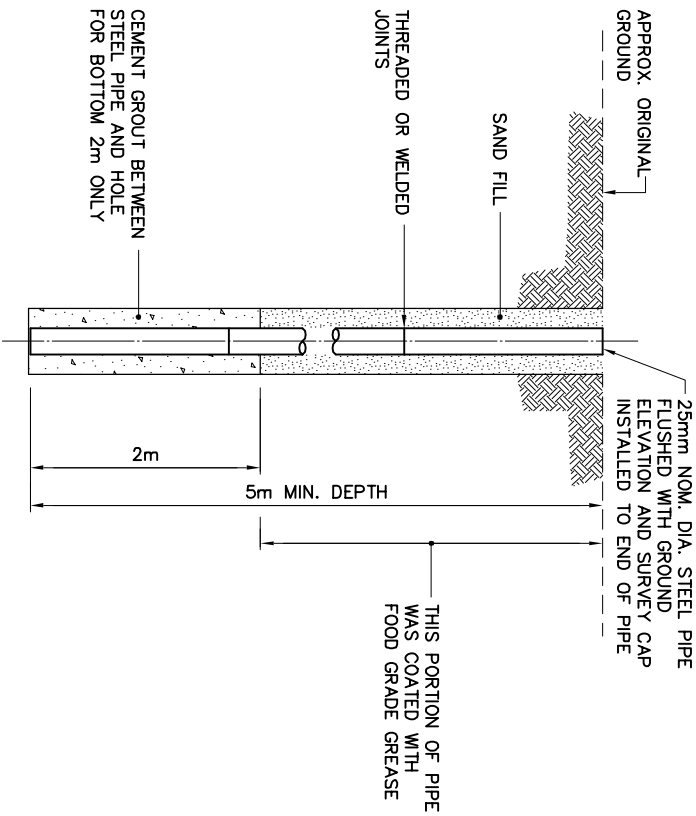

NOTE:
5 PERMANENT SURVEY CONTROL MONUMENTS INSTALLED.

MIN. EMBEDMENT WAS REDUCED IF ROCK WAS ENCOUNTERED. INSTALLATION WAS PENETRATED 2m (MIN.) INTO ROCK.

TYPICAL PERMANENT SURVEY CONTROL MONUMENT

SCALE: NTS
ALSO KNOWN AS PERMANENT BENCHMARK

0	12-10-21	AS-BUILT DRAWING	RAM
No.	DATE	REVISION	APPR.
DRAFT			
AECOM HATCH			
SCALE - EMBEL AS SHOWN			
PROJECT - PROJECT FOX-3 DEWAR LAKES			
DEW LINE CLEAN UP			
© COPYRIGHT HER MAJESTY THE QUEEN IN RIGHT OF CANADA 2012, AS REPRESENTED BY THE MINISTER OF NATIONAL DEFENCE.			
TRADE - METER	SITING	DATE	2007-08-24
SUBJECT - SILET			
MISCELLANEOUS DETAILS SHEET 1			
PRODUCTION	CONCURRENCE - ASSESSMENT	DES. OFF.	AGENT CONCEPT
DESIGNED BY/DATE		SECT. NO.	
DRAWN BY/DATE		CHEF. SECT.	
CHECKED BY/DATE		DES. MGR.	
VERIFIED BY/DATE		TEST CONCEPT	
COORDINATION	REVIEWED - REVU		
DWG. NO. - DESSN NO.	H-0677/1-9101-129		

Canada

1. ALL DIMENSIONS ARE IN METRES UNLESS NOTED OTHERWISE.
2. ALL STRUCTURES DESIGNATED FOR DEMOLITION WERE DEMOLISHED TO TOP OF CONCRETE FOUNDATIONS UNLESS NOTED OTHERWISE.
3. ALL CONCRETE PADS REMAINING WERE REINFORCED AS PER TYPICAL DETAIL, SEE DWG. H-06/11-9101-201.
4. ALL LONG RANGE RADAR (LRR) FACILITIES WERE OPERATIONAL. THESE INCLUDE ALL BUILDINGS, STRUCTURES, ELECTRICAL POWER CABLES, FUEL STORAGE TANKS AND PIPELINES NOT SCHEDULED FOR DEMOLITION.
5. PIPELINES AND ANCILLARY EQUIPMENT REMOVED INCLUDED ALL ASSOCIATED PIPE SUPPORTS AND PIPELINE MARKERS.

	DEMOLISHED
	CONCRETE PAD REGRADED
	UTILITY POLE REMOVED
	BODY OF WATER

0	12-10-22	AS-BUILT DRAWING		RM
No.	DATE	REVISION	REVISION	APPR.

AECOM **HATCH**



FOX-3 DEMAR LAKES

DEW LINE CLEAN UP

© COPYRIGHT
HER MAJESTY THE QUEEN IN RIGHT OF
CANADA 2012, AS REPRESENTED BY THE
MINISTER OF NATIONAL DEFENCE.


TRADE - METIER	DATE
STRUCTURAL	2007-08-24

STATION AREA DEMOLITION SITE PLAN

PRODUCTION	CONCURRENCE – ASSIGNMENT
DESIGNED <i>DAH</i>	DES OFF
ETUDE	AGENT CONCEPT
DRAWN <i>DD</i>	SECT HD
DESINE	CHEF SECT
CHECKED <i>RRH</i>	DES MGR
VERINE	BEST CONCEPT
COORDINATION <i>SMS</i>	REVIEWED – REVU


DWG. NO. - DESSIN NO.
H-D67/1-9101-201

Canada

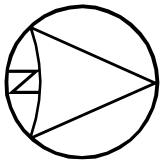

TYPICAL CONCRETE PAD REGRADING DETAIL

SCALE: NTS

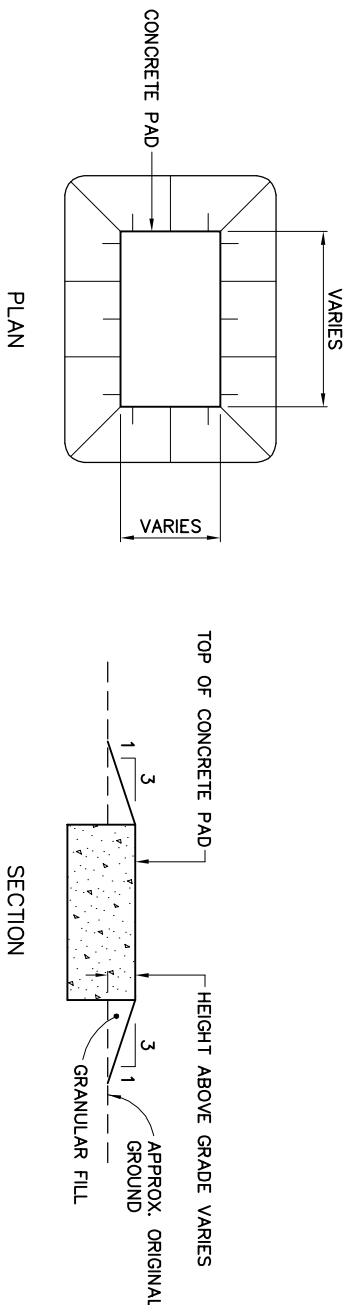

General Notes:

1. ALL DIMENSIONS ARE IN METRES UNLESS NOTED OTHERWISE.
2. ALL STRUCTURES DESIGNATED FOR CONCRETE SHALL BE CONSIDERED TO BE CONCRETE UNLESS NOTED OTHERWISE.
3. ALL CONCRETE P/OS REMAINING WERE REINFORCED AS PER TYPICAL DETAIL. SEE DWG. H-06/11-9101-201.
4. ALL LONG RANGE RADAR (LRR) FACILITIES WERE OPERATIONAL. RADAR INCLUDES ALL BUILDINGS, STRUCTURES, ELECTRICAL POWER CABLES, FUEL STORAGE TANKS AND PIPELINES NOT SCHEDULED FOR DEMOLITION.
5. PIPELINES AND AUXILIARY EQUIPMENT REMOVED INCLUDED ALL ASSOCIATED PIPE SUPPORTS AND PIPELINE MARKERS.

Legend:



DEMOLISHED

0	12-10-22	AS-BUILT DRAWING		RM
No.	DATE	REVISION	REVISION	APPR.

DRAFT

ALCOM **HATCH**

SCALE - ECHELLE 20 10 0 20 40 60m

FOX-3 DEWAR LAKES

DEW LINE CLEAN UP

© COPYRIGHT
HER MAJESTY THE QUEEN IN RIGHT OF
CANADA 2012, AS REPRESENTED BY THE
MINISTER OF NATIONAL DEFENCE.

TRADE - METTER	DATE
STRUCTURAL	2007-08-24

**AIRSTRIP AREA
DEMOLITION SITE PLAN**

PRODUCTION	CONCURRENCE - ASSIGNMENT	
DESIGNED <i>ARM</i>	DES OFF	
E-FLIDE	AGENT CONCEPT	
DRAWN	SECT HD	
DESIGNE	CHEF SECT	
CHECKED	DES MGR	
VERIFIE	GEST CONCEPT	
COORDINATION <i>JMS</i>	REVIEWED - REVU	

DWG. NO. - DESSIN NO.
H-D67/1-9101-202

Canada

