

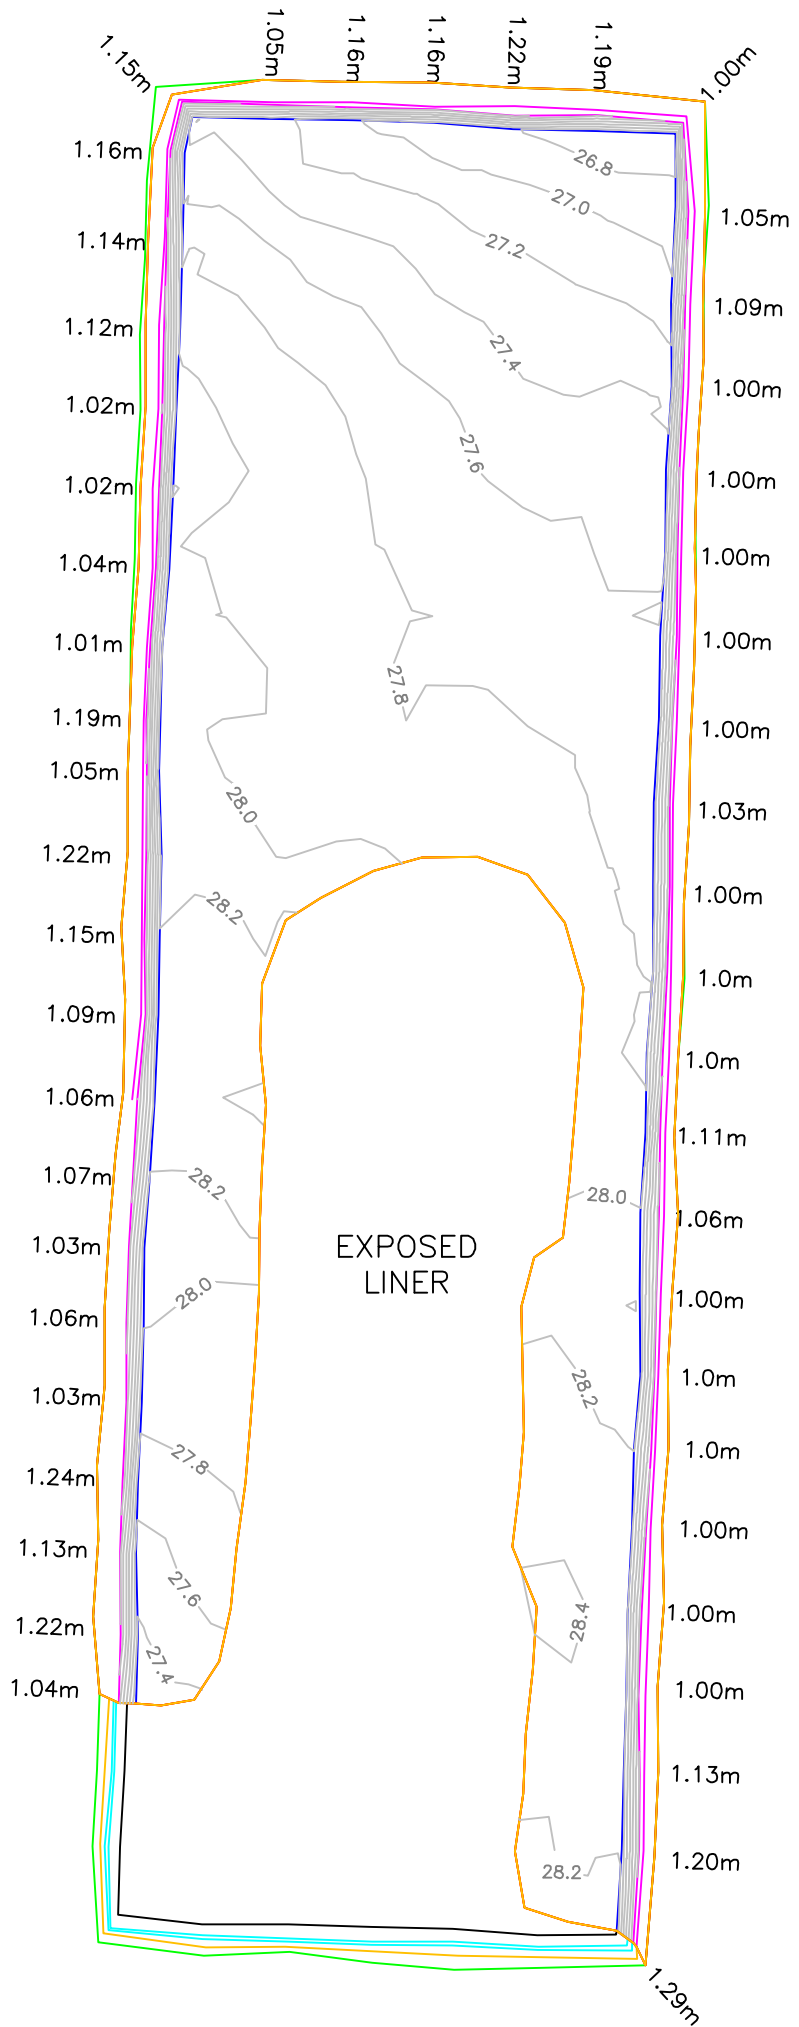


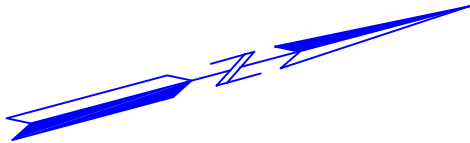

NOTES: LTU BERM VERTICAL HEIGHT
FROM LINER COVER LAYER
OF GRANULAR MATERIAL
IS SHOWN.

LTU TOE TO TOE
DIMENSIONS 67M X 240M

LTU POST LINER INSTALLED
DEMARCATON GRAVEL
PLACED = 2,414 CU. M.

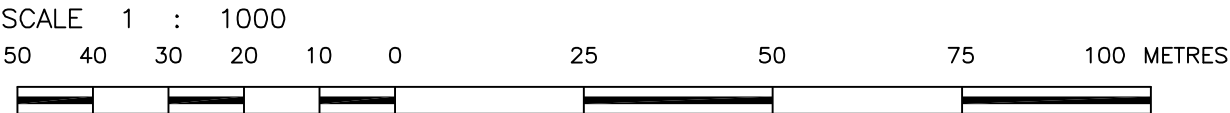

DATE OF SURVEY: OCTOBER 6, 2014



SUB-ARCTIC SURVEYS LTD.
P.O. BOX 2441
226 UTSINGI DRIVE
YELLOWKNIFE, NT. X1A 2P8
PHONE: (867) 873-2047
WEB PAGE: www.sub-arctic.ca
E-MAIL: sas@sub-arctic.ca

PROJECT NO.: 14-075-GI
FILE NO.:
LTU-DTM-ASBLT_POST-LINER

DATE: OCT. 8, 2014

SCALE: 1:1000

PREPARED BY: PV

UPLOGIAQ INC.
AS-BUILT SURVEY OF
INSTALLED LINER
CAMBRIDGE BAY - NU