

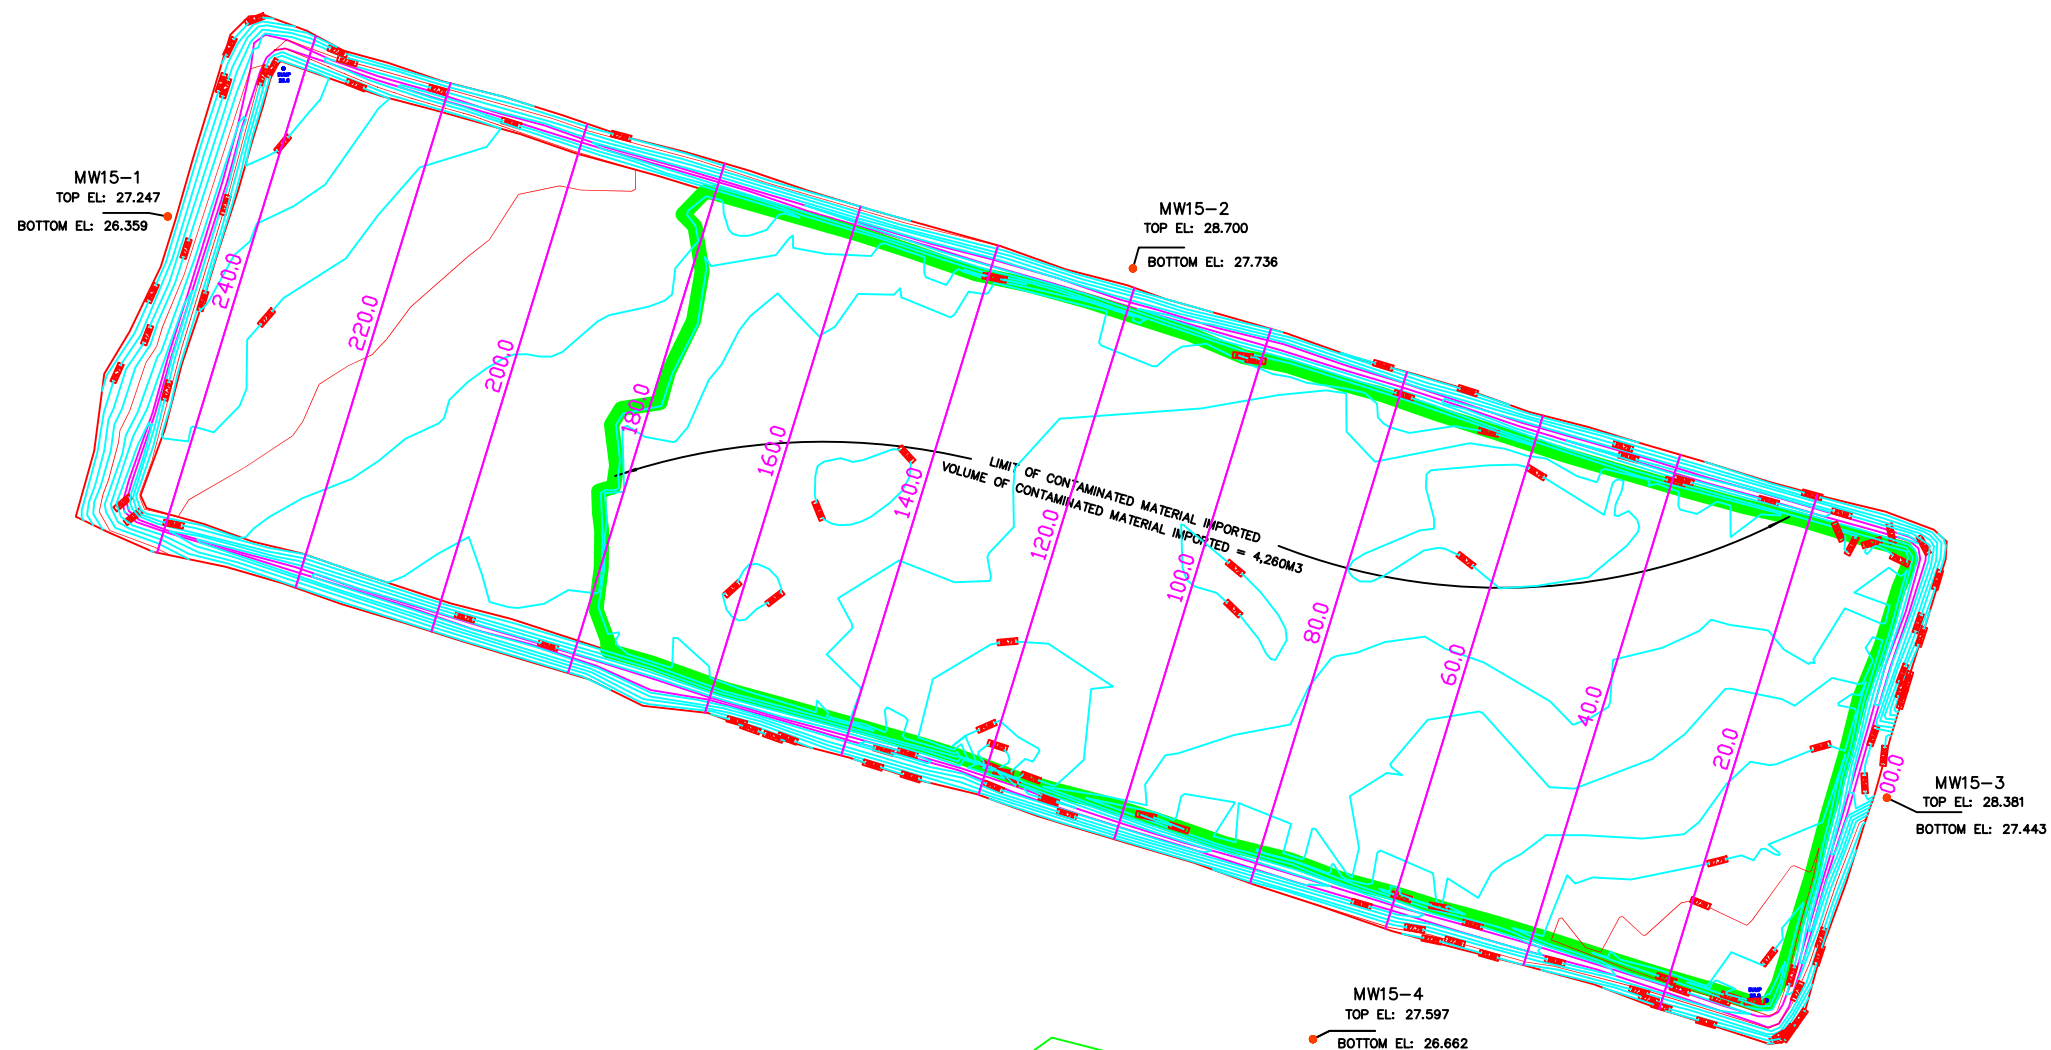


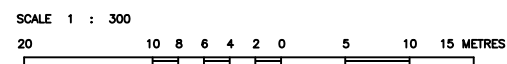

TOTAL FILL MATERIAL VOLUME FOR CONTAMINATED AREA = 5,125M3
(INCLUDING POSSITIVE GRADE CAPPING MATERIAL TO CREATE DRAINAGE))

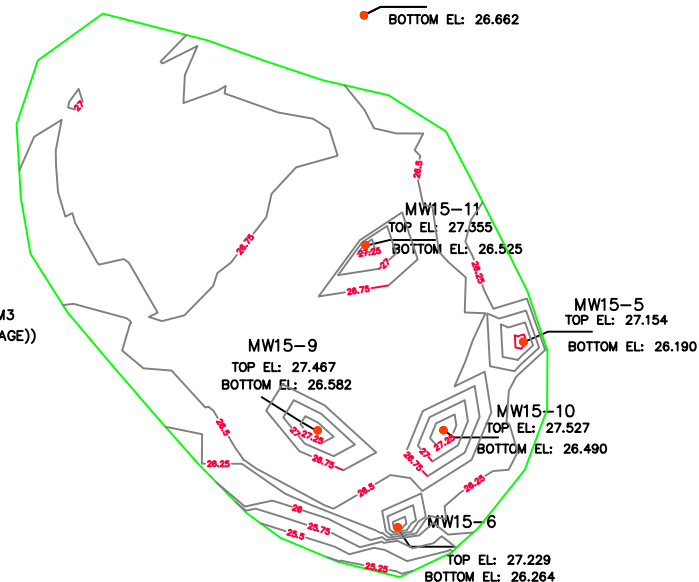

NO.	REVISION\ISSUE	DATE:

DRAWN BY: M.W.
CHECKED BY: M.W.

UPLOGIAQ Inc

AS-BUILT LTU
SHOWING
CONTAMINATED MATERIAL
IMPORTED
CAMBRIDGE BAY - NU

PROJECT NO.: 14-075-GI
FILE NO.:
DATE: SEPTEMBER 4, 2015
SCALE: 1:300