

LEGEND:

- SURVEY CONTROL MONUMENT
- TEMPORARY BENCHMARK
- COORDINATE POINT
- MONITORING SOIL SAMPLE LOCATION
- MONITORING WELL LOCATION
- VERTICAL THERMISTOR LOCATION


NOTE: DRAWING TO BE UPDATED BASED ON RECORD INFORMATION

TIER II LANDFILL COORDINATE POINTS		
NO.	COORDINATES	
	NORTHING	EASTING
2010	7 626 670.849	490 983.803
2011	7 626 747.784	491 070.866
2012	7 626 869.044	491 144.560
2013	7 626 865.734	491 080.125
2014	7 626 888.397	491 065.030
2015	7 626 897.500	491 024.516
2016	7 626 828.315	490 976.819
2017	7 626 754.320	490 897.711

COORDINATE POINTS (AS-BUILT) VERTICAL THERMISTORS		
NO.	NORTHING	EASTING
VT-1	TBD	TBD
VT-2	TBD	TBD
VT-3	TBD	TBD
VT-4	TBD	TBD
VT-5	TBD	TBD

COORDINATE POINTS (AS BUILT) MONITORING WELLS		
NO.	NORTHING	EASTING
MW-1	7 626 861.7	490 943.6
MW-2	7 626 911.8	491 156.2
MW-3	7 626 757.4	491 132.6
MW-4	7 626 822.0	490 996.7
MW-5	7 626 715.5	490 897.5

DEW LINE CLEAN UP
LANDFILL MONITORING PLAN
FOX-M HALL BEACH
TIER II DISPOSAL FACILITY
FIGURE FOX-M.6

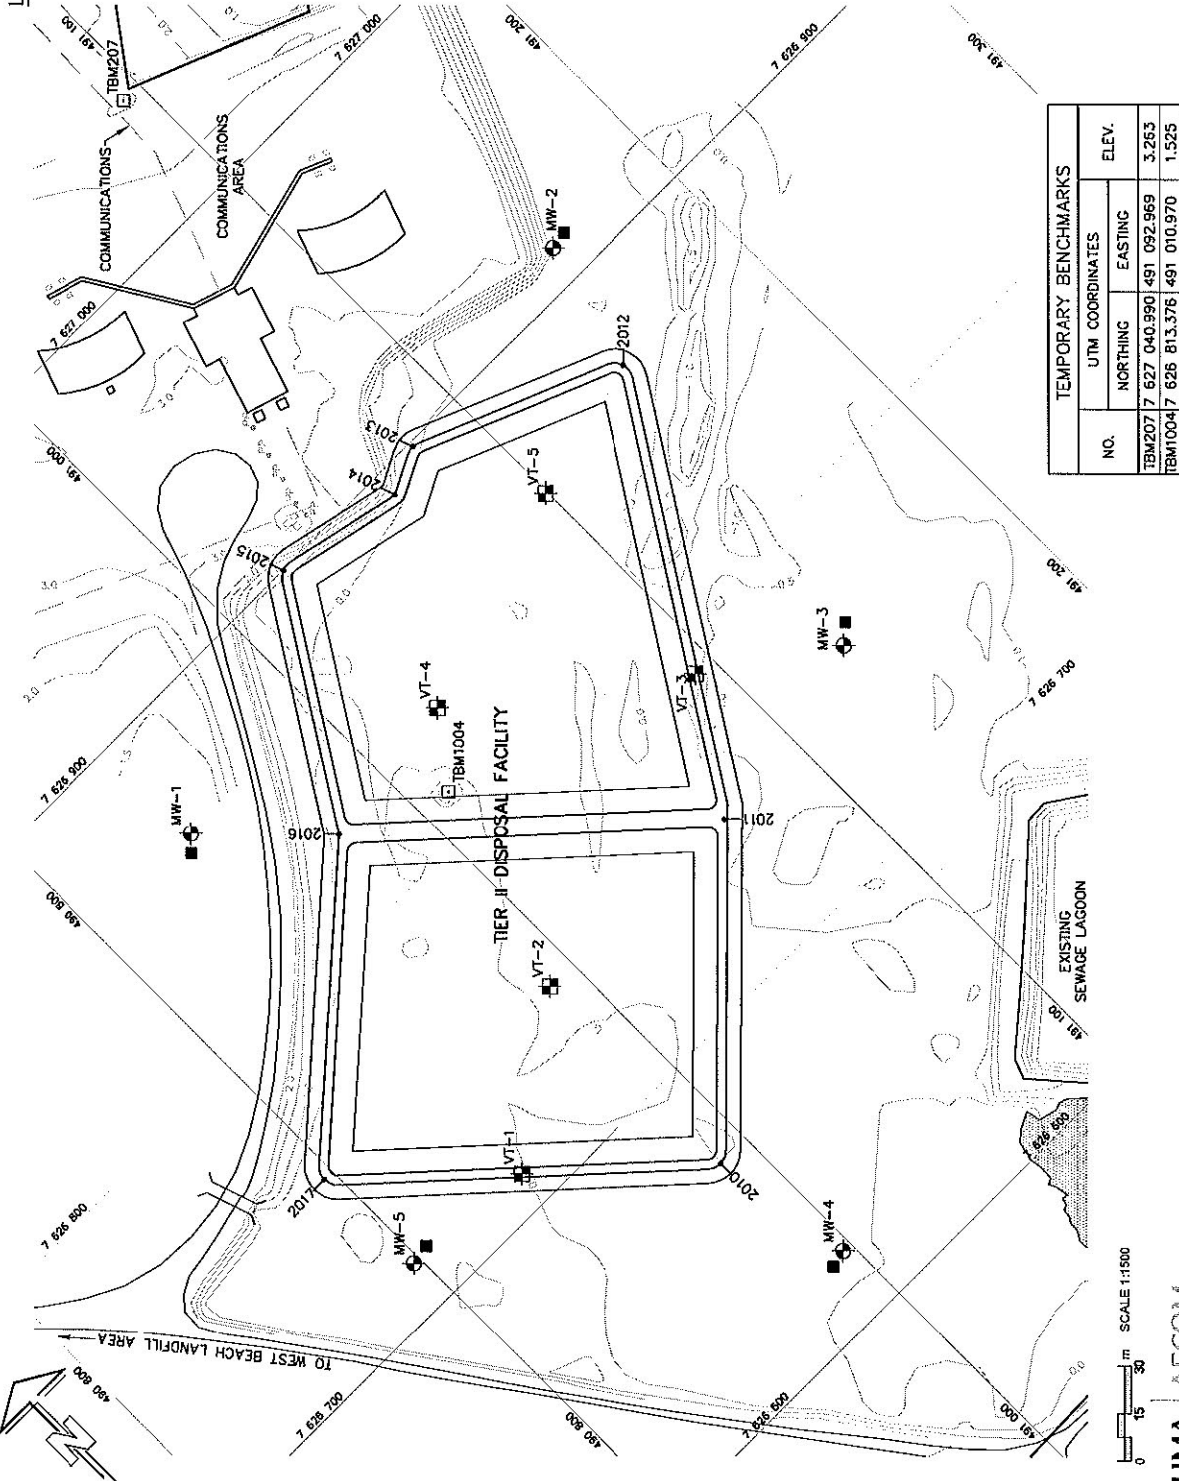

TEMPORARY BENCHMARKS		
NO.	UTM COORDINATES	
	NORTHING	EASTING
TBM207	7 627 040.990	491 092.969
TBM1004	7 626 813.376	491 010.970

SCALE 1:1500

UMA AECOM