


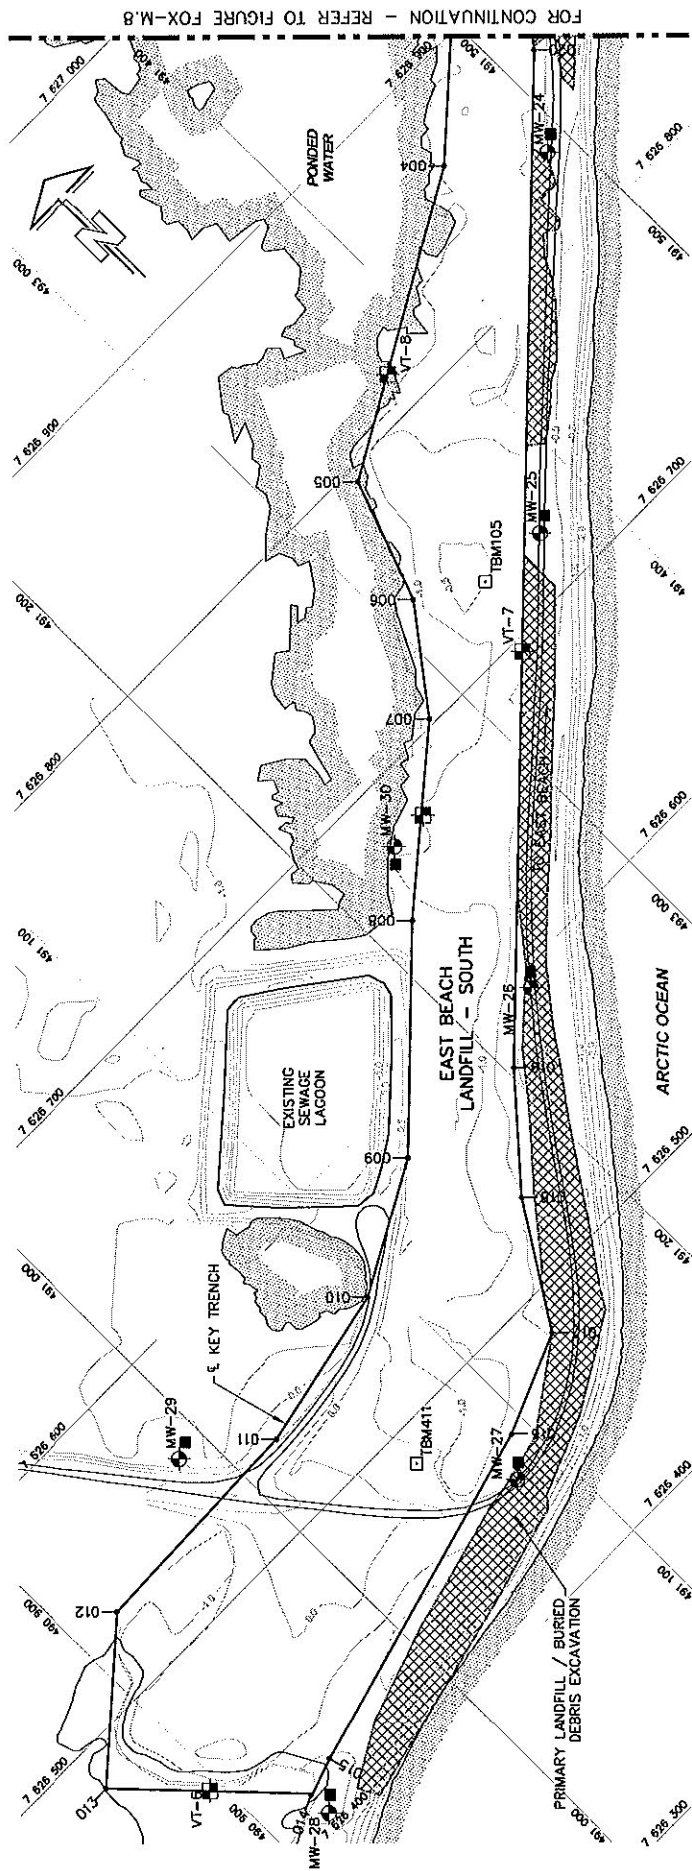

FOR CONTINUATION - REFER TO FIGURE FOX-M.8

LEGEND:

- △ SURVEY CONTROL MONUMENT
- TEMPORARY BENCHMARK
- ◀-2002 COORDINATE POINT
- MONITORING SOIL SAMPLE LOCATION
- ⊕ MONITORING WELL LOCATION
- ⊞ VERTICAL THERMISTOR LOCATION

SCALE 1:2000

COORDINATE POINTS (AS BUILT)			
NO.	MONITORING WELLS		ELEV.
	NORTHING	EASTING	
MW-24	7 626 835.4	491 488.8	0.01
MW-25	7 626 724.5	491 371.8	0.24
MW-26	7 626 592.2	491 232.3	0.57
MW-27	7 626 450.3	491 080.3	-0.10
MW-28	7 626 407.7	490 923.9	-0.42
MW-29	7 626 558.2	490 985.7	-0.03
MW-30	7 626 575.1	491 234.0	-1.03

COORDINATE POINTS (AS-BUILT) VERTICAL THERMISTORS			
NO.	NORTHING		EASTING
	TBD	TBD	TBD
VT-6	TBD	TBD	TBD
VT-7	TBD	TBD	TBD
VT-8	TBD	TBD	TBD

TEMPORARY BENCHMARKS			
NO.	UTM COORDINATES		ELEV.
	NORTHING	EASTING	
TBM106	7 627 001.134	491 547.332	-1.054
TBM411	7 626 485.282	491 055.174	-0.112

KEY TRENCH CENTRELINE COORDINATE POINTS					
NO.	COORDINATES		NO.	COORDINATES	
	NORTHING	EASTING		NORTHING	EASTING
004	7 626 920.9	491 555.4	013	7 626 531.6	490 921.2
005	7 626 869.8	491 515.5	014	7 626 534.5	491 020.7
006	7 626 573.7	491 203.2	015	7 626 549.3	491 090.4
007	7 626 533.0	491 155.5	016	7 626 578.7	491 144.6
008	7 626 483.2	491 134.6	017	7 626 647.8	491 217.0
009	7 626 465.4	491 092.2	018	7 626 702.3	491 282.6
010	7 626 423.8	490 940.3	019	7 626 742.8	491 314.0
011	7 626 418.4	490 924.9	020	7 626 794.3	491 332.9
012	7 626 482.1	490 864.6			

NOTE: DRAWING TO BE UPDATED BASED ON RECORD INFORMATION

DEW LINE CLEAN UP
LANDFILL MONITORING PLAN
FOX-M BROUGHTON ISLAND
EAST BEACH LANDFILL - SOUTH
FIGURE FOX-M.7