


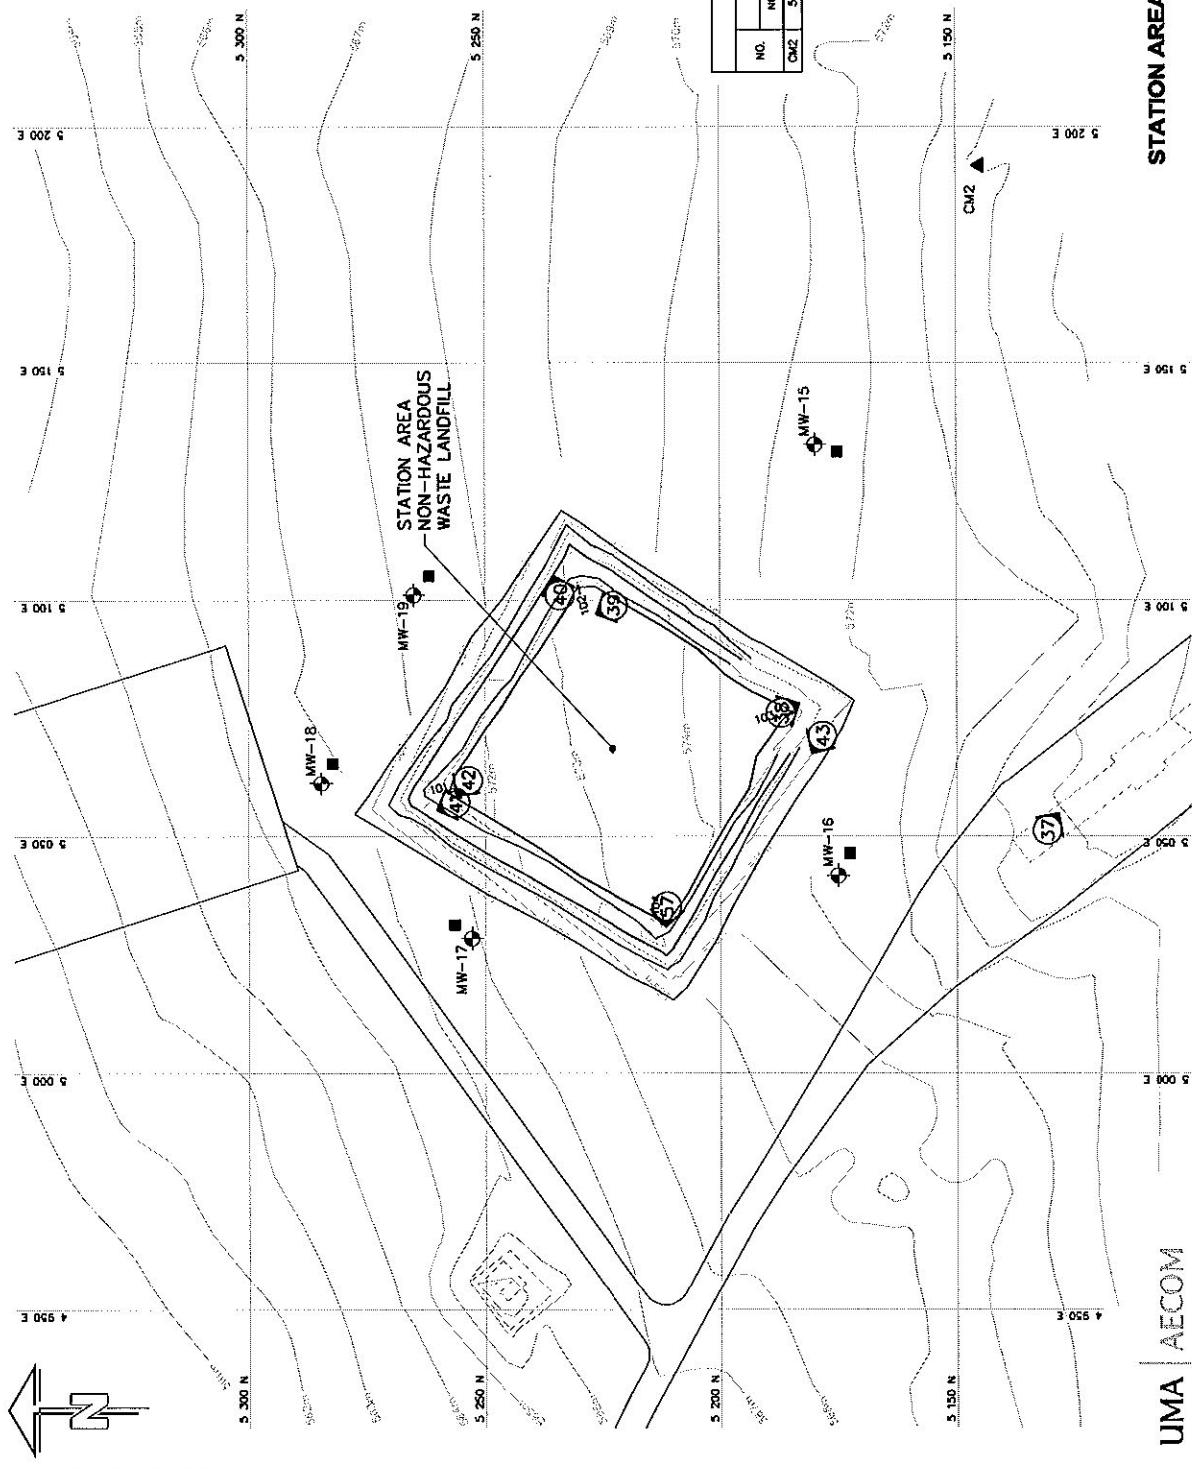

LEGEND:

- TBM4 □ TEMPORARY BENCHMARK
- BM-1 ▲ PERMANENT BENCHMARK
- 10+~ COORDINATE POINT
- MONITORING SOIL SAMPLE LOCATION
- MONITORING WELL LOCATION
- 39 PHOTOGRAPHIC VIEWPOINT

COORDINATE POINTS (AS BUILT) NON-HAZARDOUS WASTE LANDFILL			
NO.	NORTHING	EASTING	ELEV.
101	5 257.7	5 059.3	571.4
102	5 250.2	5 102.8	573.5
103	5 185.1	5 076.2	574.6
104	5 212.3	5 031.6	573.5

COORDINATE POINTS (AS BUILT) MONITORING WELLS			
NO.	NORTHING	EASTING	ELEV.
MW-15	5 180.1	5 132.8	571.50
MW-16	5 175.2	5 041.7	570.53
MW-17	5 232.9	5 028.5	567.00
MW-18	5 284.7	5 061.5	565.62
MW-19	5 285.1	5 101.2	567.33

SURVEY CONTROL MONUMENTS			
NO.	COORDINATES		ELEV.
	NORTHING	EASTING	
CM2	5 145.012	5 191.951	574.530 FOX-S BASELINE STA. -2+07.90

SCALE 1:1000

0 10 20 30 m

RECORD DRAWING
NOT FOR CONSTRUCTION

DEW LINE CLEAN UP
LANDFILL MONITORING PLAN
FOX-5 BROUGHTON ISLAND
STATION AREA NON-HAZARDOUS WASTE LANDFILL
FIGURE FOX-5.2