


L K S T M D C B A


G:\CD8228\2010\LOGISTICS\CAM-2\C8228_001_110-CAM-2_F.dwg, PL, 2010-05-27 12:32:57

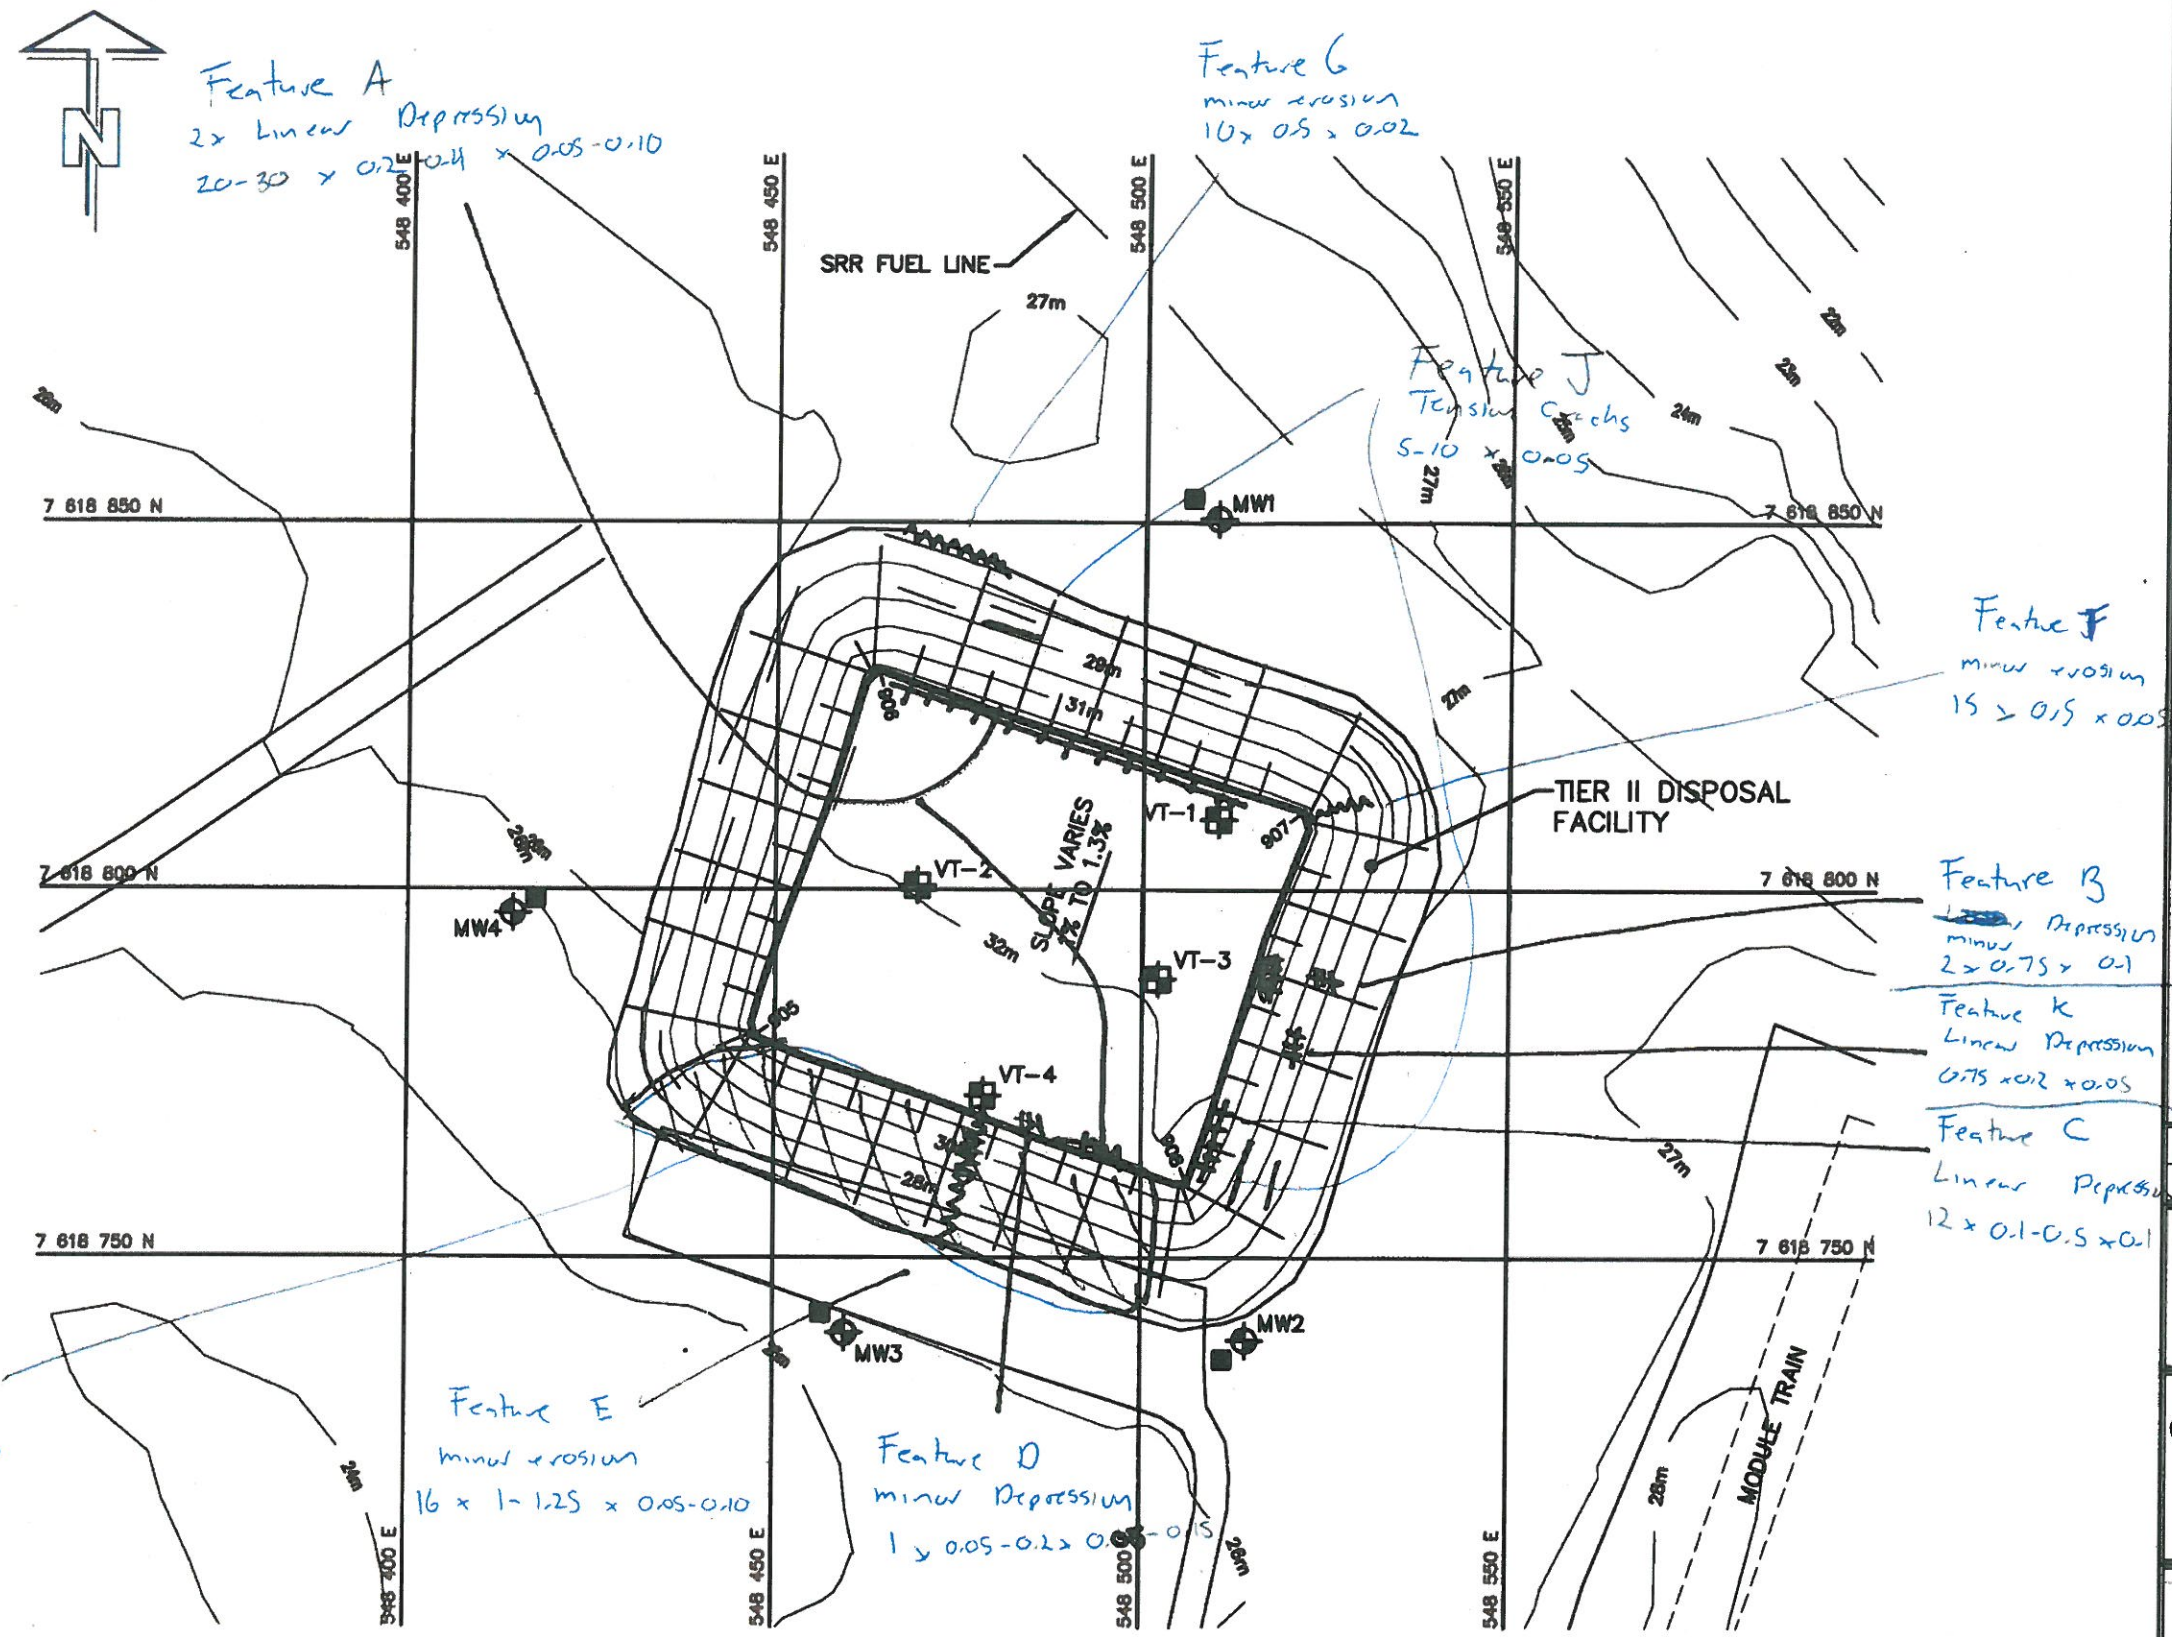

LEGEND

- 101- COORDINATE POINT
- MONITORING SOIL SAMPLE LOCATION
- MONITORING WELL LOCATION
- VERTICAL THERMISTOR LOCATION
- 1740 BASELINE SOIL SAMPLE LOCATION
- EROSION (NTS)
- TENSION CRACK (NTS)

H-I

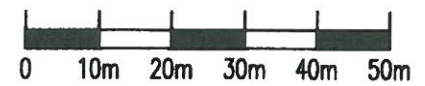

A	FINAL VERSION	10-05-27	PL	EG	JPP
NO.	VERSION	DATE	BY	VERIF.	APPR.



Construction de Défense Canada
Defence Construction Canada

LOGISTICS PLAN
COLLECTION OF LANDFILL MONITORING DATA
CAM-2, KITIKMEOT REGION (NUNAVUT)
TIER II DISPOSAL
FACILITY

SITE REMEDIATION SOLUTIONS

Biogenie, a division of EnGlobe Corp.
4485 Wilfrid-Hamel Blvd., Suite 200
Quebec (Quebec) CANADA G1P 2J7
Phone: (418) 653-4422 Fax: (418) 653-3583



MEASUREMENT UNIT	SCALE	DATE (month-year)
Metre	1 : 1,000	JUNE 2010
DRAWN BY:	VERIFIED BY:	APPROVED BY:
P. LÉGARÉ	E. CARRIÈRE	J.-P. PELLETIER
PROJECT NO:	DRAWING NO:	PAGE
CD8228_001_110	CD8228_001_110-CAM-2_F	PL

COORDINATE POINTS (AS BUILT) MONITORING WELLS			
NO.	NORTHING	EASTING	ELEV.
MW1	7 618 850.6	548 510.0	27.3
MW2	7 618 738.8	548 514.5	26.1
MW3	7 618 739.8	548 459.7	25.5
MW4	7 618 798.7	548 414.3	28.0

COORDINATE POINTS (AS-BUILT) VERTICAL THERMISTORS	
NO.	EASTING
VT-1	548 510.4
VT-2	548 488.3
VT-3	548 502.1
VT-4	548 478.4