


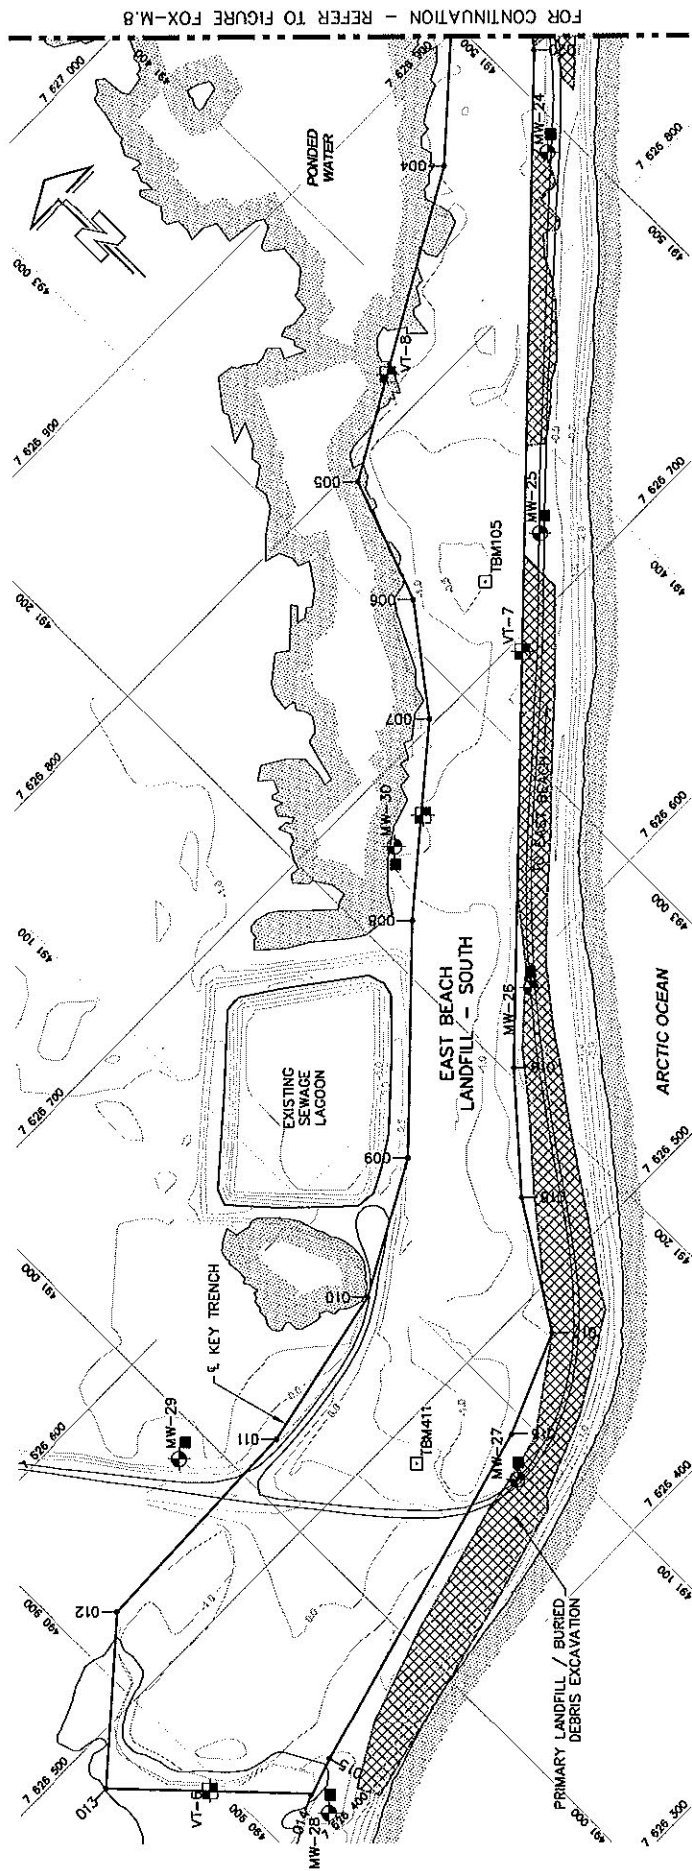

FOR CONTINUATION - REFER TO FIGURE FOX-M.8

LEGEND:

- △ SURVEY CONTROL MONUMENT
- TEMPORARY BENCHMARK
- ◀-2002 COORDINATE POINT
- MONITORING SOIL SAMPLE LOCATION
- ⊕ MONITORING WELL LOCATION
- ⊞ VERTICAL THERMISTOR LOCATION

SCALE 1:2000

COORDINATE POINTS (AS BUILT)			
MONITORING WELLS		ELEV.	
NO.	NORTHING	EASTING	ELEV.
MW-24	7 626 835.4	491 488.8	0.01
MW-25	7 626 724.5	491 371.8	0.24
MW-26	7 626 592.2	491 232.3	0.57
MW-27	7 626 450.3	491 080.3	-0.10
MW-28	7 626 407.7	490 923.9	-0.42
MW-29	7 626 558.2	490 985.7	-0.03
MW-30	7 626 575.1	491 234.0	-1.03

COORDINATE POINTS (AS-BUILT)			
VERTICAL THERMISTORS		EASTING	
NO.	NORTHING	EASTING	ELEV.
VT-6	TBD	TBD	TBD
VT-7	TBD	TBD	TBD
VT-8	TBD	TBD	TBD

TEMPORARY BENCHMARKS			
UTM COORDINATES		ELEV.	
NO.	NORTHING	EASTING	ELEV.
TBM106	7 627 001.134	491 547.332	-1.054
TBM411	7 626 485.282	491 055.174	-0.112

KEY TRENCH CENTRELINE COORDINATE POINTS			
NO.	COORDINATES		ELEV.
	NORTHING	EASTING	
004	7 626 920.9	491 555.4	0.13
005	7 626 869.8	491 515.5	0.14
006	7 626 573.7	491 203.2	0.15
007	7 626 533.0	491 155.5	0.16
008	7 626 483.2	491 134.6	0.17
009	7 626 465.4	491 092.2	0.18
010	7 626 423.8	490 940.3	0.19
011	7 626 418.4	490 924.9	0.20
012	7 626 482.1	490 864.6	

NOTE: DRAWING TO BE UPDATED BASED ON RECORD INFORMATION

DEW LINE CLEAN UP LANDFILL MONITORING PLAN FOX-M BROUGHTON ISLAND EAST BEACH LANDFILL - SOUTH FIGURE FOX-M.7