


A
B
C
D
E
F
G
H
I
J
K
L
M

G:\CD8228\2010\LOGISTICS\CAM-2\CD8228_001_110-CAM-2_E.dwg, PL, 2010-06-27 12:30:58

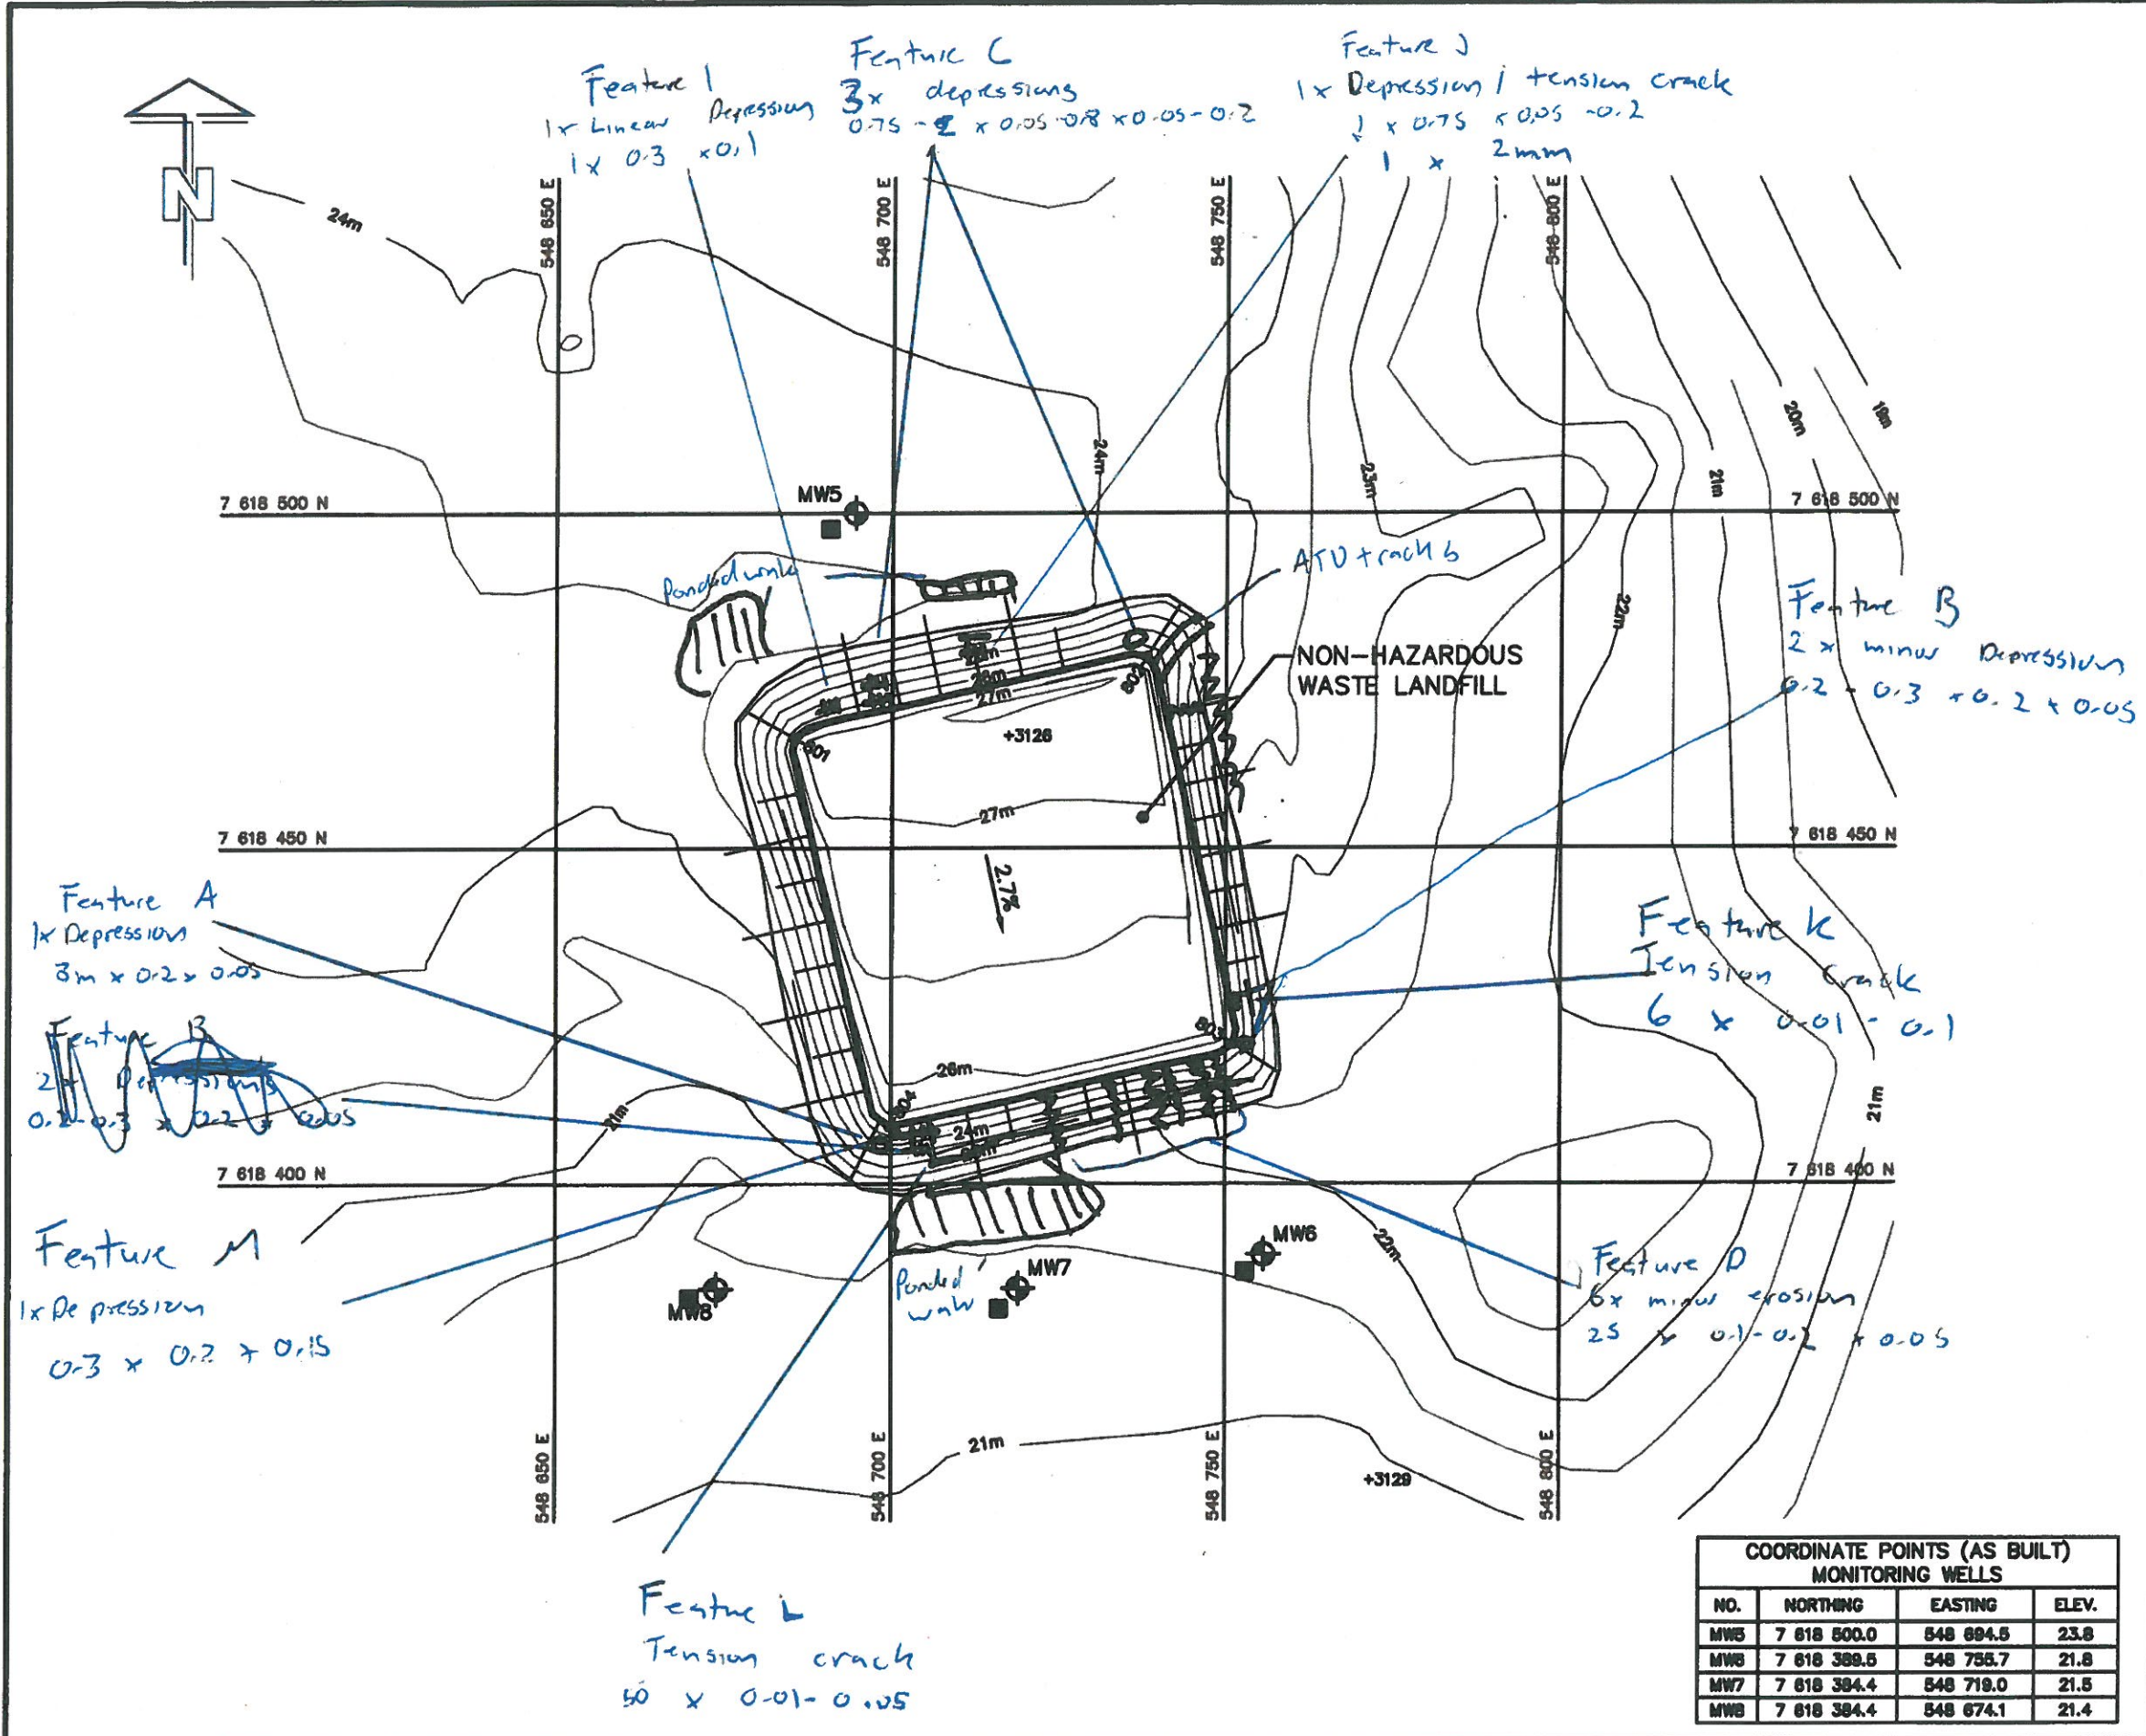

LEGEND

- 101- COORDINATE POINT
- MONITORING SOIL SAMPLE LOCATION
- MONITORING WELL LOCATION
- +1748 BASELINE SOIL SAMPLE LOCATION
- EROSION (NTS)
- TENSION CRACK (NTS)

E-F-G-A-



A	FINAL VERSION	10-05-27	PL	EC	J.P.P.
NO.	VERSION	DATE	BY	VERIF.	APPR.



Construction de Défense Canada
Defence Construction Canada

LOGISTICS PLAN
COLLECTION OF LANDFILL MONITORING DATA
CAM-2, KITIKMEOT REGION (NUNAVUT)
NON-HAZARDOUS
WASTE LANDFILL

SITE REMEDIATION SOLUTIONS



Biogenie, a division of EnGlobe Corp.
4485 Wilfrid-Hamel Blvd., Suite 200
Quebec (Quebec) CANADA G1P 2J7
Phone: (418) 653-4422 Fax: (418) 653-3583

COORDINATE POINTS (AS BUILT) MONITORING WELLS			
NO.	NORTHING	EASTING	ELEV.
MW5	7 618 600.0	548 694.5	23.8
MW6	7 618 389.5	548 756.7	21.8
MW7	7 618 384.4	548 719.0	21.5
MW8	7 618 384.4	548 674.1	21.4

MEASUREMENT UNIT Meter	SCALE 1 : 1,000	DATE (month-year) JUNE 2010
DRAWN BY: P. LEGARE	VERIFIED BY: E. CARRERE	APPROVED BY: J.-P. PELLETIER
PROJECT NO. CD8228_001_110	DRAWING NO. CD8228_001_110-CAM-2_E	PAGE PL