


October 16, 2006 Path: N:\Projects\2008\80297\2008\WorkInProgress\Documents\80297-2_CAM-2-FINAL-Report\ACAD_Files\C2-RD02.dwg Date Plotted:

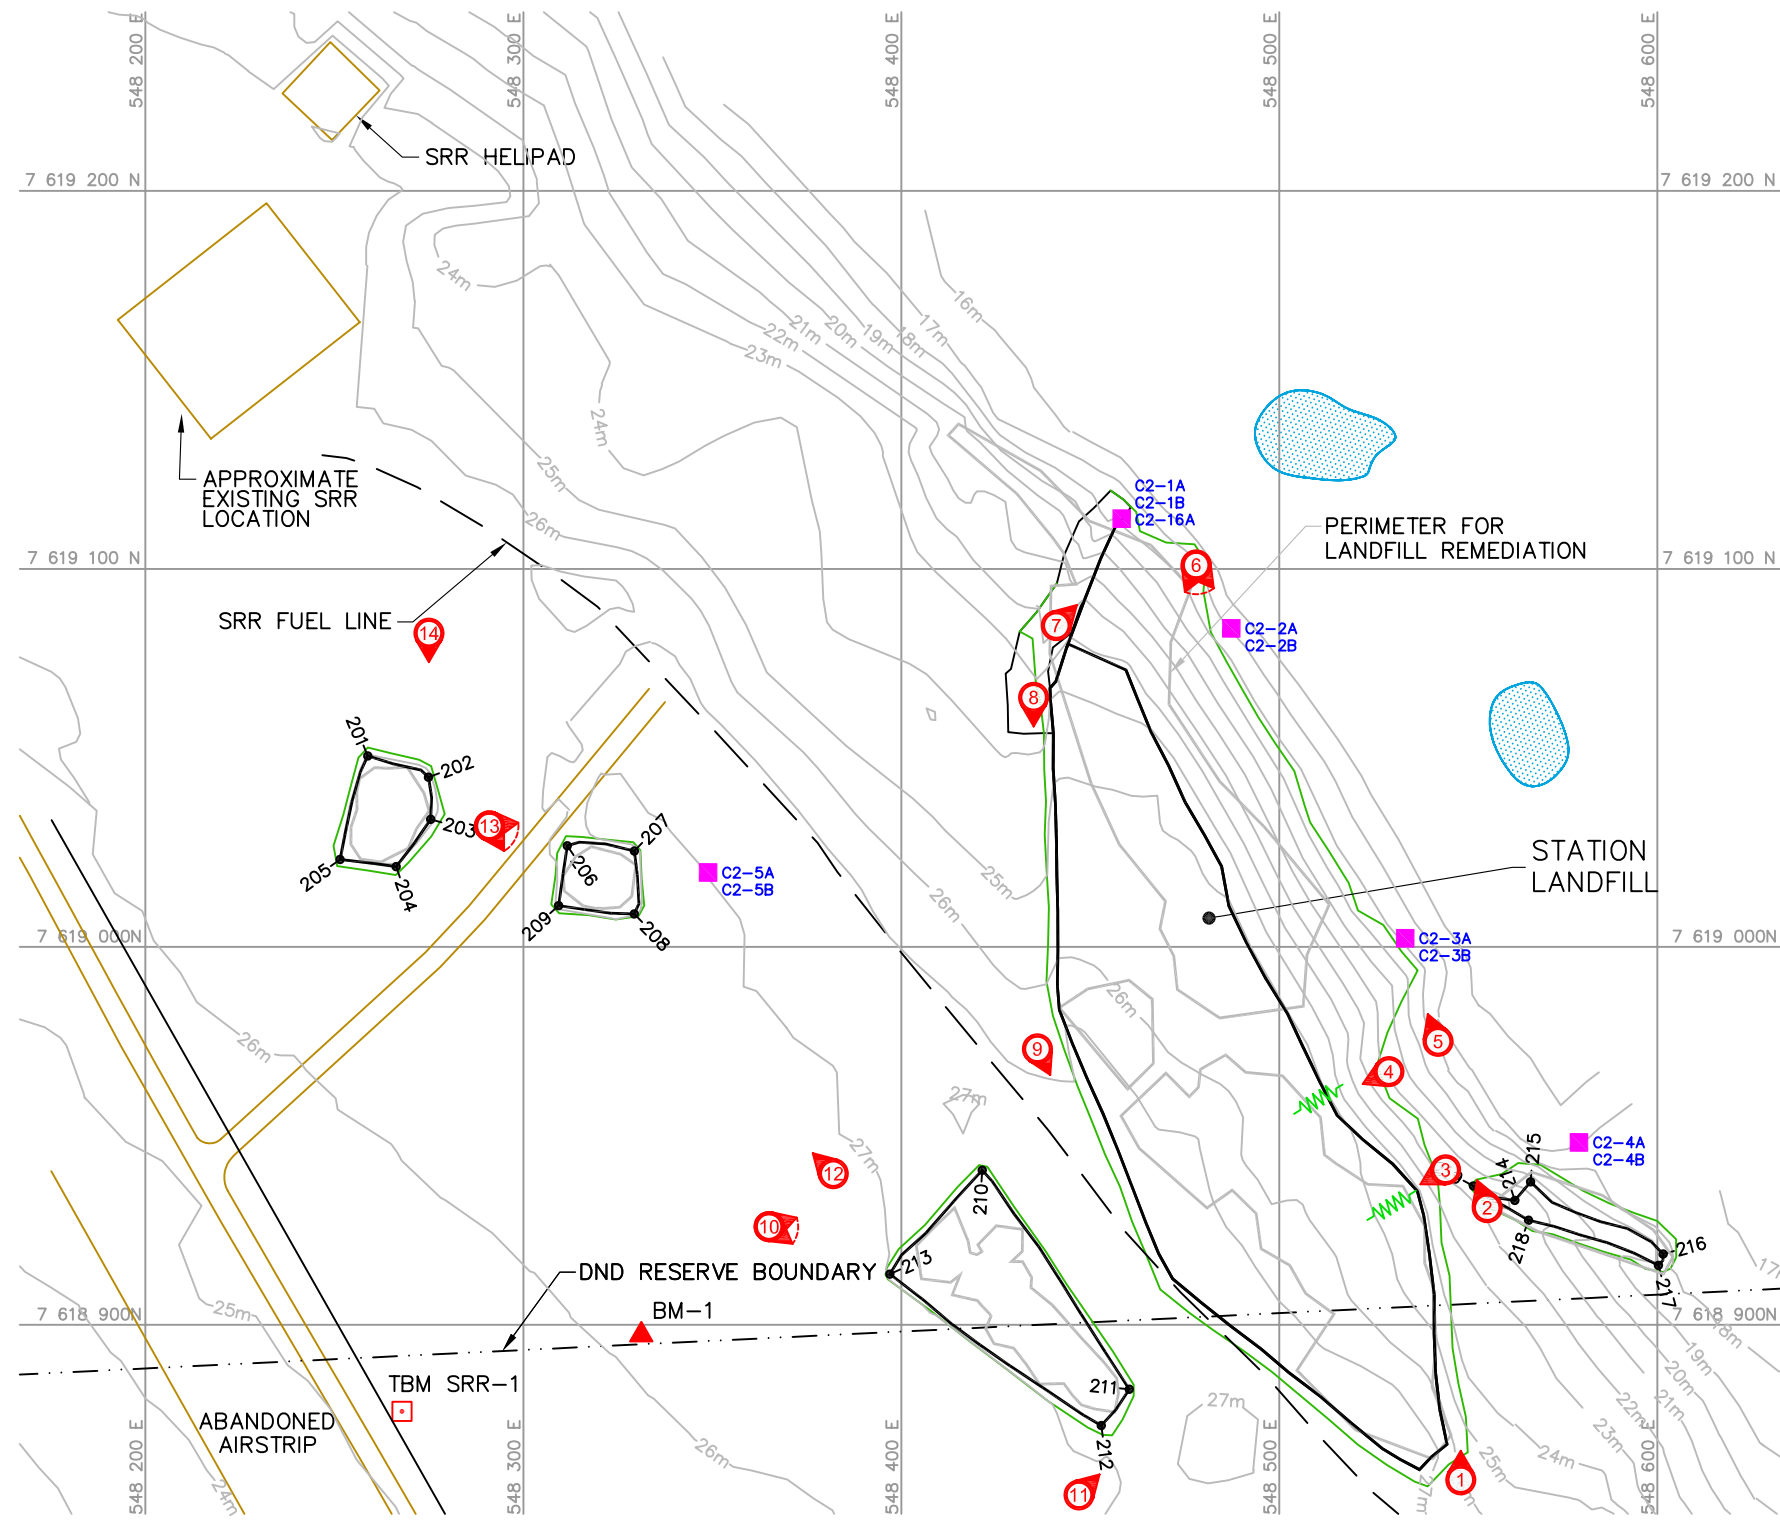

PERMANENT BENCHMARK				
NO.	COORDINATES		ELEV.	DESCRIPTION
	NORTHING	EASTING		
BM-1	7 618 897.363	548 331.191	26.595	25mm DIA. STEEL PIPE
SRR-1	7 618 877.108	548 267.873	24.975	16mm DIA. IRON BAR

- Legend**
- TBM4 □ TEMPORARY BENCHMARK
 - BM-1 ▲ PERMANENT BENCHMARK
 - 101→ COORDINATE POINT
 - C2-5A C2-5B ■ MONITORING SOIL SAMPLE LOCATION
 - ⑦ PHOTOGRAPH LOCATION
 - ~ SURFICIAL EROSION (NTS)

COORDINATE POINTS (AS-BUILT) STATION LANDFILL AREA REGRAVING		
NO.	NORTHING	EASTING
201	7 619 050.5	548 258.8
202	7 619 044.9	548 274.9
203	7 619 033.7	548 275.5
204	7 619 021.2	548 266.3
205	7 619 023.1	548 251.5
206	7 619 026.7	548 311.6
207	7 619 025.4	548 329.4
208	7 619 008.7	548 329.3
209	7 619 010.9	548 309.3
210	7 618 940.9	548 421.4
211	7 618 883.0	548 460.3
212	7 618 873.4	548 452.9
213	7 618 913.4	548 397.0
214	7 618 932.9	548 562.3
215	7 618 937.8	548 566.5
216	7 618 918.8	548 601.5
217	7 618 915.8	548 600.3
218	7 618 927.7	548 565.9
219	7 618 936.8	548 551.3

RECORD DRAWING
NOT FOR CONSTRUCTION

Map Sources / Notes:
Source drawing from UMA: C2-RD02.dwg



0 10 20 40 60 80 m

1 : 2000
UTM Zone 14W, NAD83

File Name: C2-RD02.dwg
Reviewed by: JAT
Date Issued: December, 2008
Prepared by: KAB
Project Number: 80-297

Defence Construction Canada

2008 DEW Line Monitoring Program
CAM-2 Gladman Point
Nunavut Territory

STATION LANDFILL

AECOM

Figure A-1
Version 2