


October 16, 2006 Path: N:\Projects\2008\80297\2008\WorkInProgress\Documents\80297-2_CAM-2-FINAL-Report\ACAD_Files\C2-RD03.dwg Date Plotted:

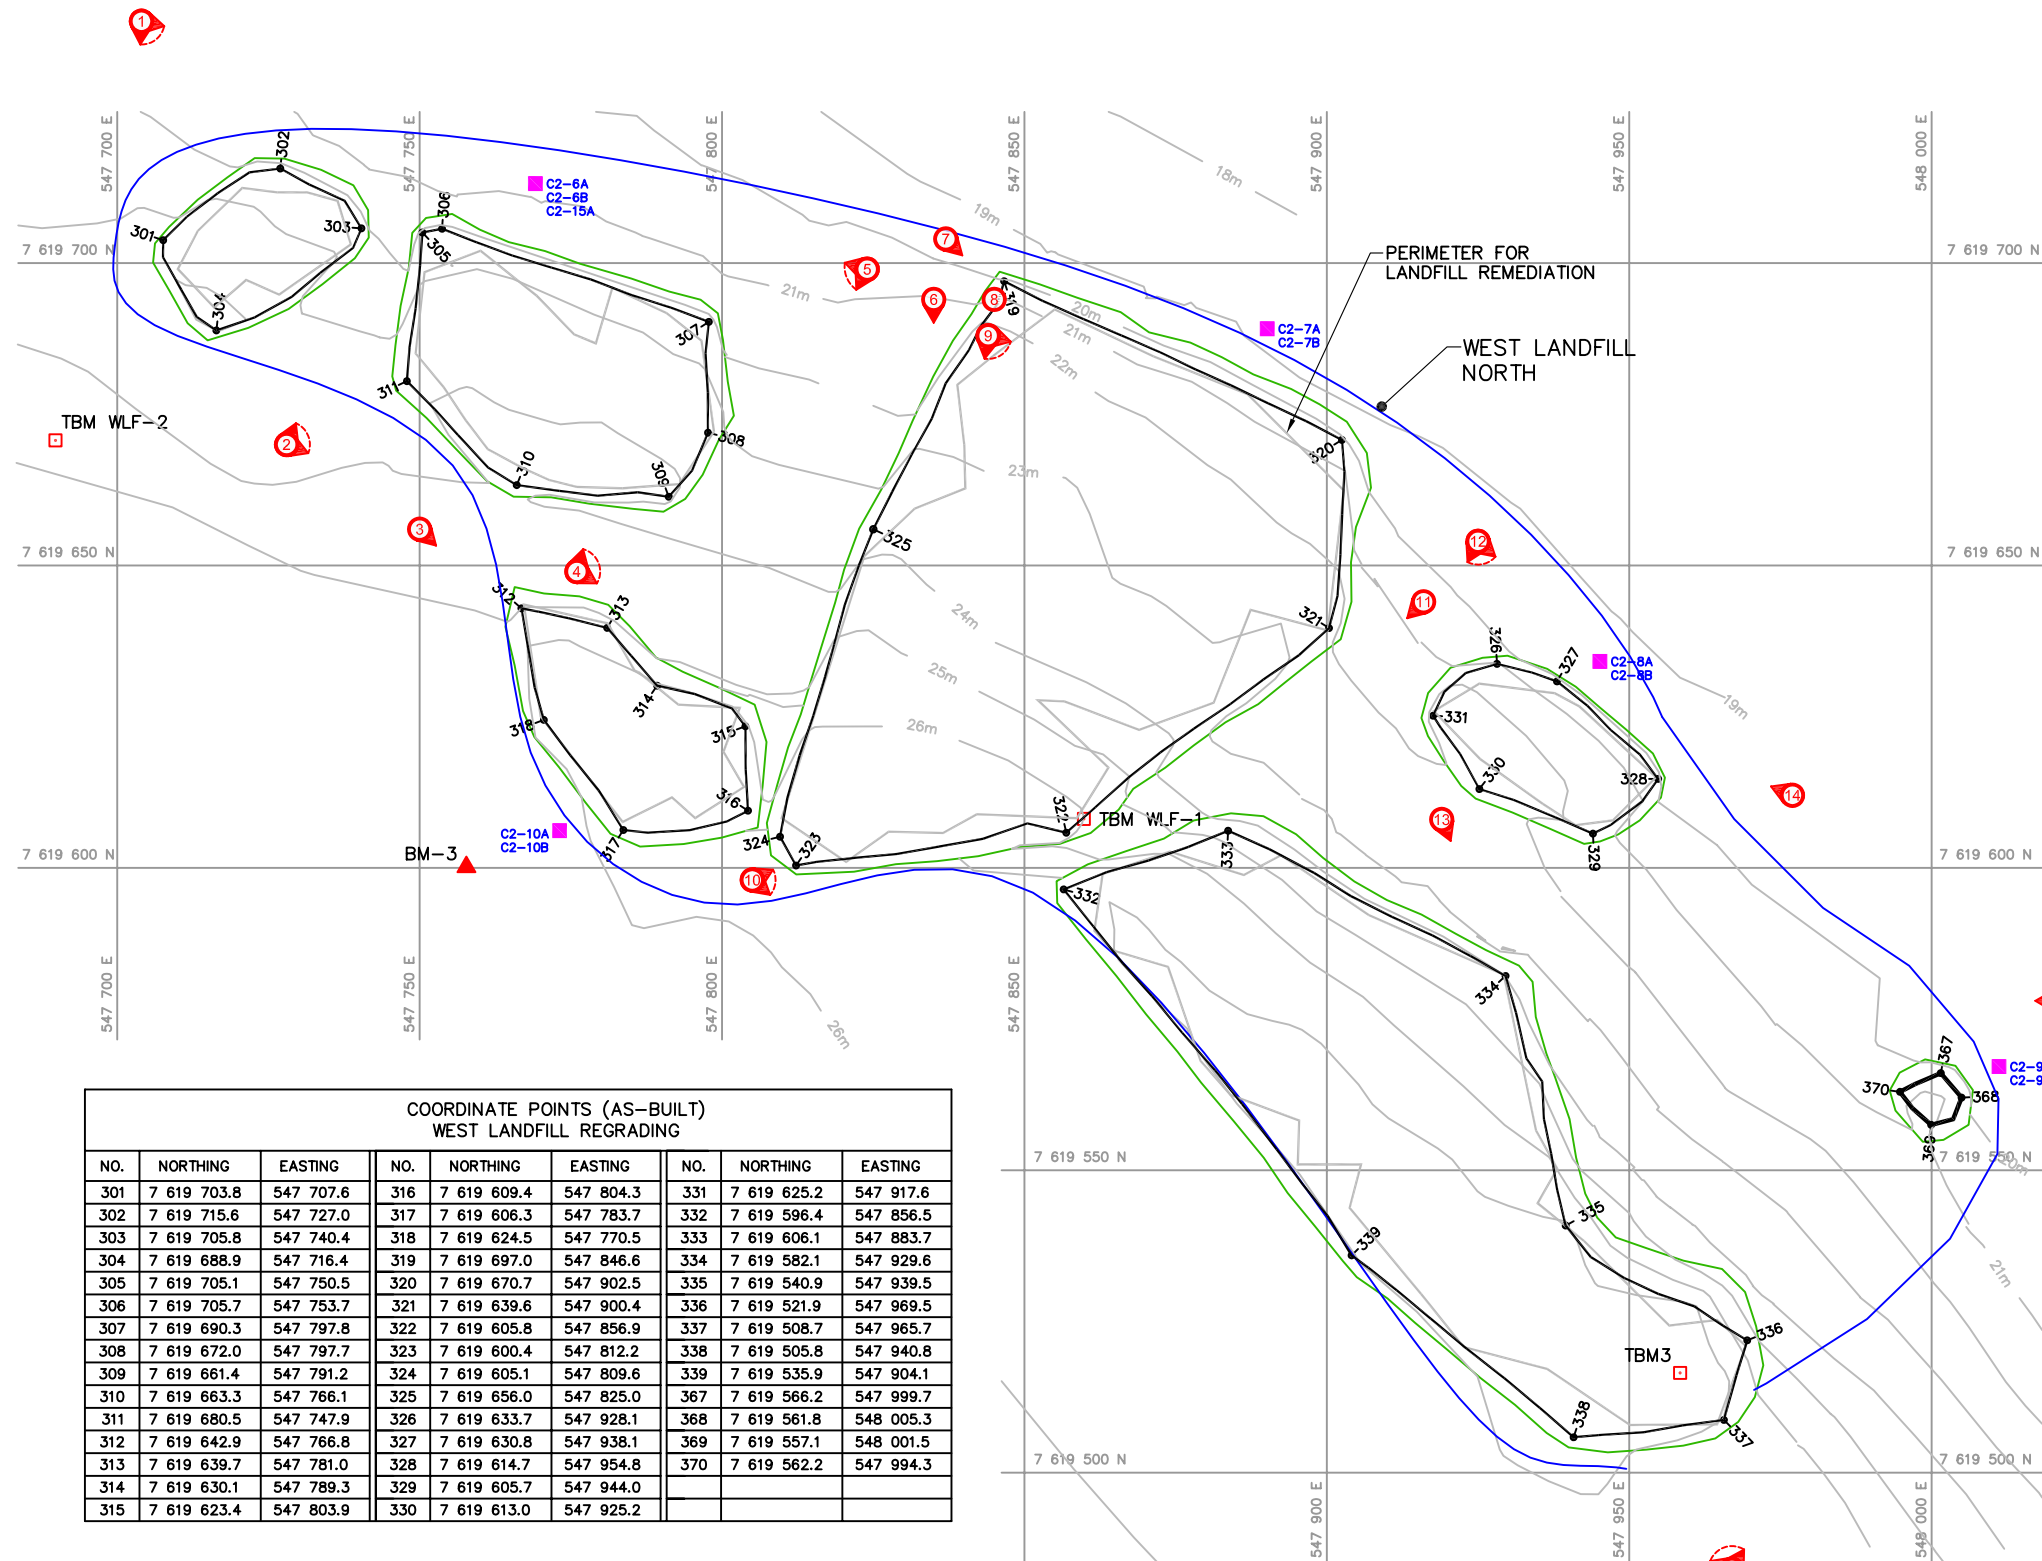


COORDINATE POINTS (AS-BUILT) WEST LANDFILL REGRADING								
NO.	NORTHING	EASTING	NO.	NORTHING	EASTING	NO.	NORTHING	EASTING
301	7 619 703.8	547 707.6	316	7 619 609.4	547 804.3	331	7 619 625.2	547 917.6
302	7 619 715.6	547 727.0	317	7 619 606.3	547 783.7	332	7 619 596.4	547 856.5
303	7 619 705.8	547 740.4	318	7 619 624.5	547 770.5	333	7 619 606.1	547 883.7
304	7 619 688.9	547 716.4	319	7 619 697.0	547 846.6	334	7 619 582.1	547 929.6
305	7 619 705.1	547 750.5	320	7 619 670.7	547 902.5	335	7 619 540.9	547 939.5
306	7 619 705.7	547 753.7	321	7 619 639.6	547 900.4	336	7 619 521.9	547 969.5
307	7 619 690.3	547 797.8	322	7 619 605.8	547 856.9	337	7 619 508.7	547 965.7
308	7 619 672.0	547 797.7	323	7 619 600.4	547 812.2	338	7 619 505.8	547 940.8
309	7 619 661.4	547 791.2	324	7 619 605.1	547 809.6	339	7 619 535.9	547 904.1
310	7 619 663.3	547 766.1	325	7 619 656.0	547 825.0	367	7 619 566.2	547 999.7
311	7 619 680.5	547 747.9	326	7 619 633.7	547 928.1	368	7 619 561.8	548 005.3
312	7 619 642.9	547 766.8	327	7 619 630.8	547 938.1	369	7 619 557.1	548 001.5
313	7 619 639.7	547 781.0	328	7 619 614.7	547 954.8	370	7 619 562.2	547 994.3
314	7 619 630.1	547 789.3	329	7 619 605.7	547 944.0			
315	7 619 623.4	547 803.9	330	7 619 613.0	547 925.2			

PERMANENT BENCHMARK			
NO.	COORDINATES		DESCRIPTION
	NORTHING	EASTING	
BM-3	7 619 600.143	547 757.734	25.763 25mm DIA. STEEL PIPE
TBM3	7 619 516.488	547 958.417	27.318 CARRIAGE BOLT
WLF-1	7 619 608.092	547 859.834	25.563 16mm DIA. IRON BAR
WLF-2	7 619 670.688	547 689.789	24.878 16mm DIA. IRON BAR

- Legend**
- TBM4 ■ TEMPORARY BENCHMARK
 - BM-1 ▲ PERMANENT BENCHMARK
 - 101 → COORDINATE POINT
 - C2-9A
■ C2-9B MONITORING SOIL SAMPLE LOCATION
 - Ⓢ PHOTOGRAPH LOCATION

RECORD DRAWING
NOT FOR CONSTRUCTION

Map Sources / Notes:
Source drawing from UMA: C2-RD03.dwg

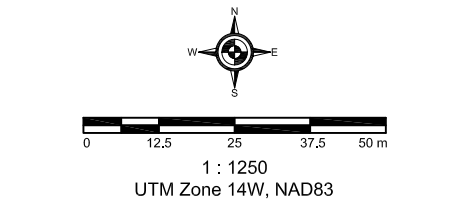

File Name: C2-RD03.dwg
Reviewed by: JAT
Date Issued: December, 2008
Prepared by: KAB
Project Number: 80-297

Defence Construction Canada
2008 DEW Line Monitoring Program
CAM-2 Gladman Point
Nunavut Territory

WEST LANDFILL - NORTH