


Date Plotted: October 16, 2006 Path: N:\Projects\2008\80297\2008\WorkInProgress\Documents\80297-2_CAM-2-FINAL-Report\ACAD_Files\C2-RD04.dwg

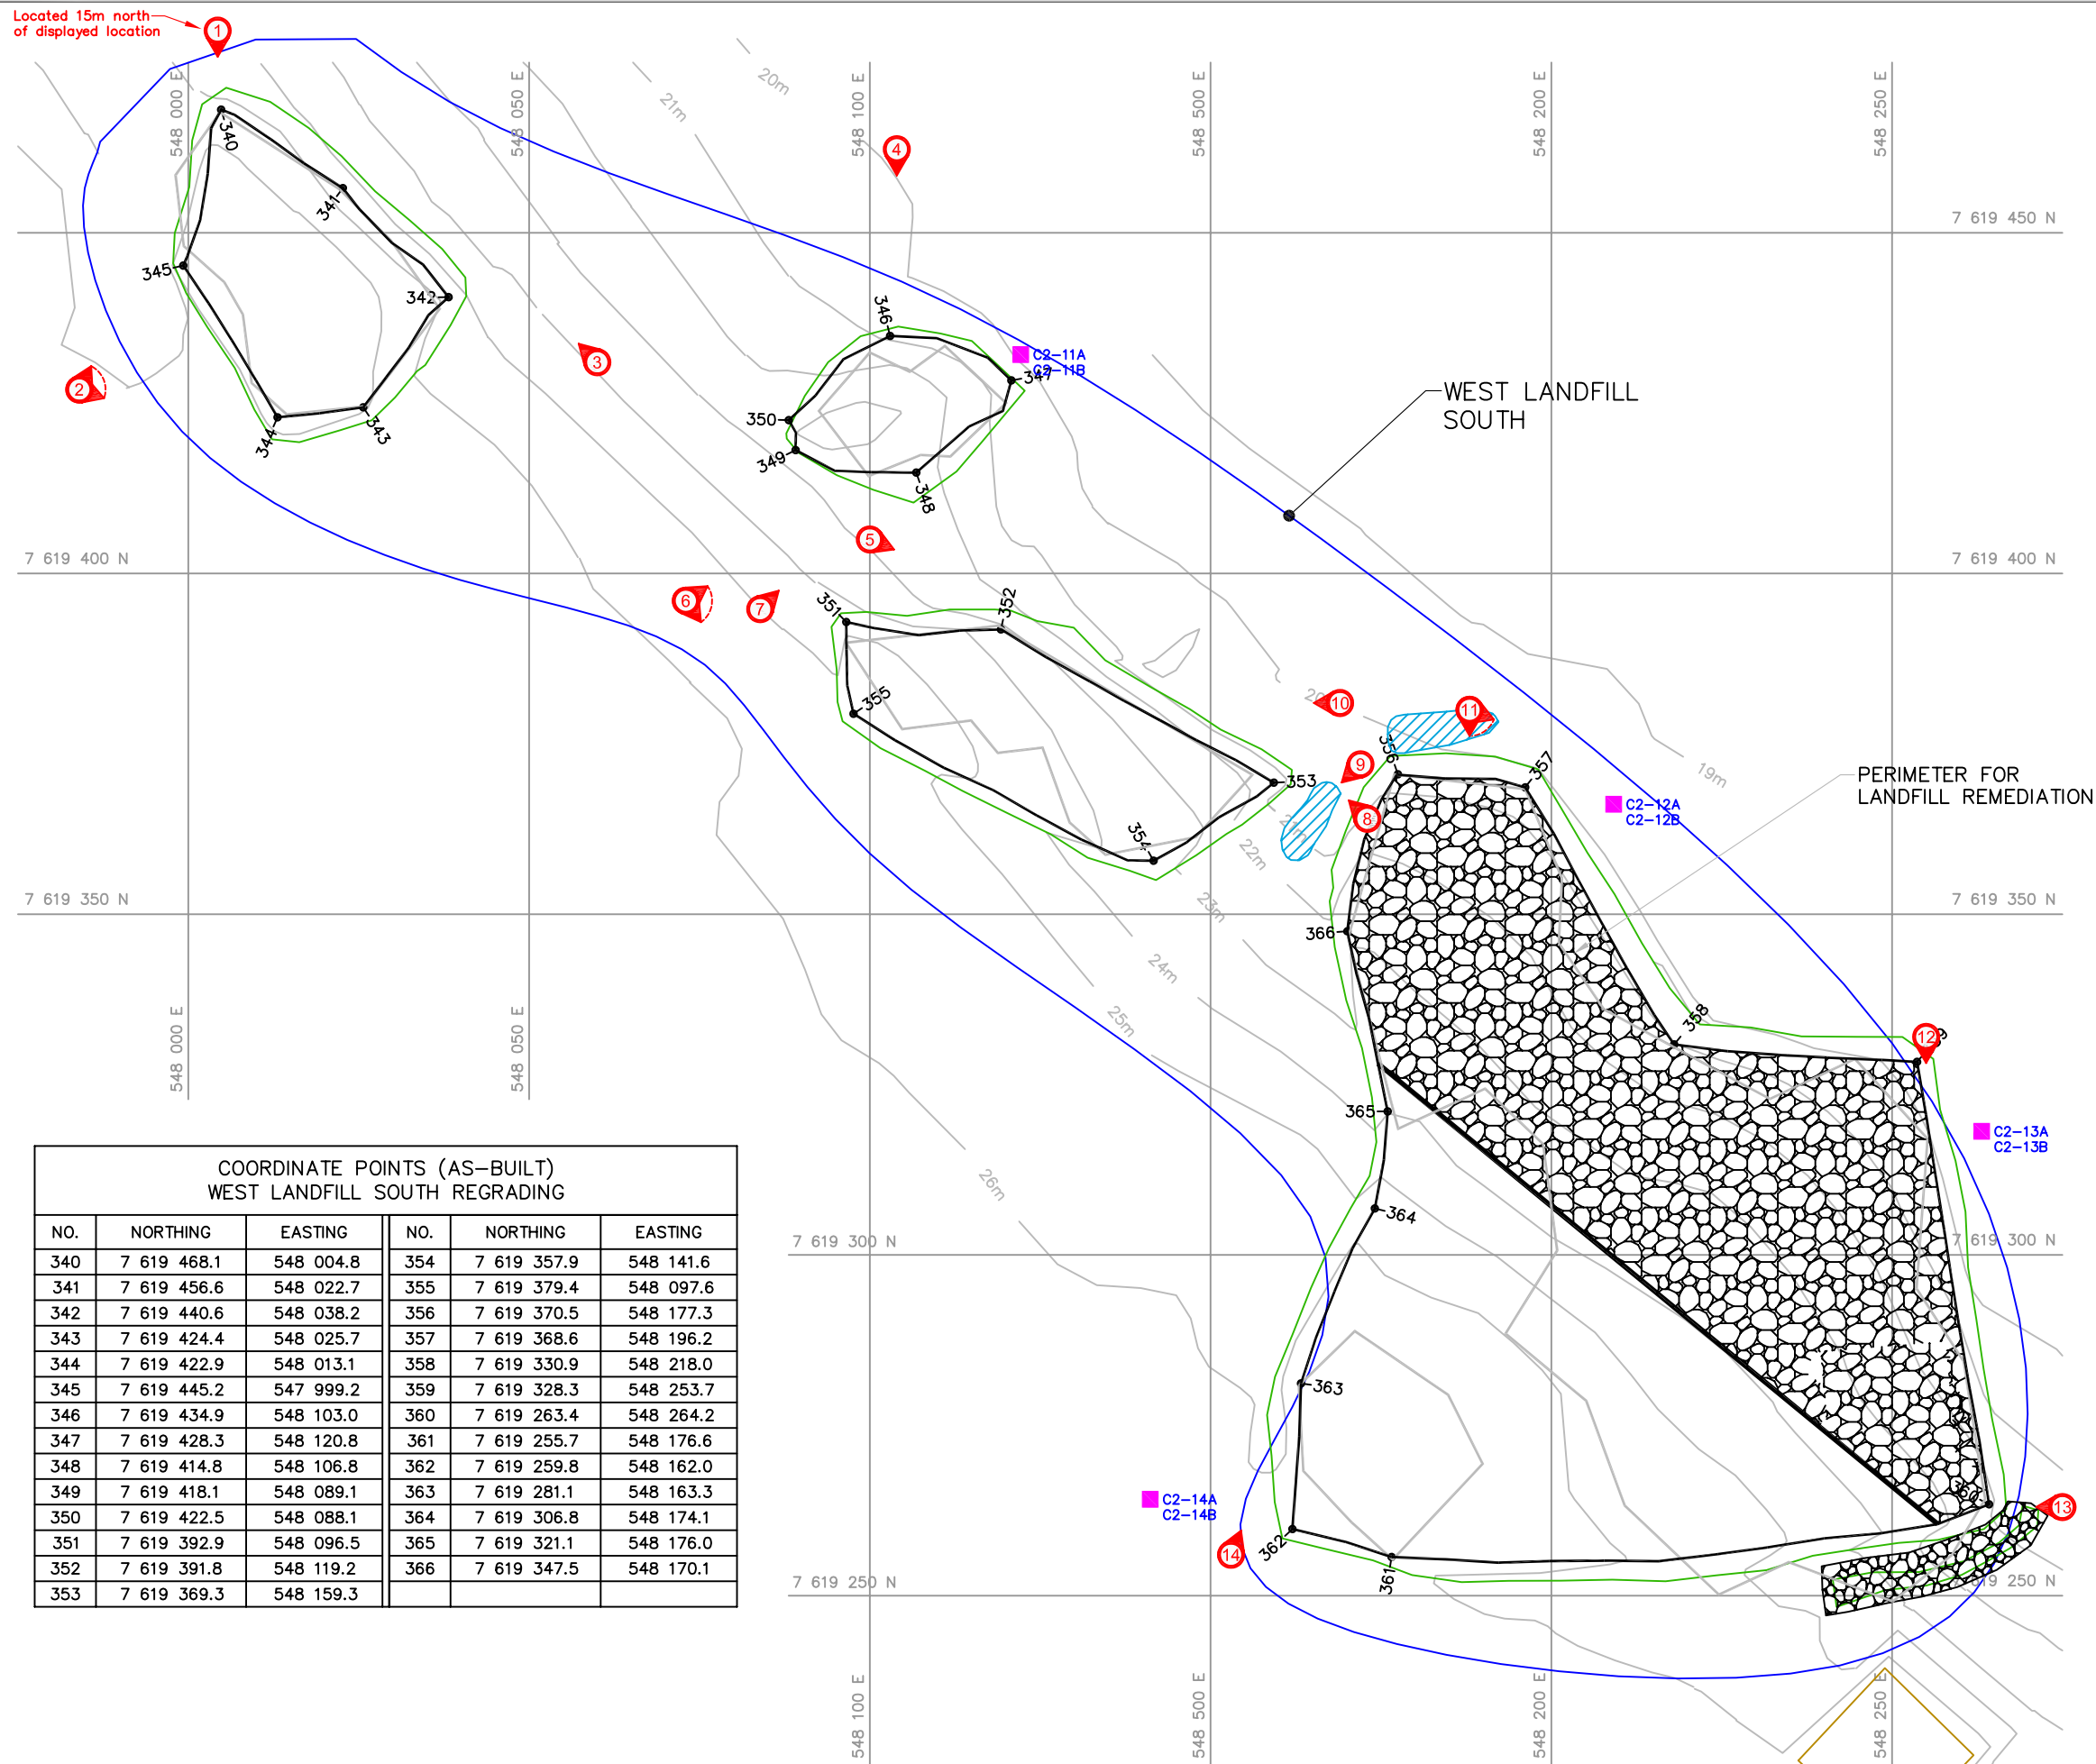

COORDINATE POINTS (AS-BUILT) WEST LANDFILL SOUTH REGRAIDING					
NO.	NORTHING	EASTING	NO.	NORTHING	EASTING
340	7 619 468.1	548 004.8	354	7 619 357.9	548 141.6
341	7 619 456.6	548 022.7	355	7 619 379.4	548 097.6
342	7 619 440.6	548 038.2	356	7 619 370.5	548 177.3
343	7 619 424.4	548 025.7	357	7 619 368.6	548 196.2
344	7 619 422.9	548 013.1	358	7 619 330.9	548 218.0
345	7 619 445.2	547 999.2	359	7 619 328.3	548 253.7
346	7 619 434.9	548 103.0	360	7 619 263.4	548 264.2
347	7 619 428.3	548 120.8	361	7 619 255.7	548 176.6
348	7 619 414.8	548 106.8	362	7 619 259.8	548 162.0
349	7 619 418.1	548 089.1	363	7 619 281.1	548 163.3
350	7 619 422.5	548 088.1	364	7 619 306.8	548 174.1
351	7 619 392.9	548 096.5	365	7 619 321.1	548 176.0
352	7 619 391.8	548 119.2	366	7 619 347.5	548 170.1
353	7 619 369.3	548 159.3			

- Legend**
- TBM4 ■ TEMPORARY BENCHMARK
 - BM-1 ▲ PERMANENT BENCHMARK
 - 101- ● COORDINATE POINT
 - C2-12A
■ C2-12B MONITORING SOIL SAMPLE LOCATION
 - ② PHOTOGRAPH LOCATION
 - ▨ PONDED WATER

RECORD DRAWING
NOT FOR CONSTRUCTION

Map Sources / Notes:
Source drawing from UMA: C2-RD04.dwg

N

W

E

S

0 5 10 20 30 40 m

1 : 1000

UTM Zone 14W, NAD83

File Name: C2-RD04.dwg
Reviewed by: JAT
Date Issued: January, 2009

Prepared by: KAB
Project Number: 80-297