


Date Plotted: October 16, 2006 Path: N:\Projects\2008\80297\2008\WorkInProgress\Documents\80297-2_CAM-2-FINAL-Report\ACAD_Files\C2-RD05.dwg

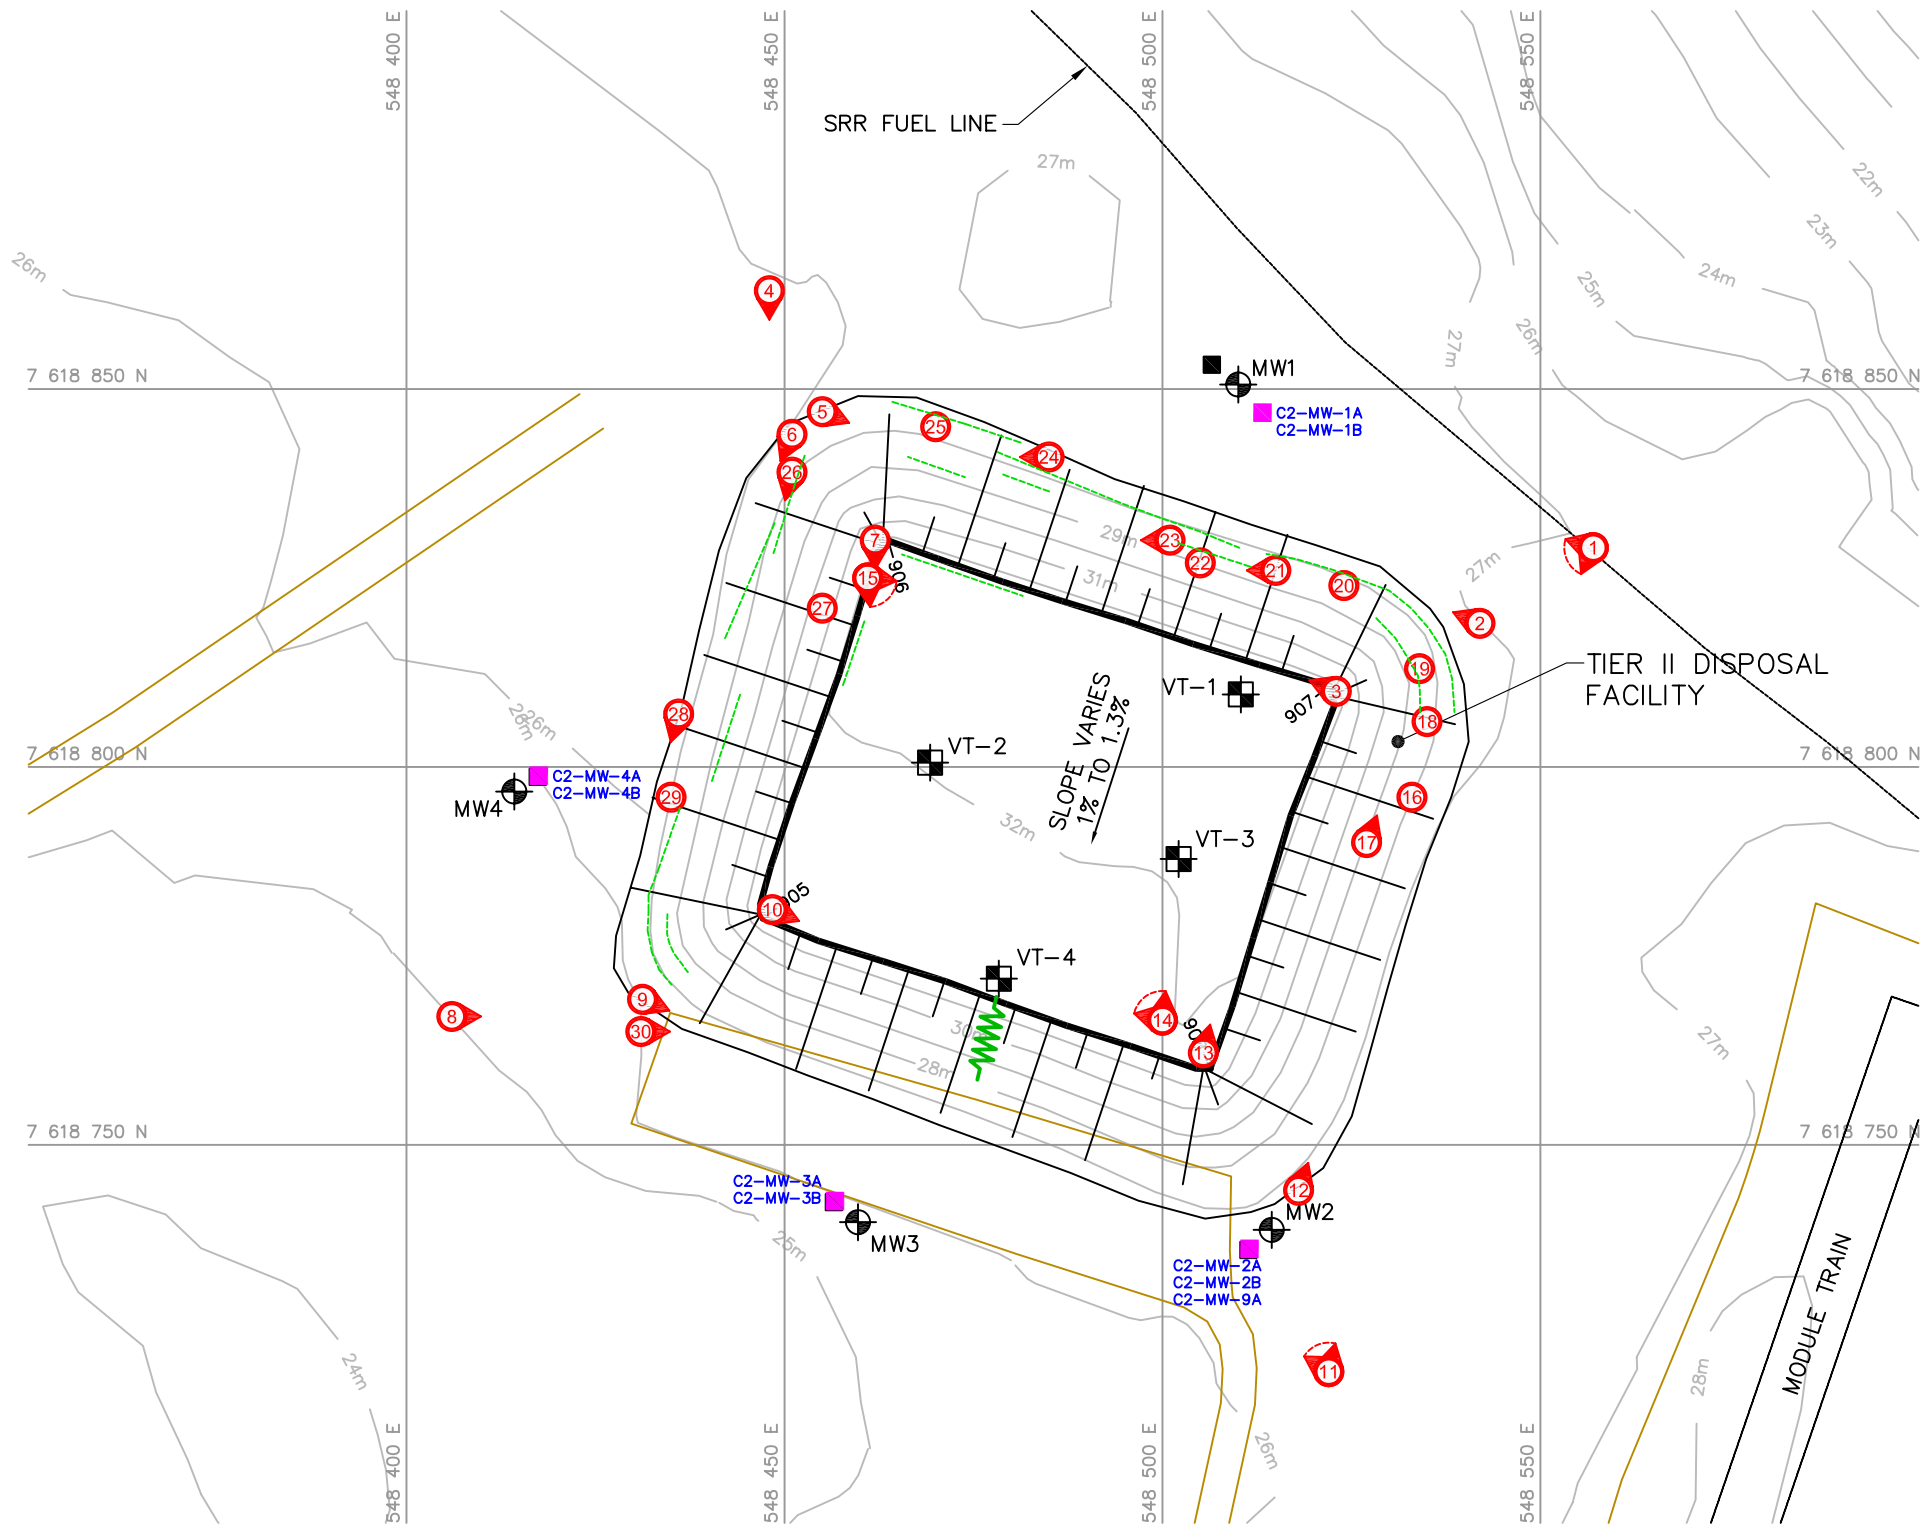

Legend

- 101- COORDINATE POINT
- C2-MW-1A
C2-MW-1B MONITORING SOIL SAMPLE LOCATION
- MONITORING WELL LOCATION
- VERTICAL THERMISTOR LOCATION
- PHOTOGRAPH LOCATION
- EROSION (NTS)
- TENSION CRACK (NTS)


COORDINATE POINTS (AS-BUILT) FINAL LANDFILL SURFACE			
NO.	NORTHING	EASTING	ELEV.
905	7 618 780.0	548 447.2	31.6
906	7 618 829.9	548 463.7	32.3
907	7 618 810.7	548 522.1	32.4
908	7 618 760.1	548 506.3	31.9

COORDINATE POINTS (AS-BUILT) VERTICAL THERMISTORS		
NO.	NORTHING	EASTING
VT-1	7 618 809.6	548 510.4
VT-2	7 618 800.6	548 469.3
VT-3	7 618 787.8	548 502.1
VT-4	7 618 772.0	548 478.4

COORDINATE POINTS (AS BUILT) MONITORING WELLS			
NO.	NORTHING	EASTING	ELEV.
MW1	7 618 850.6	548 510.0	27.3
MW2	7 618 738.8	548 514.5	26.1
MW3	7 618 739.8	548 459.7	25.5
MW4	7 618 796.7	548 414.3	26.0

RECORD DRAWING
NOT FOR CONSTRUCTION

Map Sources / Notes:
Source drawing from UMA: C2-RD05.dwg

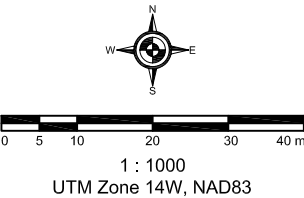

File Name: C2-RD05.dwg
Reviewed by: JAT
Date Issued: January, 2009
Prepared by: KAB
Project Number: 80-297

Defence Construction Canada

2008 DEW Line Monitoring Program
CAM-2 Gladman Point
Nunavut Territory

TIER II SOIL
DISPOSAL FACILITY

AECOM

Figure C-1
Version 2