


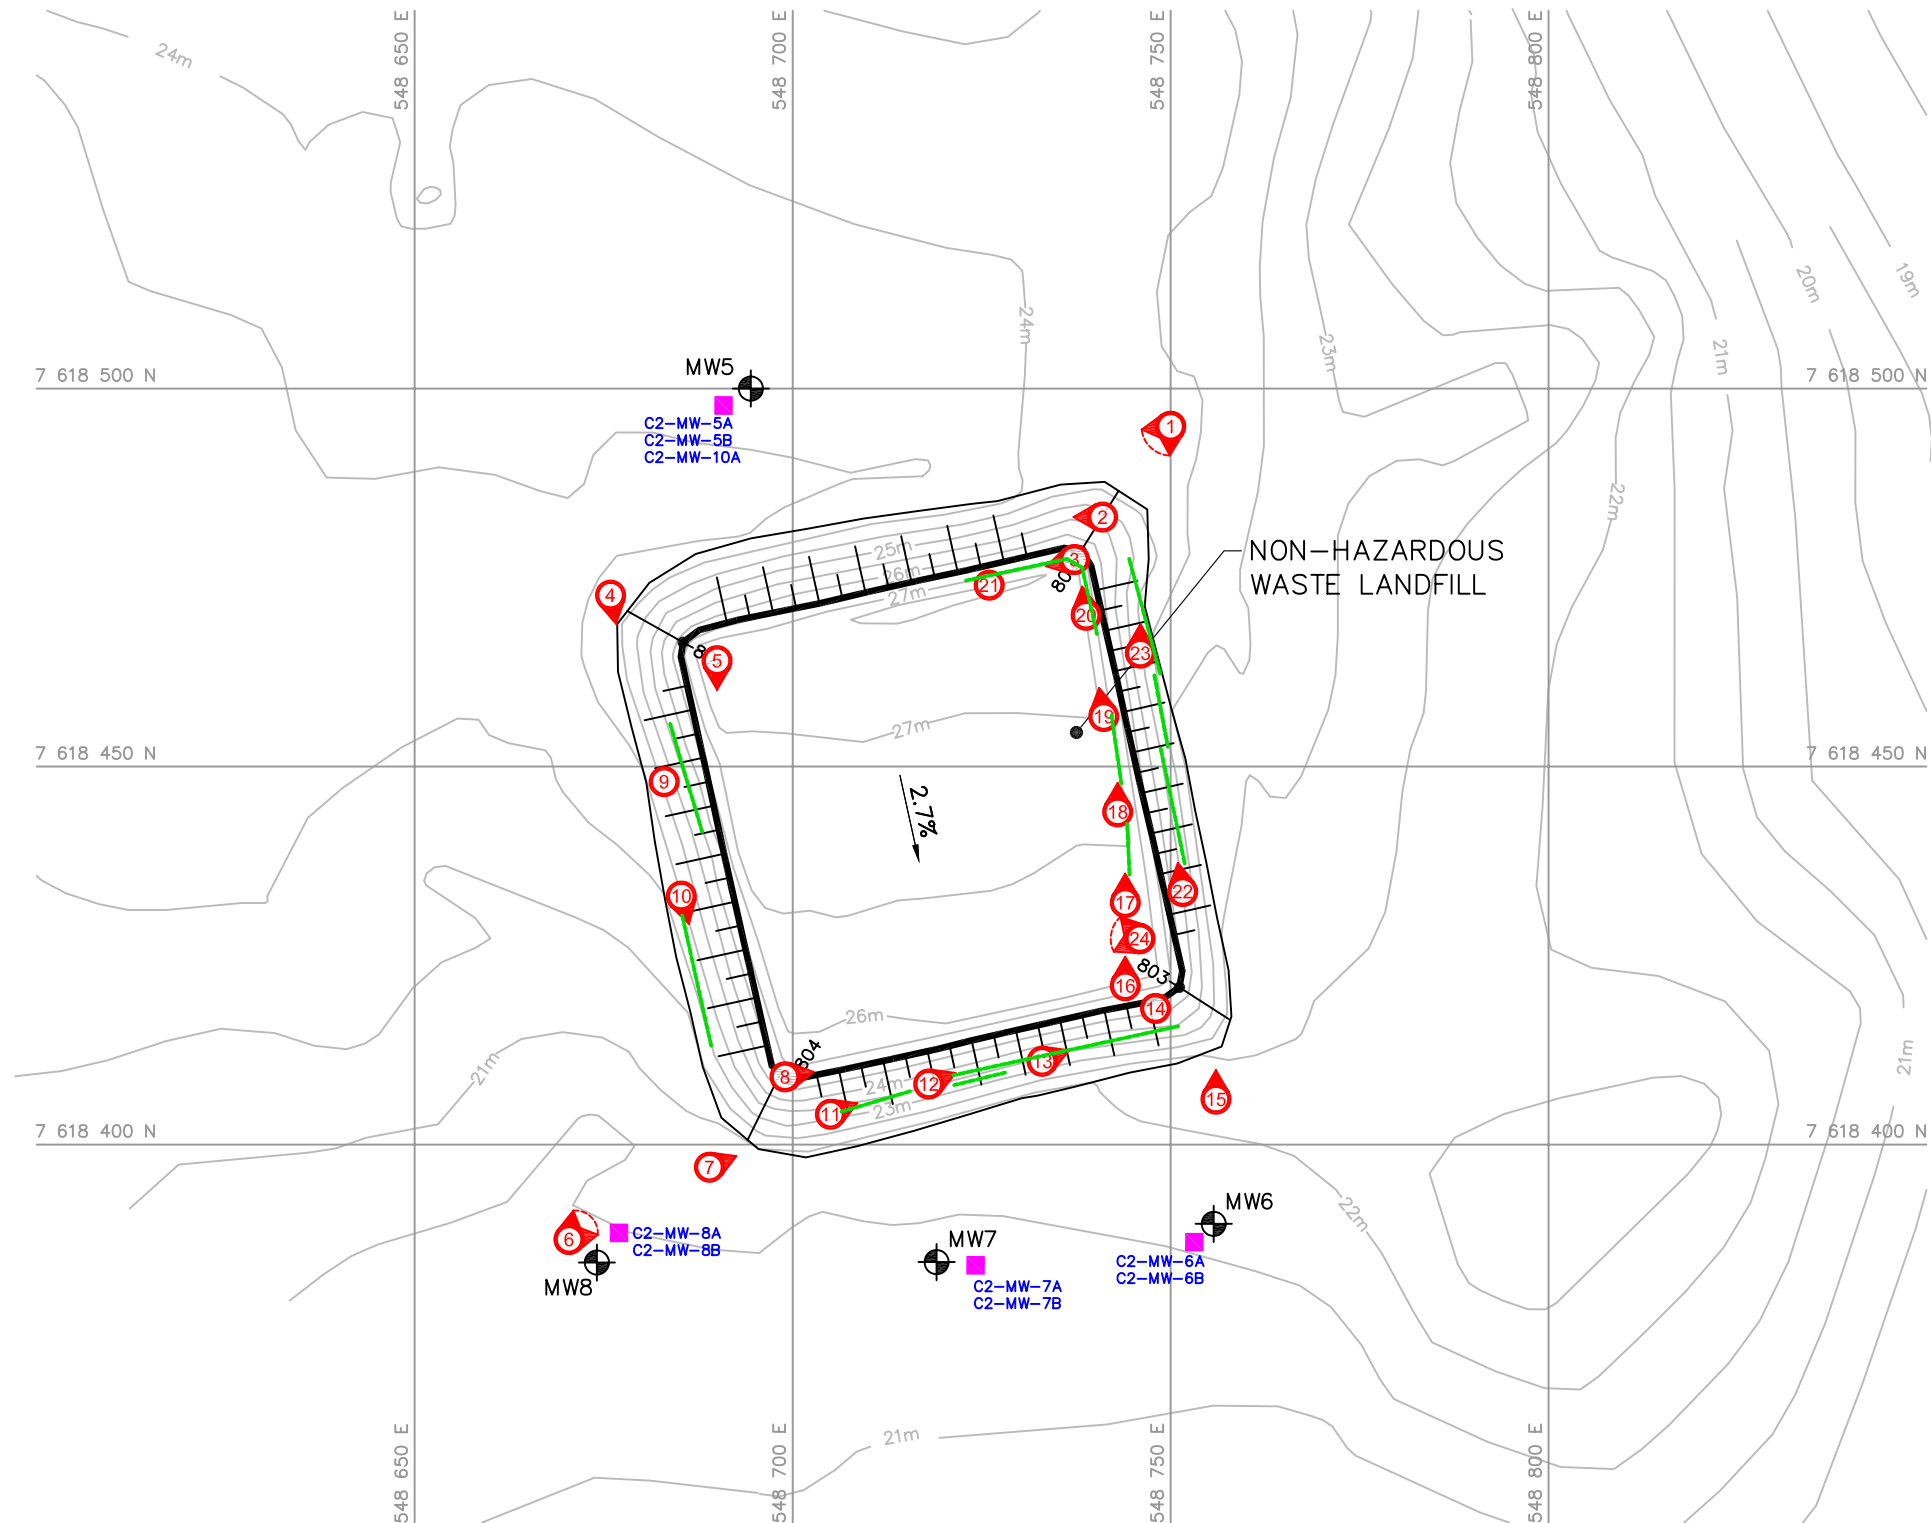

Legend


- 101- COORDINATE POINT
- C2-MW-6A MONITORING SOIL SAMPLE LOCATION
- C2-MW-6B
- MONITORING WELL LOCATION
- PHOTOGRAPH LOCATION
- TENSION CRACK (NTS)

COORDINATE POINTS (AS BUILT) MONITORING WELLS			
NO.	NORTHING	EASTING	ELEV.
MW5	7 618 500.0	548 694.5	23.8
MW6	7 618 389.5	548 755.7	21.8
MW7	7 618 384.4	548 719.0	21.5
MW8	7 618 384.4	548 674.1	21.4

COORDINATE POINTS (AS-BUILT) NON-HAZARDOUS WASTE LANDFILL			
NO.	NORTHING	EASTING	ELEV.
801	7 618 466.4	548 685.5	26.3
802	7 618 478.5	548 738.2	26.4
803	7 618 420.8	548 751.2	25.0
804	7 618 408.5	548 699.8	25.0

RECORD DRAWING
NOT FOR CONSTRUCTION

Map Sources / Notes:
Source drawing from UMA: C2-RD06.dwg

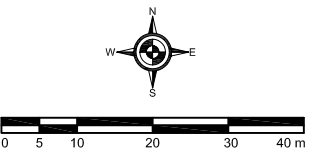

1 : 1000
UTM Zone 14W, NAD83

File Name: C2-RD06.dwg
Reviewed by: JAT
Date Issued: January, 2009
Prepared by: KAB
Project Number: 80-297

Defence Construction Canada

2008 DEW Line Monitoring Program
CAM-2 Gladman Point
Nunavut Territory

**NON-HAZARDOUS WASTE
LANDFILL**

AECOM

Figure D-1
Version 2