


Path: N:\Projects\2008\80297\2008\WorkInProgress\Documents\80297-2\_CAM-2-FINAL-Report\ACAD\_Files\C2-RD01 Plotted on: December 17, 2008


| GEOLOGIC SURVEY OF CANADA MONUMENT |               |             |        |                    |
|------------------------------------|---------------|-------------|--------|--------------------|
| NO.                                | COORDINATES   |             | ELEV.  | DESCRIPTION        |
|                                    | NORTHING      | EASTING     |        |                    |
| GSC-001                            | 7 615 597.860 | 551 061.488 | 7.351  | 16mm DIA. IRON BAR |
| GSC-002                            | 7 615 624.484 | 551 036.844 | 12.307 | 16mm DIA. IRON BAR |
| GSC-003                            | 7 615 594.412 | 550 966.341 | 20.599 | 16mm DIA. IRON BAR |

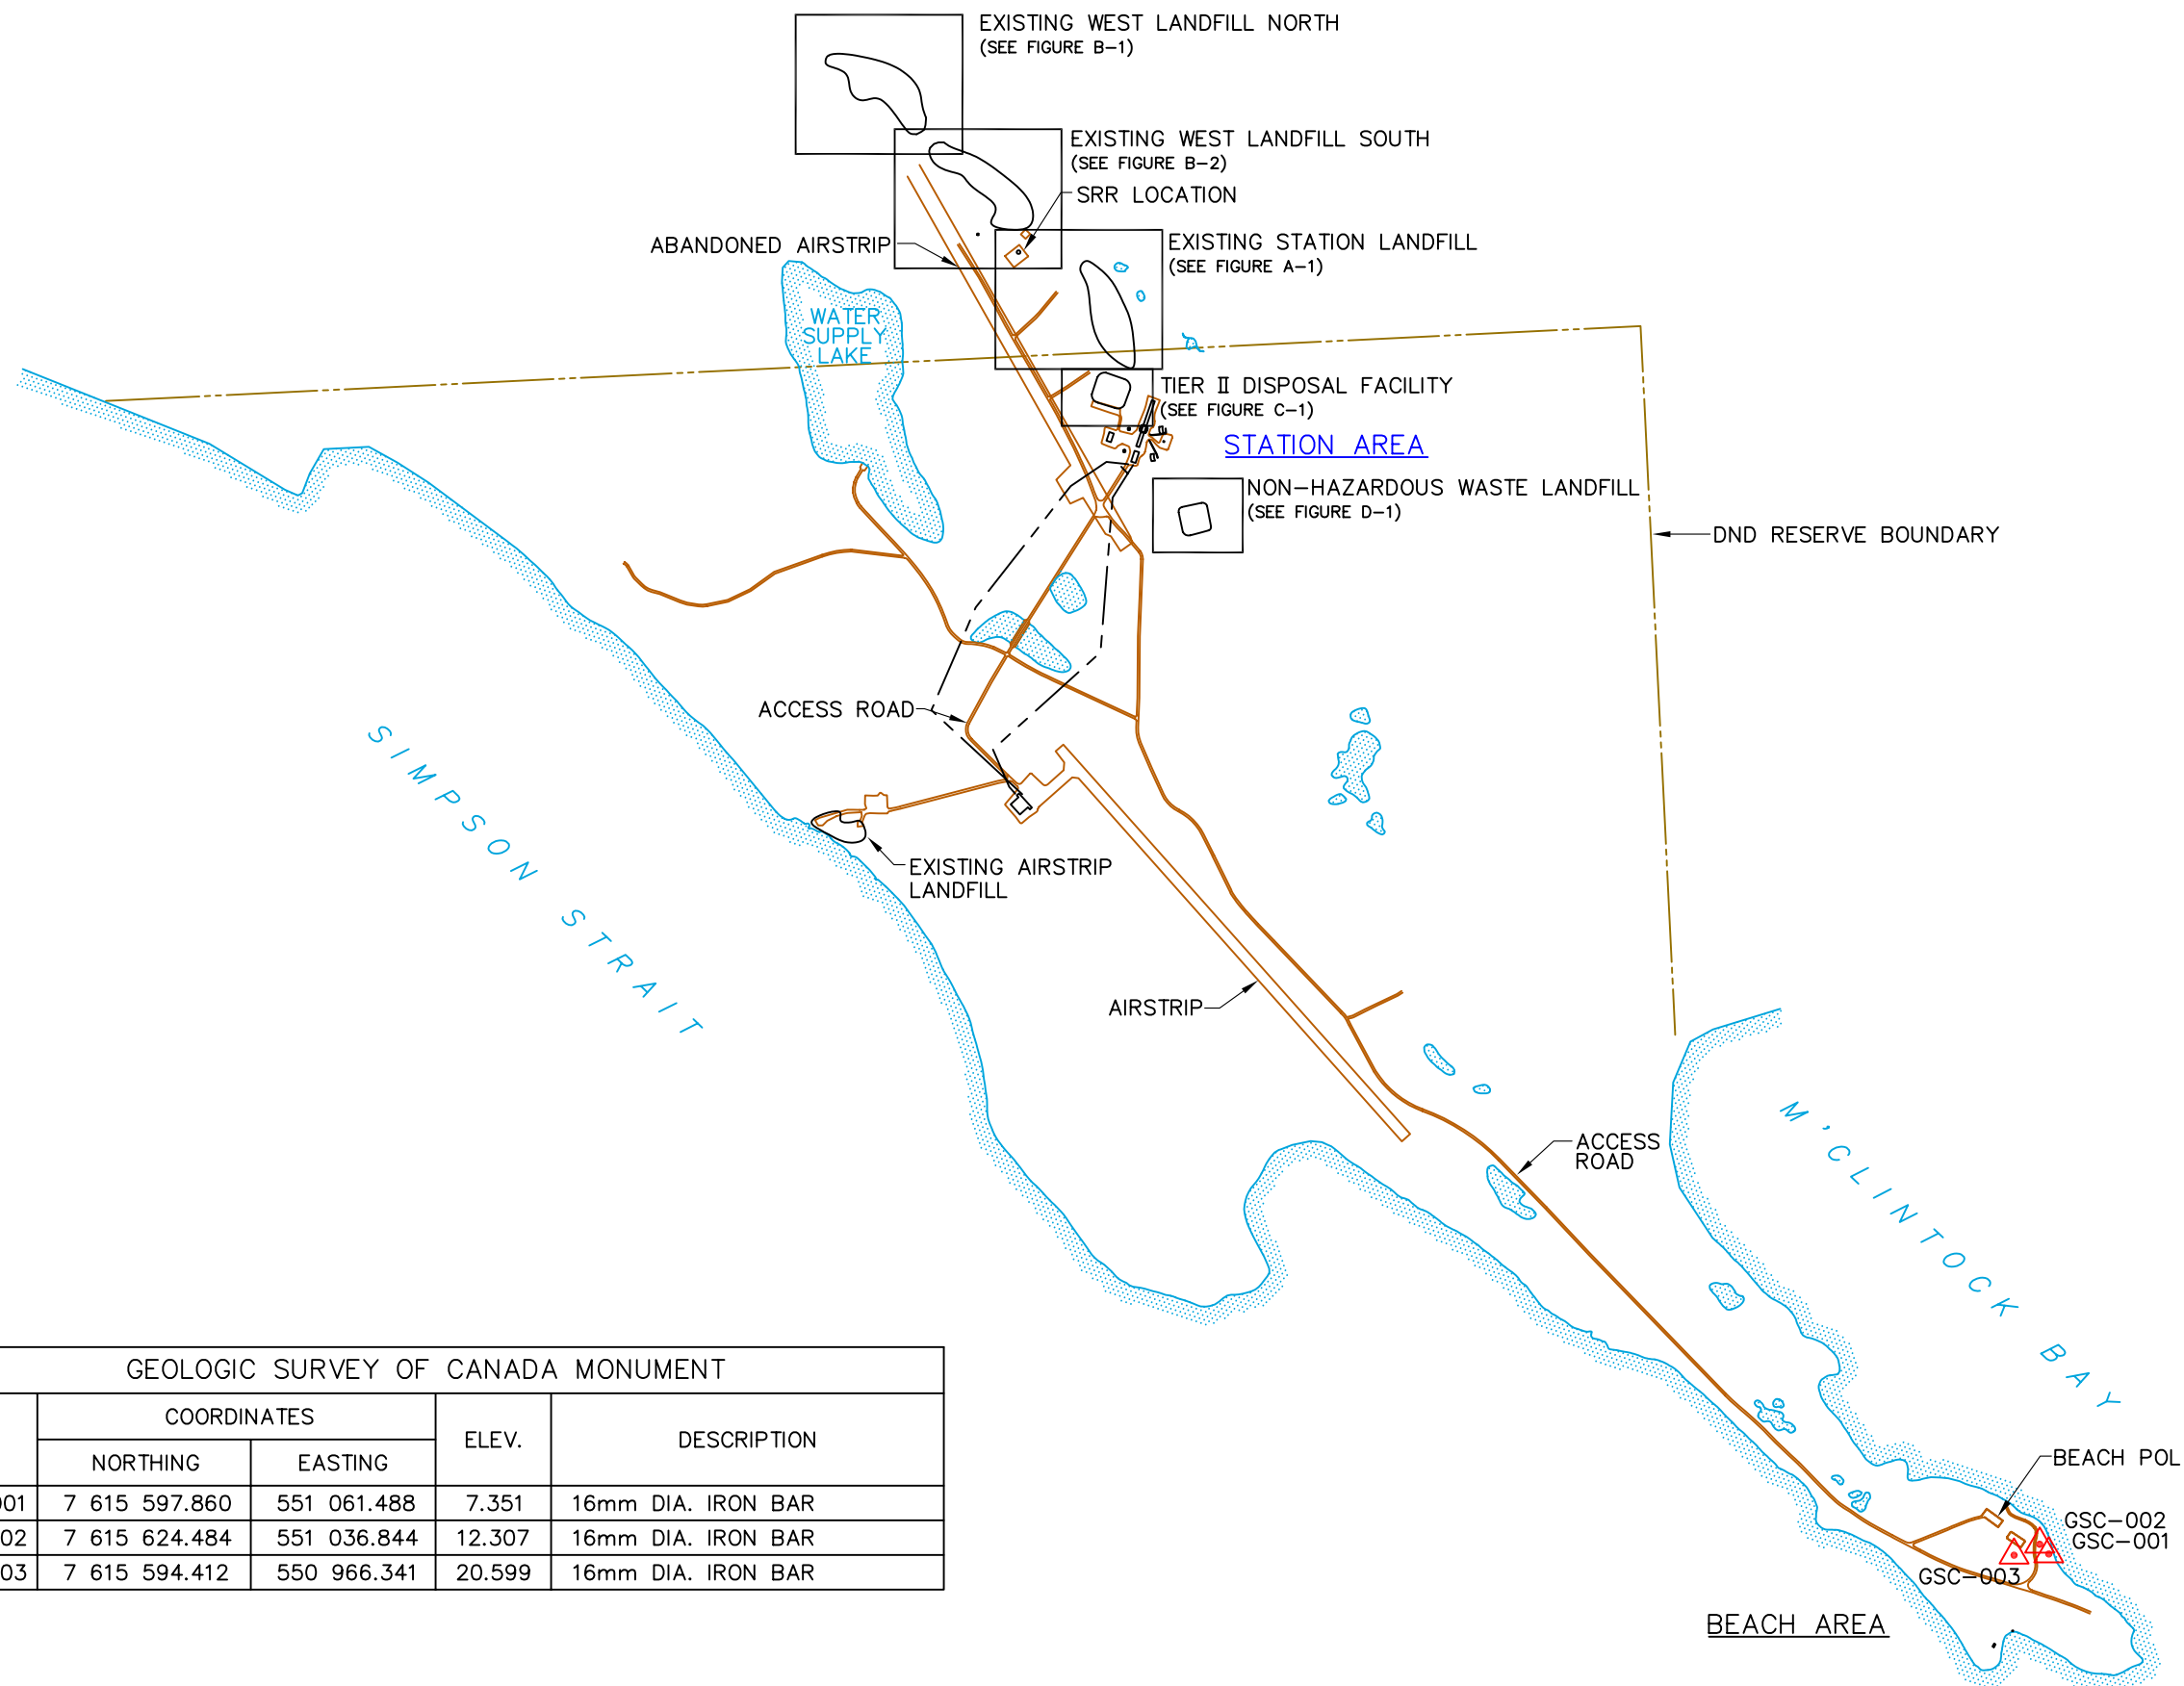

**Legend**  
GSC-002 GEOLOGIC SURVEY OF CANADA MONUMENT

**RECORD DRAWING**  
NOT FOR CONSTRUCTION

Map Sources / Notes:  
Source drawing from UMA: C2-RD01.dwg  
supplied by Defence Construction Canada

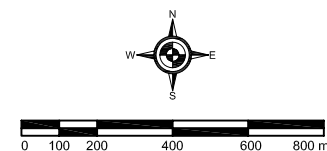

1 : 20,000  
UTM Zone 14W, NAD83

File Name: C2-RD01.dwg  
Reviewed by: JAT  
Date Issued: December, 2008  
Prepared by: KAB  
Project Number: 80-297

**Defence Construction Canada**  
2008 CAM-2 DEW Line Monitoring Program  
Cam-2 Gladman Point  
Nunavut Territory

**DEW Line Clean Up  
Monitoring Plan**

**AECOM**

**Figure 2-1**  
Version 2