



Appendix B

Figures

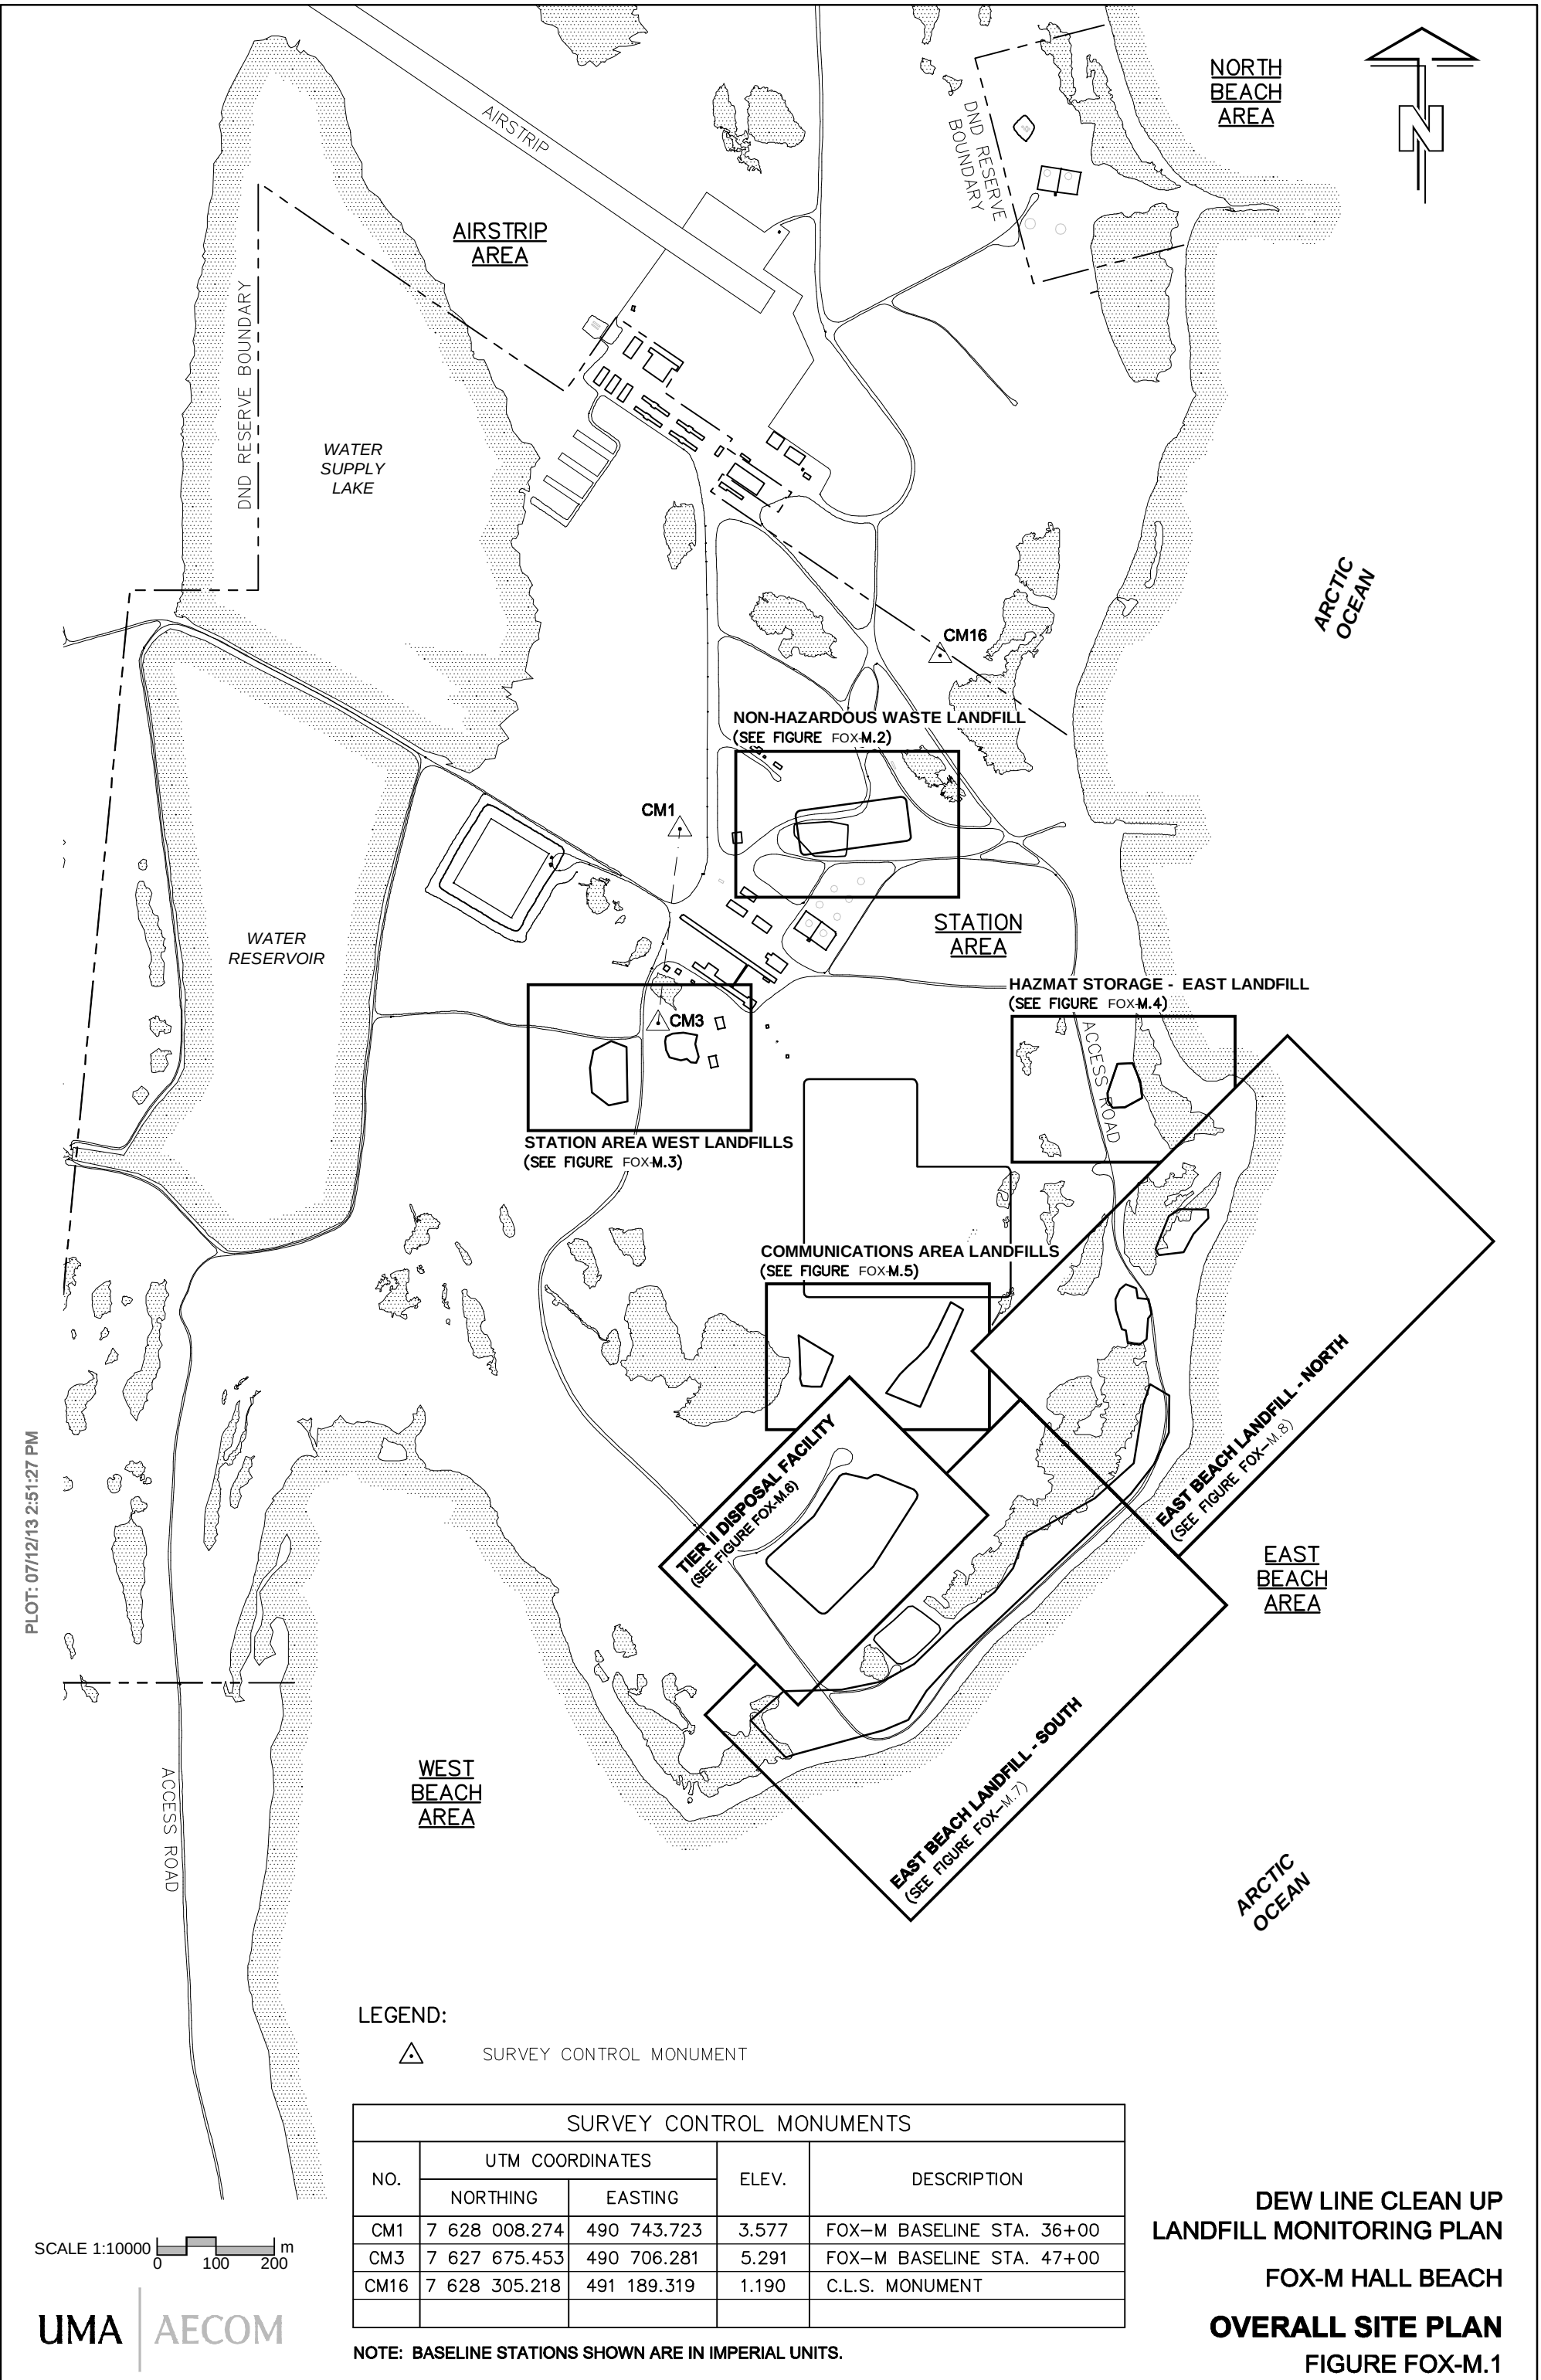

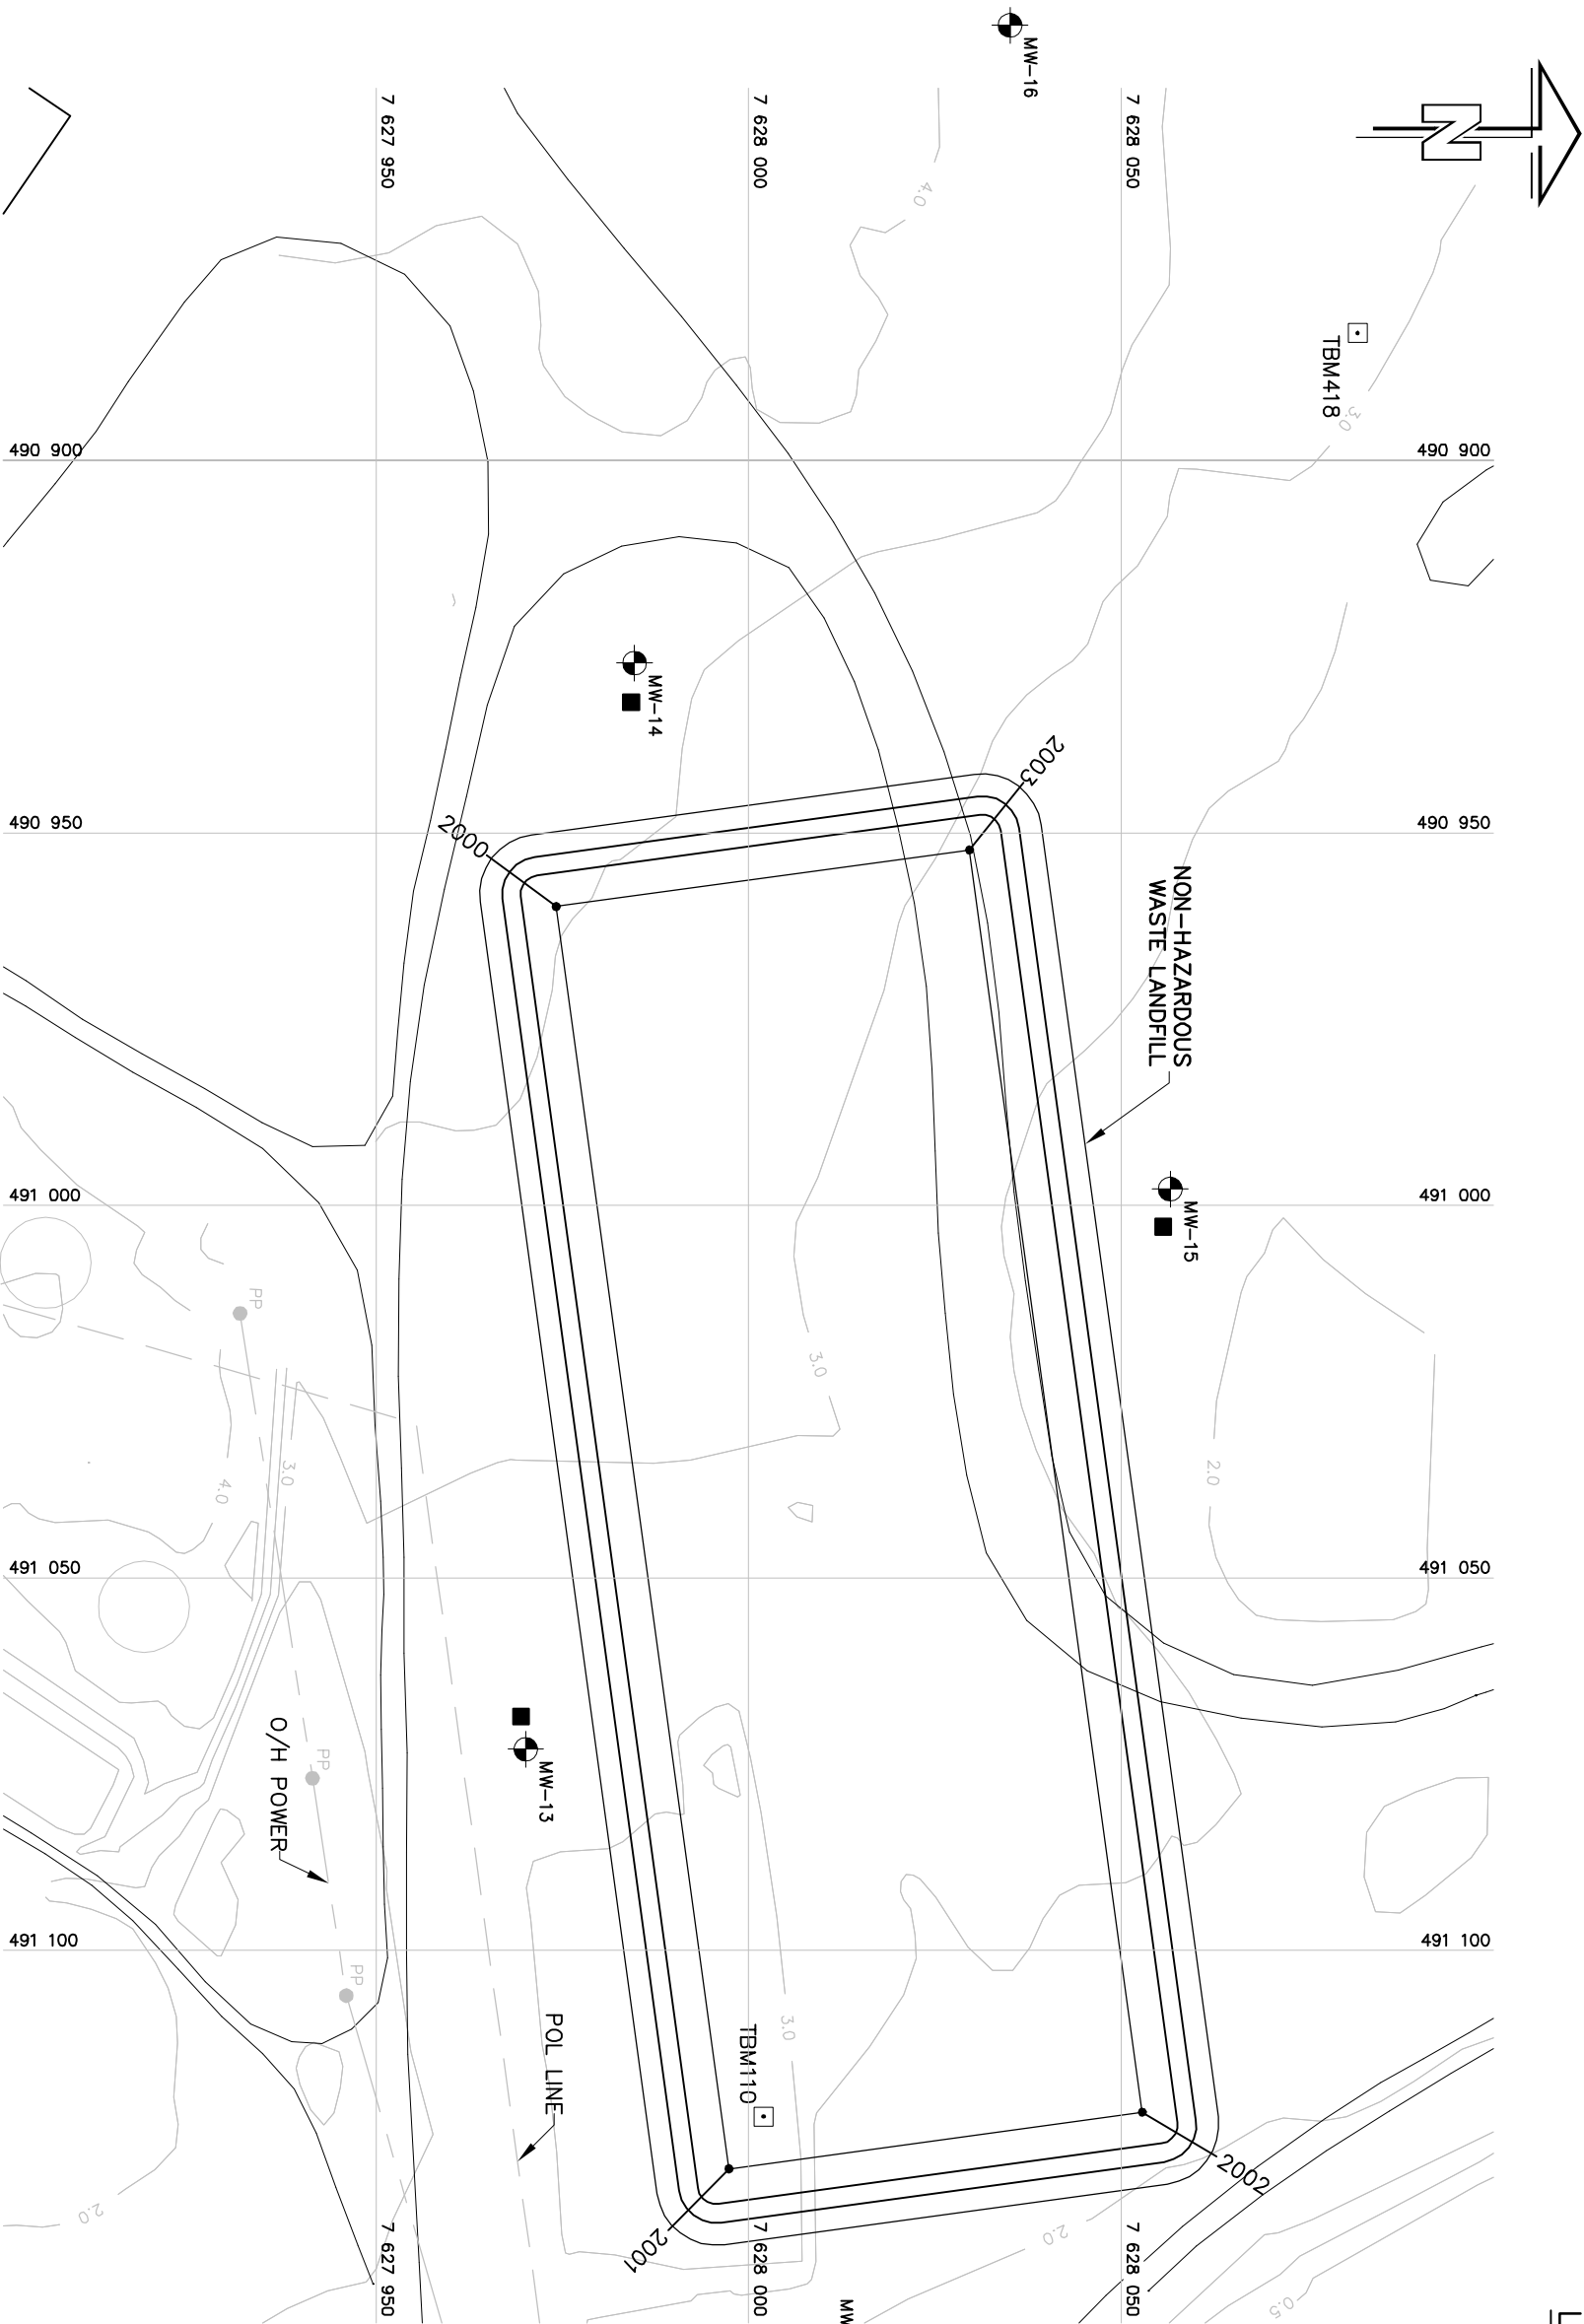


- LEGEND:**
- SURVEY CONTROL MONUMENT
 - TEMPORARY BENCHMARK
 - COORDINATE POINT
 - 2002 MONITORING SOIL SAMPLE LOCATION
 - MONITORING WELL LOCATION
 - VERTICAL THERMISTOR LOCATION

NOTE: DRAWING TO BE UPDATED BASED ON RECORD INFORMATION

COORDINATE POINTS		
NO.	COORDINATES	
	NORTHING	EASTING
2000	7 627 974.174	490 959.886
2001	7 627 997.366	491 129.306
2002	7 628 052.849	491 121.711
2003	7 628 029.657	490 952.291

TEMPORARY BENCHMARKS			
NO.	UTM COORDINATES		ELEV.
	NORTHING	EASTING	
TBM110	7 628 002.026	491 122.279	3.374
TBM418	7 628 081.738	490 882.902	3.277

COORDINATE POINTS (AS BUILT) MONITORING WELLS			
NO.	NORTHING	EASTING	ELEV.
MW-12	7 628 012.9	491 158.5	2.41
MW-13	7 627 970.1	491 073.0	3.12
MW-14	7 627 984.7	790 927.2	4.39
MW-15	7 628 056.6	490 997.8	2.72
MW-16	7 628 035.1	490 841.6	4.65

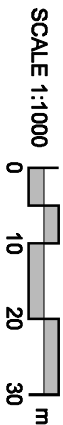

UMA | AECOM


SURVEY CONTROL MONUMENTS			
NO.	UTM COORDINATES		DESCRIPTION
	NORTHING	EASTING	
CM3	7 627 675.453	490 706.281	5.291 FOX-M BASELINE STA. 47+00

TEMPORARY BENCHMARKS			
NO.	UTM COORDINATES		ELEV.
	NORTHING	EASTING	
TBM202	7 627 536.239	490 688.266	4.032
TBM420	7 627 562.060	490 830.450	6.578

NOTE: DRAWING TO BE UPDATED BASED ON RECORD INFORMATION

LEGEND:	
	SURVEY CONTROL MONUMENT
	TEMPORARY BENCHMARK
	COORDINATE POINT
	MONITORING SOIL SAMPLE LOCATION
	MONITORING WELL LOCATION
	VERTICAL THERMISTOR LOCATION


DEW LINE CLEAN UP
LANDFILL MONITORING PLAN
FOX-M HALL BEACH
STATION AREA WEST LANDFILLS
FIGURE FOX-M.3

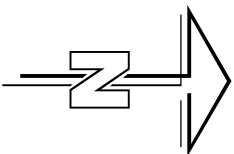


- LEGEND:**
- SURVEY CONTROL MONUMENT
 - TEMPORARY BENCHMARK
 - COORDINATE POINT
 - MONITORING SOIL SAMPLE LOCATION
 - MONITORING WELL LOCATION
 - VERTICAL THERMISTOR LOCATION

NOTE: DRAWING TO BE UPDATED BASED ON RECORD INFORMATION



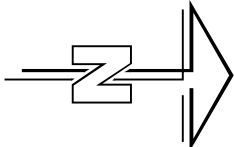

- LEGEND:**
- SURVEY CONTROL MONUMENT
 - TEMPORARY BENCHMARK
 - 2002 COORDINATE POINT
 - MONITORING SOIL SAMPLE LOCATION
 - MONITORING WELL LOCATION
 - VERTICAL THERMISTOR LOCATION

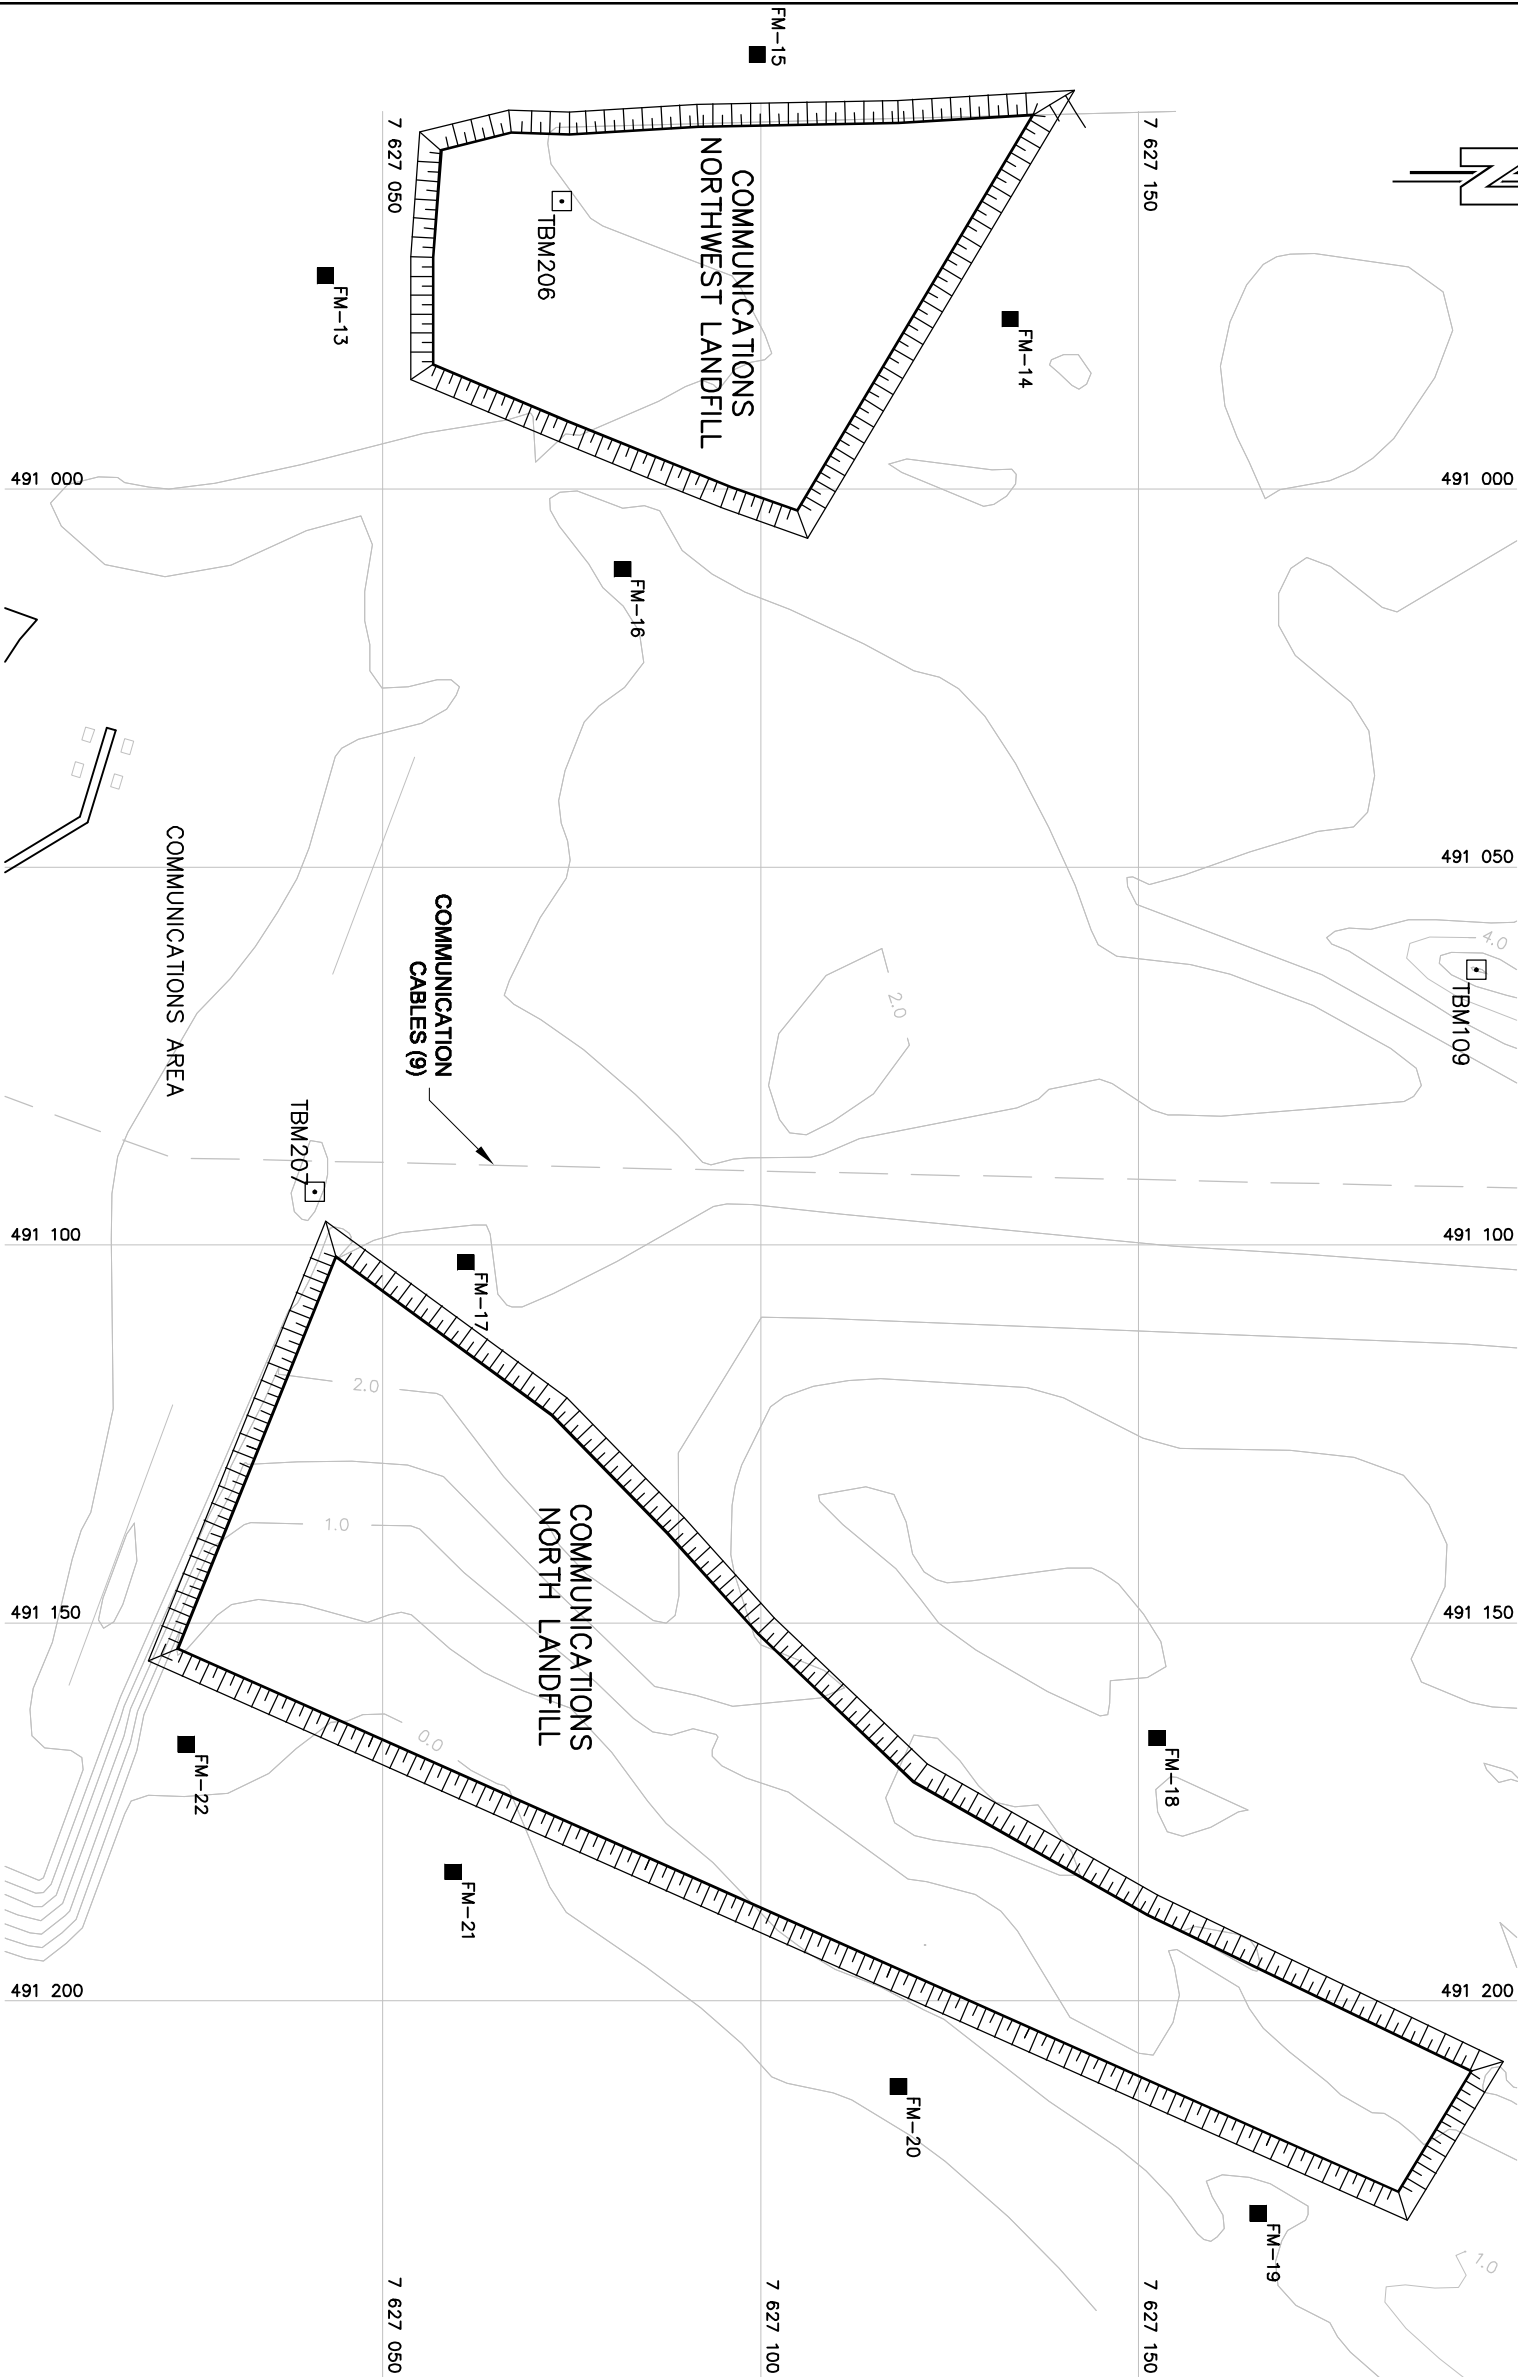

TEMPORARY BENCHMARKS			
NO.	UTM COORDINATES		ELEV.
	NORTHING	EASTING	
TBM109	7 627 194.665	491 063.587	5.078
TBM206	7 627 073.668	490 961.909	3.494
TBM207	7 627 040.990	491 092.969	3.263


NOTE: DRAWING TO BE UPDATED BASED ON RECORD INFORMATION

SCALE 1:1000

0 10 20 30 m

UMA | **AECOM**

DEW LINE CLEAN UP
LANDFILL MONITORING PLAN
FOX-M HALL BEACH
COMMUNICATIONS AREA LANDFILLS
FIGURE FOX-M.5

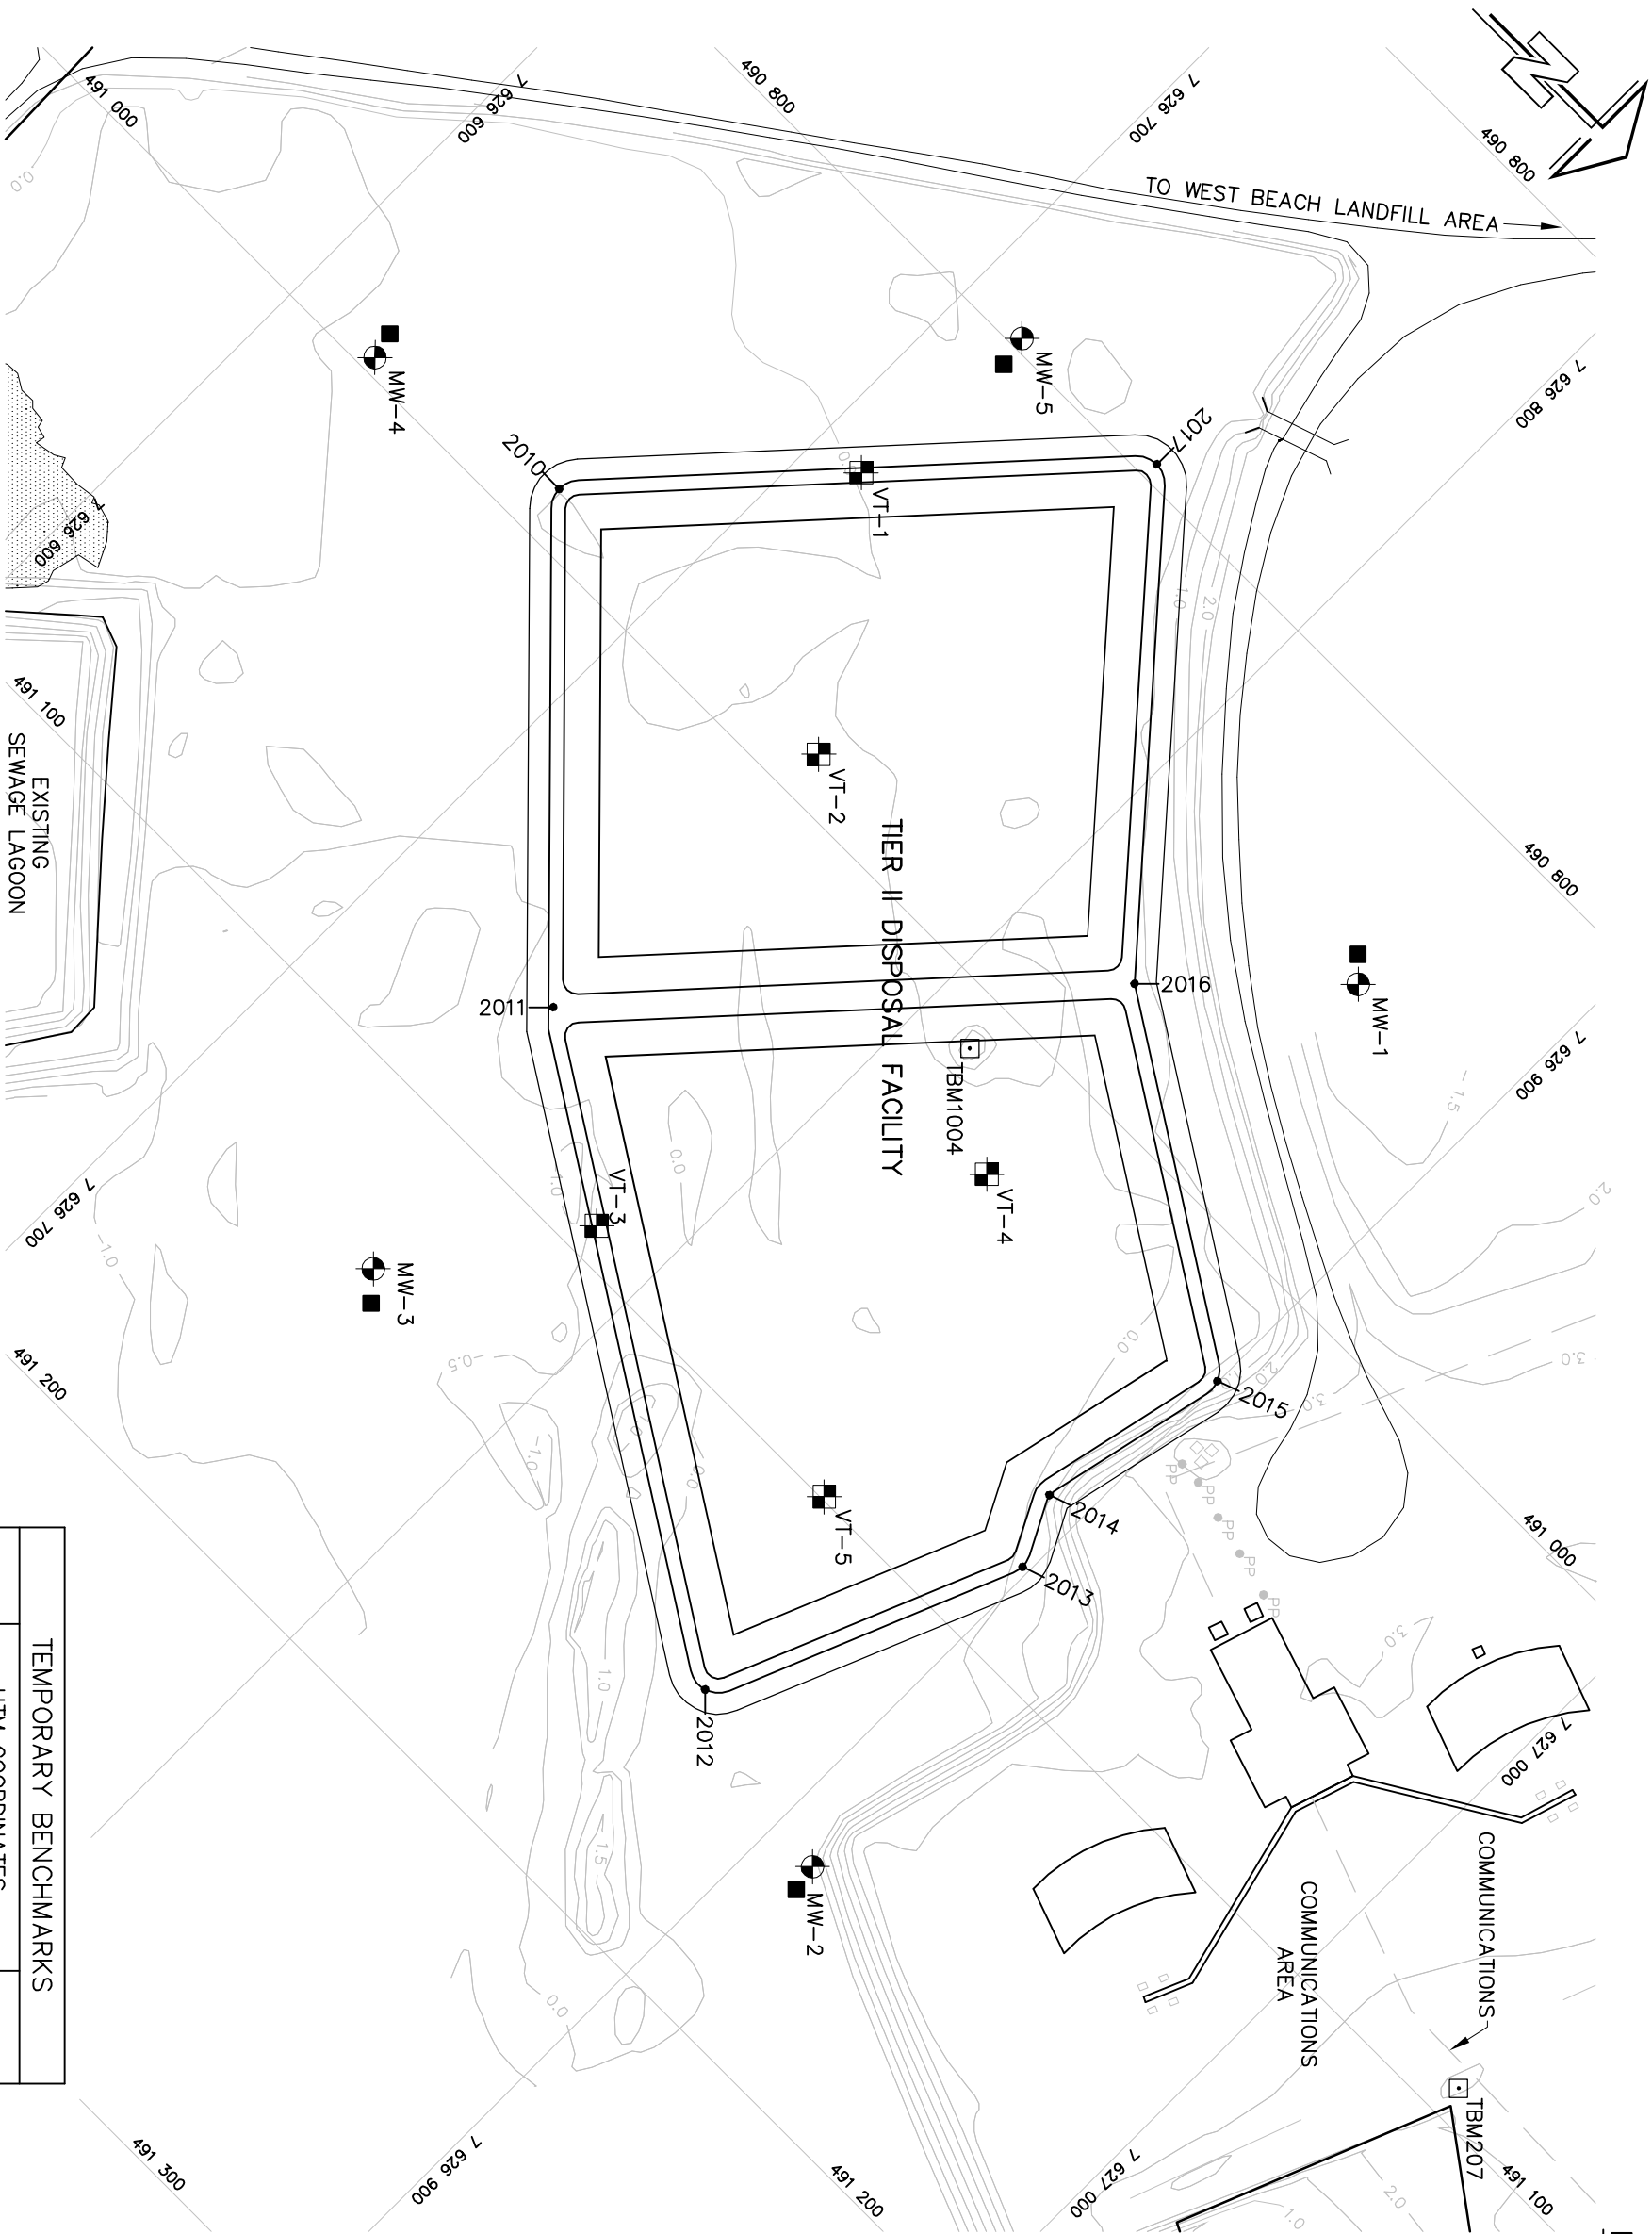

- LEGEND:**
- SURVEY CONTROL MONUMENT
 - TEMPORARY BENCHMARK
 - COORDINATE POINT
 - 2002 MONITORING SOIL SAMPLE LOCATION
 - MONITORING WELL LOCATION
 - VERTICAL THERMISTOR LOCATION

NOTE: DRAWING TO BE UPDATED BASED ON RECORD INFORMATION

TIER II LANDFILL COORDINATE POINTS		
NO.	COORDINATES	
	NORTHING	EASTING
2010	7 626 670.849	490 988.803
2011	7 626 747.784	491 070.866
2012	7 626 869.044	491 144.560
2013	7 626 895.734	491 080.125
2014	7 626 888.397	491 066.030
2015	7 626 897.600	491 024.516
2016	7 626 828.315	490 976.819
2017	7 626 754.320	490 897.711

COORDINATE POINTS (AS-BUILT) VERTICAL THERMISTORS		
NO.	NORTHING	EASTING
VT-1	TBD	TBD
VT-2	TBD	TBD
VT-3	TBD	TBD
VT-4	TBD	TBD
VT-5	TBD	TBD

COORDINATE POINTS (AS BUILT) MONITORING WELLS			
NO.	NORTHING	EASTING	ELEV.
MW-1	7 626 861.7	490 943.6	1.80
MW-2	7 626 911.8	491 156.2	0.38
MW-3	7 626 757.4	491 132.6	-0.05
MW-4	7 626 622.0	490 996.7	0.18
MW-5	7 626 715.5	490 897.5	0.59

TEMPORARY BENCHMARKS			
NO.	UTM COORDINATES		ELEV.
	NORTHING	EASTING	
TBM207	7 627 040.990	491 092.969	3.263
TBM1004	7 626 813.376	491 010.970	1.525

UMA

AECOM

0


15

30

m

SCALE 1:1500

DEW LINE CLEAN UP
LANDFILL MONITORING PLAN
FOX-M HALL BEACH
TIER II DISPOSAL FACILITY
FIGURE FOX-M.6

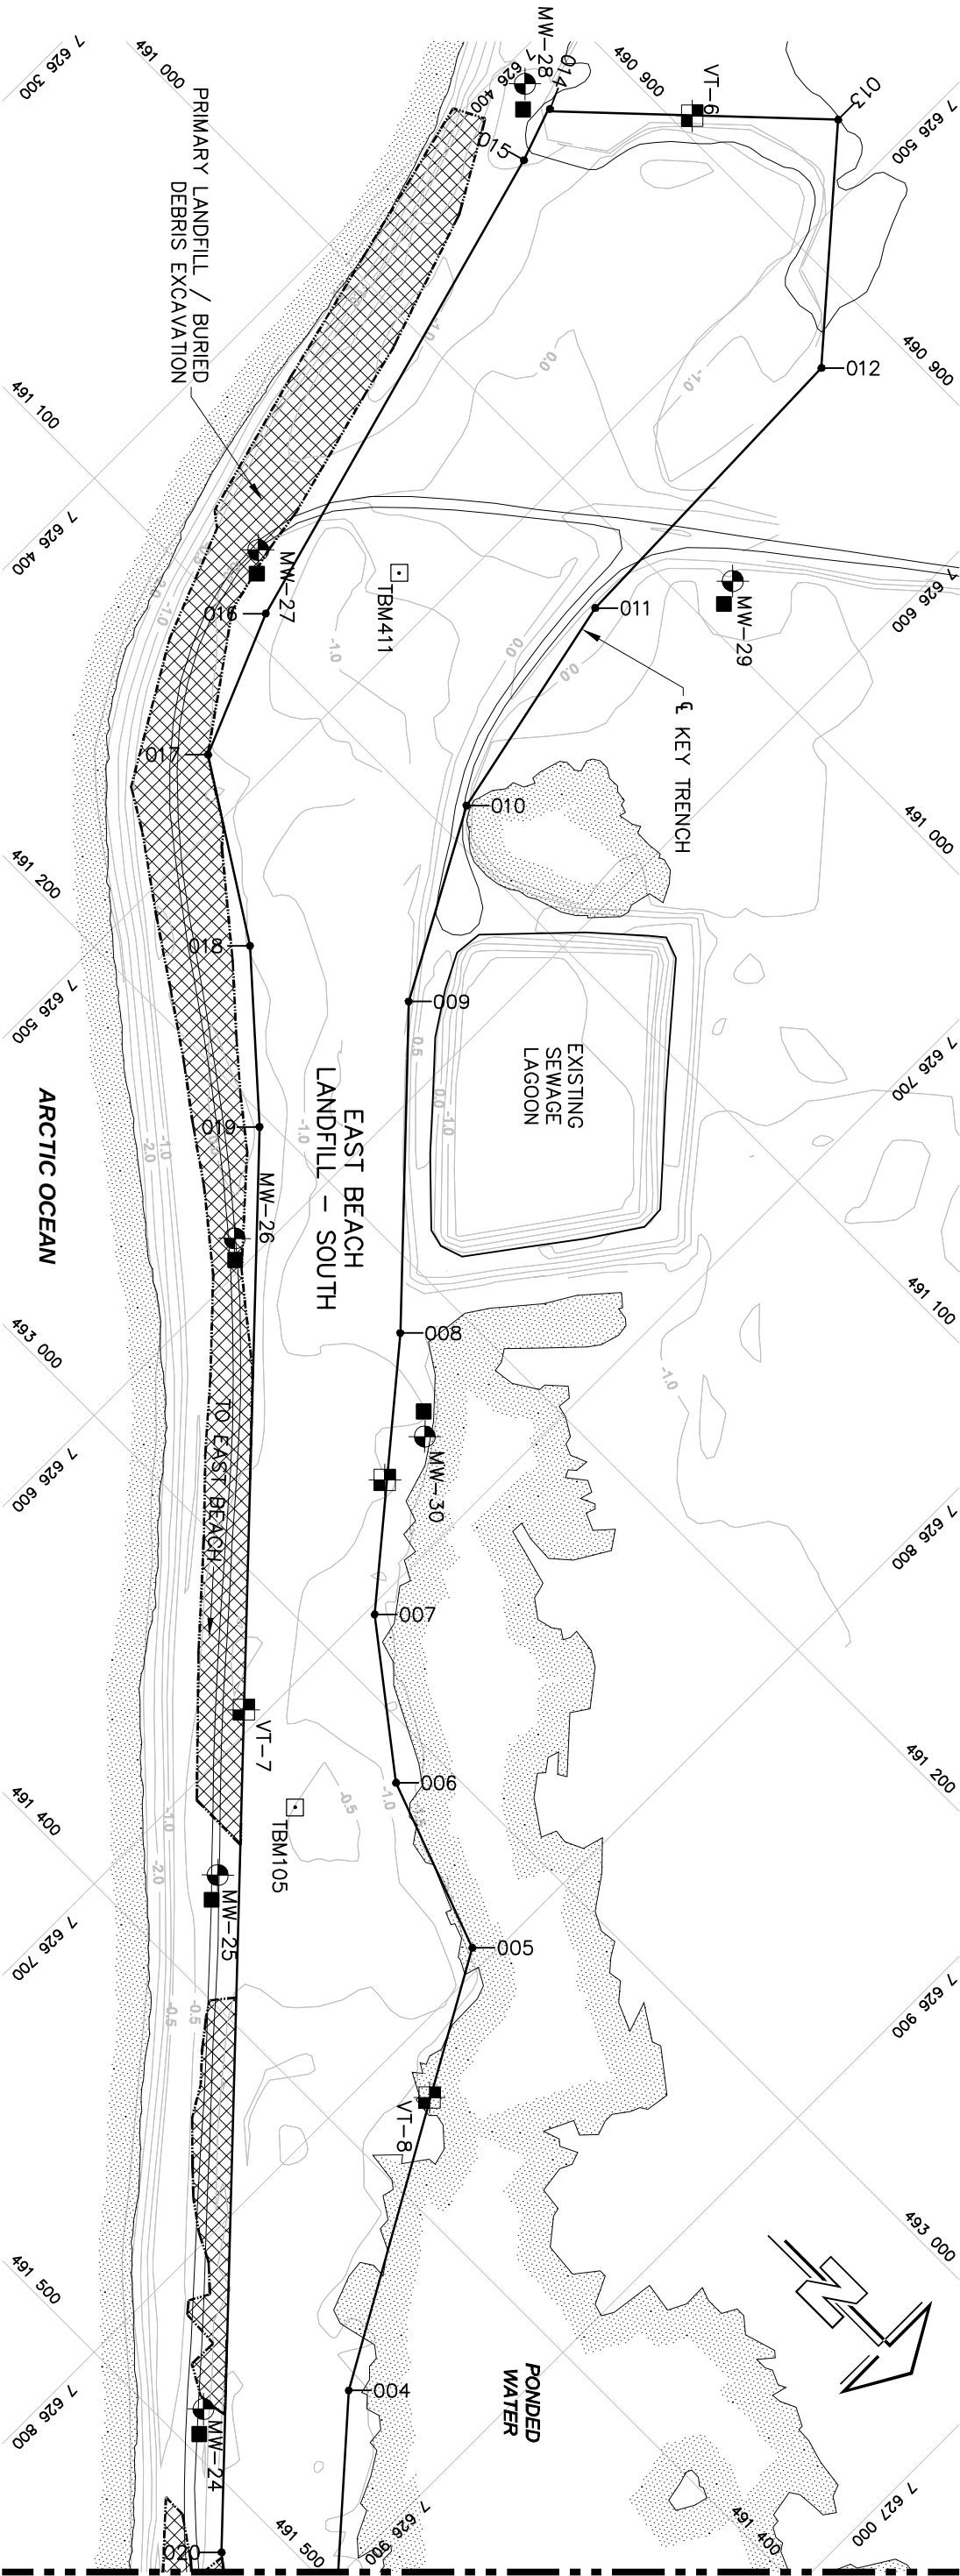

FOR CONTINUATION – REFER TO FIGURE FOX-M.8

LEGEND:

- SURVEY CONTROL MONUMENT
- TEMPORARY BENCHMARK
- COORDINATE POINT
- MONITORING SOIL SAMPLE LOCATION
- MONITORING WELL LOCATION
- VERTICAL THERMISTOR LOCATION

NOTE: DRAWING TO BE UPDATED BASED ON RECORD INFORMATION

COORDINATE POINTS (AS-BUILT)			
VERTICAL THERMISTORS			
NO.	NORTHING	EASTING	
VT-6	TBD	TBD	
VT-7	TBD	TBD	
VT-8	TBD	TBD	


TEMPORARY BENCHMARKS			
UTM COORDINATES			
NO.	NORTHING	EASTING	ELEV.
TBM106	7 627 001.134	491 547.332	-1.054
TBM411	7 626 485.282	491 055.174	-0.112

COORDINATE POINTS (AS BUILT)			
MONITORING WELLS			
NO.	NORTHING	EASTING	ELEV.
MW-24	7 626 835.4	491 488.8	0.01
MW-25	7 626 724.5	491 371.8	0.24
MW-26	7 626 592.2	491 232.3	0.57
MW-27	7 626 450.3	491 080.3	-0.10
MW-28	7 626 407.7	490 923.9	-0.42
MW-29	7 626 558.2	490 985.7	-0.03
MW-30	7 626 675.1	491 234.0	-1.03

0 20 40 m SCALE 1:2000

KEY TRENCH CENTRELINE
COORDINATE POINTS

NO.	COORDINATES		NO.	COORDINATES	
	NORTHING	EASTING		NORTHING	EASTING
004	7 626 920.9	491 555.4	013	7 626 531.6	490 921.2
005	7 626 869.8	491 515.5	014	7 626 534.5	491 020.7
006	7 626 573.7	491 203.2	015	7 626 549.3	491 090.4
007	7 626 533.0	491 166.5	016	7 626 578.7	491 144.6
008	7 626 483.2	491 134.6	017	7 626 647.8	491 217.0
009	7 626 465.4	491 092.2	018	7 626 702.3	491 282.6
010	7 626 423.8	490 940.3	019	7 626 742.8	491 314.0
011	7 626 418.4	490 924.9	020	7 626 794.3	491 332.9
012	7 626 482.1	490 864.6			

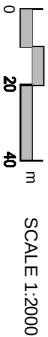

UMA | AECOM

COORDINATE POINTS (AS-BUILT) VERTICAL THERMISTORS		
NO.	NORTHING	EASTING
VT-9	TBD	TBD
VT-10	TBD	TBD
VT-11	TBD	TBD

COORDINATE POINTS (AS BUILT) MONITORING WELLS			
NO.	NORTHING	EASTING	ELEV.
MW-20	7 627 347.8	491 660.5	-0.03
MW-21	7 627 249.3	491 604.4	-0.60
MW-22	7 627 041.6	491 596.1	-0.48
MW-23	TBD	TBD	-
MW-31	7 626 935.6	491 511.6	-0.21

TEMPORARY BENCHMARKS			
NO.	UTM COORDINATES		ELEV.
	NORTHING	EASTING	
TBM106	7 627 001.134	491 547.332	-1.054
TBM301	7 627 278.353	491 558.971	-0.925
TBM302	7 627 377.783	491 614.115	-1.473
TBM303	7 627 345.714	491 656.398	-0.705
TBM304	7 627 255.400	491 612.301	-0.409

KEY TRENCH CENTRELINE COORDINATE POINTS		
NO.	COORDINATES	
	NORTHING	EASTING
001	7 627 051.5	491 548.6
002	7 627 038.0	491 581.9
003	7 626 974.4	491 580.9
020	7 626 794.3	491 332.9
021	7 626 862.4	491 53.8
022	7 626 922.0	491 520.7
023	7 627 022.2	491 537.3
024	7 627 284.0	491 606.3
025	7 627 315.2	491 623.1
026	7 627 342.0	491 648.6
027	7 627 356.7	491 647.5
028	7 627 657.0	491 599.8
029	7 627 345.1	491 580.9
030	7 627 288.7	491 557.8
031	7 627 278.5	491 564.1

-  SURVEY CONTROL MONUMENT
-  TEMPORARY BENCHMARK
-  COORDINATE POINT
-  MONITORING SOIL SAMPLE LOCATION
-  MONITORING WELL LOCATION
-  VERTICAL THERMISTOR LOCATION

NOTE: DRAWING TO BE UPDATED BASED ON
RECORD INFORMATION

DEW LINE CLEAN UP
LANDFILL MONITORING PLAN
FOX-M HALL BEACH
EAST BEACH LANDFILL - NORTH
FIGURE FOX-M.8

FOR CONTINUATION — REFER TO FIGURE FOX-M.7

