


DEW LINE CLEAN UP PROJECT

NOTE:
THIS DRAWING PACKAGE HAS BEEN
REVISED BASED ON INFORMATION
SUPPLIED BY DEFENCE CONSTRUCTION
CANADA IN 2007.
CONTRACT DRAWINGS INCLUDE THE
ENGINEER'S STAMP.

DRAWING INDEX					
DRAWING No.	TITLE	DRAWING No.	TITLE	DRAWING No.	TITLE
SITING		SITING		STRUCTURAL	
H-H11/2-9101-101	OVERALL SITE PLAN	H-H11/2-9101-110	AIRSTRIp AREA SITE PLAN	H-H11/2-9101-201	MAIN CAMP AREA DEMOLITION SITE PLAN
H-H11/2-9101-102	PROJECT LAYOUT	H-H11/2-9101-111	WEST COMMUNICATIONS AREA SITE PLAN	H-H11/2-9101-202	AIRSTRIp, NORTH BEACH AND COMMUNICATIONS AREAS DEMOLITION SITE PLANS
H-H11/2-9101-103	STATION AREA NORTH SITE PLAN	H-H11/2-9101-112	NON-HAZARDOUS WASTE LANDFILL CROSS SECTIONS AND DETAIL	H-H11/2-9101-203	ATWELL DORMITORY PLAN, SECTION AND ELEVATION
H-H11/2-9101-104	STATION AREA SOUTH SITE PLAN	H-H11/2-9101-113	TIER II DISPOSAL FACILITY-REVISED CROSS SECTIONS AND DETAIL	H-H11/2-9101-204	TROPO BUILDING / FACILITY CONTROL OFFICE PLAN AND SECTION
H-H11/2-9101-105	EAST BEACH LANDFILL NORTH AREA SITE PLAN	H-H11/2-9101-114	TIER II DISPOSAL FACILITY DETAIL AND LANDFARM SECTION		
H-H11/2-9101-106	EAST BEACH LANDFILL SOUTH AREA SITE PLAN	H-H11/2-9101-115	EAST BEACH LANDFILLS OVERALL LAYOUT		
H-H11/2-9101-107	EAST BEACH AND WEST BEACH LANDFILL AREAS SITE PLAN	H-H11/2-9101-116	EAST BEACH LANDFILLS CROSS SECTIONS	© COPYRIGHT HER MAJESTY THE QUEEN IN RIGHT OF CANADA 2011, AS REPRESENTED BY THE MINISTER OF NATIONAL DEFENCE.	
H-H11/2-9101-108	WEST BEACH BORROW AREA SITE PLAN	H-H11/2-9101-117	MISCELLANEOUS DETAILS		
H-H11/2-9101-109	NORTH BEACH AREA SITE PLAN	H-H11/2-9101-118	MISCELLANEOUS DETAILS		



FOX-M HALL BEACH AS-BUILT DRAWINGS

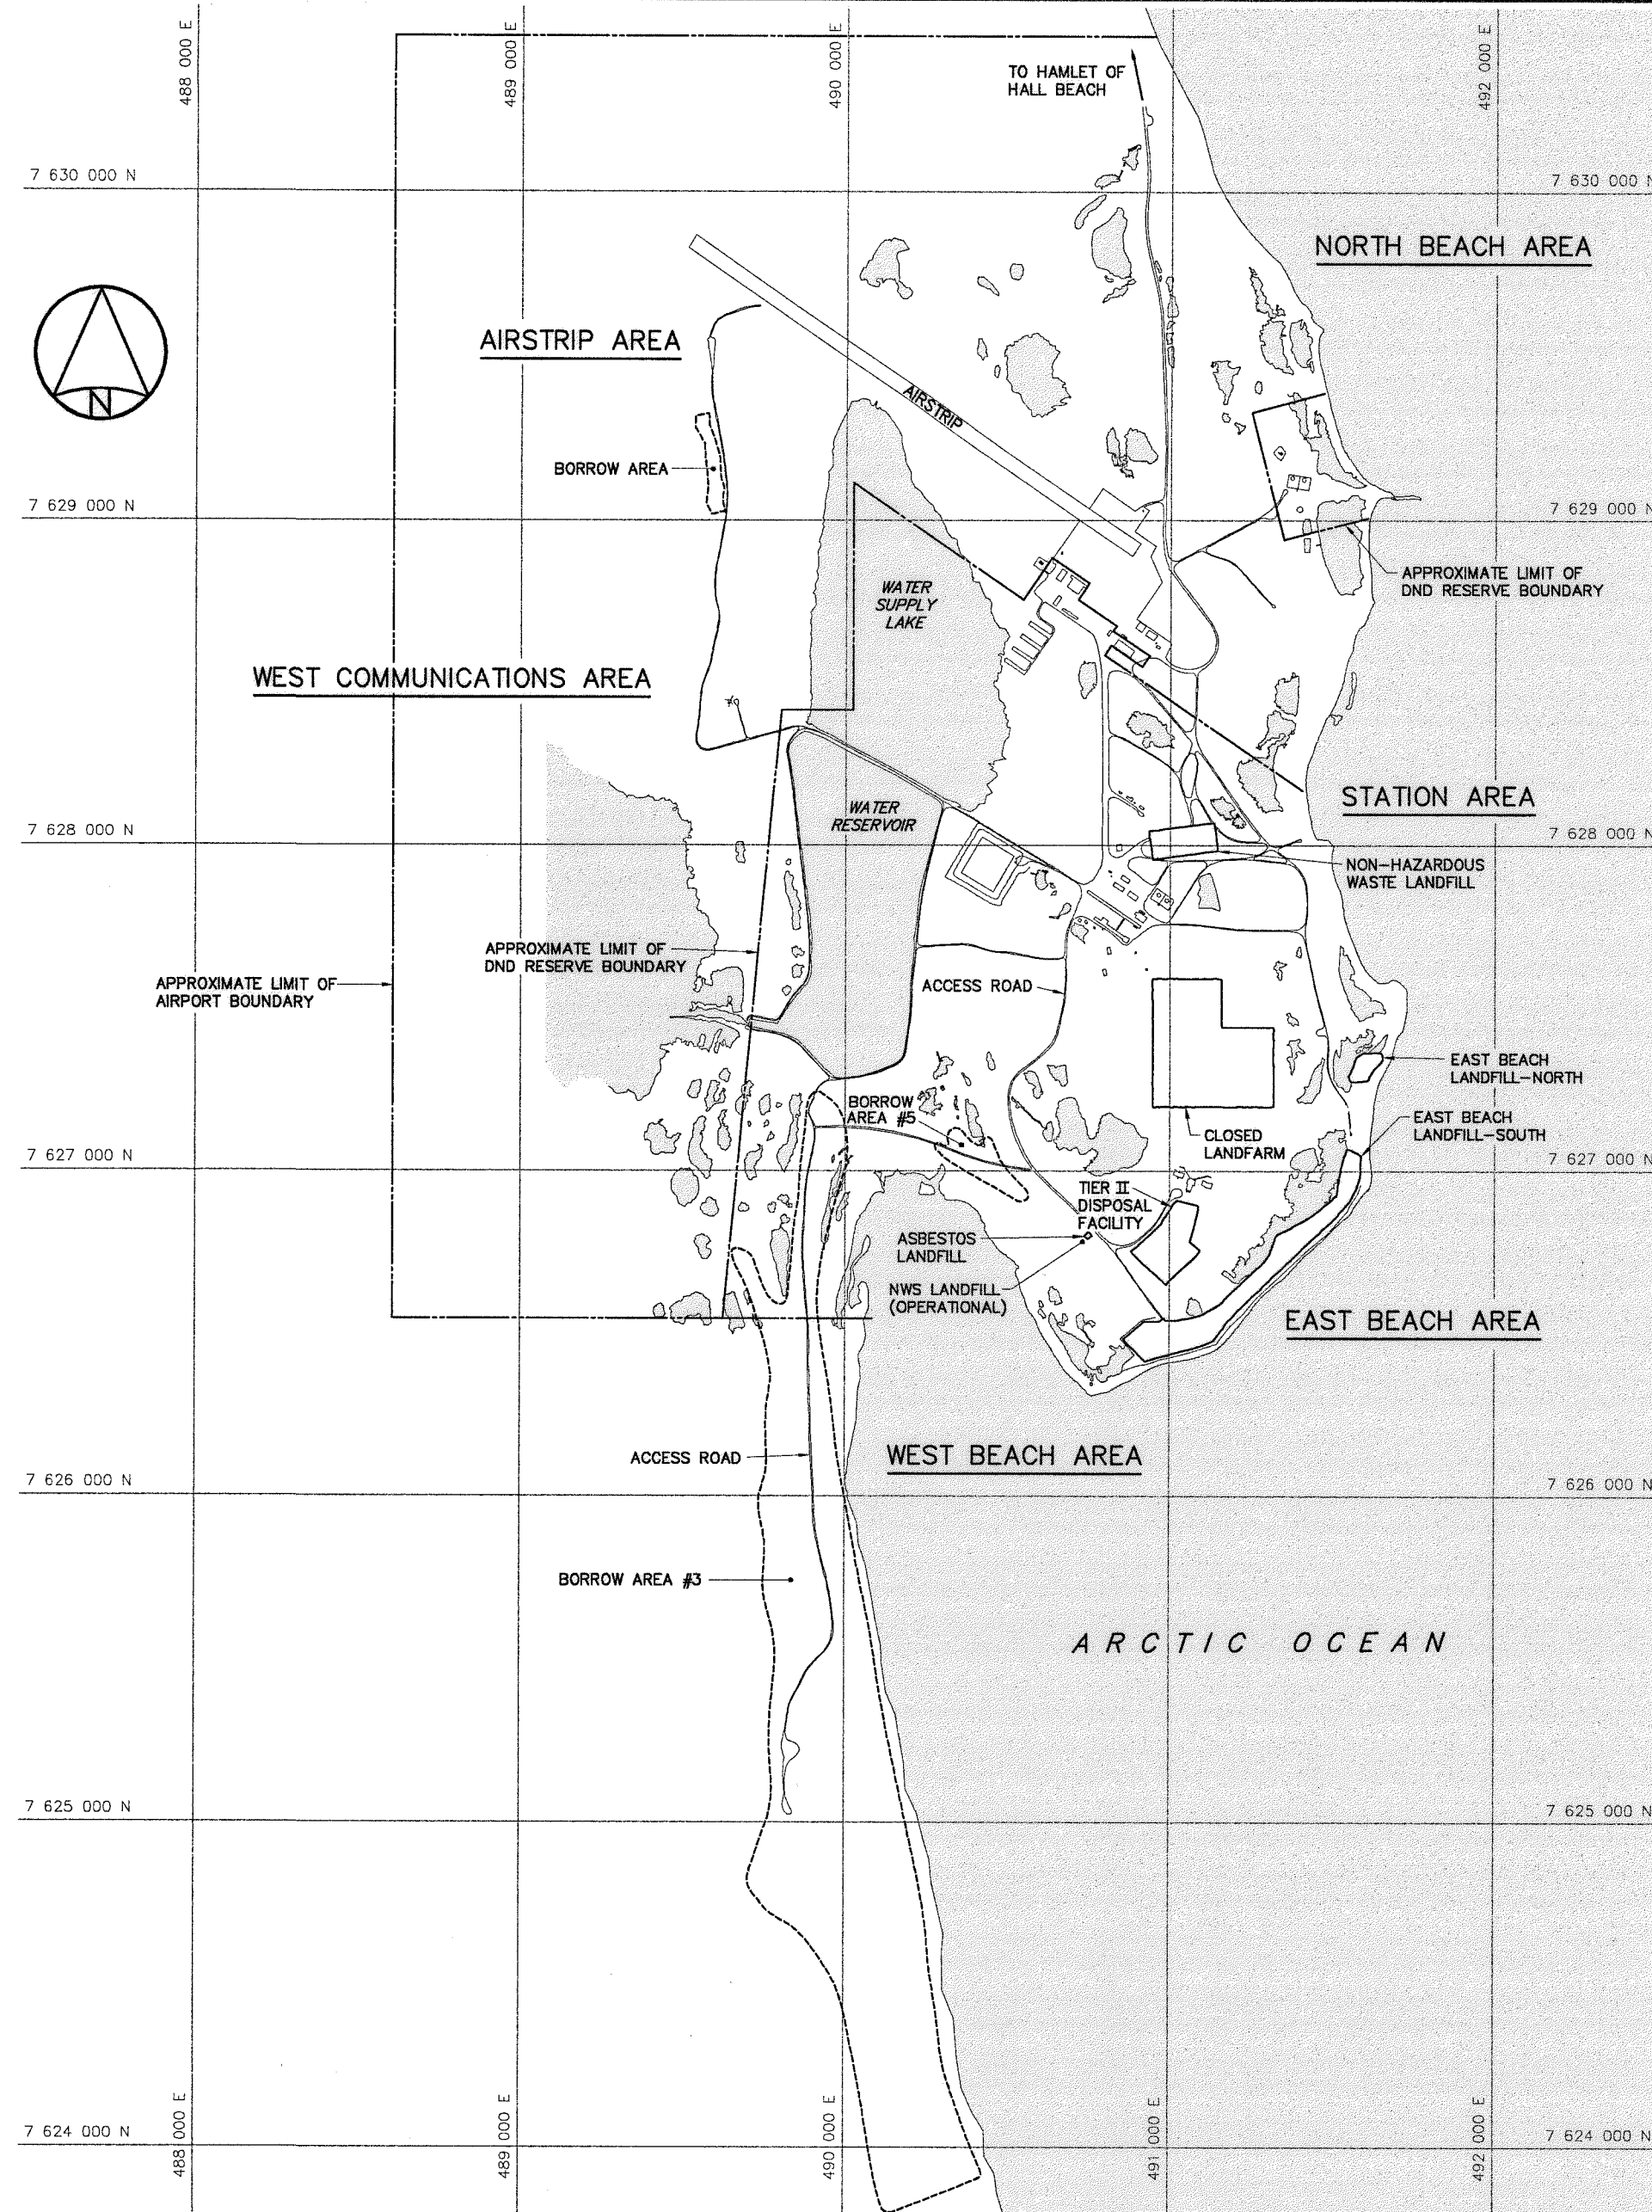



National
Défense



Défense
nationale

Headquarters
Quartier général

General Notes:

1. ALL COORDINATES ARE REFERENCED TO NAD83 (CSRS), UTM ZONE 17. ALL ELEVATIONS REFER TO GEODETIC DATUM.
2. ALL NON-HAZARDOUS DEBRIS REMOVED WITHIN THE PLAN AREA WAS PLACED IN THE NON-HAZARDOUS WASTE LANDFILL.


Legend:

- APPROXIMATE LOCATION OF PROPERTY BOUNDARY
- APPROXIMATE EXTENT OF BORROW AREA
- BODY OF WATER

0	11-03-03	AS-BUILT DRAWING	RRM	
No.	DATE	REVISION	REVISION	APPR.



March 9/11

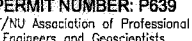PERMIT TO PRACTICE
AECOM Canada Ltd.
Signature: 
Date: 
PERMIT NUMBER: P639
NWT/NU Association of Professional Engineers and Geoscientists



SCALE - ECHELLE 200 100 0 200 400 600m

PROJECT - PROJET
FOX-M HALL BEACH

DEW LINE CLEAN UP

© COPYRIGHT
HER MAJESTY THE QUEEN IN RIGHT OF
CANADA 2011, AS REPRESENTED BY THE
MINISTER OF NATIONAL DEFENCE.

TRADE - MÉTIER	SITING	DATE	2011-03-03
----------------	--------	------	------------

SUBJECT - SUJET

OVERALL SITE PLAN

PRODUCTION		CONCURRENCE - ASSENTIMENT	
DESIGNED ÉTUDE	RRM	DES OFF AGENT CONCEPT	
DRAWN DESSINE	IC	SECT HD CHEF SECT	
CHECKED VÉRIFIÉ	BMH	DES MGR GEST CONCEPT	
COORDINATION	DTM	REVIEWED - REVU	


DWG. NO. - DESSIN NO.
H-H11/2-9101-101

Canada

NOTE: BASELINE STATIONS SHOWN ARE IN IMPERIAL UNITS.

FORMER DEBRIS LOCATION —

WEST COMMUNICATIONS AREA
(SEE DWG. H-H11/2-9191-111)

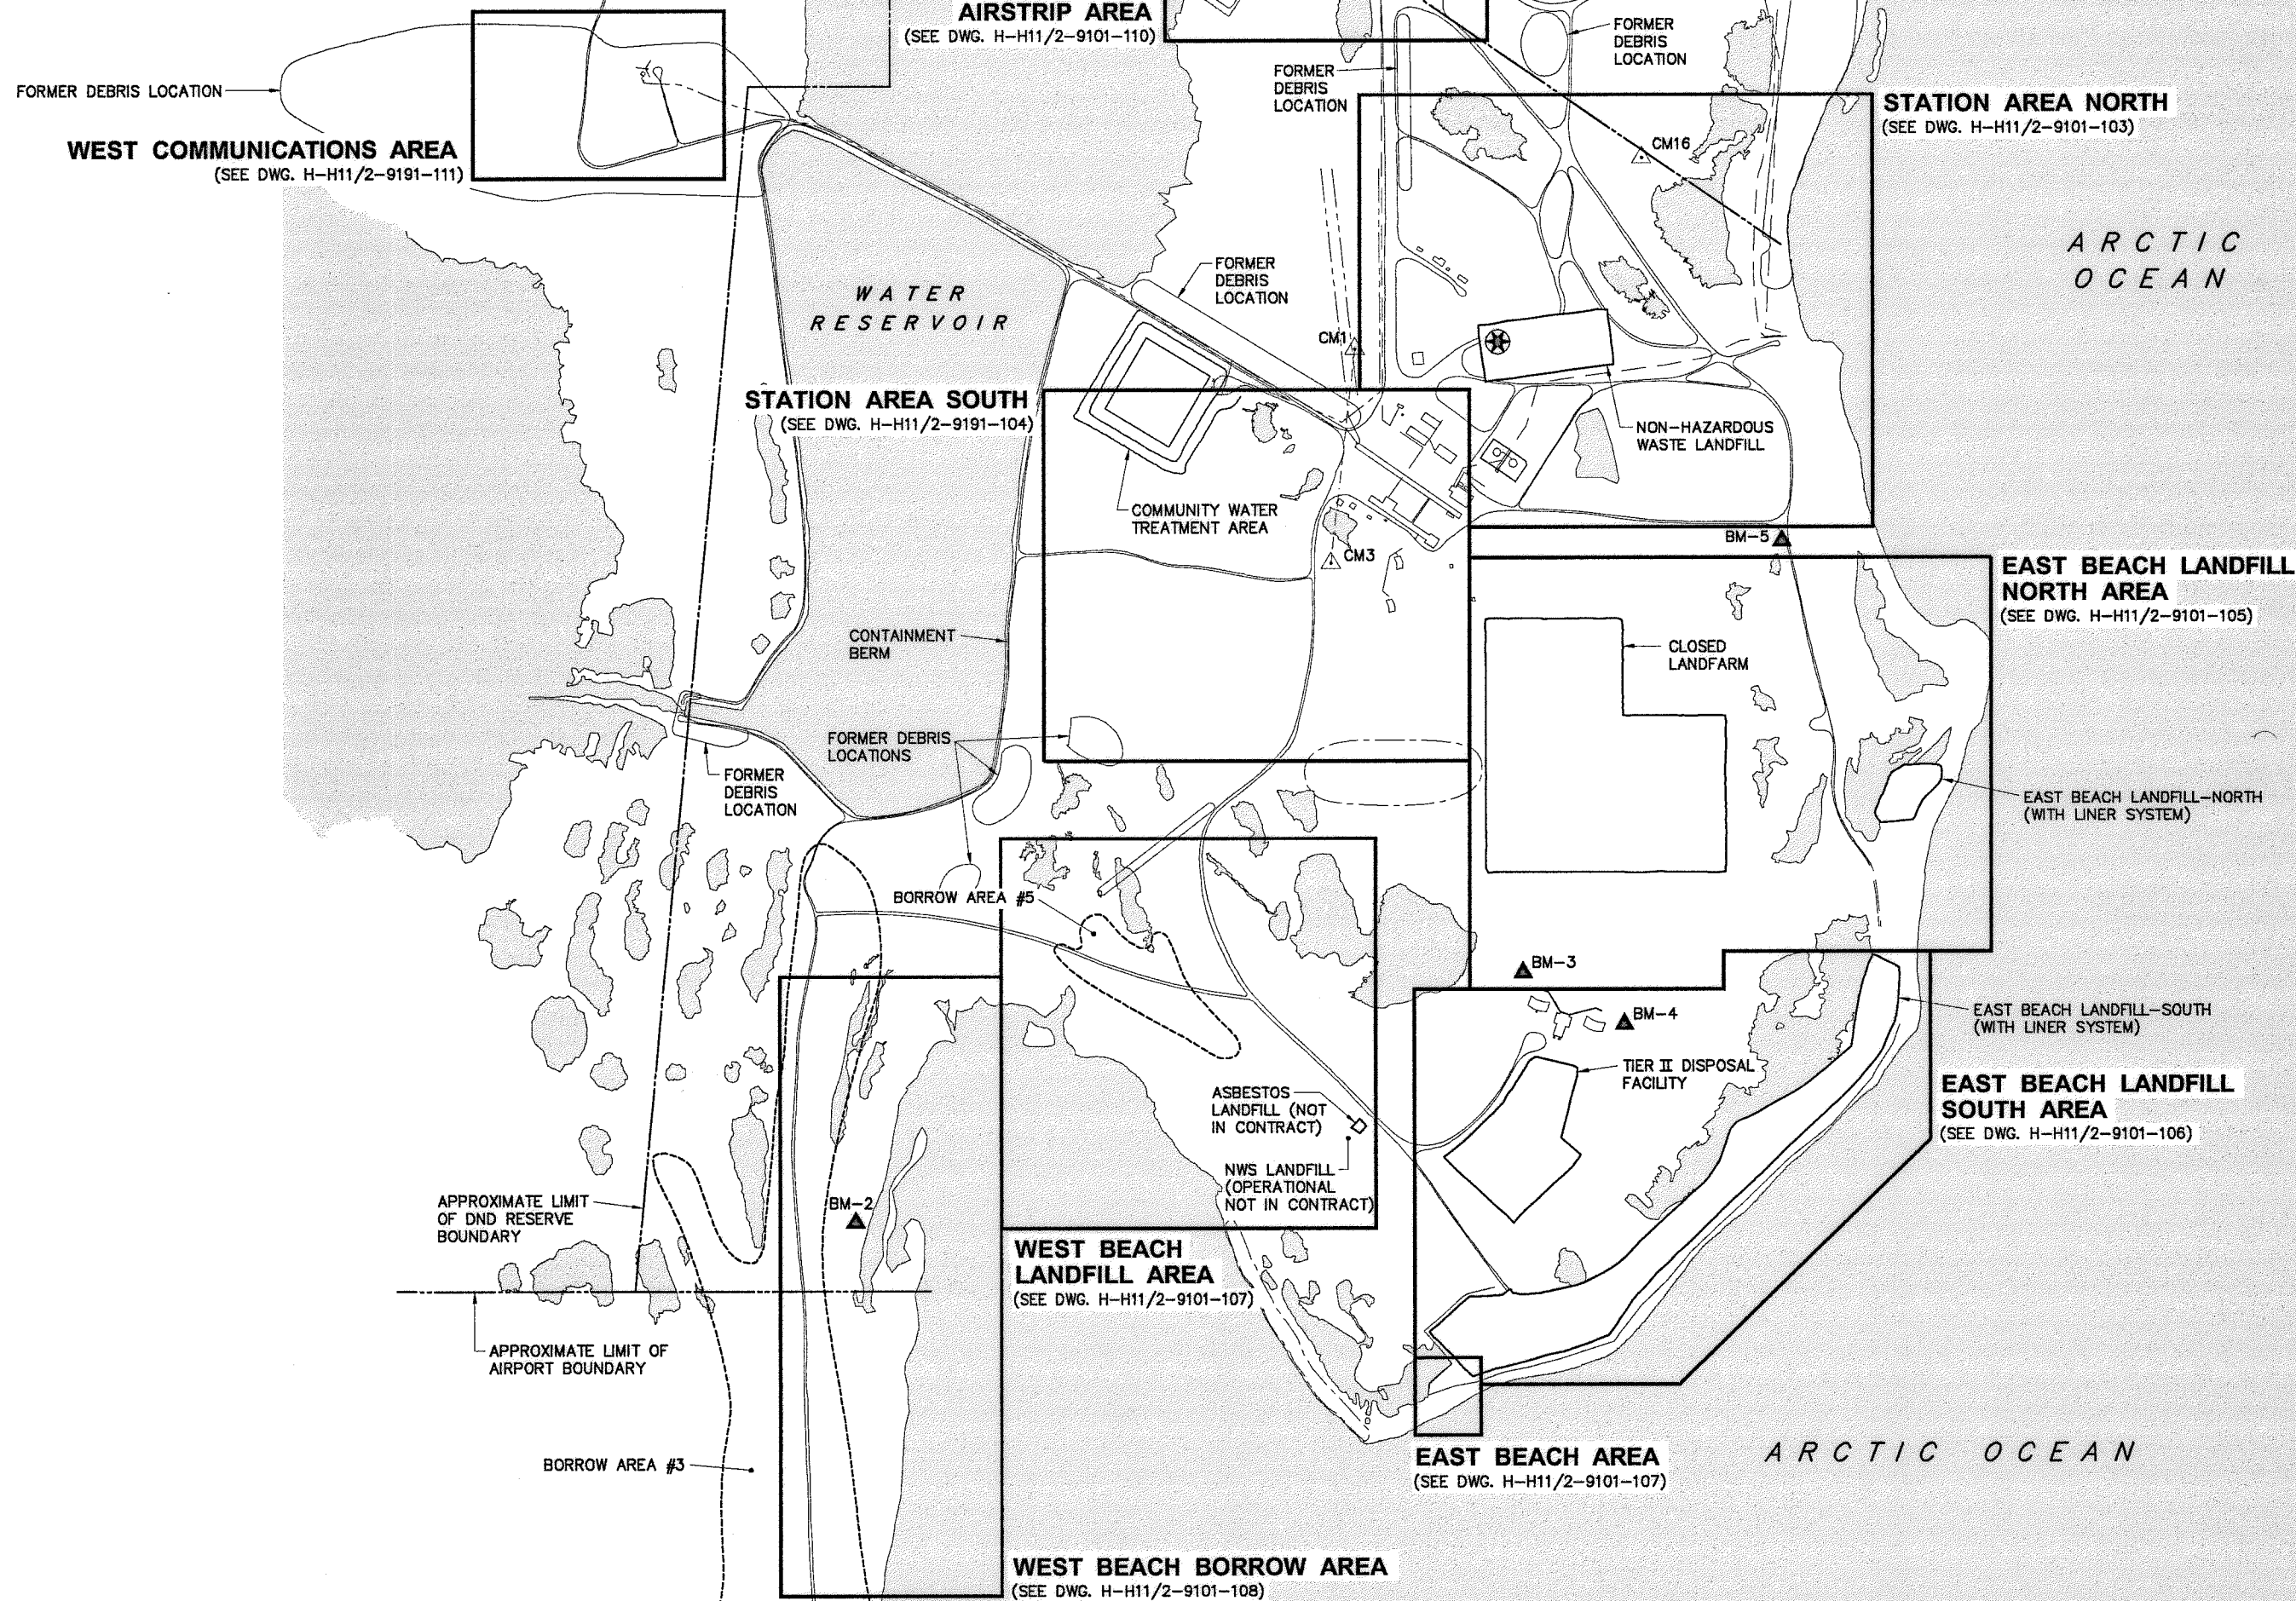

NORTH BEACH AREA
(SEE DWG. H-H11/2-9101-109)

 **National** **Défense**
Defence **nationale**

Headquarters
Quartier général

General Notes:

1. ALL COORDINATES ARE REFERENCED TO NAD83 (CSRS), UTM ZONE 17. ALL ELEVATIONS REFER TO GEODETIC DATUM.
2. ALL DIMENSIONS ARE IN METRES UNLESS NOTED OTHERWISE.
3. ALL LONG RANGE RADAR (LRR) FACILITIES WERE OPERATIONAL.
4. ARCHAEOLOGICAL FEATURES LOCATED AS PER ENVIRONMENTAL CLEAN UP STUDY OF 21 DEW LINE SITES IN CANADA, VOL. 18, UMA 1991.
5. FOR PERMANENT SURVEY CONTROL (BENCHMARK) INSTALLATION DETAIL, SEE DWG. H-H11/2-9101-117.

Legend:

- | | |
|---|---|
|  | SURVEY CONTROL MONUMENT |
|  | PERMANENT BENCHMARK
LOCATION (6) |
|  | APPROXIMATE LOCATION OF
COMMEMORATIVE PLAQUE |
|  | APPROXIMATE LOCATION OF
PROPERTY BOUNDARY |
|  | ARCHAEOLOGICAL FEATURE |
|  | BODY OF WATER |

0	11-03-03	AS-BUILT DRAWING		RRM
No.	DATE	REVISION	REVISION	APPR.



PERMIT TO PRACTICE
AECOM Canada Ltd.
Signature: *[Signature]*
Date: *Dec 9/11*
PERMIT NUMBER: P63
IWT/NU Association of Professional Engineers and Geoscientists

HATCH

SCALE - ECHELLE 100 50 0 100 200 300m

PROJECT - PROJCT
FOX-M HALL BEACH

DEW LINE CLEAN UP

© COPYRIGHT
HER MAJESTY THE QUEEN IN RIGHT OF
CANADA 2011, AS REPRESENTED BY THE
MINISTER OF NATIONAL DEFENCE.

TRADE - METIER	SITING	DATE
		2011-03-03


SUBJECT - SUJET

PROJECT LAYOUT

PRODUCTION		CONCURRENCE - ASSESSMENT	
DESIGNED ETUDIE	<i>RRM</i>		DES OFF AGENT CONCEPT
DRAWN DESSINE	<i>IC</i>		SECT HD CHEF SECT
CHECKED VERIFIE	<i>BNH</i>		DES MGR GEST CONCEPT
COORDINATION <i>DTM</i>		REVIEWED - REVU	

DWG. NO. - DESSIN NO.
H-H11/2-9101-102

Canada

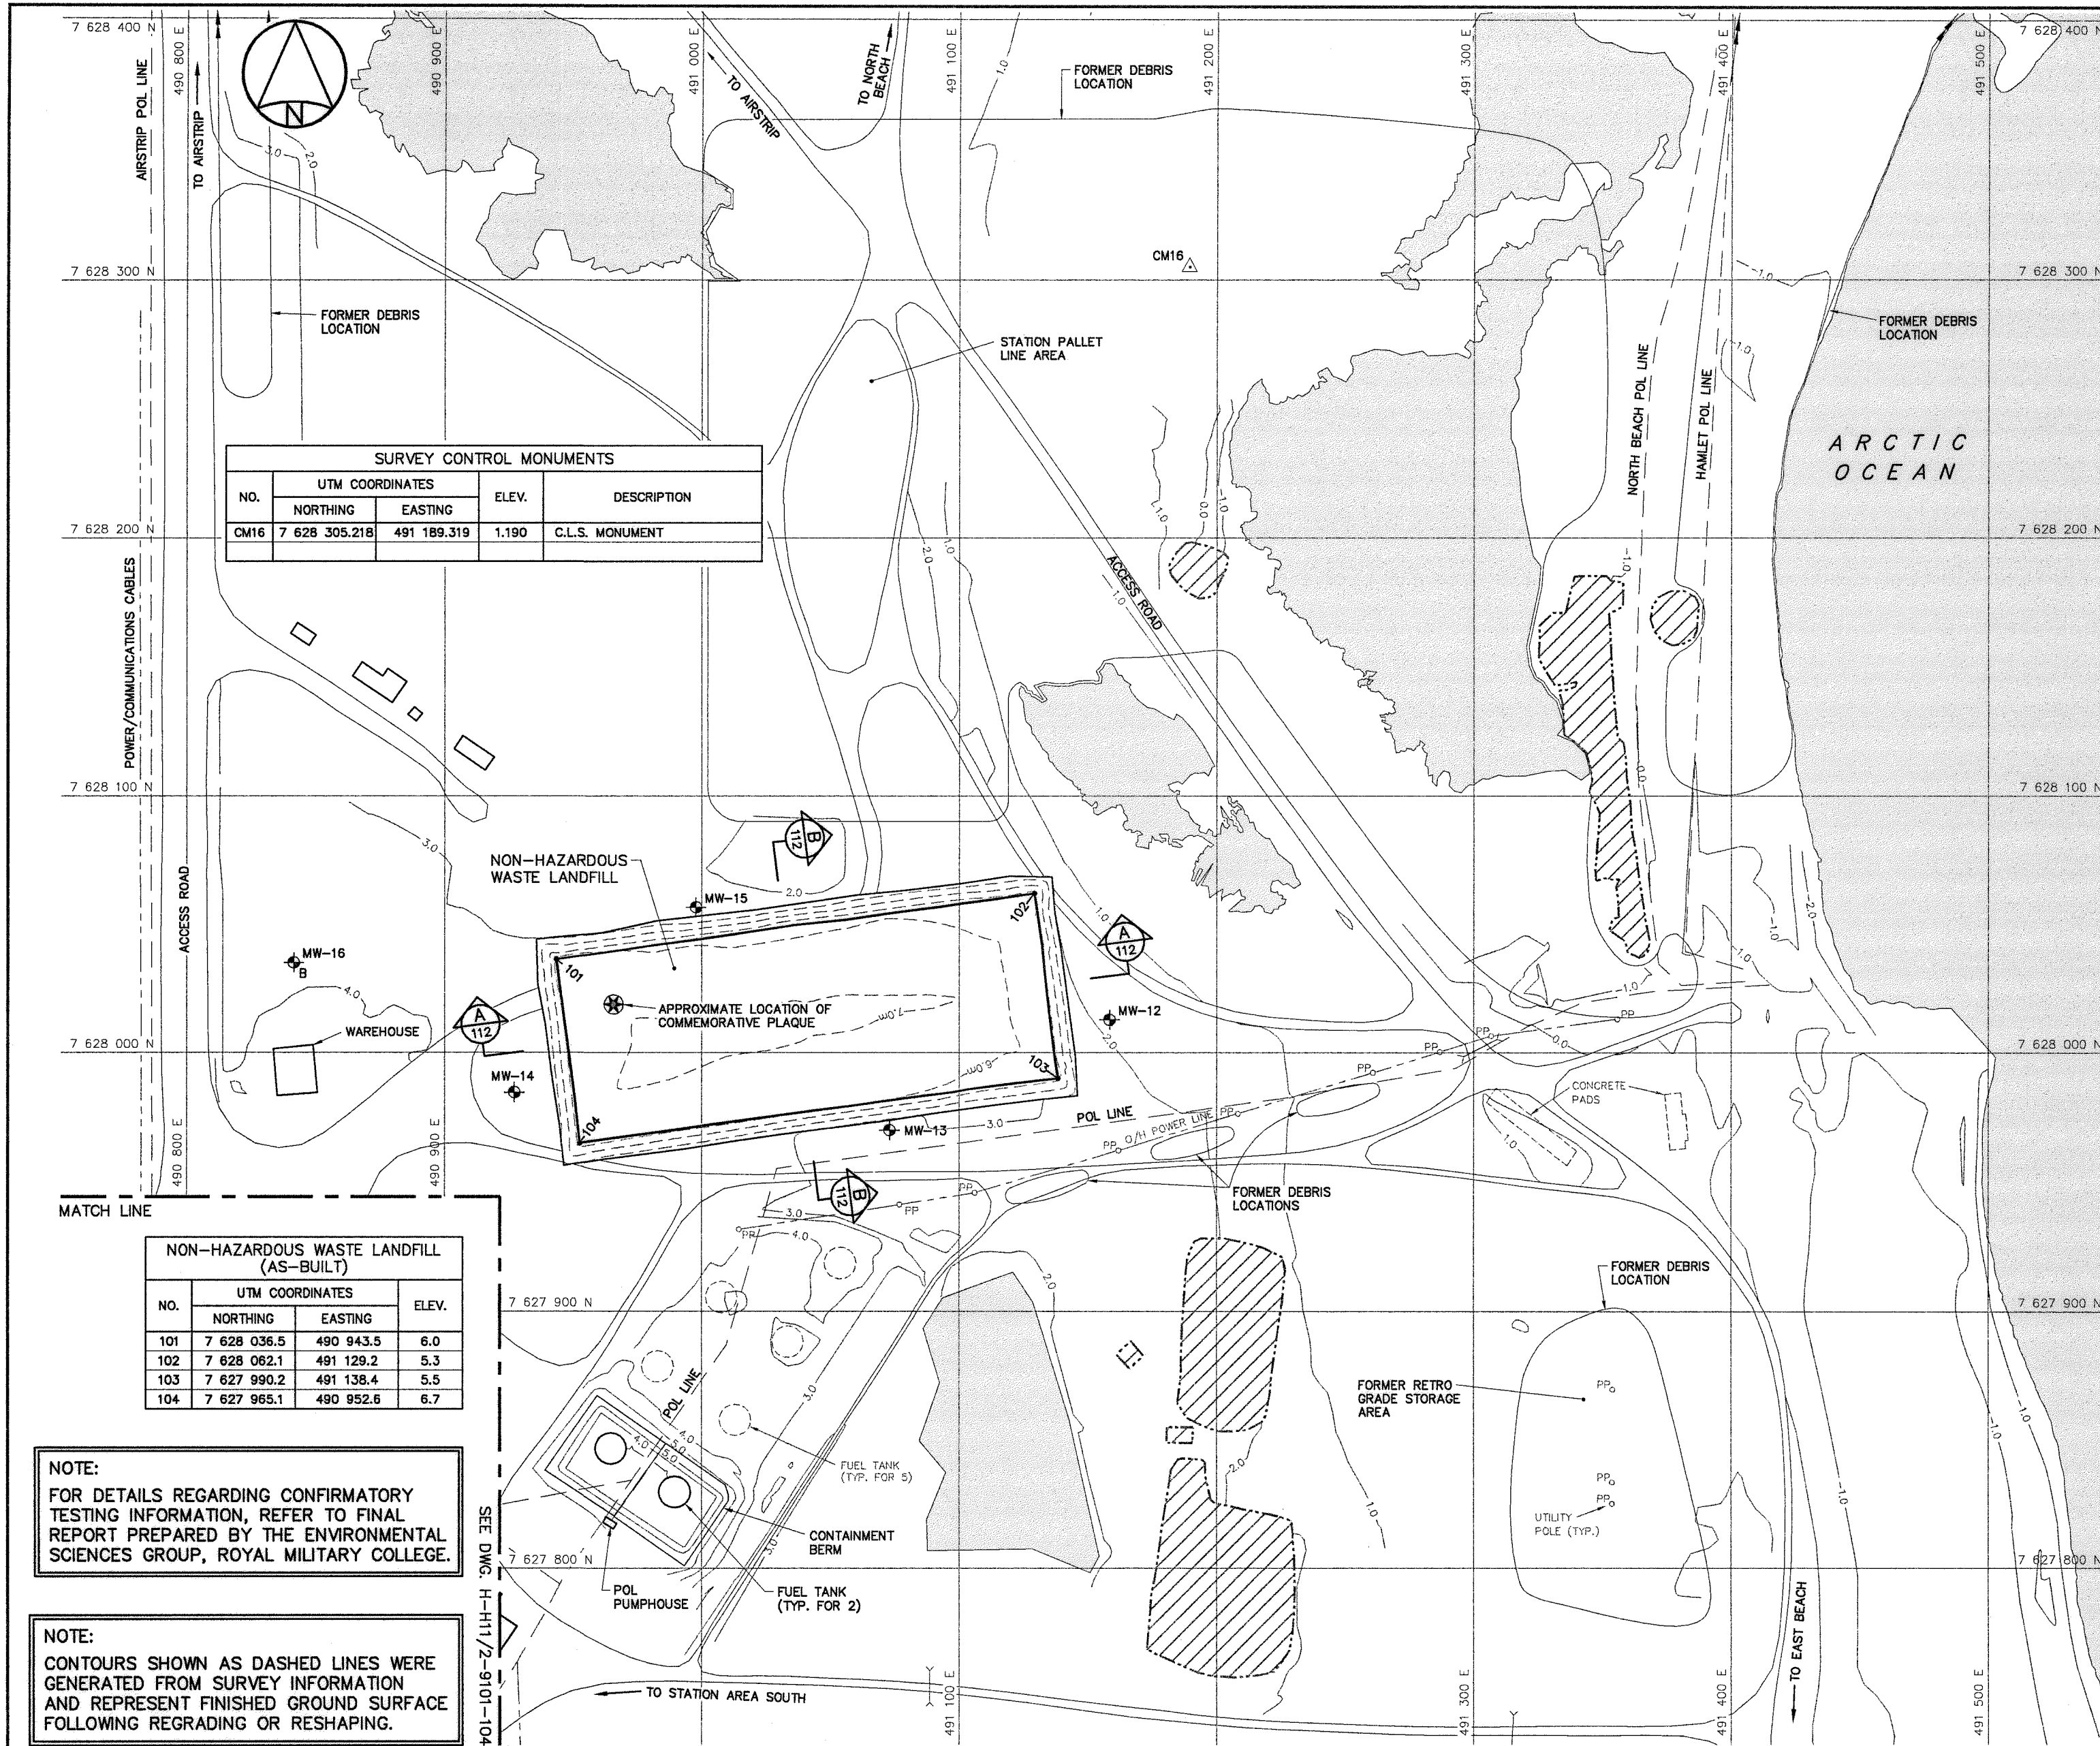

SURVEY CONTROL MONUMENTS				
NO.	UTM COORDINATES		ELEV.	DESCRIPTION
	NORTHING	EASTING		
CM16	7 628 305.218	491 189.319	1.190	C.L.S. MONUMENT

NON-HAZARDOUS WASTE LANDFILL (AS-BUILT)			
NO.	UTM COORDINATES		ELEV.
	NORTHING	EASTING	
101	7 628 036.5	490 943.5	6.0
102	7 628 062.1	491 129.2	5.3
103	7 627 990.2	491 138.4	5.5
104	7 627 965.1	490 952.6	6.7

NOTE:
FOR DETAILS REGARDING CONFIRMATORY TESTING INFORMATION, REFER TO FINAL REPORT PREPARED BY THE ENVIRONMENTAL SCIENCES GROUP, ROYAL MILITARY COLLEGE.

NOTE:
CONTOURS SHOWN AS DASHED LINES WERE GENERATED FROM SURVEY INFORMATION AND REPRESENT FINISHED GROUND SURFACE FOLLOWING REGRADING OR RESHAPING.



National
Défense



Défense
nationale

Headquarters
Quartier général

General Notes:

- ALL COORDINATES ARE REFERENCED TO NAD83 (CSRS), UTM ZONE 17. ALL ELEVATIONS REFER TO GEODETIC DATUM.
- ALL DIMENSIONS ARE IN METRES UNLESS NOTED OTHERWISE.
- ALL LONG RANGE RADAR (LRR) FACILITIES WERE OPERATIONAL.
- FOR MONITORING WELL INSTALLATION DETAIL AND COORDINATE POINTS, SEE DWG. H-H11/2-9101-117.

Legend:



SURVEY CONTROL MONUMENT



COORDINATE POINT



MONITORING WELL LOCATION (4)



BACKGROUND MONITORING WELL LOCATION (1)



COMPLETED LANDFILL OR BURIED DEBRIS EXCAVATION



FORMER BUILDING, STRUCTURE OR TANK LOCATION



BODY OF WATER

011-03-03

AS-BUILT DRAWING

RRM

No.	DATE	REVISION	REVISION	APPR.



PERMIT TO PRACTICE
AECOM Canada Ltd.
Signature: 
Date: 
PERMIT NUMBER: P639
NWT/NJ Association of Professional Engineers and Geoscientists

AECOM

HATCH

SCALE - ECHELLE 20 10 0 20 40 60m

PROJECT - PROJET
FOX-M HALL BEACH

DEW LINE CLEAN UP

© COPYRIGHT
HER MAJESTY THE QUEEN IN RIGHT OF CANADA 2011, AS REPRESENTED BY THE MINISTER OF NATIONAL DEFENCE.

TRADE - MÉTIER
SITING


DATE
2011-03-03

SUBJECT - SUJET
STATION AREA NORTH
SITE PLAN

PRODUCTION	CONCURRENCE - ASSENTIMENT
DESIGNED ETUDIE RRM	DES OFF AGENT CONCEPT
DRAWN DESSINE AC	SECT HD CHIEF SECT
CHECKED VÉRIFIÉ BNH	DES MGR GEST CONCEPT
COORDINATION DTM	REVIEWED - REVU

DWG. NO. - DESSIN NO.
H-H11/2-9101-103

Canada

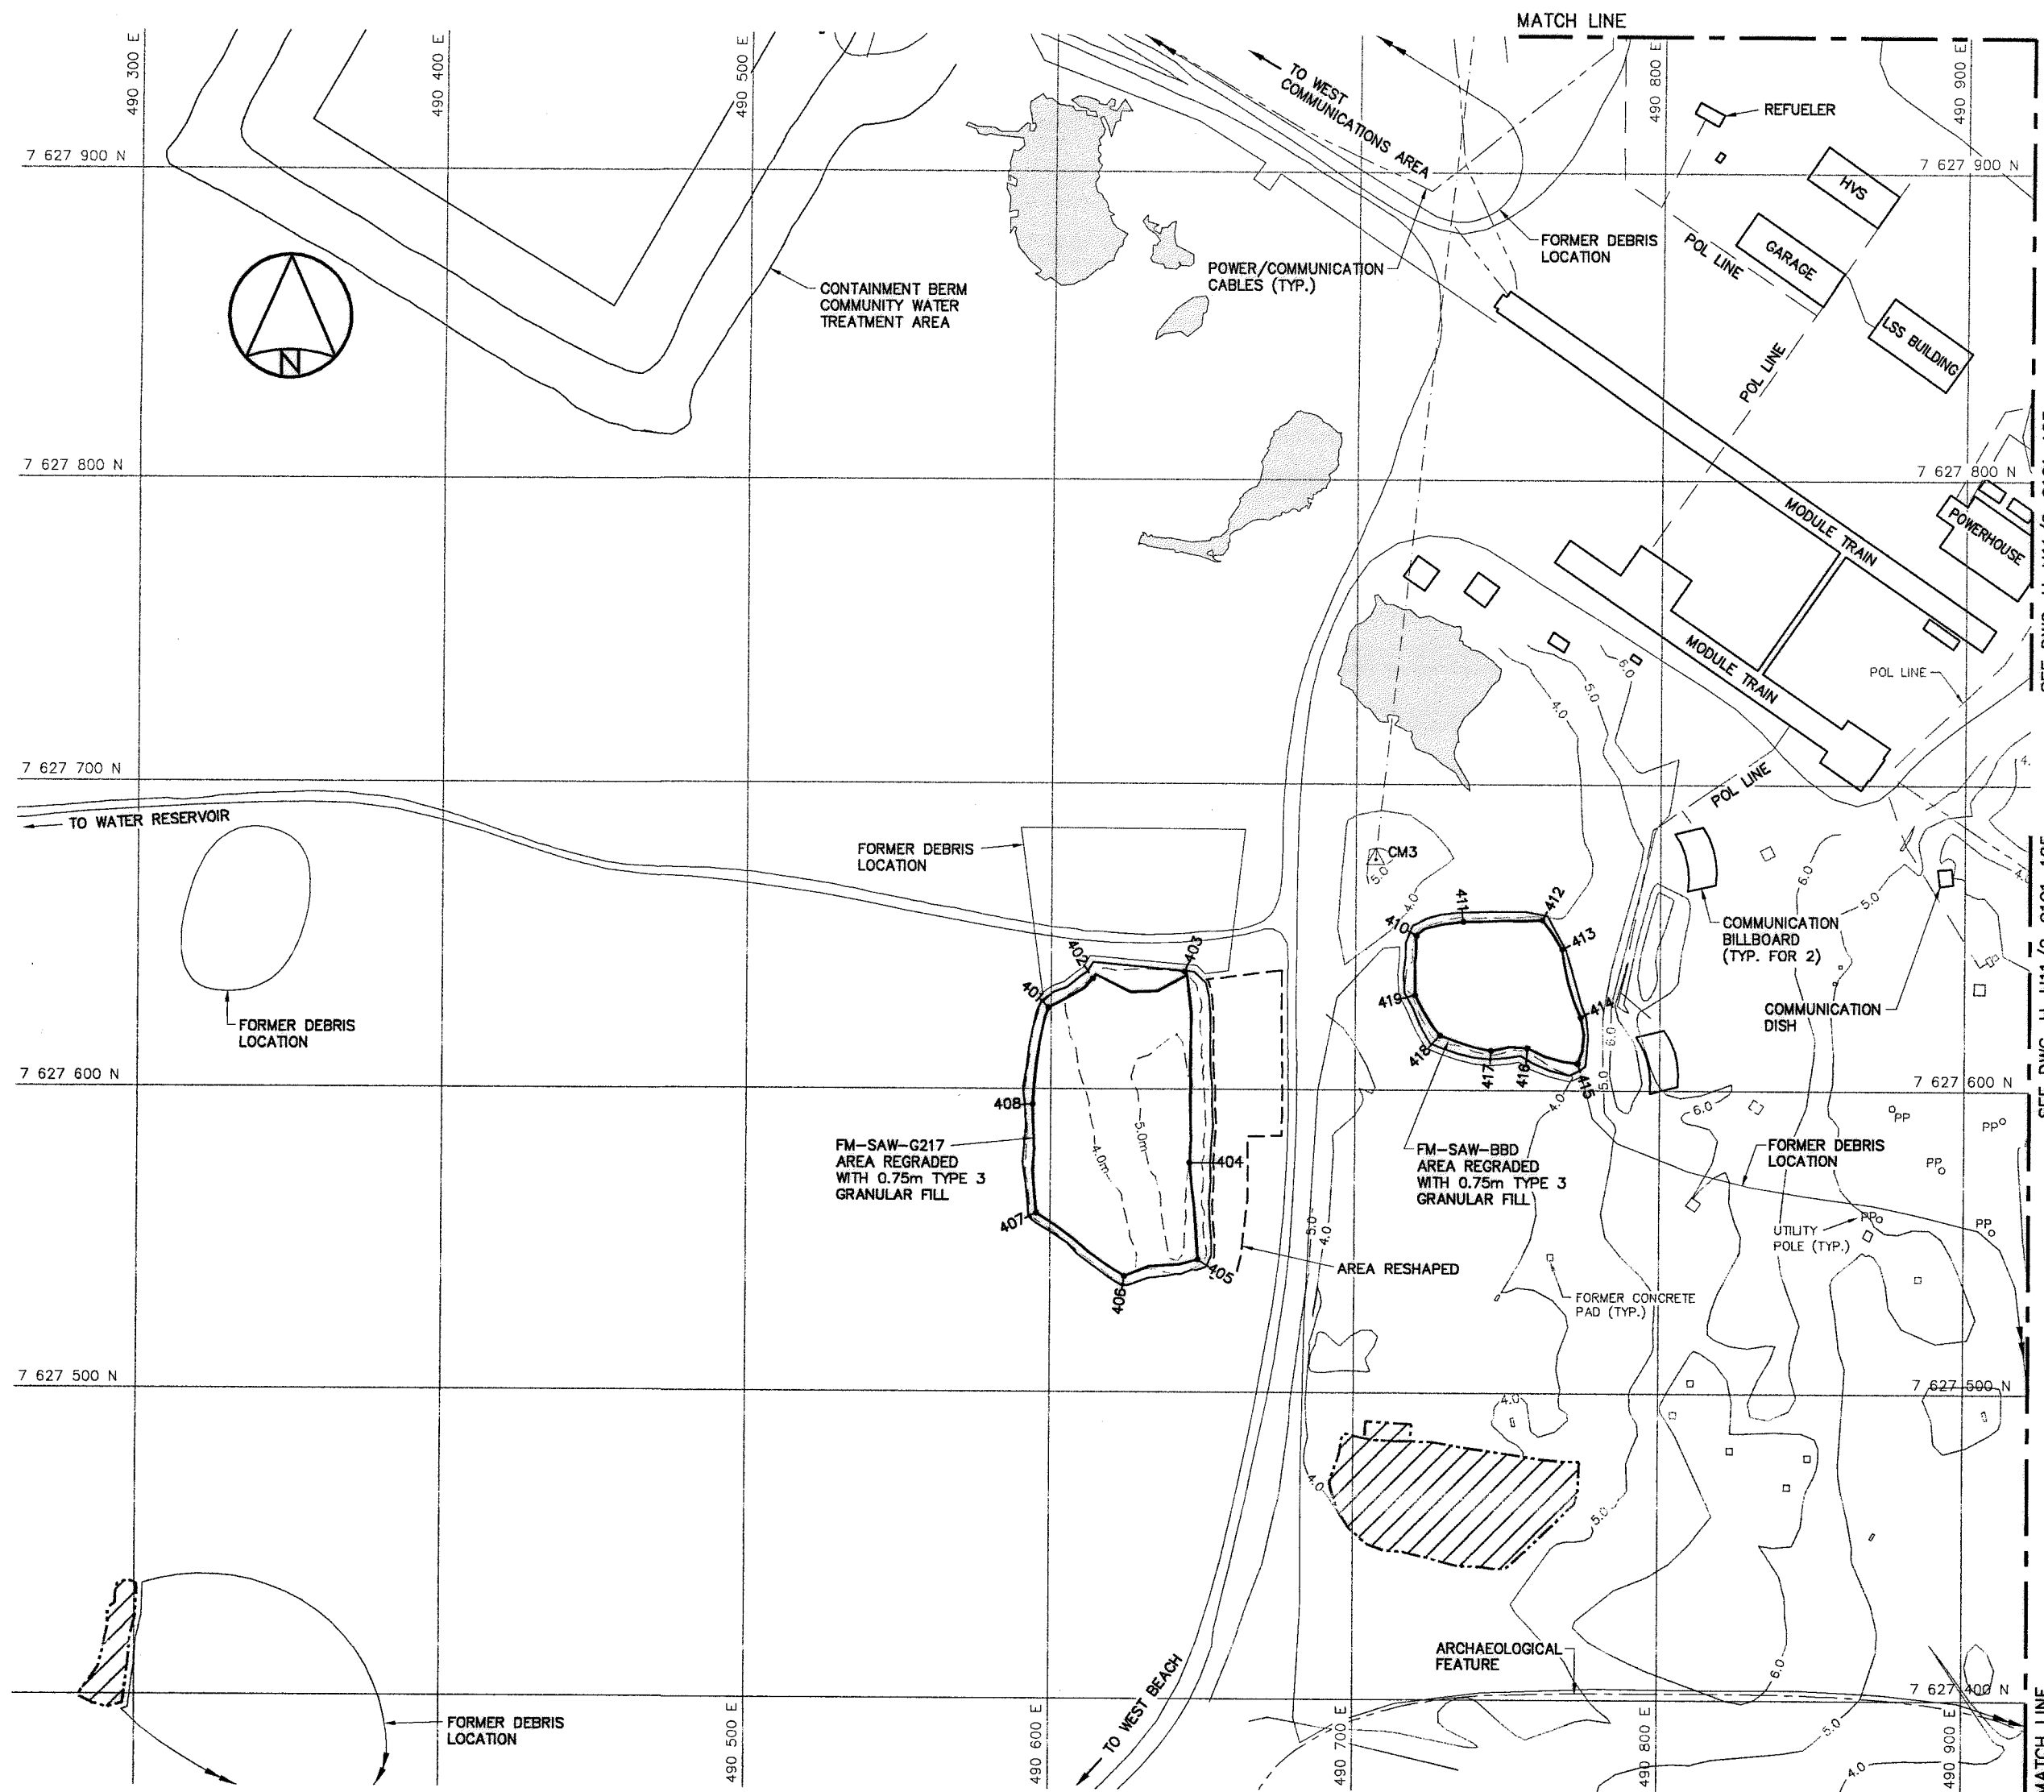

NOTE:
FOR DETAILS REGARDING CONFIRMATORY TESTING INFORMATION, REFER TO FINAL REPORT PREPARED BY THE ENVIRONMENTAL SCIENCES GROUP, ROYAL MILITARY COLLEGE.

NOTE:
CONTOURS SHOWN AS DASHED LINES WERE GENERATED FROM SURVEY INFORMATION AND REPRESENT FINISHED GROUND SURFACE FOLLOWING REGRAIDING OR RESHAPING.

SURVEY CONTROL MONUMENTS				
NO.	UTM COORDINATES		ELEV.	DESCRIPTION
	NORTHING	EASTING		
CM3	7 627 675.453	490 706.281	5.291	FOX-M BASELINE STA. 47+00

STATION AREA SOUTH REGRADED AREAS (AS-BUILT)			
NO.	UTM COORDINATES		ELEV.
	NORTHING	EASTING	
401	7 627 626.7	490 599.2	3.6
402	7 627 636.2	490 613.6	4.0
403	7 627 638.6	490 643.8	3.9
404	7 627 575.7	490 645.7	5.0
405	7 627 543.9	490 648.5	4.7
406	7 627 538.4	490 624.4	3.8
407	7 627 559.1	490 595.4	3.6
408	7 627 594.9	490 594.0	3.7
410	7 627 650.6	490 719.8	4.1
411	7 627 655.2	490 735.2	4.3
412	7 627 655.9	490 761.2	4.3
413	7 627 646.3	490 767.7	4.5
414	7 627 624.1	490 773.9	4.7
415	7 627 609.0	490 773.0	4.8
416	7 627 614.0	490 756.5	4.2
417	7 627 613.1	490 744.5	4.4
418	7 627 618.0	490 727.7	4.4
419	7 627 631.2	490 719.5	4.2

 National
Defence

Défense
nationale

Headquarters
Quartier général


General Notes:

1. ALL COORDINATES ARE REFERENCED TO NAD83 (CSRS), UTM ZONE 17. ALL ELEVATIONS REFER TO GEODETIC DATUM.
2. ALL DIMENSIONS ARE IN METRES UNLESS NOTED OTHERWISE.
3. ALL LONG RANGE RADAR (LRR) FACILITIES WERE OPERATIONAL.

Legend:

-  CM3 SURVEY CONTROL MONUMENT
-  401 COORDINATE POINT
-  COMPLETED LANDFILL OR BURIED DEBRIS EXCAVATION
-  FORMER BUILDING, STRUCTURE OR TANK LOCATION
-  BODY OF WATER

0	11-03-03	AS-BUILT DRAWING	RRM
No.	DATE	REVISION	APPR.

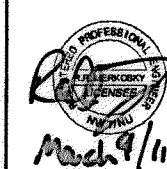

PERMIT TO PRACTICE
AECOM Canada Ltd.
Signature: 
Date: 
PERMIT NUMBER: P639
NWT/NL Association of Professional
Engineers and Geoscientists

AECOM

HATCH

SCALE - ECHELLE 20 10 0 20 40 60m

PROJECT - PROJET
FOX-M HALL BEACH

DEW LINE CLEAN UP

© COPYRIGHT
HER MAJESTY THE QUEEN IN RIGHT OF
CANADA 2011, AS REPRESENTED BY THE
MINISTER OF NATIONAL DEFENCE.

TRADE - METIER SITING DATE
2011-03-03


SUBJECT - SUJET

STATION AREA SOUTH
SITE PLAN

PRODUCTION	CONCURRENCE - ASSENTIMENT
DESIGNED ETUDIE RRM	DES OFF AGENT CONCEPT
DRAWN DESSINE IC	SECT HD CHEF SECT
CHECKED VERIFIE BWH	DES MGR GEST CONCEPT
COORDINATION DTM	REVIEWED - REVU

DWG. NO. - DESSIN NO.
H-H11/2-9101-104

Canada

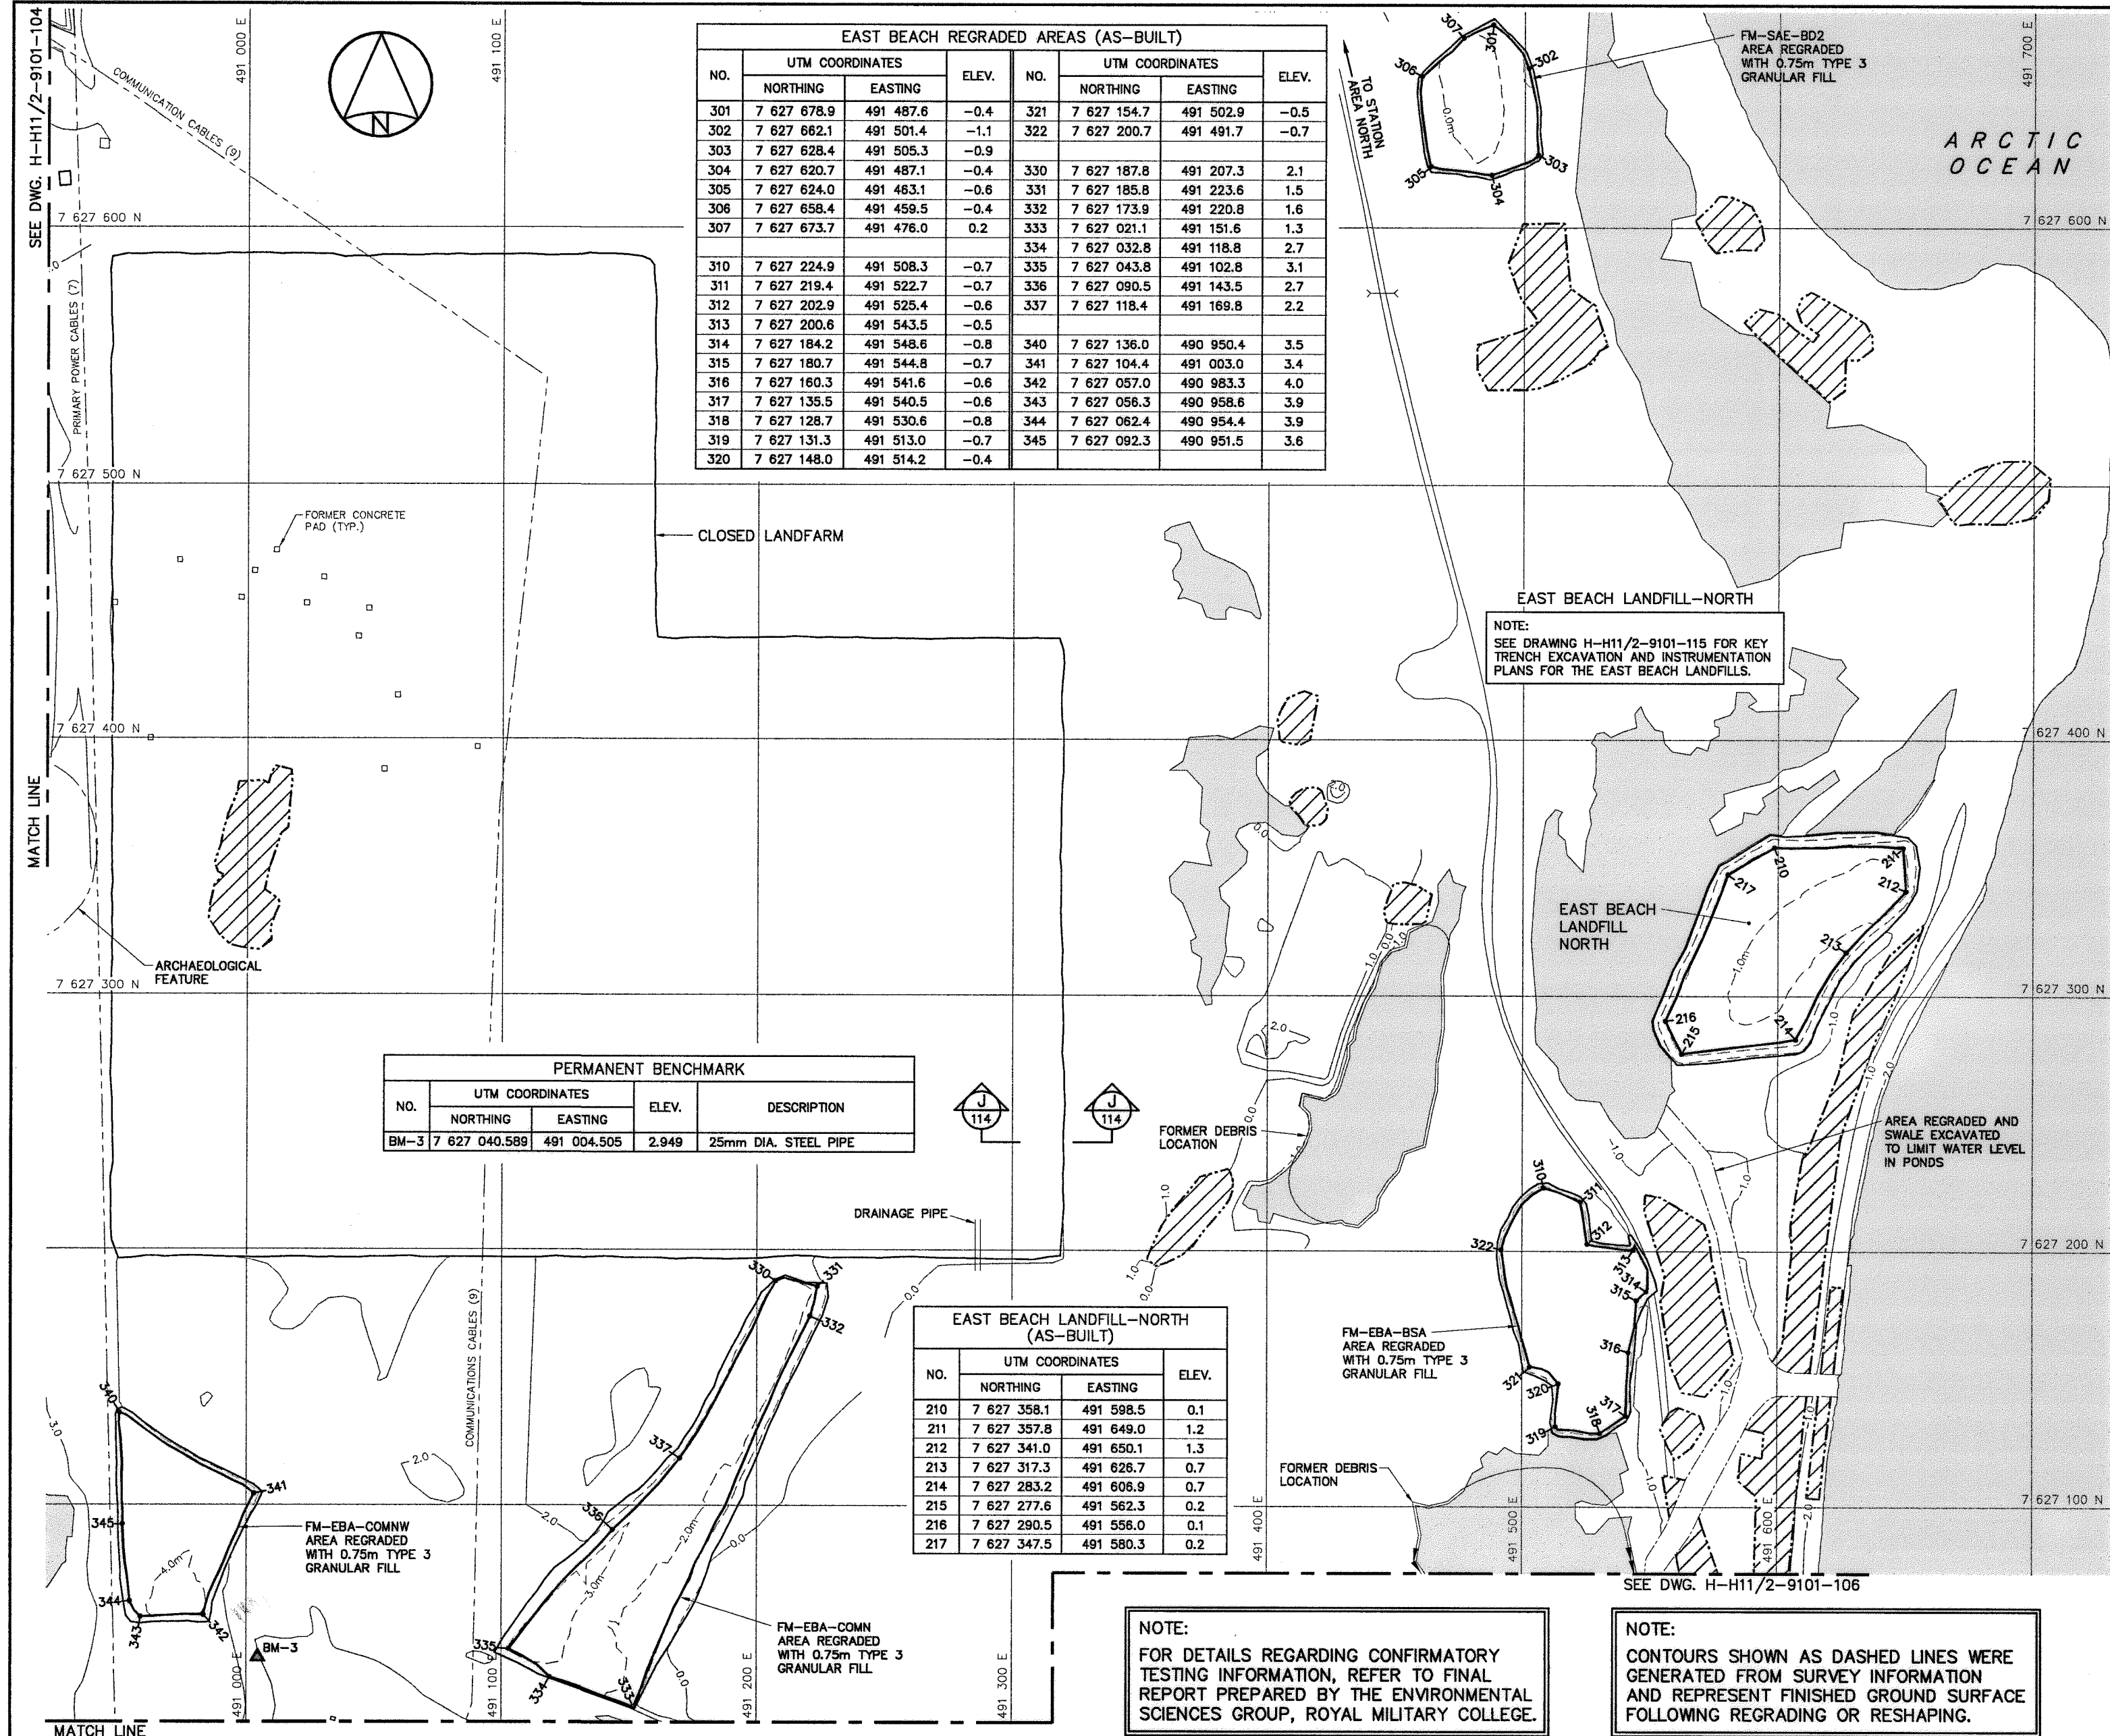

National Defence

Défense nationale

Headquarters

Quartier général

General Notes:

1. ALL COORDINATES ARE REFERENCED TO NAD83 (CSRS), UTM ZONE 17. ALL ELEVATIONS REFER TO GEODETIC DATUM.

2. ALL DIMENSIONS ARE IN METRES UNLESS NOTED OTHERWISE.

3. ALL LONG RANGE RADAR (LRR) FACILITIES WERE OPERATIONAL.

4. FOR PERMANENT SURVEY CONTROL (BENCHMARK) INSTALLATION DETAIL, SEE DWG. H-H11/2-9101-117.

Legend:

BM-3

PERMANENT BENCHMARK LOCATION (1)

20

COORDINATE POINT

SWALE

COMPLETED LANDFILL OR BURIED DEBRIS EXCAVATION

BODY OF WATER

0 11-03-03

AS-BUILT DRAWING

RRM

No.

DATE

REVISION

REVISION

APPR.

PERMIT TO PRACTICE

AECOM Canada Ltd.

Signature

Date

PERMIT NUMBER: P639

NWT/NU Association of Professional Engineers and Geoscientists

AECOM

HATCH

SCALE - ECHELLE

20 10 0 20 40 60m

PROJECT - PROJET

FOX-M HALL BEACH

DEW LINE CLEAN UP

© COPYRIGHT HER MAJESTY THE QUEEN IN RIGHT OF CANADA 2011, AS REPRESENTED BY THE MINISTER OF NATIONAL DEFENCE.

TRADE - METIER

SITING

DATE

2011-03-03

SUBJECT - SUJET

EAST BEACH LANDFILL NORTH AREA SITE PLAN

PRODUCTION

CONCURRENCE - ASSENTMENT

DESIGNED

ETUDIE

RRM

DES OFF

AGENT CONCEPT

DRAWN

DESSINE

K

SECT HD

CHEF SECT

CHECKED

VERIFIE

BNH

DES MGR

GEST CONCEPT

COORDINATION

DTM

REVIEWED - REVU


DWG. NO. - DESSIN NO.

H-H11/2-9101-105

Canada

NOTE:
FOR DETAILS REGARDING CONFIRMATORY TESTING INFORMATION, REFER TO FINAL REPORT PREPARED BY THE ENVIRONMENTAL SCIENCES GROUP, ROYAL MILITARY COLLEGE.

NOTE:
CONTOURS SHOWN AS DASHED LINES WERE GENERATED FROM SURVEY INFORMATION AND REPRESENT FINISHED GROUND SURFACE FOLLOWING REGRADING OR RESHAPING.

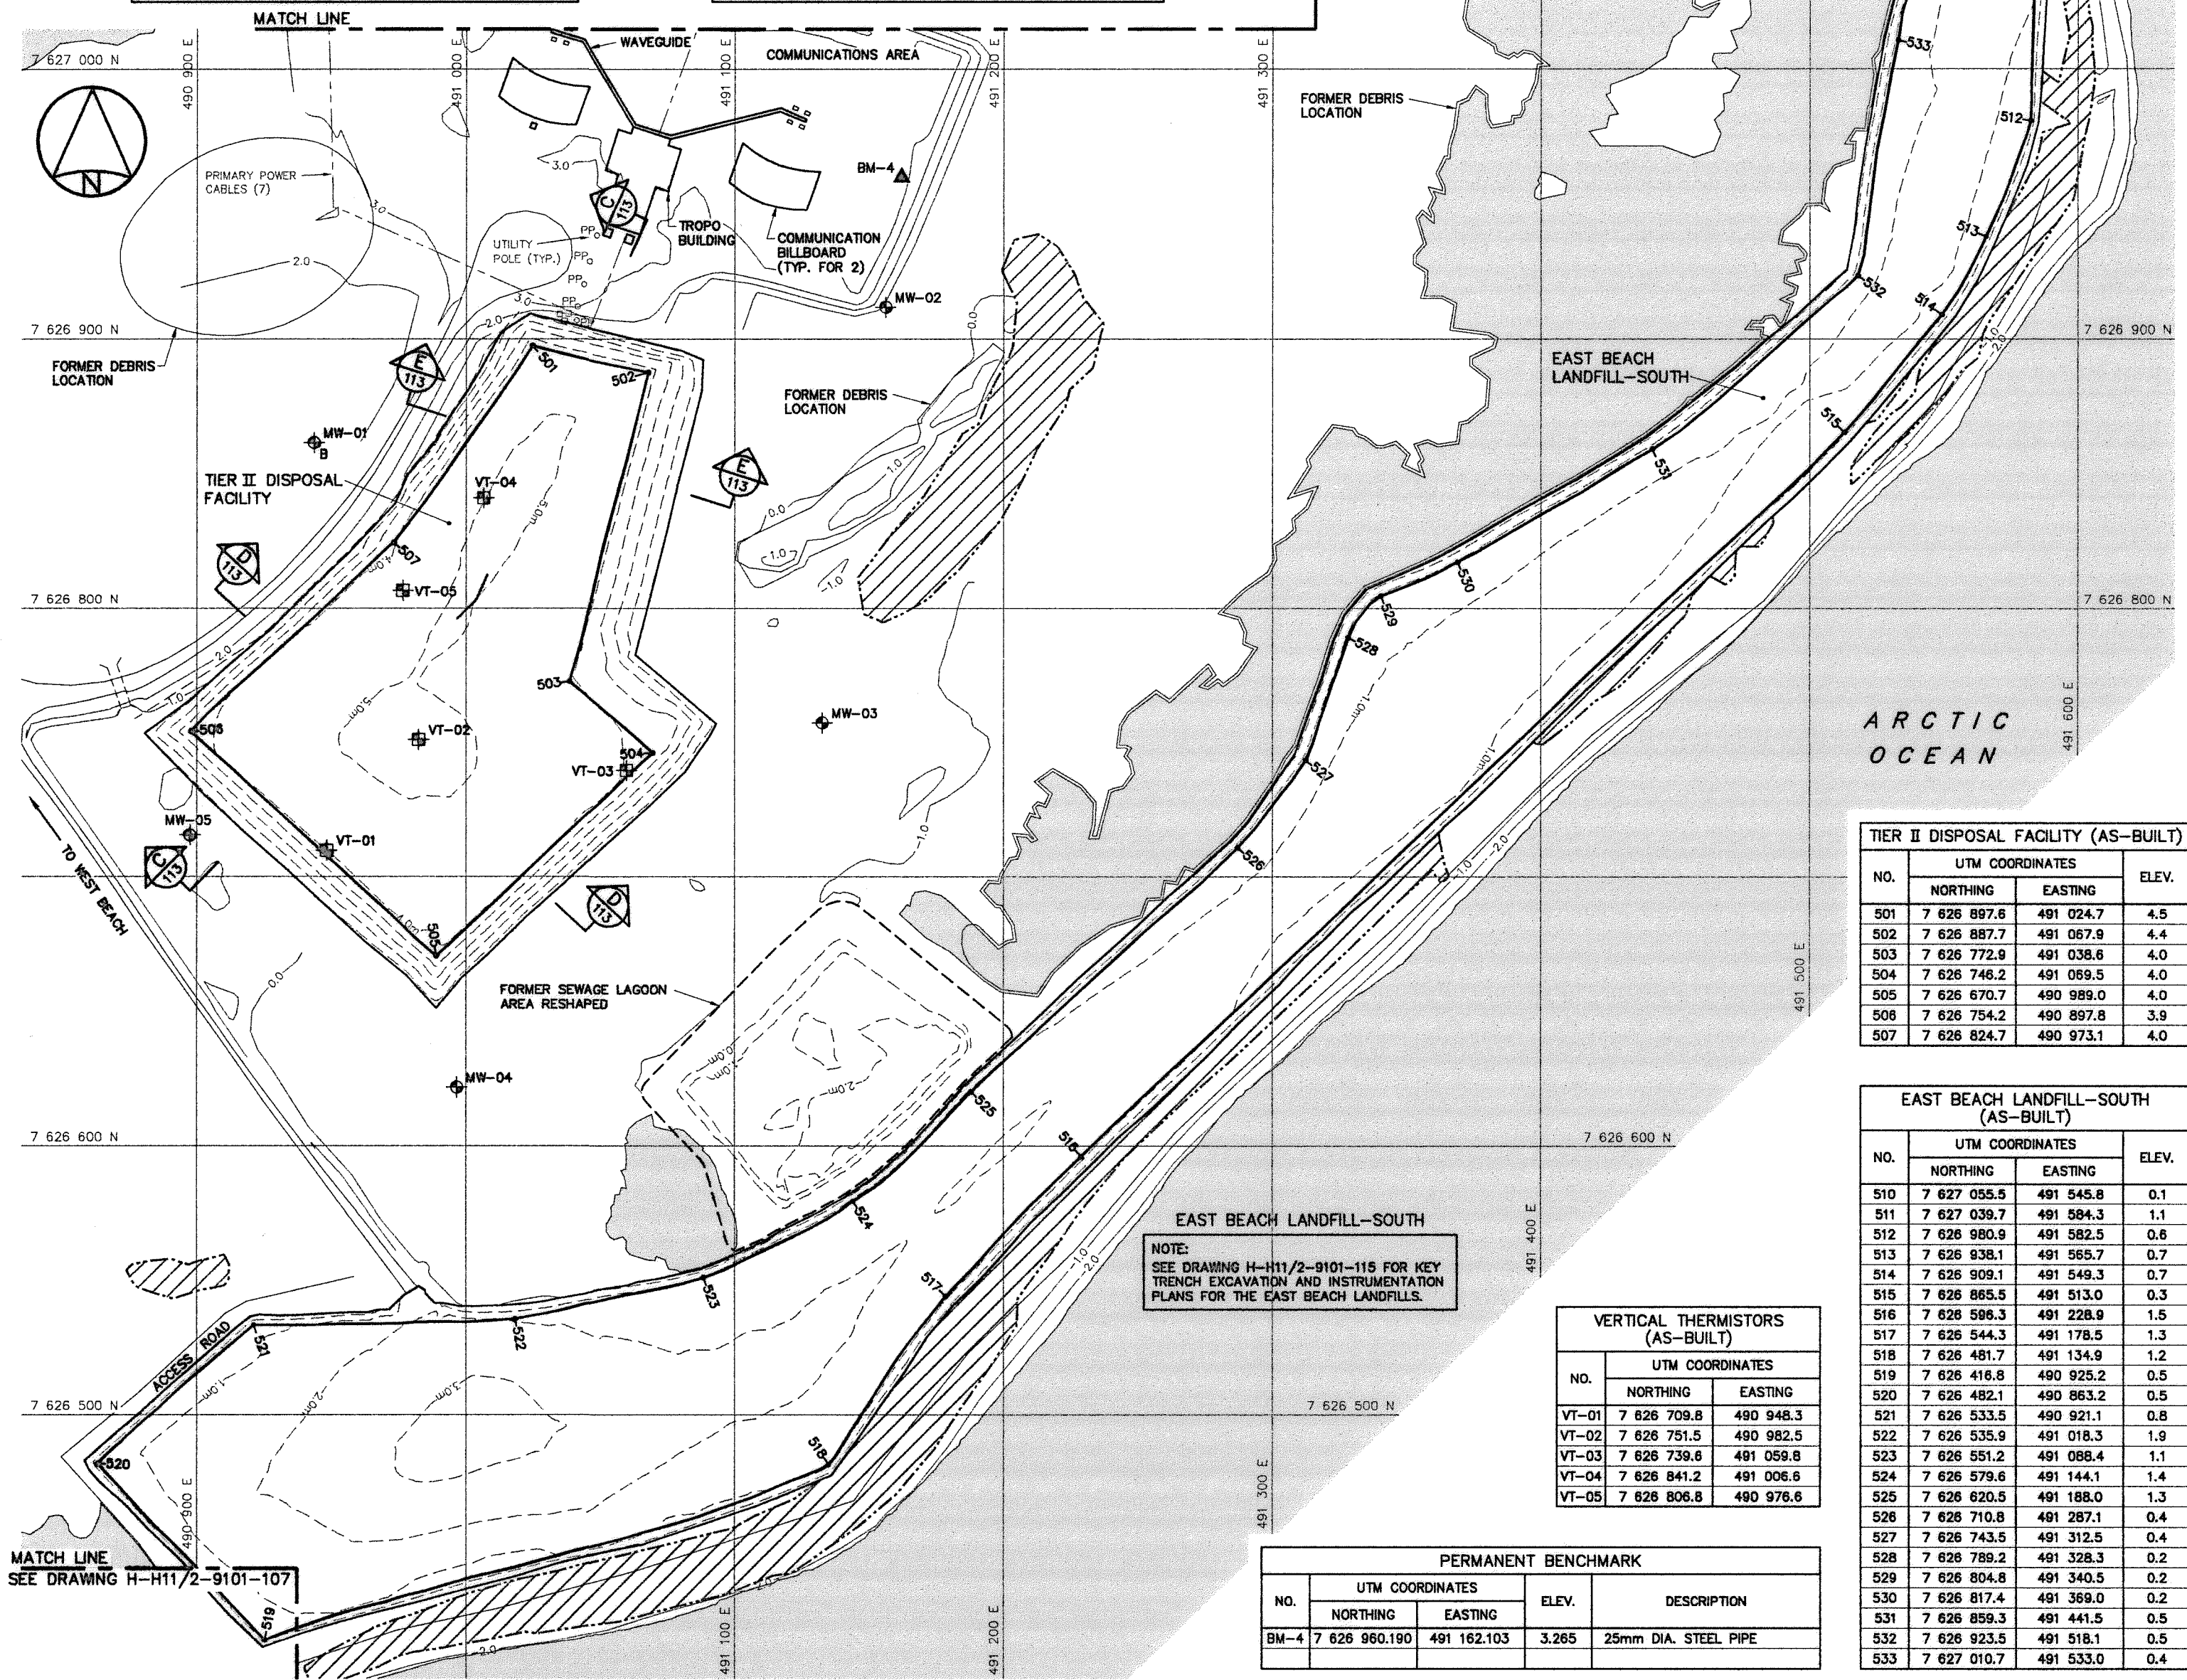

National Defence
Défense nationale

Headquarters
Quartier général

- General Notes:
1. ALL COORDINATES ARE REFERENCED TO NAD83 (CSRS), UTM ZONE 17. ALL ELEVATIONS REFER TO GEODETIC DATUM.
 2. ALL DIMENSIONS ARE IN METRES UNLESS NOTED OTHERWISE.
 3. ALL LONG RANGE RADAR (LRR) FACILITIES WERE OPERATIONAL.
 4. FOR PERMANENT SURVEY CONTROL (BENCHMARK) INSTALLATION DETAIL, SEE DWG. H-H11/2-9101-117.
 5. FOR MONITORING WELL INSTALLATION DETAIL AND COORDINATE POINTS, SEE DWG. H-H11/2-9101-117.
 6. FOR GROUND TEMPERATURE CABLE INSTALLATION DETAILS, SEE DWG. H-H11/2-9101-118.

- Legend:
- BM-4 PERMANENT BENCHMARK LOCATION (1)
 - COORDINATE POINT
 - MW-02 MONITORING WELL LOCATION (4)
 - MW-01 BACKGROUND MONITORING WELL LOCATION (1)
 - VT-01 GROUND TEMPERATURE CABLE LOCATION (5)
 - COMPLETED LANDFILL OR BURIED DEBRIS EXCAVATION
 - BODY OF WATER

TIER II DISPOSAL FACILITY (AS-BUILT)			
NO.	UTM COORDINATES		ELEV.
	NORTHING	EASTING	
501	7 626 897.6	491 024.7	4.5
502	7 626 887.7	491 067.9	4.4
503	7 626 772.9	491 038.6	4.0
504	7 626 746.2	491 069.5	4.0
505	7 626 670.7	490 989.0	4.0
506	7 626 754.2	490 897.8	3.9
507	7 626 824.7	490 973.1	4.0

EAST BEACH LANDFILL-SOUTH (AS-BUILT)			
NO.	UTM COORDINATES		ELEV.
	NORTHING	EASTING	
510	7 627 055.5	491 545.8	0.1
511	7 627 039.7	491 584.3	1.1
512	7 626 980.9	491 582.5	0.6
513	7 626 938.1	491 565.7	0.7
514	7 626 909.1	491 549.3	0.7
515	7 626 865.5	491 513.0	0.3
516	7 626 586.3	491 228.9	1.5
517	7 626 544.3	491 178.5	1.3
518	7 626 481.7	491 134.9	1.2
519	7 626 416.8	490 925.2	0.5
520	7 626 482.1	490 863.2	0.5
521	7 626 533.5	490 921.1	0.8
522	7 626 535.9	491 018.3	1.9
523	7 626 551.2	491 088.4	1.1
524	7 626 579.6	491 144.1	1.4
525	7 626 620.5	491 188.0	1.3
526	7 626 710.8	491 287.1	0.4
527	7 626 743.5	491 312.5	0.4
528	7 626 789.2	491 328.3	0.2
529	7 626 804.8	491 340.5	0.2
530	7 626 817.4	491 369.0	0.2
531	7 626 859.3	491 441.5	0.5
532	7 626 923.5	491 518.1	0.5
533	7 627 010.7	491 533.0	0.4

VERTICAL THERMISTORS (AS-BUILT)		
NO.	UTM COORDINATES	
	NORTHING	EASTING
VT-01	7 626 709.8	490 948.3
VT-02	7 626 751.5	490 982.5
VT-03	7 626 739.6	491 059.8
VT-04	7 626 841.2	491 006.6
VT-05	7 626 806.8	490 976.6

PERMANENT BENCHMARK			
NO.	UTM COORDINATES		DESCRIPTION
	NORTHING	EASTING	
BM-4	7 626 960.190	491 162.103	3.265 25mm DIA. STEEL PIPE

0	11-03-03	AS-BUILT DRAWING	RRM
No.	DATE	REVISION	APPR.

PROFESSIONAL ENGINEER
NWT/NU Association of Professional Engineers and Geoscientists
PERMIT TO PRACTICE
AECOM Canada Ltd.
Signature: [Signature]
Date: [Date]
PERMIT NUMBER: P839
NWT/NU Association of Professional Engineers and Geoscientists

SCALE - ECHELLE 20 10 0 20 40 60m

PROJECT - PROJET
FOX-M HALL BEACH

DEW LINE CLEAN UP
© COPYRIGHT
HER MAJESTY THE QUEEN IN RIGHT OF CANADA 2011, AS REPRESENTED BY THE MINISTER OF NATIONAL DEFENCE.



TRADE - METIER SITING DATE 2011-03-03

SUBJECT - SUJET
EAST BEACH LANDFILL SOUTH AREA SITE PLAN


PRODUCTION		CONCURRENCE - ASSENTMENT	
DESIGNED ETUDIE	ARM	DES OFF AGENT CONCEPT	
DRAWN DESSINE	K	SECT HD CHIEF SECT	
CHECKED VERIFIE	BNH	DES MGR GEST CONCEPT	
COORDINATION	DTM	REVIEWED - REVU	

DWG. NO. - DESSIN NO.
H-H11/2-9101-106



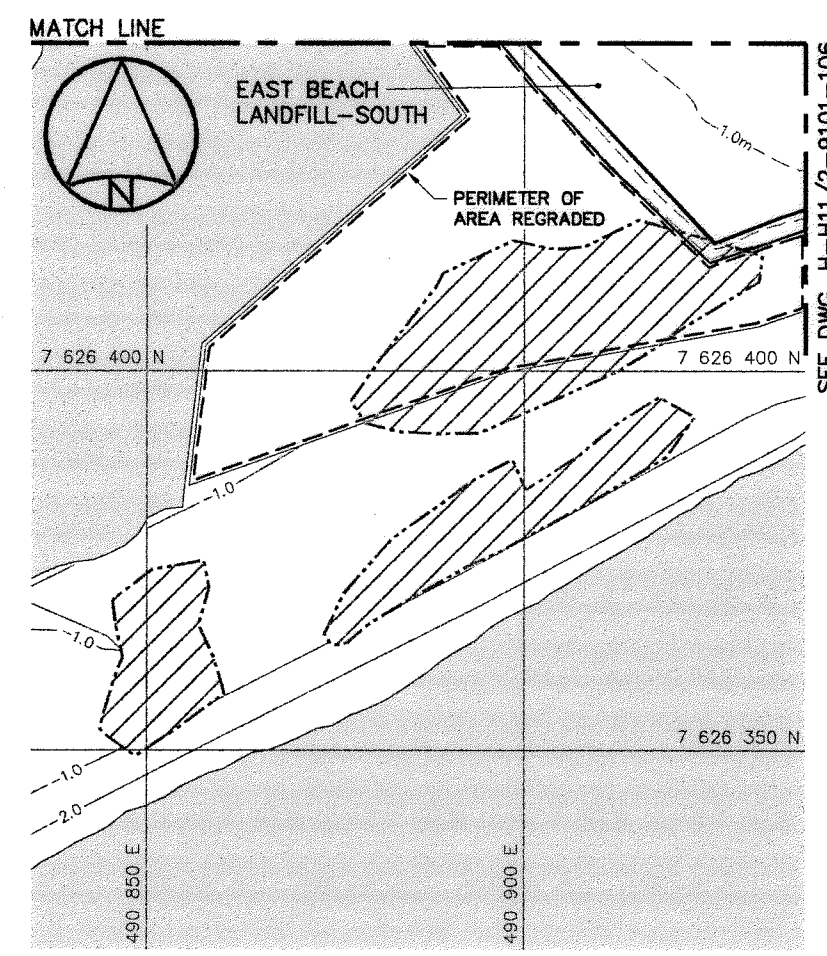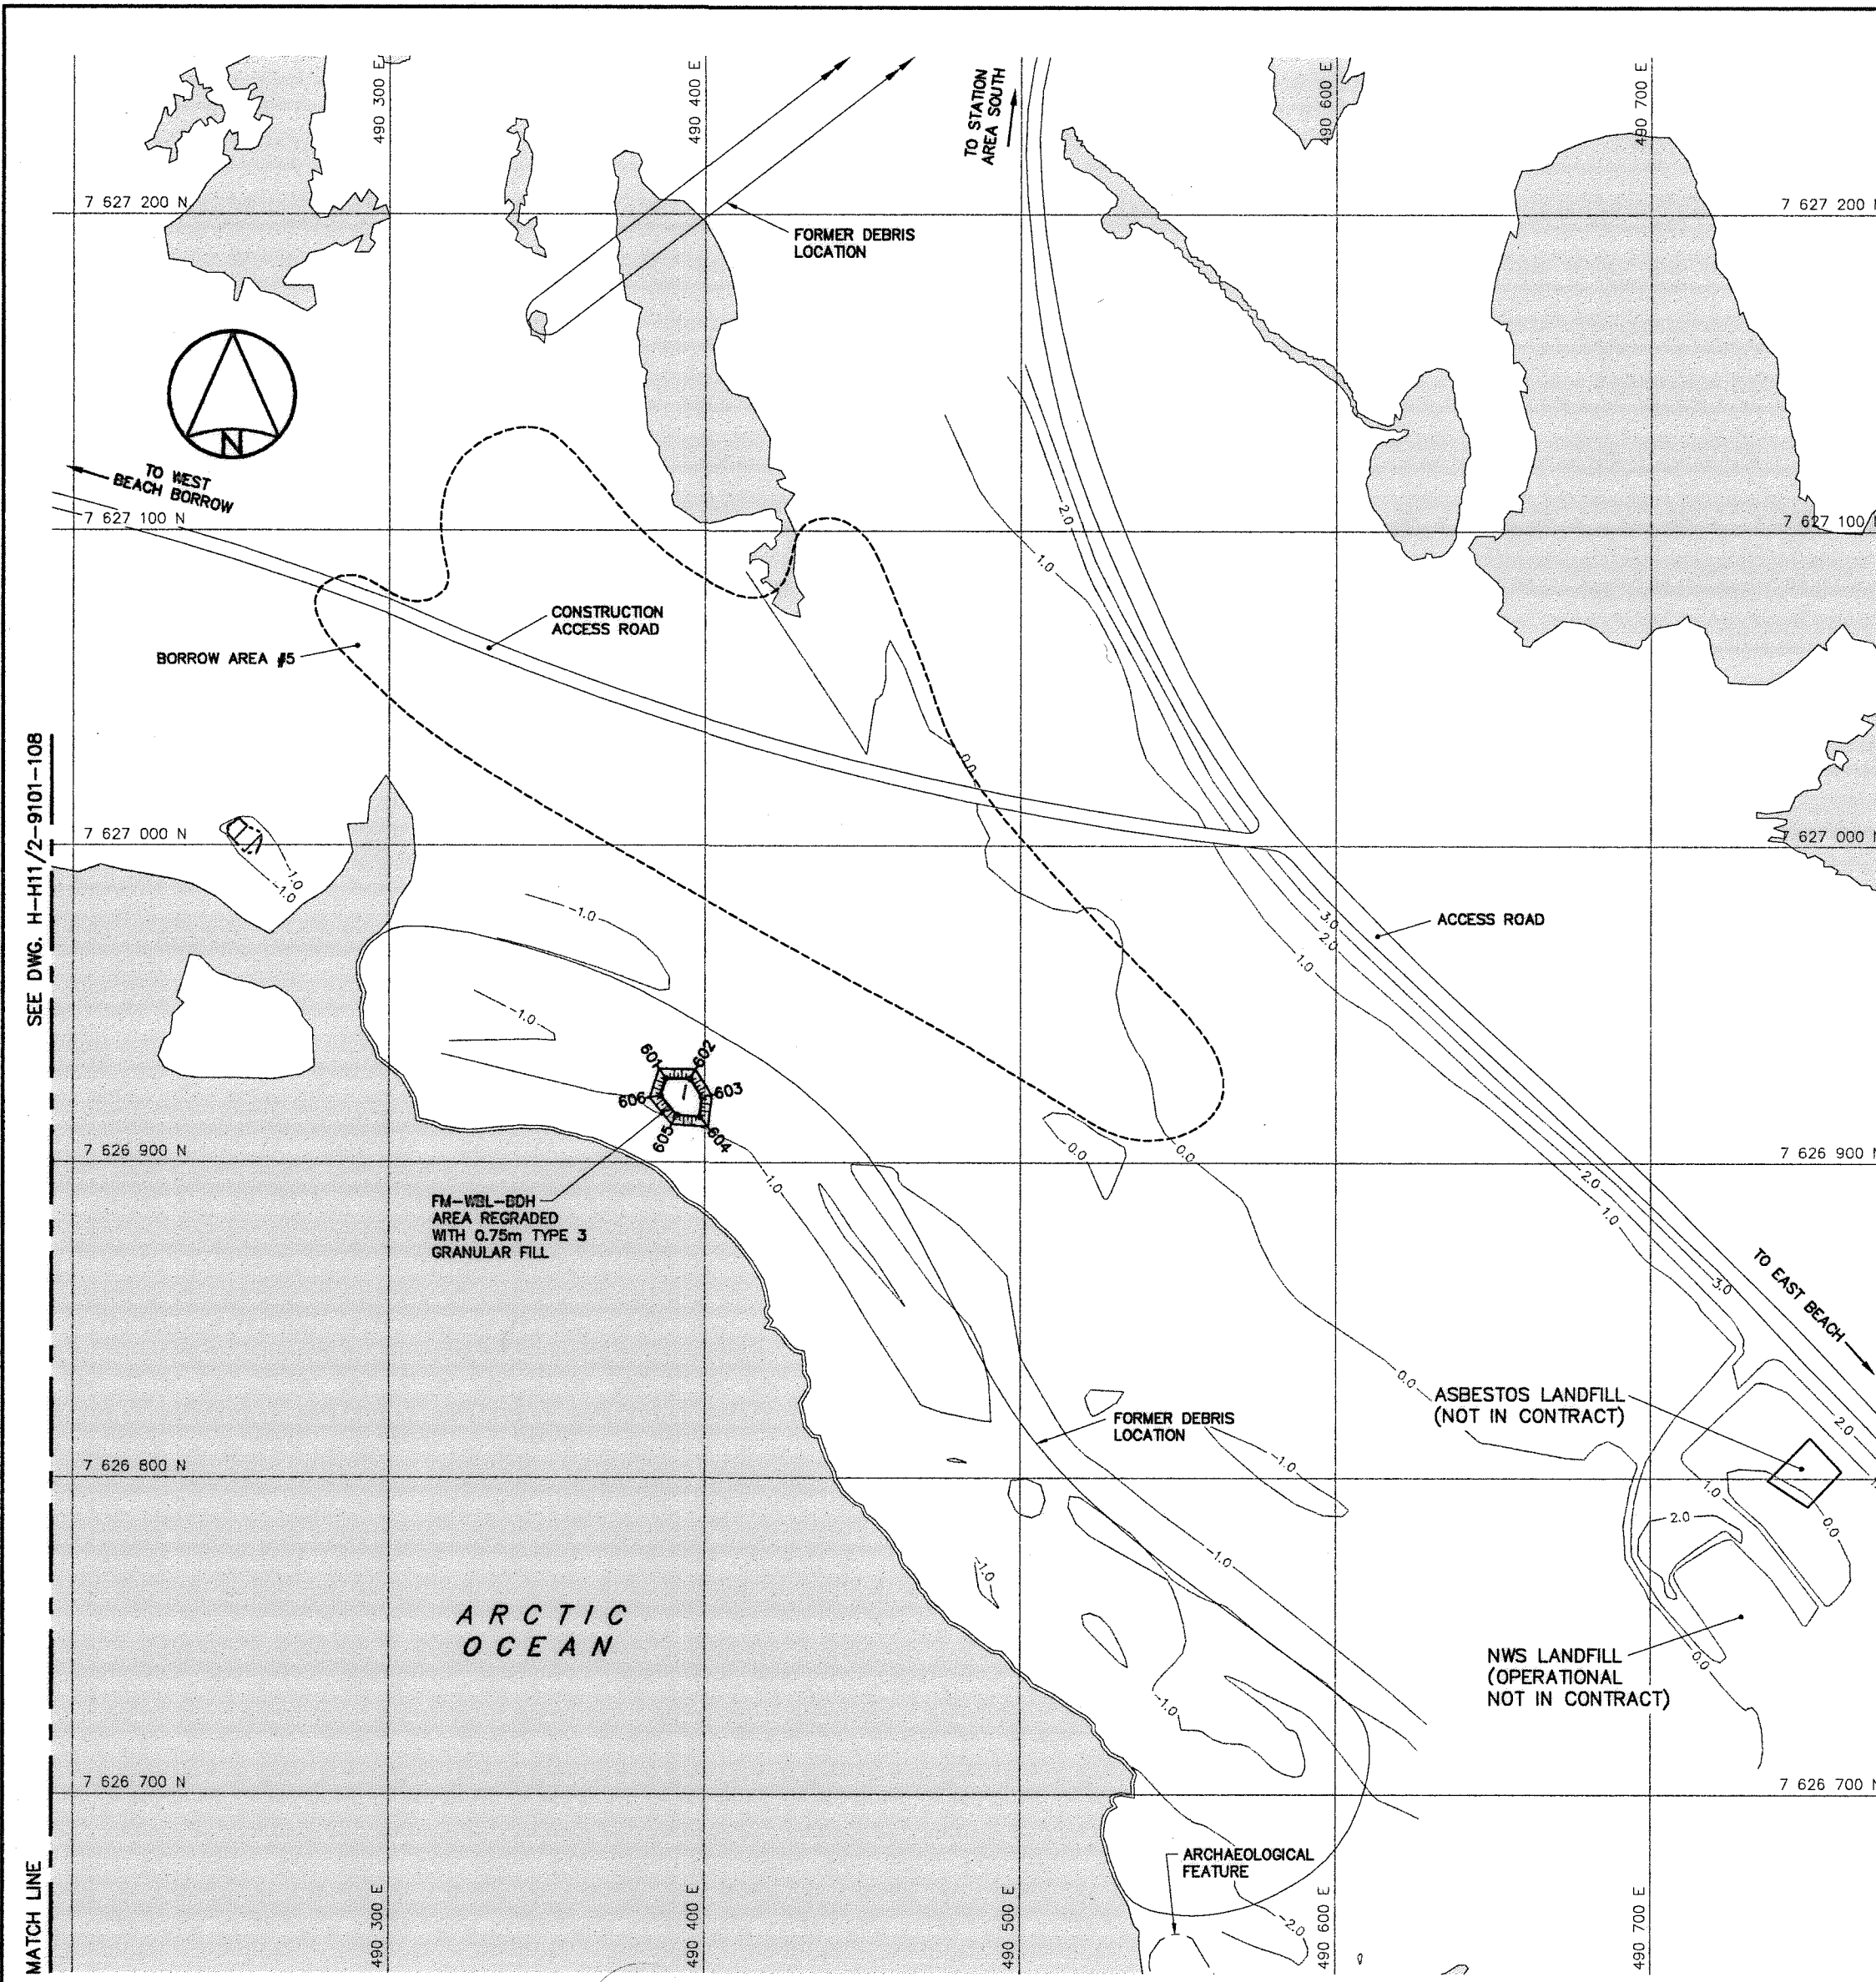

EAST BEACH AREA

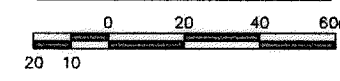


NOTE:
FOR DETAILS REGARDING CONFIRMATORY TESTING INFORMATION, REFER TO FINAL REPORT PREPARED BY THE ENVIRONMENTAL SCIENCES GROUP, ROYAL MILITARY COLLEGE.

NOTE:
CONTOURS SHOWN AS DASHED LINES WERE GENERATED FROM SURVEY INFORMATION AND REPRESENT FINISHED GROUND SURFACE FOLLOWING REGRADING OR RESHAPING.

FM-WBL-BDH REGRADED AREA (DESIGN)*		
NO.	UTM COORDINATES	
	NORTHING	EASTING
601	7 626 926.5	490 387.7
602	7 626 926.4	490 395.3
603	7 626 920.5	490 399.0
604	7 626 914.4	490 398.4
605	7 626 914.9	490 391.1
606	7 626 921.0	490 385.9

*NOTE: NO AS-BUILT SURVEY INFORMATION.

WEST BEACH LANDFILL AREA

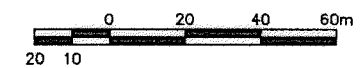



National
Défense



Défense
nationale

Headquarters
Quartier général

General Notes:

- ALL COORDINATES ARE REFERENCED TO NAD83 (CSRS), UTM ZONE 17. ALL ELEVATIONS REFER TO GEODETIC DATUM.
- ALL DIMENSIONS ARE IN METRES UNLESS NOTED OTHERWISE.

Legend:

-  COORDINATE POINT
-  COMPLETED LANDFILL OR BURIED DEBRIS EXCAVATION
-  BODY OF WATER



March 9/11

PERMIT TO PRACTICE
AECOM Canada Ltd.
Signature: 
Date:
PERMIT NUMBER: P639
NWT/NU Association of Professional Engineers and Geoscientists

AECOM

HATCH

SCALE - ECHELLE
AS SHOWN

PROJECT - PROJET
FOX-M HALL BEACH

DEW LINE CLEAN UP

© COPYRIGHT
HER MAJESTY THE QUEEN IN RIGHT OF
CANADA 2011. AS REPRESENTED BY THE
MINISTER OF NATIONAL DEFENCE.

TRADE - METIER
SITING

DATE
2011-03-03

SUBJECT - SUJET
EAST BEACH AND
WEST BEACH LANDFILL AREAS
SITE PLAN

PRODUCTION		CONCURRENCE - ASSENTMENT	
DESIGNED ETUDIE	RRM	DES OFF AGENT CONCEPT	
DRAWN DESSINE	AC	SECT HD CHEF SECT	
CHECKED VERIFIE	BWH	DES MGR GEST CONCEPT	
COORDINATION	DTM	REVIEWED - REVU	

DWG. NO. - DESSIN NO.
H-H11/2-9101-107

Canada

PERMANENT BENCHMARK				
NO.	UTM COORDINATES		ELEV.	DESCRIPTION
	NORTHING	EASTING		
BM-2	7 626 652.600	489 967.120	-0.221	25mm DIA. STEEL PIPE

NOTE:
FOR DETAILS REGARDING CONFIRMATORY TESTING INFORMATION, REFER TO FINAL REPORT PREPARED BY THE ENVIRONMENTAL SCIENCES GROUP, ROYAL MILITARY COLLEGE.

- General Notes:
1. ALL COORDINATES ARE REFERENCED TO NAD83 (GSRs), UTM ZONE 17. ALL ELEVATIONS REFER TO GEODETIC DATUM.
 2. ALL DIMENSIONS ARE IN METRES UNLESS NOTED OTHERWISE.
 3. FOR PERMANENT SURVEY CONTROL (BENCHMARK) INSTALLATION DETAIL, SEE DWG. H-H11/2-9101-117.

- Legend:
- ▲ BM-2 PERMANENT BENCHMARK LOCATION (1)
 - ▨ COMPLETED LANDFILL OR BURIED DEBRIS EXCAVATION
 - BODY OF WATER

0	11-03-03	AS-BUILT DRAWING	RRM
No.	DATE	REVISION	APPR.



March 9/04

PERMIT TO PRACTICE
AECOM Canada Ltd.
Signature: [Signature]
Date: [Date]
PERMIT NUMBER: P839
NW/NA Association of Professional Engineers and Geoscientists

AECOM HATCH

SCALE - ECHELLE 20 10 0 20 40 60m

PROJECT - PROJET
FOX-M HALL BEACH



DEW LINE CLEAN UP
© COPYRIGHT
HER MAJESTY THE QUEEN IN RIGHT OF CANADA 2011, AS REPRESENTED BY THE MINISTER OF NATIONAL DEFENCE.

TRADE - METIER SITING DATE 2011-03-03

SUBJECT - SUJET
WEST BEACH BORROW AREA
SITE PLAN


PRODUCTION		CONCURRENCE - ASSENTIMENT	
DESIGNED ETUDIE	RRM	DES OFF AGENT CONCEPT	
DRAWN DESSINE	AC	SECT HD CHEF SECT	
CHECKED VERIFIE	BWH	DES MGR GEST CONCEPT	
COORDINATION	DTM	REVIEWED - REVU	

DWG. NO. - DESSIN NO.
H-H11/2-9101-108

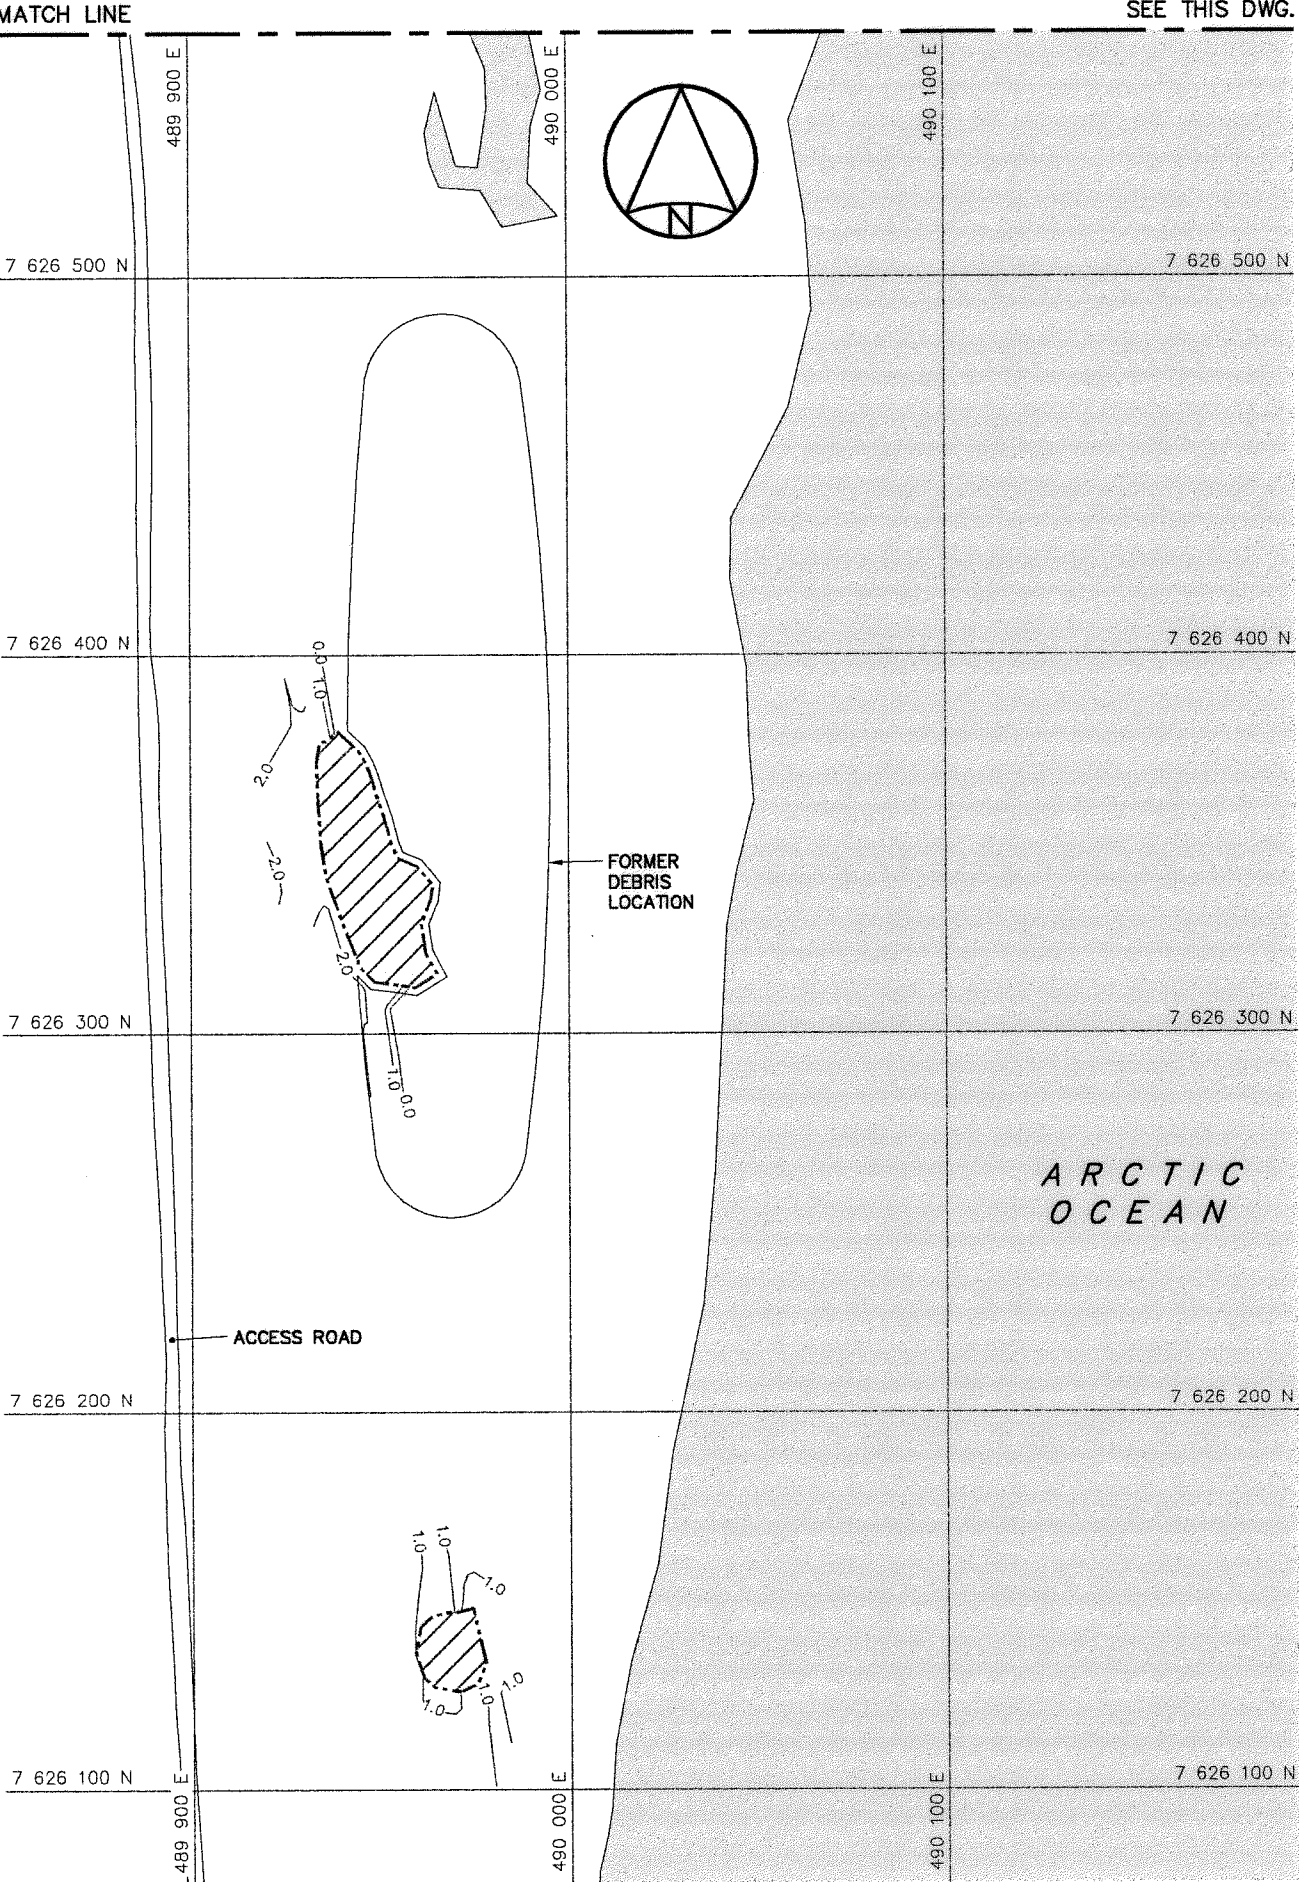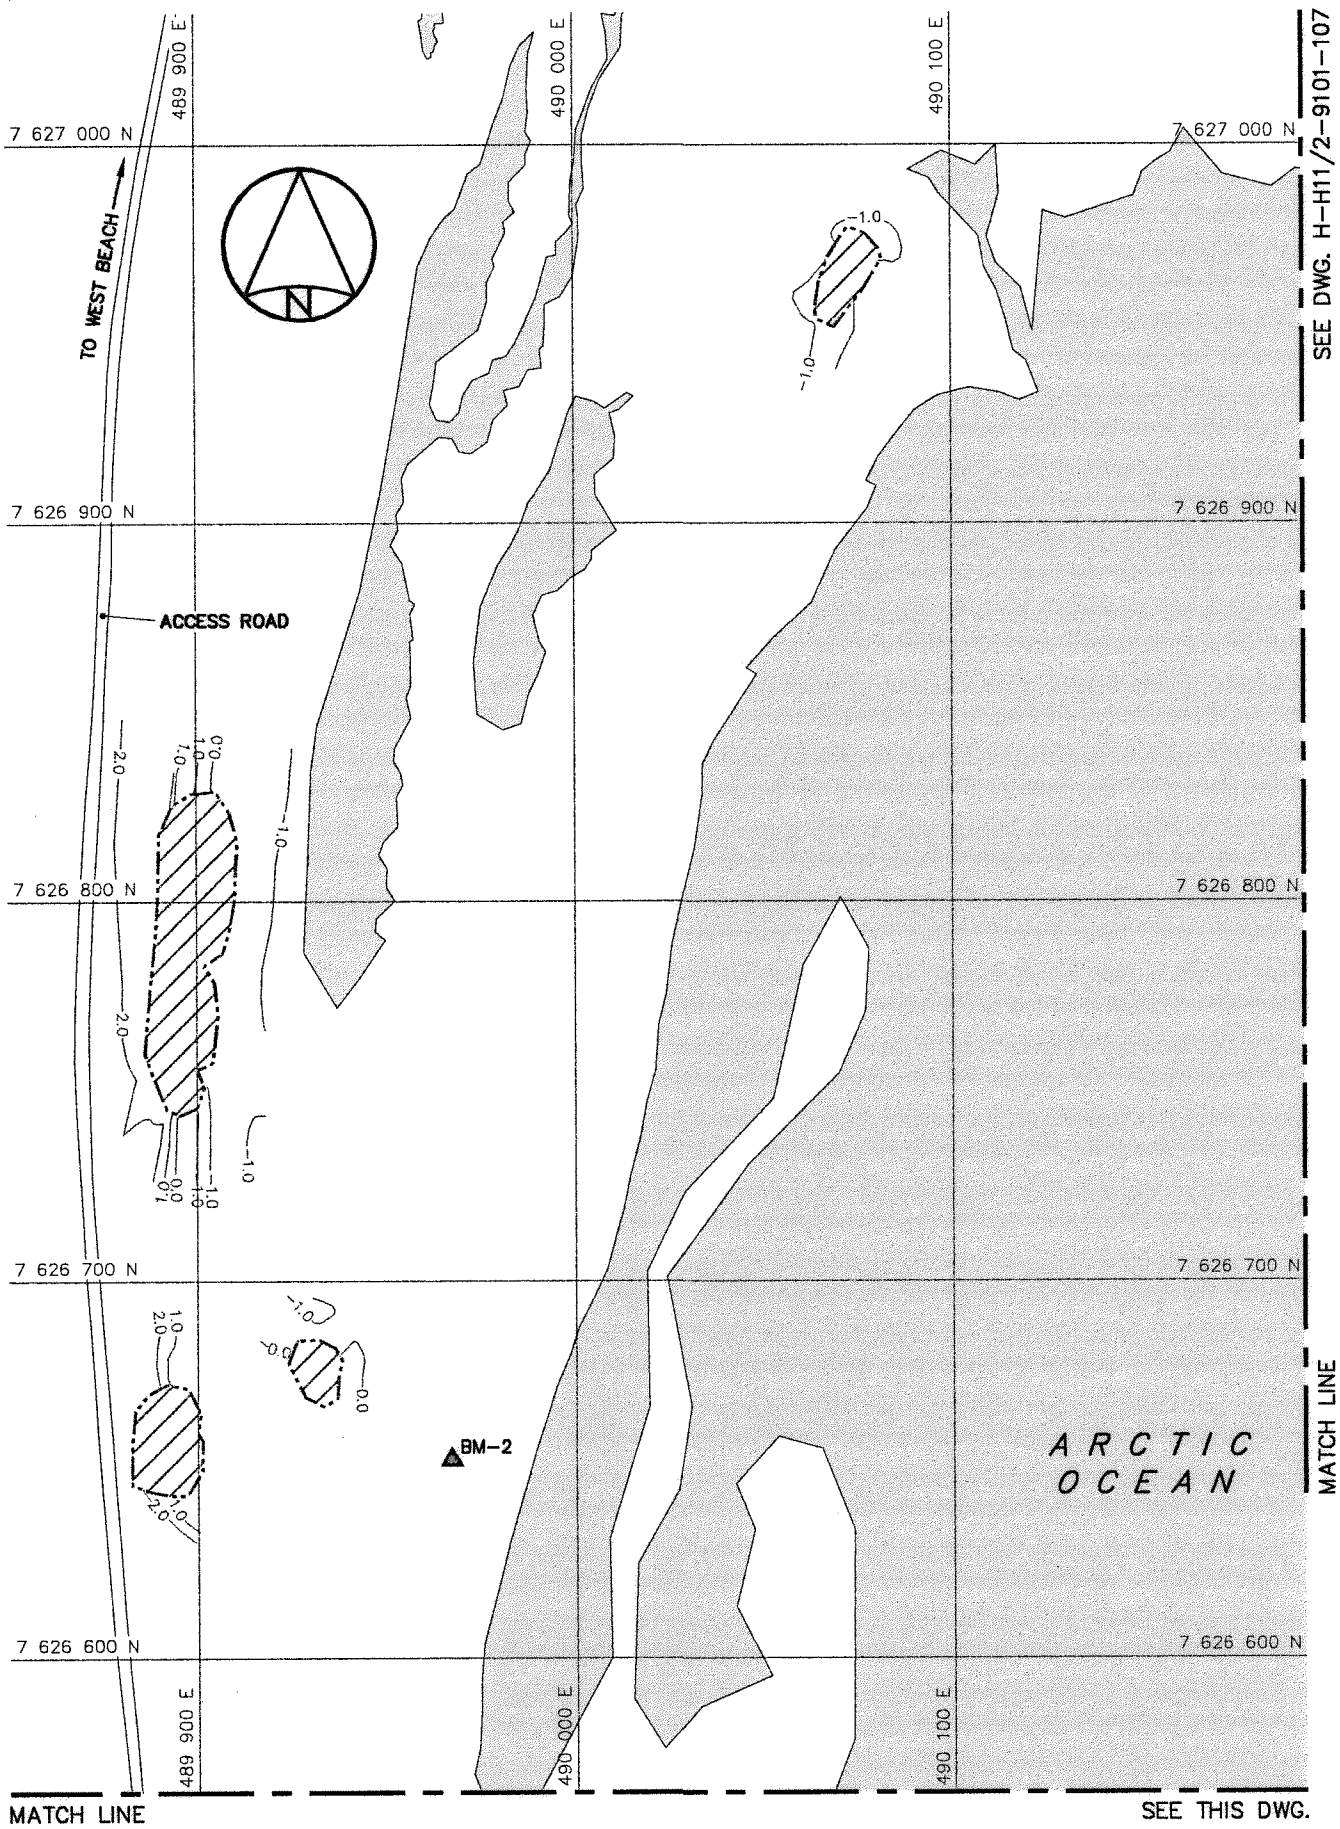

PERMANENT BENCHMARK				
NO.	UTM COORDINATES		ELEV.	DESCRIPTION
	NORTHING	EASTING		
BM-6	7 628 584.719	490 596.130	1.229	25mm DIA. STEEL PIPE

NOTE:
FOR DETAILS REGARDING CONFIRMATORY
TESTING INFORMATION, REFER TO FINAL
REPORT PREPARED BY THE ENVIRONMENTAL
SCIENCES GROUP, ROYAL MILITARY COLLEGE.

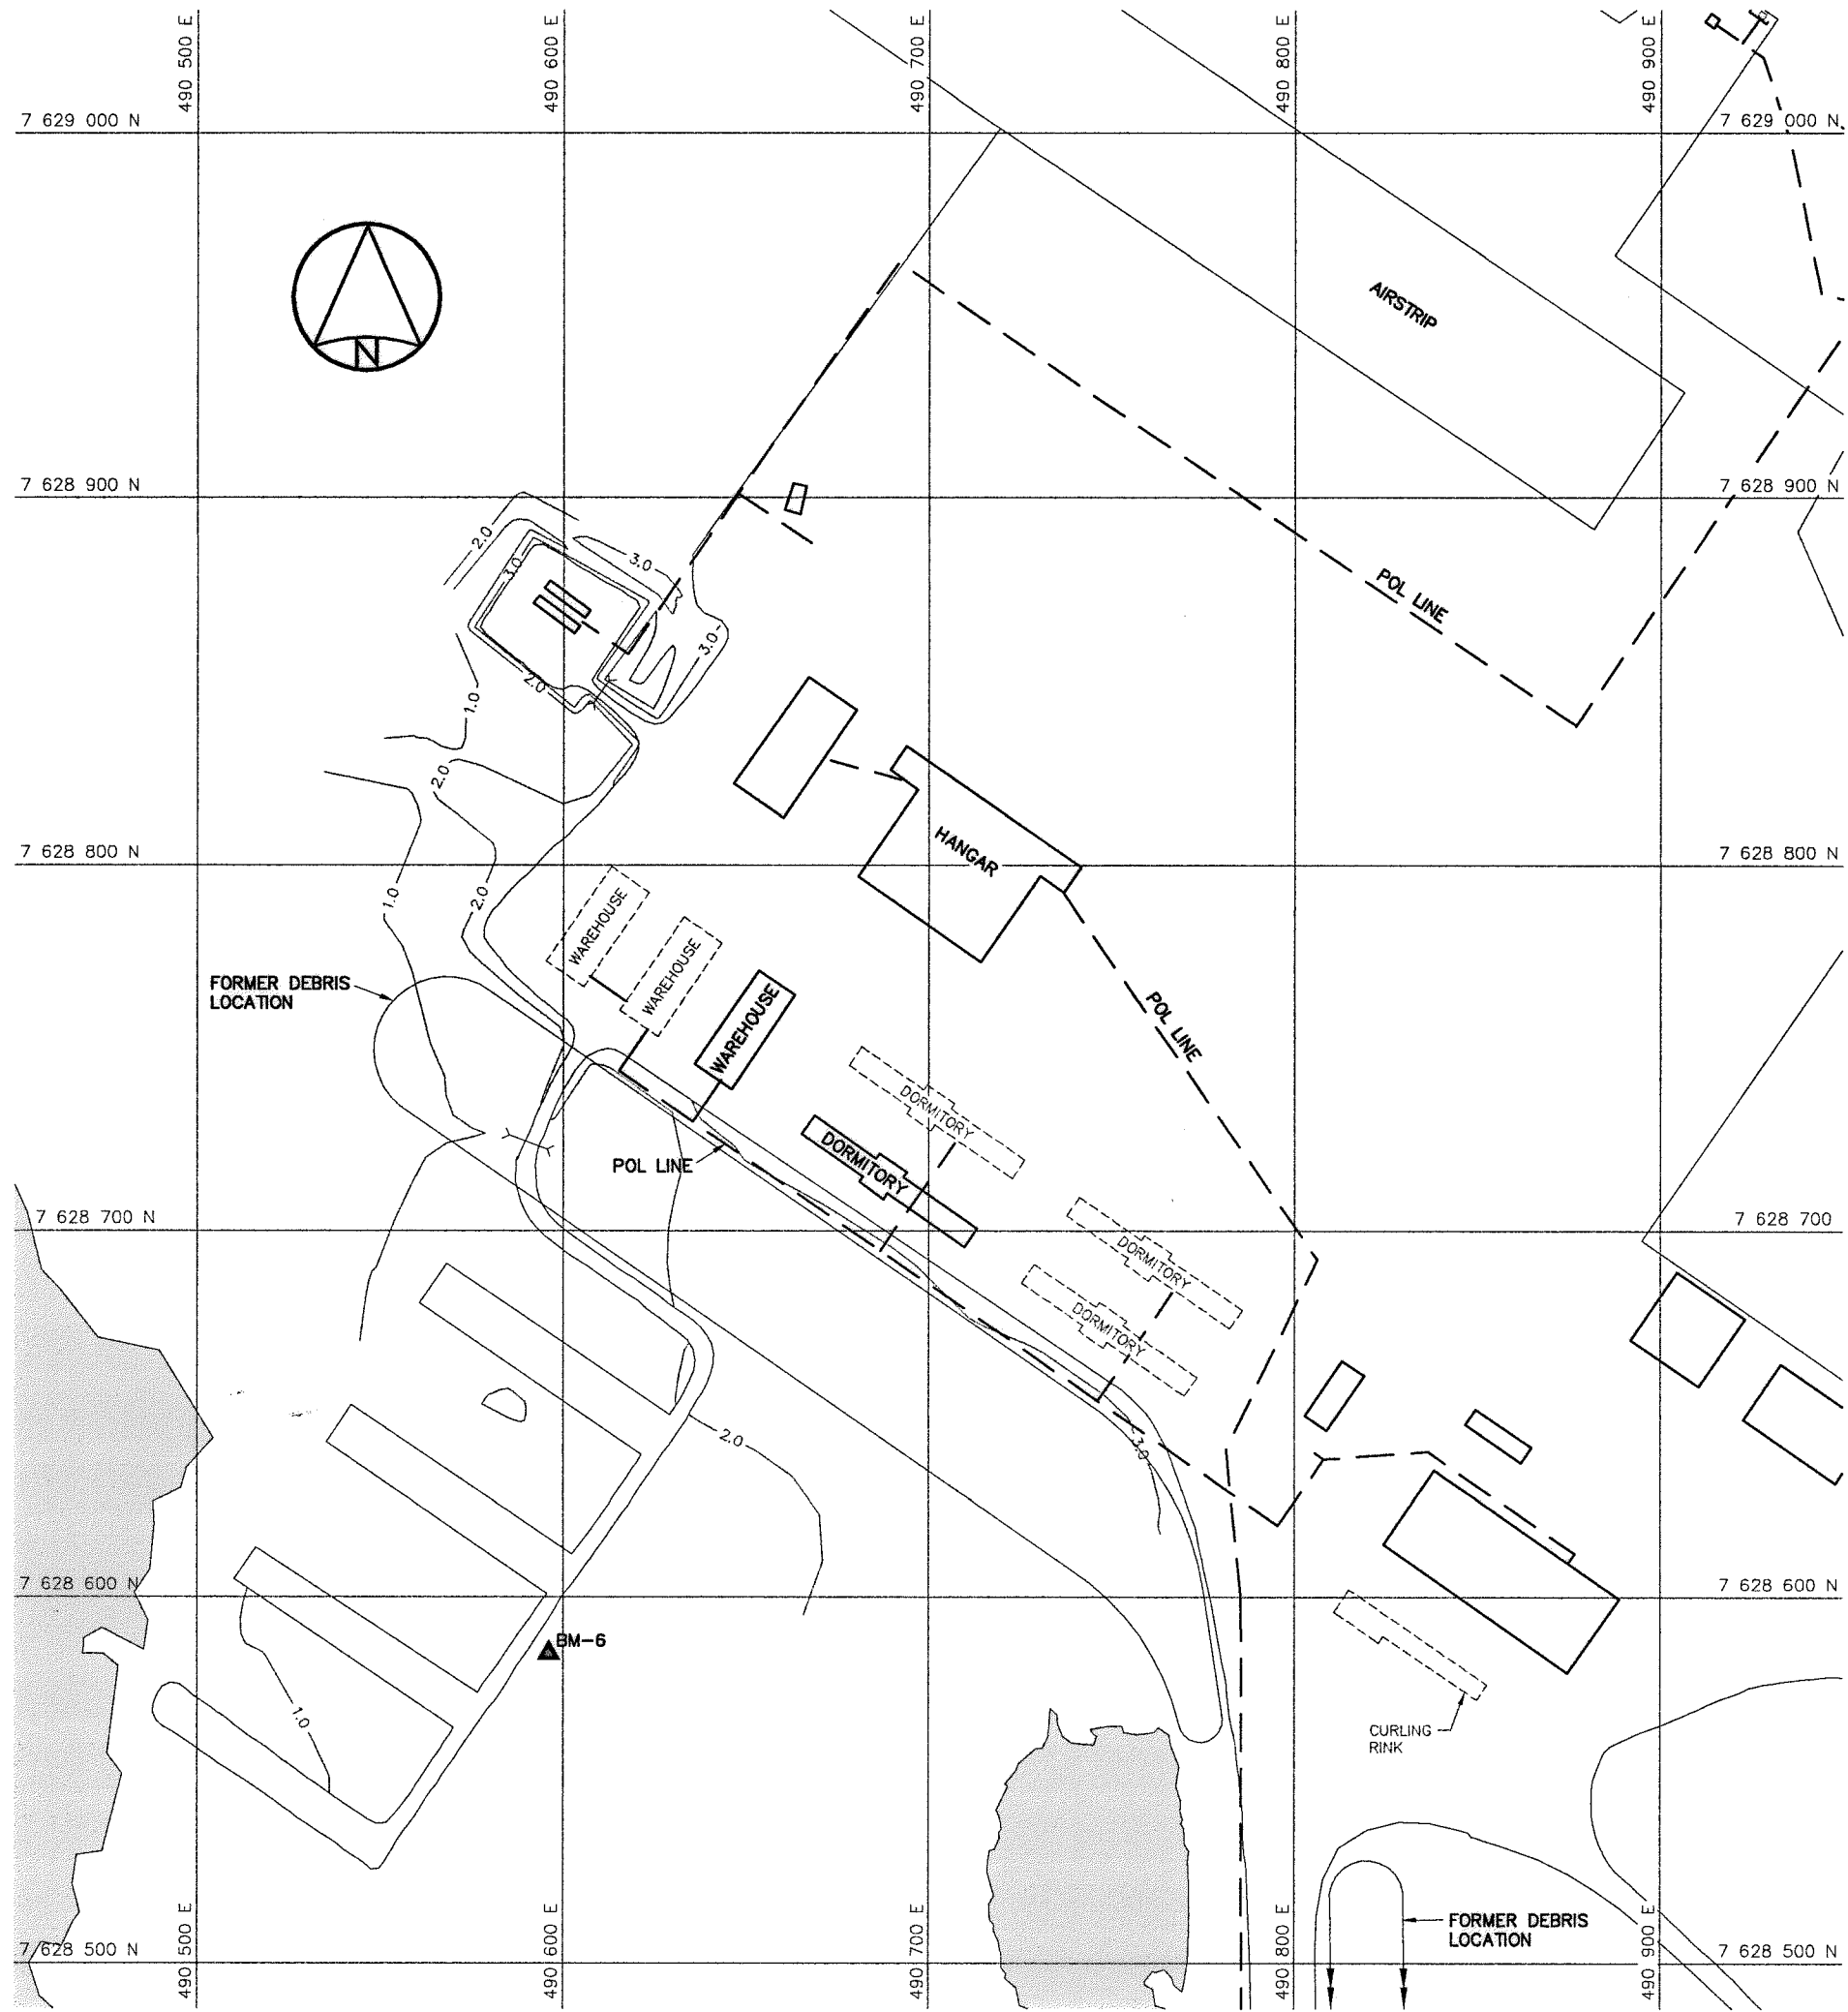

National
Défence

Défense
nationals

Headquarters
Quartier général

General Notes:

1. ALL COORDINATES ARE REFERENCED TO NAD83 (CSRS), UTM ZONE 17. ALL ELEVATIONS REFER TO GEODETIC DATUM.
2. ALL DIMENSIONS ARE IN METRES UNLESS NOTED OTHERWISE.
3. ALL LONG RANGE RADAR (LRR) FACILITIES WERE OPERATIONAL.
4. FOR PERMANENT SURVEY CONTROL (BENCHMARK) INSTALLATION DETAIL, SEE DWG. H-H11/2-9101-117.

Legend:

- ▲ BM-6 PERMANENT BENCHMARK LOCATION (1)
- FORMER BUILDING, STRUCTURE OR TANK LOCATION
- BODY OF WATER

0	11-03-03	AS-BUILT DRAWING	RRM
No.	DATE	REVISION	REVISION

PERMIT TO PRACTICE
AECOM Canada Ltd.
Signature:
Date:
PERMIT NUMBER: P639
NWT/NL Association of Professional Engineers and Geoscientists

SCALE - ECHELLE 20 10 0 20 40 60m

PROJECT - PROJET
FOX-M HALL BEACH

DEW LINE CLEAN UP

© COPYRIGHT
HER MAJESTY THE QUEEN IN RIGHT OF
CANADA 2011, AS REPRESENTED BY THE
MINISTER OF NATIONAL DEFENCE.

TRADE - METIER SITING DATE 2011-03-03

SUBJECT - SUJET


AIRSTRIP AREA
SITE PLAN

PRODUCTION	CONCURRENCE - ASSENTIMENT
DESIGNED ETUDIE RRM	DES OFF AGENT CONCEPT
DRAWN DESSINE JC	SECT HD CHEF SECT
CHECKED VERIFIE BNH	DES MGR GEST CONCEPT
COORDINATION DTM	REVIEWED - REVU

DWG. NO. - DESSIN NO.
H-H11/2-9101-110

Canada

NOTE:
FOR DETAILS REGARDING CONFIRMATORY
TESTING INFORMATION, REFER TO FINAL
REPORT PREPARED BY THE ENVIRONMENTAL
SCIENCES GROUP, ROYAL MILITARY COLLEGE.

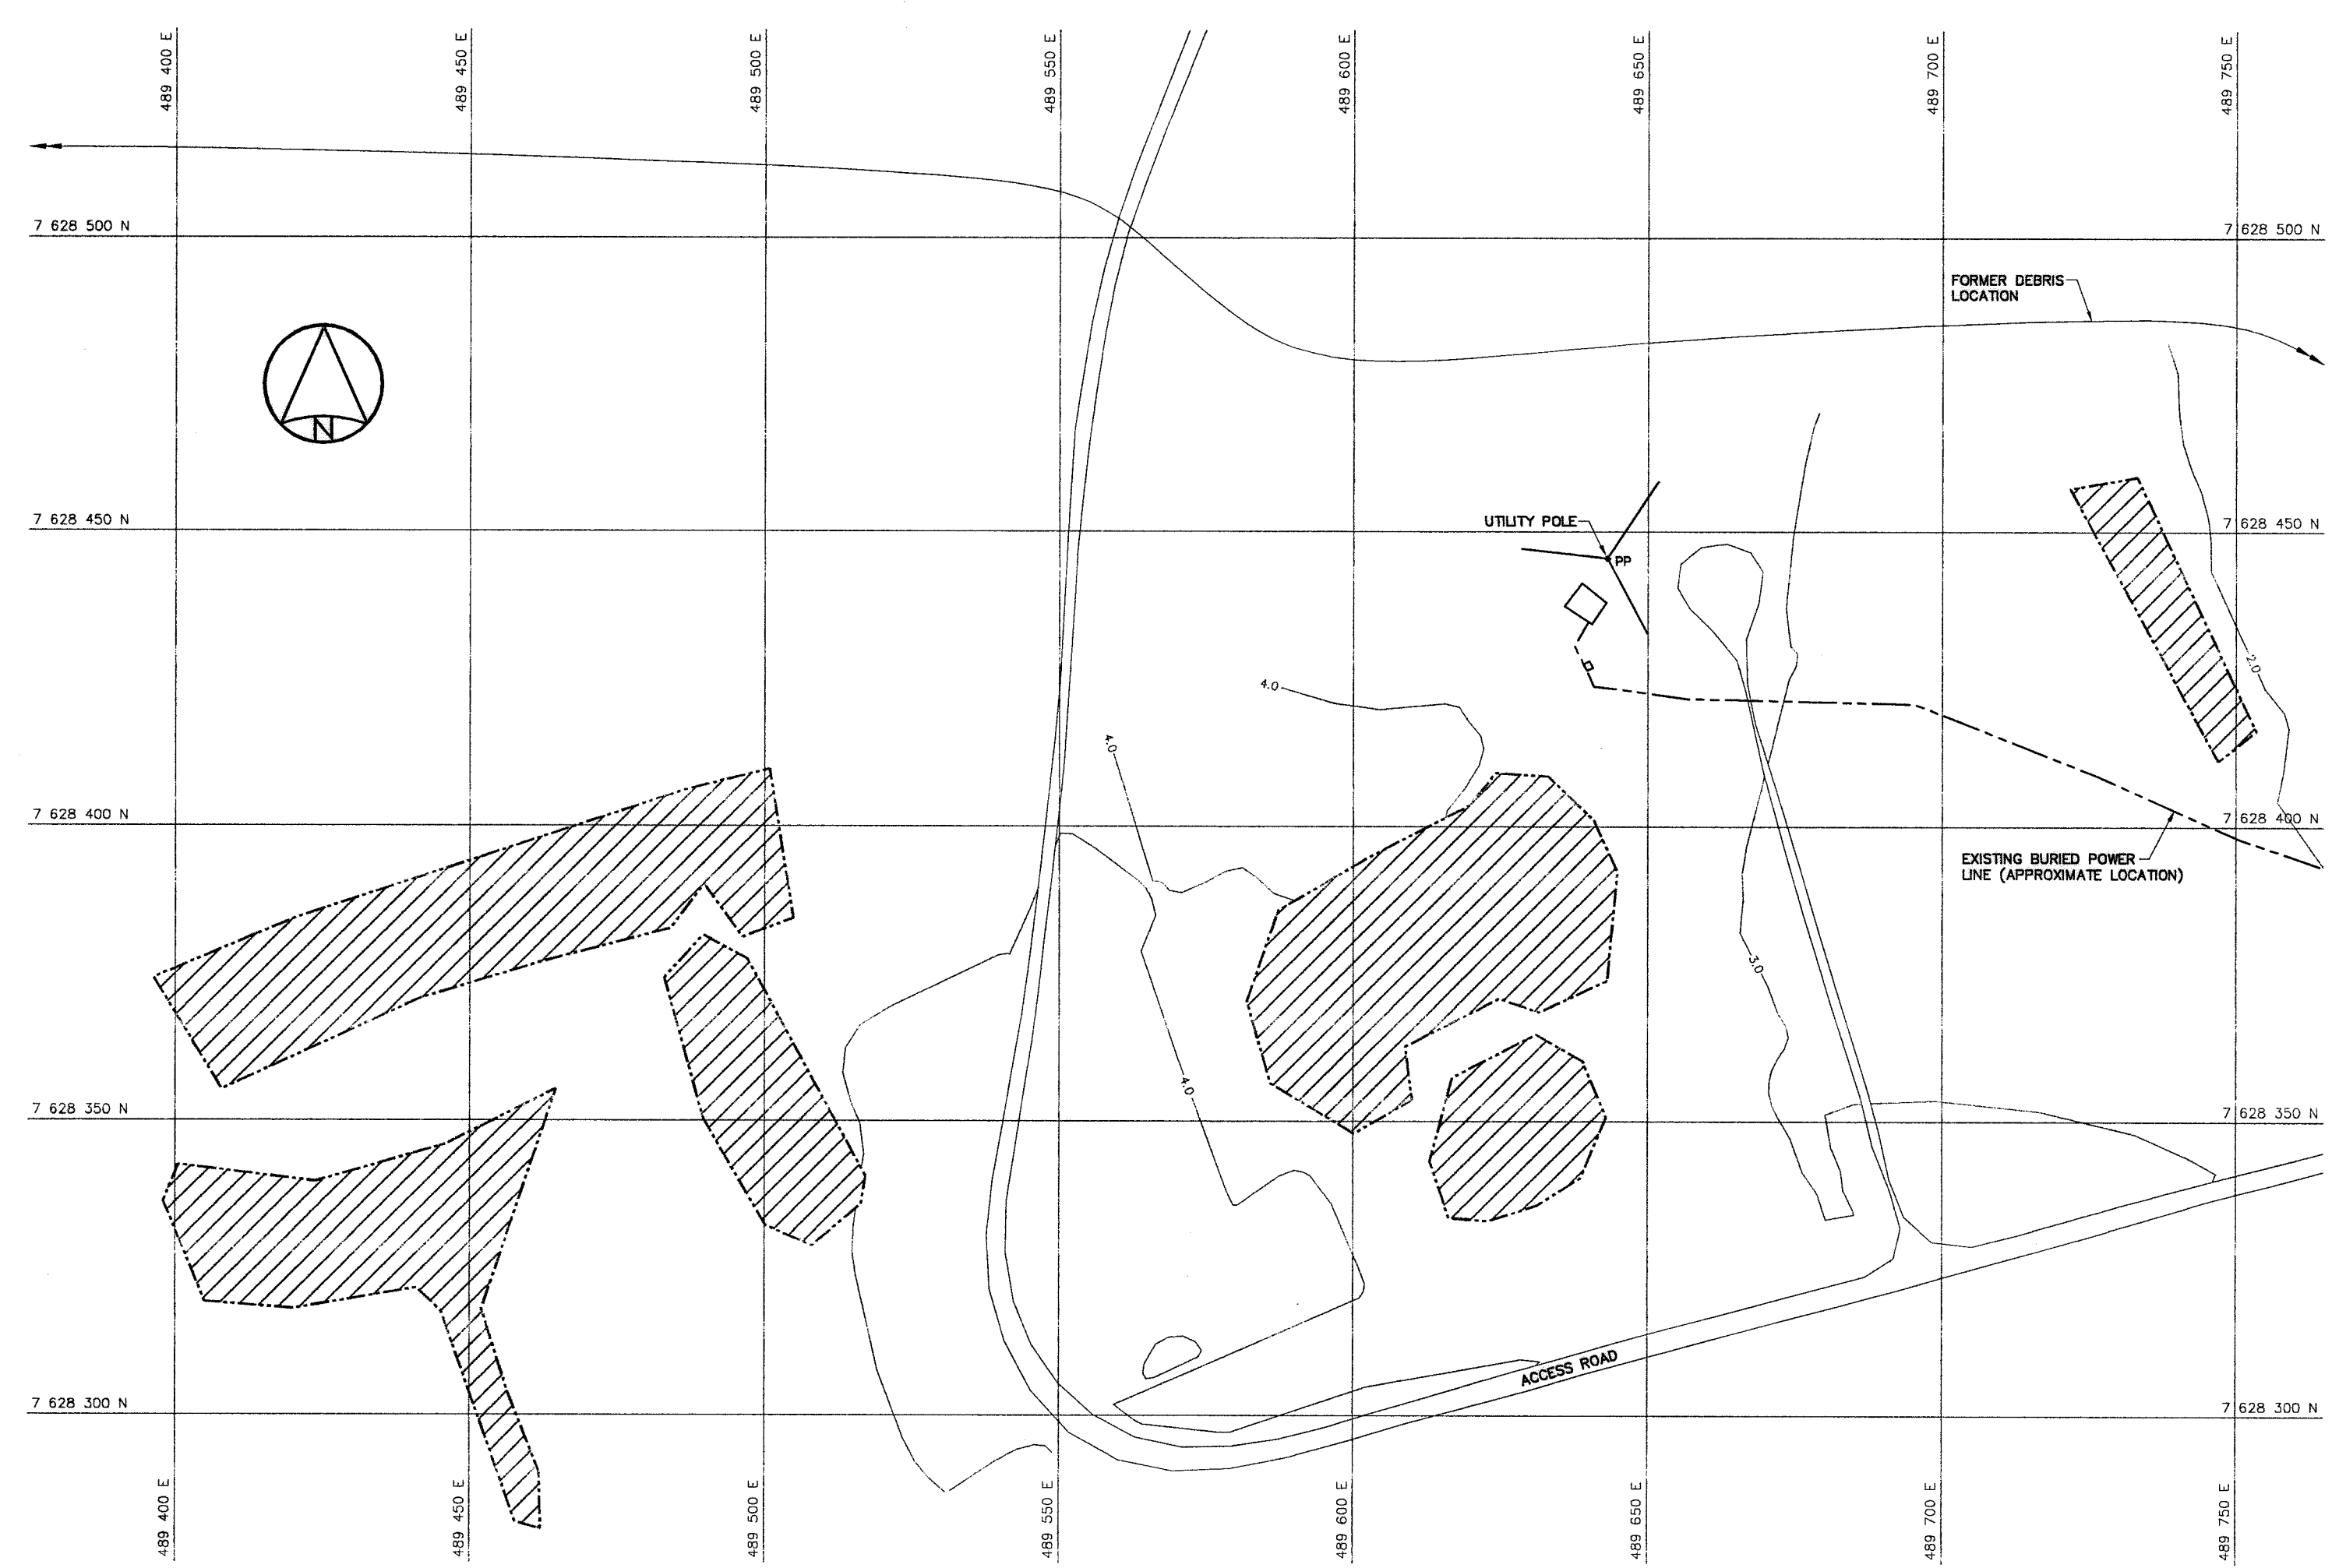

Headquarters
Quartier général

- General Notes:
1. ALL COORDINATES ARE REFERENCED TO NAD83 (CSRS), UTM ZONE 17. ALL ELEVATIONS REFER TO GEODETIC DATUM.
 2. ALL DIMENSIONS ARE IN METRES UNLESS NOTED OTHERWISE.


Legend:

 COMPLETED LANDFILL OR BURIED DEBRIS EXCAVATION

0	11-03-03	AS-BUILT DRAWING	RRM
No.	DATE	REVISION	REVISION
			APPR.



March 9/11

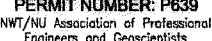PERMIT TO PRACTICE
AECOM Canada Ltd.
Signature: 
Date: 
PERMIT NUMBER: P639
NW/NU Association of Professional Engineers and Geoscientists



SCALE - ECHELLE 10 5 0 10 20 30m

PROJECT - PROJET
FOX-M HALL BEACH

DEW LINE CLEAN UP

© COPYRIGHT
HER MAJESTY THE QUEEN IN RIGHT OF
CANADA 2011, AS REPRESENTED BY THE
MINISTER OF NATIONAL DEFENCE.

TRADE - METIER SITING DATE 2011-03-03

SUBJECT - SUJET

**WEST COMMUNICATIONS AREA
SITE PLAN**

PRODUCTION		CONCURRENCE - ASSESSMENT	
DESIGNED ETUDIE	RRM	DES OFF AGENT CONCEPT	
DRAWN DESSINE	IC	SECT HD CHEF SECT	
CHECKED VERIFIE	BWH	DES MGR GEST CONCEPT	
COORDINATION	DTM	REVIEWED - REVU	

DWG. NO. - DESSIN NO.
H-H11/2-9101-111

General Notes:
1. ALL ELEVATIONS REFER TO GEODETIC DATUM.
2. ALL DIMENSIONS ARE IN METRES UNLESS NOTED OTHERWISE.

Legend:
— GENERATED BASED ON AS-BUILT SURVEY INFORMATION
- - - CONSTRUCTED AS PER DESIGN, NO AS-BUILT SURVEY INFORMATION

0	11-03-03	AS-BUILT DRAWING	RRM
No.	DATE	REVISION	REVISION



PERMIT TO PRACTICE
AECOM Canada Ltd.
Signature: *[Signature]*
Date: *March 9/11*
PERMIT NUMBER: P639
NWT/NL Association of Professional Engineers and Geoscientists

AECOM **HATCH**

SCALE - ECHELLE
AS SHOWN

PROJECT - PROJET
FOX-M HALL BEACH

DEW LINE CLEAN UP

© COPYRIGHT
HER MAJESTY THE QUEEN IN RIGHT OF CANADA 2011, AS REPRESENTED BY THE MINISTER OF NATIONAL DEFENCE.

TRADE - METIER
SITING
DATE
2011-03-03







SUBJECT - SUJET

NON-HAZARDOUS WASTE LANDFILL CROSS SECTIONS AND DETAIL

PRODUCTION	CONCURRENCE - ASSENTIMENT
DESIGNED ETUDIE RRM	DES OFF AGENT CONCEPT
DRAWN DESSINE IC	SECT HD CHIEF SECT
CHECKED VERIFIE BNH	DES MGR GEST CONCEPT
COORDINATION DTM	REVIEWED - REVU



DWG. NO. - DESSIN NO.
H-H11/2-9101-112

Canada

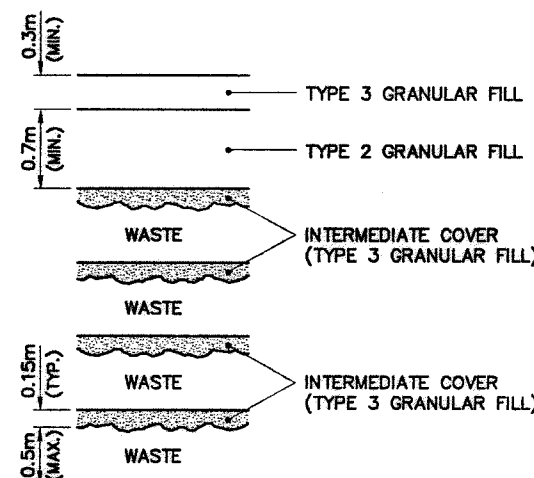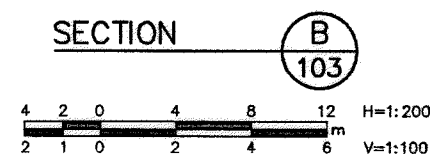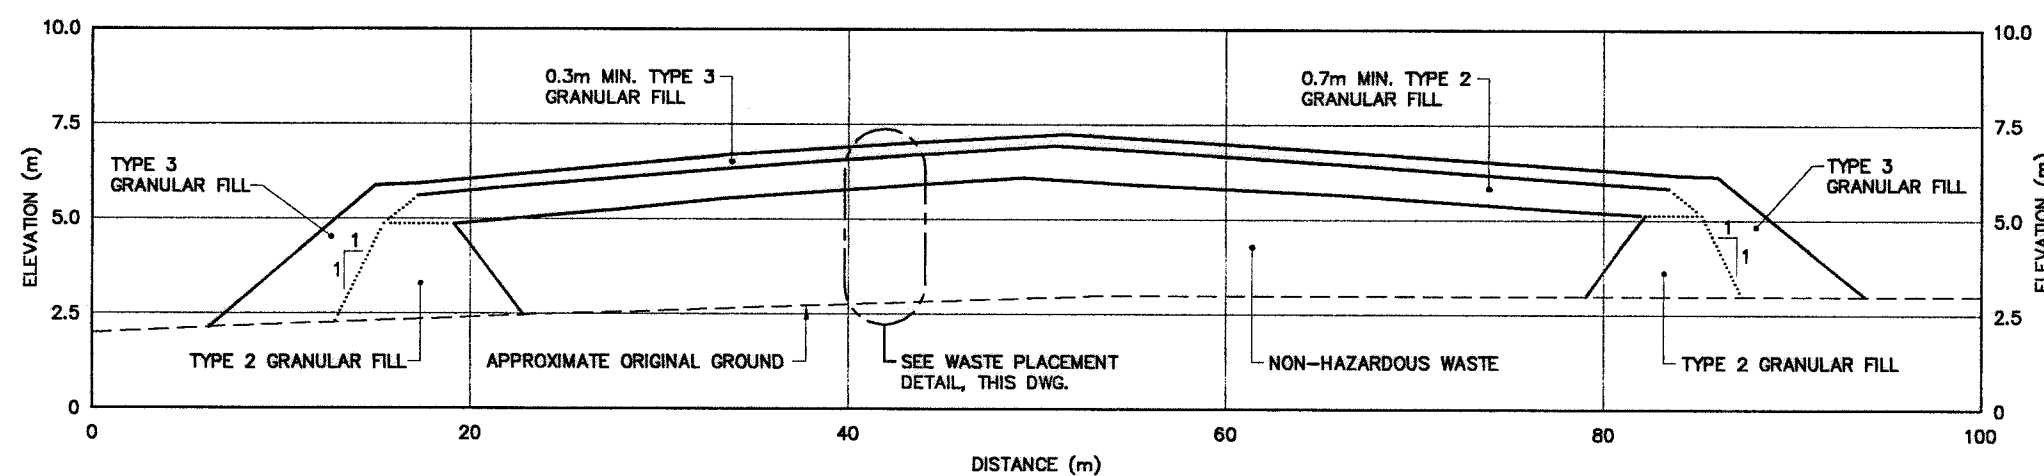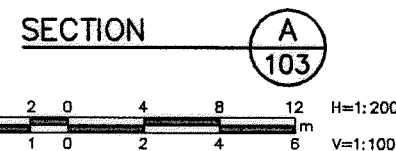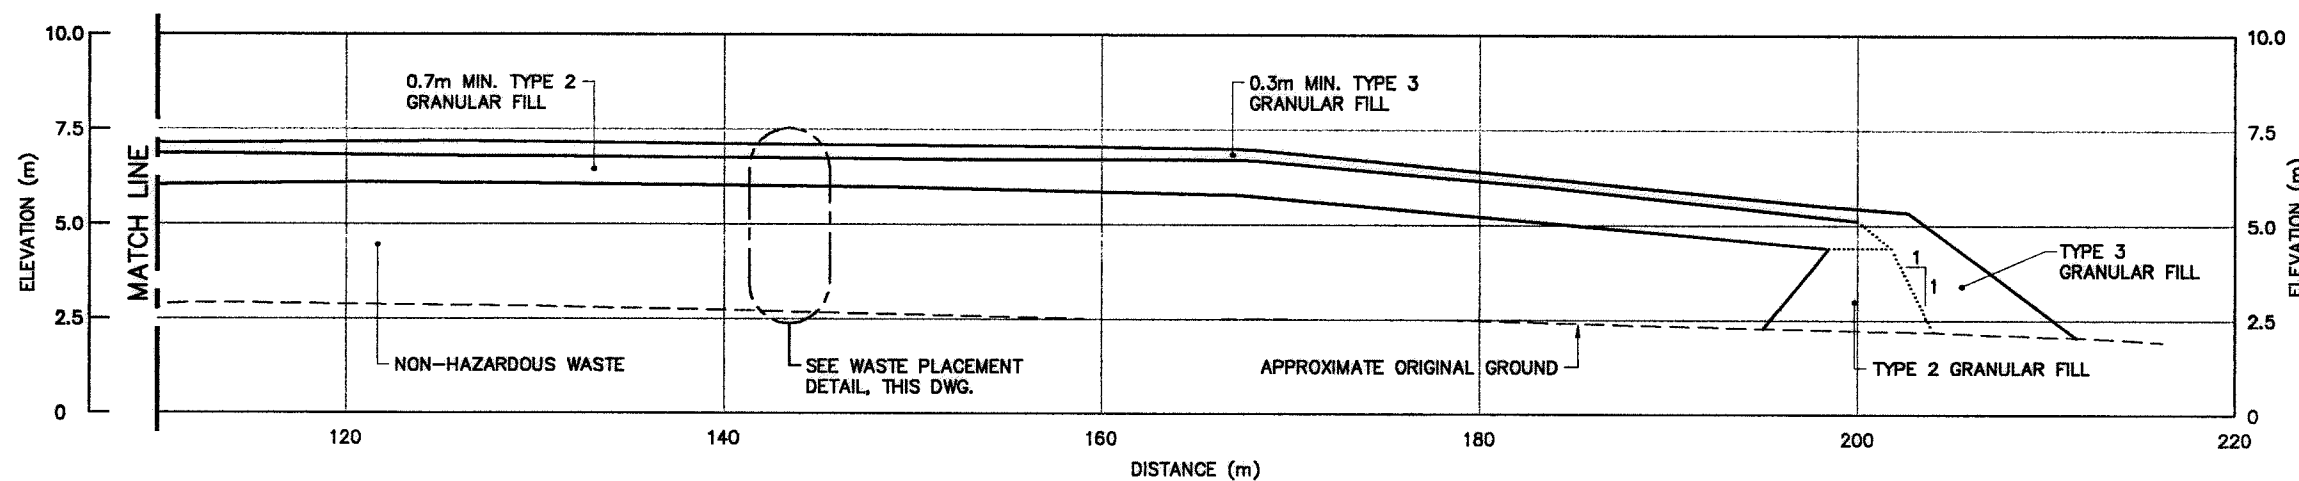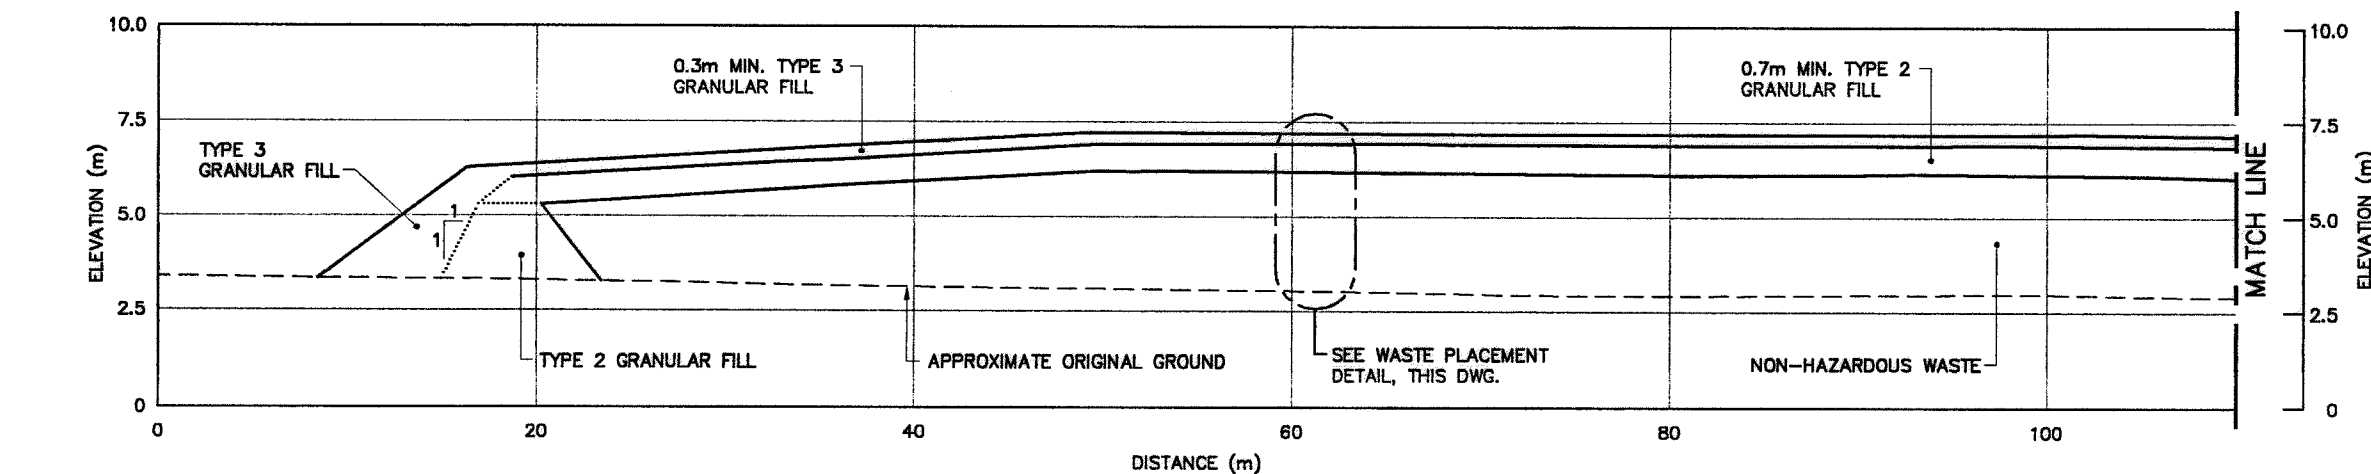


ADDITIONAL WASTE LAYERS, MAY HAVE BEEN REQUIRED, TO ACHIEVE THE NON-HAZARDOUS WASTE LANDFILL DESIGN ELEVATIONS.


WASTE PLACEMENT DETAIL
SCALE: NTS

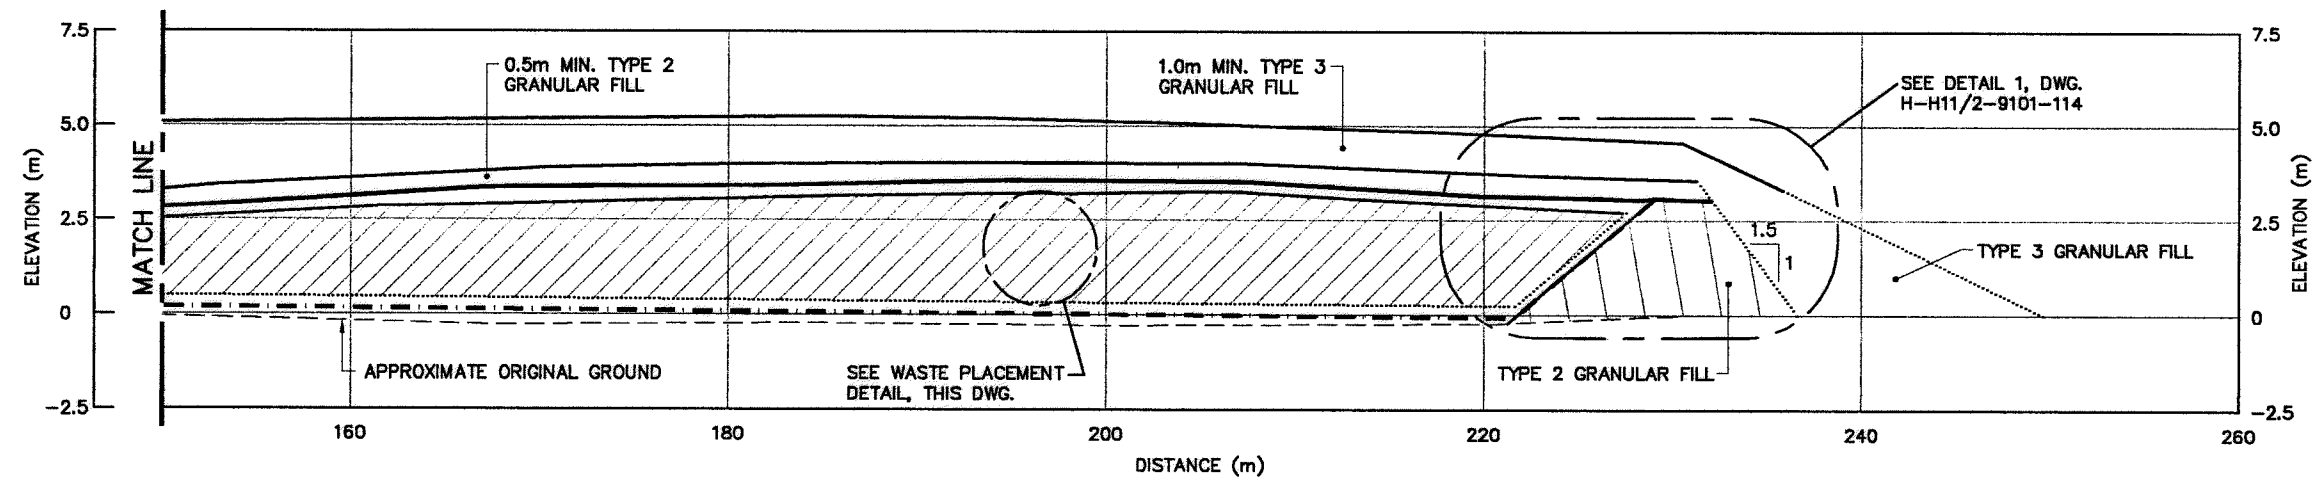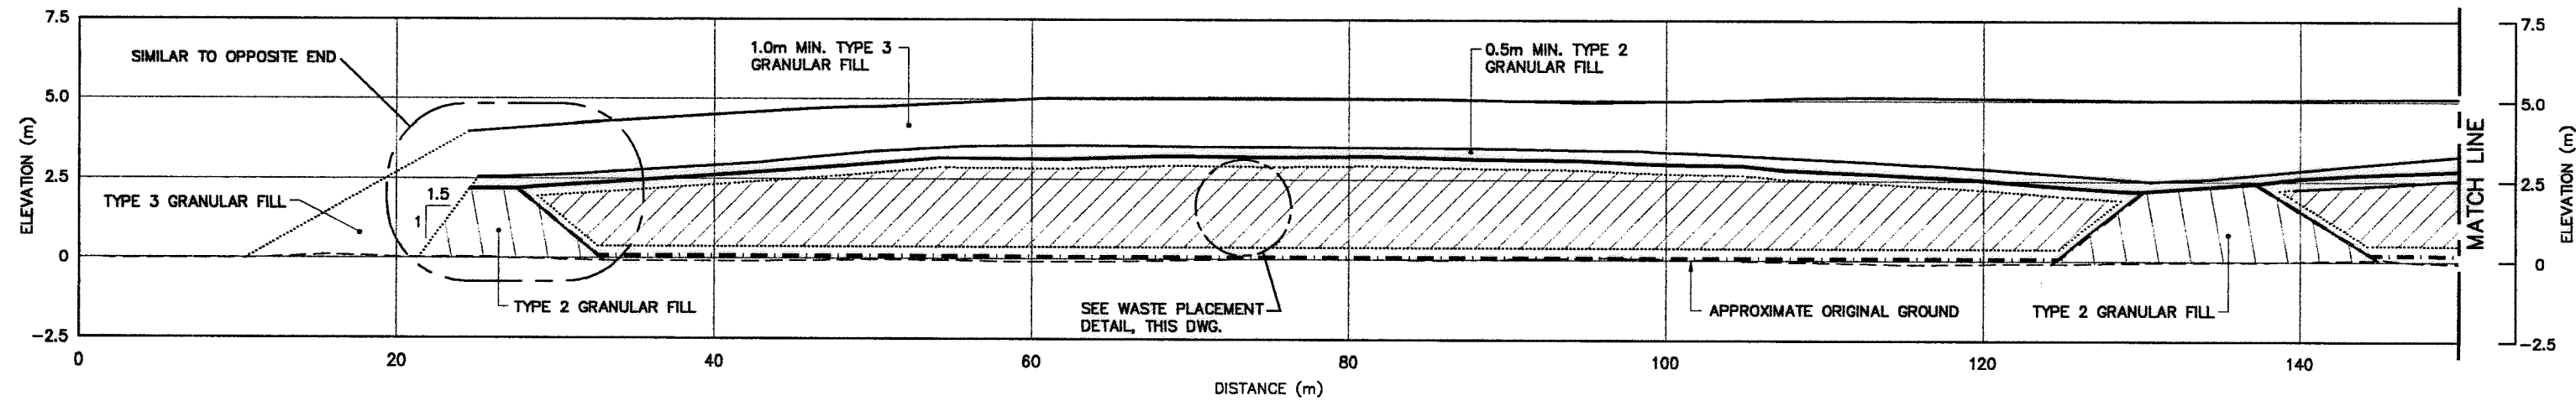

SECTION C 106
H=1:200
V=1:100

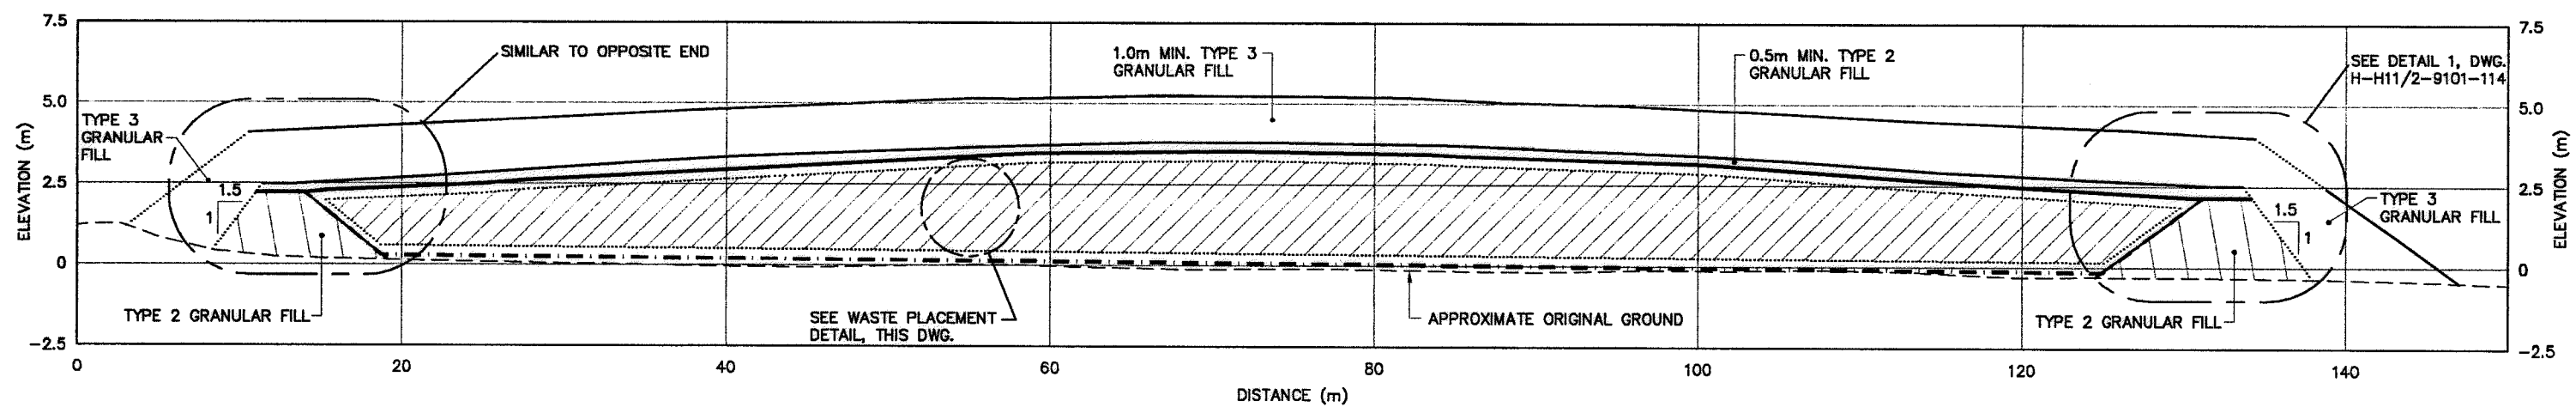


SECTION D 106
H=1:200
V=1:100

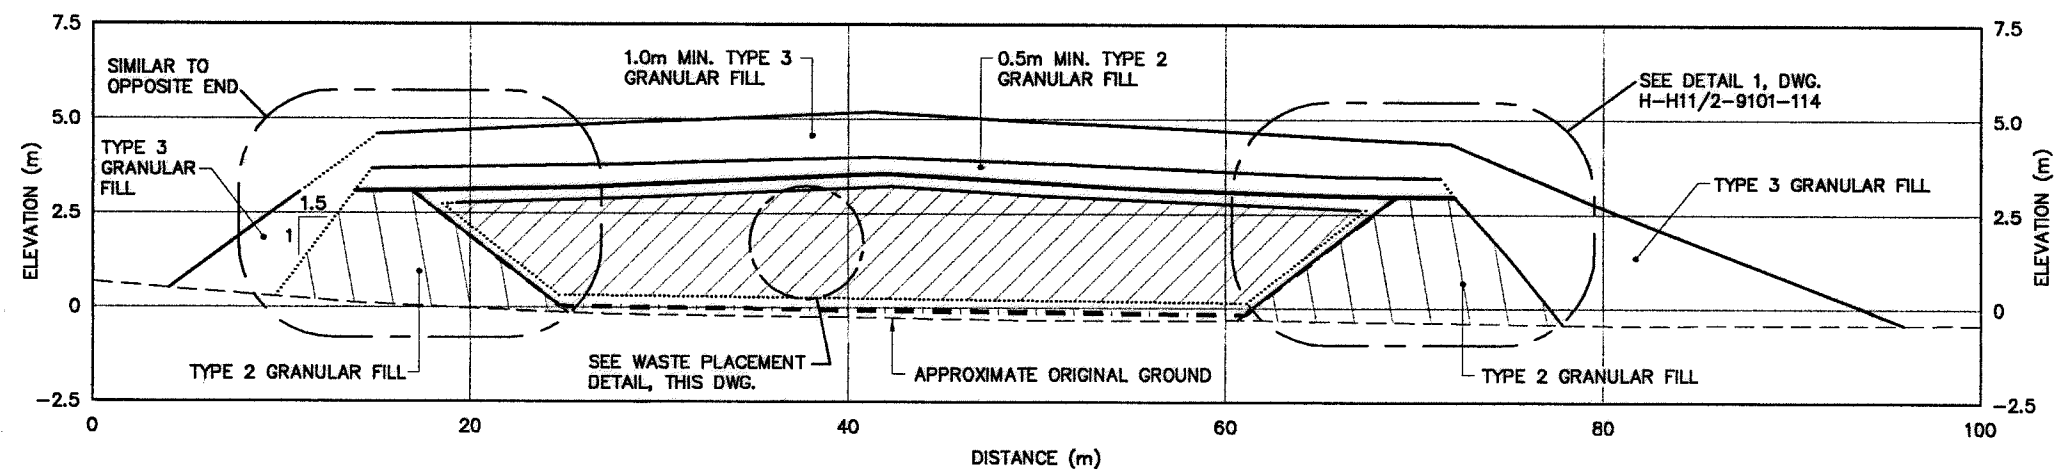

SECTION E 106
H=1:200
V=1:100

ADDITIONAL TIER II SOIL LAYERS, MAY HAVE BEEN REQUIRED, TO ACHIEVE THE TIER II DISPOSAL FACILITY DESIGN ELEVATIONS.

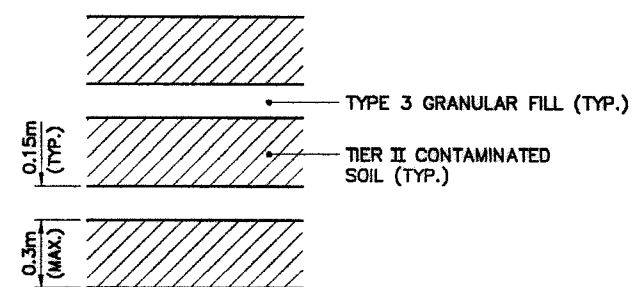

WASTE PLACEMENT DETAIL
SCALE: NTS


General Notes:

1. ALL ELEVATIONS REFER TO GEODETIC DATUM.
2. ALL DIMENSIONS ARE IN METRES UNLESS NOTED OTHERWISE.

Legend:

- GENERATED BASED ON AS-BUILT SURVEY INFORMATION
- CONSTRUCTED AS PER DESIGN, NO AS-BUILT SURVEY INFORMATION

0	11-03-03	AS-BUILT DRAWING	ARM
No.	DATE	REVISION	APPR.

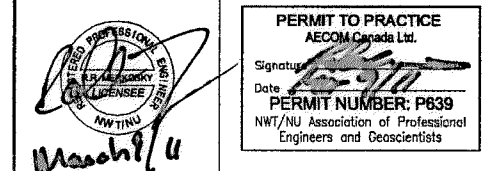

AECOM HATCH

SCALE - ECHELLE AS SHOWN

PROJECT - PROJET
FOX-M HALL BEACH

DEW LINE CLEAN UP



© COPYRIGHT
HER MAJESTY THE QUEEN IN RIGHT OF
CANADA 2011, AS REPRESENTED BY THE
MINISTER OF NATIONAL DEFENCE.

TRADE - METIER SITING DATE 2011-03-03
SUBJECT - SUJET

TIER II DISPOSAL FACILITY-REVISED
CROSS SECTIONS AND DETAIL

DESIGNED ETUDIE	ARM	DES OFF AGENT CONCEPT
DRAWN DESSINE	IC	SECT HD CHIEF SECT
CHECKED VERIFIE	DM	DES MGR GEST CONCEPT
COORDINATION COORDINATION	DM	REVIEWED - REVU

DWG. NO. - DESSIN NO.
H-H11/2-9101-113

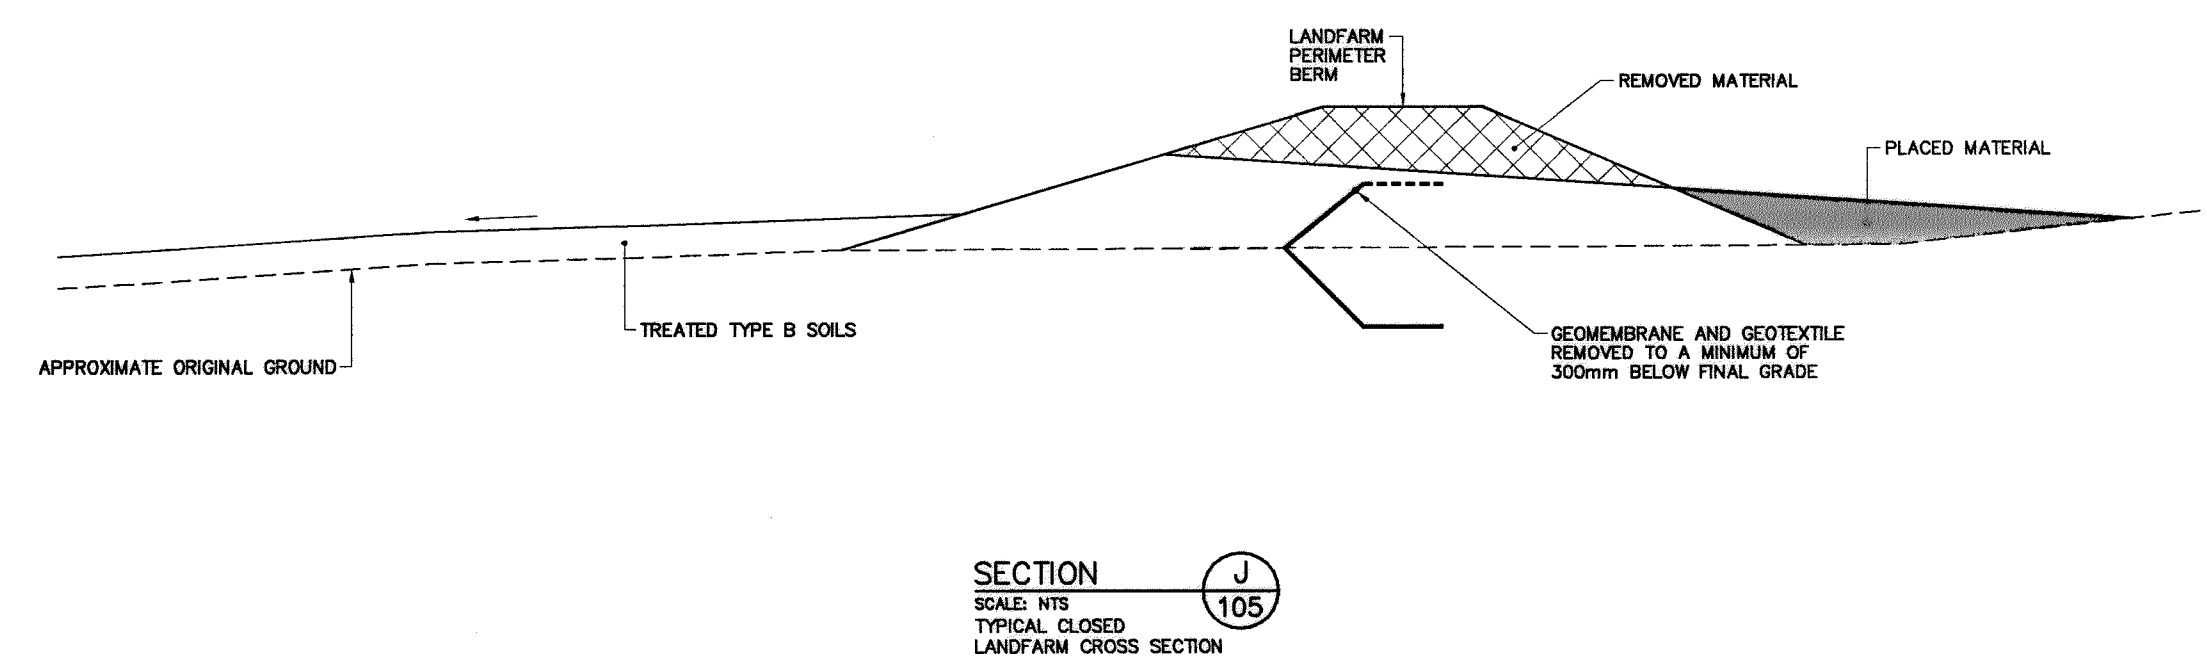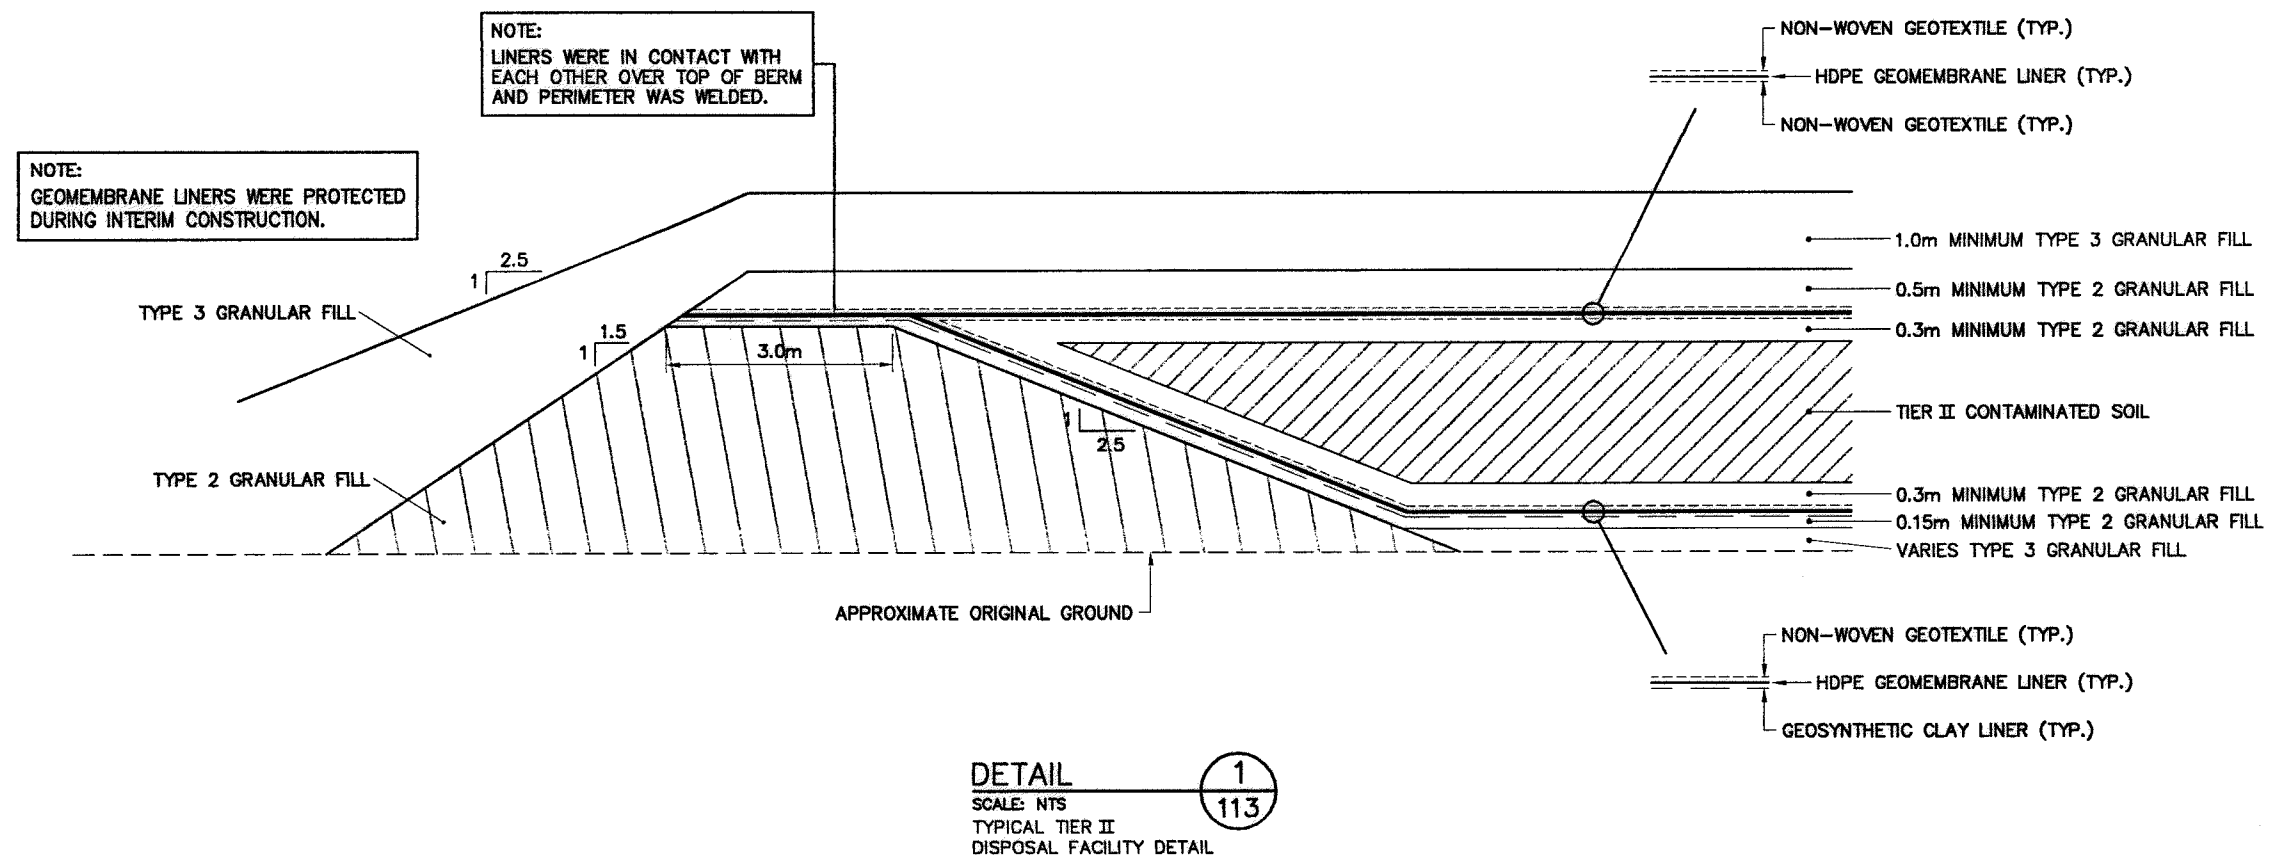

General Notes:

1. ALL DIMENSIONS ARE IN METRES UNLESS NOTED OTHERWISE.

0	11-03-03	AS-BUILT DRAWING	RRM
No.	DATE	REVISION	REVISION
			APPR.

PERMIT TO PRACTICE
AECOM Canada Ltd.
Signature: [Signature]
Date: March 9/11
PERMIT NUMBER: P639
NWT/NU Association of Professional Engineers and Geoscientists



SCALE - ECHELLE
AS SHOWN

PROJECT - PROJET
FOX-M HALL BEACH

DEW LINE CLEAN UP

© COPYRIGHT
HER MAJESTY THE QUEEN IN RIGHT OF
CANADA 2011, AS REPRESENTED BY THE
MINISTER OF NATIONAL DEFENCE.

TRADE - METIER	SITING	DATE
SUBJECT - SUJET		2011-03-03

TIER II DISPOSAL FACILITY DETAIL
AND LANDFARM SECTION

DESIGNED ETUDIE	DRAWN DESSINE	CHECKED VERIFIE	COORDINATION	CONCURRENCE - ASSENTIMENT
RRM	K	BHH	DTM	
				DES OFF AGENT CONCEPT
				SECT HD CHEF SECT
				DES MGR GEST CONCEPT
				REVIEWED - REVU

DWG. NO. - DESSIN NO.
H-H11/2-9101-114


General Notes:

1. ALL COORDINATES ARE REFERENCED TO NAD83 (CSRS), UTM ZONE 17. ALL ELEVATIONS REFER TO GEODETIC DATUM.
2. ALL DIMENSIONS ARE IN METRES UNLESS NOTED OTHERWISE.
3. FOR MONITORING WELL INSTALLATION DETAIL AND COORDINATE POINTS, SEE DWG. H-H11/2-9101-117.
4. FOR GROUND TEMPERATURE CABLE INSTALLATION DETAILS, SEE DWG. H-H11/2-9101-118.

Legend:

- 701 COORDINATE POINT
- MW-20 MONITORING WELL LOCATION (12)
- VT-06 GROUND TEMPERATURE CABLE LOCATION (6)
- SWALE
- BODY OF WATER
- CONSTRUCTED AS PER DESIGN, NO AS-BUILT SURVEY INFORMATION

0	11-03-03	AS-BUILT DRAWING	RRM
No.	DATE	REVISION	REVISION
			APPR.

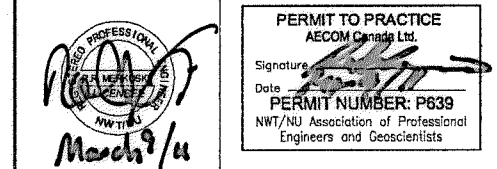

AECOM HATCH

SCALE - ECHELLE 40 20 0 40 80 120m

PROJECT - PROJET
FOX-M HALL BEACH

DEW LINE CLEAN UP

© COPYRIGHT
HER MAJESTY THE QUEEN IN RIGHT OF
CANADA 2011, AS REPRESENTED BY THE
MINISTER OF NATIONAL DEFENCE.

TRADE - METIER SITING DATE 2011-03-03


SUBJECT - SUJET

EAST BEACH LANDFILLS
OVERALL LAYOUT

PRODUCTION	CONCURRENCE - ASSENTMENT
DESIGNED ETUDE RRM	DES OFF AGENT CONCEPT
DRAWN DESSINE IC	SECT HD CHIEF SECT
CHECKED VERIFIE BNH	DES MGR GEST CONCEPT
COORDINATION DTM	REVIEWED - REVU

DWG. NO. - DESSIN NO.
H-H11/2-9101-115

Canada

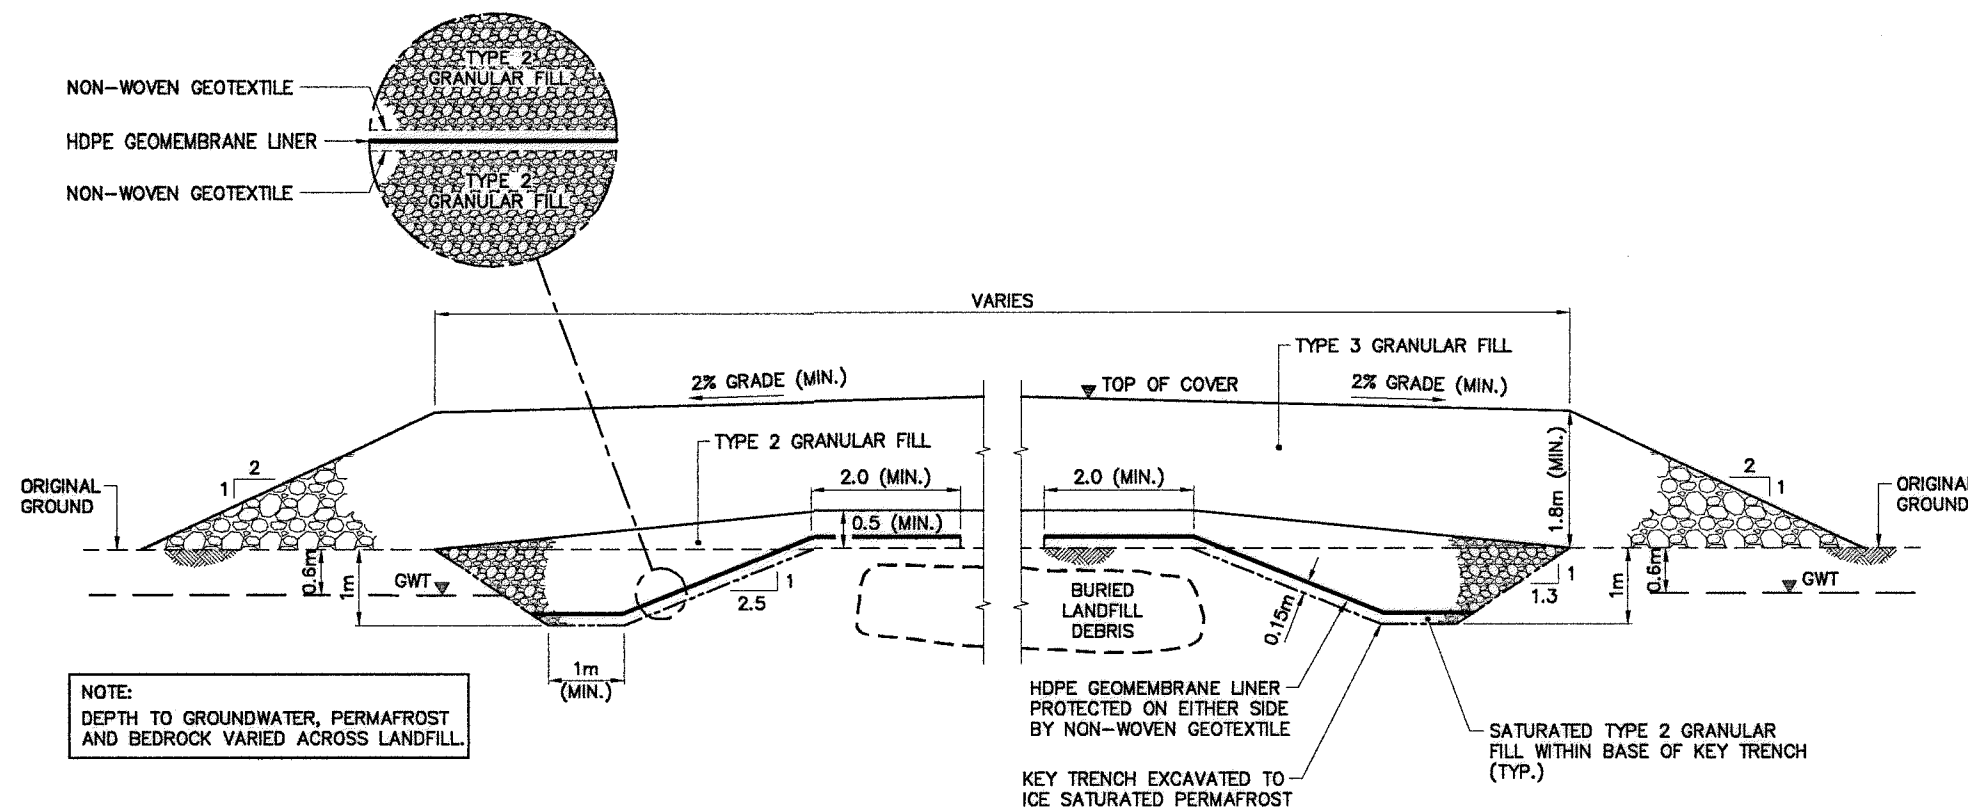

TYPICAL CONTAINMENT SYSTEM CROSS SECTION

SCALE: NTS
EAST BEACH LANDFILLS

NOTE:


FOR DETAILS REGARDING CONFIRMATORY TESTING INFORMATION, REFER TO FINAL REPORT PREPARED BY THE ENVIRONMENTAL SCIENCES GROUP, ROYAL MILITARY COLLEGE.


KEY TRENCH CENTRELINE (AS-BUILT)

NO.	UTM COORDINATES		ELEV.
	NORTHING	EASTING	
701	7 627 356.6	491 600.7	-2.5
702	7 627 357.2	491 647.2	-2.1
703	7 627 340.2	491 645.1	-1.6
704	7 627 310.5	491 620.4	-2.4
705	7 627 283.6	491 602.1	-2.3
706	7 627 278.2	491 566.3	-2.7
707	7 627 293.8	491 559.1	-3.2
708	7 627 347.2	491 584.6	-2.5
710	7 627 054.2	491 549.2	-2.5
711	7 627 038.6	491 580.1	-1.8
712	7 626 974.0	491 580.4	-2.4
713	7 626 925.3	491 557.5	-2.3
714	7 626 871.9	491 517.2	-2.4
715	7 626 576.9	491 208.7	-1.3
716	7 626 538.5	491 171.3	-1.4
717	7 626 488.3	491 137.9	-1.6
718	7 626 471.2	491 106.0	-2.0
719	7 626 422.1	490 937.5	-2.0
720	7 626 418.0	490 925.9	-2.7
721	7 626 478.9	490 868.1	-2.6
722	7 626 532.2	490 972.7	-1.5
723	7 626 532.7	491 007.7	-1.5
724	7 626 548.8	491 090.9	-1.8
725	7 626 566.1	491 130.8	-2.0
726	7 626 590.5	491 161.2	-2.3
727	7 626 629.5	491 197.7	-2.5
728	7 626 701.4	491 282.1	-2.3
729	7 626 734.9	491 310.9	-2.6
730	7 626 793.9	491 332.7	-2.8
731	7 626 863.5	491 455.3	-2.7
732	7 626 924.5	491 521.3	-2.3
733	7 627 021.3	491 537.2	-2.5

GROUND TEMPERATURE CABLE (AS-BUILT)


NO.	UTM COORDINATES	
	NORTHING	EASTING
VT-06	7 626 451.0	490 895.0
VT-07	7 626 742.0	491 381.0
VT-08	7 626 816.0	491 370.0
VT-09	7 627 039.0	491 580.0
VT-10	7 627 284.0	491 605.0
VT-11	7 627 315.0	491 569.0

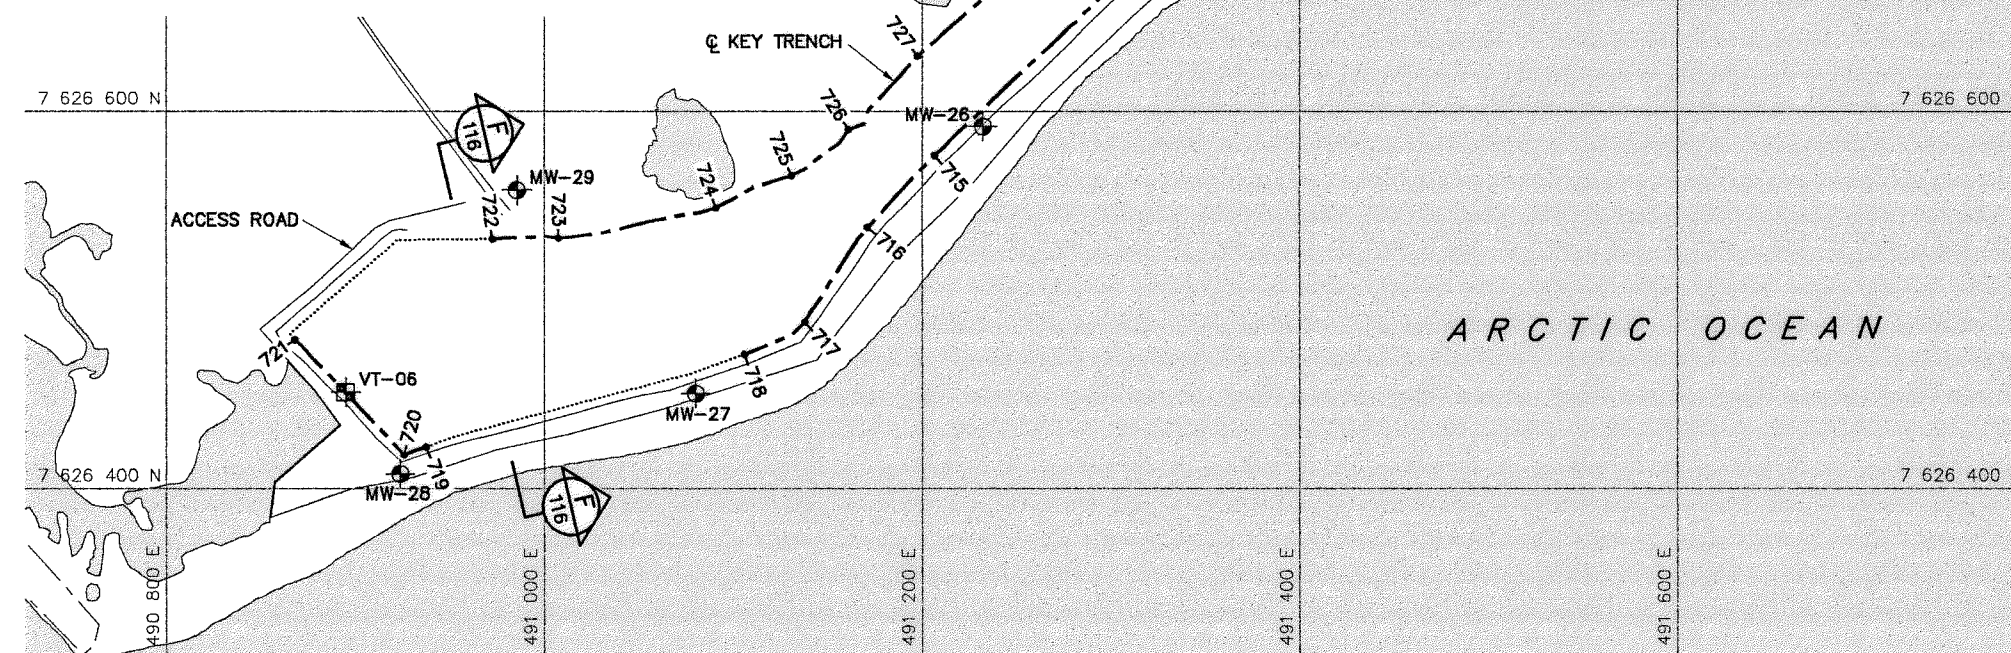

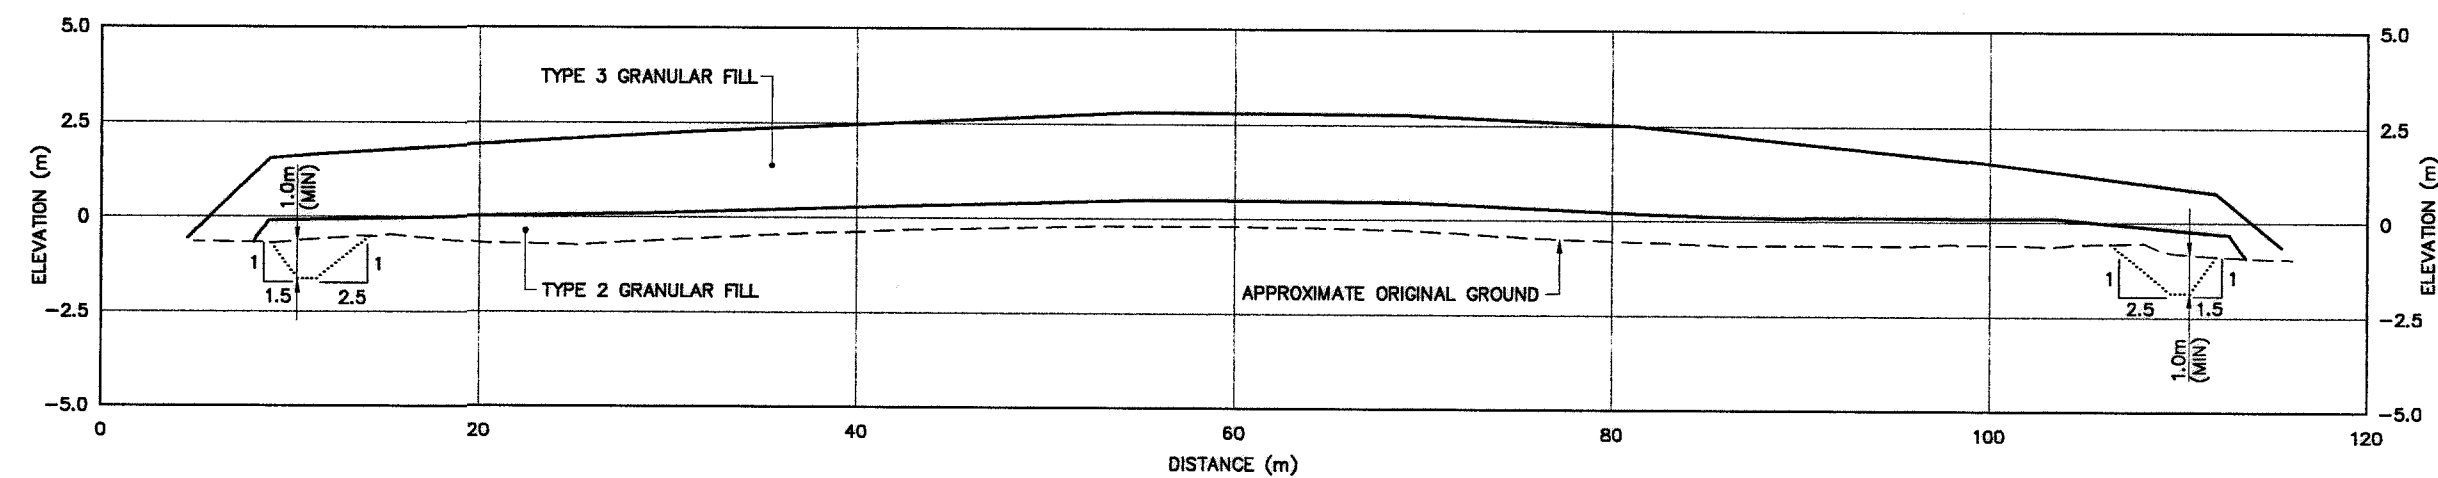


SECTION **F**
115

4 2 0 4 8 12 H=1:200
2 1 0 2 4 6 V=1:100

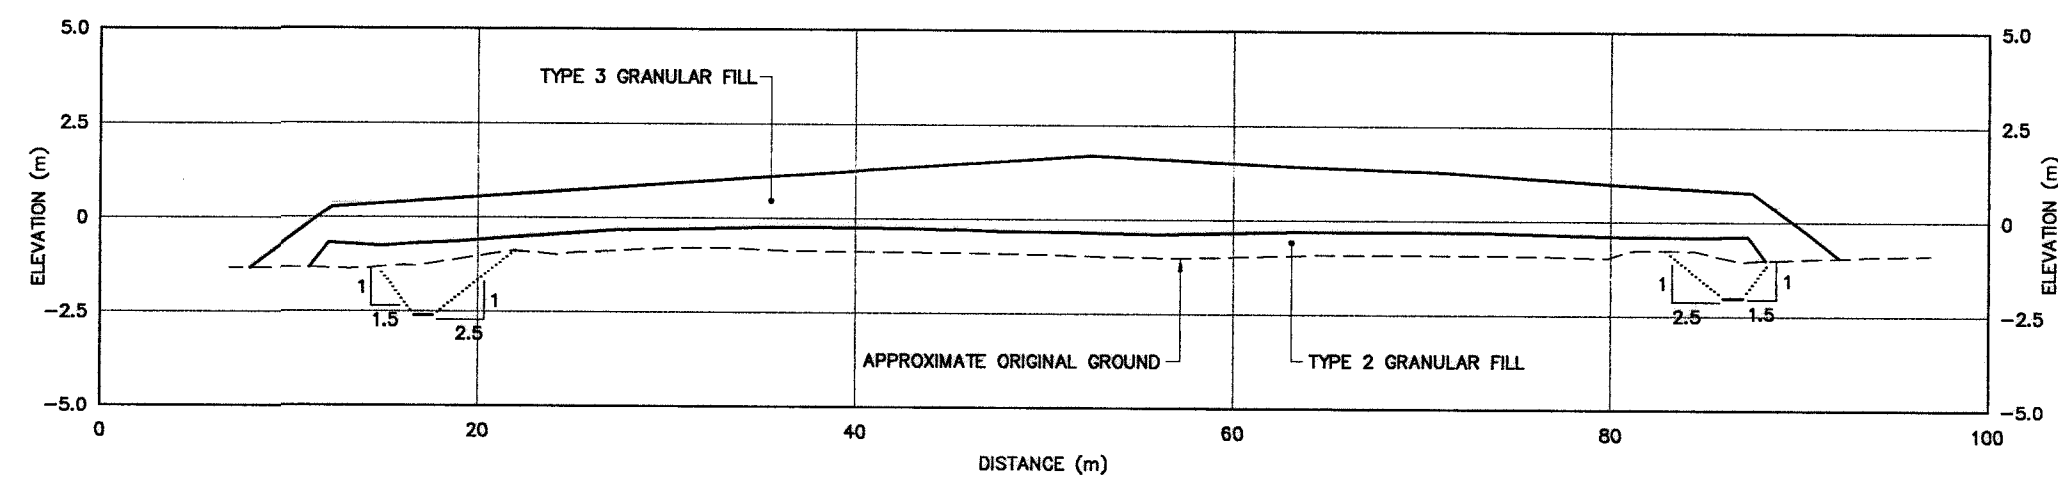

SECTION **G**
115

4 2 0 4 8 12 H=1:200
2 1 0 2 4 6 V=1:100

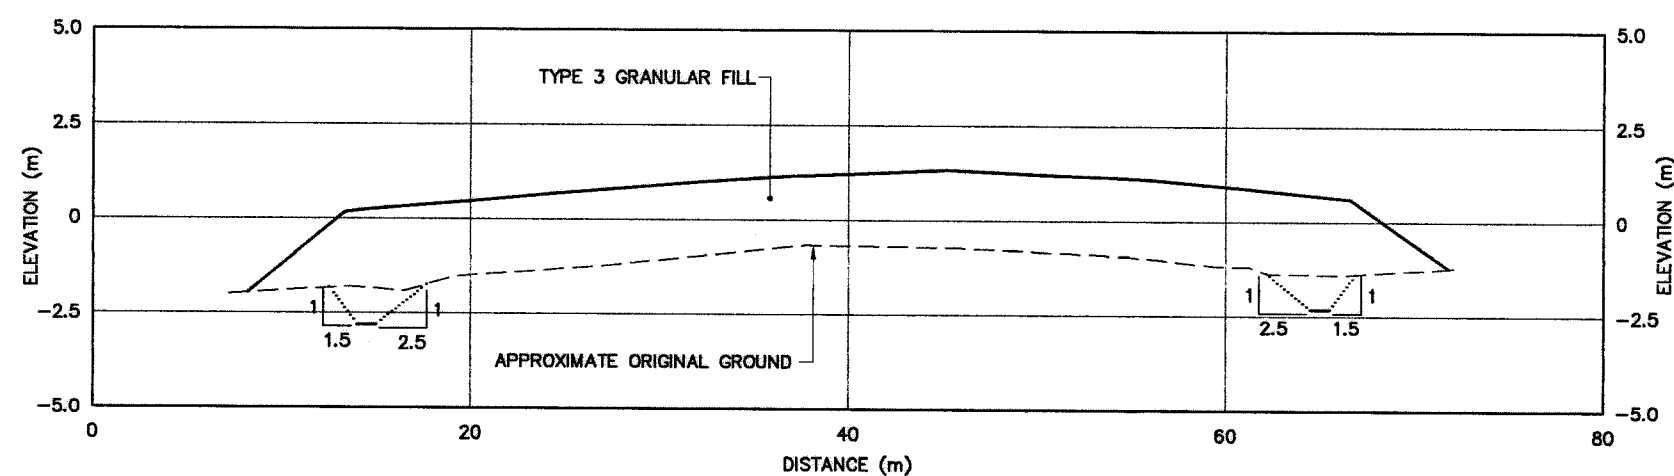

SECTION **H**
115

4 2 0 4 8 12 H=1:200
2 1 0 2 4 6 V=1:100

- General Notes:
1. ALL ELEVATIONS REFER TO GEODETIC DATUM.
 2. ALL DIMENSIONS ARE IN METRES UNLESS NOTED OTHERWISE.

- Legend:
- GENERATED BASED ON AS-BUILT SURVEY INFORMATION
 - CONSTRUCTED AS PER DESIGN, NO AS-BUILT SURVEY INFORMATION

0	11-03-03	AS-BUILT DRAWING	RRM
No.	DATE	REVISION	REVISION
			APPR.

PERMIT TO PRACTICE
AECOM Canada Ltd.

Signature:

Date:

PERMIT NUMBER: P639

NWT/NJ Association of Professional Engineers and Geoscientists

AECOM **HATCH**

SCALE - ECHELLE AS SHOWN

PROJECT - PROJET
FOX-M HALL BEACH

DEW LINE CLEAN UP

© COPYRIGHT
HER MAJESTY THE QUEEN IN RIGHT OF
CANADA 2011, AS REPRESENTED BY THE
MINISTER OF NATIONAL DEFENCE.

TRADE - METIER SITING DATE 2011-03-03

SUBJECT - SUJET

**EAST BEACH LANDFILLS
CROSS SECTIONS**

PRODUCTION	CONCURRENCE - ASSENTMENT
DESIGNED ETUDIE RRM	DES OFF AGENT CONCEPT
DRAWN DESSINE AC	SECT HD CHEF SECT
CHECKED VERIFIE BWH	DES MGR GEST CONCEPT
COORDINATION DTM	REVIEWED - REVU

DWG. NO. - DESSIN NO.
H-H11/2-9101-116

TIER II DISPOSAL FACILITY MONITORING WELLS (AS-BUILT)			
NO.	UTM COORDINATES		ELEV.
	NORTHING	EASTING	
MW-01	7 626 861.7	490 943.6	1.8
MW-02	7 626 911.8	491 156.2	0.4
MW-03	7 626 757.4	491 132.6	-0.5
MW-04	7 626 622.0	490 996.7	0.2
MW-05	7 626 715.5	490 897.5	0.6

NOTE: FOR MONITORING WELL LOCATIONS,
SEE DWG. H-H11/2-9101-106.

NON-HAZARDOUS WASTE LANDFILL MONITORING WELLS (AS-BUILT)			
NO.	UTM COORDINATES		ELEV.
	NORTHING	EASTING	
MW-12	7 628 012.9	491 158.5	2.4
MW-13	7 627 970.1	491 073.0	3.1
MW-14	7 627 984.7	490 927.2	4.4
MW-15	7 628 056.6	490 997.8	2.7
MW-16	7 628 035.1	490 841.6	4.7

NOTE: FOR MONITORING WELL LOCATIONS,
SEE DWG. H-H11/2-9101-103.


EAST BEACH LANDFILLS MONITORING WELLS (AS-BUILT)			
NO.	UTM COORDINATES		ELEV.
	NORTHING	EASTING	
MW-20	7 627 347.8	491 660.5	0.0
MW-21	7 627 249.3	491 604.4	-0.1
MW-22	7 627 041.6	491 596.1	-0.5
* MW-23	-	-	-
MW-24	7 626 835.4	491 488.8	0.0
MW-25	7 626 724.5	491 371.8	0.2
MW-26	7 626 592.2	491 232.3	0.6
MW-27	7 626 450.3	491 080.3	-0.1
MW-28	7 626 407.7	490 923.9	-0.4
MW-29	7 626 558.2	490 985.7	0.0
MW-30	7 626 675.1	491 234.0	-1.0
MW-31	7 626 935.6	491 511.6	-0.2

NOTE: FOR MONITORING WELL LOCATIONS,
SEE DWG. H-H11/2-9101-115.

* NO AS-BUILT SURVEY INFORMATION.

LANDFARM MONITORING WELLS REMOVED			
NO.	UTM COORDINATES		ELEV.
	NORTHING	EASTING	
MW-06	7 627 173.3	491 044.8	
MW-07	7 627 175.4	491 239.9	
MW-08	7 627 316.5	491 346.0	
MW-09	7 627 475.3	491 253.4	
MW-10	7 627 619.5	491 047.7	
MW-11	7 627 375.9	490 925.9	

NOTE:
22 MONITORING WELLS INSTALLED.
6 MONITORING WELLS REMOVED.

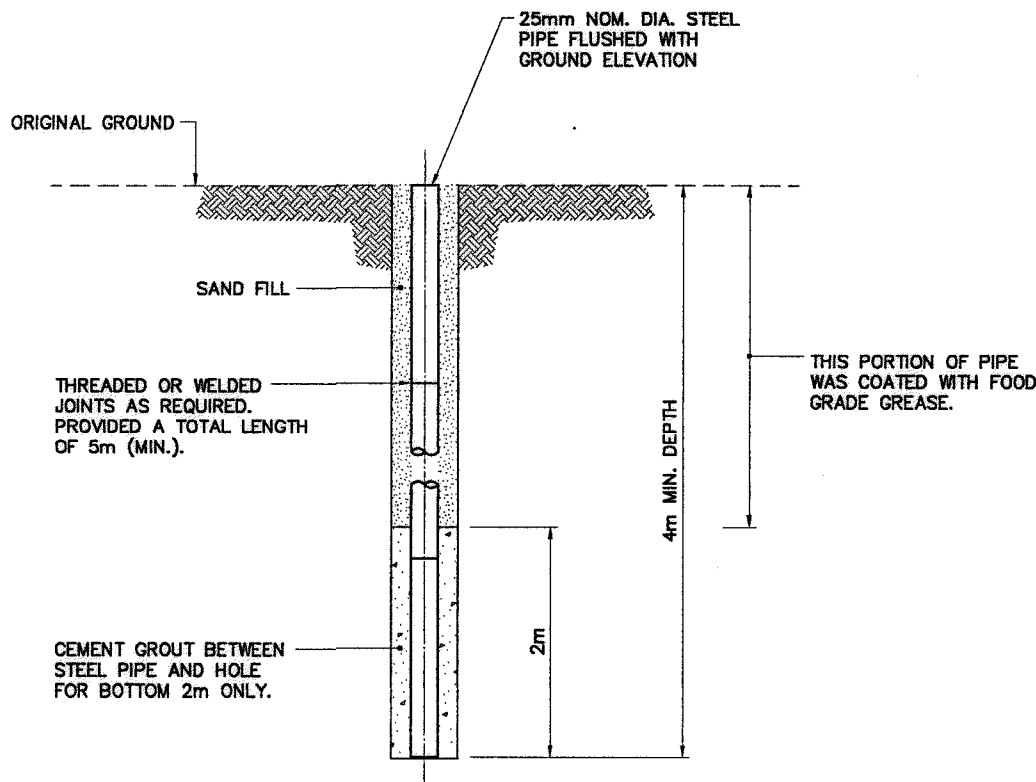


MIN. EMBEDMENT WAS REDUCED IF ROCK
WAS ENCOUNTERED. INSTALLATION WAS
PENETRATED 2m (MIN.) INTO ROCK.

NOTE:
6 PERMANENT SURVEY CONTROL
MONUMENTS INSTALLED.

TYPICAL PERMANENT SURVEY CONTROL MONUMENT

SCALE: NTS
ALSO CALLED PERMANENT BENCHMARK

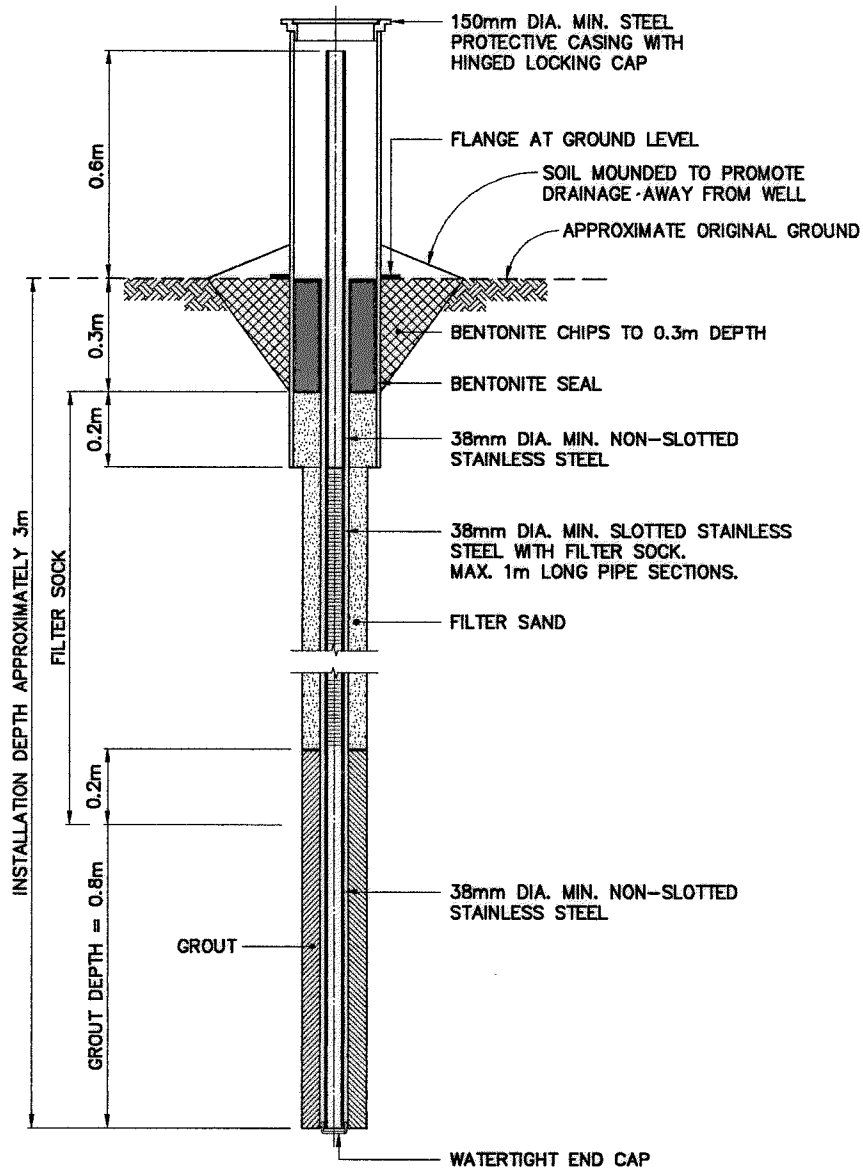

TYPICAL MONITORING WELL


SCALE: NTS
ALSO, TYPICAL BACKGROUND MONITORING WELL INSTALLATION

Headquarters Quartier général																																																			
General Notes: 1. ALL COORDINATES ARE REFERENCED TO NAD83 (CSRS), UTM ZONE 17. ALL ELEVATIONS REFER TO GEODETIC DATUM. 2. ALL DIMENSIONS ARE IN METRES UNLESS NOTED OTHERWISE.																																																			
<table border="1"> <tr> <td>0</td> <td>11-03-03</td> <td>AS-BUILT DRAWING</td> <td>RRM</td> </tr> <tr> <td>No.</td> <td>DATE</td> <td>REVISION</td> <td>REVISION</td> </tr> <tr> <td colspan="2"> </td> <td colspan="2"> PERMIT TO PRACTICE AECOM Canada Ltd. Signature: Date: PERMIT NUMBER: P639 NW/NU Association of Professional Engineers and Geoscientists </td> </tr> <tr> <td colspan="2"> AECOM </td> <td colspan="2"> HATCH </td> </tr> <tr> <td colspan="4"> SCALE - ECHELLE AS SHOWN </td> </tr> <tr> <td colspan="4"> PROJECT - PROJET FOX-M HALL BEACH </td> </tr> <tr> <td colspan="4"> DEW LINE CLEAN UP © COPYRIGHT HER MAJESTY THE QUEEN IN RIGHT OF CANADA 2011, AS REPRESENTED BY THE MINISTER OF NATIONAL DEFENCE. </td> </tr> <tr> <td colspan="2"> TRADE - METIER SITING </td> <td colspan="2"> DATE 2011-03-03 </td> </tr> <tr> <td colspan="4"> SUBJECT - SUJET MISCELLANEOUS DETAILS </td> </tr> <tr> <td colspan="2"> PRODUCTION DESIGNED ETUDIE DRAWN DESSINE CHECKED VERIFIE COORDINATION </td> <td colspan="2"> CONCURRENCE - ASSENTIMENT DES OFF AGENT CONCEPT SECT HD CHIEF SECT DES MGR GEST CONCEPT REVIEWED - REVU </td> </tr> <tr> <td colspan="4"> DWG. NO. - DESSIN NO. H-H11/2-9101-117 </td> </tr> <tr> <td colspan="4"> </td> </tr> </table>				0	11-03-03	AS-BUILT DRAWING	RRM	No.	DATE	REVISION	REVISION			PERMIT TO PRACTICE AECOM Canada Ltd. Signature: Date: PERMIT NUMBER: P639 NW/NU Association of Professional Engineers and Geoscientists		AECOM		HATCH		SCALE - ECHELLE AS SHOWN				PROJECT - PROJET FOX-M HALL BEACH				DEW LINE CLEAN UP © COPYRIGHT HER MAJESTY THE QUEEN IN RIGHT OF CANADA 2011, AS REPRESENTED BY THE MINISTER OF NATIONAL DEFENCE.				TRADE - METIER SITING		DATE 2011-03-03		SUBJECT - SUJET MISCELLANEOUS DETAILS				PRODUCTION DESIGNED ETUDIE DRAWN DESSINE CHECKED VERIFIE COORDINATION		CONCURRENCE - ASSENTIMENT DES OFF AGENT CONCEPT SECT HD CHIEF SECT DES MGR GEST CONCEPT REVIEWED - REVU		DWG. NO. - DESSIN NO. H-H11/2-9101-117							
0	11-03-03	AS-BUILT DRAWING	RRM																																																
No.	DATE	REVISION	REVISION																																																
		PERMIT TO PRACTICE AECOM Canada Ltd. Signature: Date: PERMIT NUMBER: P639 NW/NU Association of Professional Engineers and Geoscientists																																																	
AECOM		HATCH																																																	
SCALE - ECHELLE AS SHOWN																																																			
PROJECT - PROJET FOX-M HALL BEACH																																																			
DEW LINE CLEAN UP © COPYRIGHT HER MAJESTY THE QUEEN IN RIGHT OF CANADA 2011, AS REPRESENTED BY THE MINISTER OF NATIONAL DEFENCE.																																																			
TRADE - METIER SITING		DATE 2011-03-03																																																	
SUBJECT - SUJET MISCELLANEOUS DETAILS																																																			
PRODUCTION DESIGNED ETUDIE DRAWN DESSINE CHECKED VERIFIE COORDINATION		CONCURRENCE - ASSENTIMENT DES OFF AGENT CONCEPT SECT HD CHIEF SECT DES MGR GEST CONCEPT REVIEWED - REVU																																																	
DWG. NO. - DESSIN NO. H-H11/2-9101-117																																																			

General Notes:

1. ALL DIMENSIONS ARE IN METRES UNLESS NOTED OTHERWISE.
2. FILLED AROUND CASING AND MOUNDED TO PROMOTE DRAINAGE AWAY FROM INSTRUMENT.

0	11-03-03	AS-BUILT DRAWING	RRM
No.	DATE	REVISION	REVISION
			APPR.

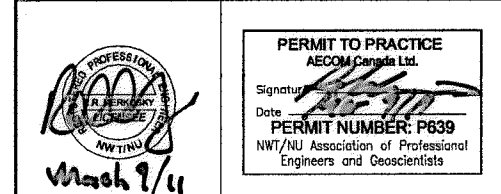

AECOM HATCH

SCALE - ECHELLE AS SHOWN

PROJECT - PROJET
FOX-M HALL BEACH

DEW LINE CLEAN UP
© COPYRIGHT
HER MAJESTY THE QUEEN IN RIGHT OF
CANADA 2011, AS REPRESENTED BY THE
MINISTER OF NATIONAL DEFENCE.

TRADE - METIER SITING DATE
2011-03-03


SUBJECT - SUJET

MISCELLANEOUS DETAILS


DESIGNED ETUDIE	RRM	DES OFF AGENT CONCEPT
DRAWN DESSINE	IC	SECT HD CHEF SECT
CHECKED VERIFIE	BNH	DES MGR GEST CONCEPT
COORDINATION DTM		REVIEWED - REVU

DWG. NO. - DESSIN NO.
H-H11/2-9101-118


Canada

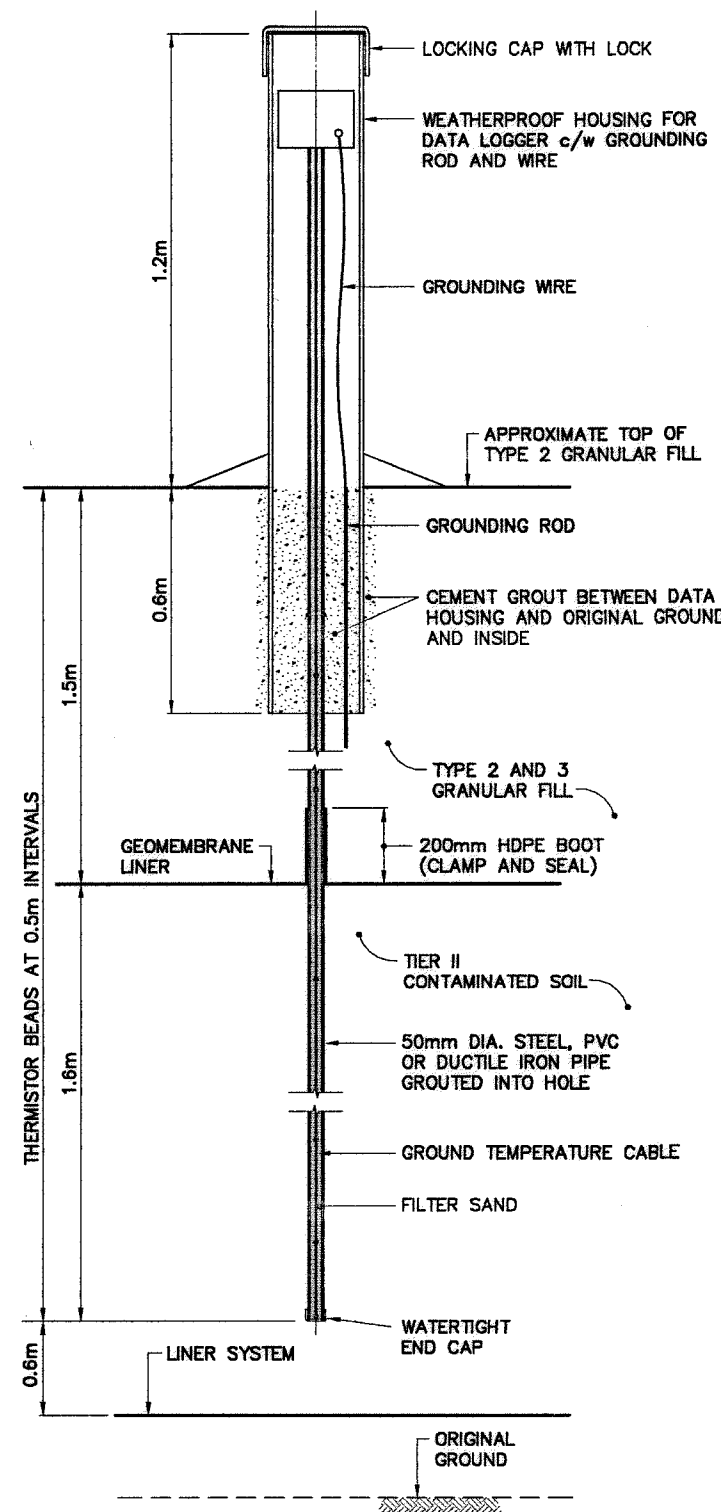

GROUND TEMPERATURE CABLE
SCALE: NTS
TIER II DISPOSAL FACILITY, VT-2,4,5

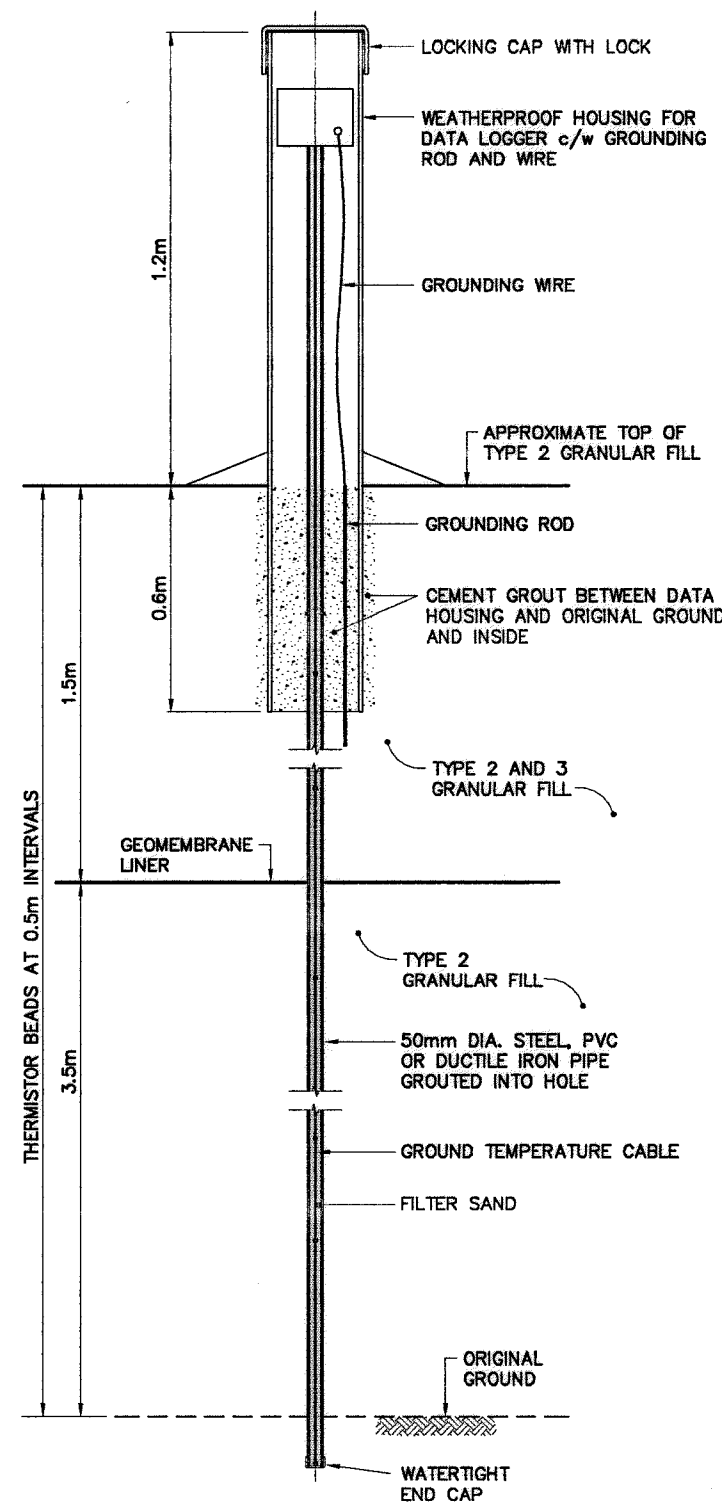

GROUND TEMPERATURE CABLE
SCALE: NTS
TIER II DISPOSAL FACILITY, VT-1,3

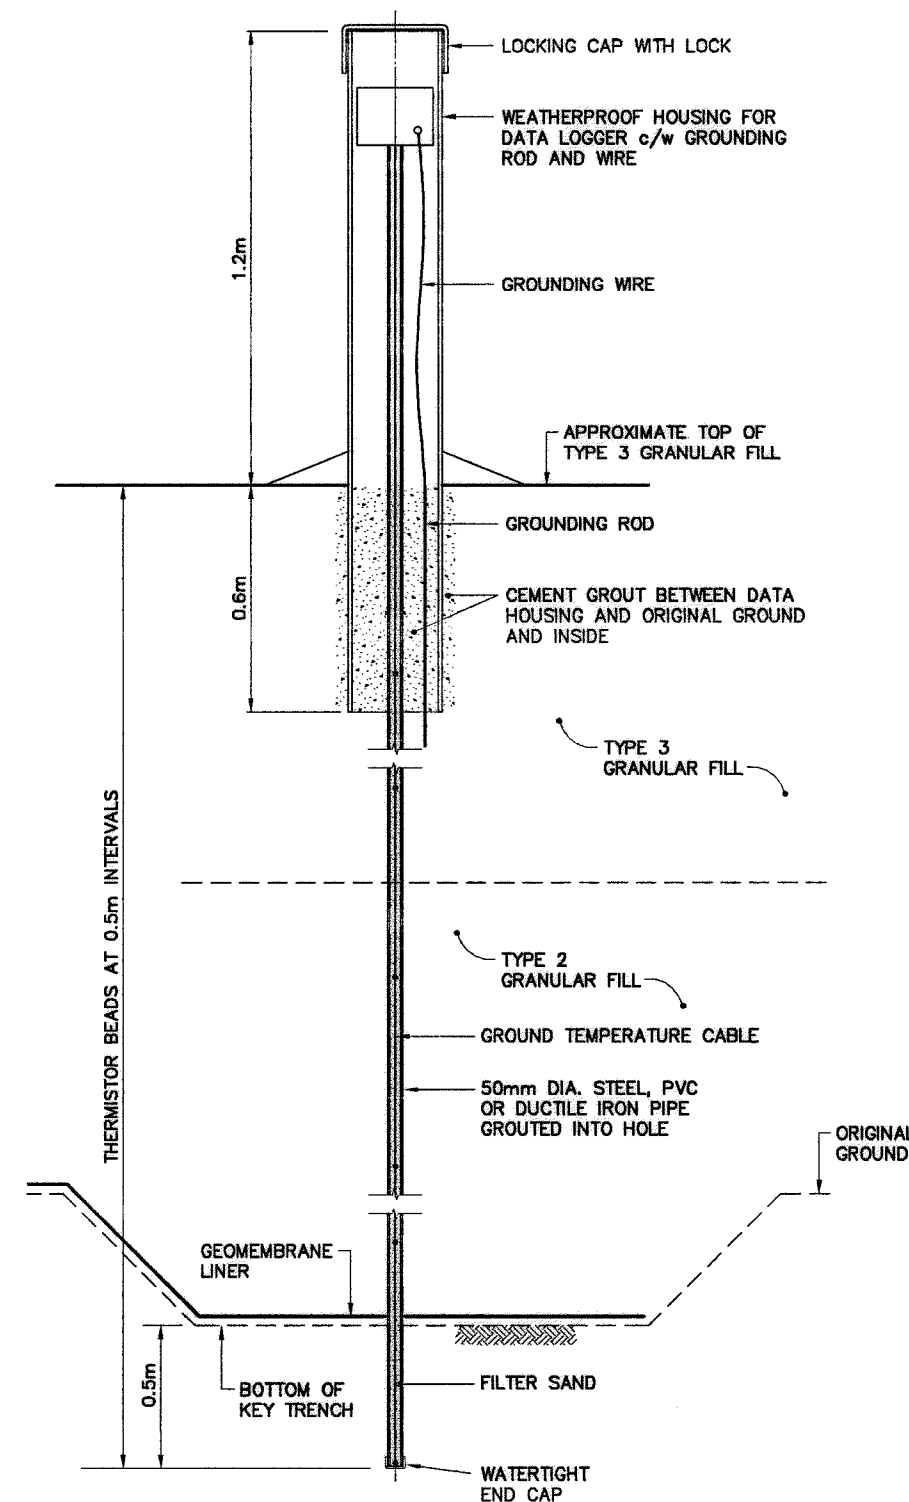

GROUND TEMPERATURE CABLE
SCALE: NTS
EAST BEACH LANDFILLS, VT-6 TO VT-11



National

Défense

Defence

natérale

Headquarters

Quartier général

General Notes:

1. ALL STRUCTURES DESIGNATED FOR DEMOLITION WERE DEMOLISHED TO TOP OF CONCRETE FOUNDATIONS UNLESS NOTED OTHERWISE.

2. ALL DIMENSIONS ARE IN METRES UNLESS NOTED OTHERWISE.

3. ALL LONG RANGE RADAR (LRR) FACILITIES WERE OPERATIONAL.

4. LOCATION OF POL LINES AND POWER/COMMUNICATION CABLES ARE APPROXIMATE ONLY.

Legend:

DEMOLISHED

C

CONCRETE PAD REMOVED

PP

UTILITY POLE REMOVED

BODY OF WATER

0

11-03-03

AS-BUILT DRAWING

RRM

No.

DATE

REVISION

REVISION

APPR.

PERMIT TO PRACTICE

AECOM Canada Ltd.

Signature

Date

PERMIT NUMBER: P639

NWT/NU Association of Professional Engineers and Geoscientists

AECOM

HATCH

SCALE - ECHELLE

20

10

0

20

40

60m

PROJECT - PROJET

FOX-M HALL BEACH

DEW LINE CLEAN UP

© COPYRIGHT

HER MAJESTY THE QUEEN IN RIGHT OF CANADA 2011, AS REPRESENTED BY THE MINISTER OF NATIONAL DEFENCE.

TRADE - MÉTIER

STRUCTURAL

DATE

2011-03-03

SUBJECT - SUJET

MAIN CAMP AREA

DEMOLITION SITE PLAN

PRODUCTION

CONCURRENCE - ASSESSMENT

DESIGNED

ETUDIE

RRM

DES OFF

AGENT CONCEPT

DRAWN

DESSINE

IC

SECT HD

CHEF SECT

CHECKED

VERIFIE

BNH

DES MGR

GEST CONCEPT

COORDINATION


DTM

REVIEWED - REVU


DWG. NO. - DESSIN NO.

H-H11/2-9101-201


Canada

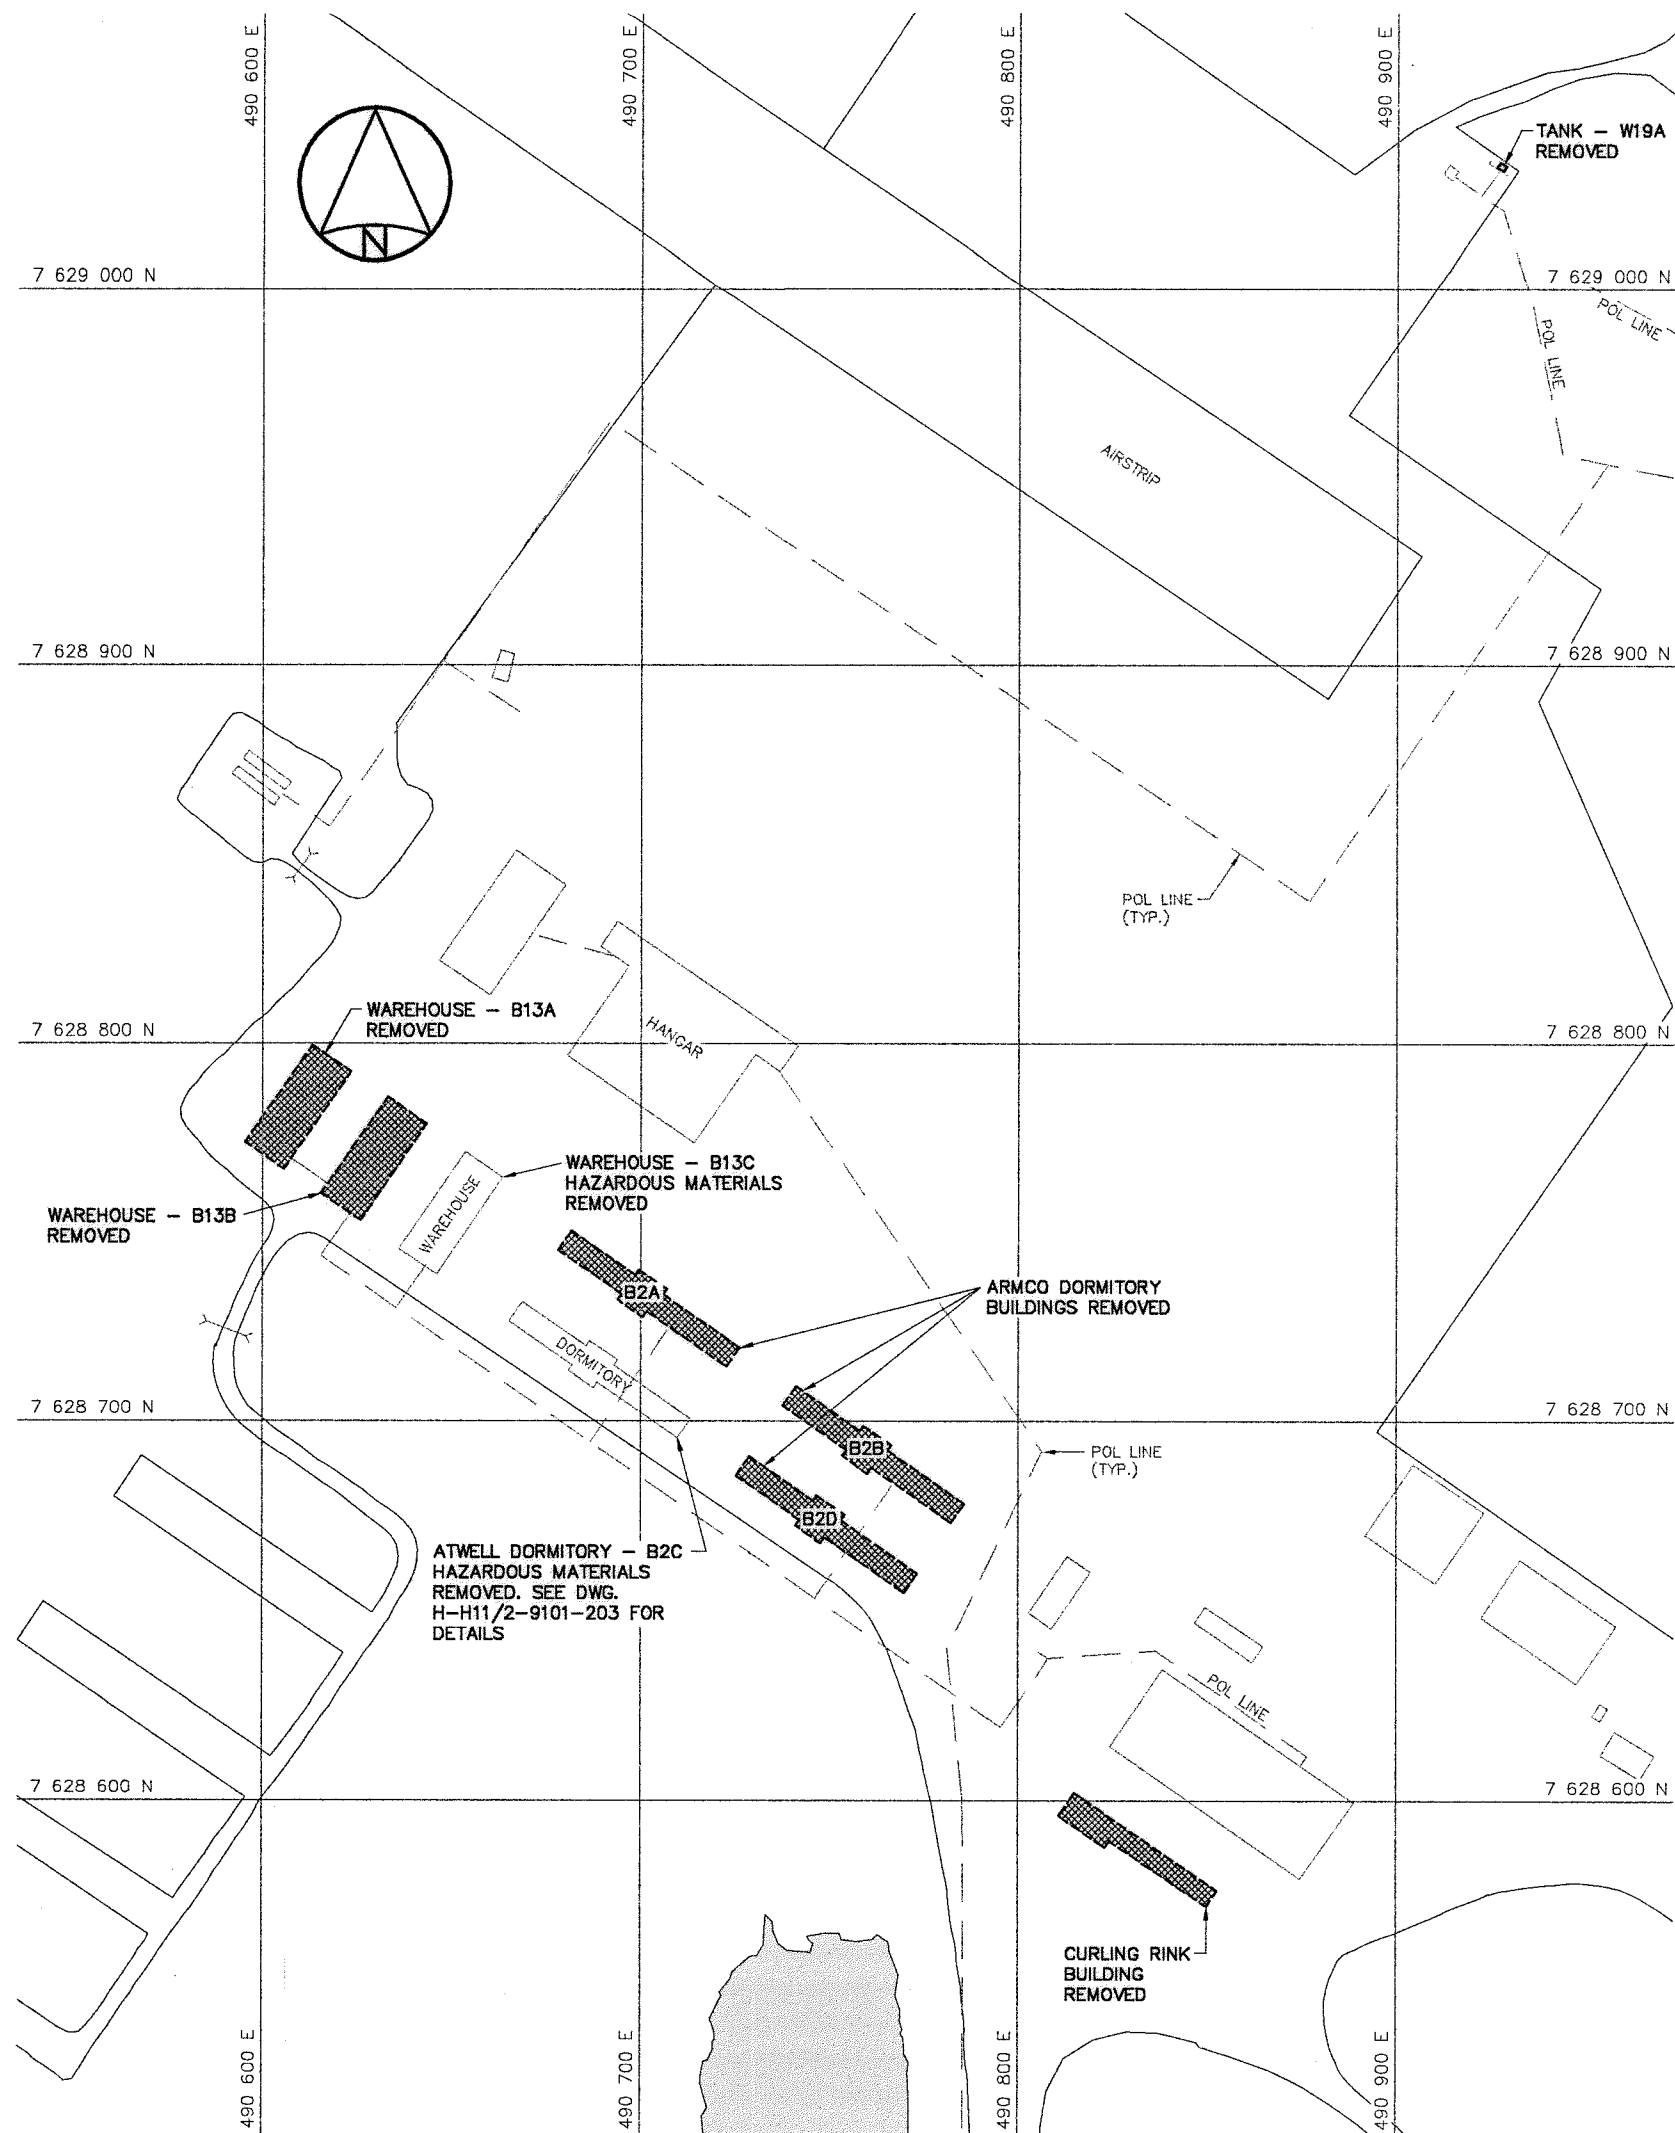

AIRSTrip AREA

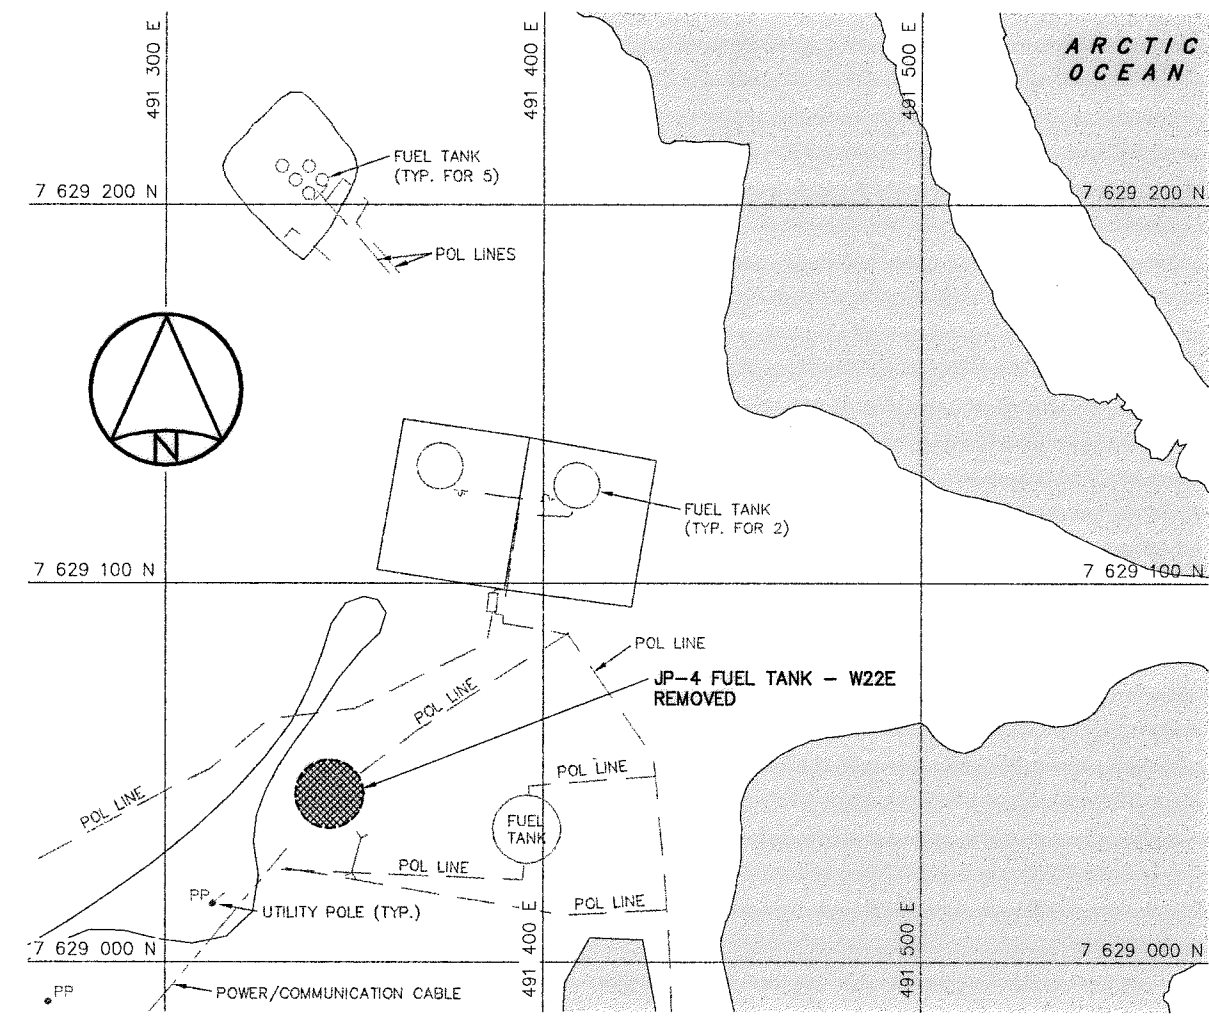

NORTH BEACH AREA

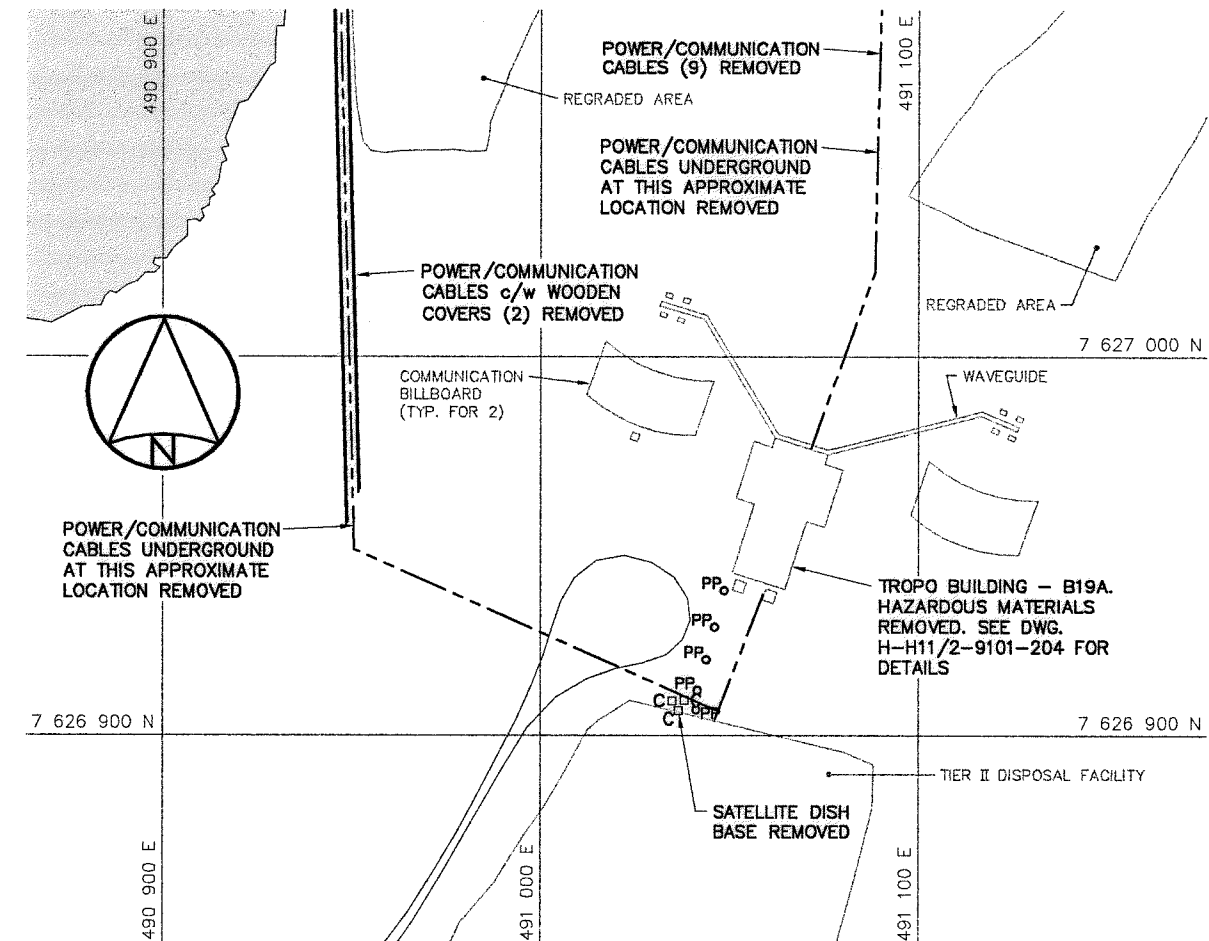

COMMUNICATIONS AREA

Headquarters
Quartier général

General Notes:

1. ALL STRUCTURES DESIGNATED FOR DEMOLITION WERE DEMOLISHED TO TOP OF CONCRETE FOUNDATIONS UNLESS NOTED OTHERWISE.
2. ALL DIMENSIONS ARE IN METRES UNLESS NOTED OTHERWISE.
3. ALL LONG RANGE RADAR (LRR) FACILITIES WERE OPERATIONAL.
4. LOCATION OF POL LINES AND POWER/COMMUNICATION CABLES ARE APPROXIMATE ONLY.

Legend:

- DEMOLISHED
- CONCRETE PAD REMOVED
- UTILITY POLE REMOVED
- BODY OF WATER

0	11-03-03	AS-BUILT DRAWING	RRM
No.	DATE	REVISION	APPR.

PERMIT TO PRACTICE
AECOM Canada Ltd.
 Signature:
 Date:
PERMIT NUMBER: P839
NWIT/NU Association of Professional Engineers and Geoscientists

SCALE - ECHELLE 20 10 0 20 40 60m

PROJECT - PROJET
FOX-M HALL BEACH

DEW LINE CLEAN UP

© COPYRIGHT
HER MAJESTY THE QUEEN IN RIGHT OF CANADA 2011, AS REPRESENTED BY THE MINISTER OF NATIONAL DEFENCE.

TRADE - METIER STRUCTURAL	DATE 2011-03-03
-------------------------------------	---------------------------


SUBJECT - SUJET
AIRSTrip, NORTH BEACH AND COMMUNICATIONS AREAS DEMOLITION SITE PLANS

PRODUCTION	CONCURRENCE - ASSENTMENT
DESIGNED ETUDIE RRM	DES OFF AGENT CONCEPT
DRAWN DESSINE IC	SECT HD CHEF SECT
CHECKED VERIFIE BWH	DES MGR GEST CONCEPT
COORDINATION DTM	REVIEWED - REVU

DWG. NO. - DESSIN NO.
H-H11/2-9101-202


General Notes:

1. ALL DIMENSIONS ARE IN MILLIMETRES
UNLESS NOTED OTHERWISE.
2. LOOSE PCB AMENDED PAINT REMOVED
ON EXTERIOR/INTERIOR AND SURFACES
REPAINTED.

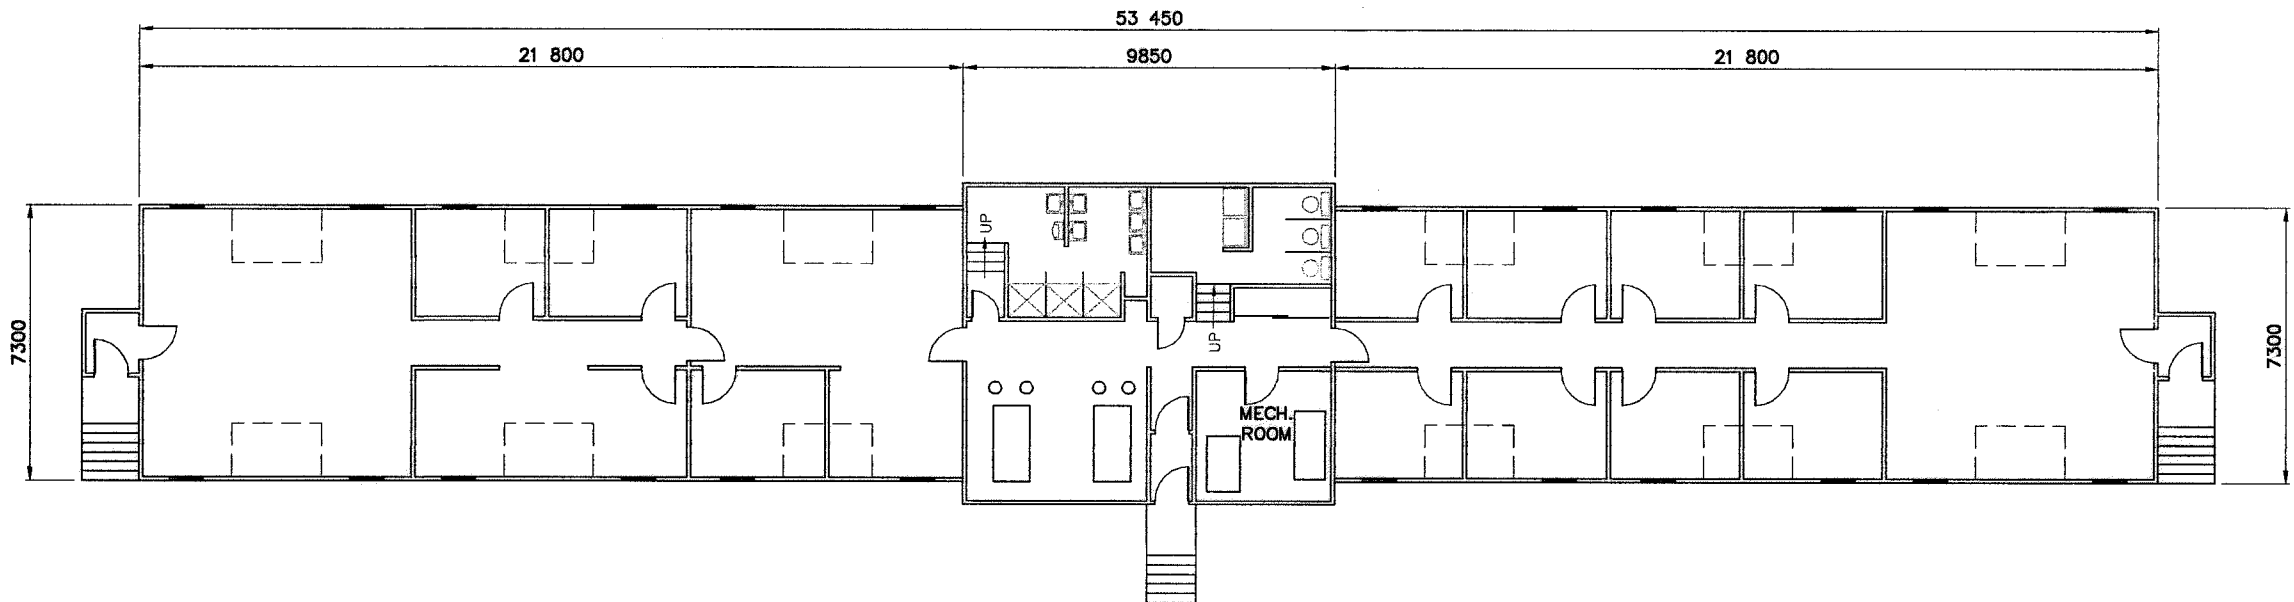


NWSO NUMBER	COMMENTS
B2C	REMOVED HAZARDOUS MATERIALS AND REFINISHED.

FLOOR PLAN

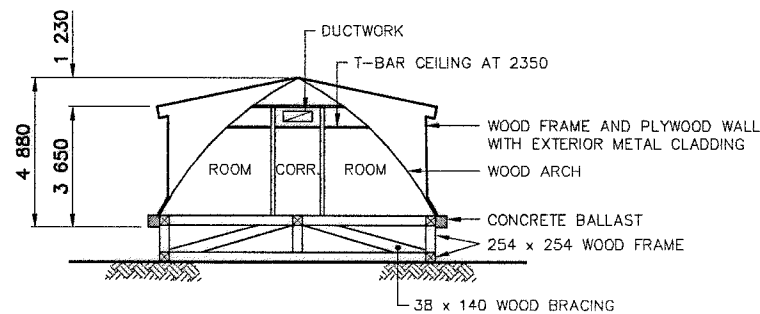

SECTION

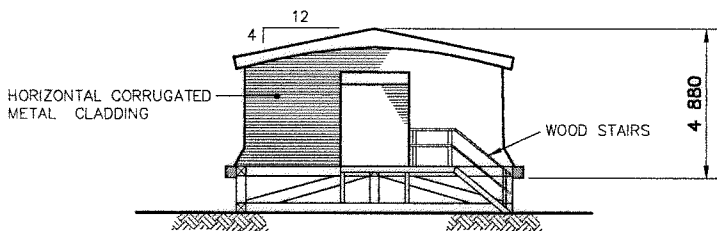

END ELEVATION

0	11-03-03	AS-BUILT DRAWING	RRM
No.	DATE	REVISION	REVISION
			APPR.



PERMIT TO PRACTICE
AECOM Canada Ltd.
Signature: [Signature]
Date: [Date]
PERMIT NUMBER: P-639
NW/NU Association of Professional
Engineers and Geoscientists

AECOM

HATCH

SCALE - ECHELLE 2 1 0 2 4 6m

PROJECT - PROJET
FOX-M HALL BEACH

DEW LINE CLEAN UP

© COPYRIGHT
HER MAJESTY THE QUEEN IN RIGHT OF
CANADA 2011, AS REPRESENTED BY THE
MINISTER OF NATIONAL DEFENCE.

TRADE - METIER STRUCTURAL DATE 2011-03-03


SUBJECT - SUJET

ATWELL DORMITORY
PLAN, SECTION, AND ELEVATION

PRODUCTION	CONCURRENCE - ASSENTIMENT
DESIGNED ETUDIE RRM	DES OFF AGENT CONCEPT
DRAWN DESSINE IC	SECT HD CHEF SECT
CHECKED VERIFIE DMH	DES MGR GEST CONCEPT
COORDINATION DTM	REVIEWED - REVU

DWG. NO. - DESSIN NO.
H-H11/2-9101-203


Canada

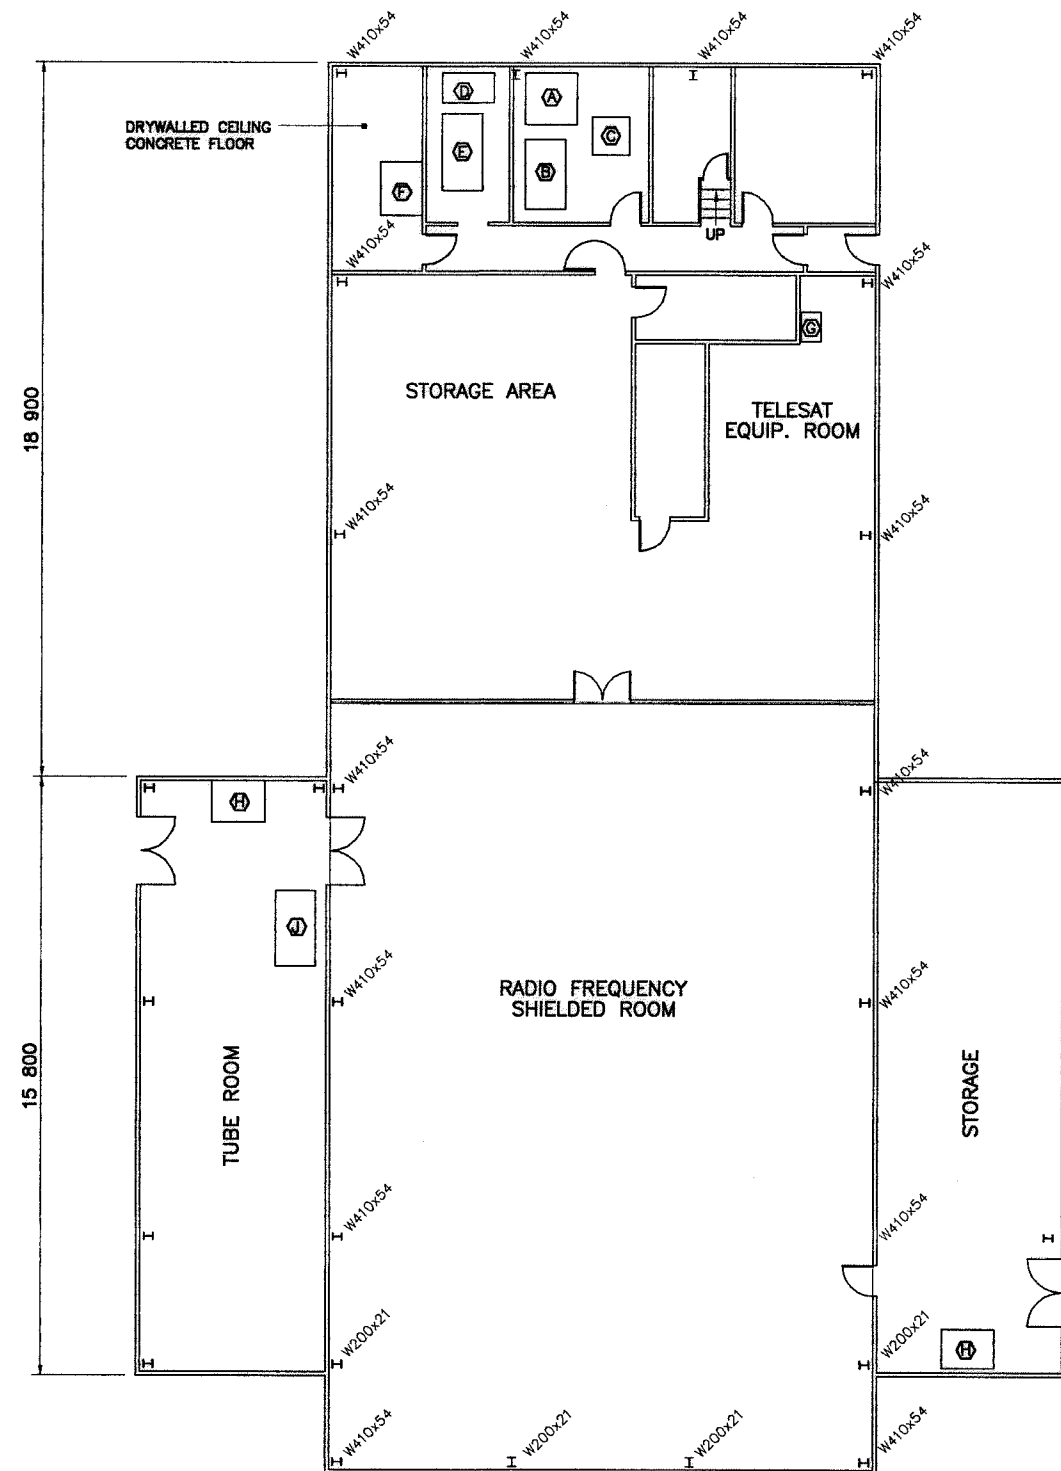

PLAN

EQUIPMENT LEGEND	
TAG	DESCRIPTION
A	2300 US Gal. SEWAGE TANK
B	2300 US Gal. WATER TANK
C	SEWAGE PUMPOUT TANK
D	275 US Gal. DIESEL FUEL TANK
E	250000 BTU/HR OIL BURNING FURNACE
F	TRANSFORMER "G.E." 1.4mx1.1mx2.3m HIGH
G	TRANSFORMER "HAMMOND" TYPE "F" 16KV, 91 lbs., CAT.# 115012
H	TRANSFORMER "G.E." DRY TYPE MODEL# 9T23Y3877, 1910 lbs.
I	CEILING MOUNTED FURNACE

NWSO NUMBER	COMMENTS
B19A	REMOVED HAZARDOUS MATERIALS AND REFINISHED.

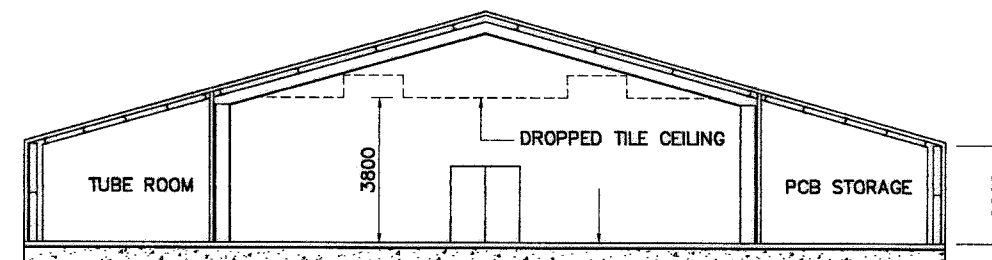

SECTION

General Notes:

1. ALL DIMENSIONS ARE IN MILLIMETRES UNLESS NOTED OTHERWISE.
2. LOOSE PCB AMENDED PAINT REMOVED ON EXTERIOR/INTERIOR AND SURFACES REPAINTED.

0	11-03-03	AS-BUILT DRAWING		RRM
No.	DATE	REVISION	REVISION	APPR



PERMIT TO PRACTICE
AECOM Canada Ltd.
Signature: [Signature]
Date: March 9/4
PERMIT NUMBER: P839
NW/NU Association of Professional Engineers and Geoscientists

AECOM

HATCH

SCALE - ECHELLE 2 1 0 2 4 6m

PROJECT - PROJET
FOX-M HALL BEACH

DEW LINE CLEAN UP

© COPYRIGHT
HER MAJESTY THE QUEEN IN RIGHT OF
CANADA 2011, AS REPRESENTED BY THE
MINISTER OF NATIONAL DEFENCE.

TRADE - METIER STRUCTURAL DATE 2011-03-03

SUBJECT - SUJET
TROPO BUILDING /
FACILITY CONTROL OFFICE
PLAN AND SECTION

PRODUCTION	CONCURRENCE - ASSENTIMENT
DESIGNED ETUDIE RRM	DES OFF AGENT CONCEPT
DRAWN DESSINE IC	SECT HD CHEF SECT
CHECKED VERIFIE BWH	DES MGR GEST CONCEPT
COORDINATION DTM	REVIEWED - REVU

DWG. NO. - DESSIN NO.
H-H11/2-9101-204