

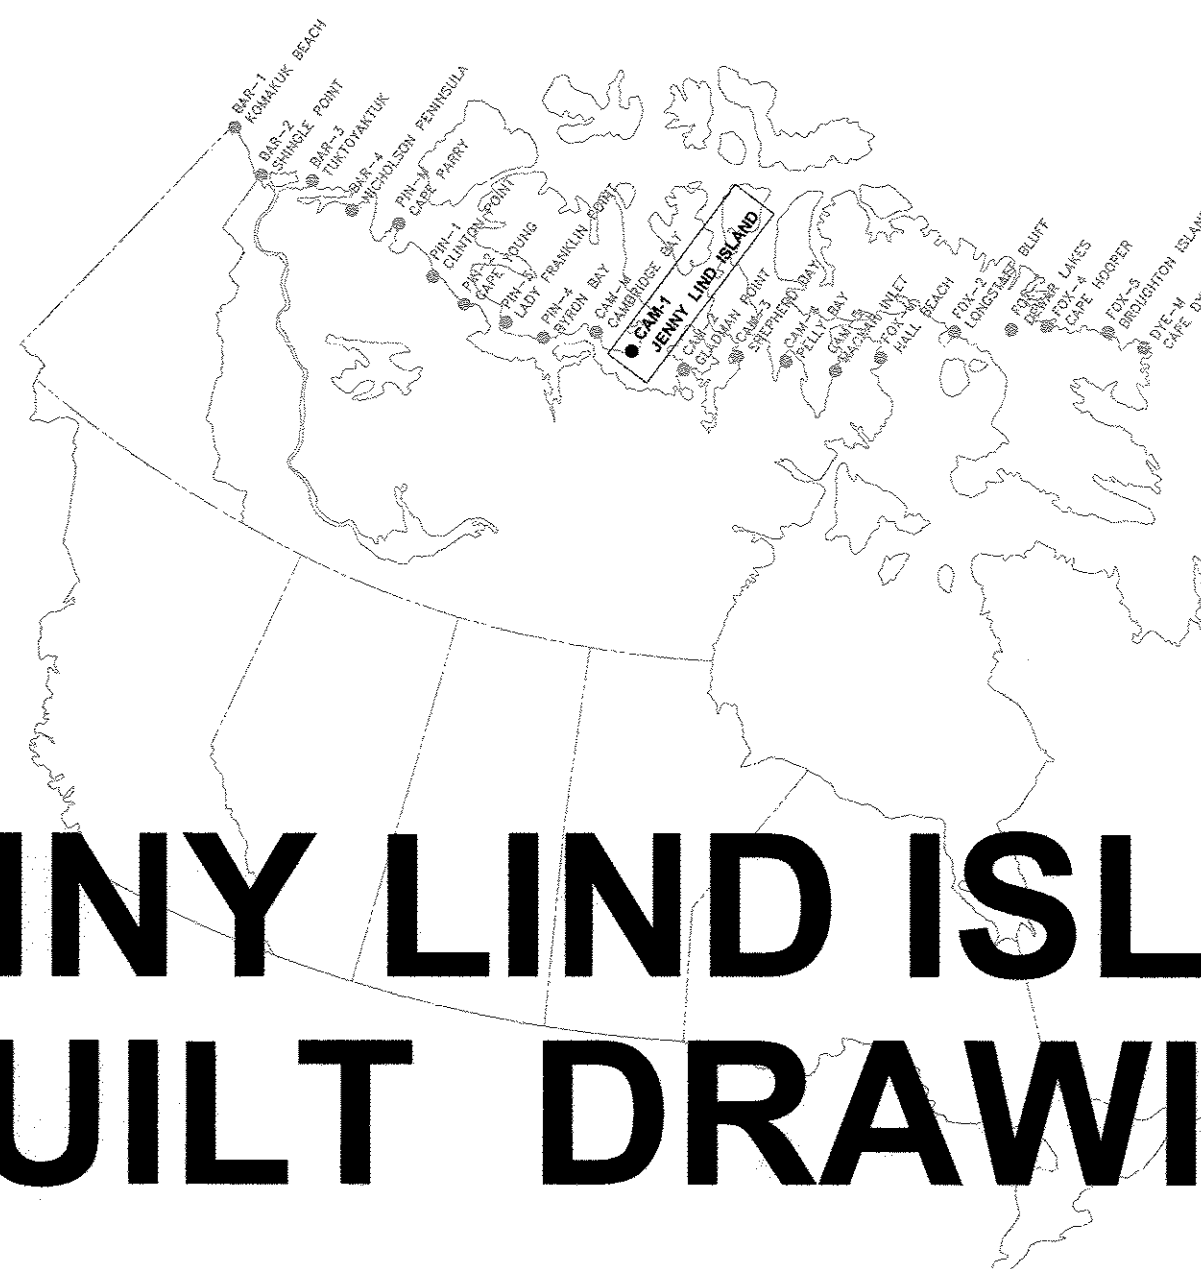


NOTE:
THIS DRAWING PACKAGE HAS BEEN
REVISED BASED ON INFORMATION
SUPPLIED BY DEFENCE CONSTRUCTION
CANADA IN 2009.
CONTRACT DRAWINGS INCLUDE THE
ENGINEER'S STAMP.

DRAWING INDEX							
DRAWING No.		TITLE		DRAWING No.		TITLE	
SITING		SITING		STRUCTURAL			
H-J44/1-9101-101	OVERALL SITE PLAN	H-J44/1-9101-112	NON-HAZARDOUS WASTE LANDFILL SECTION AND DETAIL	H-J44/1-9101-205	MODULE TRAIN UNITS 1A-25 PLAN		
H-J44/1-9101-102	PROJECT LAYOUT STATION AREA	H-J44/1-9101-113	TIER II DISPOSAL FACILITY KEY TRENCH EXCAVATION PLAN & GRADING/INSTRUMENTATION PLAN	H-J44/1-9101-206	MODULE TRAIN UNITS 1A-25 ELEVATIONS		
H-J44/1-9101-103	PROJECT LAYOUT AIRSTRIP AND BEACH AREA	H-J44/1-9101-114	TIER II DISPOSAL FACILITY CROSS SECTION AND DETAIL	H-J44/1-9101-207	RADAR TOWER/PADOME PLAN AND SECTION		
H-J44/1-9101-104	DEBRIS AREA 9 AND STATION AREA NORTH SITE PLANS	H-J44/1-9101-115	BEACH AREA EXCAVATION AND REGRADING PLAN	H-J44/1-9101-208	POL PUMPHOUSE AND GNL STORAGE SHED PLANS AND ELEVATIONS		
H-J44/1-9101-105	STATION AREA SITE PLAN	H-J44/1-9101-116	MISCELLANEOUS DETAILS SHEET 1	H-J44/1-9101-209	COMMUNICATION DISH ELEVATIONS		
H-J44/1-9101-106	STATION AREA EAST SITE PLAN	H-J44/1-9101-117	MISCELLANEOUS DETAILS SHEET 2	H-J44/1-9101-210	WATER AND FUEL TANKS PLAN AND ELEVATIONS		
H-J44/1-9101-107	STATION AREA SOUTH SITE PLAN	STRUCTURAL		H-J44/1-9101-211	AIRSTRIP ANCILLARY FACILITIES STANDARD DETAILS		
H-J44/1-9101-108	BEACH AREA SITE PLAN	H-J44/1-9101-201	STATION AREA DEMOLITION SITE PLAN	© COPYRIGHT HER MAJESTY THE QUEEN IN RIGHT OF CANADA 2012, AS REPRESENTED BY THE MINISTER OF NATIONAL DEFENCE.			
H-J44/1-9101-109	USAF LANDFILL AREA, AIRSTRIP AREAS AND EAST POINT AREA SITE PLANS	H-J44/1-9101-202	AIRSTRIP AREA AND BEACH AREA DEMOLITION SITE PLAN				
H-J44/1-9101-110	LANDFILL CROSS-SECTION AND DETAILS	H-J44/1-9101-203	WAREHOUSE PLAN, SECTION AND ELEVATION				
H-J44/1-9101-111	NON-HAZARDOUS WASTE LANDFILL PLANS AND SECTION	H-J44/1-9101-204	GARAGE PLAN AND SECTION				

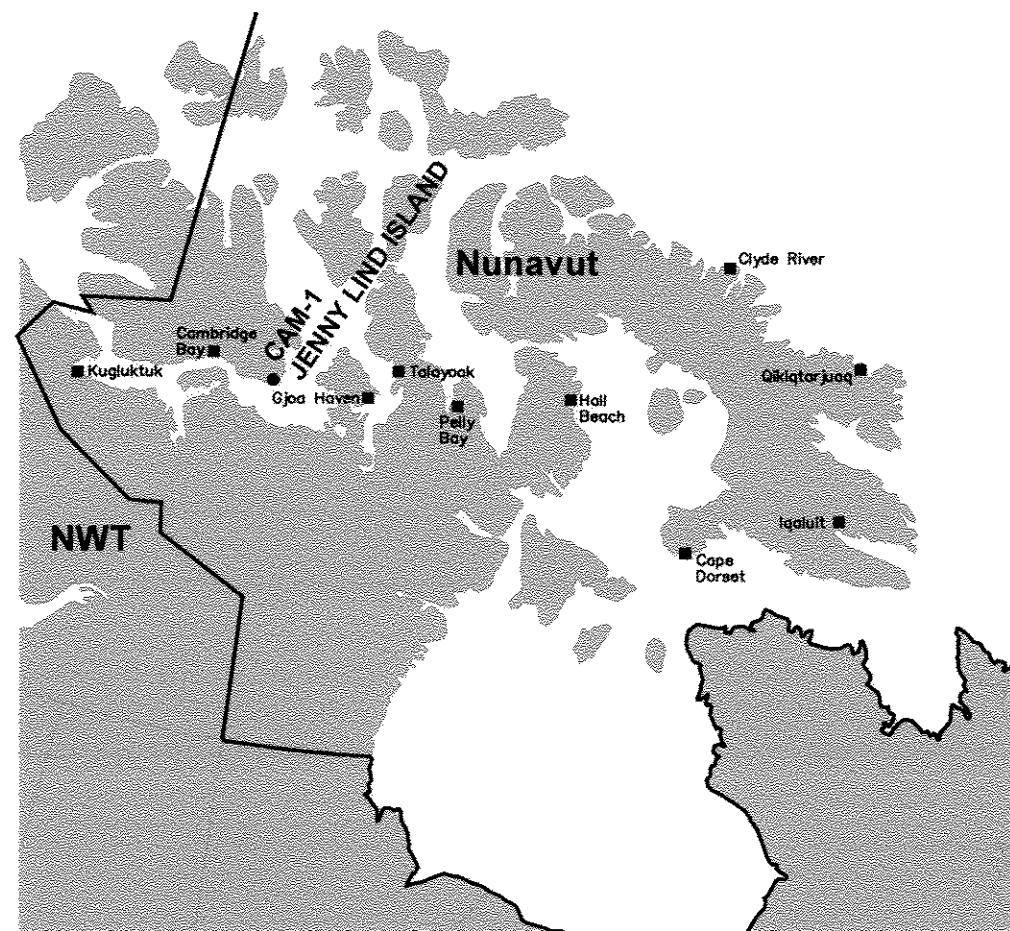

CAM-1 JENNY LIND ISLAND AS-BUILT DRAWINGS

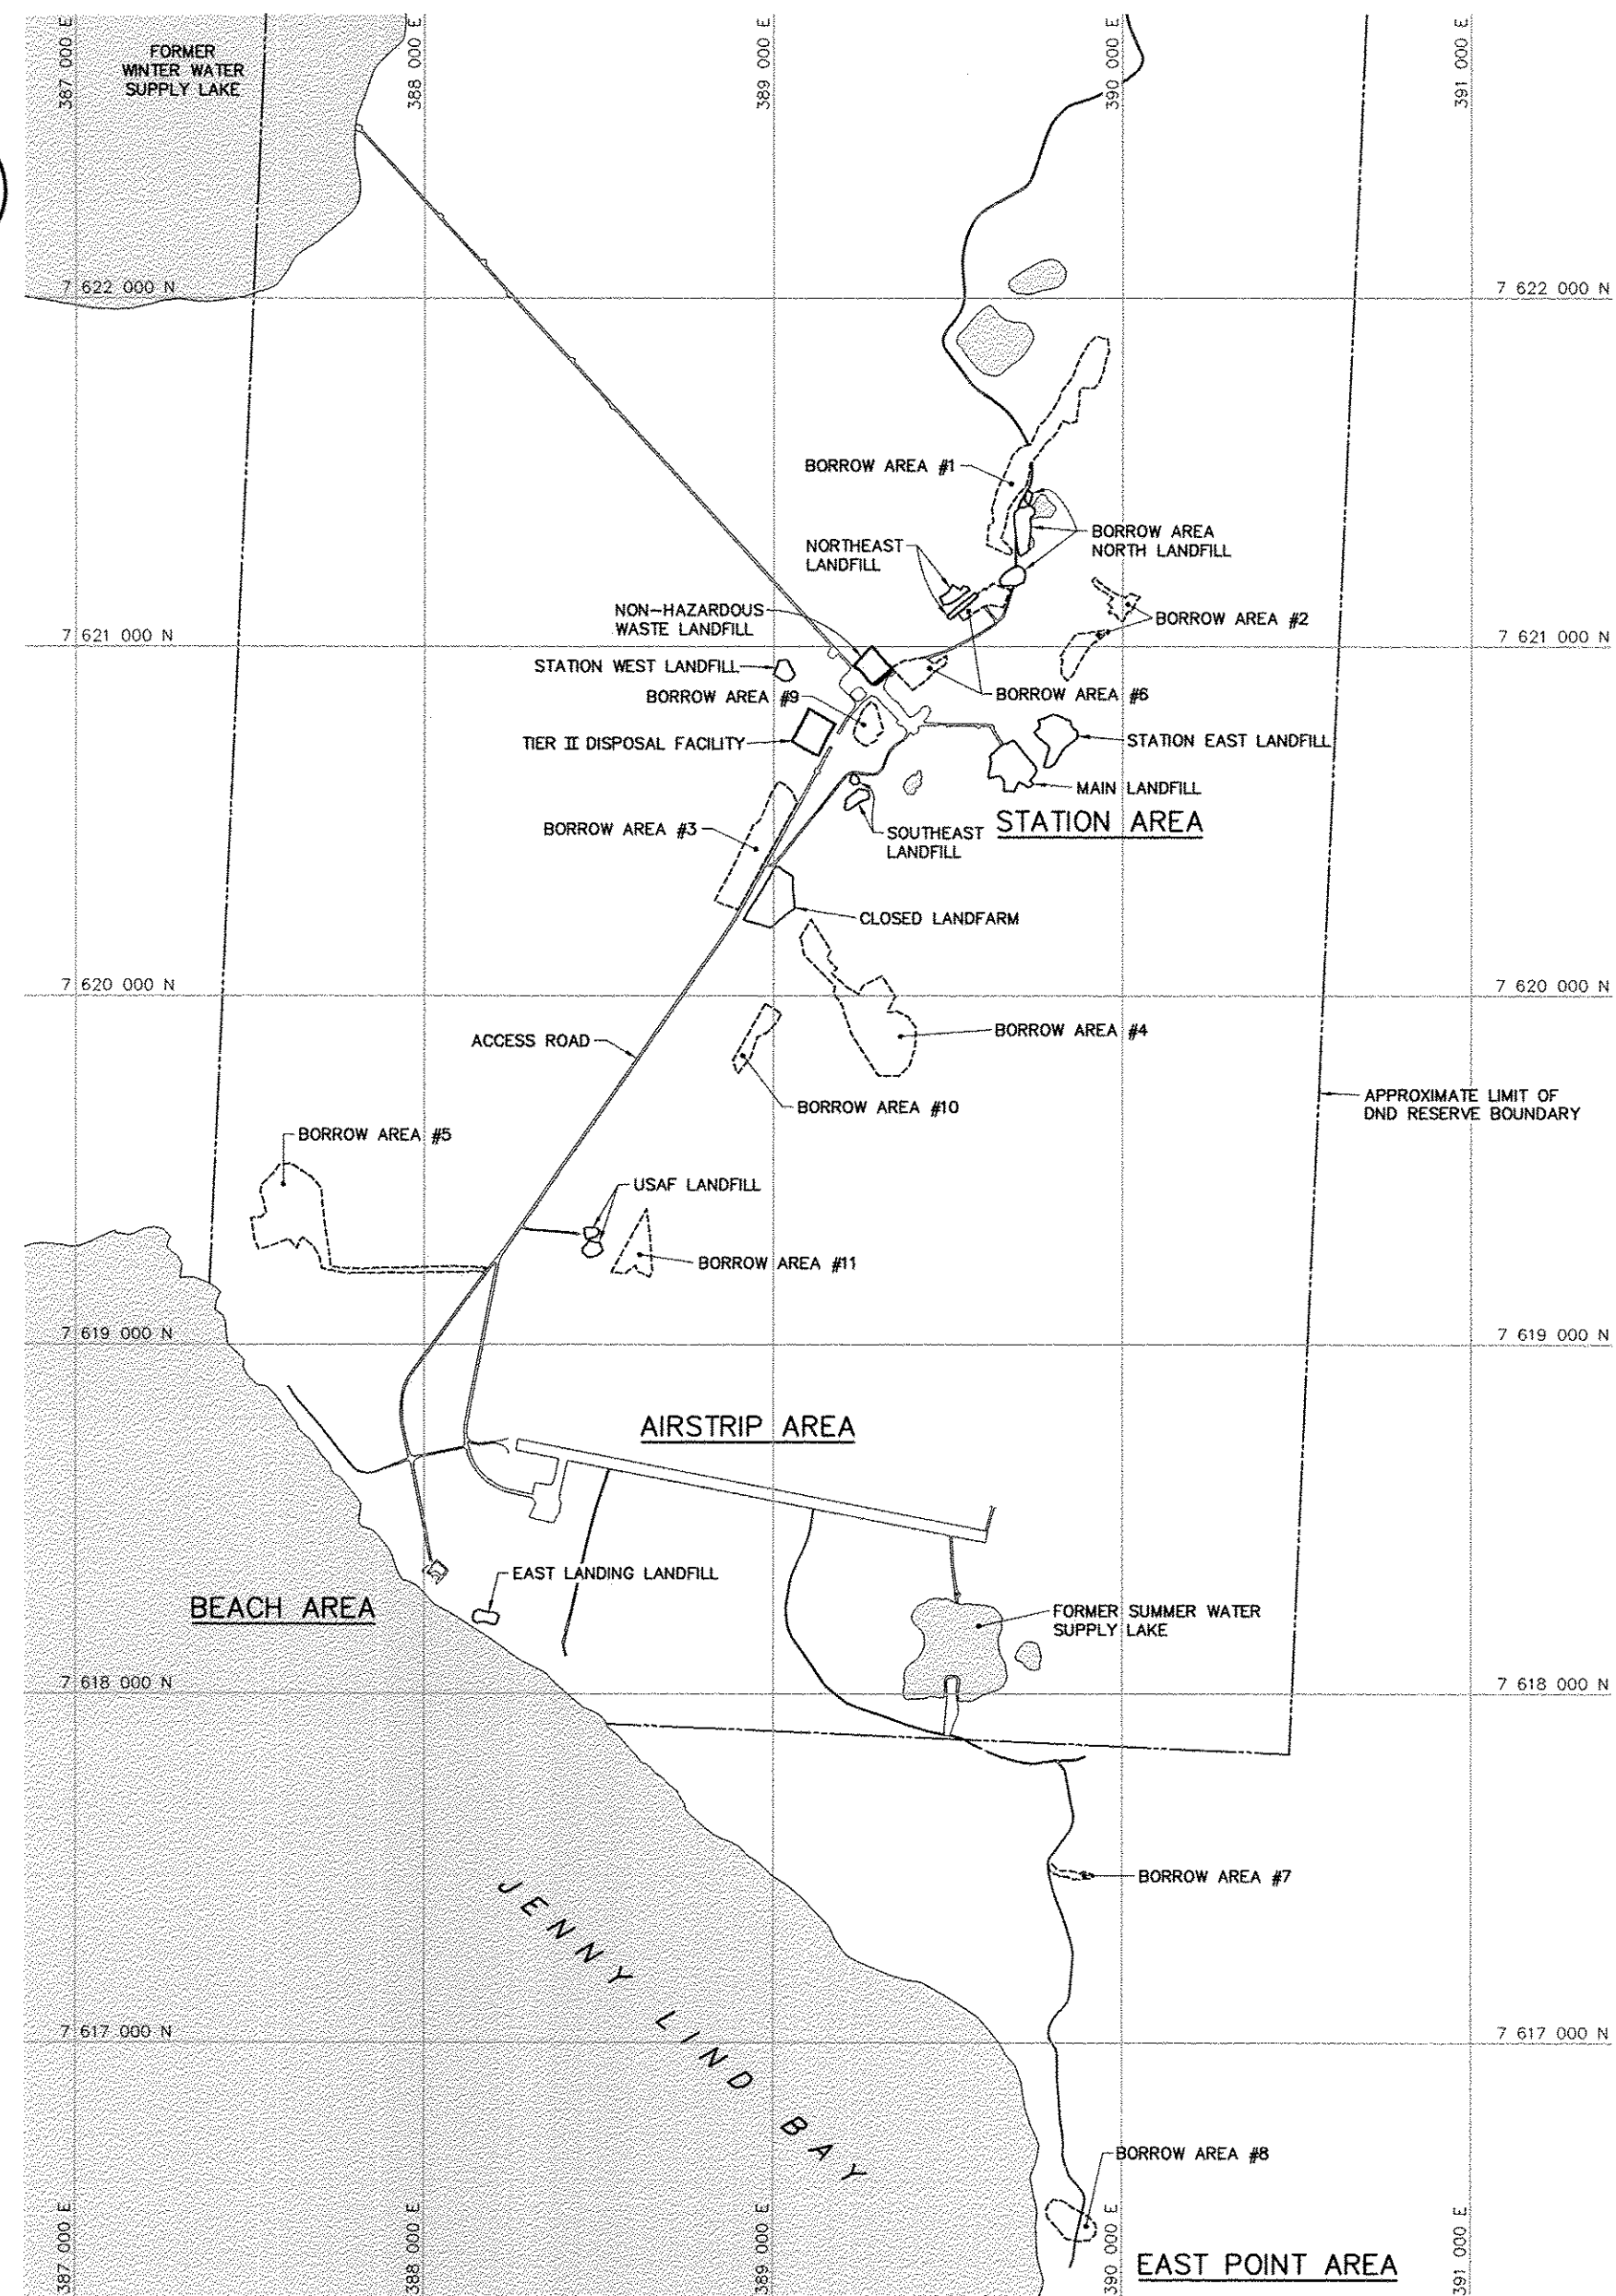

LOCATION OF JENNY LIND ISLAND WITHIN NUNAVUT TERRITORY

Headquarters
Quartier général

General Notes:

1. ALL COORDINATES ARE REFERENCED TO NAD83 (CSRS), UTM ZONE 14N. ALL ELEVATIONS REFER TO GEODETIC DATUM.
2. ALL DIMENSIONS ARE IN METRES UNLESS NOTED OTHERWISE.
3. ALL NON-HAZARDOUS DEBRIS REMOVED WITHIN THE PLAN AREA WAS PLACED IN THE NON-HAZARDOUS WASTE LANDFILL.

Legend:

- APPROXIMATE LOCATION OF
PROPERTY BOUNDARY
-  APPROXIMATE EXTENT OF
BORROW AREA
-  BODY OF WATER

0	12-07-16	AS-BUILT DRAWING		RRM
No.	DATE	REVISION	REVISION	APPRO



PERMIT TO PRACTICE
 AECOM Canada Ltd.
 Signature: *[Signature]*
 Date: *July 19/12*
 PERMIT NUMBER: P639
 NWT/NU Association of Professional
 Engineers and Geoscientists

SCALE - ECHELLE 200 100 0 200 400 600m

PROJECT - PROJCT
CAM-1 JENNY LIND ISLAND

DEW LINE CLEAN UP

© COPYRIGHT
HER MAJESTY THE QUEEN IN RIGHT OF
CANADA 2012, AS REPRESENTED BY THE
MINISTER OF NATIONAL DEFENCE.

TRADE - METIER	SITING	DATE
		2006-09-15


SUBJECT - SUJET

OVERALL SITE PLAN

PRODUCTION	CONCURRENCE - ASSENTIMENT	
DESIGNED ETUDE <i>ANP / RRM</i>		DES OFF AGENT CONCEPT
DRAWN DESSINE <i>LJP</i>		SECT HD CHEF SECT
CHECKED VERIFIE <i>KMS</i>		DES MGR GEST CONCEPT
COORDINATION <i>SMS</i>	REVIEWED - REVU	

DWG. NO. - DESSIN NO.
H-J44/1-9101-101

Canadă

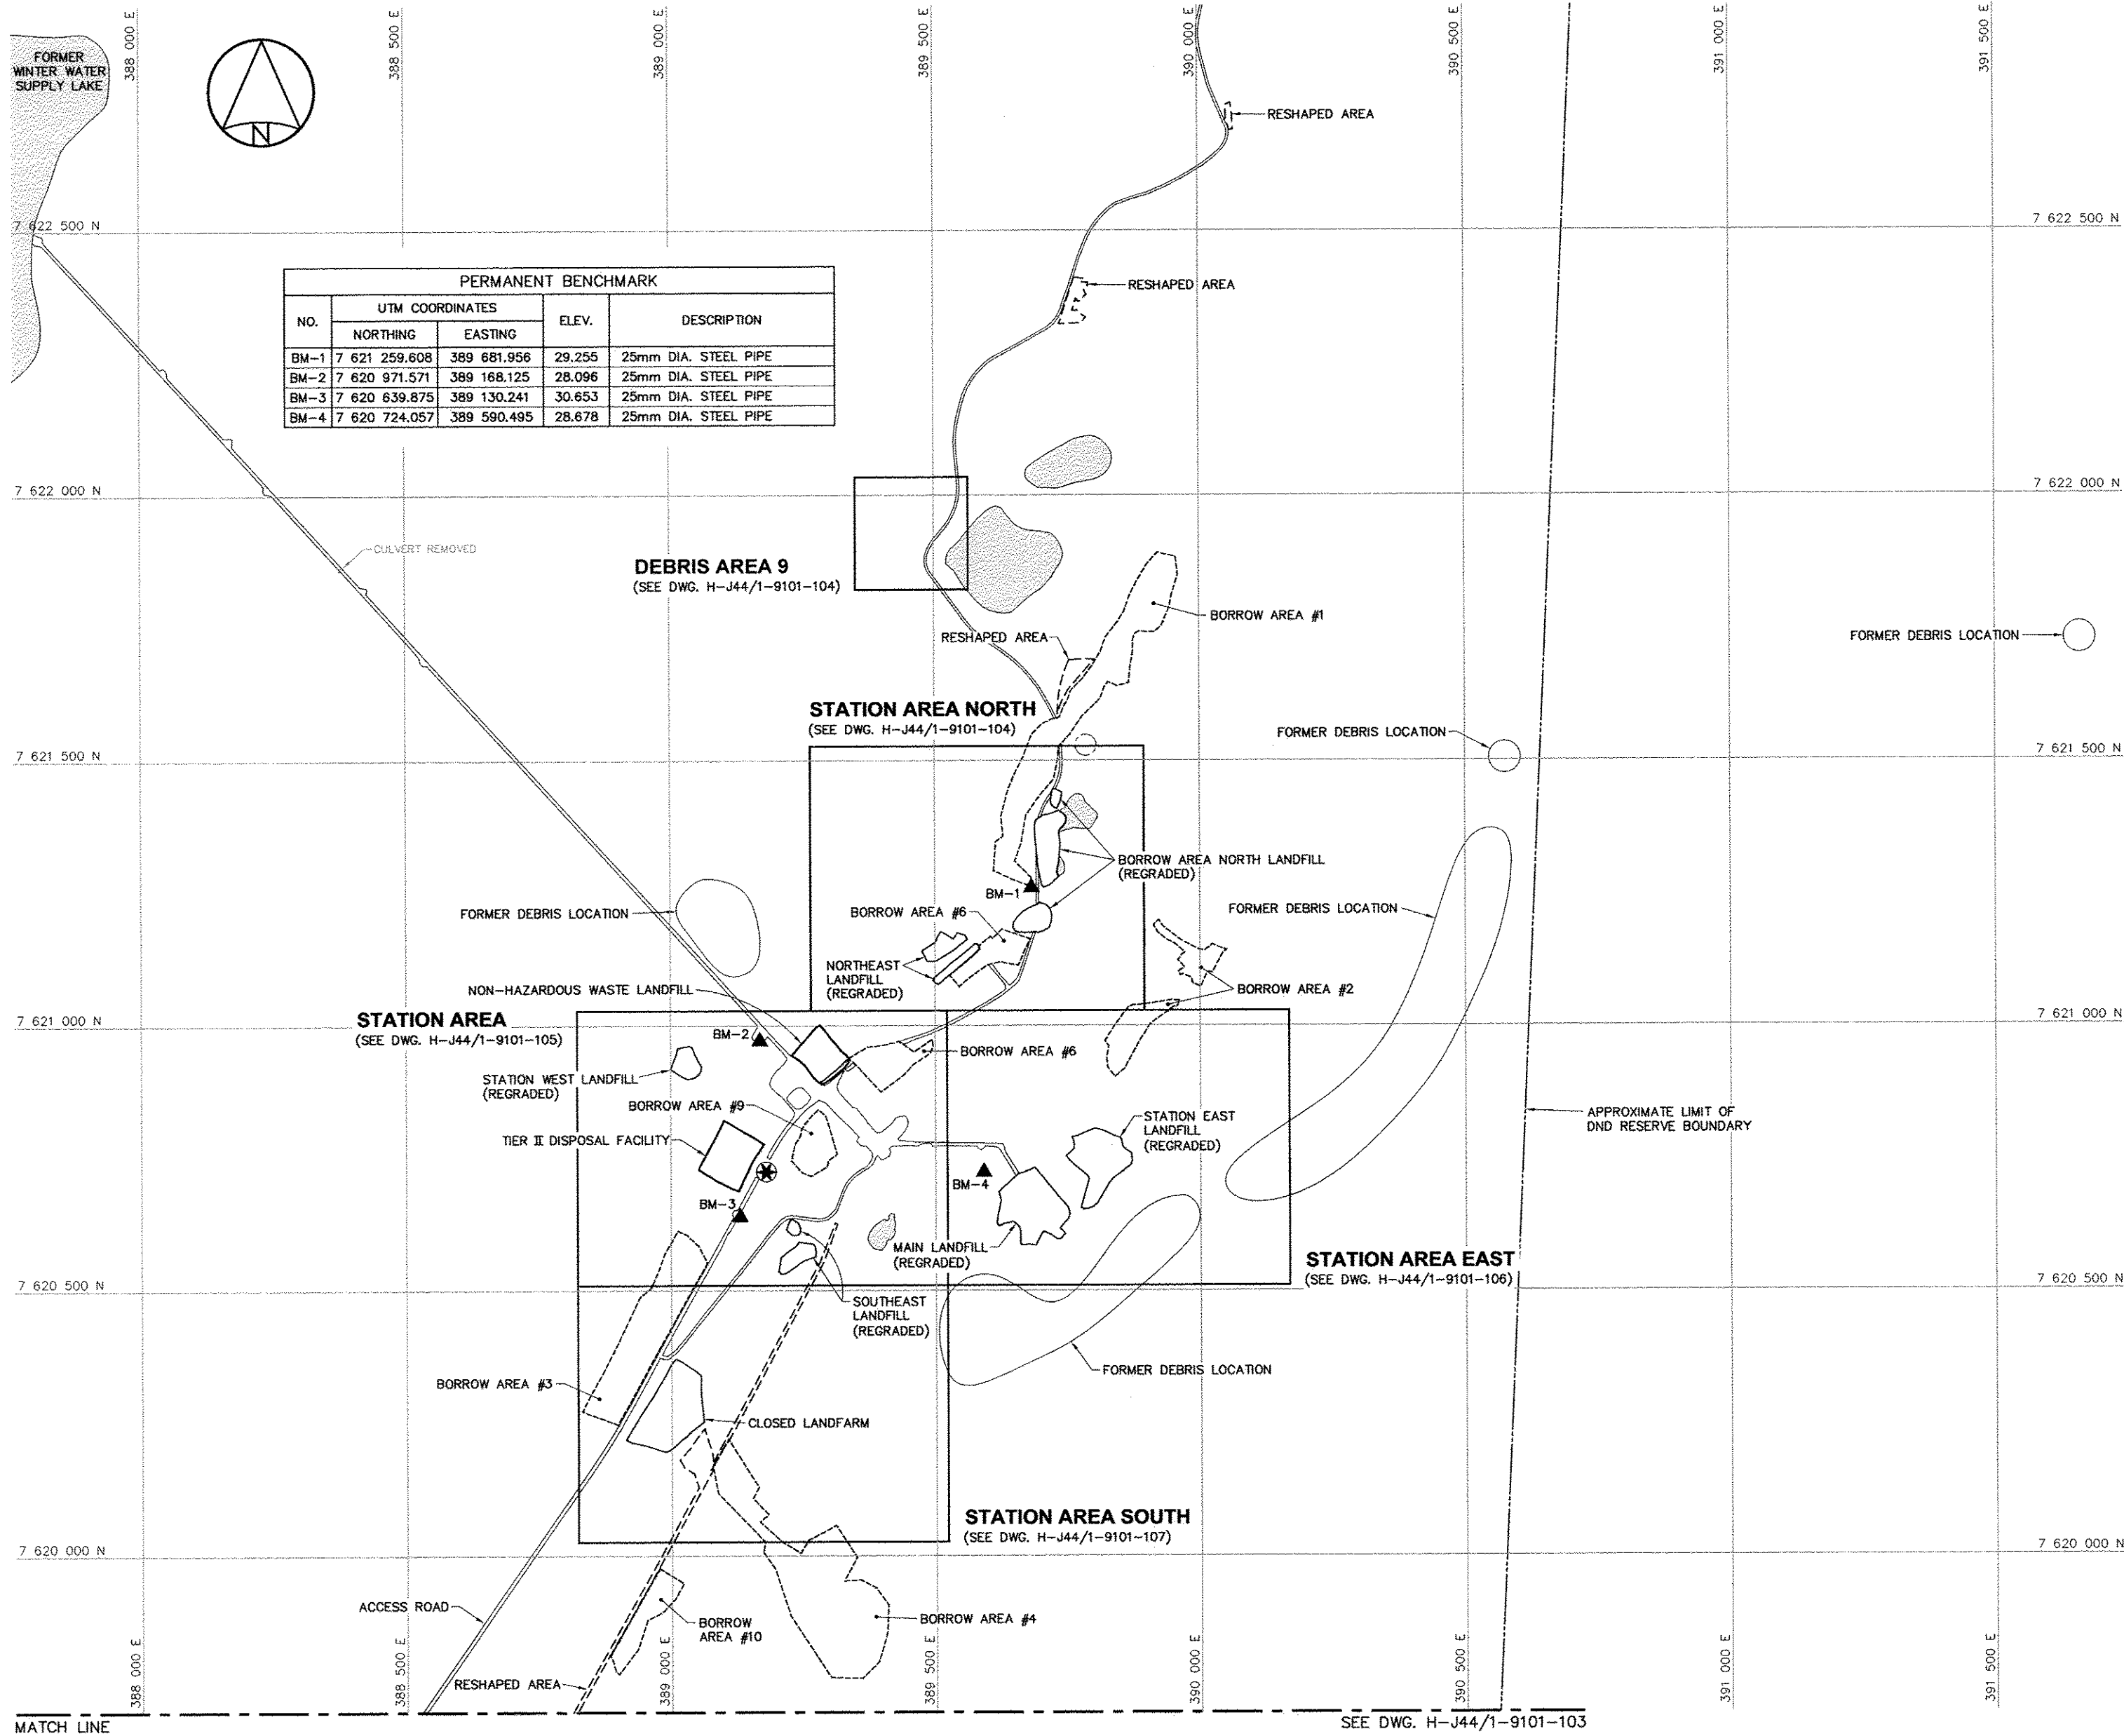

PERMANENT BENCHMARK				
NO.	UTM COORDINATES		ELEV.	DESCRIPTION
	NORTHING	EASTING		
BM-1	7 621 259.608	389 681.956	29.255	25mm DIA. STEEL PIPE
BM-2	7 620 971.571	389 168.125	28.096	25mm DIA. STEEL PIPE
BM-3	7 620 639.875	389 130.241	30.653	25mm DIA. STEEL PIPE
BM-4	7 620 724.057	389 590.495	28.678	25mm DIA. STEEL PIPE

National
Défense

Défense
nationale

Headquarters
Quartier général

General Notes:

- ALL COORDINATES ARE REFERENCED TO NAD83 (CSRS), UTM ZONE 14N. ALL ELEVATIONS REFER TO GEODETIC DATUM.
- ALL DIMENSIONS ARE IN METRES UNLESS NOTED OTHERWISE.
- ARCHAEOLOGICAL FEATURES LOCATED AS PER ENVIRONMENTAL CLEAN UP STUDY OF 21 DEW LINE SITES IN CANADA, VOL. 13, UMA 1991.
- FOR PERMANENT SURVEY CONTROL (BENCHMARK) INSTALLATION DETAIL, SEE DWG. H-J44/1-9101-117.

Legend:

BM-1 PERMANENT BENCHMARK LOCATION (4)

COMMEMORATIVE PLAQUE LOCATION

APPROXIMATE LOCATION OF PROPERTY BOUNDARY

ARCHAEOLOGICAL FEATURE

BODY OF WATER

0	12-07-16	AS-BUILT DRAWING	RRM
No.	DATE	REVISION	APPR.

PERMIT TO PRACTICE
AECOM Canada Ltd.
Signature: *[Signature]*
Date: 5/2/12
PERMIT NUMBER: P639
NWT/NL Association of Professional Engineers and Geoscientists

AECOM

HATCH

SCALE - ECHELLE 100 50 0 100 200 300m

PROJECT - PROJET
CAM-1 JENNY LIND ISLAND

DEW LINE CLEAN UP

© COPYRIGHT
HER MAJESTY THE QUEEN IN RIGHT OF
CANADA 2012, AS REPRESENTED BY THE
MINISTER OF NATIONAL DEFENCE.

TRADE - METIER SITING DATE 2006-09-15

SUBJECT - SUJET

PROJECT LAYOUT
STATION AREA

PRODUCTION	CONCURRENCE - ASSENTIMENT
DESIGNED ETUDIE ANP/RRM	DES OFF AGENT CONCEPT
DRAWN DESSINE LJV	SECT HD CHEF SECT
CHECKED VERIFIE KMS	DES MGR GEST CONCEPT
COORDINATION SMS	REVIEWED - REVU

DWG. NO. - DESSIN NO.
H-J44/1-9101-102

Canada

General Notes:

- ALL COORDINATES ARE REFERENCED TO NAD83 (CSRS), UTM ZONE 14N. ALL ELEVATIONS REFER TO GEODETIC DATUM.
- ALL DIMENSIONS ARE IN METRES UNLESS NOTED OTHERWISE.
- FOR PERMANENT SURVEY CONTROL (BENCHMARK) INSTALLATION DETAIL, SEE DWG. H-J44/1-9101-117.

Legend:

- ▲ BM-1 PERMANENT BENCHMARK LOCATION (1)
● 101 COORDINATE POINT
○ BODY OF WATER

0	12-07-16	AS-BUILT DRAWING	RRM
No.	DATE	REVISION	APPR.

PERMIT TO PRACTICE
AECOM Canada Ltd.
Signature: *[Signature]*
Date: *July 19/12*
PERMIT NUMBER: P639
NWT/NU Association of Professional Engineers and Geoscientists

AECOM HATCH

SCALE - ECHELLE 20 10 0 20 40 60m

PROJECT - PROJET
CAM-1 JENNY LIND ISLAND

DEW LINE CLEAN UP

© COPYRIGHT
HER MAJESTY THE QUEEN IN RIGHT OF
CANADA 2012, AS REPRESENTED BY THE
MINISTER OF NATIONAL DEFENCE.

TRADE - METIER	SITING	DATE
SUBJECT - SUJET		2006-09-15

DEBRIS AREA 9 AND
STATION AREA NORTH
SITE PLANS

DESIGNED ETUDIE	ANP/RRM	DES OFF AGENT CONCEPT
DRAWN DESSINE	LJV	SECT HD CHIEF SECT
CHECKED VERIFIE	KMS	DES MGR GEST CONCEPT
COORDINATION SMB		REVIEWED - REVU

DWG. NO. - DESSIN NO.
H-J44/1-9101-104

Canada

DEBRIS AREA 9 REGRADED (AS-BUILT)			
NO.	UTM COORDINATES		ELEV.
	NORTHING	EASTING	
101	7 621 908.4	389 454.1	26.2
102	7 621 895.0	389 457.5	26.6
103	7 621 893.1	389 448.4	26.9
104	7 621 904.0	389 440.7	26.8


NOTE:

FOR DETAILS REGARDING CONFIRMATORY TESTING INFORMATION, REFER TO FINAL REPORT PREPARED BY THE ENVIRONMENTAL SCIENCES GROUP, ROYAL MILITARY COLLEGE.

NOTE:

CONTOURS SHOWN AS DASHED LINES WERE GENERATED FROM SURVEY INFORMATION AND REPRESENT FINISHED GROUND SURFACE FOLLOWING REGRADING OR RESHAPING.


PERMANENT BENCHMARK			
NO.	UTM COORDINATES		DESCRIPTION
	NORTHING	EASTING	
BM-1	7 621 259.608	389 681.956	29.255 25mm DIA. STEEL PIPE

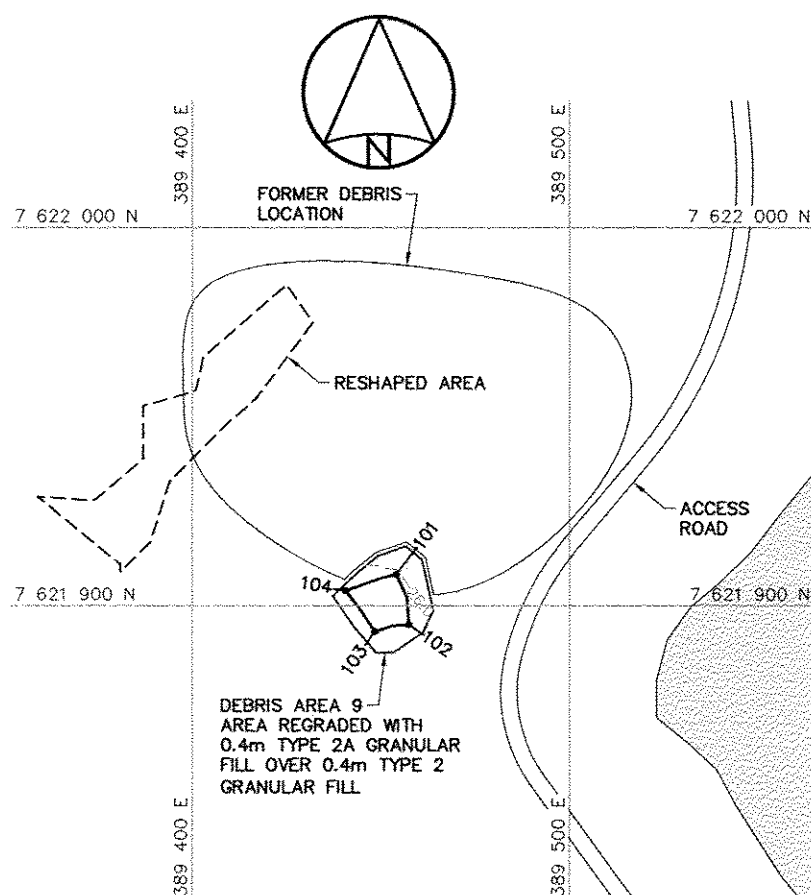

DEBRIS AREA 9

BORROW AREA NORTH LANDFILL REGRADED (AS-BUILT)			
NO.	UTM COORDINATES		ELEV.
	NORTHING	EASTING	
110	7 621 443.9	389 725.9	30.1
111	7 621 439.1	389 735.6	29.6
112	7 621 415.4	389 727.9	29.6
113	7 621 422.7	389 721.8	29.9
120	7 621 397.6	389 731.2	29.5
121	7 621 387.0	389 741.9	29.3
122	7 621 365.1	389 727.8	29.4
123	7 621 340.8	389 732.0	29.2
124	7 621 278.9	389 723.5	29.5
125	7 621 271.3	389 713.8	29.4
126	7 621 273.3	389 702.8	29.5
127	7 621 383.0	389 692.3	30.3
128	7 621 391.4	389 722.7	29.6
130	7 621 223.5	389 693.9	29.9
131	7 621 222.6	389 704.7	29.7
132	7 621 210.6	389 715.6	29.4
133	7 621 187.1	389 711.5	28.9
134	7 621 182.5	389 705.3	29.1
135	7 621 178.9	389 656.1	29.6
136	7 621 187.5	389 654.9	29.7
137	7 621 197.4	389 659.6	29.7

NORTHEAST LANDFILL REGRADED (AS-BUILT)			
NO.	UTM COORDINATES		ELEV.
	NORTHING	EASTING	
140	7 621 171.9	389 511.5	29.4
141	7 621 157.8	389 535.8	29.3
142	7 621 169.1	389 543.2	29.1
143	7 621 167.5	389 554.7	29.0
144	7 621 162.2	389 557.1	28.9
145	7 621 124.3	389 500.4	29.3
146	7 621 123.8	389 488.2	29.3
147	7 621 139.4	389 478.3	29.0
148	7 621 155.1	389 503.4	29.3
150	7 621 148.6	389 575.7	29.6
151	7 621 144.4	389 579.5	29.9
152	7 621 084.6	389 509.4	30.4
153	7 621 086.9	389 501.6	29.9

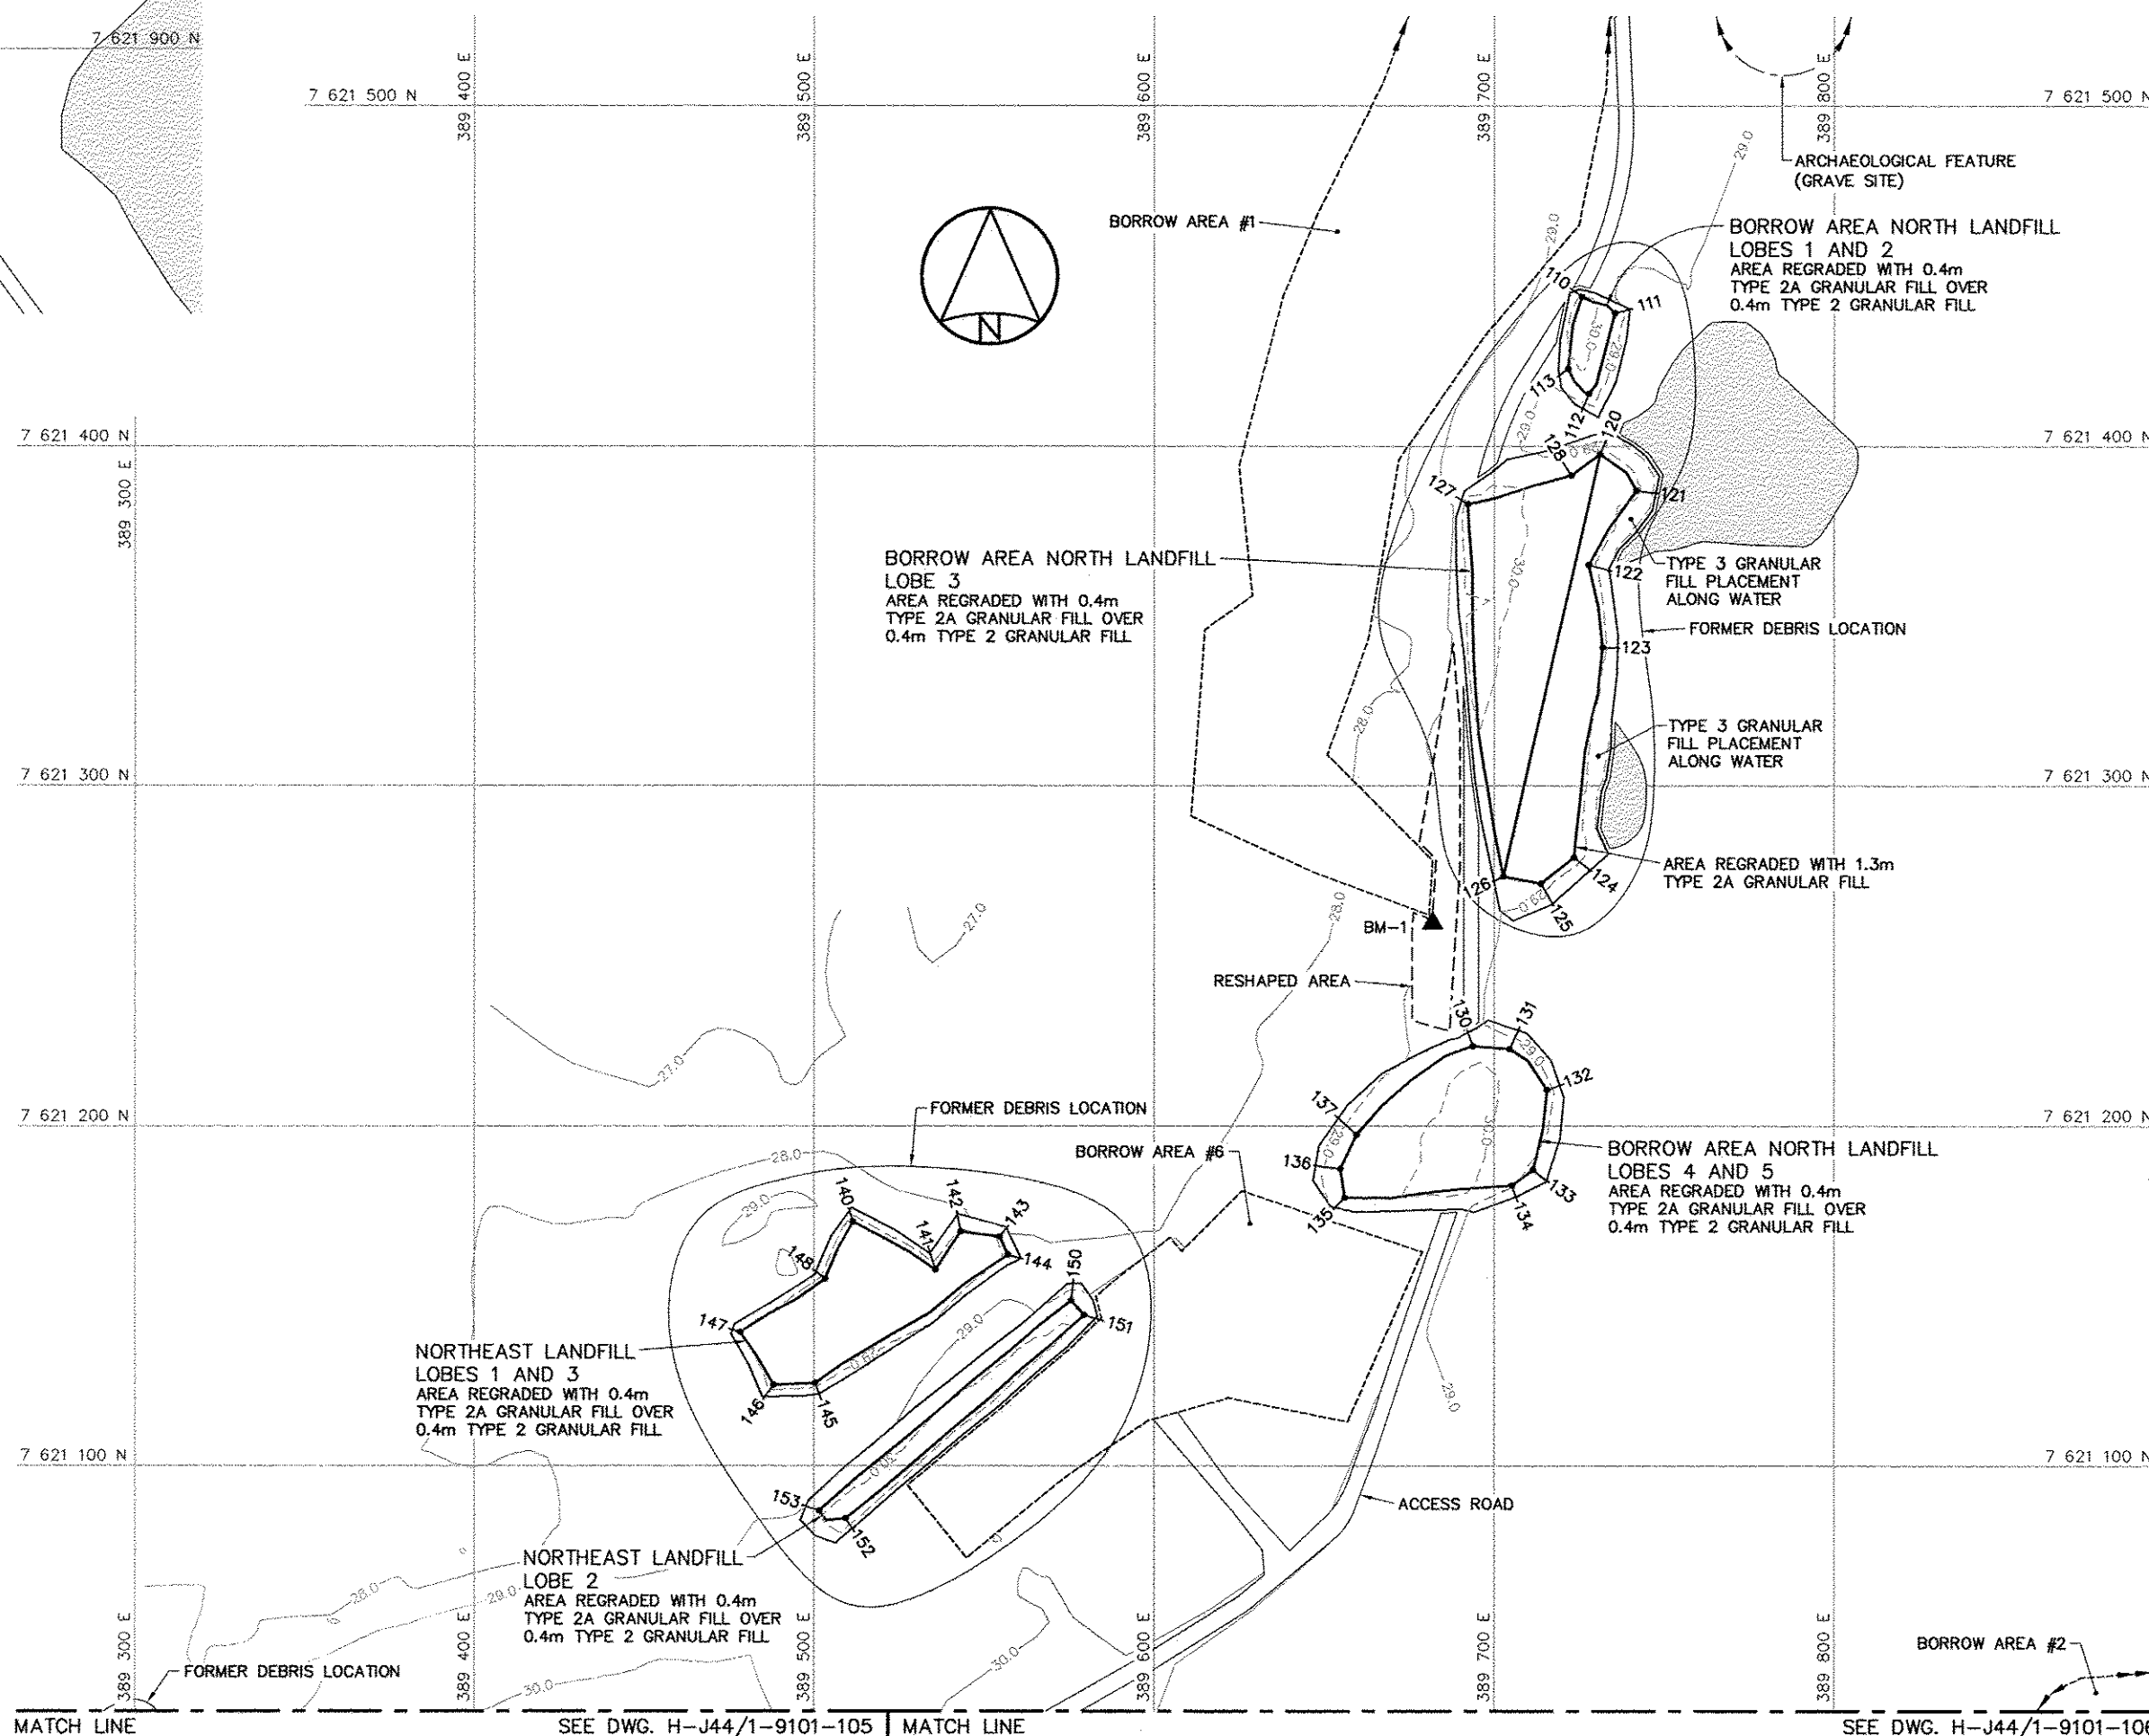

MATCH LINE

SEE DWG. H-J44/1-9101-105

STATION AREA NORTH

SEE DWG. H-J44/1-9101-106

STATION WEST LANDFILL REGRADED (AS-BUILT)			
NO.	UTM COORDINATES		ELEV.
	NORTHING	EASTING	
201	7 620 958.6	389 031.4	25.5
202	7 620 925.0	389 054.5	26.2
203	7 620 910.7	389 050.7	26.2
204	7 620 903.3	389 040.4	25.8
205	7 620 905.4	389 025.9	25.7
206	7 620 920.0	389 003.3	25.2
207	7 620 955.0	389 015.3	25.1

MODULE TRAIN DEBRIS AREA REGRADED (AS-BUILT)			
NO.	UTM COORDINATES		ELEV.
	NORTHING	EASTING	
210	7 620 760.6	389 419.8	31.8
211	7 620 759.3	389 424.7	31.6
212	7 620 750.3	389 425.5	31.5
213	7 620 748.6	389 421.8	31.5
214	7 620 751.5	389 418.3	31.7
220	7 620 773.0	389 471.7	31.5
221	7 620 772.5	389 485.2	31.9
222	7 620 769.0	389 485.8	31.8
223	7 620 758.6	389 483.8	30.6
224	7 620 762.4	389 469.7	31.7

STATION SOUTH DEBRIS AREA REGRADED (AS-BUILT)			
NO.	UTM COORDINATES		ELEV.
	NORTHING	EASTING	
230	7 620 695.7	389 238.3	33.0
231	7 620 690.1	389 242.6	32.9
232	7 620 643.8	389 188.6	31.1
233	7 620 649.7	389 183.8	31.1
240	7 620 693.0	389 178.9	32.2
241	7 620 686.9	389 193.4	32.2
242	7 620 673.8	389 189.6	31.5
243	7 620 673.4	389 182.7	31.3
244	7 620 679.7	389 175.2	31.4
250	7 620 746.0	389 175.1	32.2
251	7 620 741.7	389 183.9	31.9
252	7 620 738.7	389 193.7	33.1
253	7 620 729.0	389 213.6	33.6
254	7 620 711.2	389 198.5	33.1
255	7 620 723.7	389 168.7	32.0
256	7 620 733.9	389 161.2	31.0
257	7 620 741.5	389 165.3	30.8

SOUTHWEST DEBRIS AREA REGRADED (AS-BUILT)			
NO.	UTM COORDINATES		ELEV.
	NORTHING	EASTING	
260	7 620 648.0	389 108.1	29.4
261	7 620 634.8	389 109.8	29.6
262	7 620 619.1	389 097.7	29.2
263	7 620 618.8	389 081.7	29.1
264	7 620 641.1	389 080.8	29.4
265	7 620 649.8	389 086.5	29.4

SOUTHEAST LANDFILL REGRADED (AS-BUILT)			
NO.	UTM COORDINATES		ELEV.
	NORTHING	EASTING	
270	7 620 588.0	389 243.8	30.2
271	7 620 583.5	389 267.4	30.0
272	7 620 568.9	389 270.4	29.6
273	7 620 560.8	389 249.1	29.6
274	7 620 536.4	389 208.2	29.1
275	7 620 560.7	389 209.4	29.8
280	7 620 633.3	389 226.9	31.2
281	7 620 621.9	389 239.6	30.9
282	7 620 610.0	389 239.0	30.3
283	7 620 607.5	389 229.0	30.0
284	7 620 615.8	389 221.3	30.3

General Notes:

- ALL COORDINATES ARE REFERENCED TO NAD83 (CSRS), UTM ZONE 14N. ALL ELEVATIONS REFER TO GEODETIC DATUM.
- ALL DIMENSIONS ARE IN METRES UNLESS NOTED OTHERWISE.
- FOR PERMANENT SURVEY CONTROL (BENCHMARK) INSTALLATION DETAIL, SEE DWG. H-J44/1-9101-117.

Legend:

- BM-2 PERMANENT BENCHMARK LOCATION (2)
- 201 COORDINATE POINT
- COMMEMORATIVE PLAQUE LOCATION
- PP FORMER UTILITY POLE
- FORMER BUILDING, STRUCTURE OR TANK LOCATION
- BODY OF WATER

0	12-07-16	AS-BUILT DRAWING	RRM
No.	DATE	REVISION	APPR.

PERMIT TO PRACTICE
AECOM Canada Ltd.
Signature: *[Signature]*
Date: 19/12/12
PERMIT NUMBER: P639
HWI/NU Association of Professional Engineers and Geoscientists

AECOM HATCH

SCALE - ECHELLE 20 10 0 20 40 60m

PROJECT - PROJET
CAM-1 JENNY LIND ISLAND

DEW LINE CLEAN UP

© COPYRIGHT
HER MAJESTY THE QUEEN IN RIGHT OF CANADA 2012, AS REPRESENTED BY THE MINISTER OF NATIONAL DEFENCE.

TRADE - METIER SITING DATE 2006-09-15
SUBJECT - SUJET

STATION AREA
SITE PLAN

PRODUCTION	CONCURRENCE - ASSENTIMENT
DESIGNED ETUDIE ANP/RRM	DES OFF AGENT CONCEPT
DRAWN DESSINE LJV	SECT HD CHIEF SECT
CHECKED VERIFIE KMS	DES MGR GEST CONCEPT
COORDINATION SMB	REVIEWED - REVU

DWG. NO. - DESSIN NO.
H-J44/1-9101-105

Canada

NOTE:
FOR DETAILS REGARDING CONFIRMATORY TESTING INFORMATION, REFER TO FINAL REPORT PREPARED BY THE ENVIRONMENTAL SCIENCES GROUP, ROYAL MILITARY COLLEGE.

NOTE:
CONTOURS SHOWN AS DASHED LINES WERE GENERATED FROM SURVEY INFORMATION AND REPRESENT FINISHED GROUND SURFACE FOLLOWING REGRADED OR RESHAPING.

STATION WEST LANDFILL
AREA REGRADED WITH 0.4m
TYPE 2A GRANULAR FILL OVER
0.4m TYPE 2 GRANULAR FILL

TIER II DISPOSAL FACILITY
NOTE:
SEE DWG. H-J44/1-9101-113 AND 114 FOR DETAILED PLANS, INCLUDING INSTRUMENTATION LOCATIONS AND SECTION FOR THE TIER II DISPOSAL FACILITY.

TIER II DISPOSAL FACILITY

SOUTHWEST DEBRIS AREA
AREA REGRADED WITH 0.4m
TYPE 2A GRANULAR FILL OVER
0.4m TYPE 2 GRANULAR FILL

STATION SOUTH DEBRIS AREA
AREAS REGRADED WITH 0.4m
TYPE 2A GRANULAR FILL OVER
0.4m TYPE 2 GRANULAR FILL

SOUTHEAST LANDFILL LOBE 2
AREA REGRADED WITH 0.4m
TYPE 2A GRANULAR FILL OVER
0.4m TYPE 2 GRANULAR FILL

SOUTHEAST LANDFILL LOBE 1
AREA REGRADED WITH 0.4m
TYPE 2A GRANULAR FILL OVER
0.4m TYPE 2 GRANULAR FILL

PERMANENT BENCHMARK				
NO.	UTM COORDINATES		ELEV.	DESCRIPTION
	NORTHING	EASTING		
BM-2	7 620 971.571	389 168.125	28.096	25mm DIA. STEEL PIPE
BM-3	7 620 639.875	389 130.241	30.653	25mm DIA. STEEL PIPE


General Notes:

1. ALL COORDINATES ARE REFERENCED TO NAD83 (CSRS), UTM ZONE 14N. ALL ELEVATIONS REFER TO GEODETIC DATUM.
2. ALL DIMENSIONS ARE IN METRES UNLESS NOTED OTHERWISE.
3. FOR PERMANENT SURVEY CONTROL (BENCHMARK) INSTALLATION DETAIL, SEE DWG. H-J44/1-9101-117.

Legend:

- BM-4 PERMANENT BENCHMARK LOCATION (1)
301 COORDINATE POINT

0	12-07-16	AS-BUILT DRAWING	RRM
No.	DATE	REVISION	APPR.

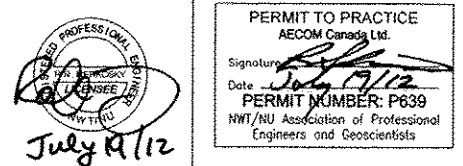

AECOM HATCH

SCALE - ECHELLE 20 10 0 20 40 60m

PROJECT - PROJET
CAM-1 JENNY LIND ISLAND

DEW LINE CLEAN UP

© COPYRIGHT
HER MAJESTY THE QUEEN IN RIGHT OF
CANADA 2012, AS REPRESENTED BY THE
MINISTER OF NATIONAL DEFENCE.

TRADE - METIER SITING DATE 2006-09-15

SUBJECT - SUJET

STATION AREA EAST
SITE PLAN

PRODUCTION	CONCURRENCE - ASSENTMENT
DESIGNED ETUDIE ANP/RRM	DES OFF AGENT CONCEPT
DRAWN DESSINE LJV	SECT HD CHEF SECT
CHECKED VERIFIE KMS	DES MGR GEST CONCEPT
COORDINATION SMS	REVIEWED - REVU

DWG. NO. - DESSIN NO.
H-J44/1-9101-106

Canada

NOTE:
FOR DETAILS REGARDING CONFIRMATORY
TESTING INFORMATION, REFER TO FINAL
REPORT PREPARED BY THE ENVIRONMENTAL
SCIENCES GROUP, ROYAL MILITARY COLLEGE.


NOTE:
CONTOURS SHOWN AS DASHED LINES WERE
GENERATED FROM SURVEY INFORMATION
AND REPRESENT FINISHED GROUND SURFACE
FOLLOWING REGRADING OR RESHAPING.

PERMANENT BENCHMARK				
NO.	UTM COORDINATES		ELEV.	DESCRIPTION
	NORTHING	EASTING		
BM-4	7 620 724.057	389 590.495	28.678	25mm DIA. STEEL PIPE

NORTHEAST DEBRIS AREA REGRADED (AS-BUILT)			
NO.	UTM COORDINATES		ELEV.
	NORTHING	EASTING	
301	7 620 919.8	389 791.2	29.3
302	7 620 909.9	389 802.5	29.3
303	7 620 882.4	389 800.3	29.7
304	7 620 878.8	389 789.8	29.5
305	7 620 912.6	389 780.4	29.3
306	7 620 918.1	389 784.0	29.2

STATION EAST LANDFILL REGRADED (AS-BUILT)			
NO.	UTM COORDINATES		ELEV.
	NORTHING	EASTING	
310	7 620 799.2	389 808.6	28.0
311	7 620 783.5	389 845.8	27.6
312	7 620 764.6	389 852.8	27.6
313	7 620 757.6	389 863.7	27.8
314	7 620 743.2	389 864.5	27.7
315	7 620 712.7	389 828.1	27.4
316	7 620 662.3	389 796.9	27.2
317	7 620 659.0	389 779.1	27.3
318	7 620 715.0	389 794.1	27.6
319	7 620 753.9	389 751.4	27.6
320	7 620 764.1	389 763.6	27.6
321	7 620 785.7	389 765.6	28.3
322	7 620 799.3	389 798.9	28.0

MAIN LANDFILL REGRADED (AS-BUILT)			
NO.	UTM COORDINATES		ELEV.
	NORTHING	EASTING	
330	7 620 726.9	389 683.2	28.4
331	7 620 654.7	389 746.7	27.6
332	7 620 645.1	389 748.3	27.6
333	7 620 618.5	389 727.9	27.6
334	7 620 608.1	389 738.0	27.3
335	7 620 600.6	389 731.2	27.3
336	7 620 615.8	389 701.4	27.6
337	7 620 590.7	389 686.5	27.7
338	7 620 590.5	389 663.6	27.8
339	7 620 622.9	389 659.3	27.3
340	7 620 634.8	389 639.9	27.2
341	7 620 627.8	389 619.6	27.8
342	7 620 672.6	389 625.5	28.1
343	7 620 687.0	389 622.0	28.3
344	7 620 717.7	389 657.8	28.7

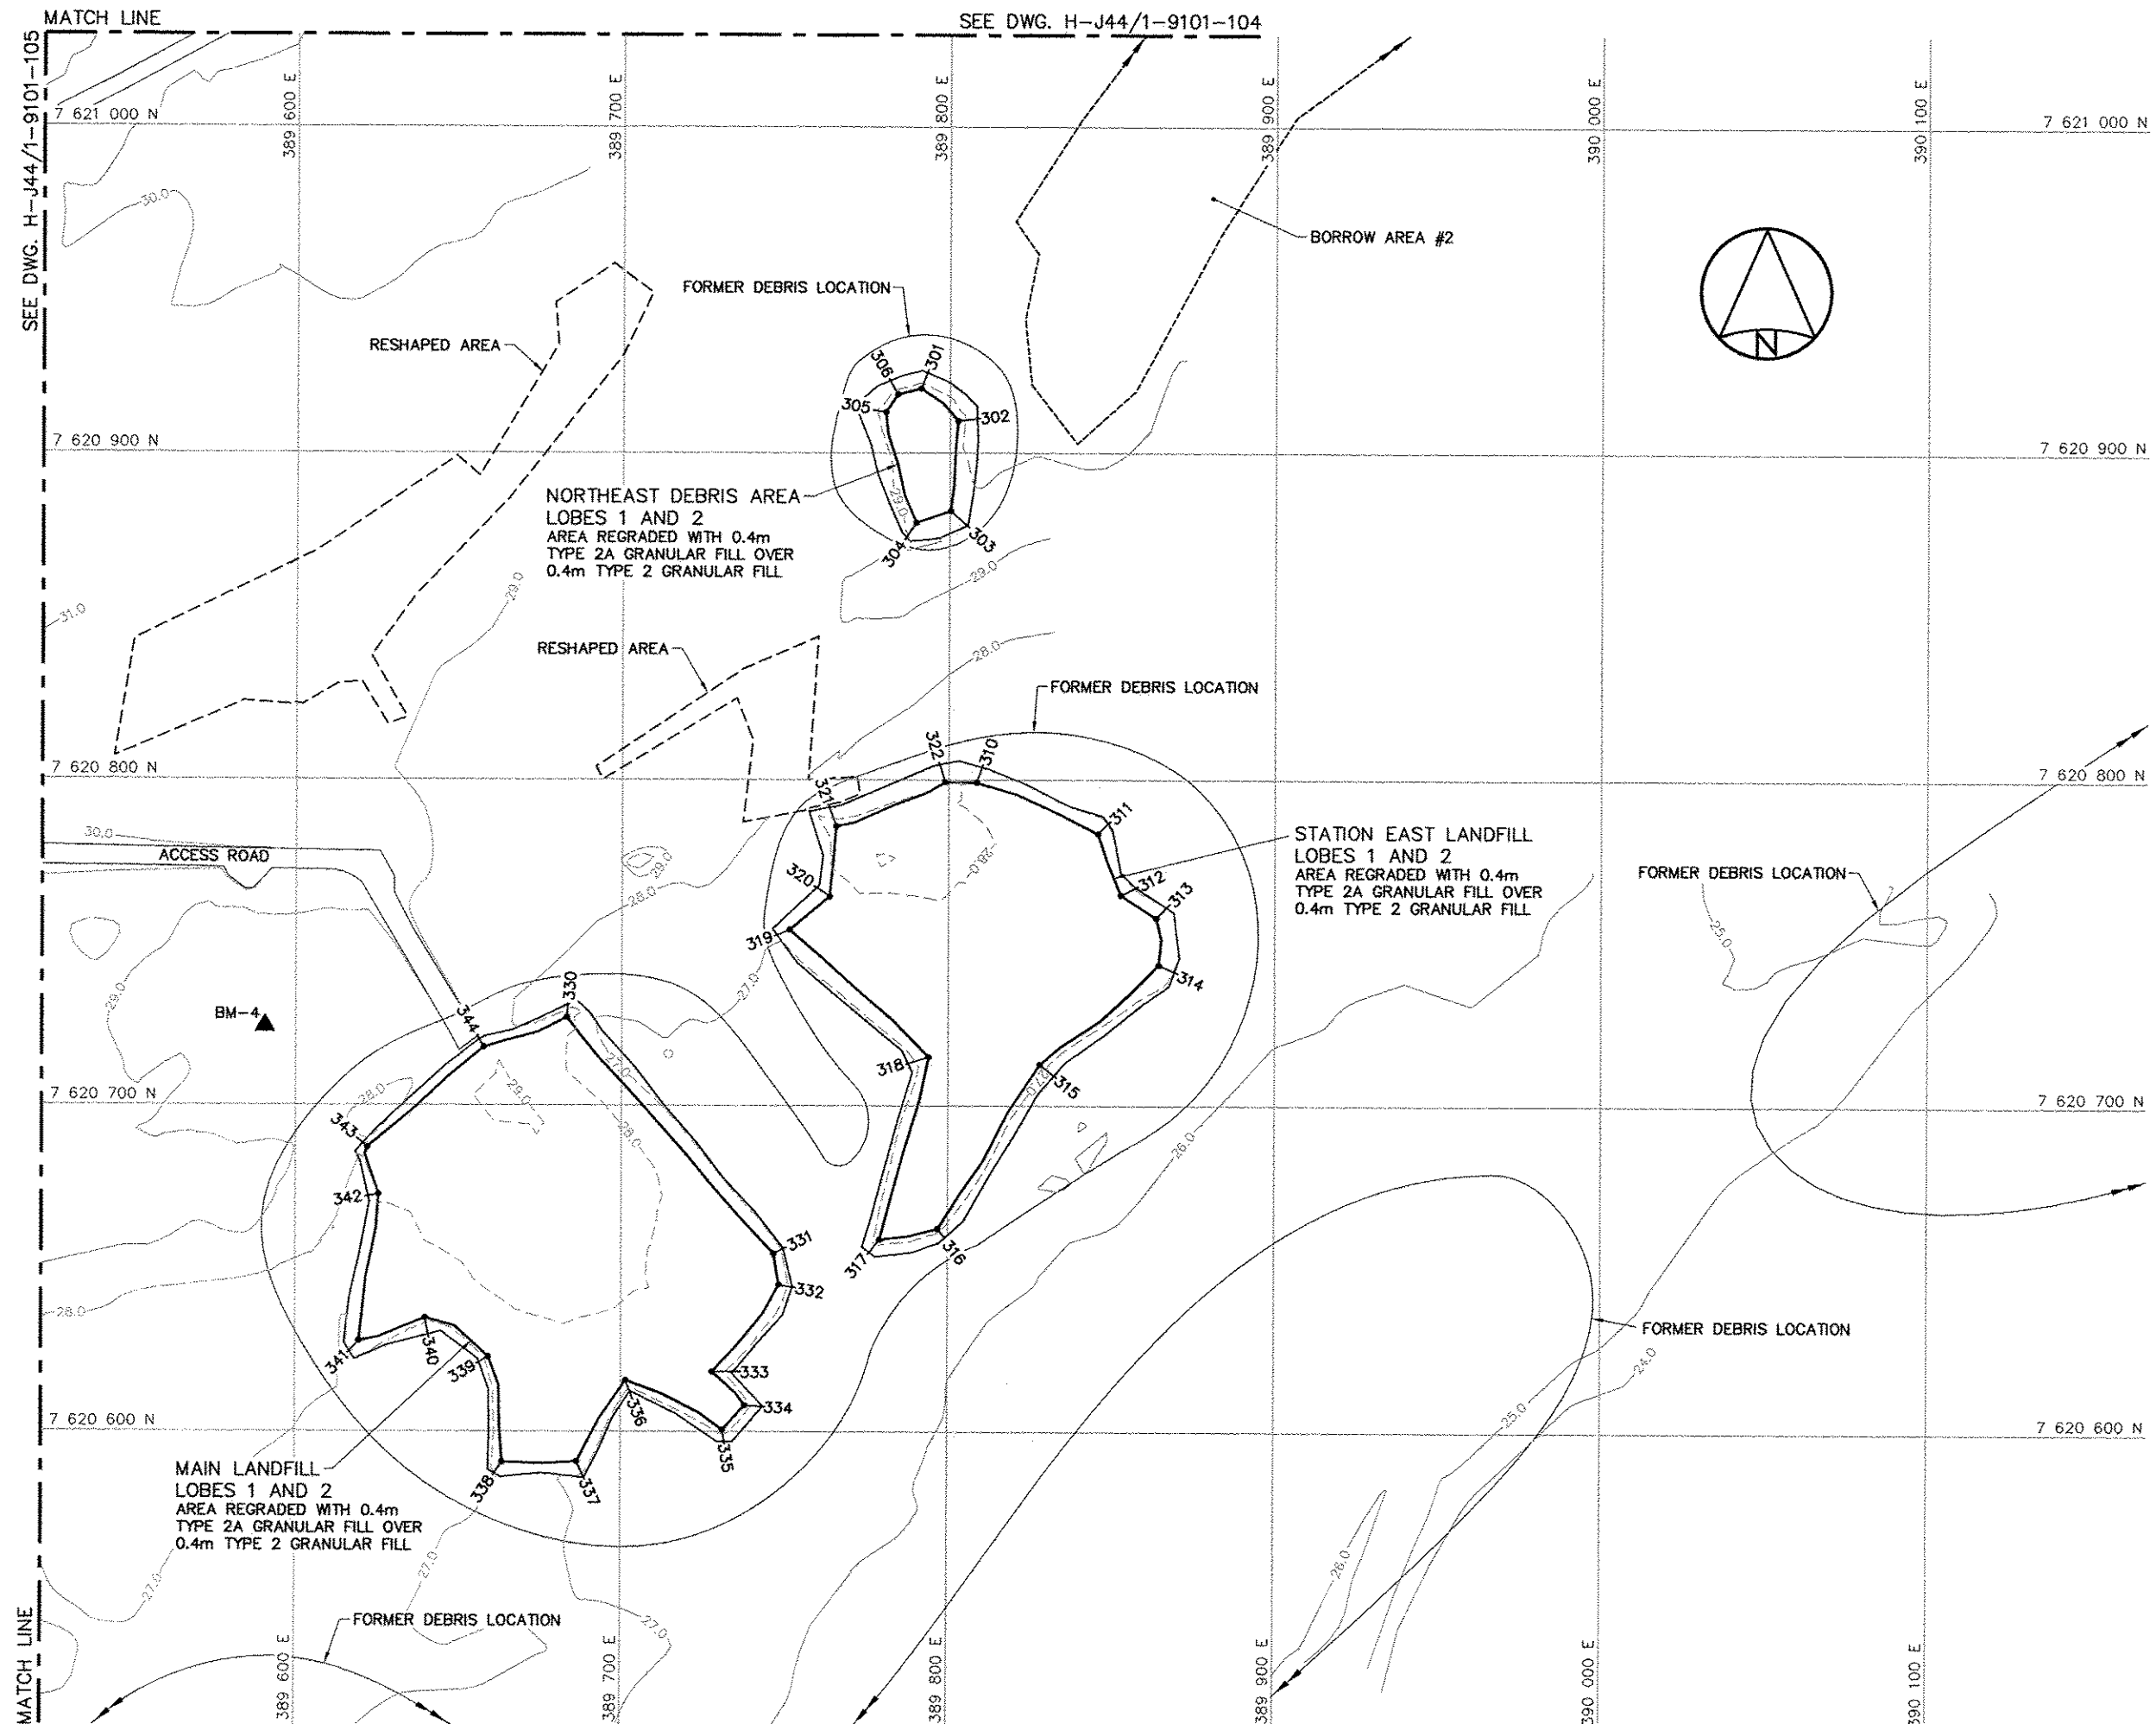


LANDFARM MONITORING WELLS REMOVED		
NO.	UTM COORDINATES	
	NORTHING	EASTING
MW-09	7 620 260.6	389 072.7
MW-10	7 620 293.5	388 955.7
MW-11	7 620 218.5	388 905.1
MW-12	7 620 189.6	388 951.1

NOTE:
FOR DETAILS REGARDING CONFIRMATORY TESTING INFORMATION, REFER TO FINAL REPORT PREPARED BY THE ENVIRONMENTAL SCIENCES GROUP, ROYAL MILITARY COLLEGE.

SOUTH DEBRIS AREA REGRADED (AS-BUILT)			
NO.	UTM COORDINATES		ELEV.
	NORTHING	EASTING	
401	7 620 329.3	389 079.4	30.2
402	7 620 325.5	389 094.3	30.0
403	7 620 315.1	389 100.4	29.3
404	7 620 296.4	389 091.0	29.2
405	7 620 295.8	389 085.8	29.6
406	7 620 306.4	389 068.3	30.2

NOTE:
CONTOURS SHOWN AS DASHED LINES WERE GENERATED FROM SURVEY INFORMATION AND REPRESENT FINISHED GROUND SURFACE FOLLOWING REGRAIDING OR RESHAPING.

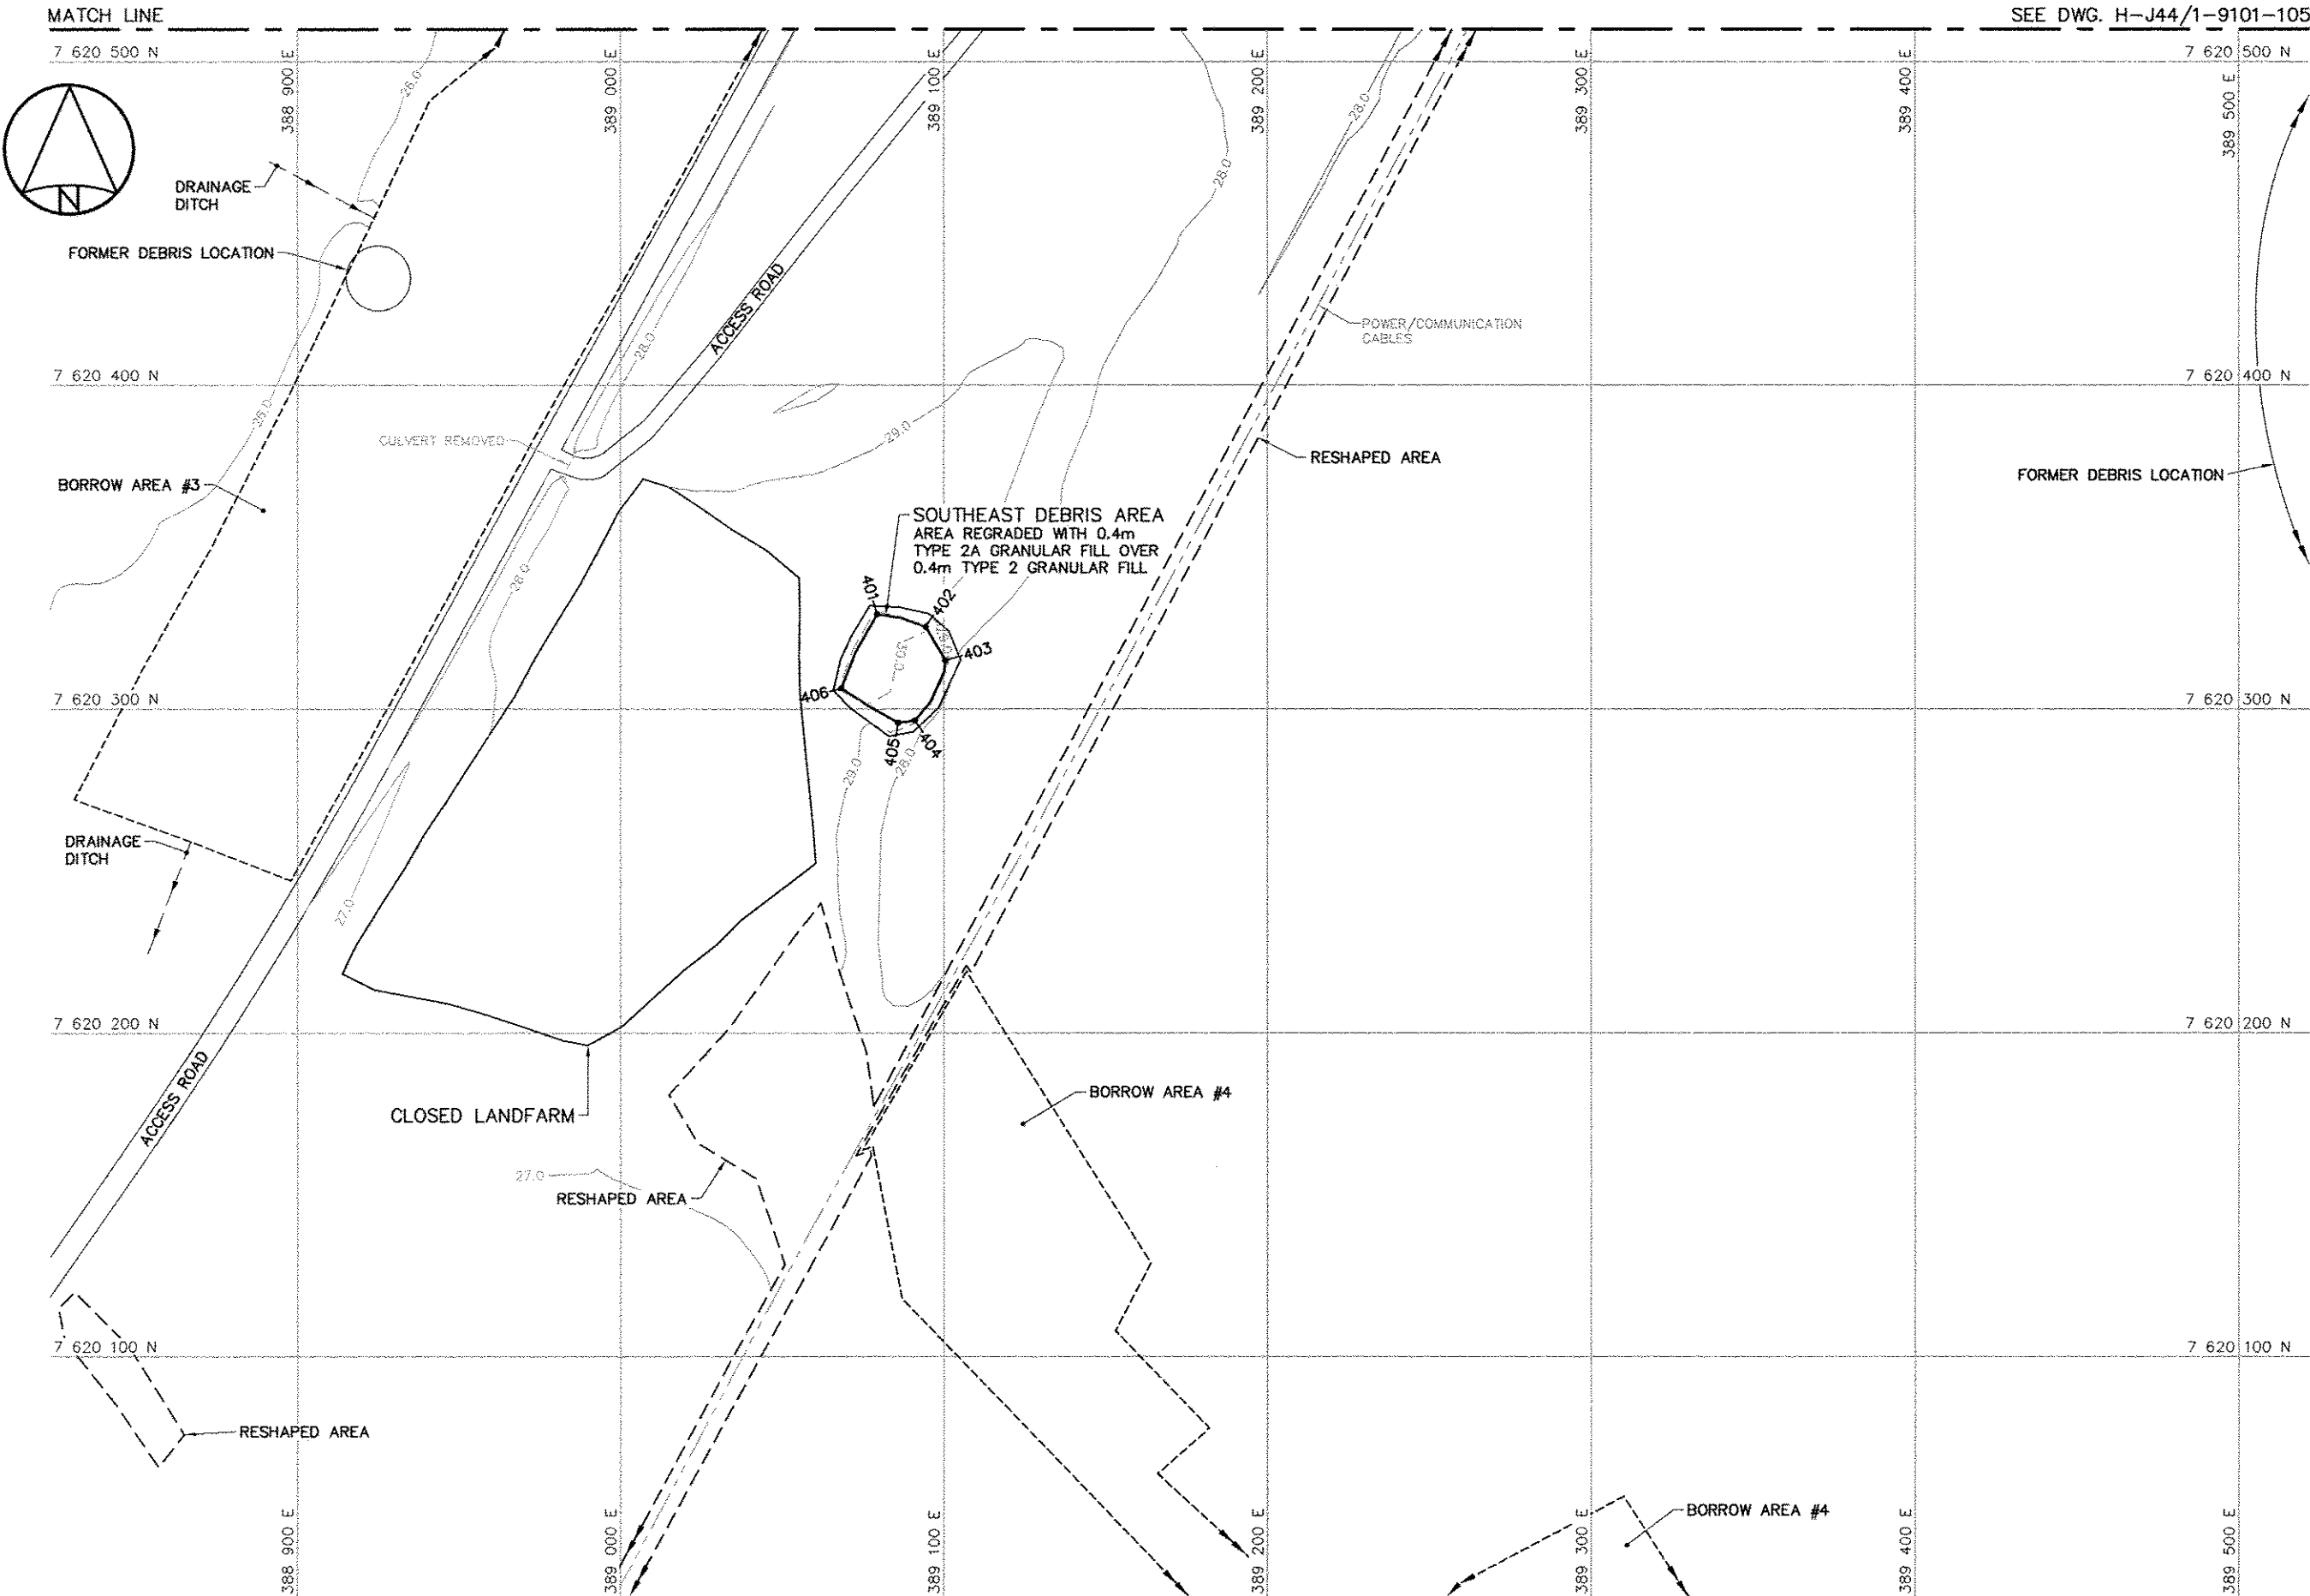

- General Notes:
1. ALL COORDINATES ARE REFERENCED TO NAD83 (CSRS), UTM ZONE 14N. ALL ELEVATIONS REFER TO GEODETIC DATUM.
 2. ALL DIMENSIONS ARE IN METRES UNLESS NOTED OTHERWISE.

Legend:
401 COORDINATE POINT

0	12-07-16	AS-BUILT DRAWING	RRM
No.	DATE	REVISION	REVISION

PERMIT TO PRACTICE
AECOM Canada Ltd.
Signature: [Signature]
Date: 12/19/12
PERMIT NUMBER: P639
NWT/NU Association of Professional Engineers and Geoscientists

AECOM HATCH
SCALE - ECHELLE 20 10 0 20 40 60m

PROJECT - PROJET
CAM-1 JENNY LIND ISLAND

DEW LINE CLEAN UP
© COPYRIGHT
HER MAJESTY THE QUEEN IN RIGHT OF
CANADA 2012, AS REPRESENTED BY THE
MINISTER OF NATIONAL DEFENCE.

TRADE - METIER SITING DATE 2006-09-15
SUBJECT - SUJET

STATION AREA SOUTH
SITE PLAN

PRODUCTION		CONCURRENCE - ASSENTIMENT	
DESIGNED ETUDIE	AMP/RRM	DES OFF AGENT CONCEPT	
DRAWN DESSINE	LJV	SECT HD CHEF SECT	
CHECKED VERIFIE	KMS	DES MGR GEST CONCEPT	
COORDINATION	SMS	REVIEWED - REVU	

DWG. NO. - DESSIN NO.
H-J44/1-9101-107

General Notes:

1. ALL COORDINATES ARE REFERENCED TO NAD83 (CSRS), UTM ZONE 14N. ALL ELEVATIONS REFER TO GEODETIC DATUM.
2. ALL DIMENSIONS ARE IN METRES UNLESS NOTED OTHERWISE.
3. ALL SHORT RANGE RADAR (SRR) FACILITIES WERE OPERATIONAL.

Legend:

-  CM101 SURVEY CONTROL MONUMENT
-  501 COORDINATE POINT
-  COMPLETED LANDFILL OR BURIED DEBRIS EXCAVATION
-  FORMER UTILITY POLE
-  FORMER BUILDING, STRUCTURE OR TANK LOCATION
-  BODY OF WATER

0 12-07-16 AS-BUILT DRAWING RRM

No. DATE REVISION REVISION APPR.



PERMIT TO PRACTICE
AECOM Canada Ltd.
Signature: 
Date: July 9/12
PERMIT NUMBER: P639
NWT/NU Association of Professional Engineers and Geoscientists

SCALE - ECHELLE 20 10 0 20 40 60m

PROJECT - PROJET
CAM-1 JENNY LIND ISLAND

DEW LINE CLEAN UP

© COPYRIGHT
HER MAJESTY THE QUEEN IN RIGHT OF
CANADA 2012, AS REPRESENTED BY THE
MINISTER OF NATIONAL DEFENCE.

TRADE - METIER SITING DATE
2006-09-15

SUBJECT - SUJET

BEACH AREA
SITE PLAN

PRODUCTION		CONCURRENCE - ASSENTIMENT	
DESIGNED ETUDIE	ANP/RRM	DES OFF AGENT CONCEPT	
DRAWN DESSINE	LJV	SECT HD CHIEF SECT	
CHECKED VERIFIE	KMS	DES MOR GEST CONCEPT	
COORDINATION	SHS	REVIEWED - REVU	

DWG. NO. - DESSIN NO.
H-J44/1-9101-108


WEST LANDING DEBRIS AREA REGRADED (AS-BUILT)			
NO.	UTM COORDINATES		ELEV.
	NORTHING	EASTING	
501	7 618 571.7	387 913.7	7.0
502	7 618 587.3	387 923.0	7.2
503	7 618 559.2	387 926.0	7.2
504	7 618 545.3	387 924.5	6.7
505	7 618 543.0	387 898.3	5.2
506	7 618 560.2	387 889.7	5.3

EAST LANDING LANDFILL REGRADED (AS-BUILT)			
NO.	UTM COORDINATES		ELEV.
	NORTHING	EASTING	
510	7 618 234.1	388 154.2	5.9
511	7 618 227.3	388 181.8	6.3
512	7 618 224.9	388 199.0	6.7
513	7 618 217.1	388 205.6	6.8
514	7 618 206.1	388 198.4	6.5
515	7 618 214.0	388 157.5	5.4
516	7 618 217.8	388 149.7	5.4

SURVEY CONTROL MONUMENTS				
NO.	UTM COORDINATES		ELEV.	DESCRIPTION
	NORTHING	EASTING		
CM101	7 618 507.336	388 303.720	17.975	MONUMENT NO 8699635

NOTE:
FOR DETAILS REGARDING CONFIRMATORY
TESTING INFORMATION, REFER TO FINAL
REPORT PREPARED BY THE ENVIRONMENTAL
SCIENCES GROUP, ROYAL MILITARY COLLEGE.

NOTE:
CONTOURS SHOWN AS DASHED LINES WERE
GENERATED FROM SURVEY INFORMATION
AND REPRESENT FINISHED GROUND SURFACE
FOLLOWING REGRADING OR RESHAPING.

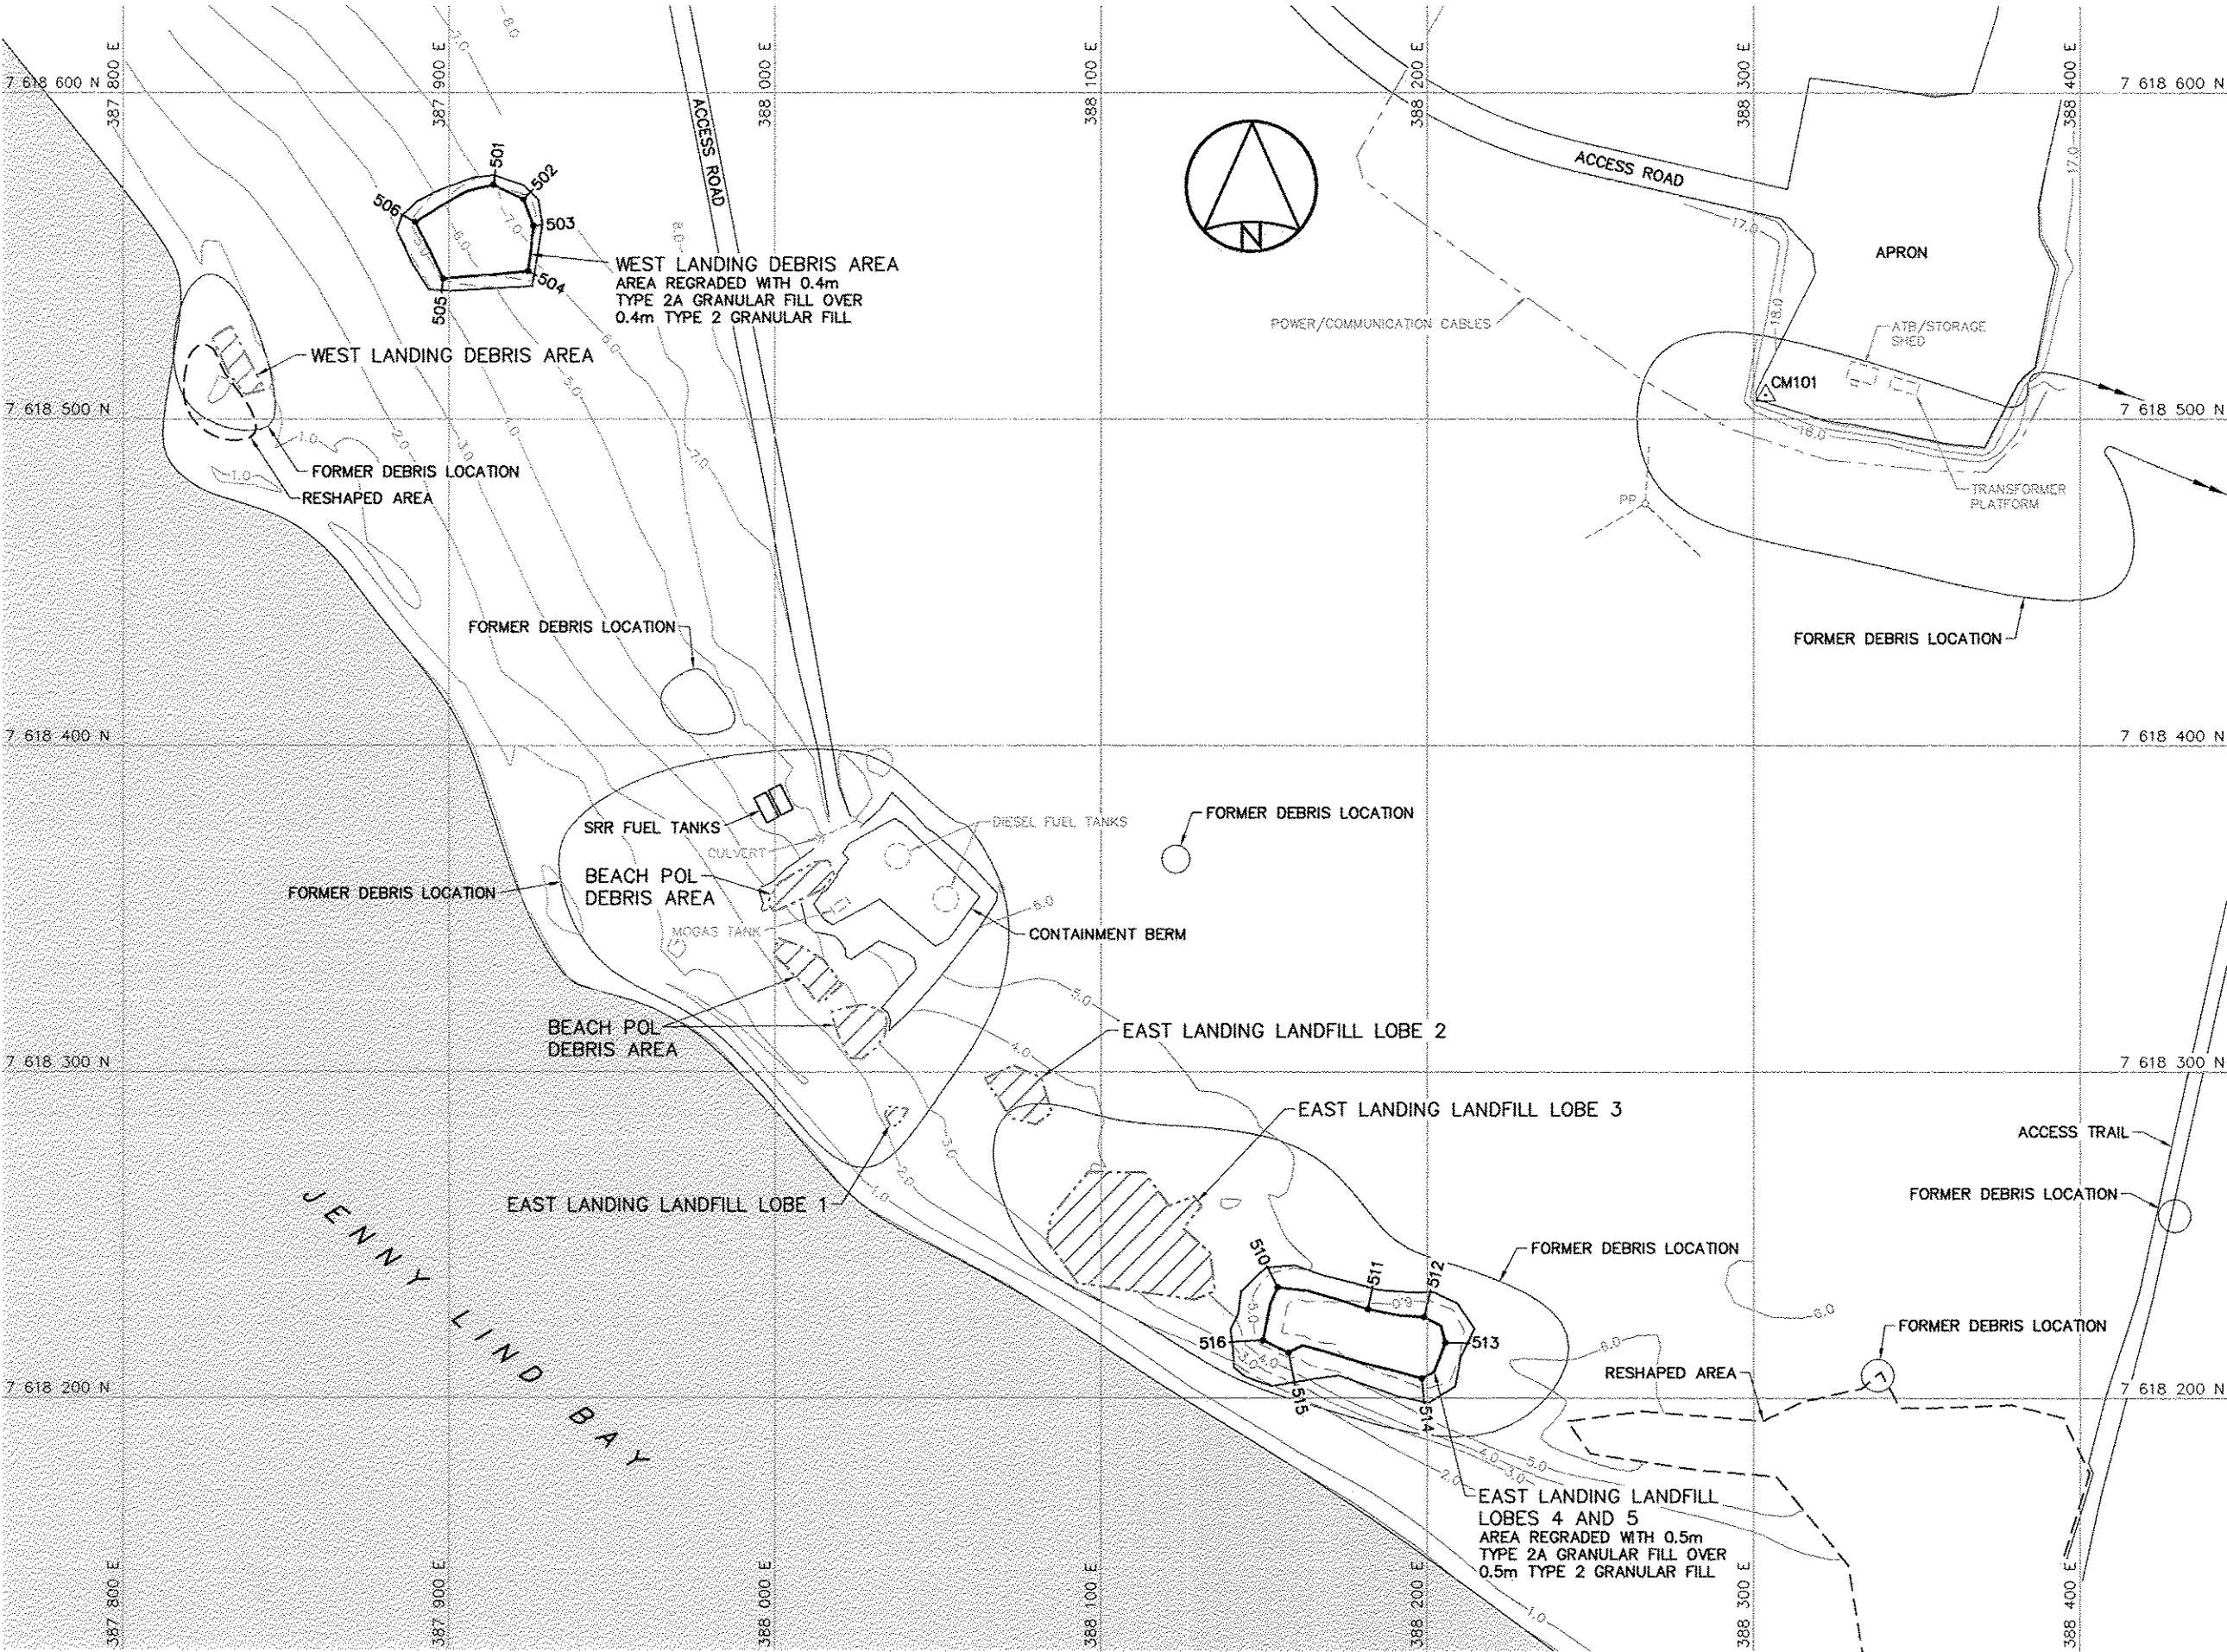

General Notes:

1. ALL COORDINATES ARE REFERENCED TO NAD83 (CSRS), UTM ZONE 14N. ALL ELEVATIONS REFER TO GEODETIC DATUM.
2. ALL DIMENSIONS ARE IN METRES UNLESS NOTED OTHERWISE.

Legend:

- 601 COORDINATE POINT
- COMPLETED LANDFILL OR BURIED DEBRIS EXCAVATION
- BODY OF WATER

0	12-07-16	AS-BUILT DRAWING	RRM
No.	DATE	REVISION	APPR.



PERMIT TO PRACTICE
AECOM Canada Ltd.
Signature: [Signature]
Date: 19/12/12
PERMIT NUMBER: P639
NWT/NY Association of Professional Engineers and Geoscientists

AECOM HATCH

SCALE - ECHELLE 20 10 0 20 40 60m

PROJECT - PROJET
CAM-1 JENNY LIND ISLAND

DEW LINE CLEAN UP

© COPYRIGHT
HER MAJESTY THE QUEEN IN RIGHT OF CANADA 2012, AS REPRESENTED BY THE MINISTER OF NATIONAL DEFENCE.

TRADE - MÉTIER SITING DATE 2006-09-15


SUBJECT - SUJET

**USAF LANDFILL AREA, AIRSTRIP AREAS AND EAST POINT AREA
SITE PLANS**

PRODUCTION		CONCURRENCE - ASSENTIMENT	
DESIGNED ETUDIE	ANP/RRM	DES OFF AGENT CONCEPT	
DRAWN DESSINE	LJV	SECT HD CHIEF SECT	
CHECKED VERIFIE	KMS	DES MGR GEST CONCEPT	
COORDINATION	SMS	REVIEWED - REVU	

DWG. NO. - DESSIN NO.
H-J44/1-9101-109

Canada

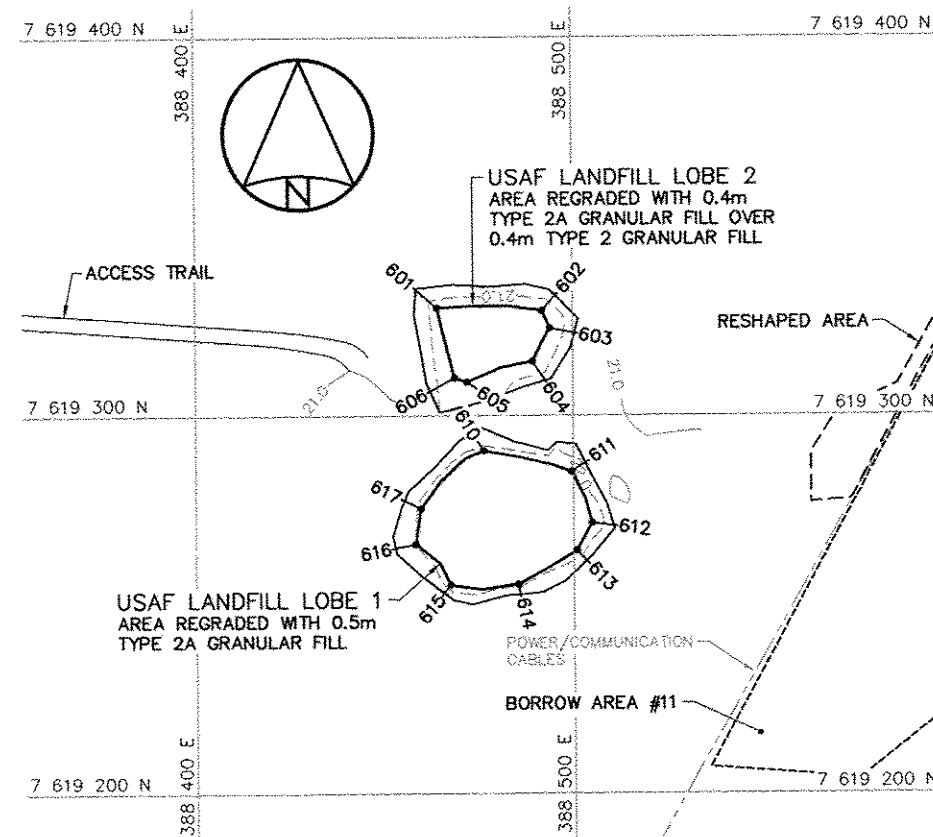

USAF LANDFILL AREA

NOTE:


FOR DETAILS REGARDING CONFIRMATORY TESTING INFORMATION, REFER TO FINAL REPORT PREPARED BY THE ENVIRONMENTAL SCIENCES GROUP, ROYAL MILITARY COLLEGE.

NOTE:


CONTOURS SHOWN AS DASHED LINES WERE GENERATED FROM SURVEY INFORMATION AND REPRESENT FINISHED GROUND SURFACE FOLLOWING REGRADED OR RESHAPING.

AIRSTRIP SOUTH DEBRIS AREA REGRADED (AS-BUILT)			
NO.	UTM COORDINATES		ELEV.
	NORTHING	EASTING	
620	7 617 831.1	389 591.4	14.1
621	7 617 833.0	389 600.1	14.0
622	7 617 821.8	389 608.7	13.9
623	7 617 822.4	389 595.5	14.4


EAST POINT DEBRIS AREA REGRADED (AS-BUILT)			
NO.	UTM COORDINATES		ELEV.
	NORTHING	EASTING	
630	7 616 638.2	389 830.9	2.6
631	7 616 634.5	389 836.7	2.6
632	7 616 612.7	389 814.3	2.6
633	7 616 607.7	389 812.5	2.8
634	7 616 596.5	389 800.4	2.1
635	7 616 592.3	389 789.2	2.2
636	7 616 597.8	389 774.6	2.2
637	7 616 611.0	389 769.4	1.8

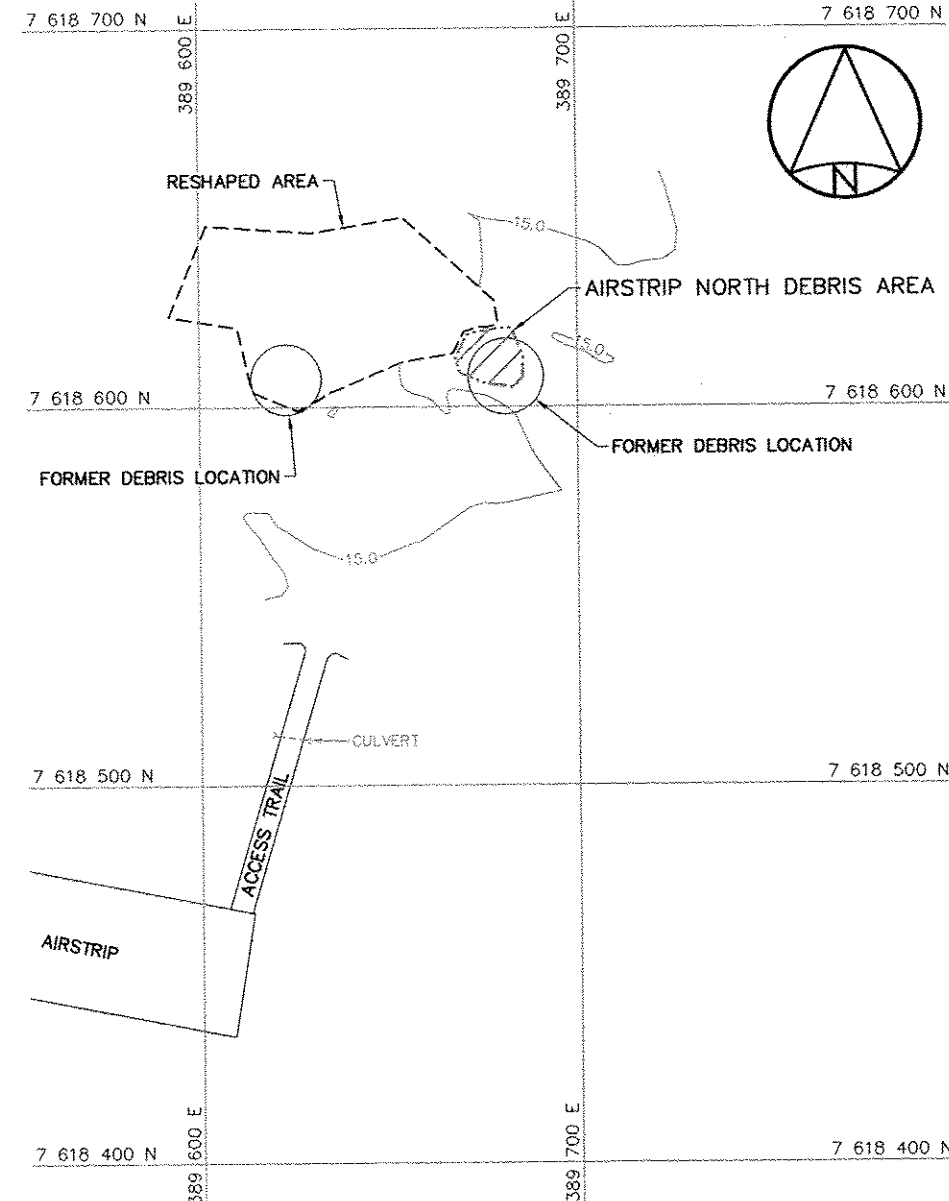

AIRSTRIP NORTH DEBRIS AREA

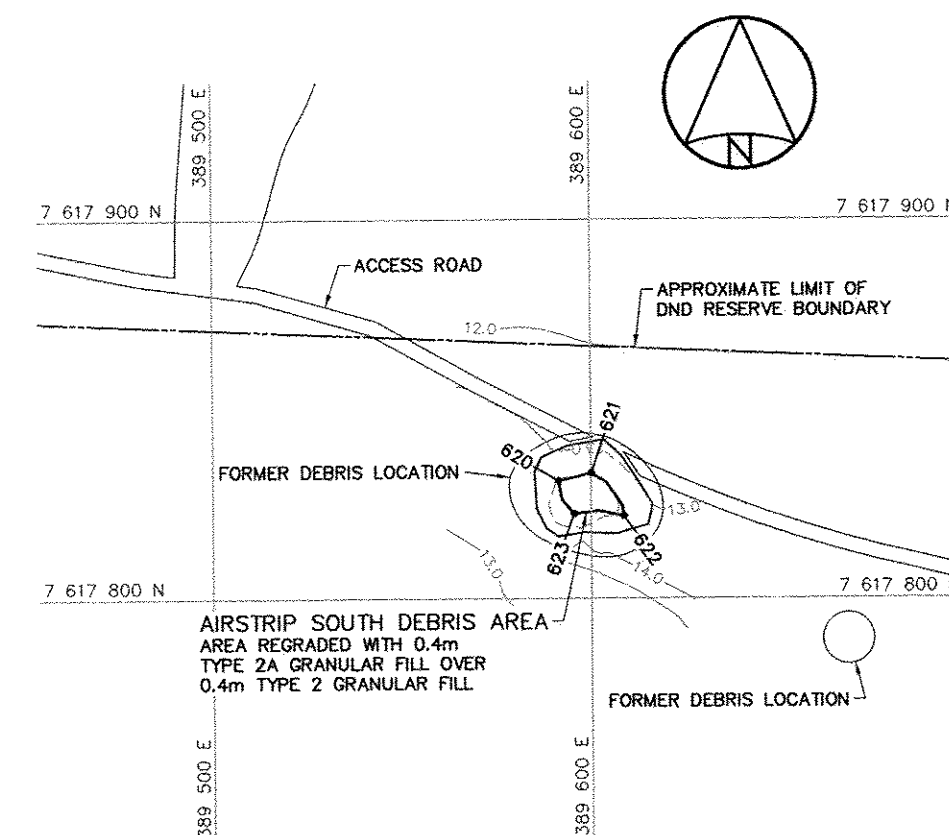

AIRSTRIP SOUTH DEBRIS AREA

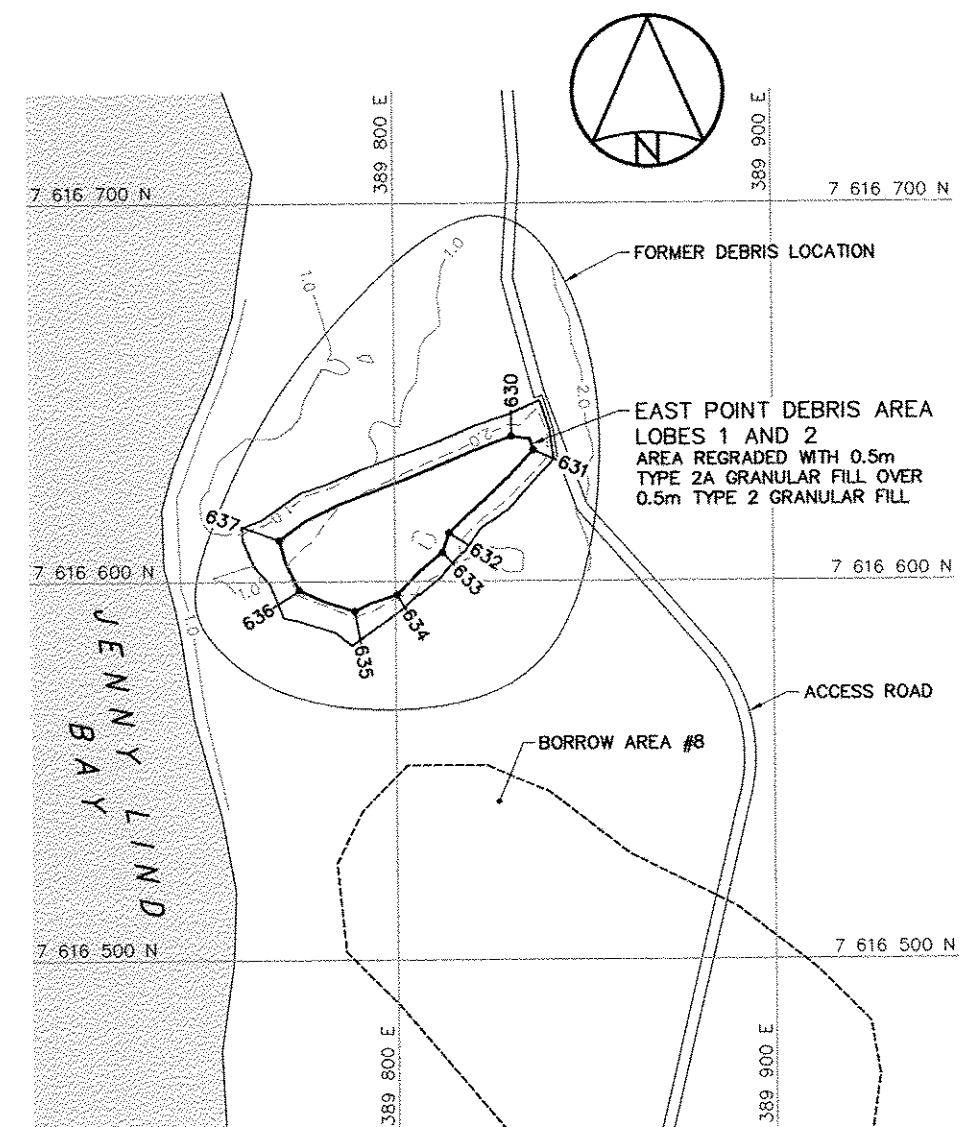

EAST POINT DEBRIS AREA


General Notes:

1. ALL COORDINATES ARE REFERENCED TO NAD83 (CSRS), UTM ZONE 14N. ALL ELEVATIONS REFER TO GEODETIC DATUM.
2. ALL DIMENSIONS ARE IN METRES UNLESS NOTED OTHERWISE.
3. FOR MONITORING WELL INSTALLATION DETAILS, SEE DWG. H-J44/1-9101-117.

Legend:

- 701 COORDINATE POINT
- MW-02 MONITORING WELL LOCATION (3)
- MW-01 BACKGROUND MONITORING WELL LOCATION (1)
- FORMER BUILDING, STRUCTURE OR TANK LOCATION
- GENERATED BASED ON AS-BUILT SURVEY INFORMATION
- CONSTRUCTED AS PER DESIGN, NO AS-BUILT SURVEY INFORMATION

0	12-07-16	AS-BUILT DRAWING	RRM
No.	DATE	REVISION	REVISION
			APPR.

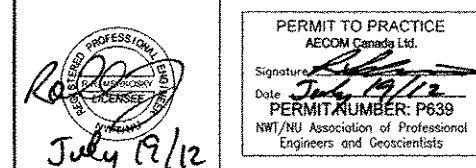

AECOM HATCH

SCALE - ÉCHELLE AS SHOWN

PROJECT - PROJET
CAM-1 JENNY LIND ISLAND

DEW LINE CLEAN UP

© COPYRIGHT
HER MAJESTY THE QUEEN IN RIGHT OF
CANADA 2012, AS REPRESENTED BY THE
MINISTER OF NATIONAL DEFENCE.


TRADE - MÉTIER SITING DATE 2006-09-15
SUBJECT - SUJET

**NON-HAZARDOUS WASTE LANDFILL
PLANS AND SECTION**


DESIGNED ÉTUDE	ANP/RRM	DES OFF AGENT CONCEPT
DRAWN DESSINE	LJV	SECT HD CHEF SECT
CHECKED VÉRIFIÉ	KMS	DES MGR GEST CONCEPT
COORDINATION	SMS	REVIEWED - REVU

DWG. NO. - DESSIN NO.
H-J44/1-9101-111

Canada

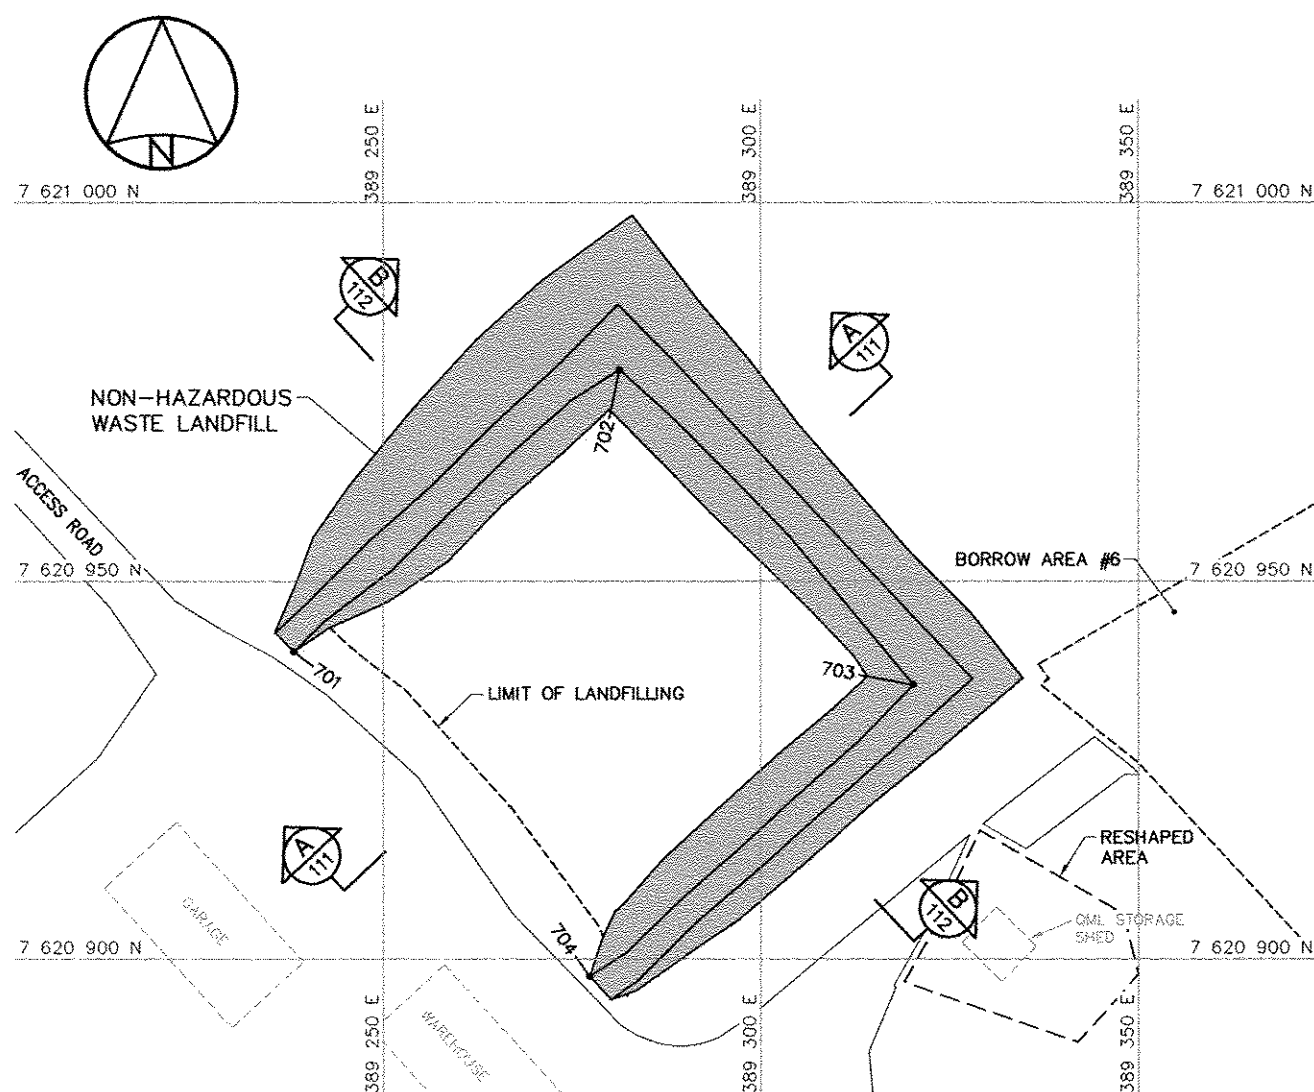

BERM CONSTRUCTION PLAN

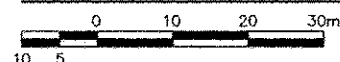


NO.	UTM COORDINATES		ELEV.
	NORTHING	EASTING	
701	7 620 940.7	389 238.2	31.4
702	7 620 977.9	389 281.3	31.4
703	7 620 936.3	389 320.2	32.2
704	7 620 897.7	389 277.3	32.1

NOTE:


FOR DETAILS REGARDING CONFIRMATORY TESTING INFORMATION, REFER TO FINAL REPORT PREPARED BY THE ENVIRONMENTAL SCIENCES GROUP, ROYAL MILITARY COLLEGE.

NOTE:

CONTOURS SHOWN AS DASHED LINES WERE GENERATED FROM SURVEY INFORMATION AND REPRESENT FINISHED GROUND SURFACE FOLLOWING REGRADING OR RESHAPING.

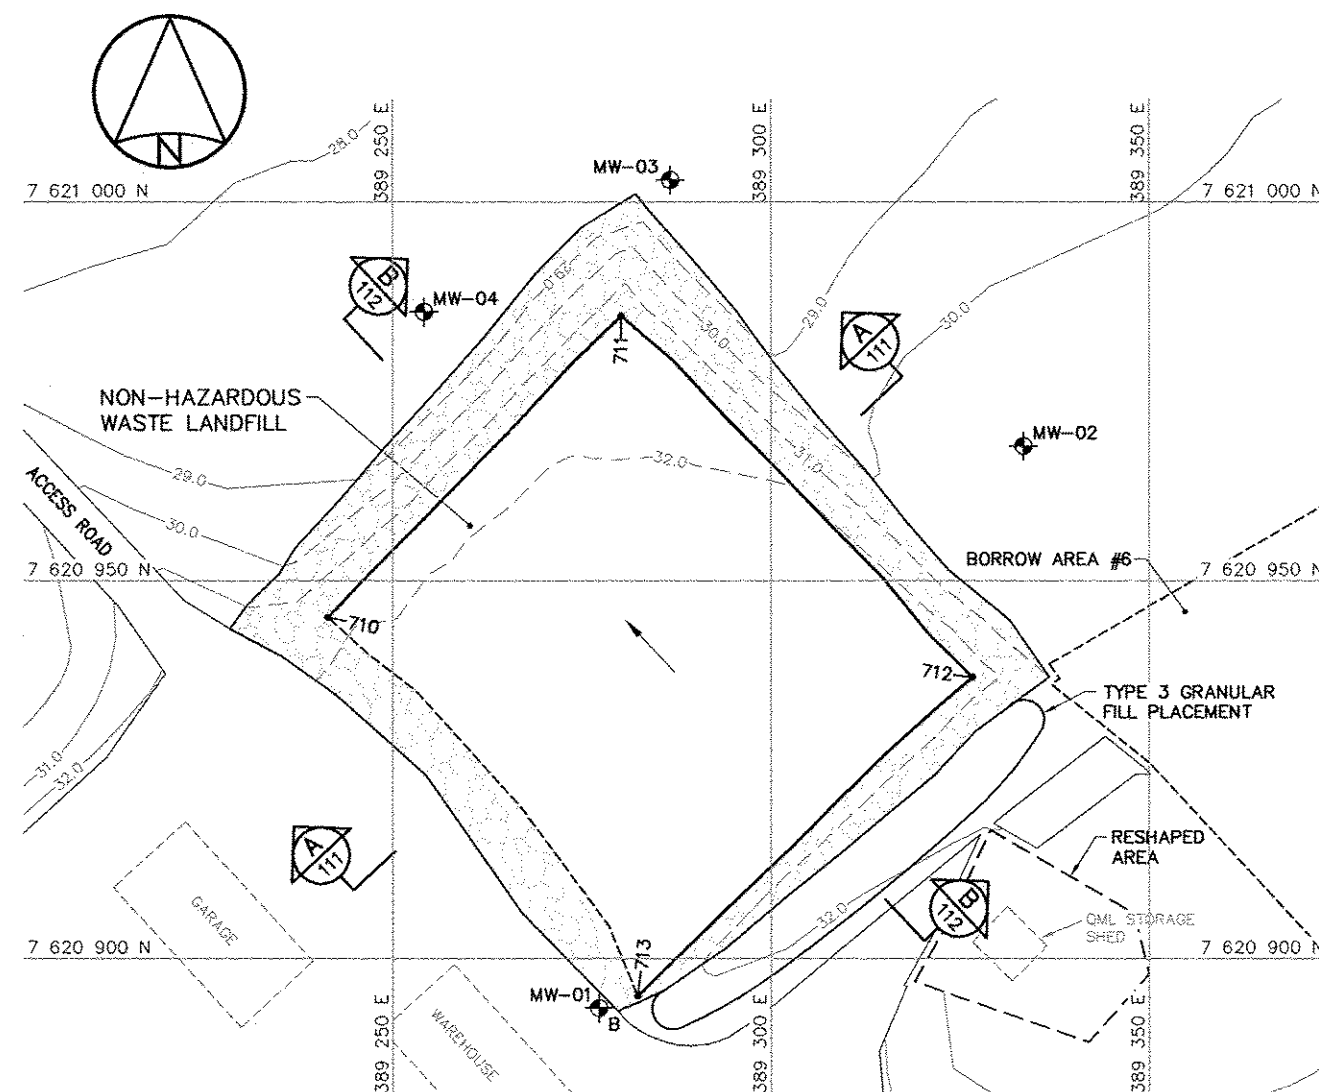


FINAL GRADING/INSTRUMENTATION PLAN

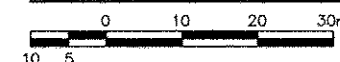


NO.	UTM COORDINATES		ELEV.
	NORTHING	EASTING	
710	7 620 945.2	389 241.4	32.0
711	7 620 985.0	389 280.2	31.6
712	7 620 937.3	389 326.6	32.6
713	7 620 895.1	389 282.3	32.6

NOTE:
COORDINATE POINTS AND ELEVATIONS PROVIDED ARE TO THE FINAL GRADE OF TYPE 1 GRANULAR FILL.

NO.	UTM COORDINATES		ELEV.
	NORTHING	EASTING	
MW-01	7 620 893.5	389 277.2	33.1
MW-02	7 620 967.8	389 333.4	30.2
MW-03	7 621 002.9	389 286.7	28.1
MW-04	7 620 985.5	389 254.1	28.2

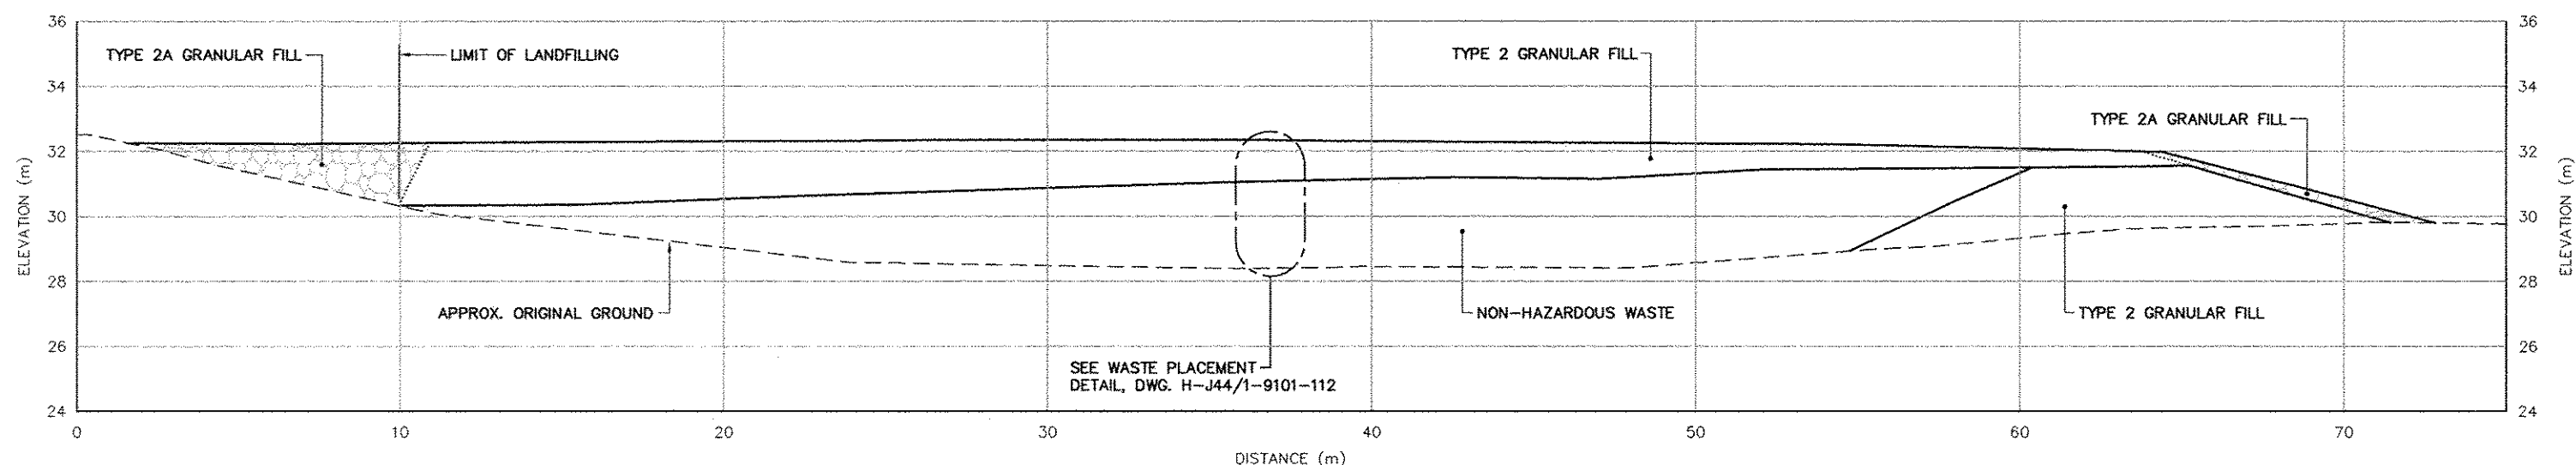

SECTION A-A

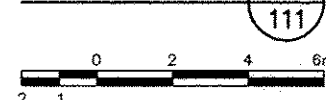

General Notes:

1. ALL ELEVATIONS REFER TO GEODETIC DATUM.
2. ALL DIMENSIONS ARE IN METRES UNLESS NOTED OTHERWISE.

Legend:

- GENERATED BASED ON AS-BUILT SURVEY INFORMATION
- CONSTRUCTED AS PER DESIGN, NO AS-BUILT SURVEY INFORMATION

0	12-07-16	AS-BUILT DRAWING	RRM
No.	DATE	REVISION	REVISION
			APPR.

PERMIT TO PRACTICE
AECOM Canada Ltd.

Signature: *[Signature]*
Date: 5.6.12/12
PERMIT NUMBER: P639
NWT/NY Association of Professional Engineers and Geoscientists

AECOM **HATCH**

SCALE - ECHELLE AS SHOWN

PROJECT - PROJET
CAM-1 JENNY LIND ISLAND

DEW LINE CLEAN UP

© COPYRIGHT
HER MAJESTY THE QUEEN IN RIGHT OF
CANADA 2012, AS REPRESENTED BY THE
MINISTER OF NATIONAL DEFENCE.

TRADE - METIER SITING DATE
2006-09-15





SUBJECT - SUJET

**NON-HAZARDOUS WASTE LANDFILL
SECTION AND DETAIL**

PRODUCTION		CONCURRENCE - ASSENTMENT	
DESIGNED ETUDIE	AHP/RRM	DES OFF AGENT CONCEPT	
DRAWN DESSINE	LJV	SECT HD CHEF SECT	
CHECKED VERIFIE	KMS	DES MGR GEST CONCEPT	
COORDINATION	SMS	REVIEWED - REVU	

DWG. NO. - DESSIN NO.
H-J44/1-9101-112

Canada

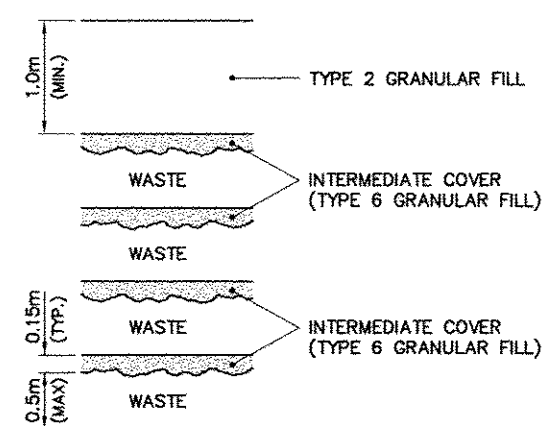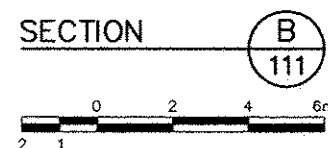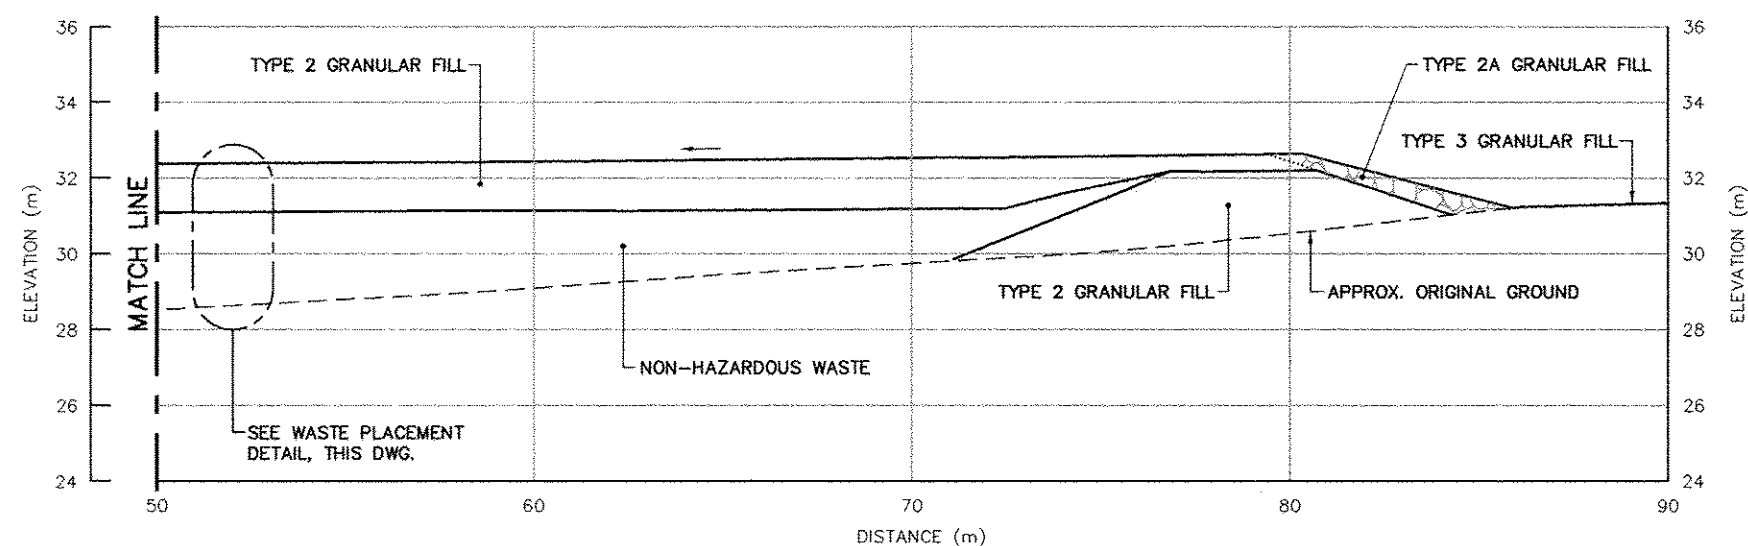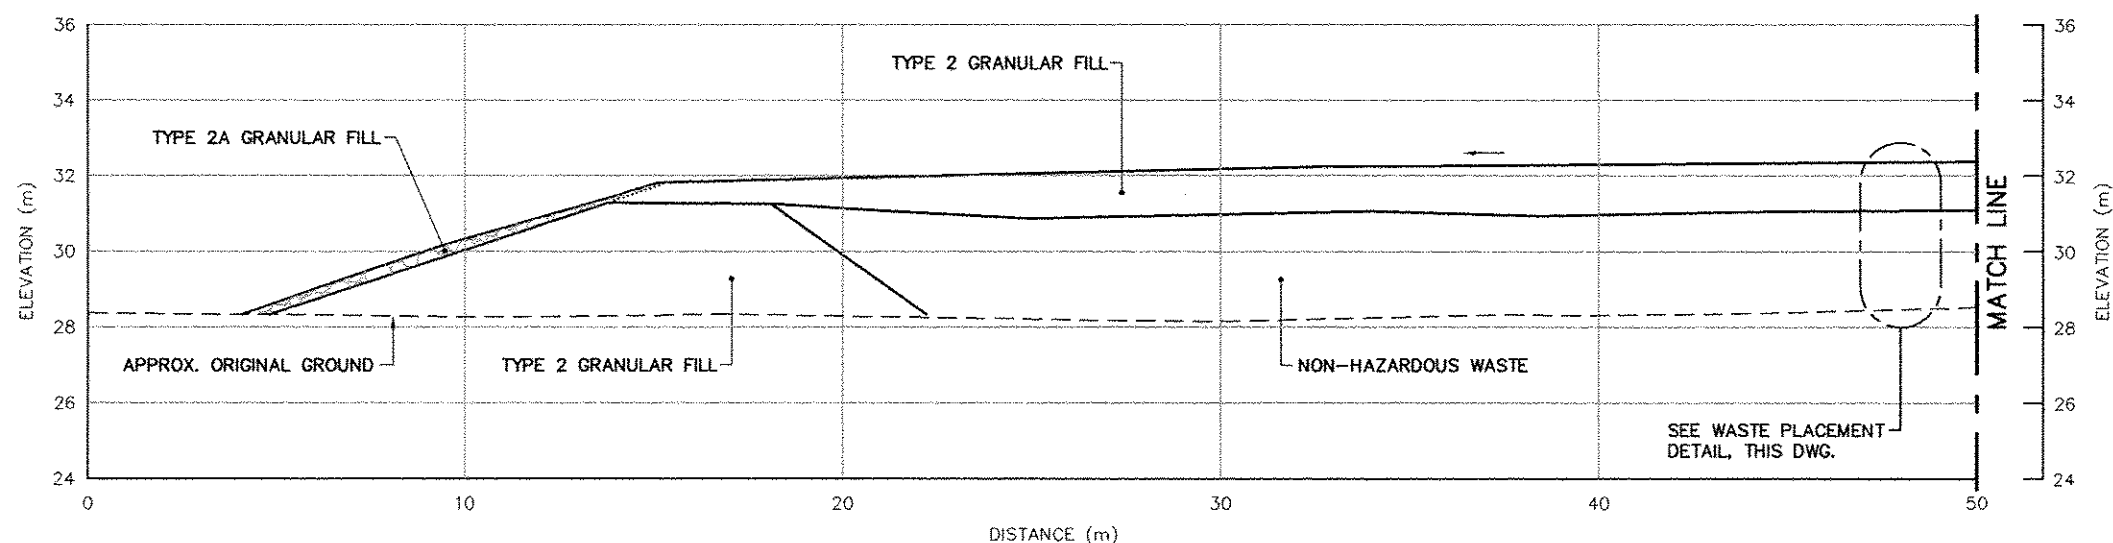

WASTE PLACEMENT DETAIL
SCALE: NTS

General Notes:

1. ALL COORDINATES ARE REFERENCED TO NAD83 (CSRS), UTM ZONE 14N. ALL ELEVATIONS REFER TO GEODETIC DATUM.
2. ALL DIMENSIONS ARE IN METRES UNLESS NOTED OTHERWISE.
3. KEY TRENCH WAS TO EXTEND 1.25m MIN. BELOW EXISTING GROUND. EXCAVATION DEPTH WAS FIELD CONFIRMED BY THE SITE ENGINEER, BASED ON THE PRESENCE OF SOUND BEDROCK OR SATURATED GROUND.
4. FOR MONITORING WELL INSTALLATION DETAILS, SEE DWG. H-J44/1-9101-117.
5. FOR GROUND TEMPERATURE CABLE INSTALLATION DETAIL, SEE DWG. H-J44/1-9101-117.

Legend:

- COMMEMORATIVE PLAQUE LOCATION
- COORDINATE POINT
- MW-06 MONITORING WELL LOCATION (3)
- MW-05 BACKGROUND MONITORING WELL LOCATION (1)
- VT-01 GROUND TEMPERATURE CABLE LOCATION (4)

0	12-07-16	AS-BUILT DRAWING	RRM
No.	DATE	REVISION	APPR.

PERMIT TO PRACTICE
AECOM Canada Ltd.
Signature: [Signature]
Date: July 19/12
PERMIT NUMBER: P639
NWT/NU Association of Professional Engineers and Geoscientists

AECOM **HATCH**

SCALE - ÉCHELLE AS SHOWN

PROJECT - PROJET
CAM-1 JENNY LIND ISLAND

DEW LINE CLEAN UP

© COPYRIGHT
HER MAJESTY THE QUEEN IN RIGHT OF
CANADA 2012, AS REPRESENTED BY THE
MINISTER OF NATIONAL DEFENCE.

TRADE - MÉTIER SITING DATE 2006-09-15


SUBJECT - SUJET

**TIER II DISPOSAL FACILITY
KEY TRENCH EXCAVATION PLAN &
GRADING/INSTRUMENTATION PLAN**


PRODUCTION	CONCURRENCE - ASSENTIMENT
DESIGNED ETUDIE ANP/RRM	DES OFF AGENT CONCEPT
DRAWN DESSINE LJV	SECT HD CHIEF SECT
CHECKED VERIFIÉ KMS	DES MGR GEST CONCEPT
COORDINATION SMB	REVIEWED - REVU

DWG. NO. - DESSIN NO.
H-J44/1-9101-113

Canada

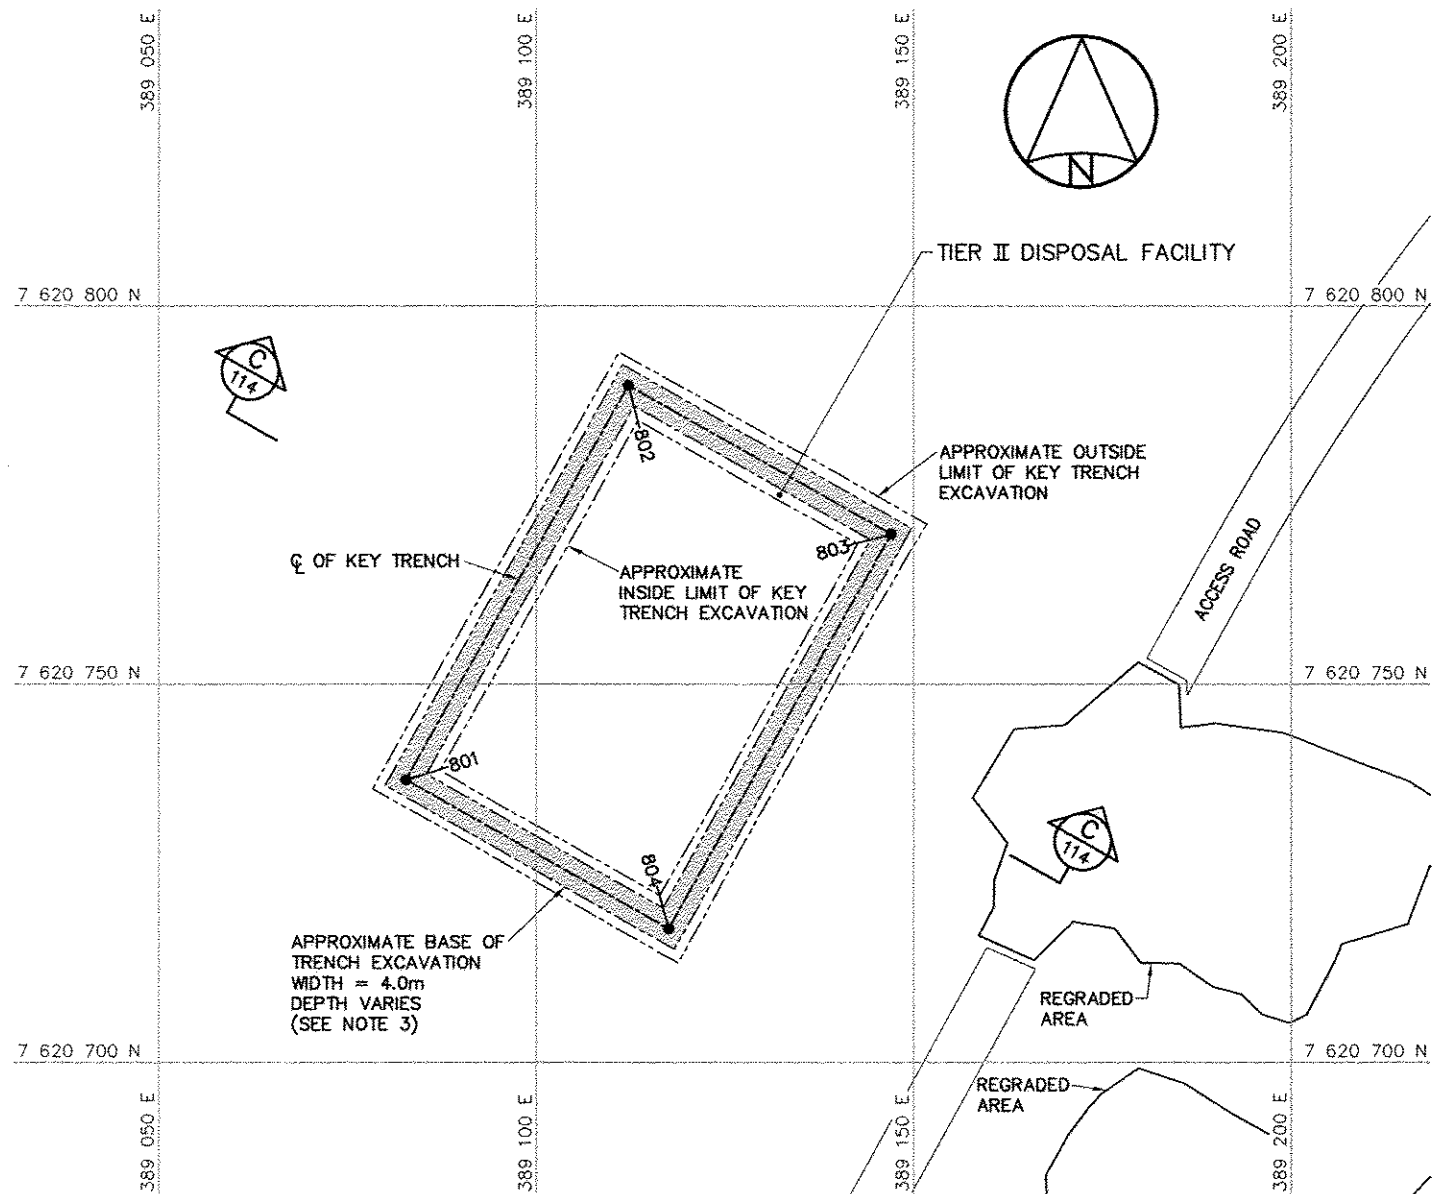

KEY TRENCH EXCAVATION PLAN

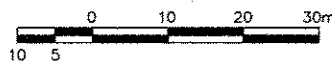


TIER II DISPOSAL FACILITY KEY TRENCH EXCAVATION (DESIGN)*		
NO.	UTM COORDINATES	
	NORTHING	EASTING
801	7 620 737.3	389 082.7
802	7 620 789.5	389 112.2
803	7 620 769.9	389 147.0
804	7 620 717.6	389 117.5


* NOTE: NO AS-BUILT SURVEY INFORMATION.

NOTE:
FOR DETAILS REGARDING CONFIRMATORY
TESTING INFORMATION, REFER TO FINAL
REPORT PREPARED BY THE ENVIRONMENTAL
SCIENCES GROUP, ROYAL MILITARY COLLEGE.

NOTE:
CONTOURS SHOWN AS DASHED LINES WERE
GENERATED FROM SURVEY INFORMATION
AND REPRESENT FINISHED GROUND SURFACE
FOLLOWING REGRAIDING OR RESHAPING.

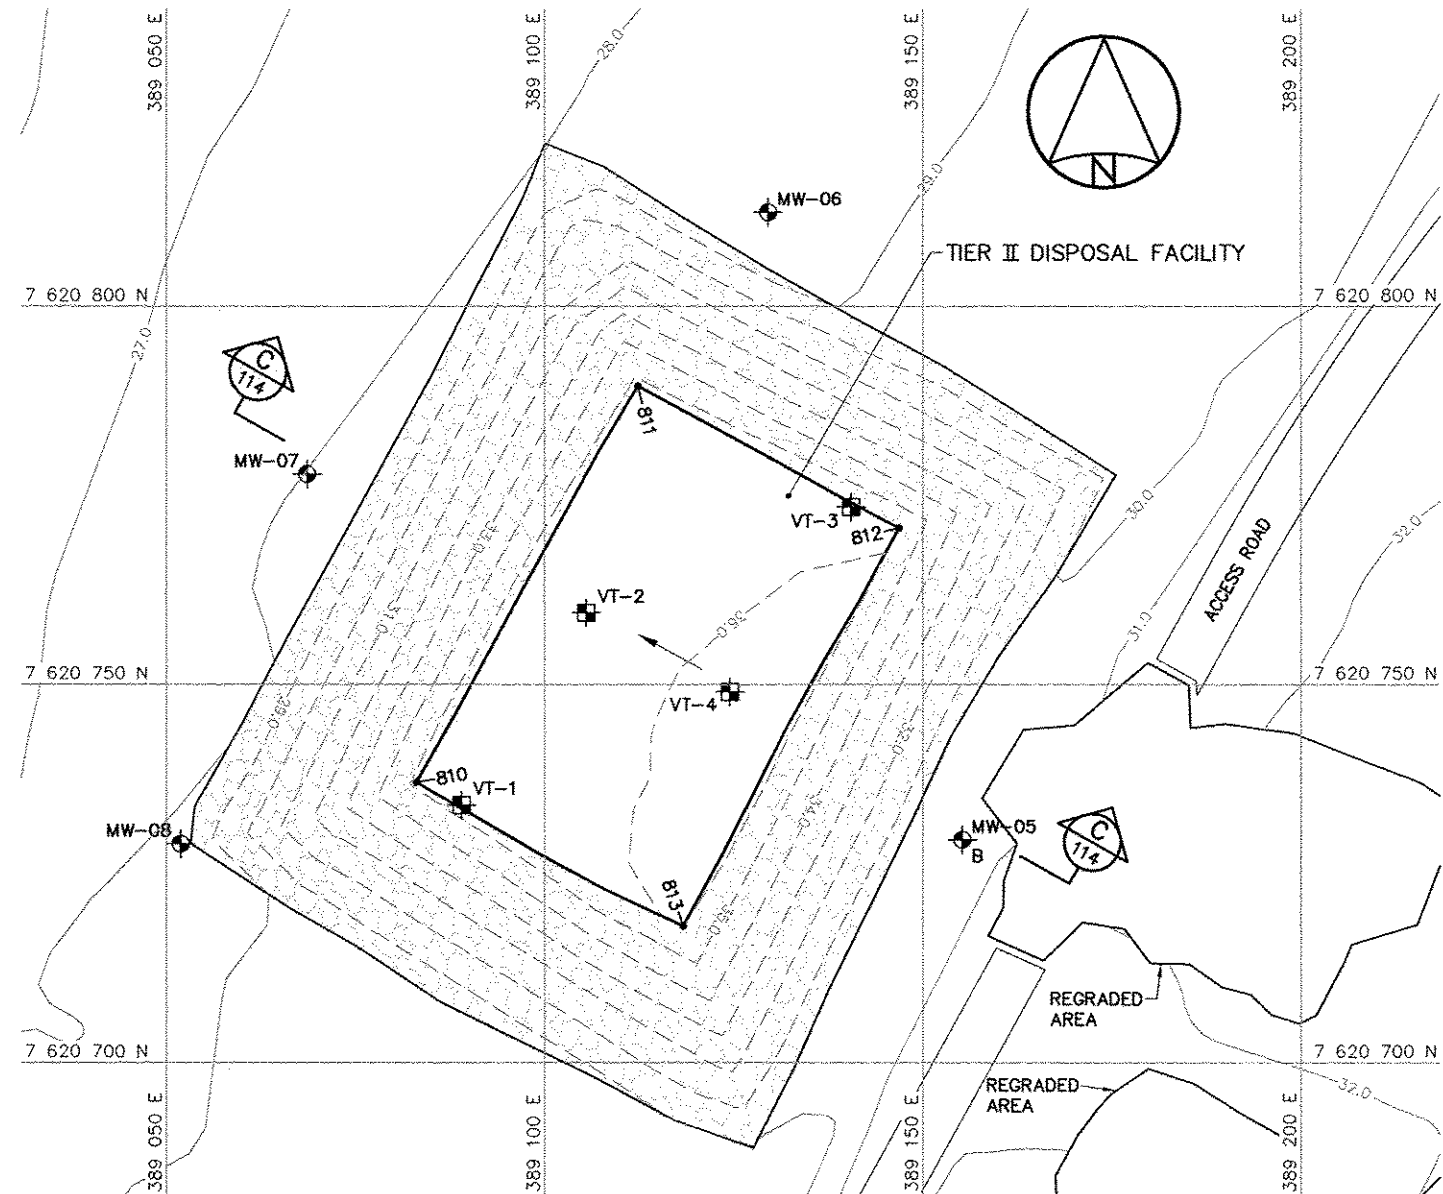

FINAL GRADING/INSTRUMENTATION PLAN

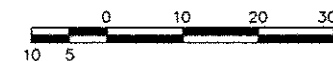

TIER II DISPOSAL FACILITY FINAL GRADING (AS-BUILT)			
NO.	UTM COORDINATES		ELEV.
	NORTHING	EASTING	
810	7 620 737.0	389 083.0	35.2
811	7 620 789.5	389 112.3	35.3
812	7 620 770.7	389 146.8	35.9
813	7 620 718.0	389 118.3	36.0

NOTE:
COORDINATE POINTS AND ELEVATIONS PROVIDED ARE
TO THE FINAL GRADE OF TYPE 1 GRANULAR FILL.

TIER II DISPOSAL FACILITY MONITORING WELLS (AS-BUILT)			
NO.	UTM COORDINATES		ELEV.
	NORTHING	EASTING	
MW-05	7 620 729.4	389 155.2	30.7
MW-06	7 620 812.4	389 129.5	28.5
MW-07	7 620 777.8	389 068.6	27.8
MW-08	7 620 728.9	389 051.9	28.1

TIER II DISPOSAL FACILITY GROUND TEMPERATURE CABLES (AS-BUILT)			
NO.	UTM COORDINATES		ELEV.
	NORTHING	EASTING	
VT-01	7 620 734.0	389 089.0	35.3
VT-02	7 620 759.5	389 105.5	35.7
VT-03	7 620 773.5	389 140.5	35.9
VT-04	7 620 749.0	389 124.5	36.2

General Notes:

1. ALL ELEVATIONS REFER TO GEODETIC DATUM.
2. ALL DIMENSIONS ARE IN METRES UNLESS NOTED OTHERWISE.
3. KEY TRENCH WAS TO EXTEND 1.25m MIN. BELOW EXISTING GROUND. EXCAVATION DEPTH WAS FIELD CONFIRMED BY THE SITE ENGINEER, BASED ON THE PRESENCE OF SOUND BEDROCK OR SATURATED GROUND.

Legend:

- GENERATED BASED ON AS-BUILT SURVEY INFORMATION
- CONSTRUCTED AS PER DESIGN, NO AS-BUILT SURVEY INFORMATION

0	12-07-16	AS-BUILT DRAWING	RRM
No.	DATE	REVISION	APPR.



PERMIT TO PRACTICE
AECOM Canada Ltd.
Signature: *[Signature]*
Date: *July 19/12*
PERMIT NUMBER: P639
NWT/NR Association of Professional Engineers and Geoscientists

AECOM HATCH

SCALE -- ECHELLE AS SHOWN

PROJECT -- PROJET
CAM-1 JENNY LIND ISLAND




DEW LINE CLEAN UP
 © COPYRIGHT
 HER MAJESTY THE QUEEN IN RIGHT OF CANADA 2012, AS REPRESENTED BY THE MINISTER OF NATIONAL DEFENCE.

TRADE -- METIER SITING
 DATE 2006-09-15
 SUBJECT -- SUJET


**TIER II DISPOSAL FACILITY
CROSS SECTION AND DETAIL**

PRODUCTION	CONCURRENCE -- ASSENTIMENT
DESIGNED ETUDIE ANP/RRM	DES OFF AGENT CONCEPT
DRAWN DESSINE LJP	SECT HD CHEF SECT
CHECKED VERIFIE KMS	DES MOR GEST CONCEPT
COORDINATION SMS	REVIEWED -- REVU

DWG. NO. -- DESSIN NO.
H-J44/1-9101-114

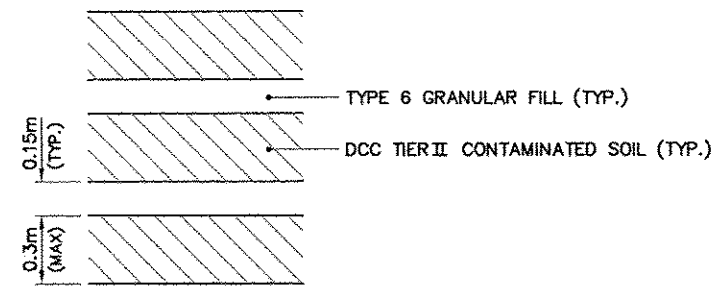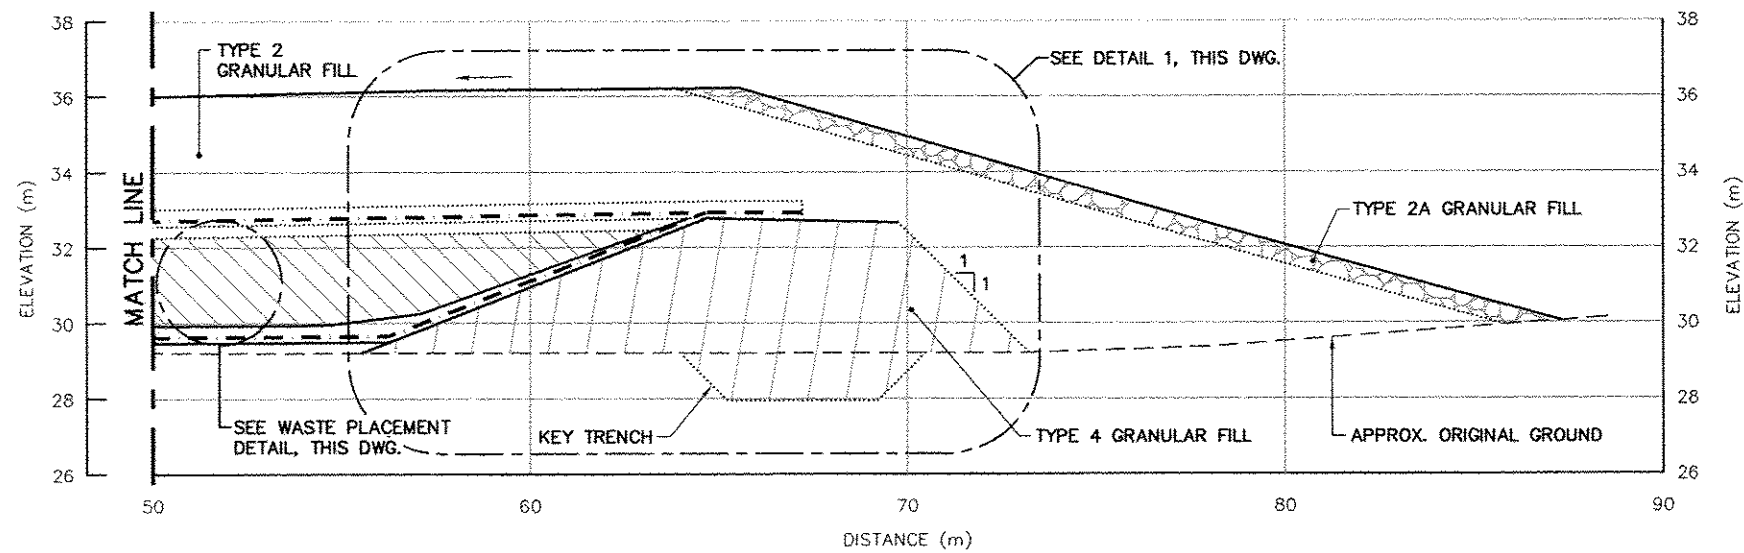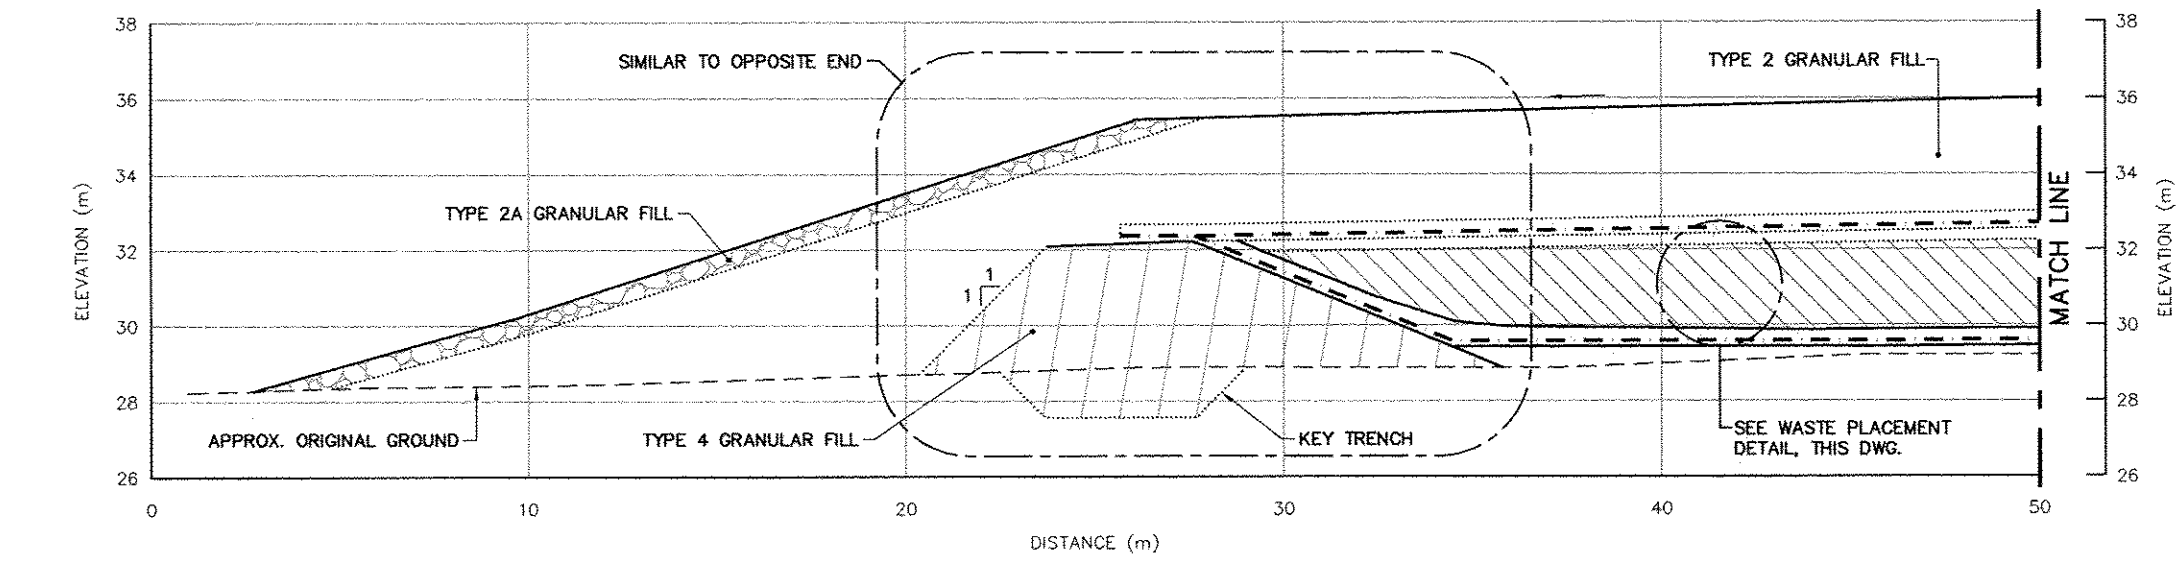


WASTE PLACEMENT DETAIL
SCALE: NTS

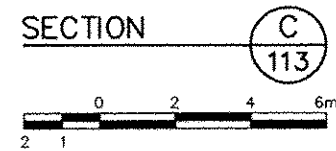


NOTE:
LINERS WERE IN CONTACT WITH EACH OTHER OVER TOP OF BERM AND PERIMETER WAS WELDED.

NOTE:
GEOMEMBRANE LINERS WERE PROTECTED DURING INTERIM CONSTRUCTION.

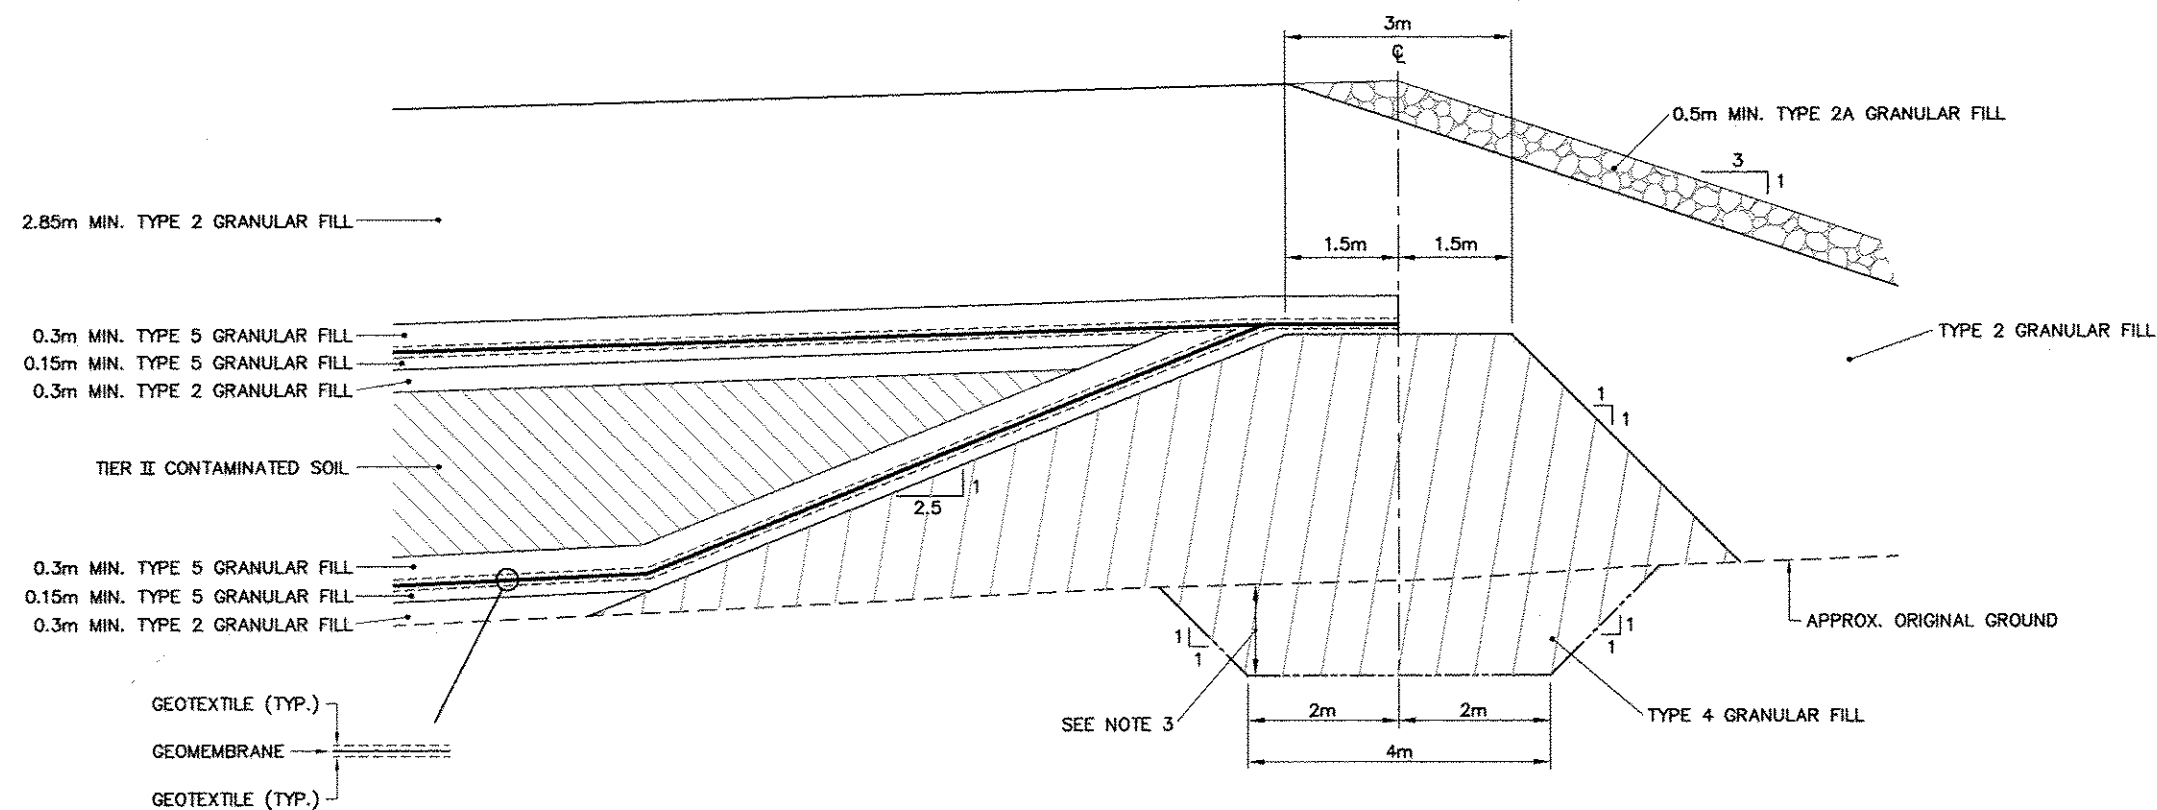


DETAIL
SCALE: NTS


TABLE 1 GROUND TEMPERATURE CABLE INSTALLATION	
INSTRUMENT No.	APPROXIMATE DEPTH BELOW FINAL GRADE (m)
TIER II DISPOSAL FACILITY	
VT-1	8.3
VT-2	5.3
VT-3	8.3
VT-4	5.5

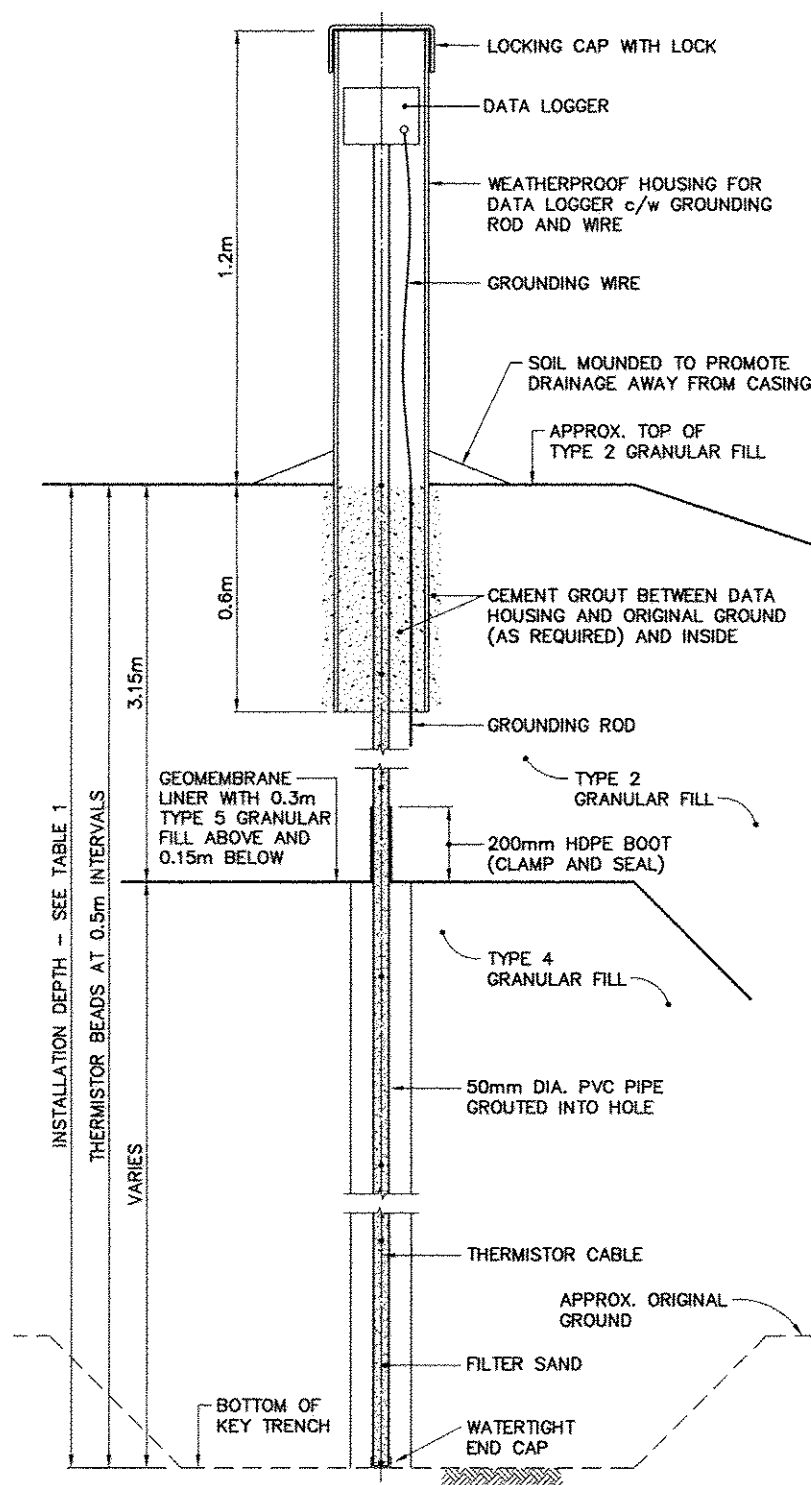

TYPICAL GROUND TEMPERATURE CABLE
SCALE: NTS

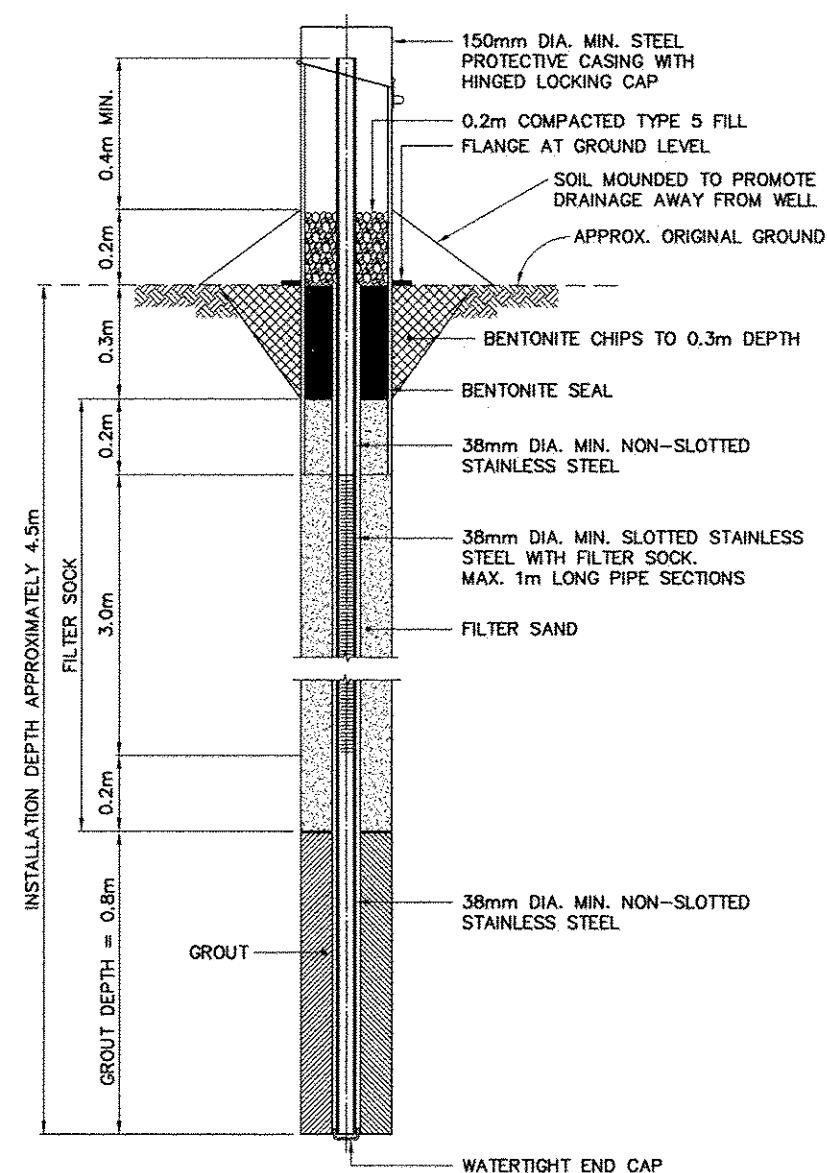


TYPICAL MONITORING WELL
SCALE: NTS
FOR BEDROCK DEPTH > 0.7m
INCLUDING TYPICAL BACKGROUND MONITORING WELL INSTALLATION

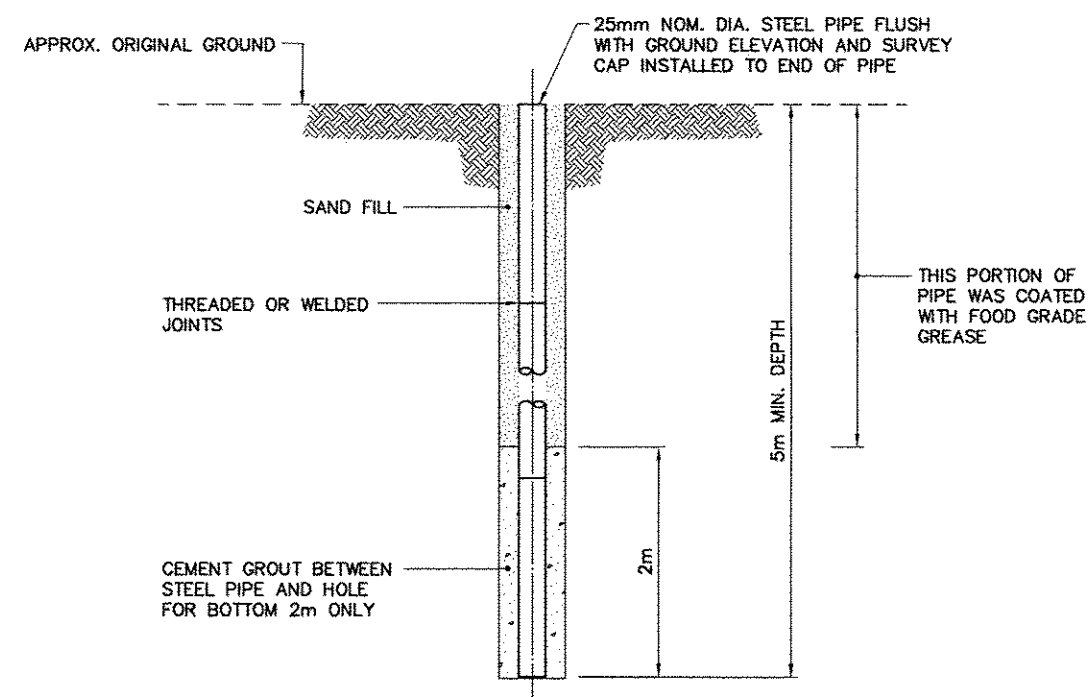

NOTE:
4 PERMANENT SURVEY CONTROL
MONUMENTS INSTALLED.

TYPICAL PERMANENT SURVEY CONTROL MONUMENT

SCALE: NTS
ALSO KNOWN AS PERMANENT BENCHMARK

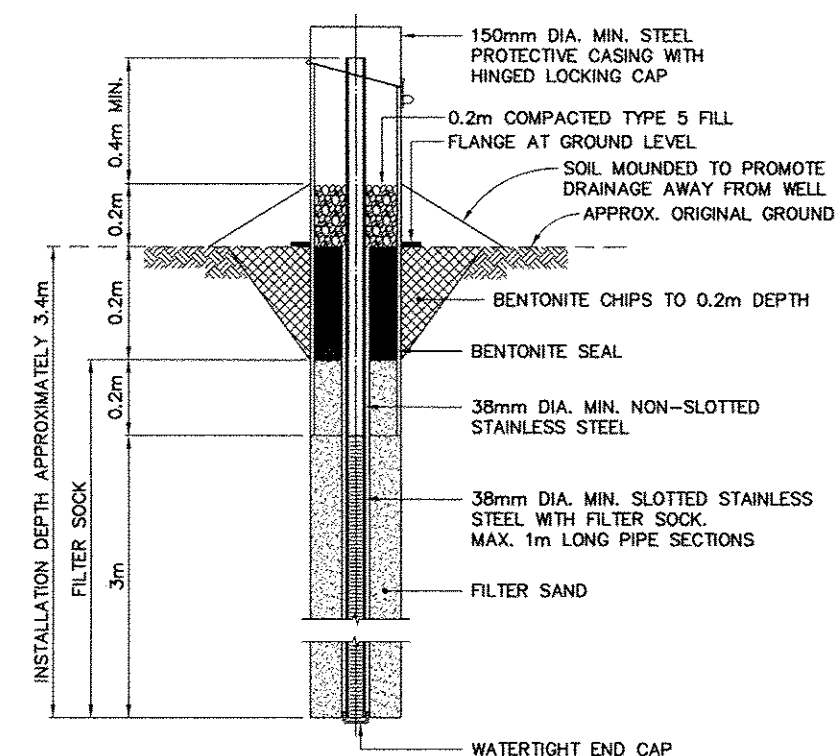

TYPICAL MONITORING WELL
SCALE: NTS
FOR BEDROCK DEPTH < 0.7m
INCLUDING TYPICAL BACKGROUND MONITORING WELL INSTALLATION

General Notes:

1. ALL DIMENSIONS ARE IN METRES UNLESS NOTED OTHERWISE.

0	12-07-16	AS-BUILT DRAWING	RRM
---	----------	------------------	-----

No.	DATE	REVISION	REVISION	APPR.
-----	------	----------	----------	-------

		PERMIT TO PRACTICE AECOM Canada Ltd. Signature: <i>[Signature]</i> Date: <i>July 19/12</i> PERMIT NUMBER: P639 NWT/NTU Association of Professional Engineers and Geoscientists
--	--	--

AECOM HATCH

SCALE - ECHELLE AS SHOWN

PROJECT - PROJET
CAM-1 JENNY LIND ISLAND

DEW LINE CLEAN UP

© COPYRIGHT
HER MAJESTY THE QUEEN IN RIGHT OF
CANADA 2012, AS REPRESENTED BY THE
MINISTER OF NATIONAL DEFENCE.

TRADE - METIER	SITING	DATE
SUBJECT - SUJET		2006-09-15

MISCELLANEOUS DETAILS
SHEET 2

DESIGNED	ETUDIE	DES OFF
ANP/RRM		AGENT CONCEPT
DRAWN	DESSINE	SECT HD
LJV		CHEF SECT
CHECKED	VERIFIE	DES MGR
KMS		GEST CONCEPT
COORDINATION	COORDINATION	REVIEWED - REVU
SMS		

DWG. NO. - DESSIN NO.
H-J44/1-9101-117

General Notes:

1. ALL DIMENSIONS ARE IN METRES UNLESS NOTED OTHERWISE.
2. ALL STRUCTURES DESIGNATED FOR DEMOLITION WERE DEMOLISHED TO TOP OF CONCRETE FOUNDATIONS UNLESS NOTED OTHERWISE.
3. ALL POLES, INCLUDING GUY WIRES, WERE REMOVED UNLESS NOTED OTHERWISE.
4. ALL ELECTRICAL CABLES AND POL LINES DESIGNATED FOR DEMOLITION WERE REMOVED.
5. ALL SHORT RANGE RADAR (SRR) FACILITIES WERE OPERATIONAL. THESE INCLUDE FUEL STORAGE TANKS AND PIPELINES NOT SCHEDULED FOR DEMOLITION.
6. ALL CULVERTS WERE REMOVED.
7. ALL CONCRETE PADS REMAINING WERE REGRADED, AS PER TYPICAL DETAIL, SEE DWG. H-J44/1-9101-201.
8. POL LINES AND POWER/ COMMUNICATION CABLES LOCATIONS ARE APPROXIMATE ONLY. SOME ABOVE GROUND POL LINES AND CABLES THAT WERE REMOVED MAY NOT BE SHOWN.

Legend:

- DEMOLISHED
- UTILITY POLE REMOVED
- BODY OF WATER

0	12-07-16	AS-BUILT DRAWING	RRM
No.	DATE	REVISION	APPR.

PERMIT TO PRACTICE
AECOM Canada Ltd.
Signature: *[Signature]*
Date: *July 19/12*
PERMIT NUMBER: P639
NWT/NU Association of Professional Engineers and Geoscientists



SCALE - ECHELLE 20 10 0 20 40 60m

PROJECT - PROJET
CAM-1 JENNY LIND ISLAND

DEW LINE CLEAN UP
© COPYRIGHT
HER MAJESTY THE QUEEN IN RIGHT OF
CANADA 2012, AS REPRESENTED BY THE
MINISTER OF NATIONAL DEFENCE.

TRADE - METIER **STRUCTURAL** DATE **2006-09-15**
SUBJECT - SUJET

**AIRSTRIIP AREA AND BEACH AREA
DEMOLITION SITE PLAN**

PRODUCTION		CONCURRENCE - ASSENTMENT	
DESIGNED ETUDIE	ANP/RRM	DES OFF AGENT CONCEPT	
DRAWN DESSINE	LJV	SECT HD CHIEF SECT	
CHECKED VERIFIE	KMS	DES MGR GEST CONCEPT	
COORDINATION	SMS	REVIEWED - REVU	

DWG. NO. - DESSIN NO.
H-J44/1-9101-202

Canada

