



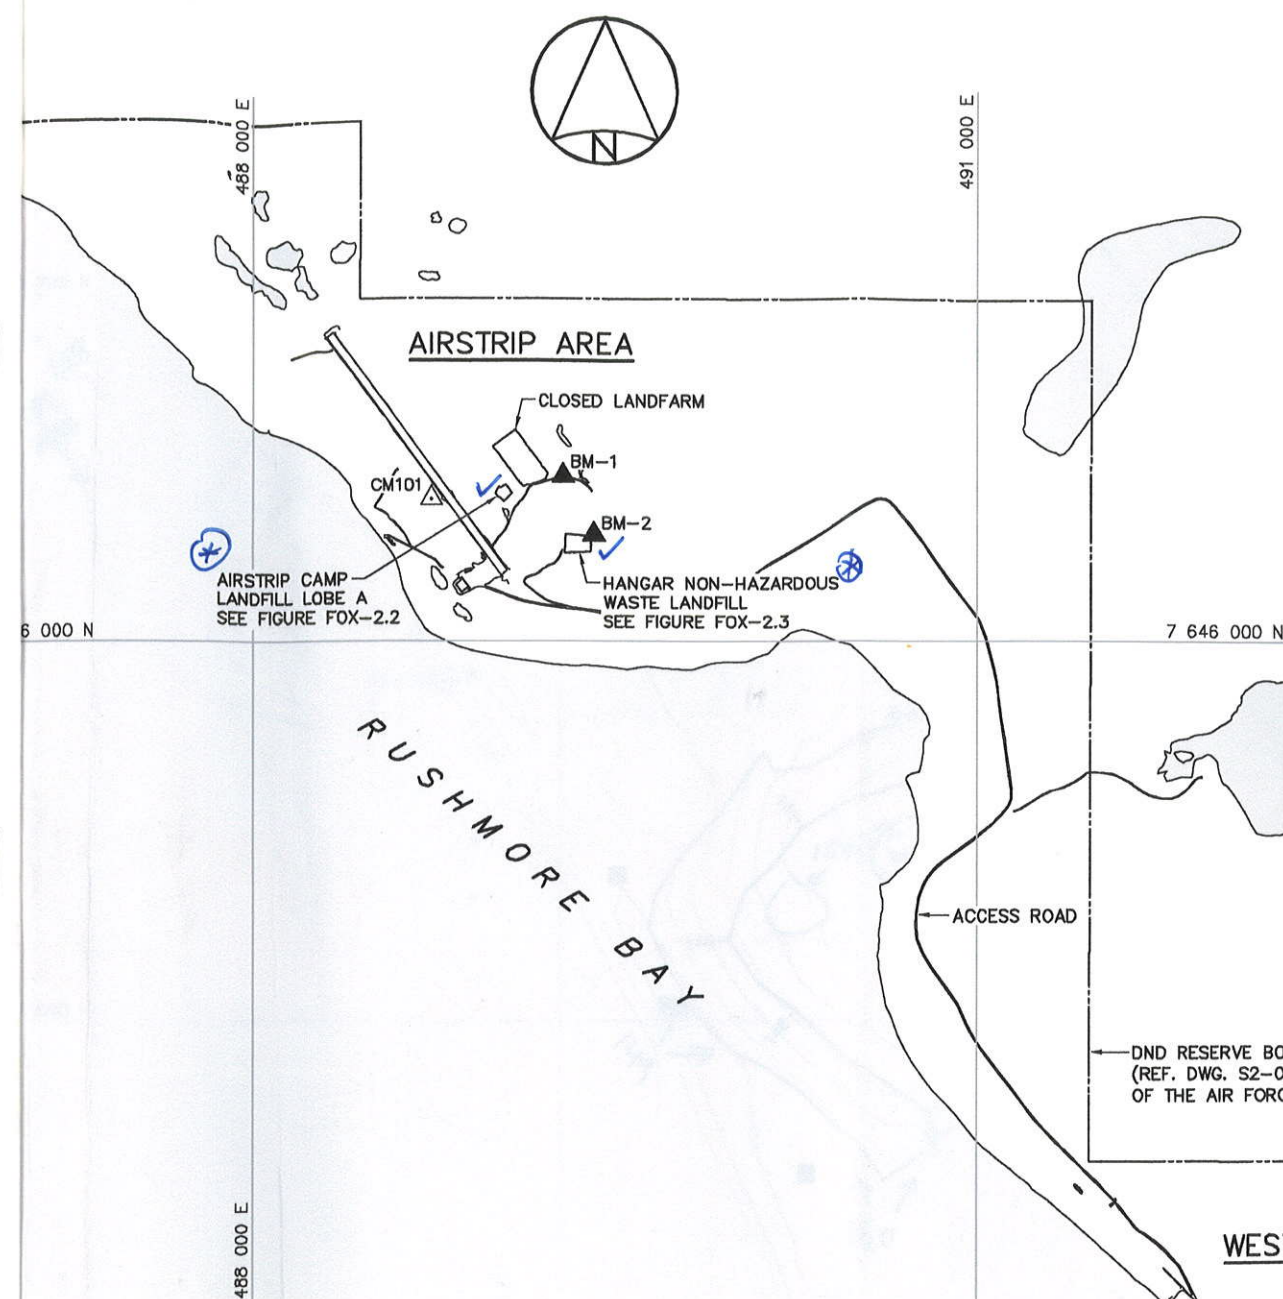

SURVEY CONTROL MONUMENTS				
NO.	UTM COORDINATES		ELEV.	DESCRIPTION
	NORTHING	EASTING		
CM1	7 643 282.694	494 194.689	150.604	FOX-2 BASELINE STA. 0+00
CM2	7 643 154.373	494 195.664	155.980	FOX-2 BASELINE STA. N/A
CM3	7 643 035.836	494 196.504	158.975	FOX-2 BASELINE STA. N/A
CM101	7 646 589.787	488 746.333	12.088	FOX-2 BASELINE STA. 12+00

OTE: BASELINE STATIONS SHOWN ARE IN IMPERIAL UNITS.

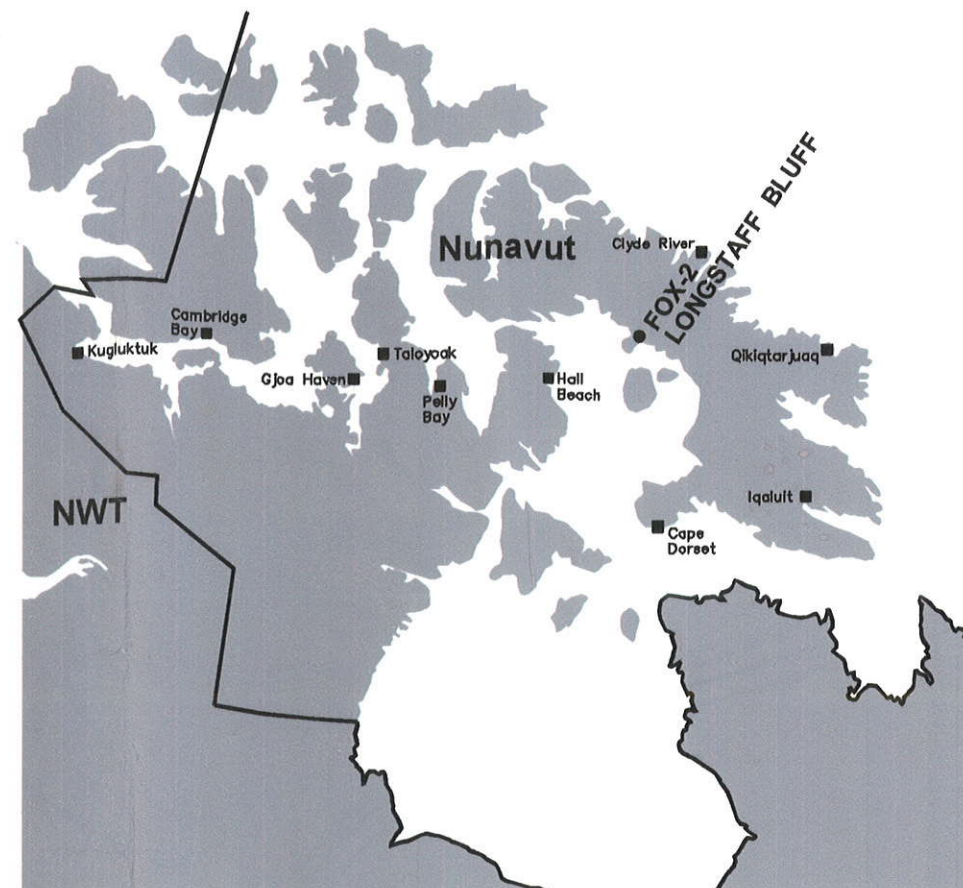

LOCATION OF LONGSTAFF BLUFF WITHIN NUNAVUT TERRITORY
SCALE: NTS


- GENERAL NOTES:**
1. ALL COORDINATES ARE REFERENCED TO NAD83 (CSRS), UTM ZONE 18N. ALL ELEVATIONS REFER TO GEODETIC DATUM.
 2. ALL DIMENSIONS ARE IN METRES UNLESS NOTED OTHERWISE.

- LEGEND:**
- △ CM1 SURVEY CONTROL MONUMENT (4)
 - ▲ BM-1 APPROXIMATE PERMANENT BENCHMARK LOCATION (5)
 - APPROXIMATE LOCATION OF PROPERTY BOUNDARY
 - BODY OF WATER

RECORD DRAWING
NOT FOR CONSTRUCTION

0 300 600 m SCALE 1:30000

**DEW LINE CLEAN UP
LANDFILL MONITORING PLAN**
FOX-2 LONGSTAFF BLUFF
LOCATION PLAN
FIGURE FOX-2.1

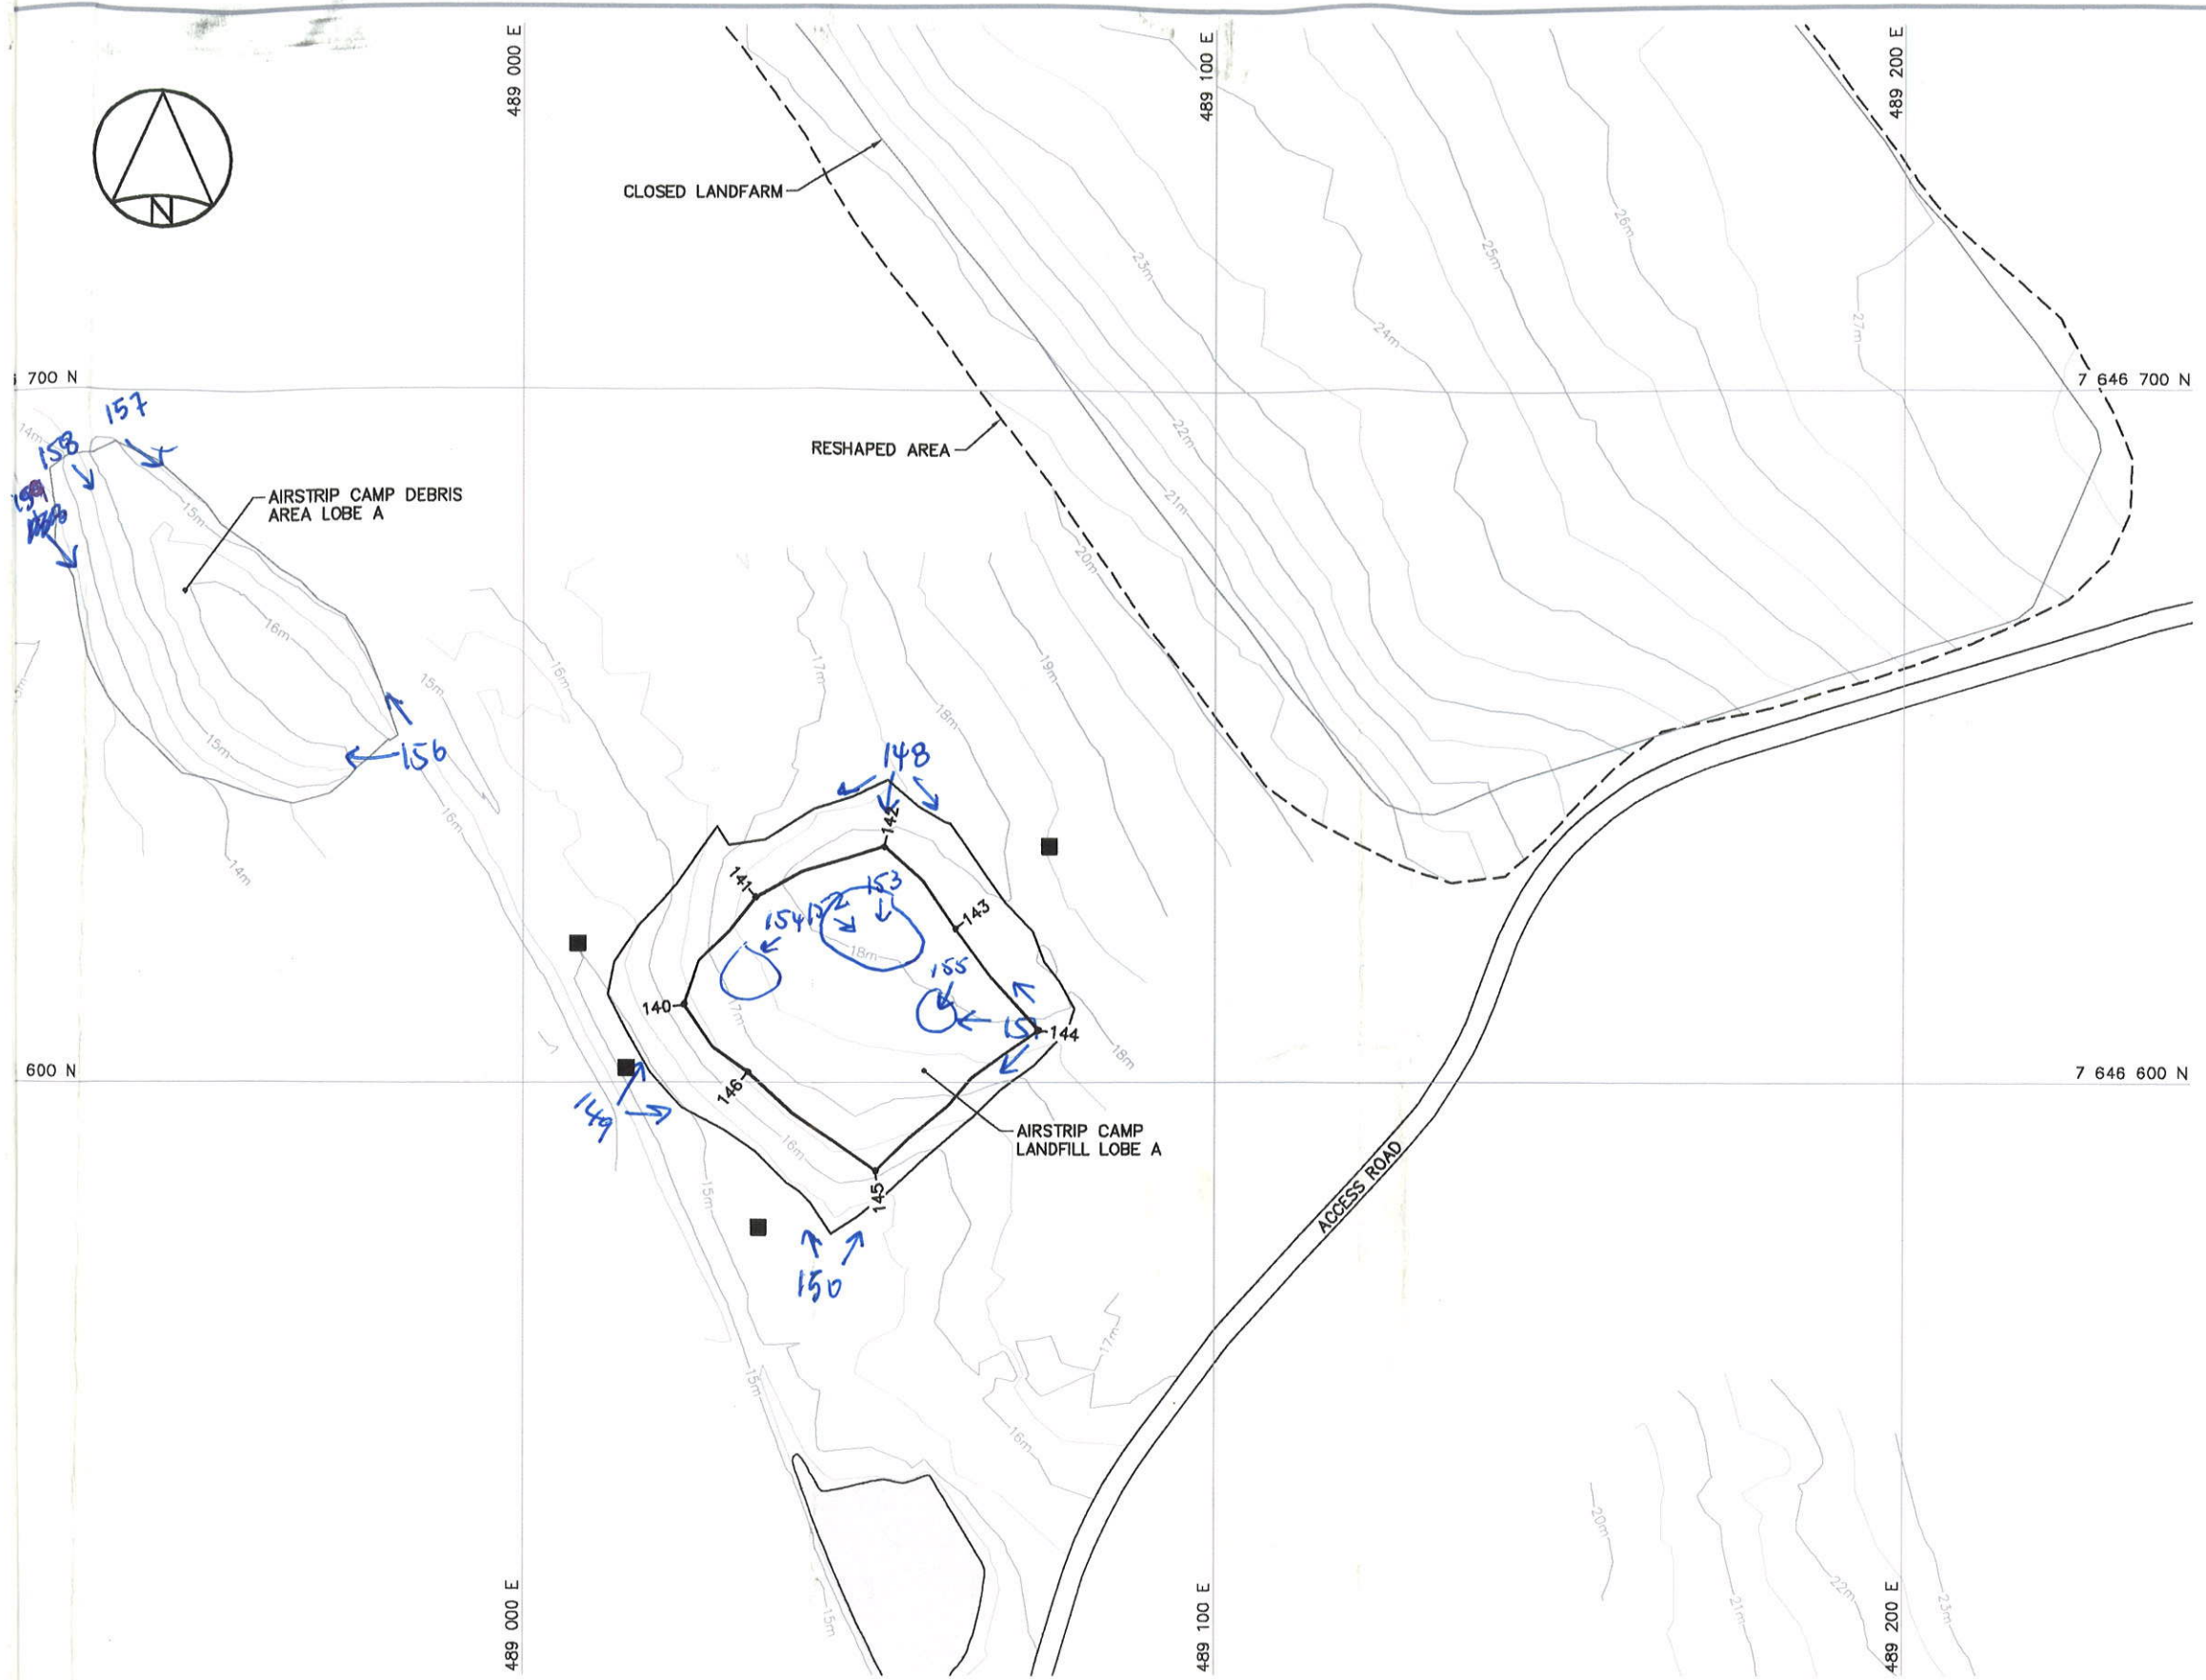


- GENERAL NOTES:
1. ALL COORDINATES ARE REFERENCED TO NAD83 (CSRS), UTM ZONE 18N. ALL ELEVATIONS REFER TO GEODETIC DATUM.
 2. ALL DIMENSIONS ARE IN METRES UNLESS NOTED OTHERWISE.

- LEGEND:
- 140 COORDINATE POINT
 - MONITORING SOIL SAMPLE LOCATION (4)
 - BODY OF WATER


AIRSTRIp CAMP LANDFILL LOBE A REGRADED (AS-BUILT)			
NO.	UTM COORDINATES		ELEV.
	NORTHING	EASTING	
140	7 646 611.2	489 023.2	16.4
141	7 646 626.8	489 033.5	17.8
142	7 646 633.9	489 052.3	18.2
143	7 646 622.1	489 062.5	18.3
144	7 646 607.4	489 074.5	17.9
145	7 646 587.2	489 051.1	16.1
146	7 646 601.4	489 032.4	16.7

RECORD DRAWING
NOT FOR CONSTRUCTION

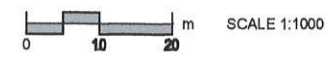

DEW LINE CLEAN UP
LANDFILL MONITORING PLAN
FOX-2 LONGSTAFF BLUFF

**AIRSTRIp CAMP
LANDFILL LOBE A**
FIGURE FOX-2.2

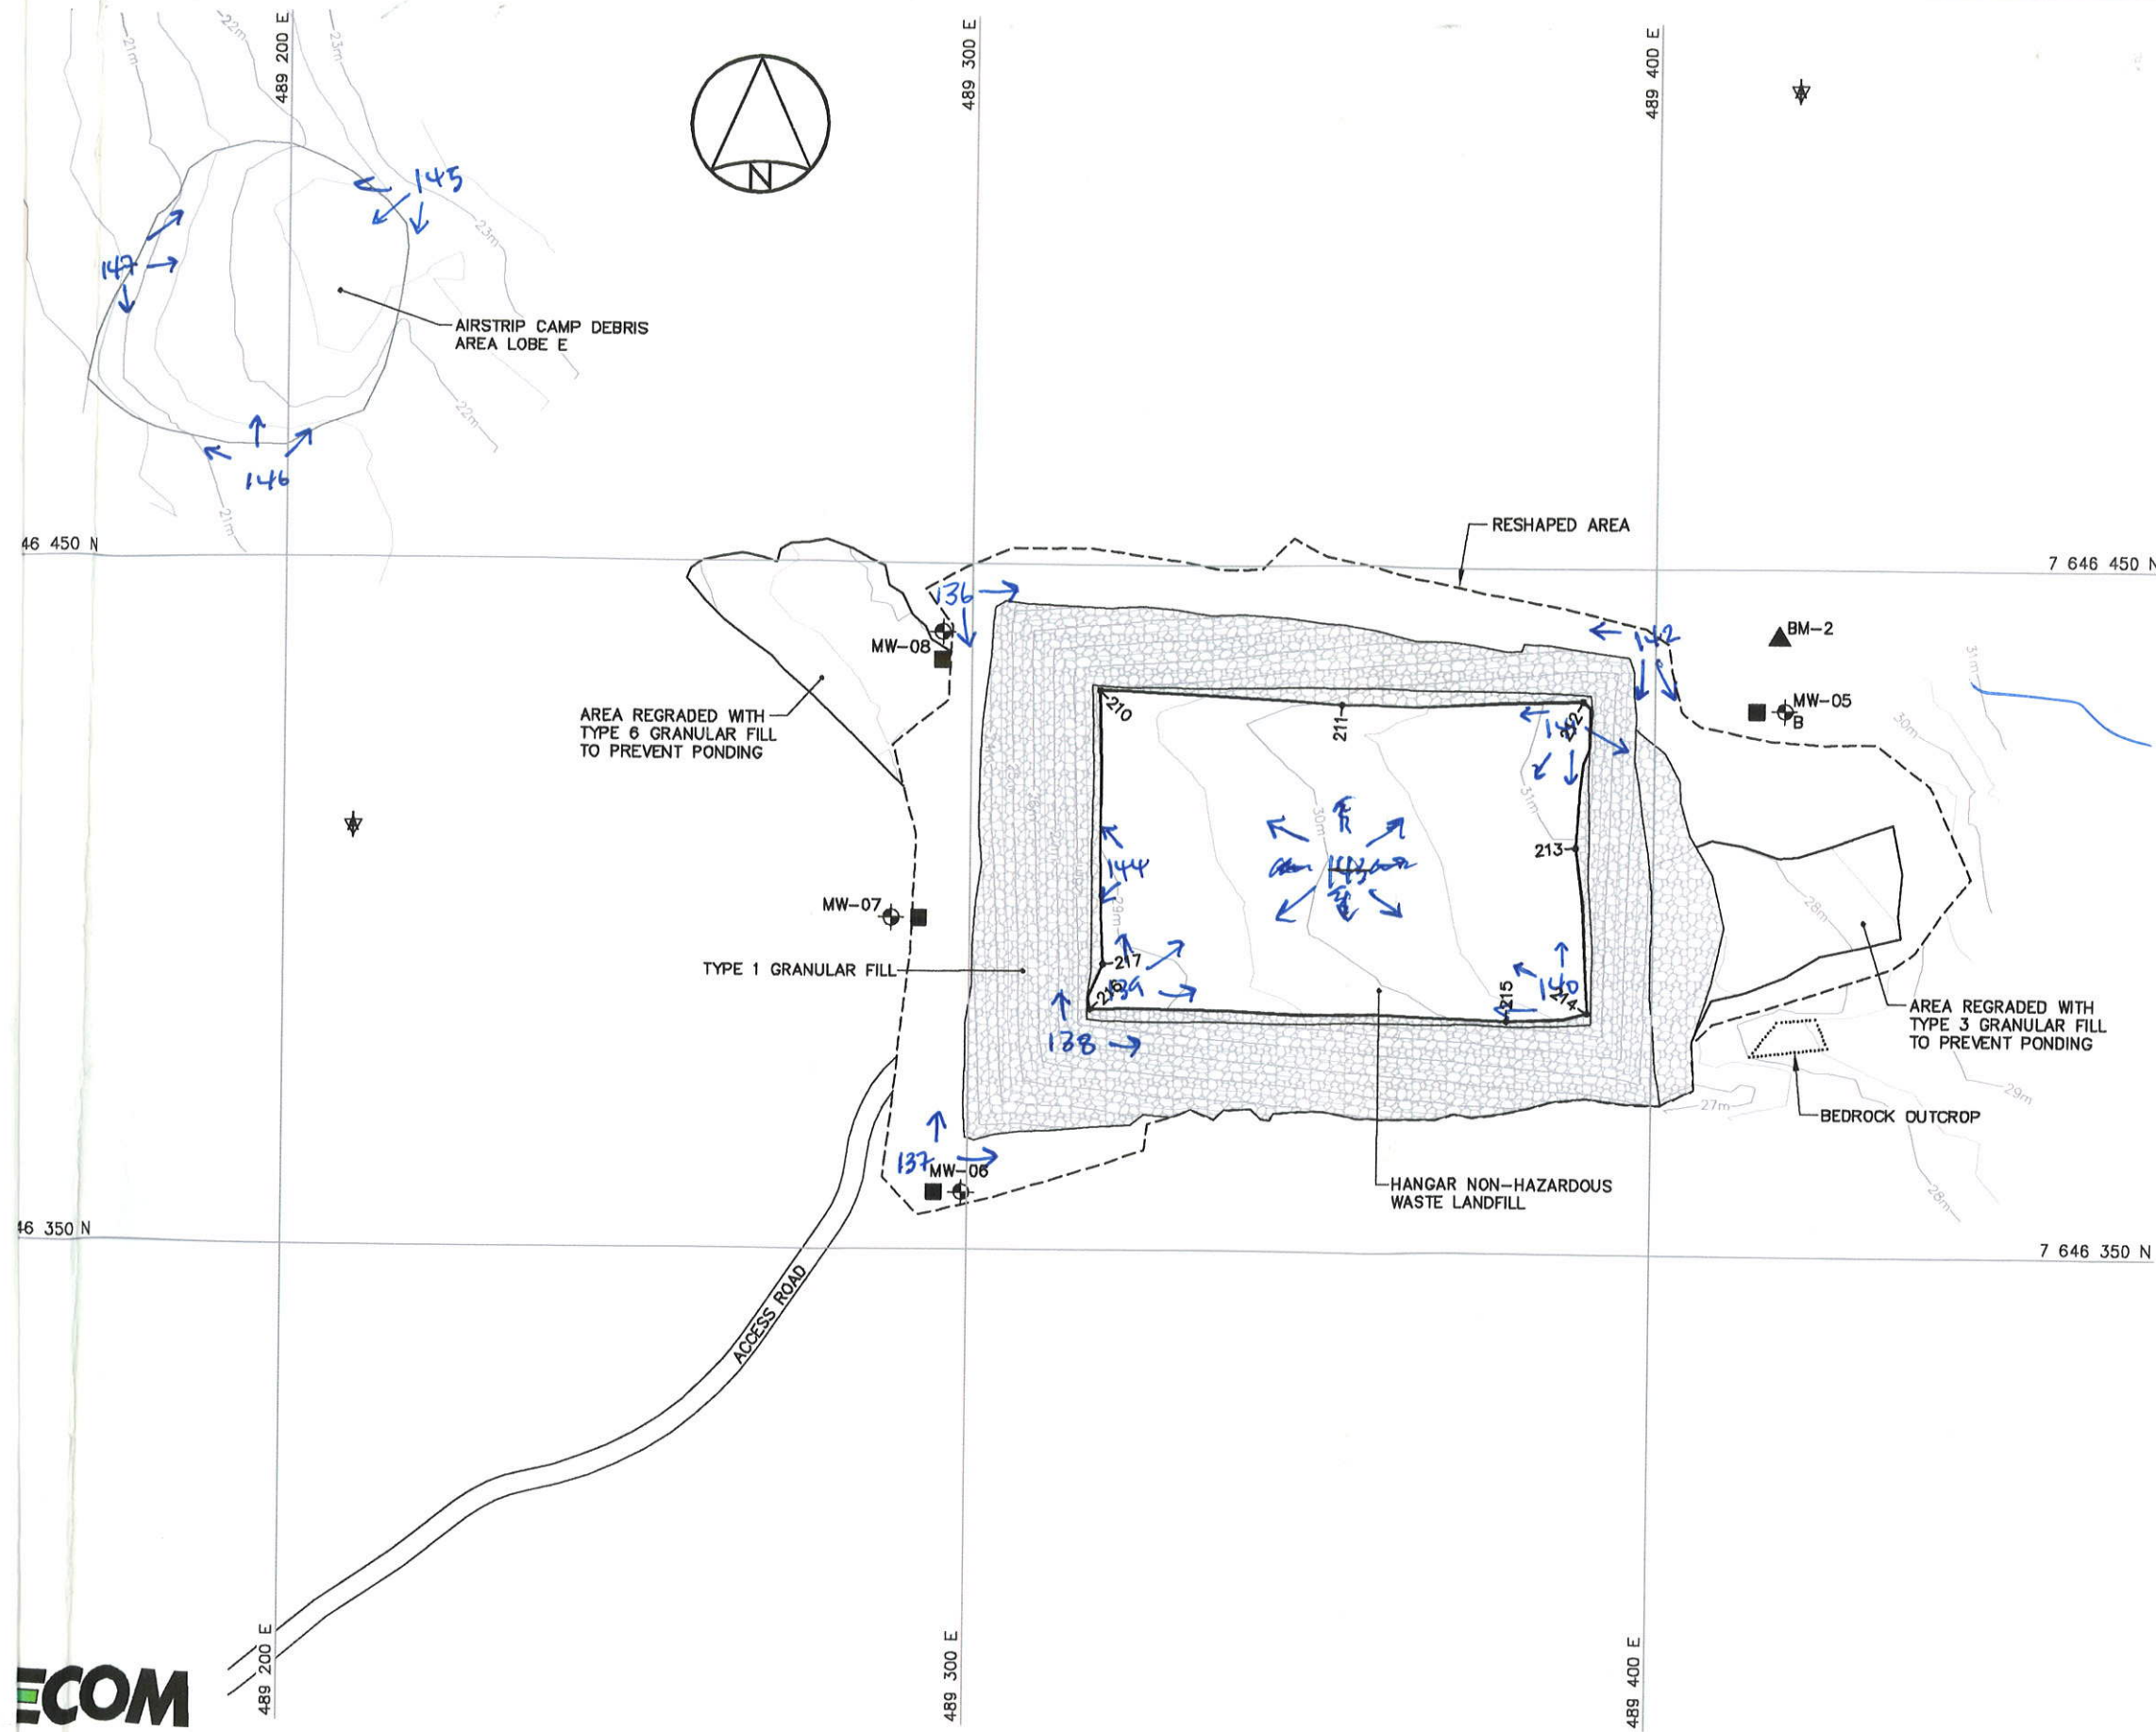


- GENERAL NOTES:**
1. ALL COORDINATES ARE REFERENCED TO NAD83 (CSRS), UTM ZONE 18N. ALL ELEVATIONS REFER TO GEODETIC DATUM.
 2. ALL DIMENSIONS ARE IN METRES UNLESS NOTED OTHERWISE.

- LEGEND:**
- ▲ BM-2 APPROXIMATE PERMANENT BENCHMARK LOCATION (1)
 - 210 COORDINATE POINT
 - ⊕ MONITORING WELL LOCATION (3)
 - ⊕ B BACKGROUND MONITORING WELL LOCATION (1)
 - MONITORING SOIL SAMPLE LOCATION (4)
 - ★ ARCHAEOLOGICAL FEATURES

NON-HAZARDOUS WASTE LANDFILL FINAL GRADING (AS-BUILT)			
NO.	UTM COORDINATES		ELEV.
	NORTHING	EASTING	
210	7 646 431.6	489 318.6	29.2
211	7 646 429.7	489 354.0	30.1
212	7 646 430.6	489 369.4	31.3
213	7 646 409.3	489 388.6	31.0
214	7 646 385.1	489 390.5	30.6
215	7 646 383.9	489 378.8	30.3
216	7 646 385.1	489 317.5	28.6
217	7 646 391.7	489 319.3	28.9


NON-HAZARDOUS WASTE LANDFILL MONITORING WELLS (AS-BUILT)			
NO.	UTM COORDINATES		ELEV. (TOP)
	NORTHING	EASTING	
MW-05	7 646 429.4	489 418.7	30.2
MW-06	7 646 358.3	489 299.2	22.5
MW-07	7 646 398.3	489 288.6	23.4
MW-08	7 646 440.0	489 295.8	24.4

RECORD DRAWING
NOT FOR CONSTRUCTION

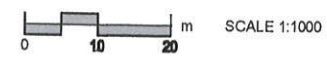

DEW LINE CLEAN UP
LANDFILL MONITORING PLAN
FOX-2 LONGSTAFF BLUFF
**HANGAR NON-HAZARDOUS
WASTE LANDFILL**
FIGURE FOX-2.3

ECOM

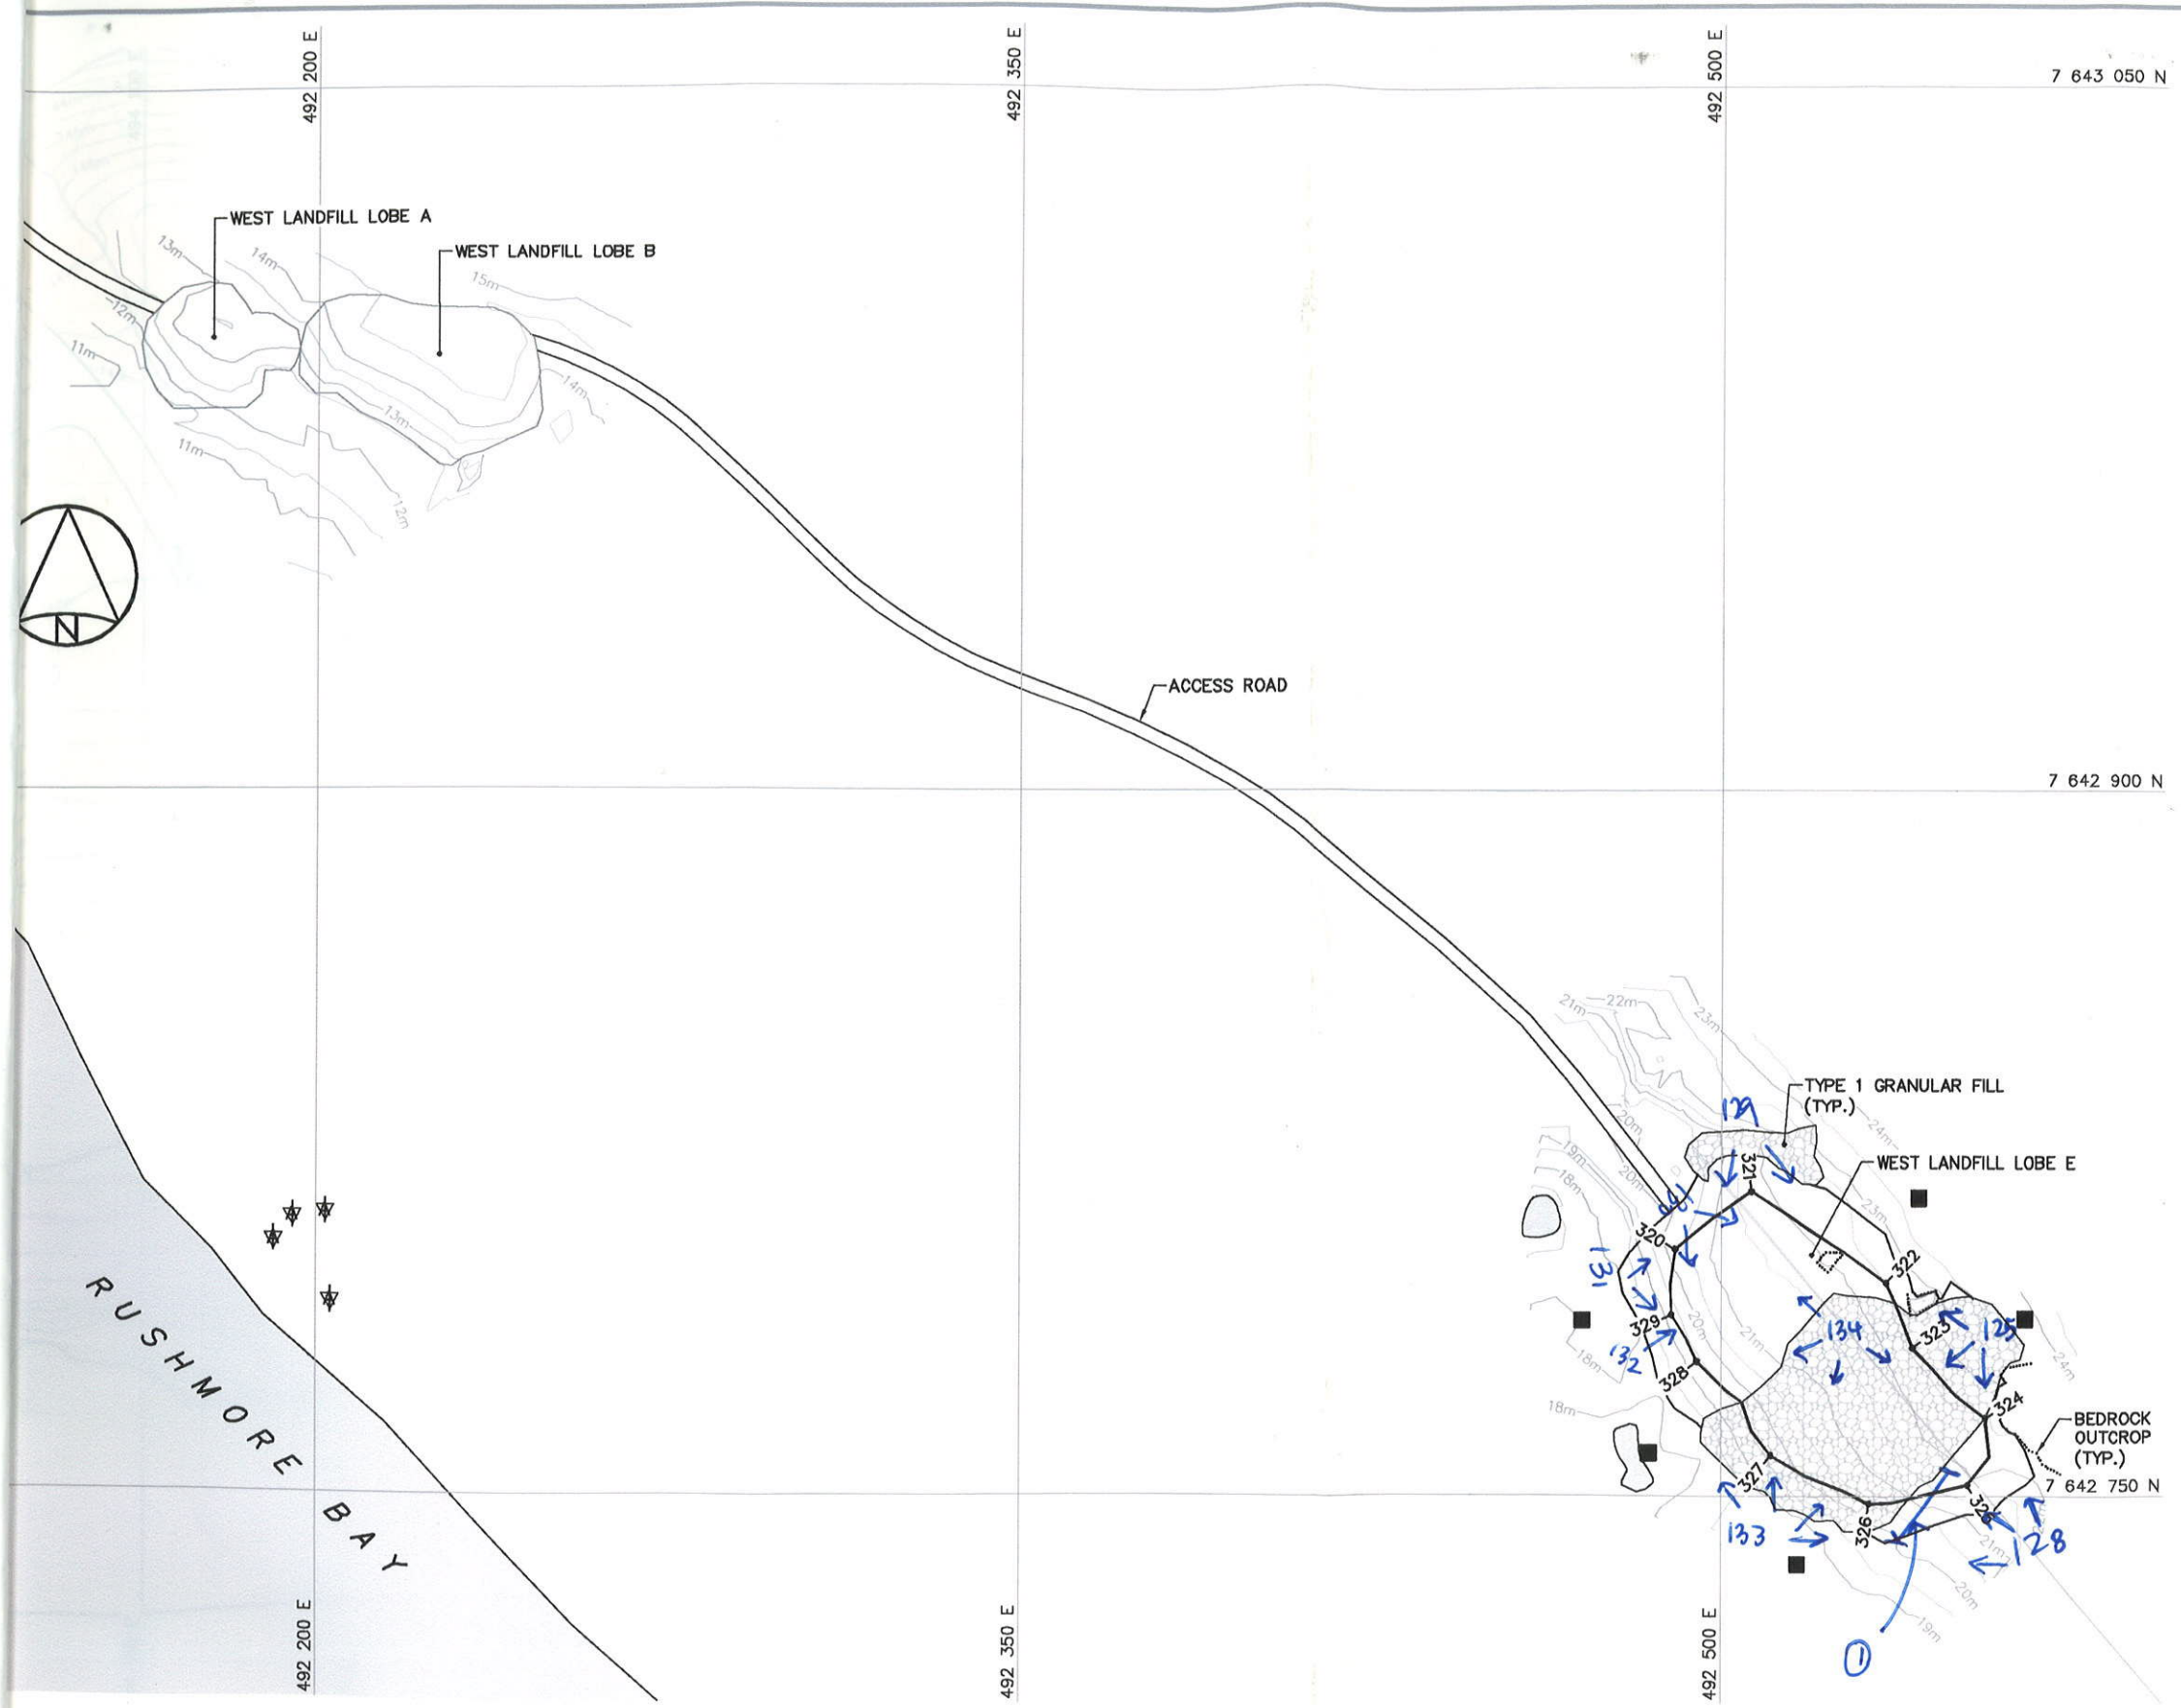

- GENERAL NOTES:
1. ALL COORDINATES ARE REFERENCED TO NAD83 (CSRS), UTM ZONE 18N. ALL ELEVATIONS REFER TO GEODETIC DATUM.
 2. ALL DIMENSIONS ARE IN METRES UNLESS NOTED OTHERWISE.


- LEGEND:
- 320 COORDINATE POINT
 - MONITORING SOIL SAMPLE LOCATION (5)
 - ★ ARCHAEOLOGICAL FEATURES
 - BODY OF WATER

WEST LANDFILL (LOBE E) REGRADED (AS-BUILT)			
NO.	UTM COORDINATES		ELEV.
	NORTHING	EASTING	
320	7 642 802.4	492 490.2	20.4
321	7 642 814.8	492 506.2	21.9
322	7 642 795.4	492 535.1	22.5
323	7 642 781.5	492 540.8	22.6
324	7 642 766.6	492 556.3	22.5
325	7 642 752.3	492 552.6	21.9
326	7 642 748.3	492 531.5	20.4
327	7 642 758.6	492 510.4	19.7
328	7 642 778.6	492 494.8	19.4
329	7 642 788.5	492 489.4	19.3

RECORD DRAWING
NOT FOR CONSTRUCTION



DEW LINE CLEAN UP
LANDFILL MONITORING PLAN
FOX-2 LONGSTAFF BLUFF
WEST LANDFILL LOBE E
FIGURE FOX-2.4

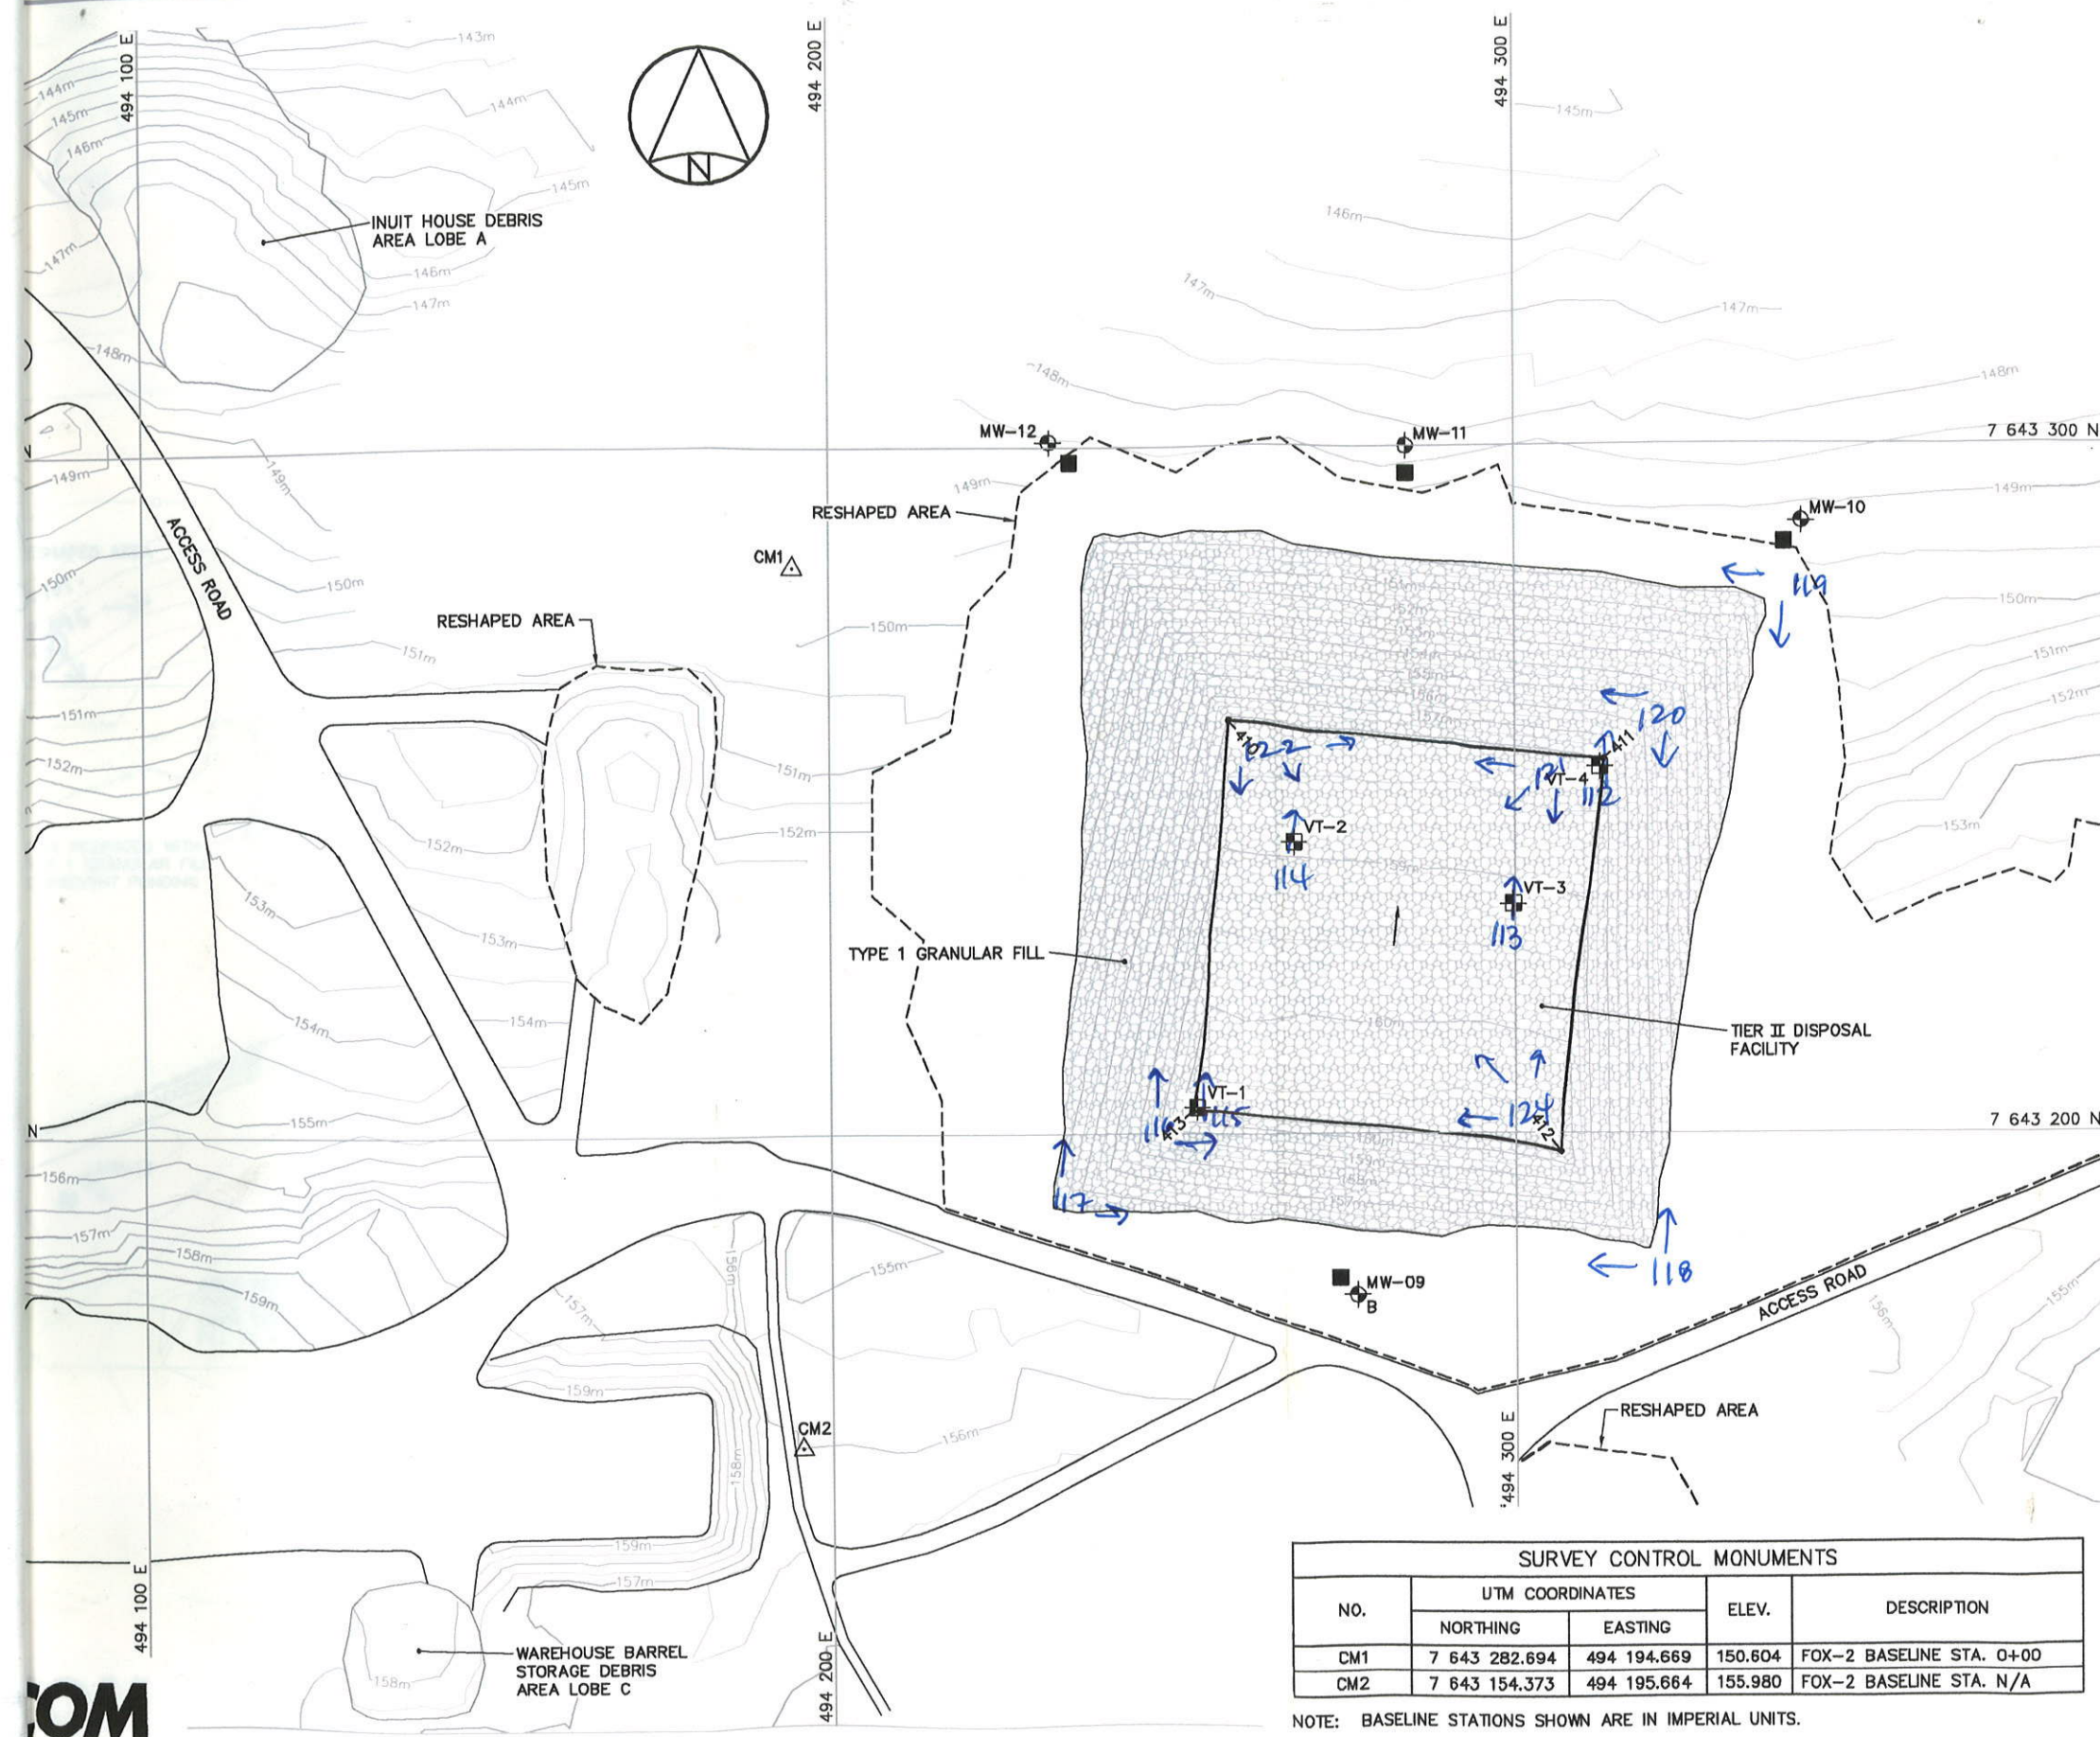


- GENERAL NOTES:
1. ALL COORDINATES ARE REFERENCED TO NAD83 (CSRS), UTM ZONE 18N. ALL ELEVATIONS REFER TO GEODETIC DATUM.
 2. ALL DIMENSIONS ARE IN METRES UNLESS NOTED OTHERWISE.

- LEGEND:
- △ CM1 SURVEY CONTROL MONUMENT (2)
 - COORDINATE POINT
 - ⊕ MONITORING WELL LOCATION (3)
 - ⊕ B BACKGROUND MONITORING WELL LOCATION (1)
 - ⊕ APPROXIMATE VERTICAL THERMISTOR LOCATION (4)
 - MONITORING SOIL SAMPLE LOCATION (4)

TIER II DISPOSAL FACILITY FINAL GRADING (AS-BUILT)			
NO.	UTM COORDINATES		ELEV.
	NORTHING	EASTING	
410	7 643 260.1	494 258.2	158.1
411	7 643 254.3	494 312.9	158.0
412	7 643 197.3	494 306.5	160.5
413	7 643 203.3	494 252.5	160.5

TIER II DISPOSAL FACILITY MONITORING WELLS (AS-BUILT)			
NO.	UTM COORDINATES		ELEV. (TOP)
	NORTHING	EASTING	
MW-09	7 643 176.6	494 276.9	156.9
MW-10	7 643 288.8	494 341.7	149.7
MW-11	7 643 300.1	494 284.2	148.9
MW-12	7 643 300.9	494 232.0	149.2

RECORD DRAWING
NOT FOR CONSTRUCTION

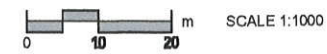

DEW LINE CLEAN UP
LANDFILL MONITORING PLAN
FOX-2 LONGSTAFF BLUFF
TIER II DISPOSAL FACILITY
FIGURE FOX-2.5

SURVEY CONTROL MONUMENTS				
NO.	UTM COORDINATES		ELEV.	DESCRIPTION
	NORTHING	EASTING		
CM1	7 643 282.694	494 194.669	150.604	FOX-2 BASELINE STA. 0+00
CM2	7 643 154.373	494 195.664	155.980	FOX-2 BASELINE STA. N/A

NOTE: BASELINE STATIONS SHOWN ARE IN IMPERIAL UNITS.

