


**PERMIT TO PRACTICE
QIKIQTAAALUK ENVIRONMENTAL**

Signature 

Date 29/10/09

PERMIT NUMBER: P 530

The Association of Professional Engineers,
Geologists and Geophysicists of the NWT / NU

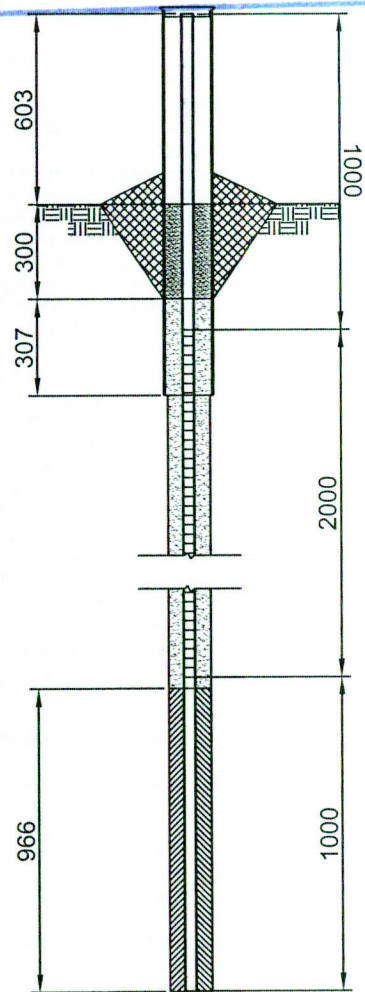


**MONITORING WELL
EAST**

x: 10074.831

y: 9559.239

z: 14.823 (TOP OF WELL)

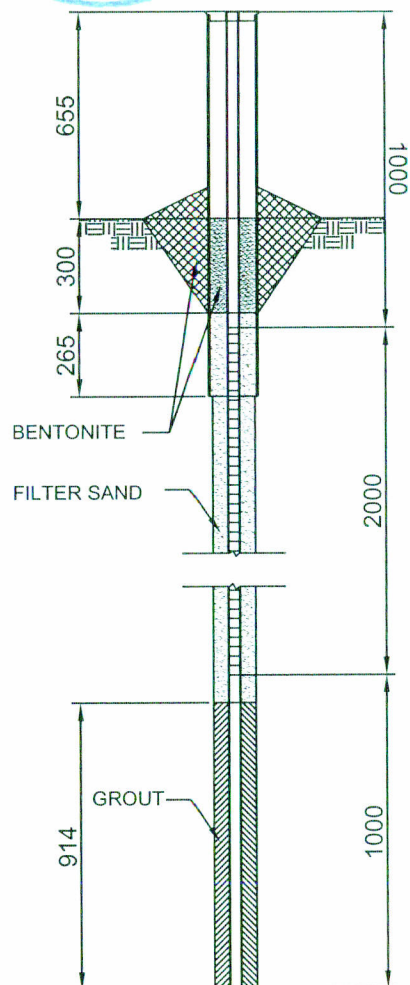


**MONITORING WELL
NORTH**

x: 10126.882

y: 9667.598

z: 12.938 (TOP OF WELL)

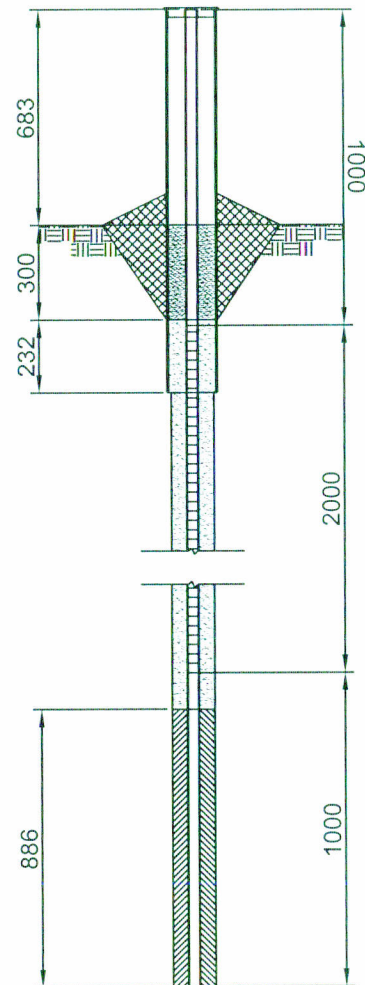

**MONITORING WELL
WEST**

x: 10042.954

y: 9679.215

z: 16.846 (TOP OF WELL)



ᑭᑭᑭᑭᑭᑭ ᑭᑭᑭᑭᑭᑭ
Qikiqtaaluk Logistics
Inc.

General Notes - Notes Générales:

- 1) PIPE OVER GROUND : MIN 500 MM
- 2) BENTONITE IN CASE : MIN 300 MM
- 3) FILTER SAND IN CASE : MIN 200 MM
- 4) GROUT : MIN 800 MM, MAX 1 000 MM

Legend - Légende:

No.	DATE	REVISION	REVISION	APPR
-----	------	----------	----------	------



ᑭᑭᑭᑭᑭᑭ ᑭᑭᑭᑭᑭᑭ
QIKIQTAAALUK ENVIRONMENTAL

SCALE - ÉCHELLE

Not to scale

PROJECT - PROJET

CAPE CHRISTIAN PROJECT

© QIKIQTAAALUK LOGISTICS INC. 2009

TRADE - MÉTIER

AS-BUILT

DATE

2009-08-13

SUBJECT - SUJET

NON-HAZARDOUS LANDFILL MONITORING WELLS AT CAPE
CHRISTIAN

PRODUCTION

CONCURRENCE - ASSENTMENT

DESIGNED
ÉTUDE

JONATHAN REMILLARD

DRAWN
DESSINE

JONATHAN REMILLARD

CHECKED
VÉRIFIÉ

PHILIPPE SIMON

CO-ORDINATION

REVISED - RÉVISÉ

DWG. NO. - DESSIN NO.
2009-QESm 200/P6-20