


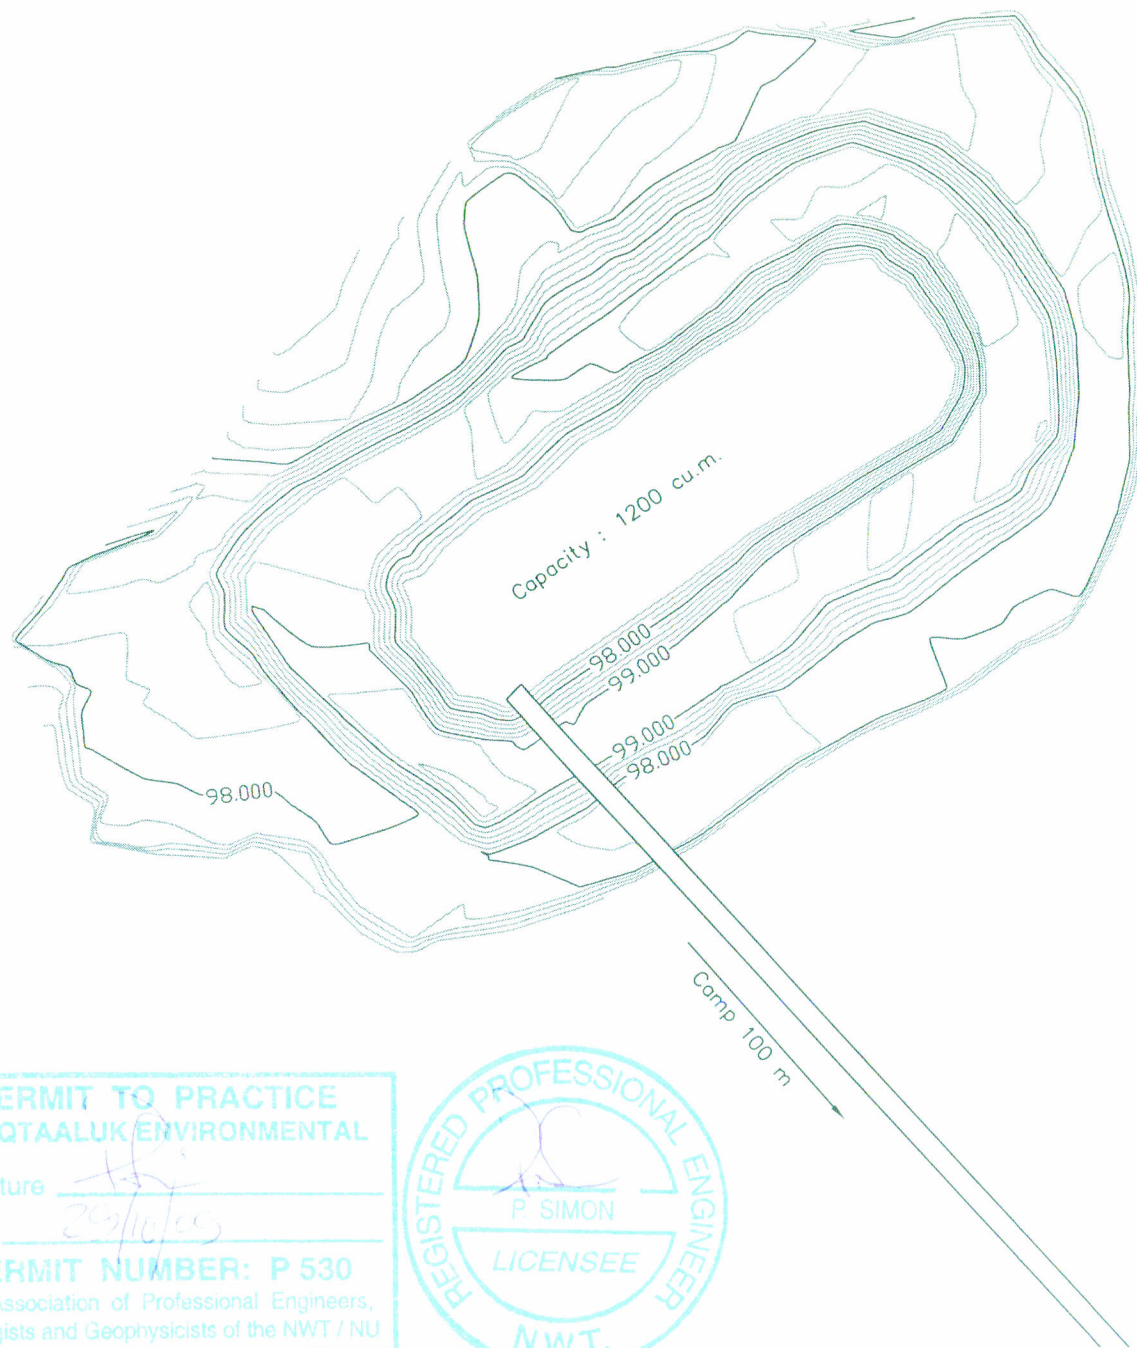

**PERMIT TO PRACTICE
QIKIQTAAALUK ENVIRONMENTAL**

Signature [Signature]

Date 20/10/09

PERMIT NUMBER: P 530

The Association of Professional Engineers,
Geologists and Geophysicists of the NWT / NU



ᑭᑭᑭᑭᑭᑭ ᑭᑭᑭᑭᑭᑭᑭᑭ
Qikiqtaaluk Logistics
Inc.

General Notes - Notes Générales:

- 1) Sewage lagoon capacity 1200 m³

Legend - Légende:

No.	DATE	REVISION	REVISION	APPR.



ᑭᑭᑭᑭᑭᑭ ᑭᑭᑭᑭᑭᑭᑭᑭ
QIKIQTAAALUK ENVIRONMENTAL

SCALE - ÉCHELLE

Not to scale

PROJECT - PROJET

CAPE CHRISTIAN PROJECT

© QIKIQTAAALUK LOGISTICS INC. 2009

TRADE - MÈTRE

AS-BUILT

DATE

2009-08-09

SUBJECT - SUJET

CAPE CHRISTIAN SEWAGE LAGOON

PRODUCTION	CONCURRENCE - ASSISEMENT
DESIGNED ETUDE	PHILIPPE SIMON
DRAWN DESSINE	JONATHAN REMILLARD
CHECKED VÉRIFIÉ	PHILIPPE SIMON
COORDINATION	REVIEWED - REVU

DWG. NO. - DESSIN NO.

2009-DESIN 2007P6-21