


Date Plotted: October 16, 2006 Path: N:\Projects\2008\80297\2008\WorkInProgress\Documents\80297-4\_CAM-4-FINAL-Report\ACAD\_Files\C4-RD01A.dwg

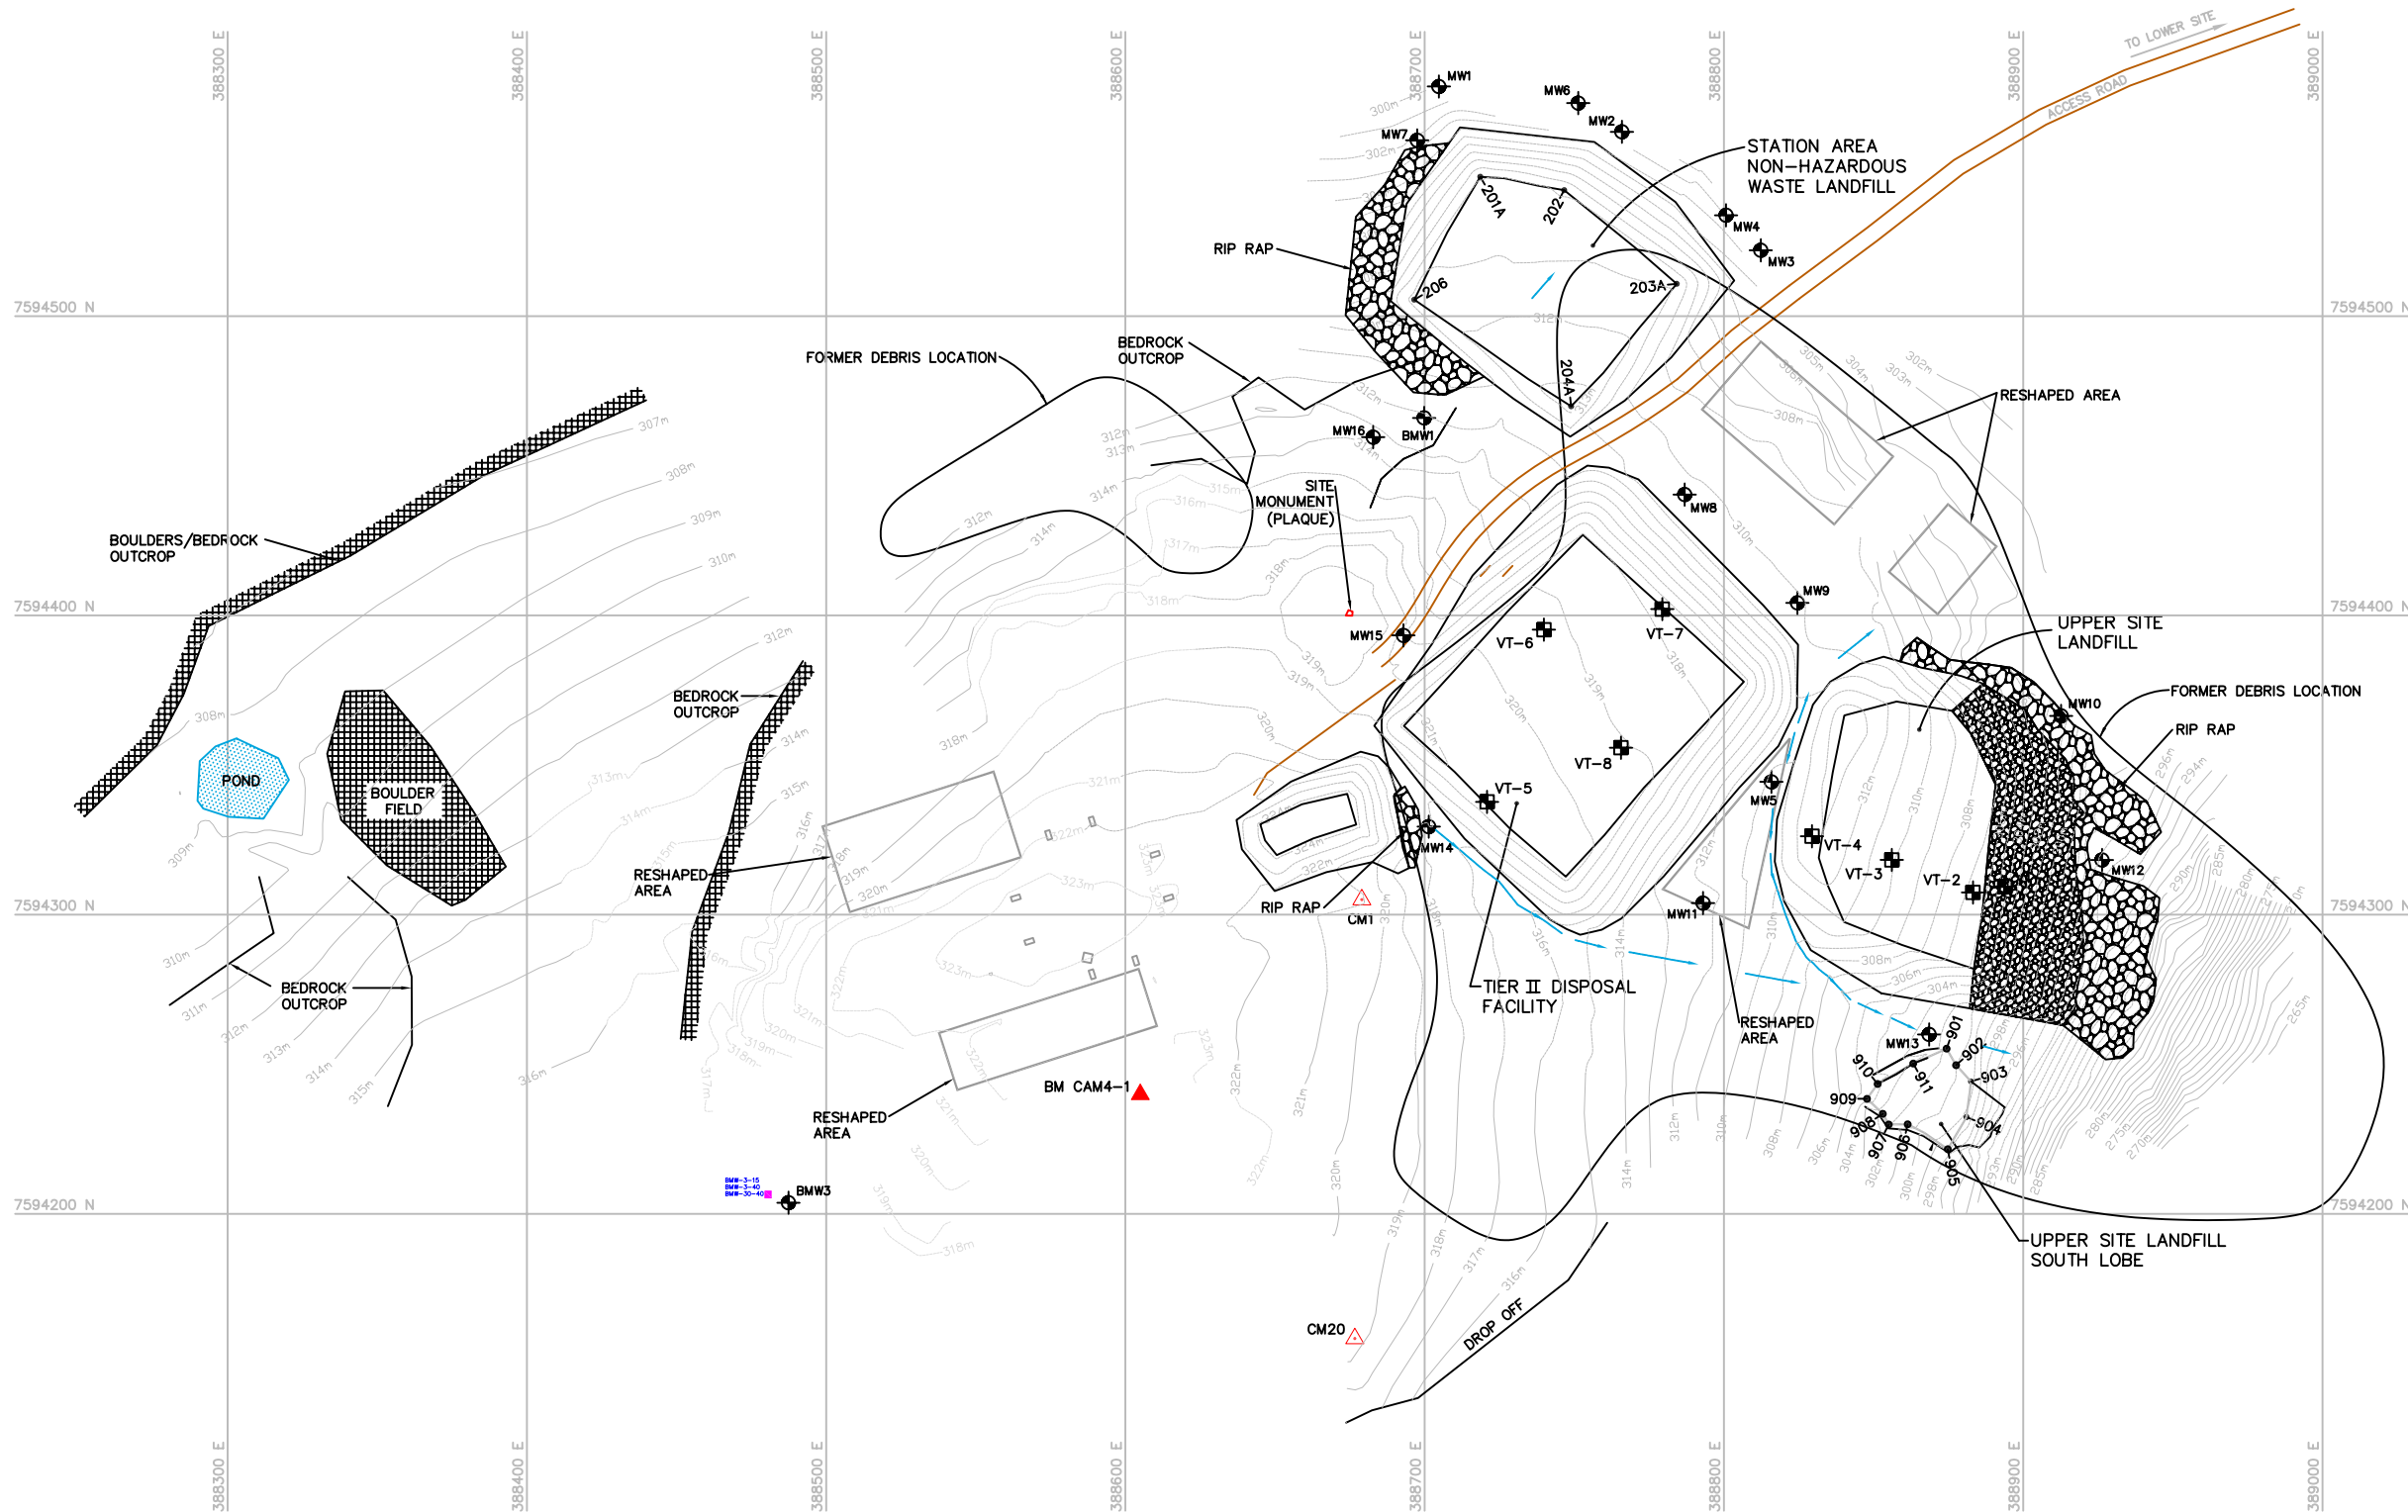

**Legend**

CM20	△	TEMPORARY BENCHMARK
BM-1	▲	PERMANENT BENCHMARK
	⊕	THERMISTOR LOCATION
	■	MONITORING SOIL SAMPLE LOCATION
	⊙	MONITORING WELL LOCATION

**RECORD DRAWING**  
NOT FOR CONSTRUCTION

Map Sources / Notes:  
Source drawing from UMA: C4-RD01A.dwg

0 10 20 40 60 80 100 m  
1 : 2500  
UTM Zone 16W, NAD83

File Name: C4-RD01A.dwg  
Reviewed by: DCJ  
Date Issued: October, 2008

Prepared by: KAB  
Project Number: 80-297

**Defence Construction Canada**  
**2008 CAM-4 DEW Line Monitoring Program**  
**CAM-4 Kugaaruk**  
**Nunavut Territory**

**Upper Site Layout**

**AECOM**

**Figure 2-2**  
Version 1