



Date Plotted: October 16, 2006 Path: N:\Projects\2008\80297\2008\World\Progress\Documents\80297_4_CAM-4-FINAL-Report\ACAD_Files\C4-RD01B.dwg

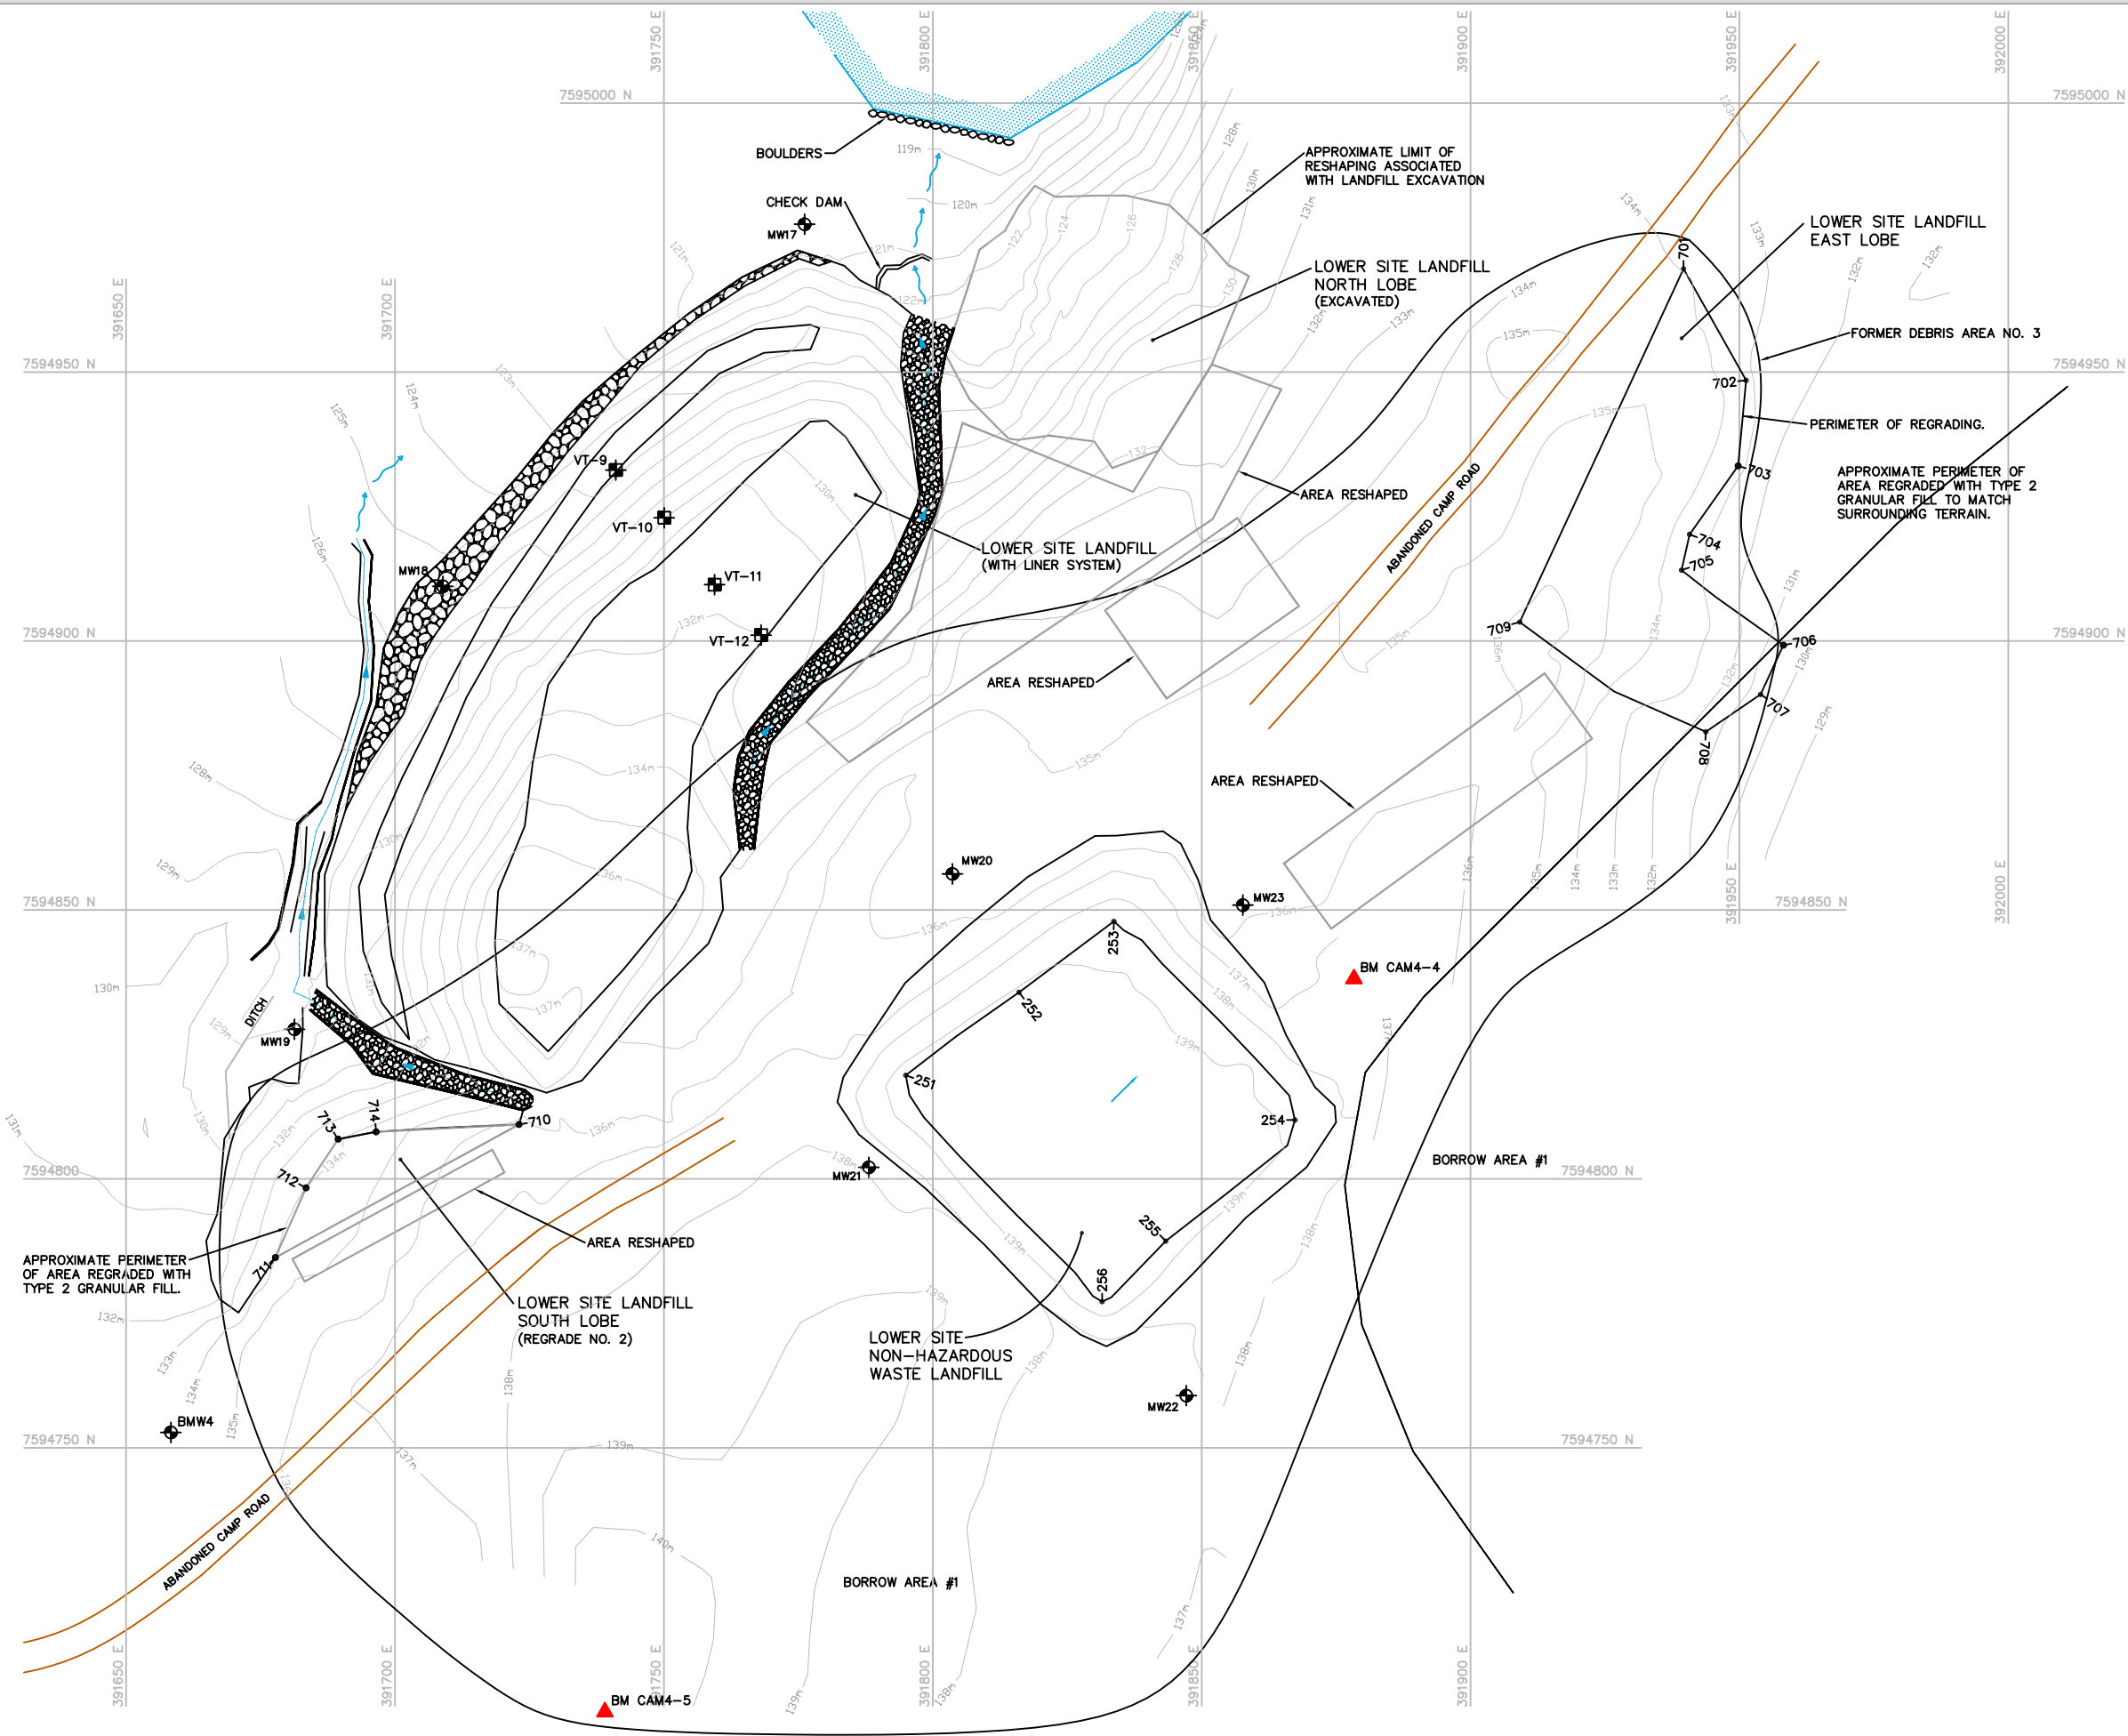

- Legend**
- CM20 TEMPORARY BENCHMARK
 - BM-1 PERMANENT BENCHMARK
 - THERMISTOR LOCATION
 - MONITORING WELL LOCATION

RECORD DRAWING
NOT FOR CONSTRUCTION

Map Sources / Notes:
Source drawing from UMA: C4-RD01B.dwg

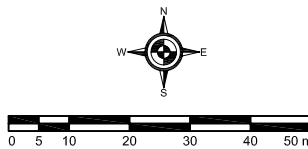

1 : 1250
UTM Zone 16W, NAD83

File Name:	C4-RD01B.dwg	Prepared by:	KAB
Reviewed by:	DCJ	Project Number:	80-297
Date Issued:	October, 2008		

Defence Construction Canada

2008 CAM-4 DEW Line Monitoring Program
CAM-4 Kugaaruk
Nunavut Territory

Lower Site Layout

AECOM

Figure 2-3
Version 1