



Date Plotted: October 16, 2006 Path: N:\Projects\2008\80297\2008\WorkInProgress\Documents\80297-4_CAM-4-FINAL-Report\ACAD_Files\C4-RD02.dwg

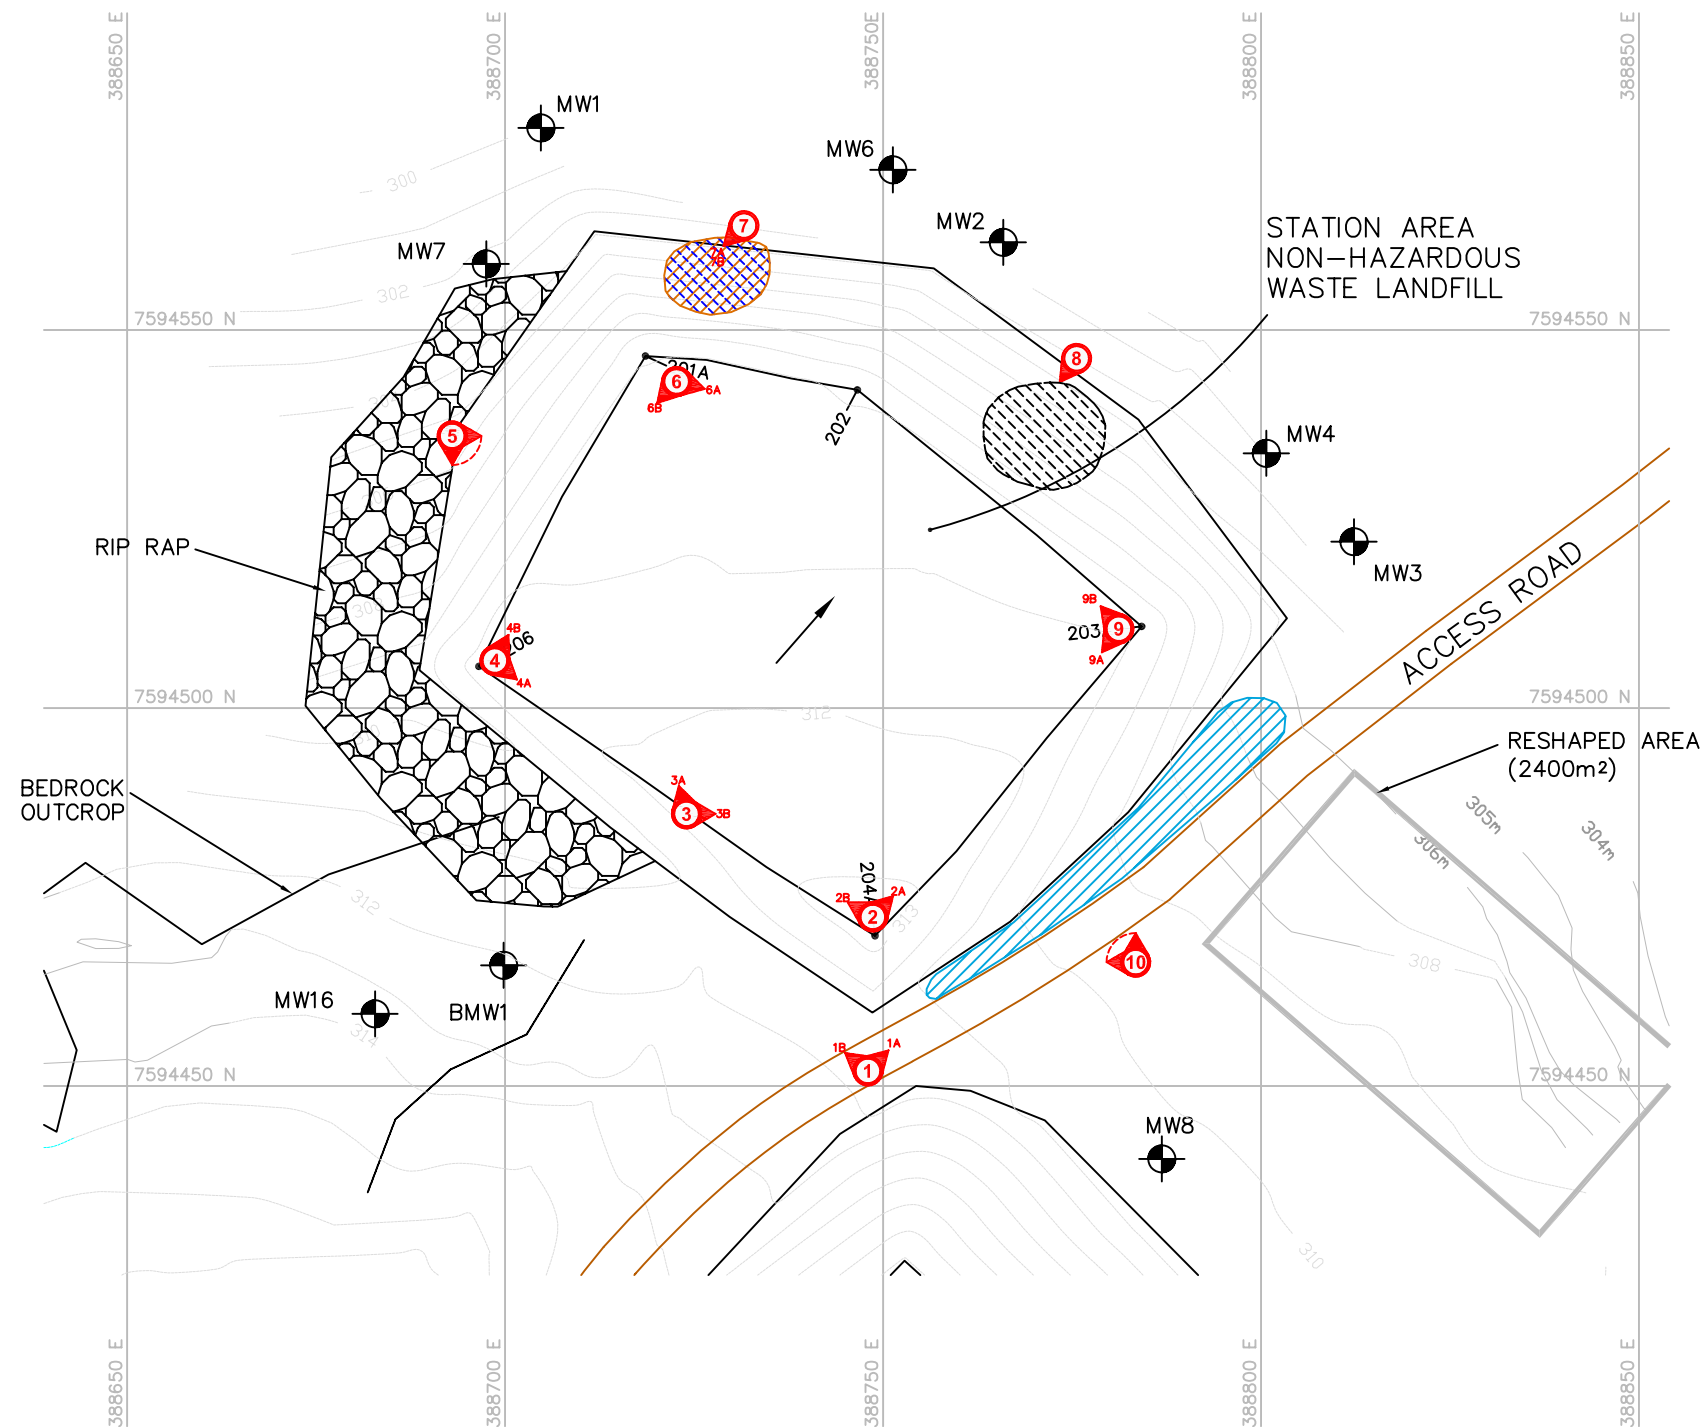

- Legend**
- TBM4 □ TEMPORARY BENCHMARK
 - BM-1 ▲ PERMANENT BENCHMARK
 - 101 → COORDINATE POINT
 - ⊕ MONITORING WELL LOCATION
 - ⑩ PHOTOGRAPH LOCATION
 - AREA OF ORANGE STAINING
 - AREA OF MINOR SEEPAGE
 - AREA OF MINOR EROSION
 - AREA OF WATER DRAINAGE

RECORD DRAWING
NOT FOR CONSTRUCTION

Map Sources / Notes:
-Source drawing from UMA: C4-RD02.dwg
-Photograph numbers refer to those found in Appendix A2 - Visual Inspection Photographs

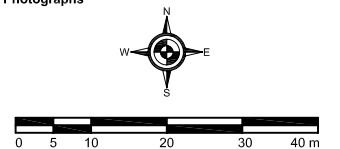

1 : 1000
UTM Zone 16W, NAD83

File Name: C4-RD02.dwg
Reviewed by: DCJ
Date Issued: October, 2008
Prepared by: KAB
Project Number: 80-297

Defence Construction Canada
2008 CAM-4 DEW Line Monitoring Program
CAM-4 Kugaaruk
Nunavut Territory

**Station Area Non-Hazardous
Waste Landfill**

AECOM

Figure A-1
Version 1