


Date Plotted: October 16, 2006 Path: N:\Projects\2008\80297\2008\WorkInProgress\Data Interpretation\CAD\CAM-4\C4-RD03.dwg

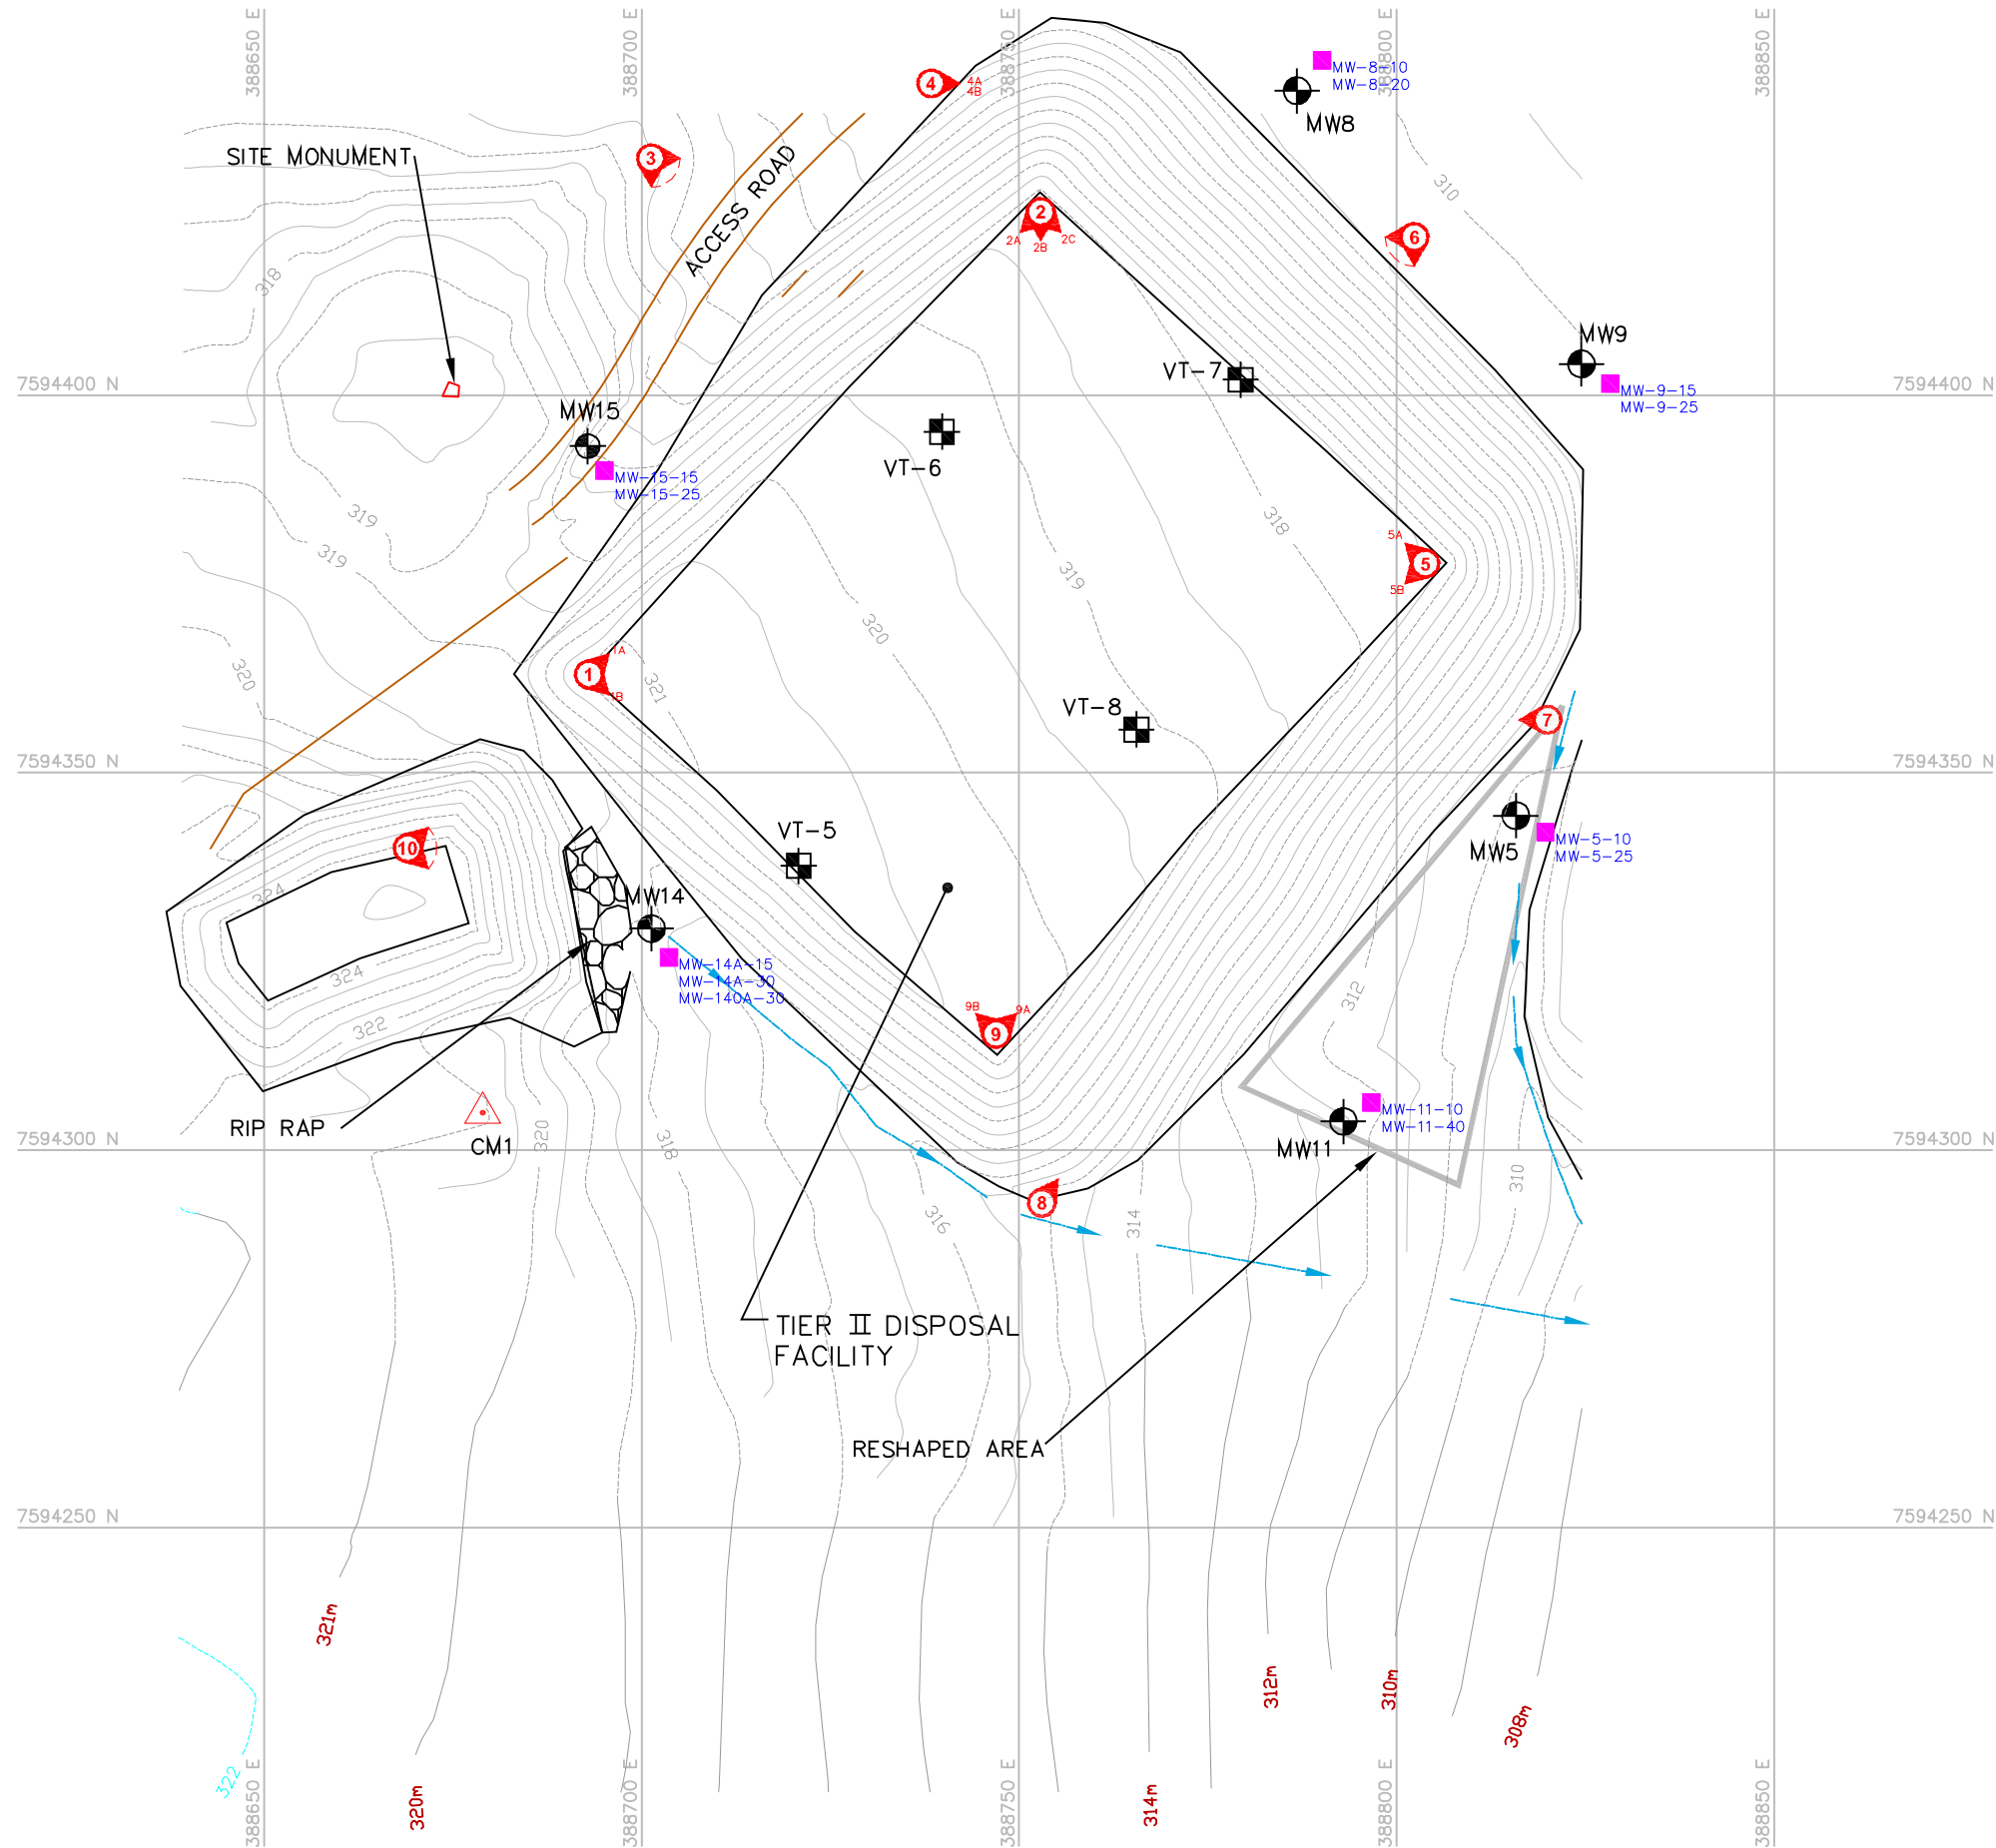

**Legend**

TBM4	TEMPORARY BENCHMARK
BM-1	PERMANENT BENCHMARK
101-	COORDINATE POINT
MW-11-10 MW-11-40	MONITORING SOIL SAMPLE LOCATION
	MONITORING WELL LOCATION
	VERTICAL THERMISTOR LOCATION
	PHOTOGRAPH LOCATION

**RECORD DRAWING**  
NOT FOR CONSTRUCTION

Map Sources / Notes:  
Source drawing from UMA: C4-RD03.dwg

1 : 1000  
UTM Zone 16W, NAD83

File Name:	C4-RD03.dwg	Prepared by:	KAB
Reviewed by:	DCJ	Project Number:	80-297
Date Issued:	October, 2008		

**Defence Construction Canada**  
**2008 CAM-4 DEW Line Monitoring Program**  
**CAM-4 Kugaaruk**  
**Nunavut Territory**  
**DCC Tier II**  
**Soil Disposal Facility**

**AECOM**

**Figure B-1**  
Version 1