



Date Plotted: October 16, 2006 Path: N:\Projects\2008\80297\2008\WorkInProgress\Data Interpretation\CAD\CAM-4\C4-RD05.dwg

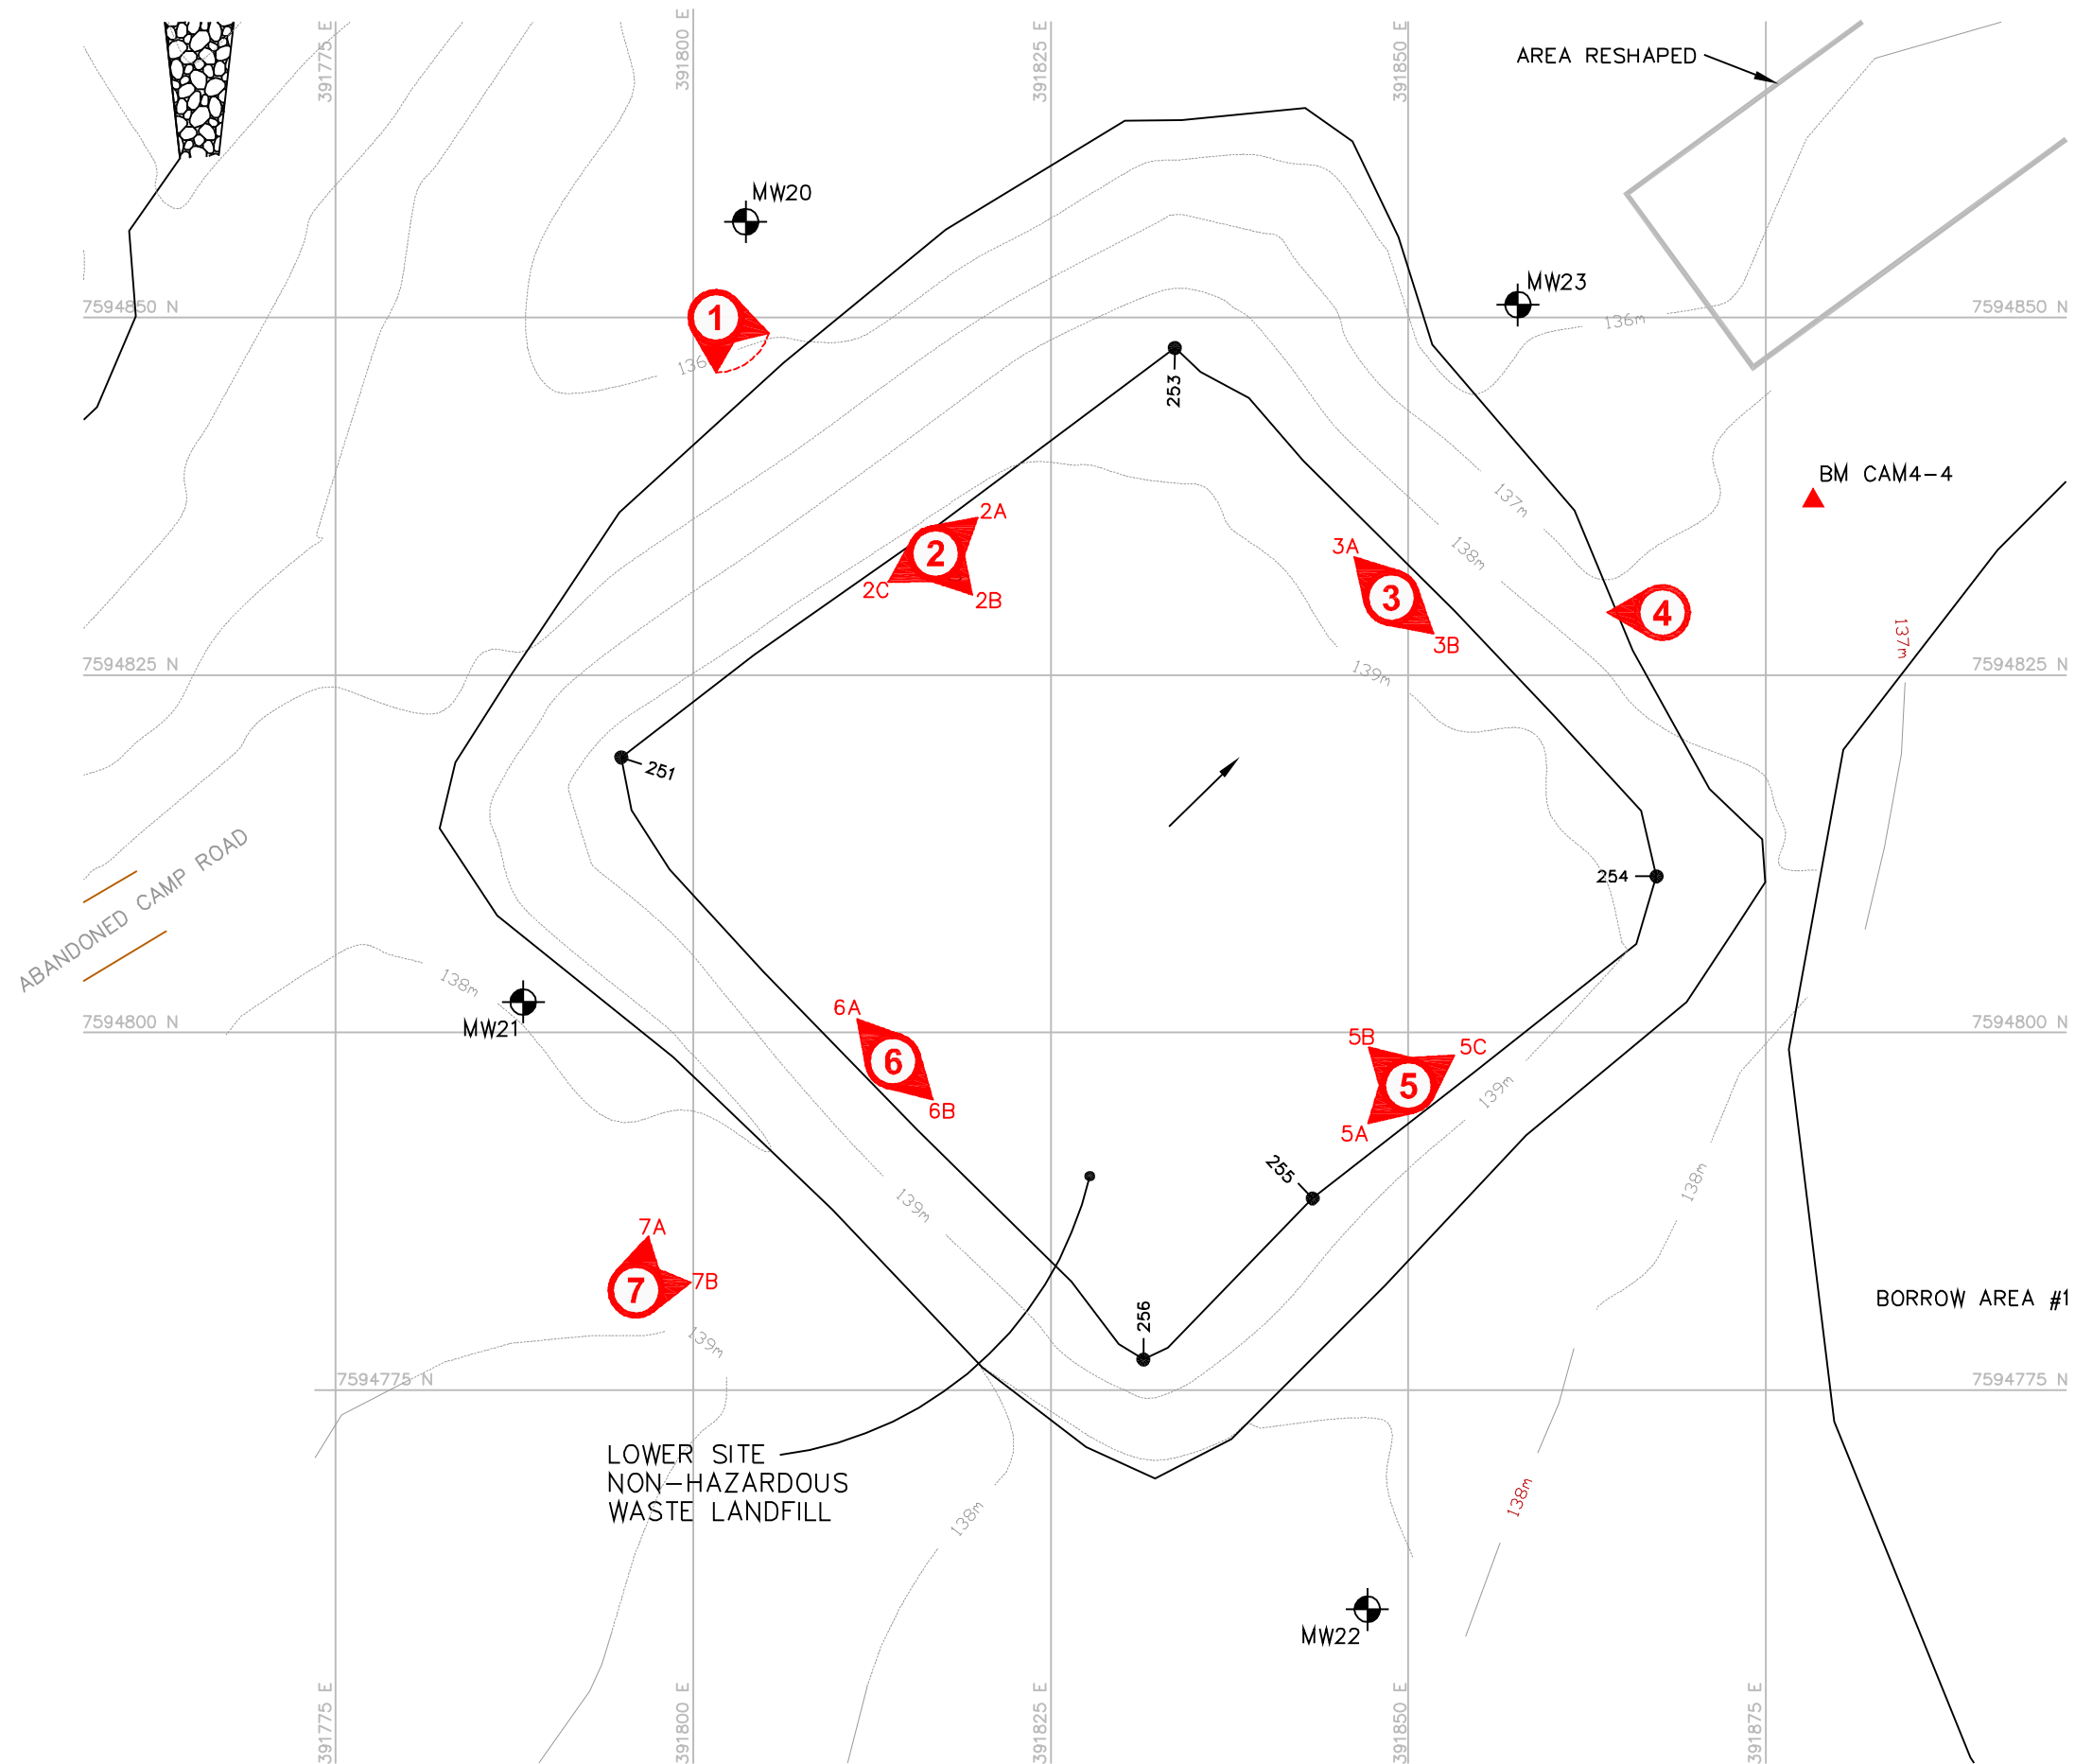

- Legend**
- TBM4 □ TEMPORARY BENCHMARK
 - BM-1 ▲ PERMANENT BENCHMARK
 - 101-→ COORDINATE POINT
 - ⊕ MONITORING WELL LOCATION
 - ① PHOTOGRAPH LOCATION

RECORD DRAWING
NOT FOR CONSTRUCTION

Map Sources / Notes:
Source drawing from UMA: C4-RD05.dwg

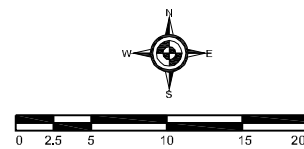

UTM Zone 16W, NAD83

File Name:	C4-RD05.dwg	Prepared by:	KAB
Reviewed by:	DCJ	Project Number:	80-297
Date Issued:	October, 2008		

Defence Construction Canada
2008 CAM-4 DEW Line Monitoring Program
CAM-4 Kugaaruk
Nunavut Territory

Lower Site
Non-hazardous Waste Landfill

AECOM

Figure D-1
Version 1