


Date Plotted: October 16, 2006 Path: N:\Projects\2008\80297\2008\WorkInProgress\Data Interpretation\CAD\CAM-4\C4-RD06.dwg

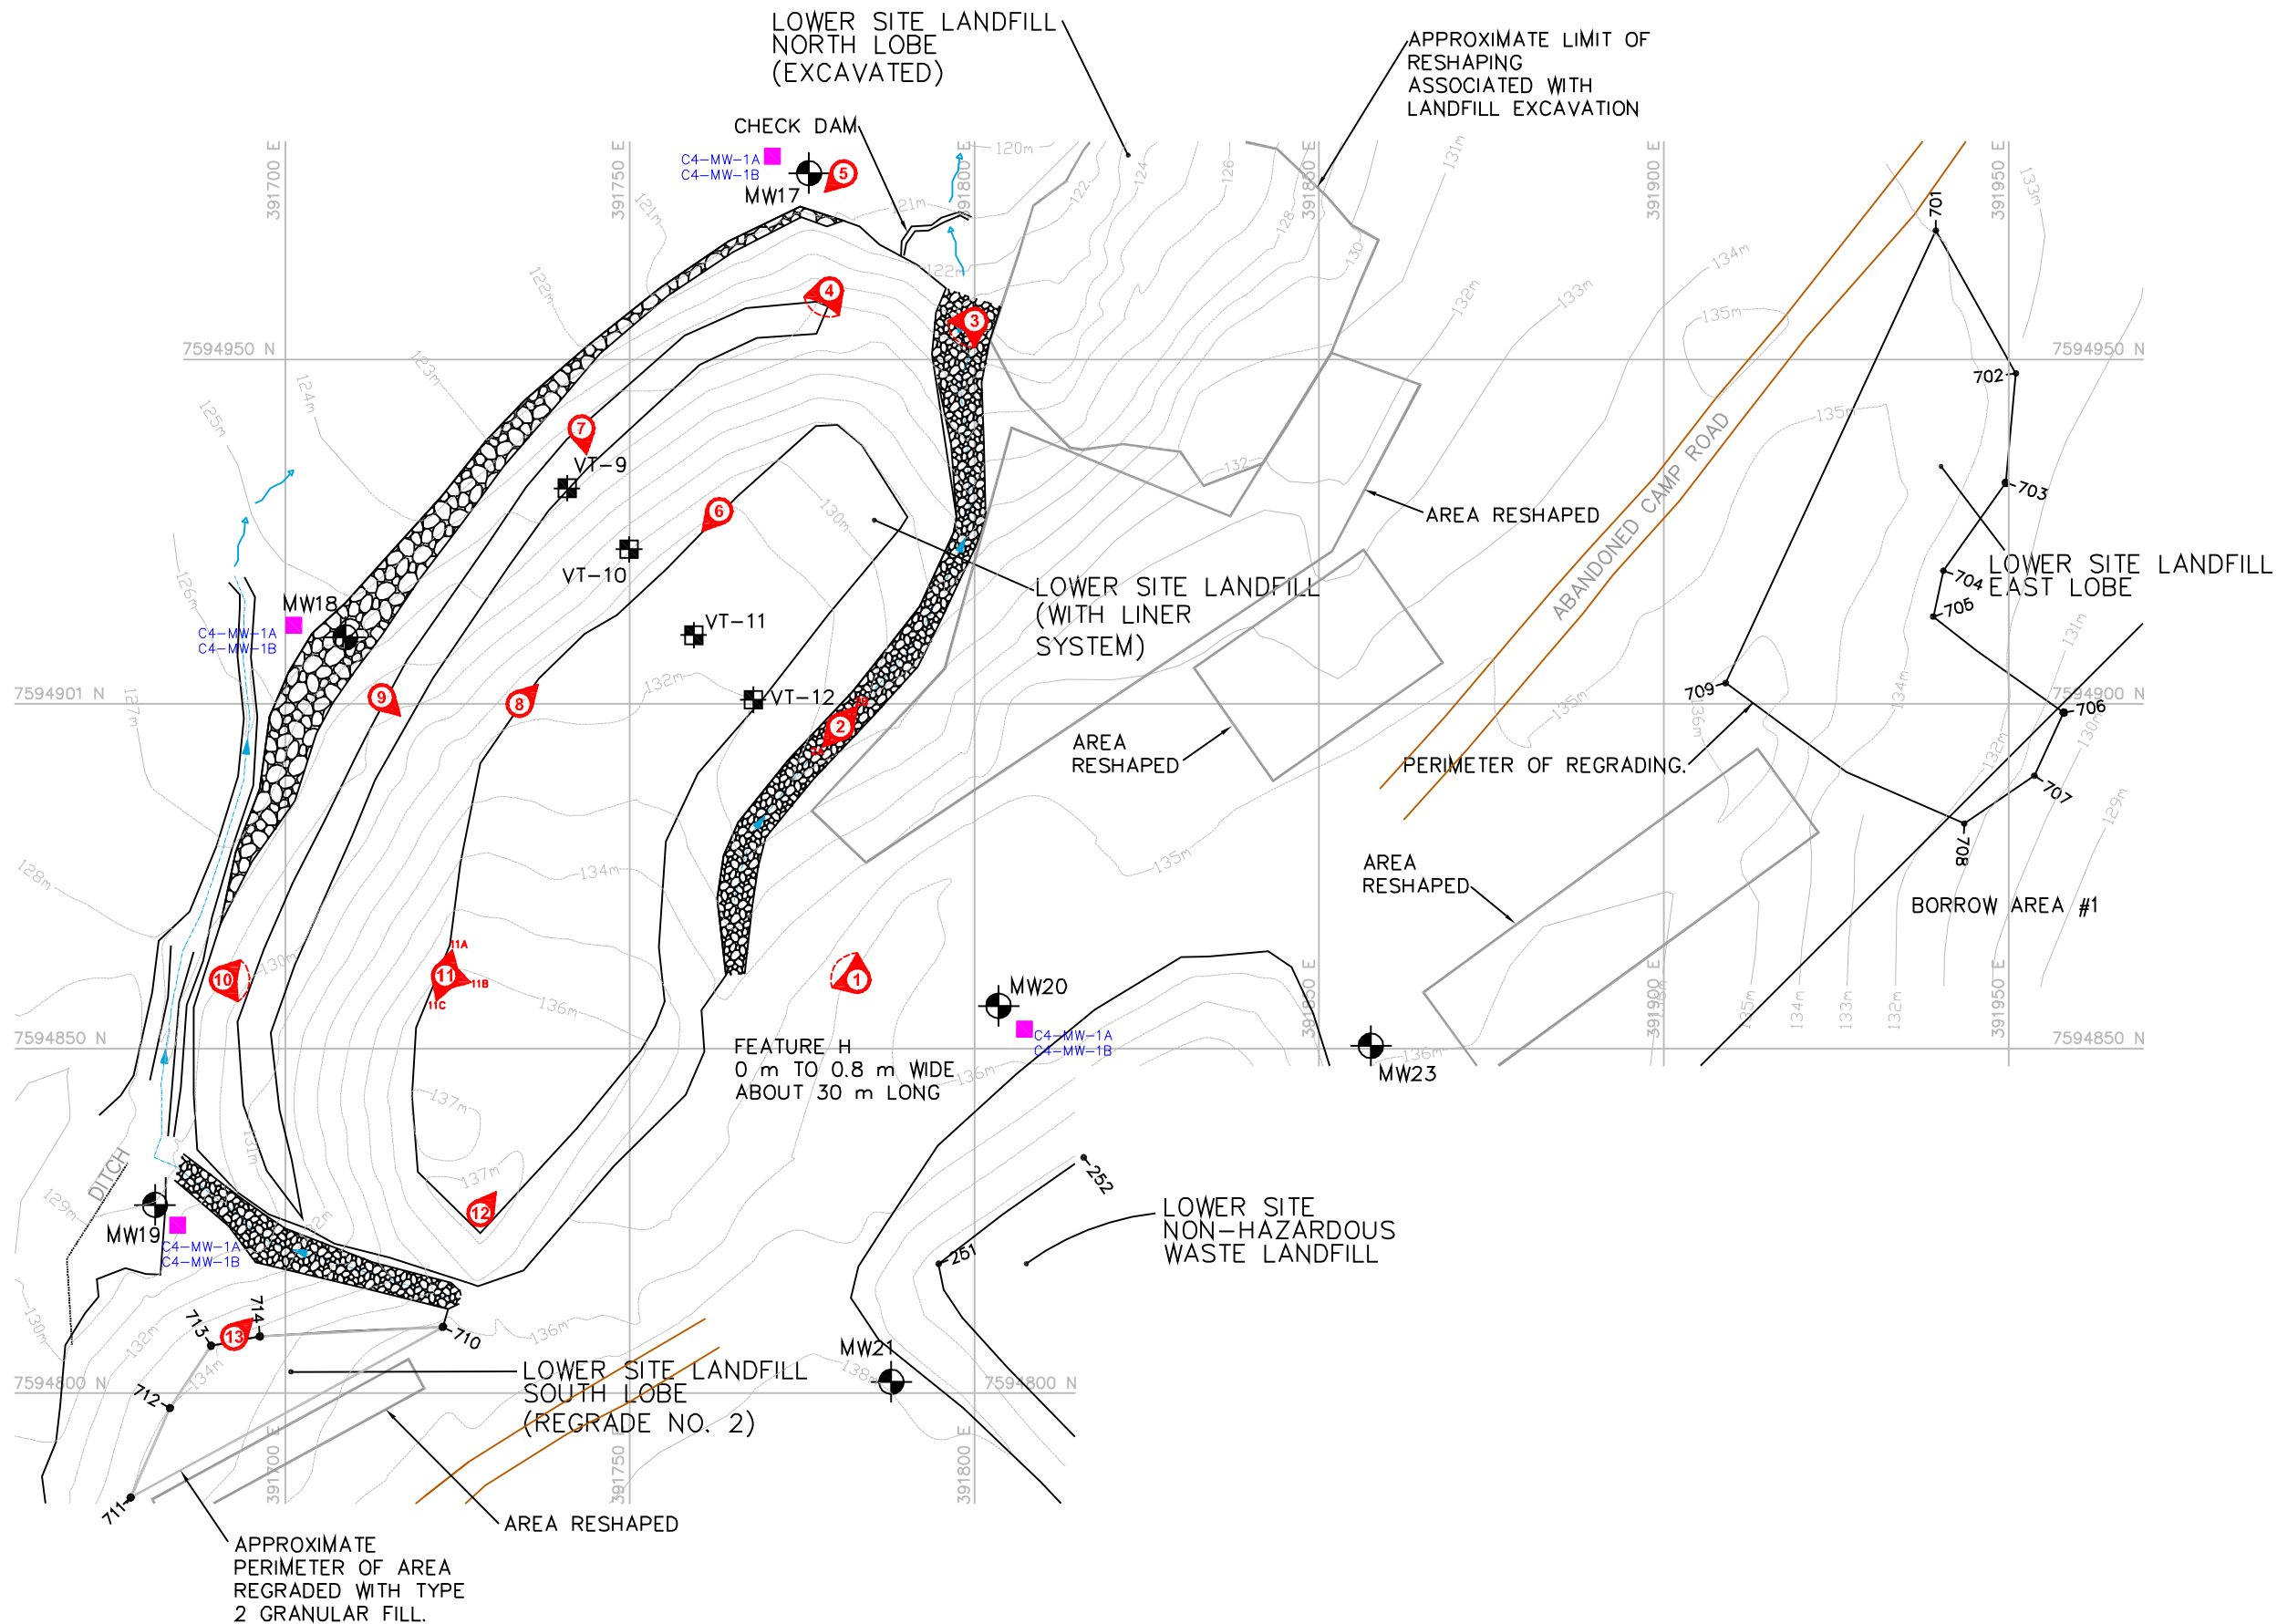


Legend

- TBM-4 □ TEMPORARY BENCHMARK
- BM-1 ▲ PERMANENT BENCHMARK
- 101- COORDINATE POINT
- C4-MW-1A C4-MW-1B ■ MONITORING SOIL SAMPLE LOCATION
- ⊕ MONITORING WELL LOCATION
- ⊕ VERTICAL THERMISTOR LOCATION
- ⑨ PHOTOGRAPH LOCATION

RECORD DRAWING
NOT FOR CONSTRUCTION

Map Sources / Notes:
Source drawing from UMA: C4-RD06.dwg

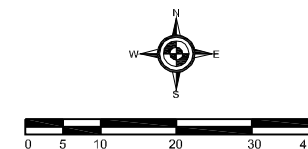

1 : 1000
UTM Zone 16W, NAD83

File Name: C4-RD06.dwg
Reviewed by: DCJ
Date Issued: October, 2008
Prepared by: KAB
Project Number: 80-297

Defence Construction Canada
2008 CAM-4 DEW Line Monitoring Program
CAM-4 Kugaaruk
Nunavut Territory

Lower Site Landfill

AECOM

Figure E-1
Version 1