


Date Plotted: October 16, 2006 Path: N:\Projects\2008\80297\2008\World\Progress\Documents\80297_4_CAM-4-FINAL-Report\ACAD_Files\C4-RD06.dwg

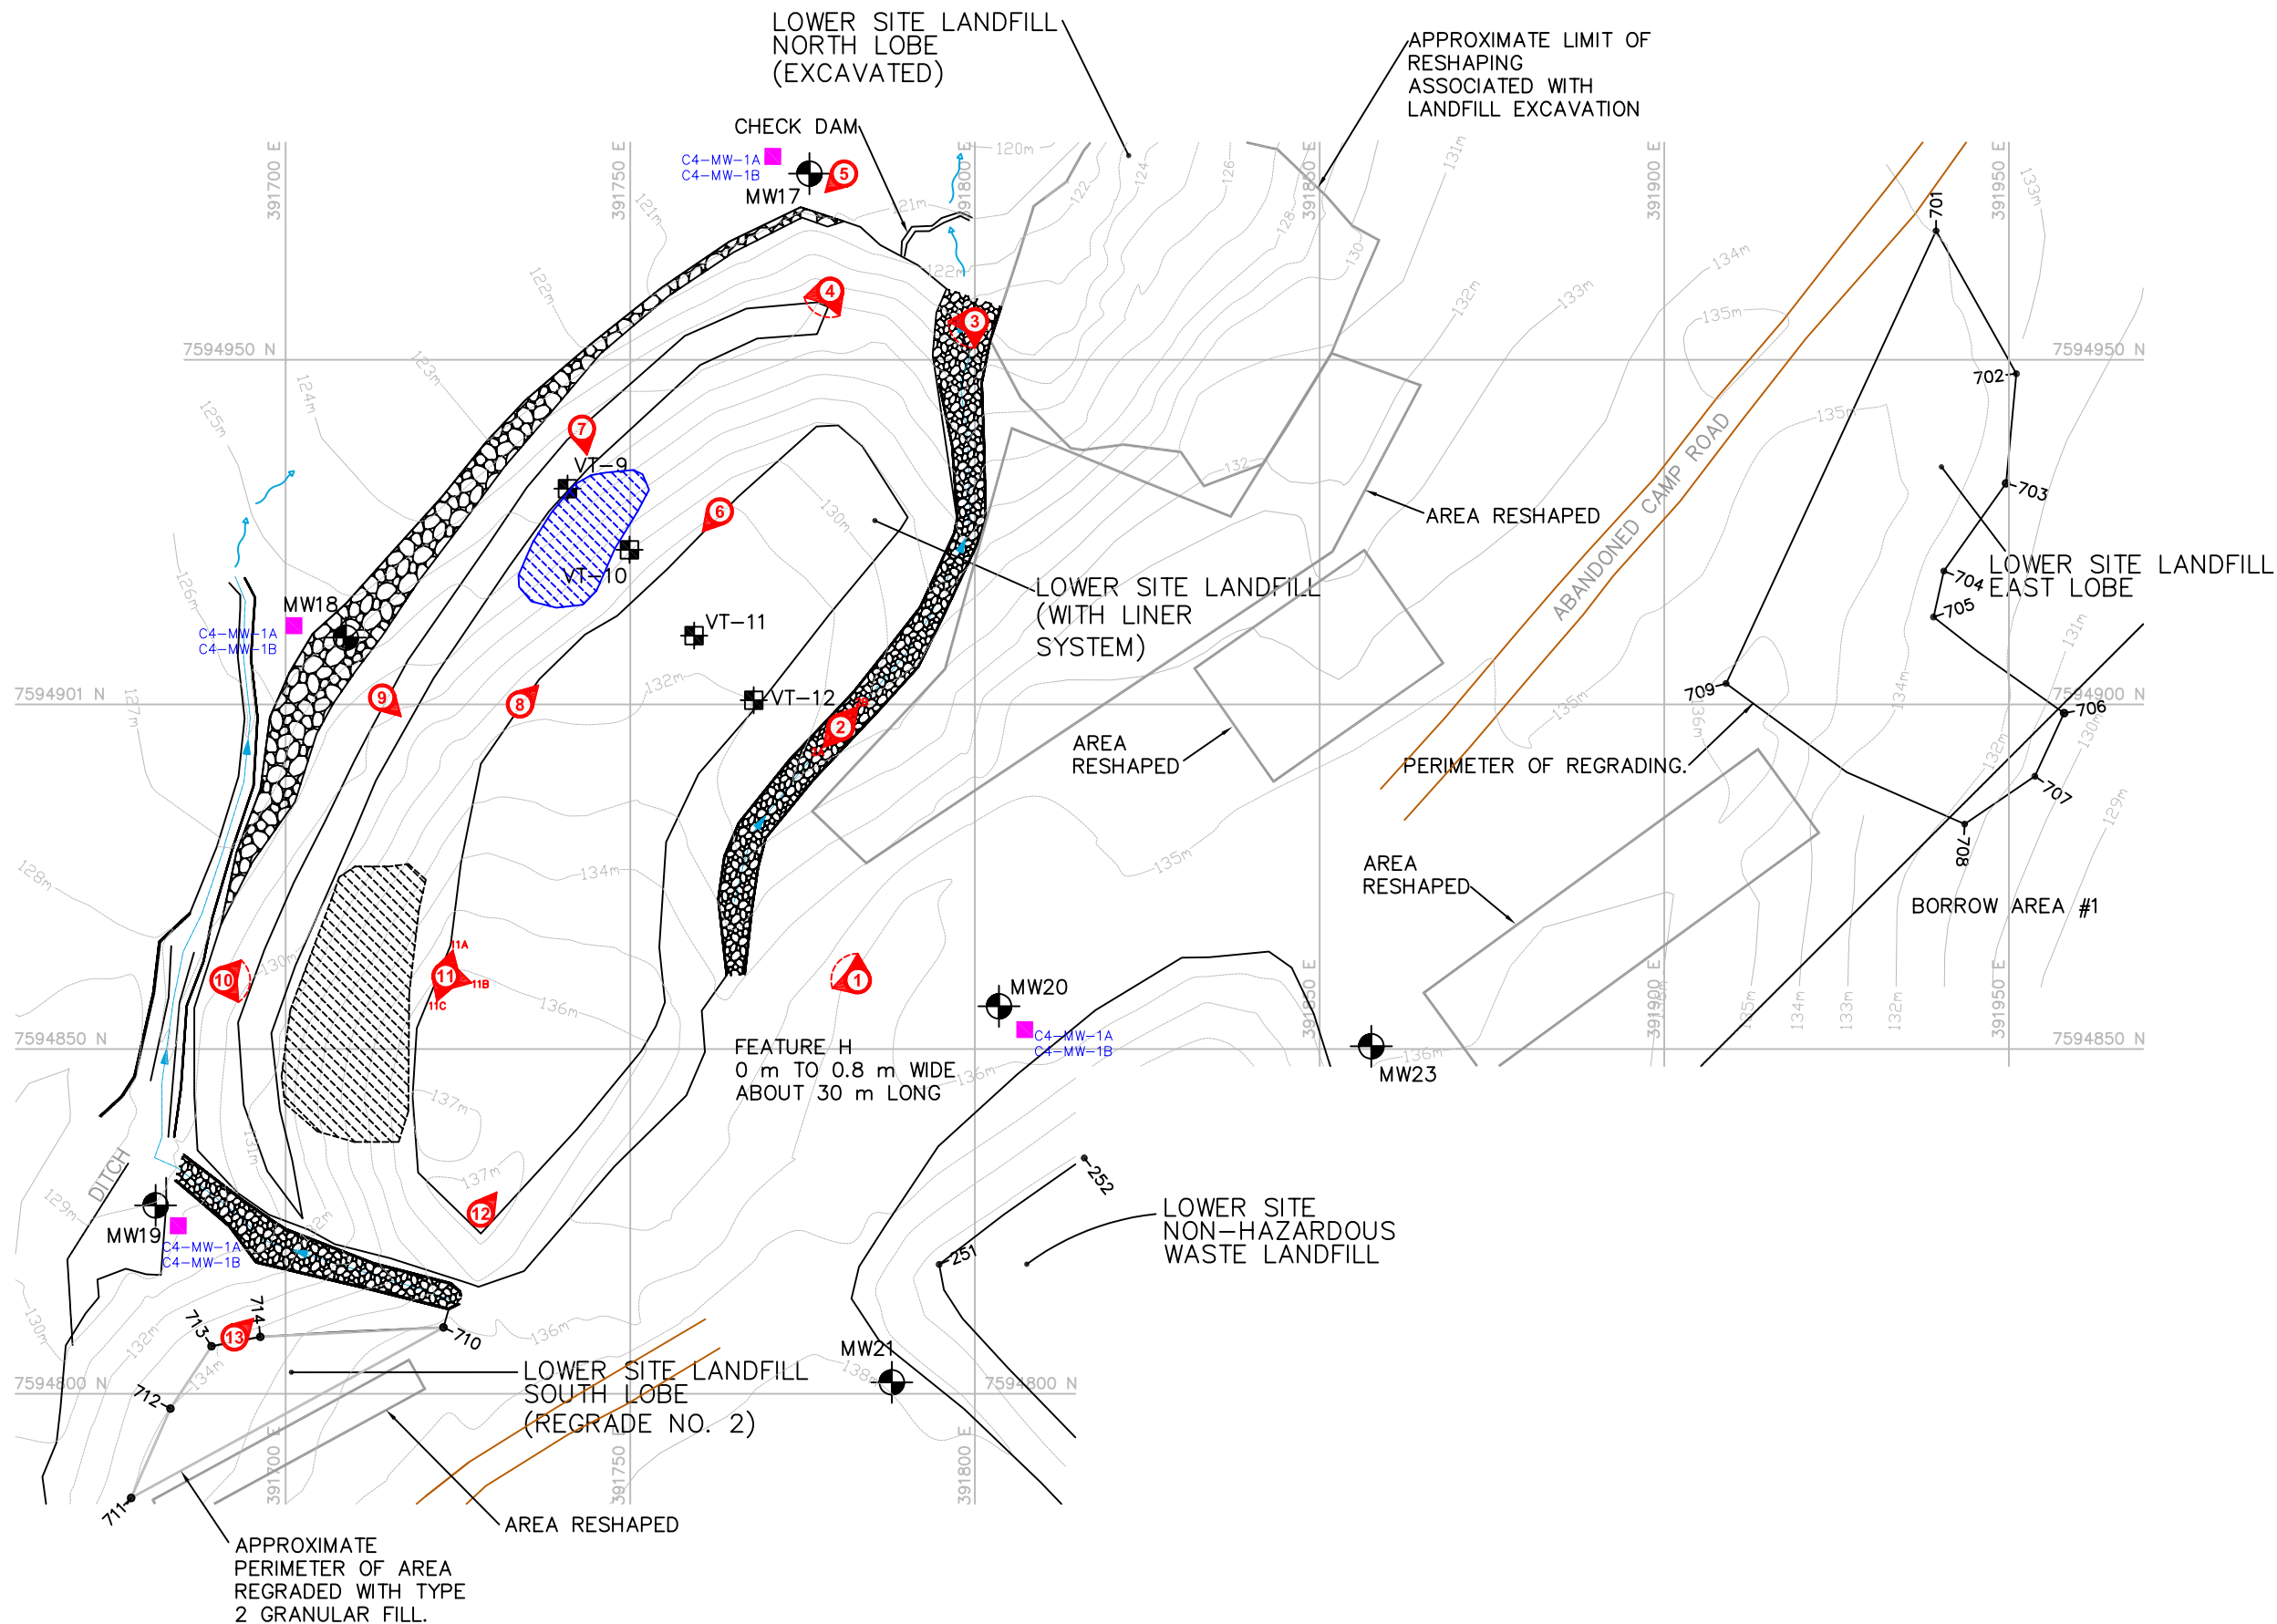

Legend

TBM4	TEMPORARY BENCHMARK
BM-1	PERMANENT BENCHMARK
101	COORDINATE POINT
C4-MW-1A C4-MW-1B	MONITORING SOIL SAMPLE LOCATION
[Symbol]	MONITORING WELL LOCATION
[Symbol]	VERTICAL THERMISTOR LOCATION
[Symbol]	PHOTOGRAPH LOCATION
[Symbol]	AREA OF MINOR SEEPAGE
[Symbol]	AREA OF MINOR EROSION

RECORD DRAWING
NOT FOR CONSTRUCTION

Map Sources / Notes:
-Source drawing from UMA: C4-RD06.dwg
-Photograph numbers refer to those found in Appendix E2 - Visual Inspection Photographs

Scale:
1 : 1000
UTM Zone 16W, NAD83

File Name: C4-RD06.dwg
Reviewed by: DCJ
Date Issued: October, 2008

Prepared by: KAB
Project Number: 80-297

Defence Construction Canada
2008 CAM-4 DEW Line Monitoring Program
CAM-4 Kugaaruk
Nunavut Territory

Lower Site Landfill

AECOM

Figure E-1
Version 1