




AS-BUILT DRAWING INDEX	
DRAWING NUMBER	TITLE
SITING	
AB-2002-102-01	LOCATION OF BORROW PITS USED DURING THE SEASON
AB-2002-102-02	GENERAL SITE LAYOUT AND AS-BUILT DRAWING INDEX
AB-2002-102-03	GENERAL LAYOUT OF, AND MODIFICATIONS MADE TO, THE UPPER WORKSITE
AB-2002-102-04	GENERAL LAYOUT OF, AND MODIFICATIONS MADE TO, THE MAIN PCB STORAGE FACILITY AND SURROUNDING AREA
AB-2002-102-05	GENERAL LAYOUT OF THE RADIO HILL AREA
AB-2002-102-06	GENERAL LAYOUT OF, AND MODIFICATIONS MADE TO, THE BEACH AREA
AB-2002-102-07	BEACH WASTE STORAGE AND STAGING AREAS
AB-2002-102-08	MODIFICATIONS MADE TO THE INCINERATION PLATFORM
AB-2002-102-09	S1/S4 BUILDING AND DRAINAGE AREA GRIDDING SYSTEM
FIRE SAFETY	
99-102-FSM	FIRE SAFETY PLAN - CORE CAMP LAYOUT -
99-102-FS1	FIRE SAFETY PLAN - CORE CAMP -
99-102-FS2	FIRE SAFETY PLAN - REC. ROOM / SUPERINTENDENT OFFICE / LAUNDRY ROOM / WORKSHOPS -
99-102-FS3	FIRE SAFETY PLAN - WAREHOUSE / MEDIC OFFICE / HEALTH & SAFETY OFFICE -
99-102-FS4	FIRE SAFETY PLAN - GARAGE -
99-102-FS5	FIRE SAFETY PLAN - TRAINING CENTRE -



**BAF-5 RESOLUTION ISLAND
2002 AS-BUILT DRAWINGS**

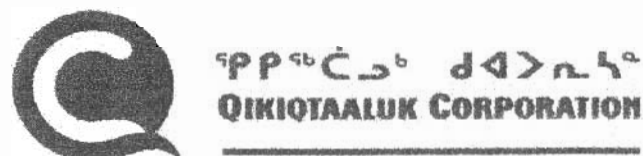

2002 ⁹C>7L7C 00^{9b}76ΔC



NOVEMBER 2002



INDIAN AND NORTHERN
AFFAIRS CANADA

NUNAVUT REGIONAL OFFICE

GENERAL NOTES:

1. LOCATIONS OF BORROW AREAS ARE APPROXIMATE AND NOT SURVEYED.

LEGEND:

No.	DATE	REVISION	REVISION	APPR.
-----	------	----------	----------	-------



SCALE - ÉCHELLE 200 100 0 200 400 m

PROJECT - PROJET
BAF-5 RESOLUTION ISLAND

© COPYRIGHT HER MAJESTY THE QUEEN
IN THE RIGHT OF CANADA 2002,
AS REPRESENTED BY INDIAN AND
NORTHERN AFFAIRS CANADA

TRADE - MÉTIER
SITING

DATE
2002-11-28

SUBJECT - SUJET

LOCATION OF BORROW PITS USED DURING
THE WORK SEASON

PRODUCTION	CONCURRENCE - ASSENTIMENT
DESIGNED ÉTUDE	P.S.
DRAWN Dessin	G.J.
CHECKED VÉRIFIÉ	K.C.
COORDINATION	REVIEWED - REVU


CHG. NO. - DESIGN NO.
AB-2002-102-01

Canada

RADIO HILL BORROW PIT
910 m³ OF SAND AND GRAVEL EXCAVATED

LAKE BORROW PIT #2
NOT USED DURING THE 2002 WORK SEASON

LOWER LAKE BORROW PIT
NOT USED DURING THE 2002 WORK SEASON

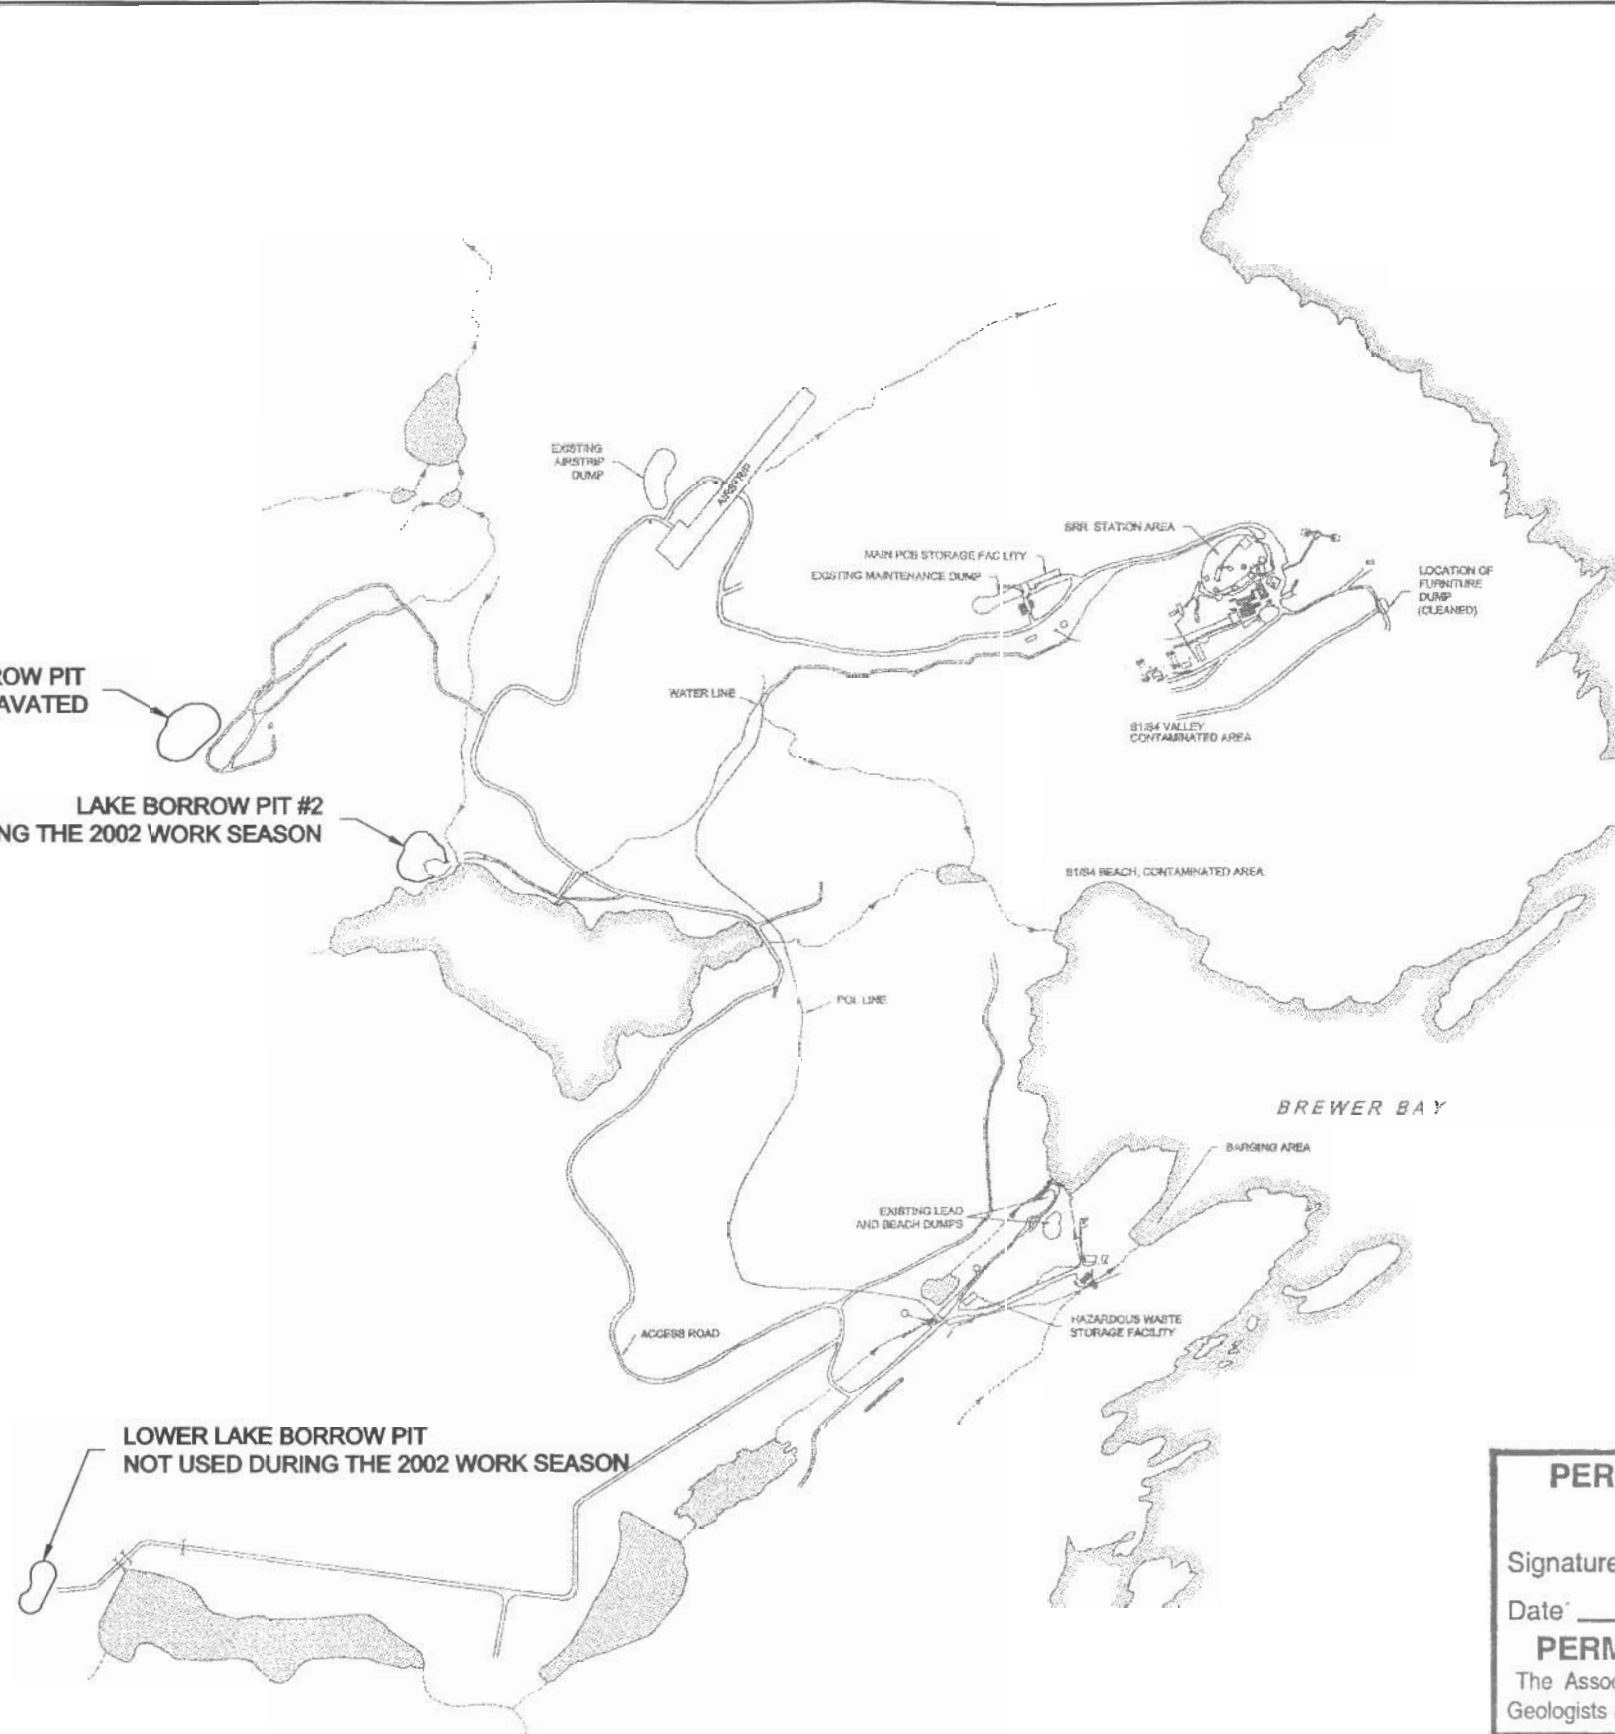

PERMIT TO PRACTICE
SINANNI INC.


Signature *K. Cote*

Date: 03/01/29

PERMIT NUMBER: P 410

The Association of Professional Engineers,
Geologists and Geophysicists of the N.W.T.


RADIO HILL BORROW AREA
DRAWING AB-2002-102-05

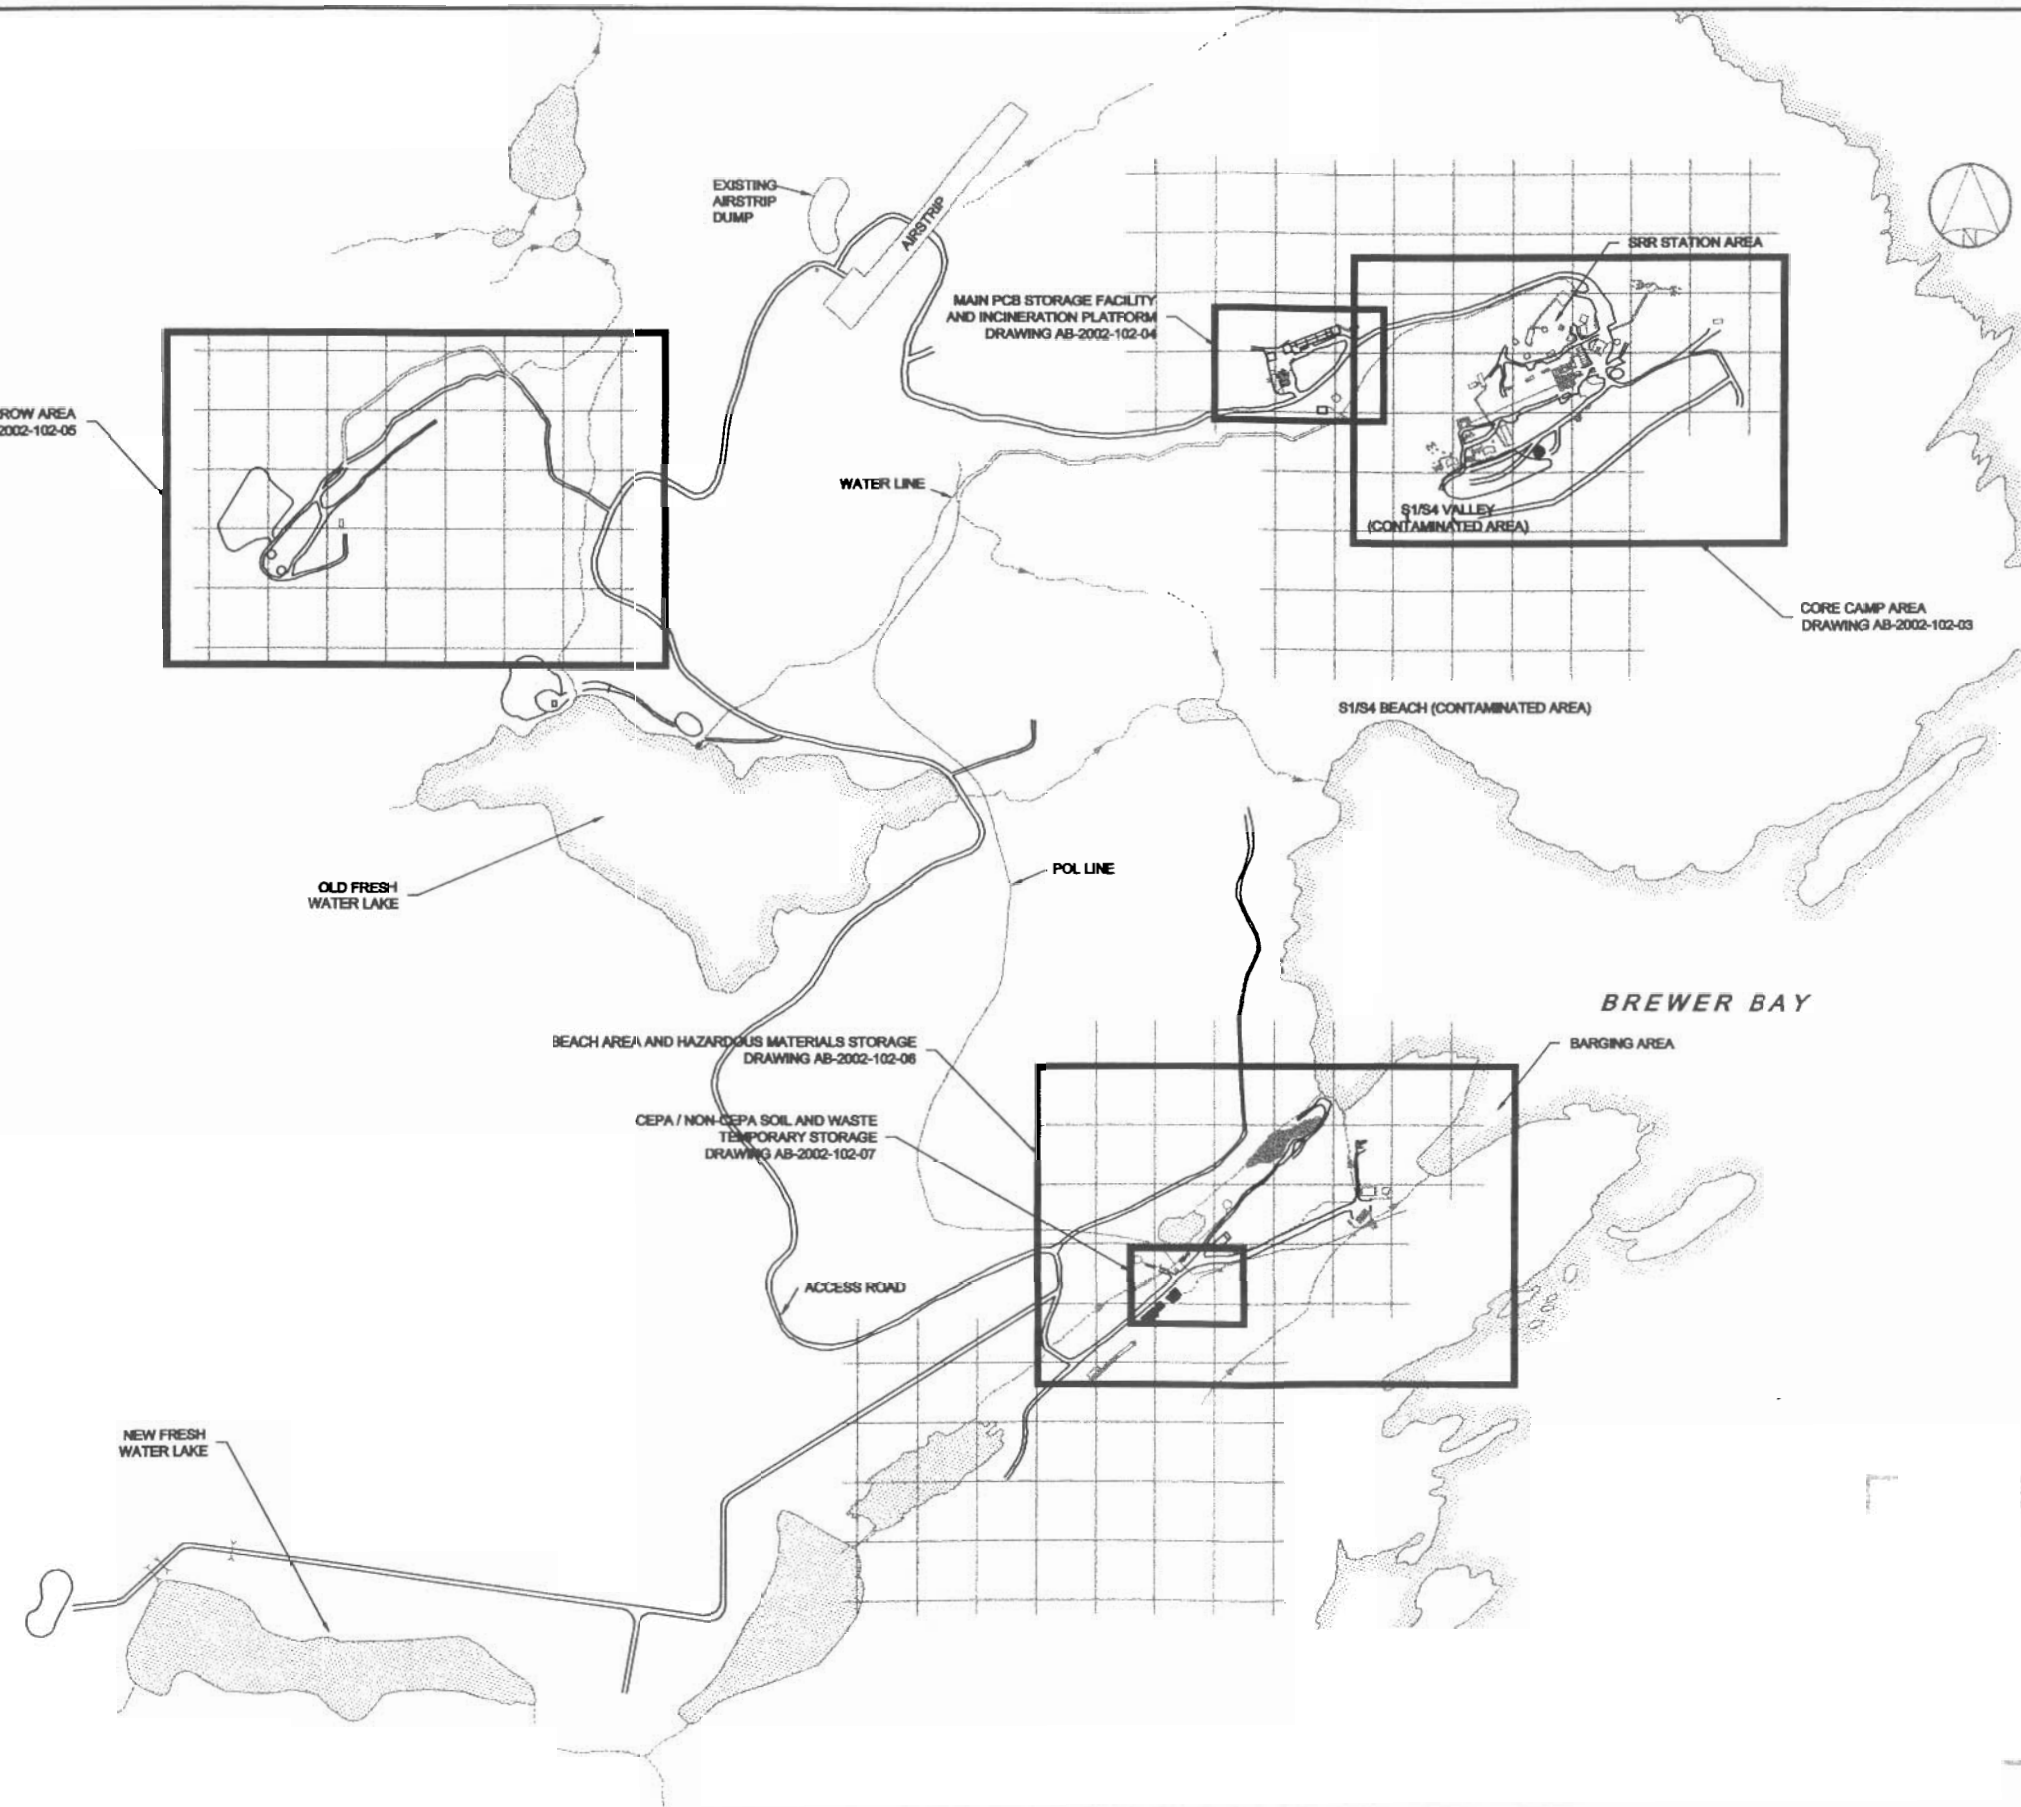

mlbt
03/01/29

IN THE RIGHT OF CANADA
NWT / NU

INDIAN AND NORTHERN AFFAIRS CANADA																											
NUNAVUT REGIONAL OFFICE																											
General Notes:																											
Legend:																											
<table border="1"> <thead> <tr> <th>NO.</th> <th>DATE</th> <th>REVISION</th> <th>REVISION</th> <th>APPR.</th> </tr> </thead> <tbody> <tr> <td> </td> <td> </td> <td> </td> <td> </td> <td> </td> </tr> </tbody> </table>	NO.	DATE	REVISION	REVISION	APPR.						Sinanni Inc. SCALE - ECHELLE 1:50 0 100 200 300 m PROJECT - PROJET BAF-5 RESOLUTION ISLAND © COPYRIGHT HER MAJESTY THE QUEEN IN THE RIGHT OF CANADA 2002, AS REPRESENTED BY INDIAN AND NORTHERN AFFAIRS CANADA <table border="1"> <tr> <td>TRADE - METIER</td> <td>SITING</td> <td>DATE</td> <td>2002-11-28</td> </tr> </table> SUBJECT - SUJET GENERAL SITE LAYOUT AND AS BUILT DRAWING INDEX <table border="1"> <thead> <tr> <th>PRODUCTION</th> <th>CONCURRENCE - ASSENTIMENT</th> </tr> </thead> <tbody> <tr> <td>DESIGNED ETUDE</td> <td>P.S.</td> </tr> <tr> <td>DRAWN DESSINE</td> <td>G.J.</td> </tr> <tr> <td>CHECKED VERIFIE</td> <td>K.C.</td> </tr> <tr> <td>COORDINATION</td> <td>REVIEWED - REVU</td> </tr> </tbody> </table> DWG. NO. - DESSIN NO. AB-2002-102-02 Canada			TRADE - METIER	SITING	DATE	2002-11-28	PRODUCTION	CONCURRENCE - ASSENTIMENT	DESIGNED ETUDE	P.S.	DRAWN DESSINE	G.J.	CHECKED VERIFIE	K.C.	COORDINATION	REVIEWED - REVU
NO.	DATE	REVISION	REVISION	APPR.																							
TRADE - METIER	SITING	DATE	2002-11-28																								
PRODUCTION	CONCURRENCE - ASSENTIMENT																										
DESIGNED ETUDE	P.S.																										
DRAWN DESSINE	G.J.																										
CHECKED VERIFIE	K.C.																										
COORDINATION	REVIEWED - REVU																										

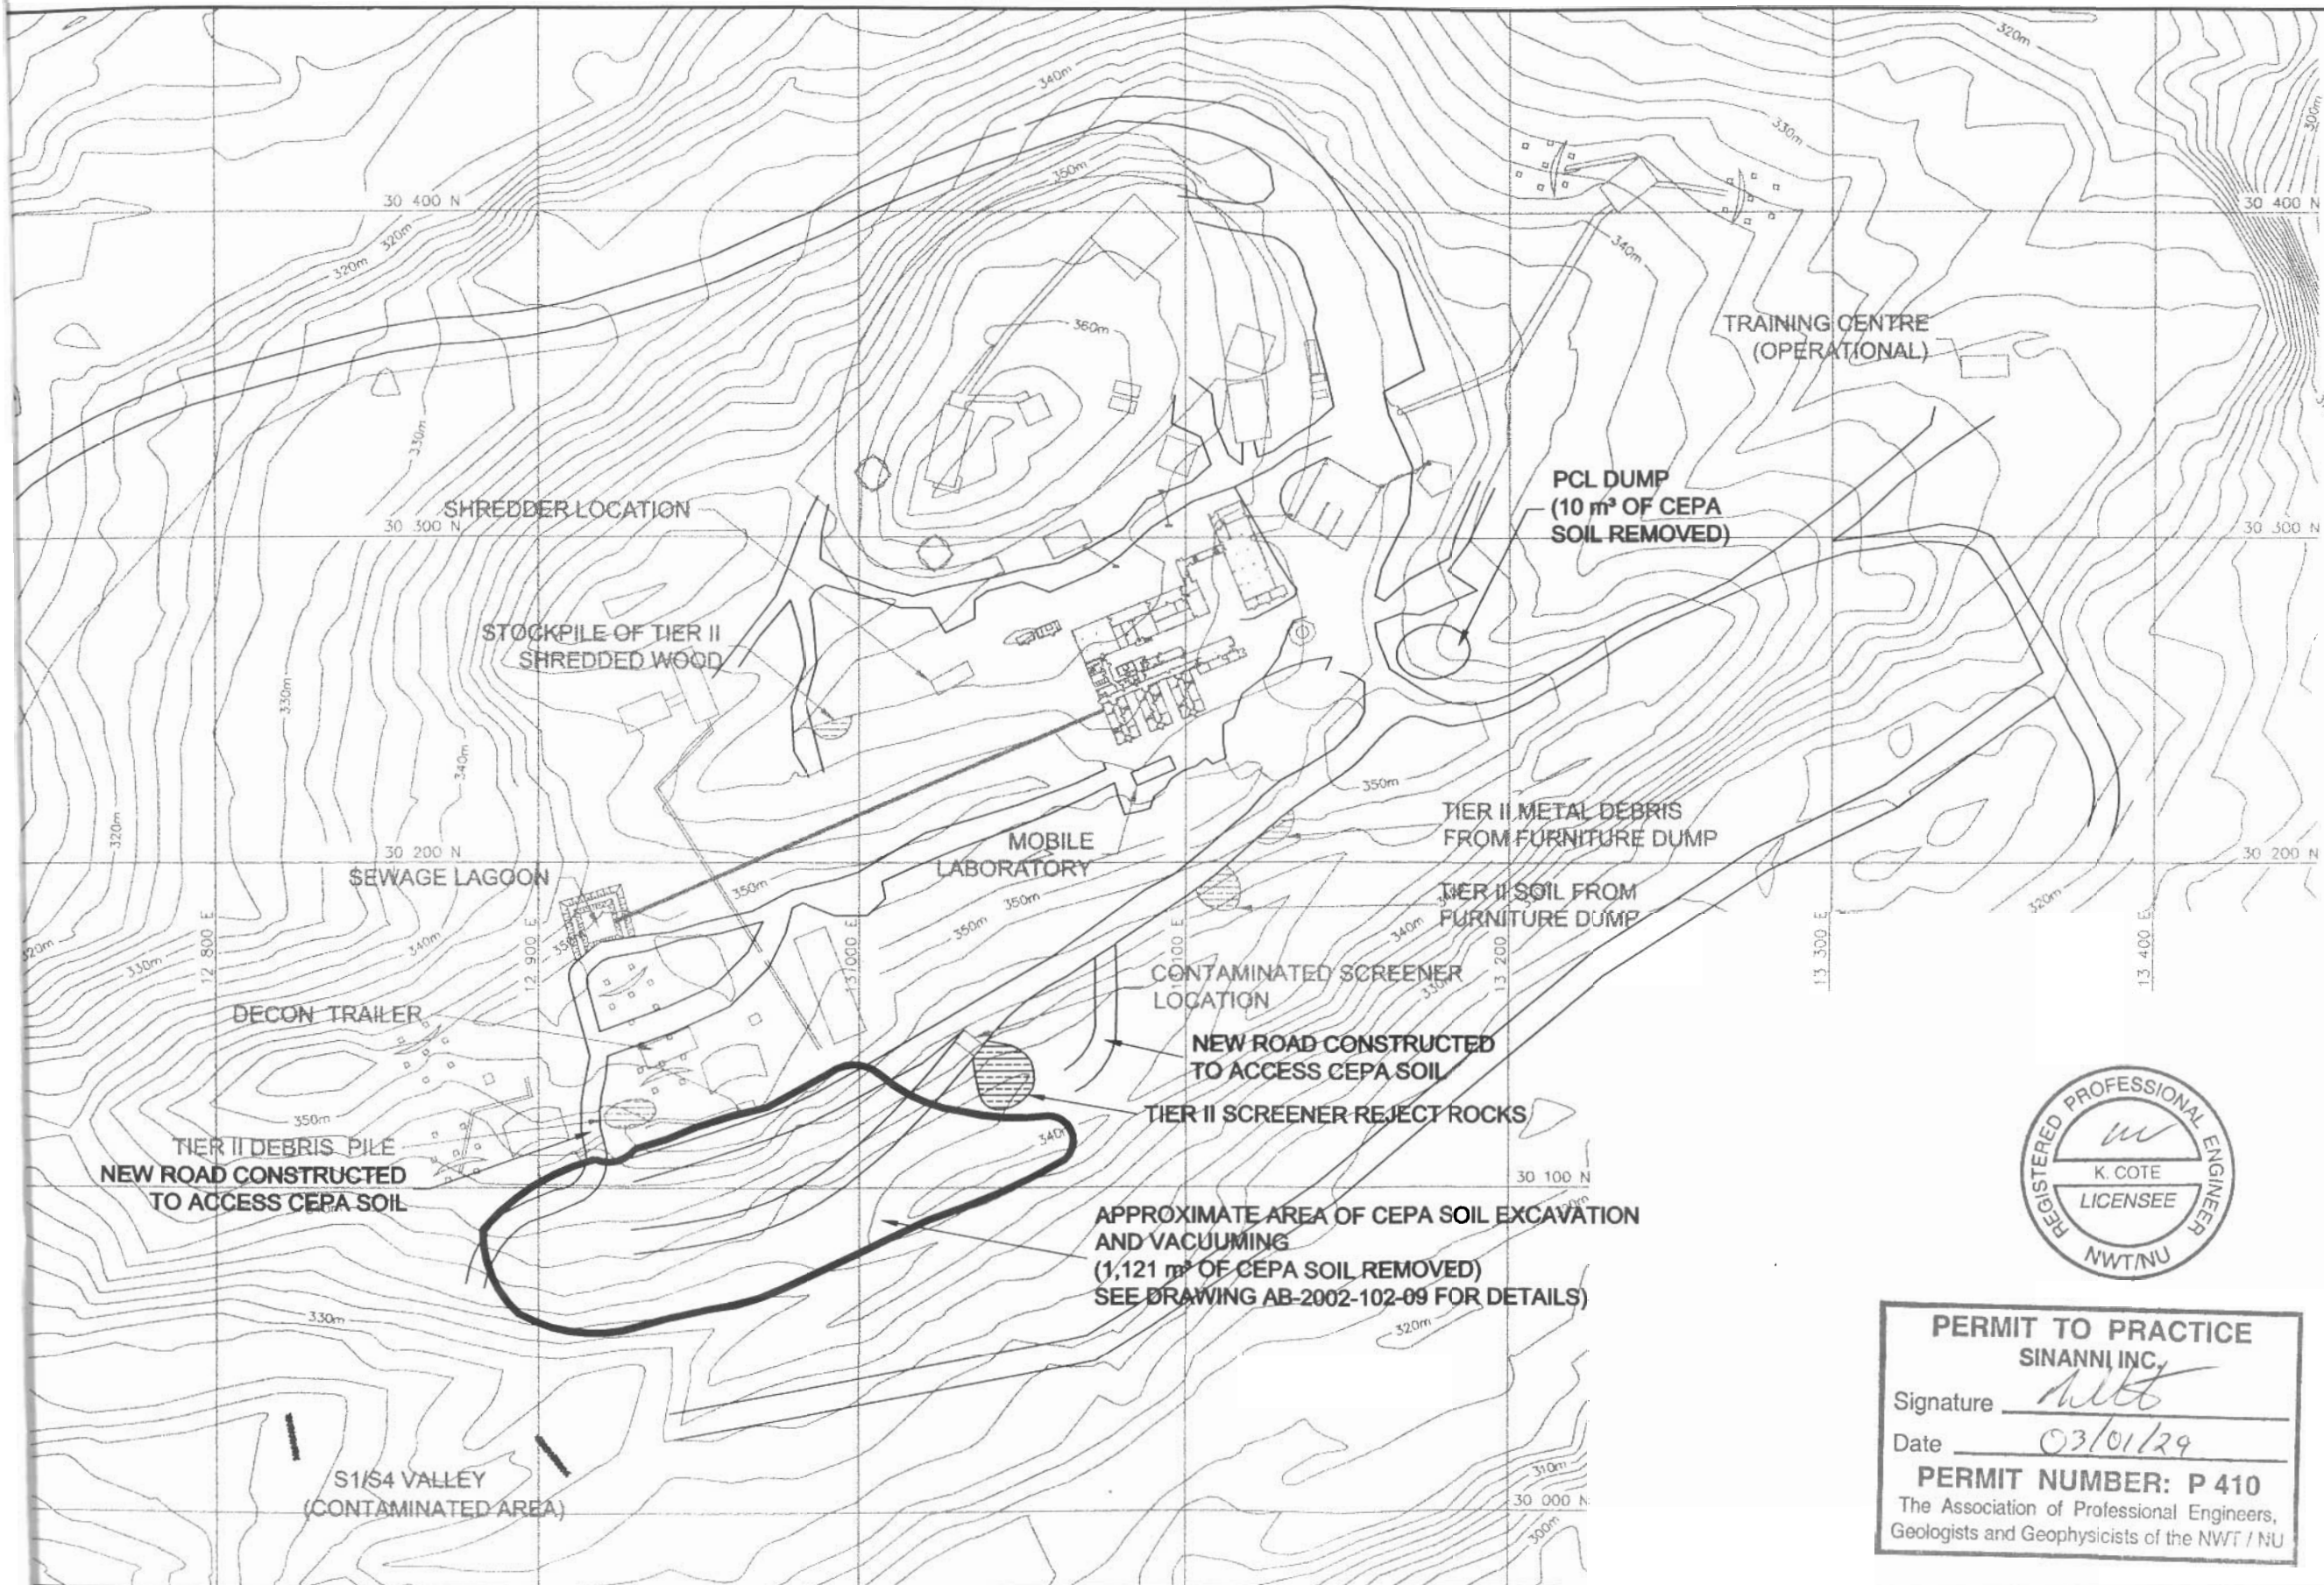

INDIAN AND NORTHERN AFFAIRS CANADA

NUNAVUT REGIONAL OFFICE

GENERAL NOTES:

1. NEW ROAD LOCATIONS ARE APPROXIMATE AND NOT SURVEYED.
2. REFER TO DRAWING AB-2002-102-08 FOR DETAILS ON CONTAMINATED SOIL REMOVAL FROM THE S1/S4 VALLEY AREA.

LEGEND:

BURIED ELECTRICAL LINE

NO.	DATE	REVISION	REVISION	APPR.

Sinanni Inc.

SCALE - ECHELLE 1:500

PROJECT - PROJET

BAF-5 RESOLUTION ISLAND

© COPYRIGHT HER MAJESTY THE QUEEN IN THE RIGHT OF CANADA 2002, AS REPRESENTED BY INDIAN AND NORTHERN AFFAIRS CANADA

TRADE - METIER	SITING	DATE
		2002-11-28

SUBJECT - SUJET

GENERAL LAYOUT OF, AND MODIFICATIONS MADE TO, THE UPPER SITE

PRODUCTION	CONCURRENCE - AGREEMENT
DESIGNED ETUDE	P.S.
DRAWN DESSINE	G.J.
CHECKED VERIFIE	K.C.
COORDINATION	REVIEWED - REVU

DRAWING NO. - DESSIN NO.
AB-2002-102-03

REGISTERED PROFESSIONAL ENGINEER

K. COTE

LICENSEE

NWT/NU

PERMIT TO PRACTICE


SINANNI INC.

Signature

Date 03/01/29

PERMIT NUMBER: P 410

The Association of Professional Engineers, Geologists and Geophysicists of the NWT / NU

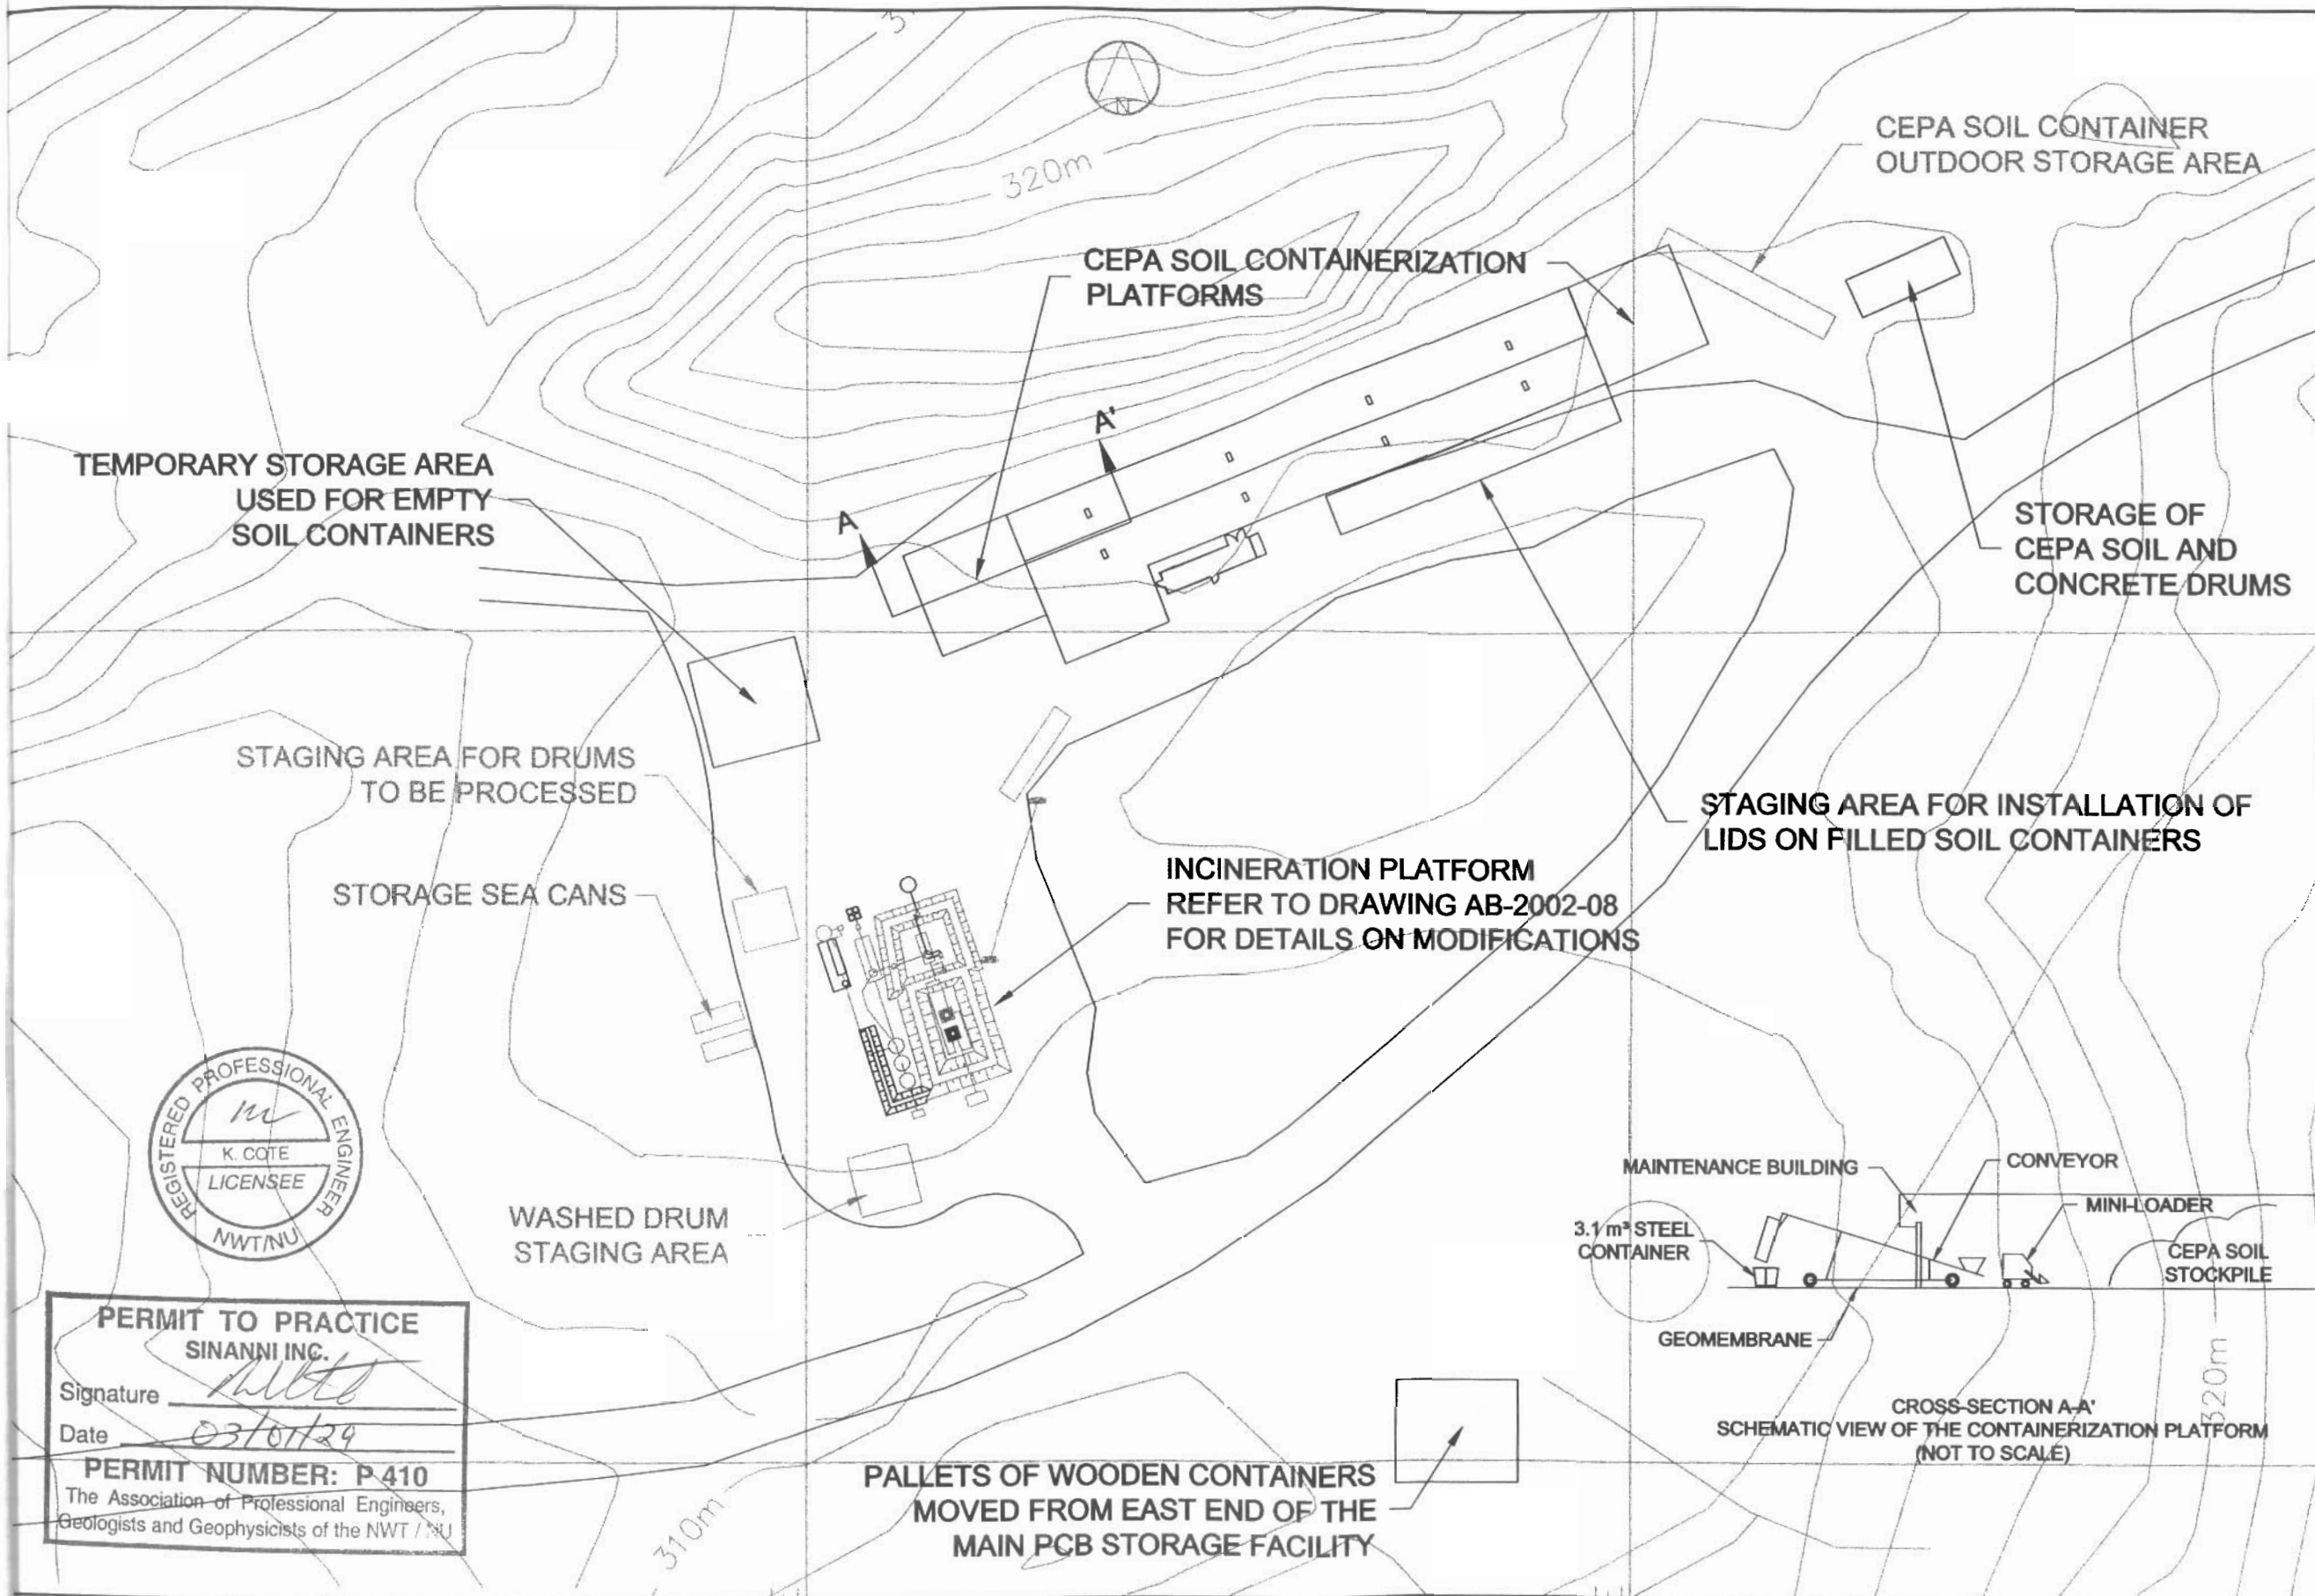

INDIAN AND NORTHERN AFFAIRS CANADA			
NUNAVUT REGIONAL OFFICE			
General Notes: 1.			
Legend: (---) BURIED ELECTRICAL LINE			
Sinanni Inc.			
PROJECT - PROJET BAF-5 RESOLUTION ISLAND			
© COPYRIGHT HER MAJESTY THE QUEEN IN THE RIGHT OF CANADA 2002, AS REPRESENTED BY INDIAN AND NORTHERN AFFAIRS CANADA			
TRADE - METIER SITING	DATE 2002-11-28		
SUBJECT - SUJET GENERAL LAYOUT OF, AND MODIFICATIONS MADE TO, THE MAIN PCB STORAGE FACILITY AND SURROUNDING AREA			
PRODUCTION DESIGNED ETUDIE DRAWN DESSINE CHECKED VERIFIE COORDINATION	CONCURRENCE - ASSENTIMENT P.S. G.J. K.C. REVIEWED - REVU		
DWSL NO. - DESIGN NO. AB-2002-102-04			



PERMIT TO PRACTICE
SINANNI INC.
 Signature [Signature]
 Date 03/01/29
PERMIT NUMBER: P 410
 The Association of Professional Engineers,
 Geologists and Geophysicists of the NWT / NU