

Appendix 3

Resolution Island Final As Build Drawings (February, 2007)




AS-BUILT DRAWING INDEX	
DRAWING NUMBER	TITLE
SITING	
AB-2006-102-01	LOCATION OF BORROW PITS USED DURING THE 2005 SEASON
AB-2006-102-02	GENERAL SITE LAYOUT AND AS-BUILT DRAWING INDEX (END OF PROJECT)
AB-2006-102-03	GENERAL LAYOUT OF THE UPPER SITE (END OF PROJECT)
AB-2006-102-04	GENERAL LAYOUT OF THE AREA SURROUNDING THE TIER II LANDFILL AND THE LAND FARM PLATFORM (END OF PROJECT)
AB-2005-102-05	GENERAL LAYOUT OF THE BEACH AREA (END OF PROJECT)
AB-2005-102-06	SURVEYED DRAWING OF THE TIER II LANDFILL
AB-2005-102-07	CROSS-SECTIONS OF THE TIER II LANDFILL (DRAWING 1 OF 2)
AB-2005-102-08	CROSS-SECTIONS OF THE TIER II LANDFILL (DRAWING 2 OF 2)



2006 $\langle \rho_C \rangle_L^C$ $\Pi \Pi^b \Delta^C$



February 2007

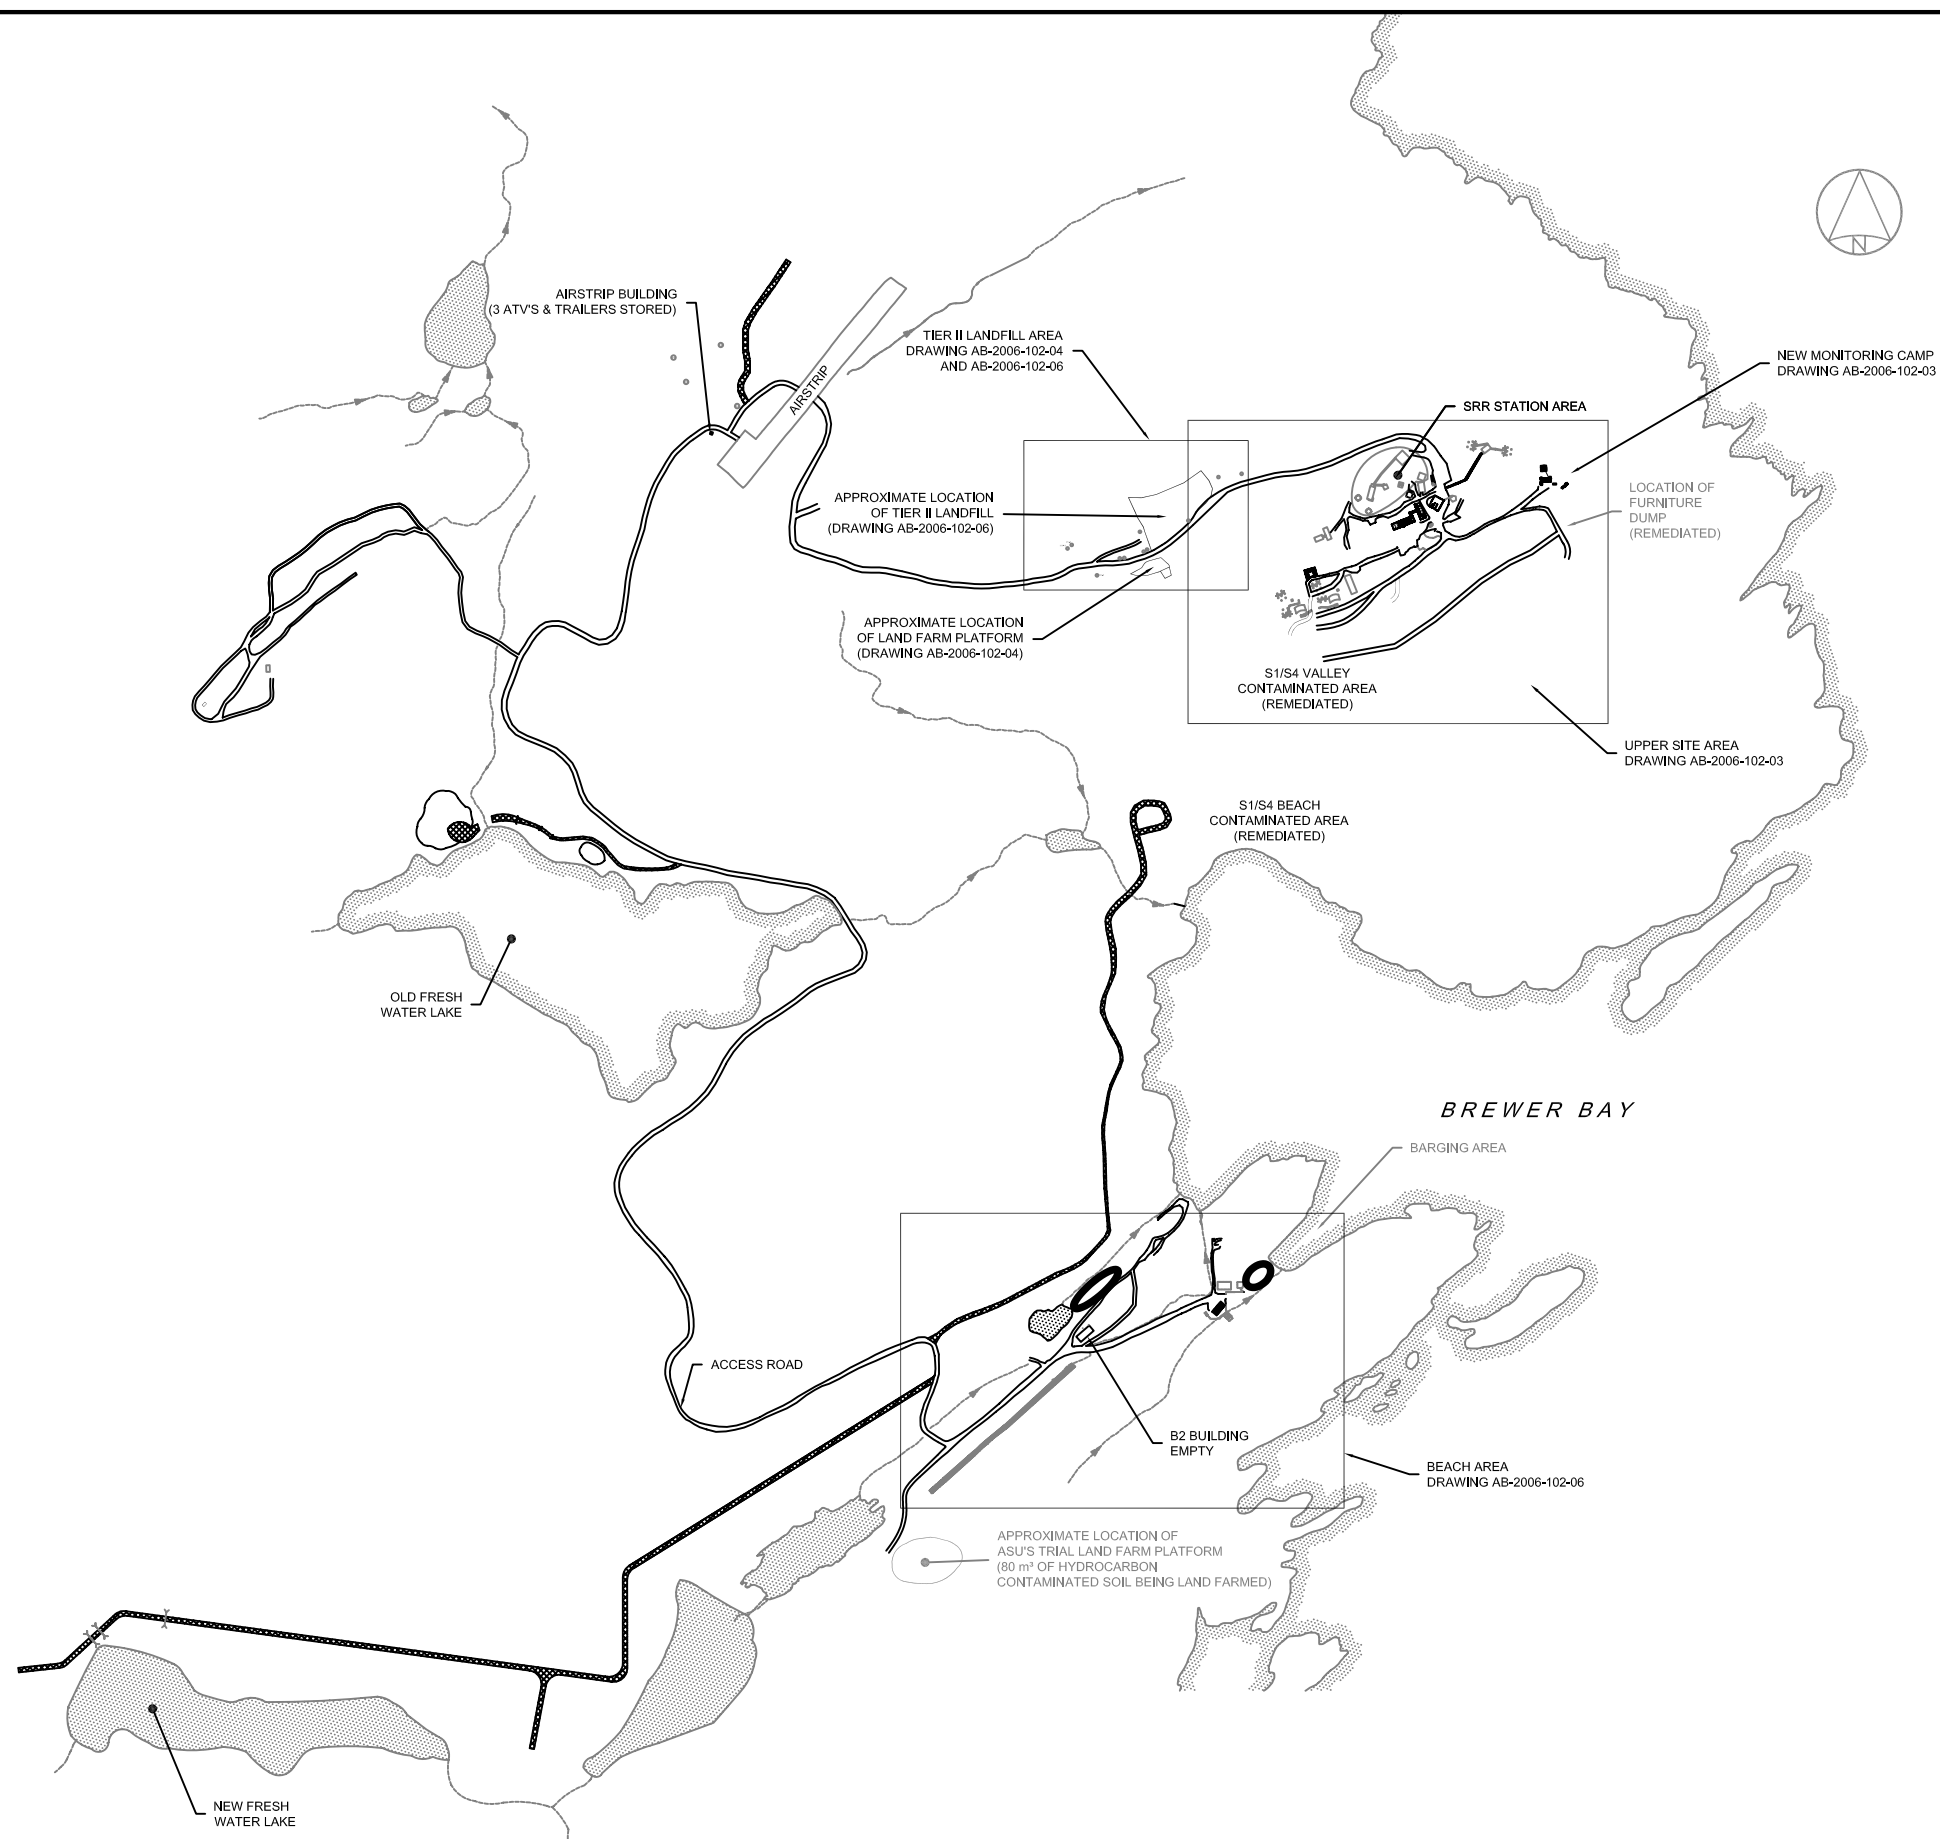

NUNAVUT REGIONAL OFFICE

General Notes:

1. ALL DECOMMISSIONED ROADS HAD CULVERTS REMOVED AND WERE REGRADED TO MATCH SURROUNDING TERRAIN.

Legend:

No.	DATE	REVISION	REVISION	APPR.



SCALE - ÉCHELLE 100 50 0 100 200 300 m

PROJECT - PROJCT

BAF-5 RESOLUTION ISLAND

© COPYRIGHT HER MAJESTY THE QUEEN
IN THE RIGHT OF CANADA 2006,
AS REPRESENTED BY INDIAN AND
NORTHERN AFFAIRS CANADA


TRADE - MÉTIER	SITING	DATE
		2007-01-24

SUBJECT - SUJET

GENERAL SITE LAYOUT AND AS BUILT DRAWING
INDEX
(END OF PROJECT)

PRODUCTION	CONCURRENCE - ASSESSMENT
DESIGNED ÉTUDE	G.J.
DRAWN DESSINE	G.J.
CHECKED VÉRIFIÉ	P.S.
COORDINATION	REVIEWED - REVU C.M.


DWG. NO. - DESSIN NO.
AB-2006-102-02

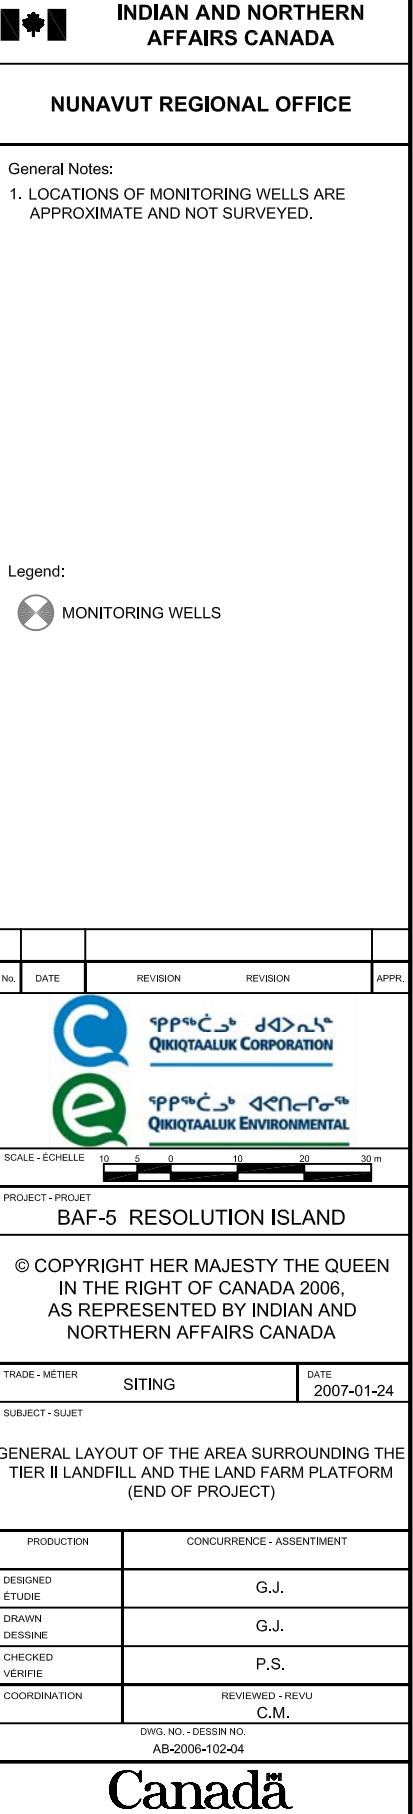



BENCHMARKS				
NO.	COORDINATES		ELEVATION	DESCRIPTION
	NORTH	EAST		
1	6830136.76	412830.56	353.58	MEDALLION
2	6830234.87	412899.16	346.35	MEDALLION
3	6830284.64	412948.08	356.48	MEDALLION
4	6830272.12	412737.94	316.47	CROSS
5	6830296.91	412838.57	330.15	PIPE & NAIL
6	6830389.58	412728.35	316.80	PIPE & NAIL

THERMISTORS				
NO.	COORDINATES		ELEVATION	DESCRIPTION
	NORTH	EAST		
VT-1	6830321.32	412686.28	318.10	PIPE
VT-2	6830298.80	412651.28	317.33	PIPE
VT-3	6830272.50	412674.09	315.88	PIPE
VT-4	6830303.61	412701.22	316.84	PIPE

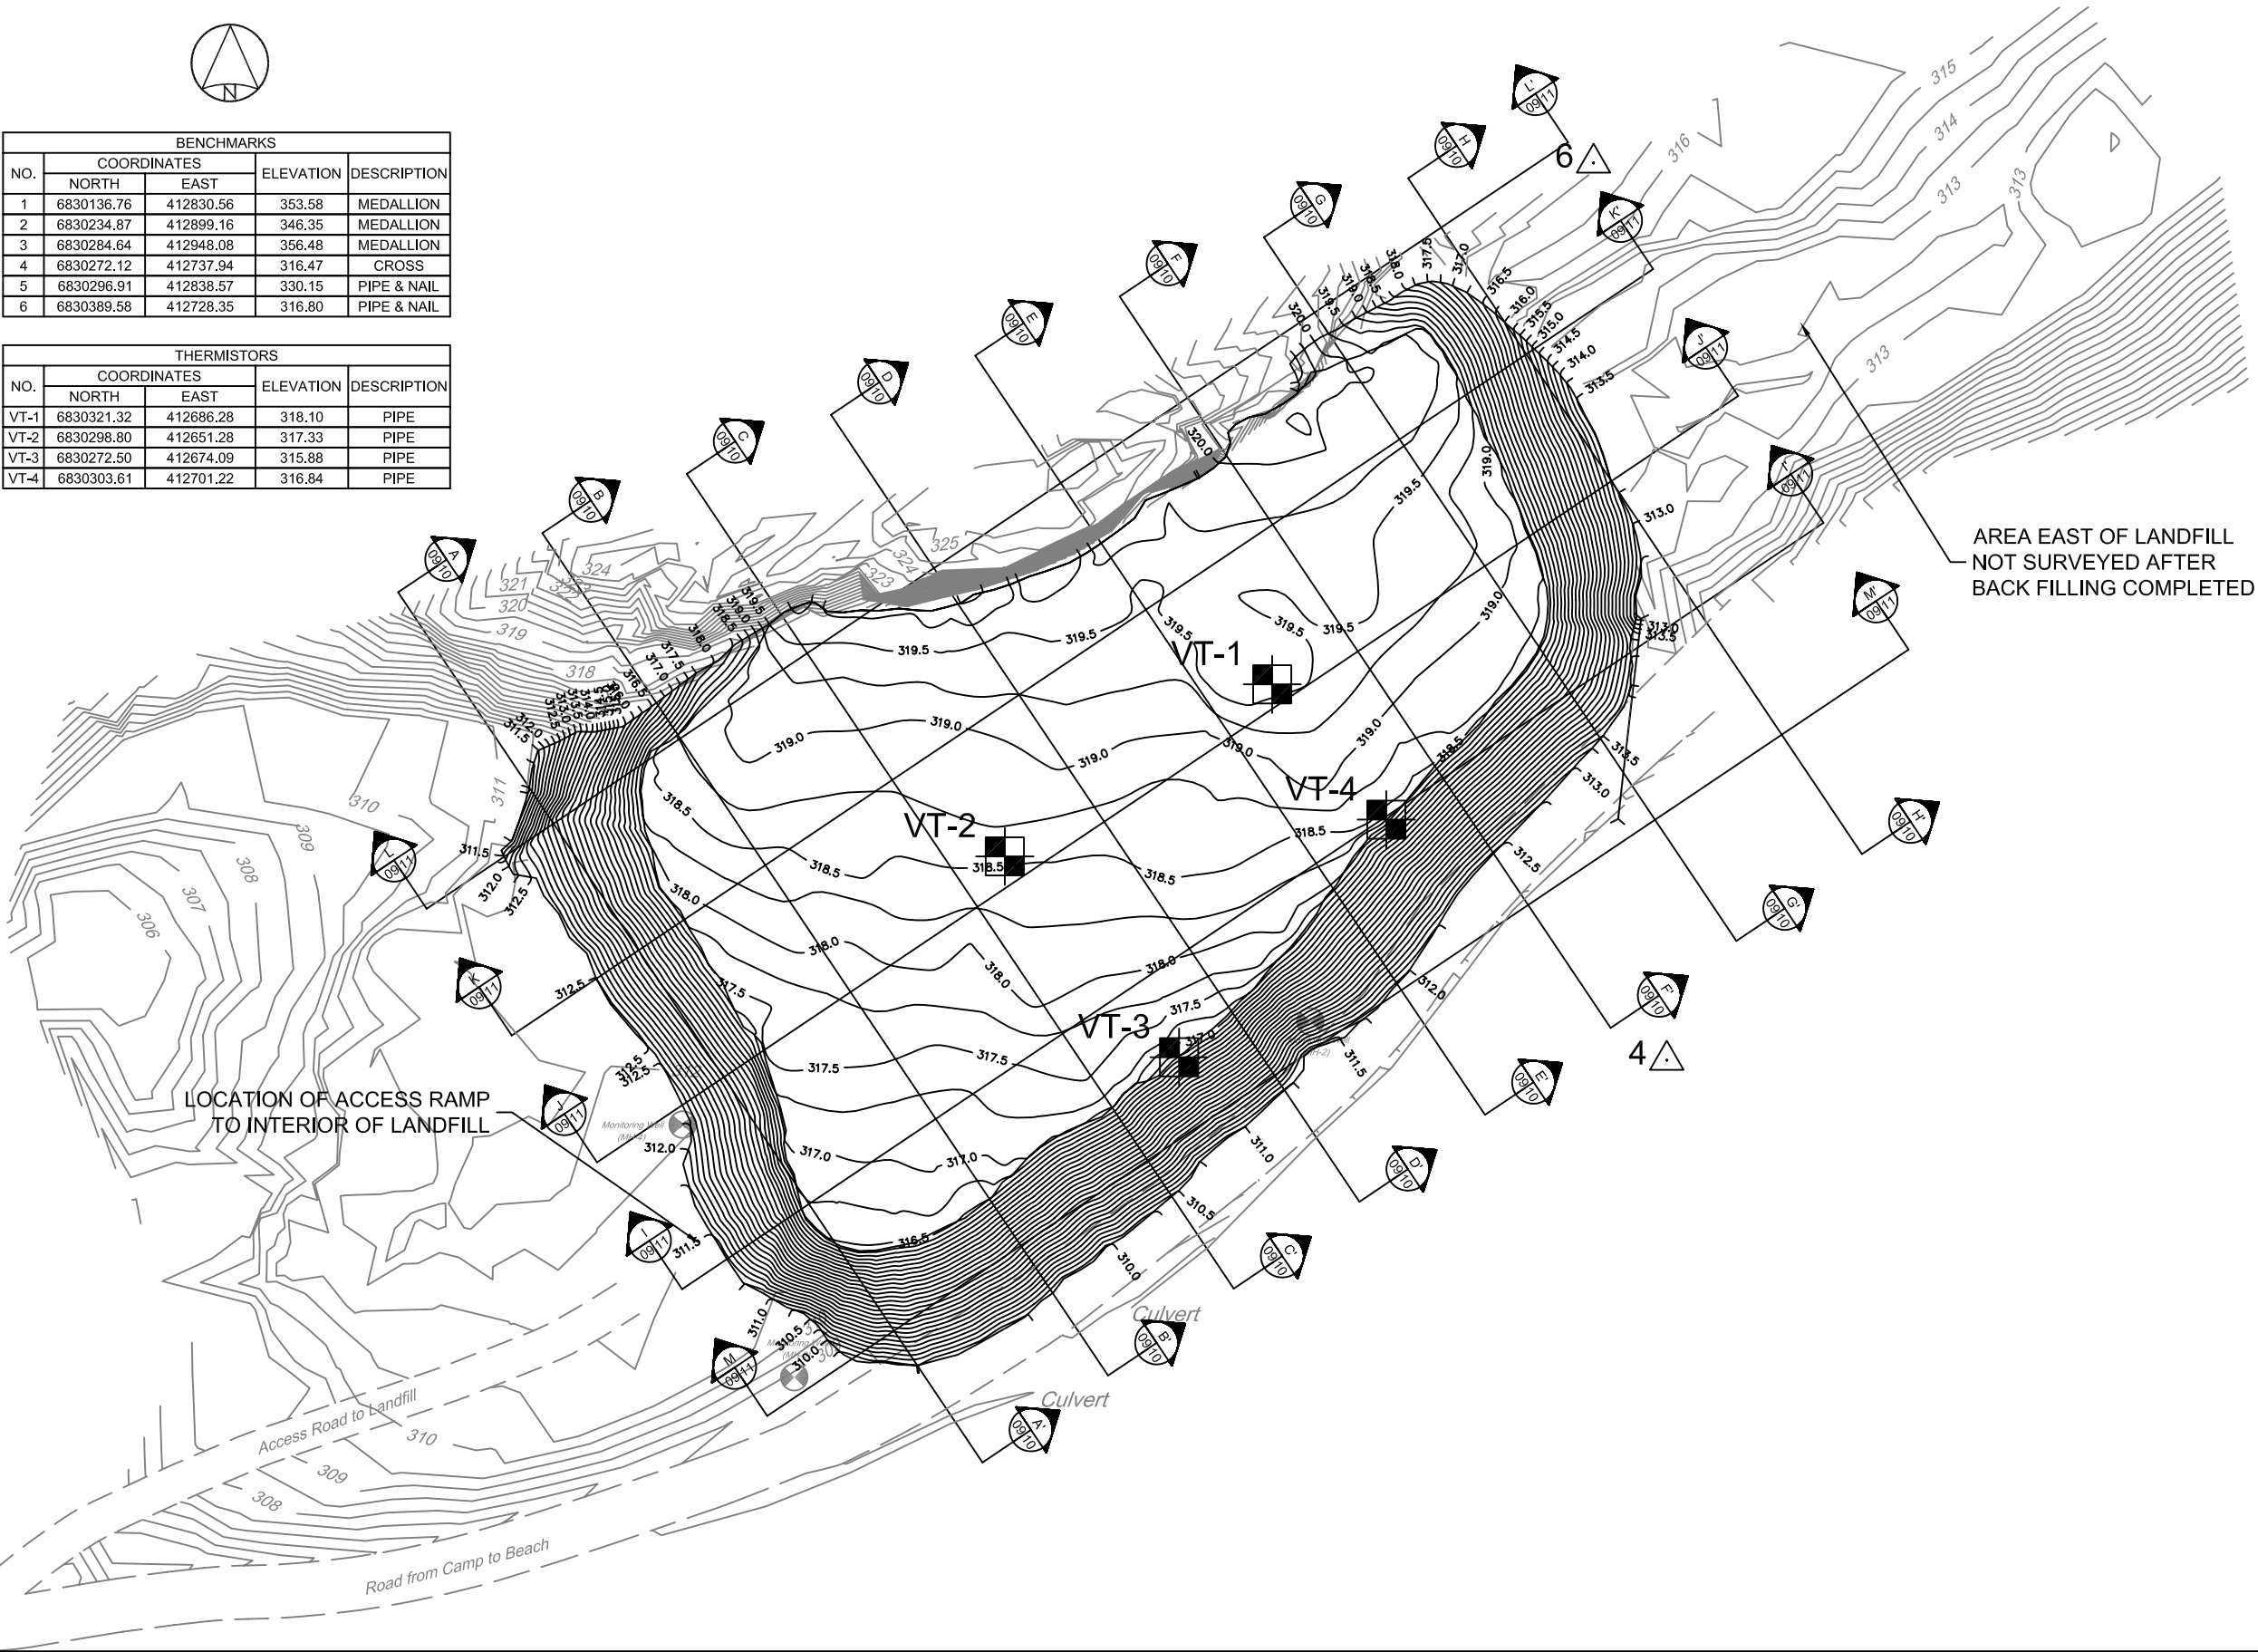

INDIAN AND NORTHERN
AFFAIRS CANADA

NUNAVUT REGIONAL OFFICE

General Notes:

- THE DRAWING IS NOW ORIENTED ACCURATELY TO NAD83 GRID NORTH BUT MAY BE SEVERAL METERS OFF IN POSITION.
- BENCH MARKS 1, 2 AND 3 ARE MEDALLIONS SET IN BEDROCK (NOT SHOWN).
- BENCHMARK 4 IS A CROSS CHISELLED INTO BEDROCK WITH A 3/8 INCH HOLE DRILLED IN THE MIDDLE.
- BENCHMARKS 5 AND 6 ARE STEEL PIPES GROUTED INTO THE BEDROCK WITH A NAIL STICKING OUT OF THE TOP.
- MONITORING WELLS INSTALLED DURING THE 2005 SEASON ARE NOT SURVEYED.

Legend:

MONITORING WELL LOCATION

PERMANENT CULVERT

BENCHMARK LOCATION

THERMISTOR LOCATION

5

No.	DATE	REVISION	REVISION	APPR.

QIKIQTAALUK CORPORATION

QIKIQTAALUK ENVIRONMENTAL

SCALE - ÉCHELLE 10 5 0 10 20 m

PROJECT - PROJET
BAF-5 RESOLUTION ISLAND

© COPYRIGHT HER MAJESTY THE QUEEN
IN THE RIGHT OF CANADA 2007,
AS REPRESENTED BY INDIAN AND
NORTHERN AFFAIRS CANADA









TRADE - MÉTIER	SITING	DATE	2007-02-08
SUBJECT - SUJET			





SURVEYED DRAWING OF THE TIER II LANDFILL AREA

PRODUCTION	CONCURRENCE - ASSENTIMENT
DESIGNED ETUDIE	G.J.
DRAWN DESSINE	G.J.
CHECKED VÉRIFIÉ	P.S.
COORDINATION	REVIEWED - REVU C.M.


DWG. NO. - DESSIN NO.
AB-2006-102-06

Canada

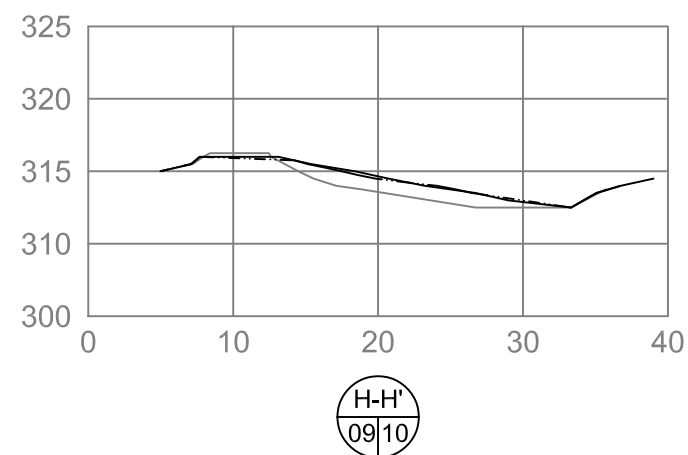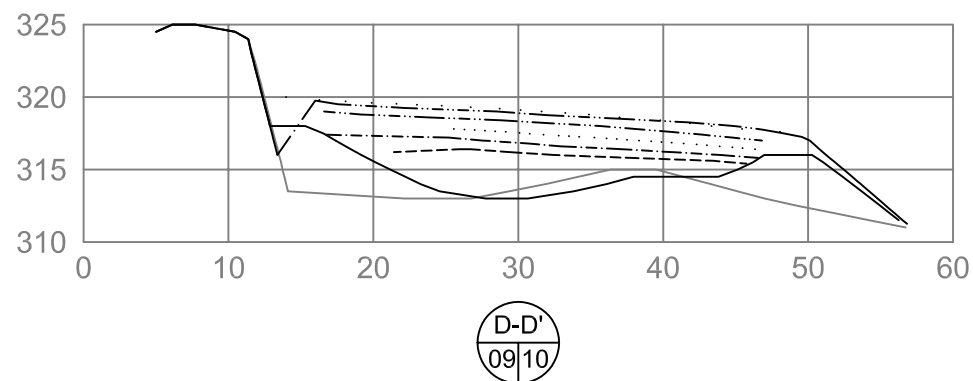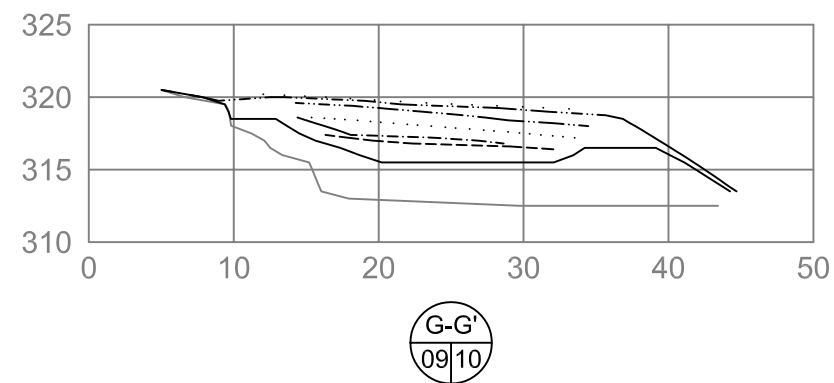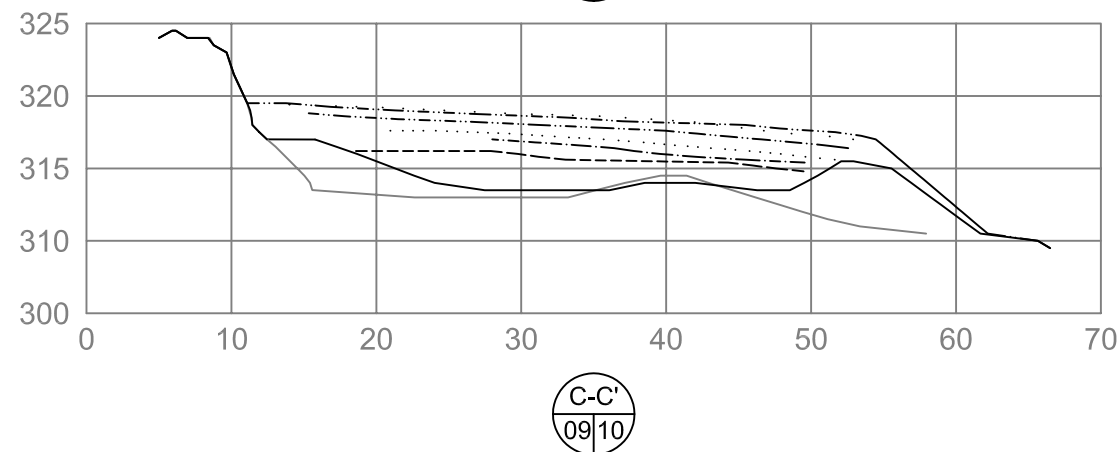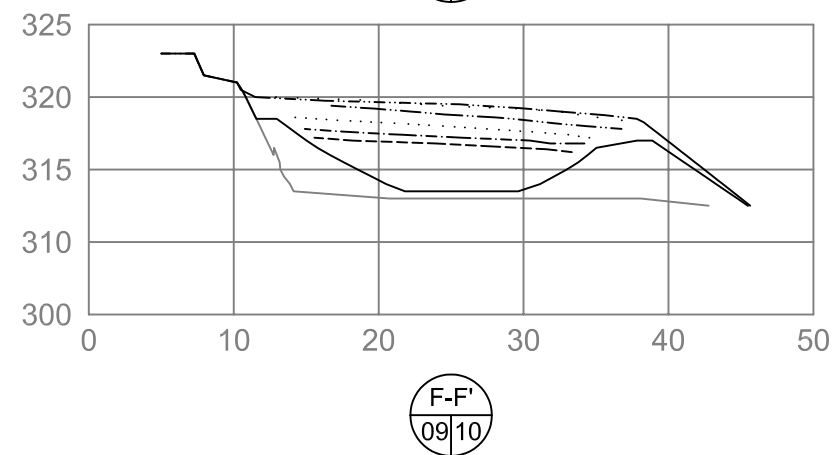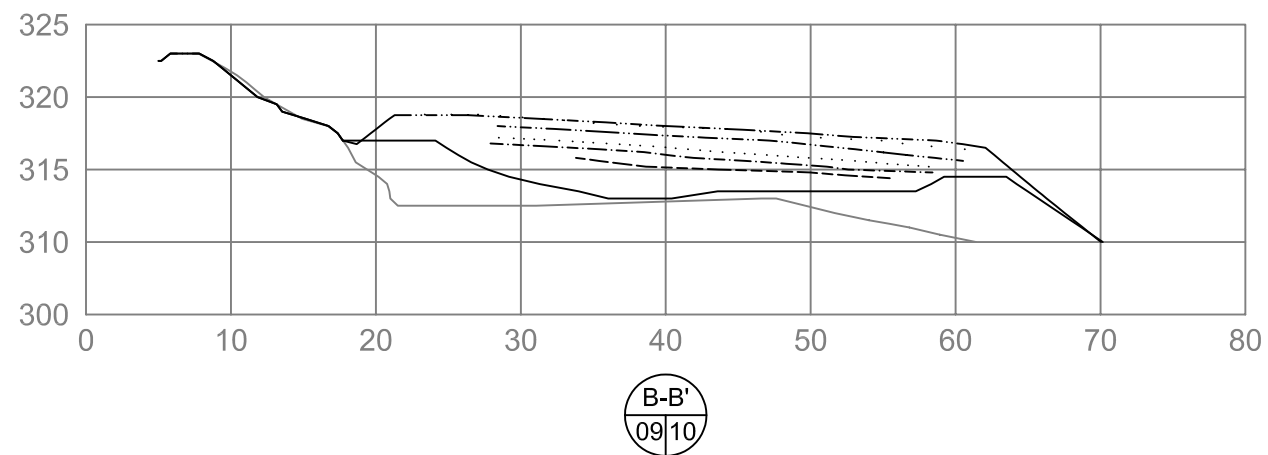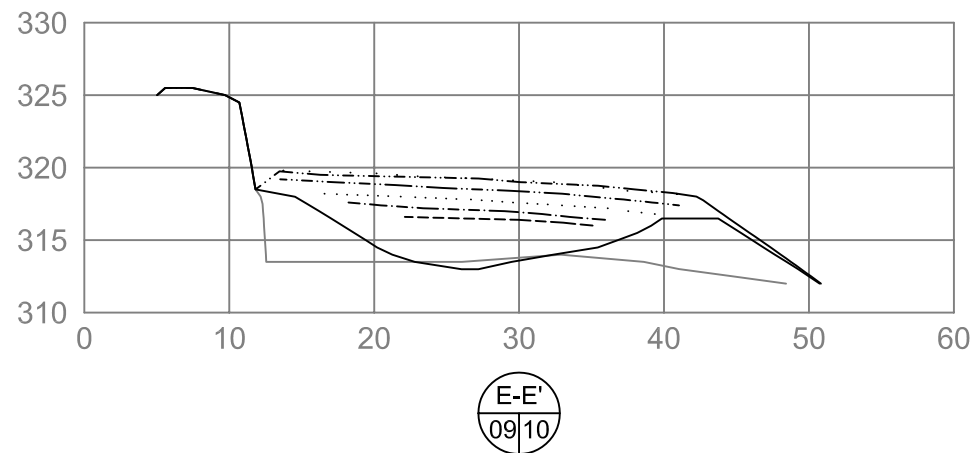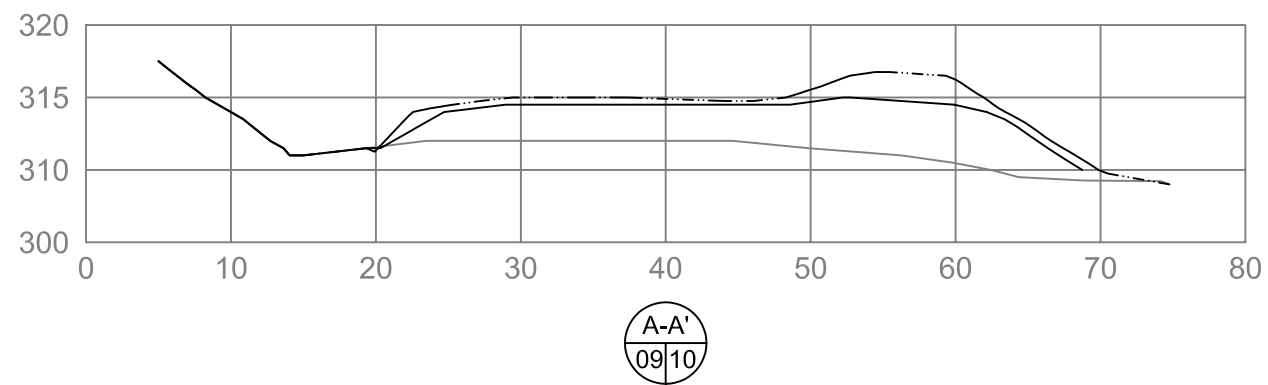

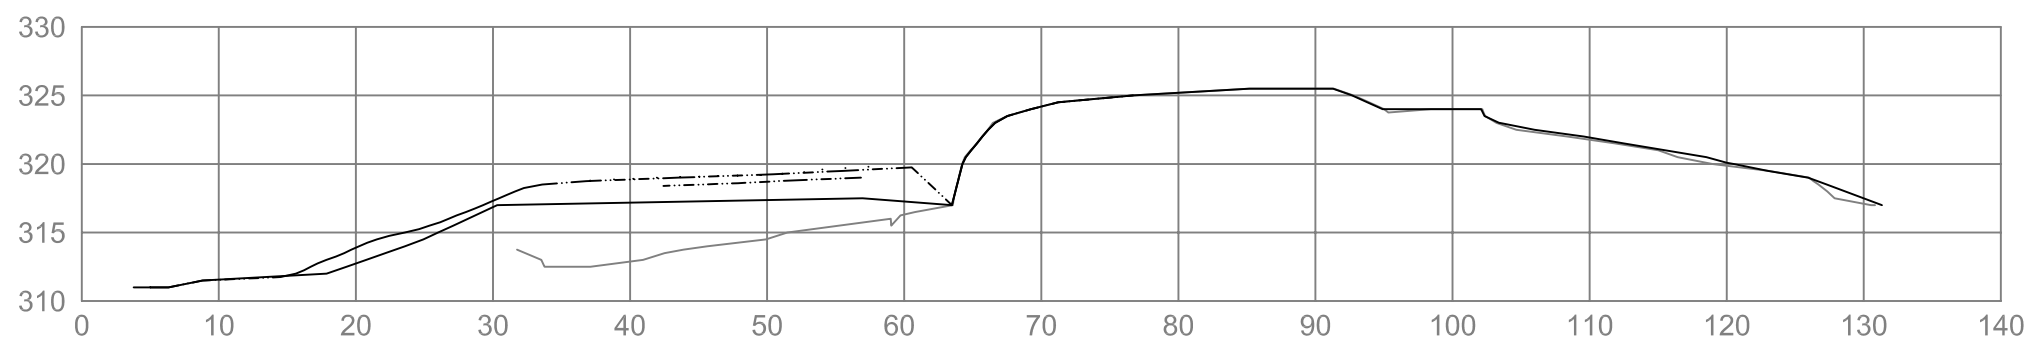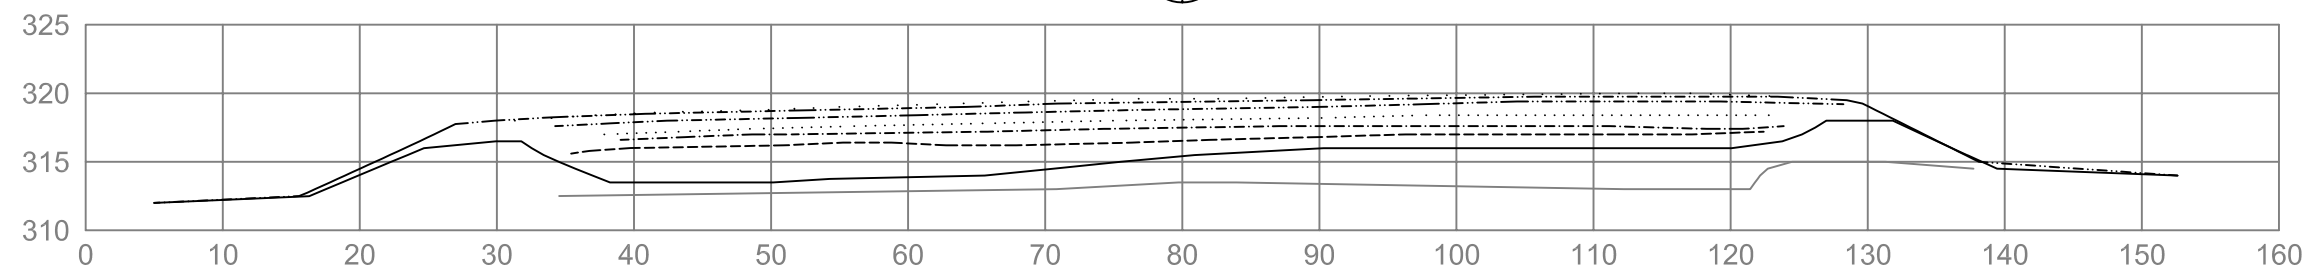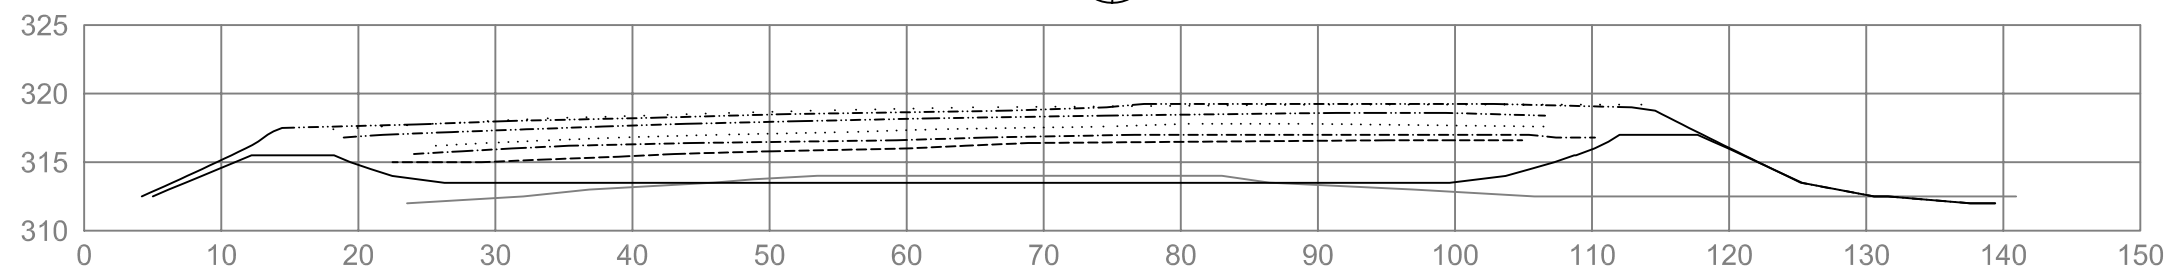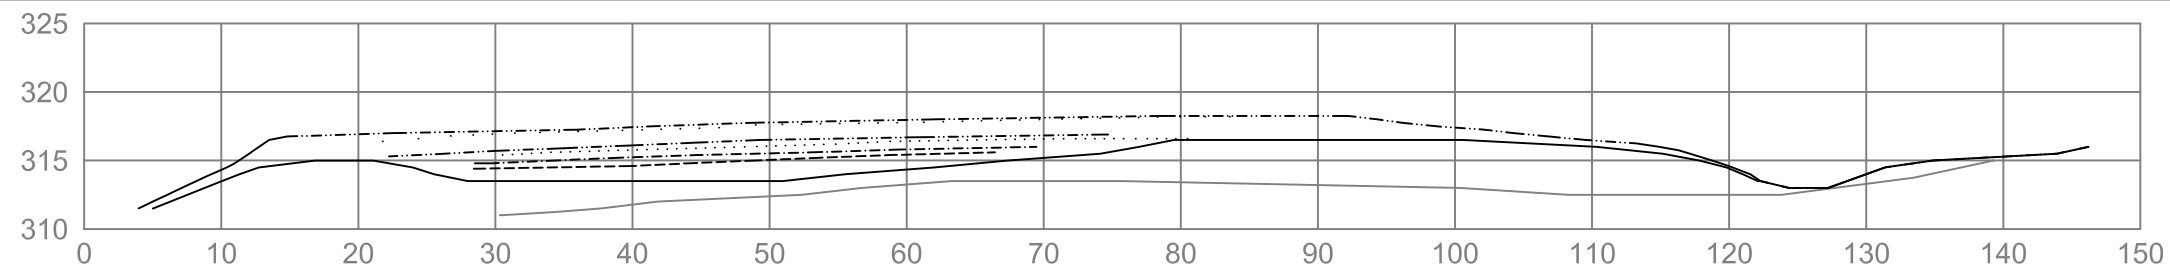

L-L'
09 | 11

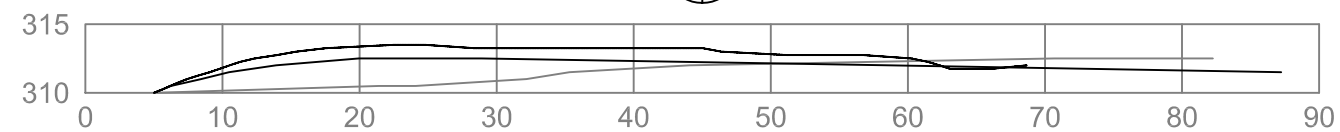

M-M'
09/11



**INDIAN AND NORTHERN
AFFAIRS CANADA**

NUNAVUT REGIONAL OFFICE

1. GREY LINES REPRESENT NATURAL GROUND ELEVATION. BLACK LINES REPRESENT THE GROUND ELEVATIONS AT THE END OF THE 2006 WORK SEASON.

Legend:

TOP TYPE 1

— · — · — · — TOP TYPE 2

..... TOP MEMBRANE

— . — . — . — TOP TIER I

TOP TIER II

No.	DATE	REVISION	APPROVED



SCALE - ÉCHELLE

AS SHOWN

PROJECT - PROJET
BAF-5 RESOLUTION ISLAND

© COPYRIGHT HER MAJESTY THE QUEEN
IN THE RIGHT OF CANADA 2007,
AS REPRESENTED BY INDIAN AND
NORTHERN AFFAIRS CANADA

TRADE - MÉTIER	SITING	DATE	2007-02-08
----------------	--------	------	------------

SUBJECT - SUJET

CROSS-SECTIONS OF THE TIER II LANDFILL
(DRAWING 2 OF 2)

PRODUCTION	CONCURRENCE - ASSESSMENT
DESIGNED ÉTUDE	G.J.
DRAWN DESSINE	G.J.
CHECKED VÉRIFIÉ	P.S.
COORDINATION	REVIEWED - REVU C.M.

DWG. NO. - DESSIN NO.

AB-2006-102-08

Canada



19

The composite image consists of two parts. The top part is a map of the Eastern Arctic region of Canada, showing the coastline from Grise Fiord in the north to Sanikiluaq in the south. Key locations labeled on the map include Grise Fiord, Resolute Bay, Pond Inlet, Arctic Bay, Clyde River, Igloolik, Hall Beach, Pangnirtung, Iqaluit, Cape Dorset, Kimmirut, and Sanikiluaq. A circle is drawn around the area between Pangnirtung and Iqaluit, with a small circle and the letter 'C' inside it, indicating the location of Cape Thomsen. The bottom part is a black and white photograph of a coastal scene. It shows a body of water in the foreground, a small boat, and a person standing on a rocky shore. In the background, there are steep, dark hills or mountains.


2006 $\leq \alpha \leq \beta$ $\gamma \leq \delta$



February 2007



PERMIT TO PRACTICE
QIKIQTAAALUK ENVIRONMENTAL
Signature *B.G. Johnson*
Date *April 20th 2007*
PERMIT NUMBER: P 530
The Association of Professional Engineers,
Geoscientists and Geophysicists of the NWT / NU

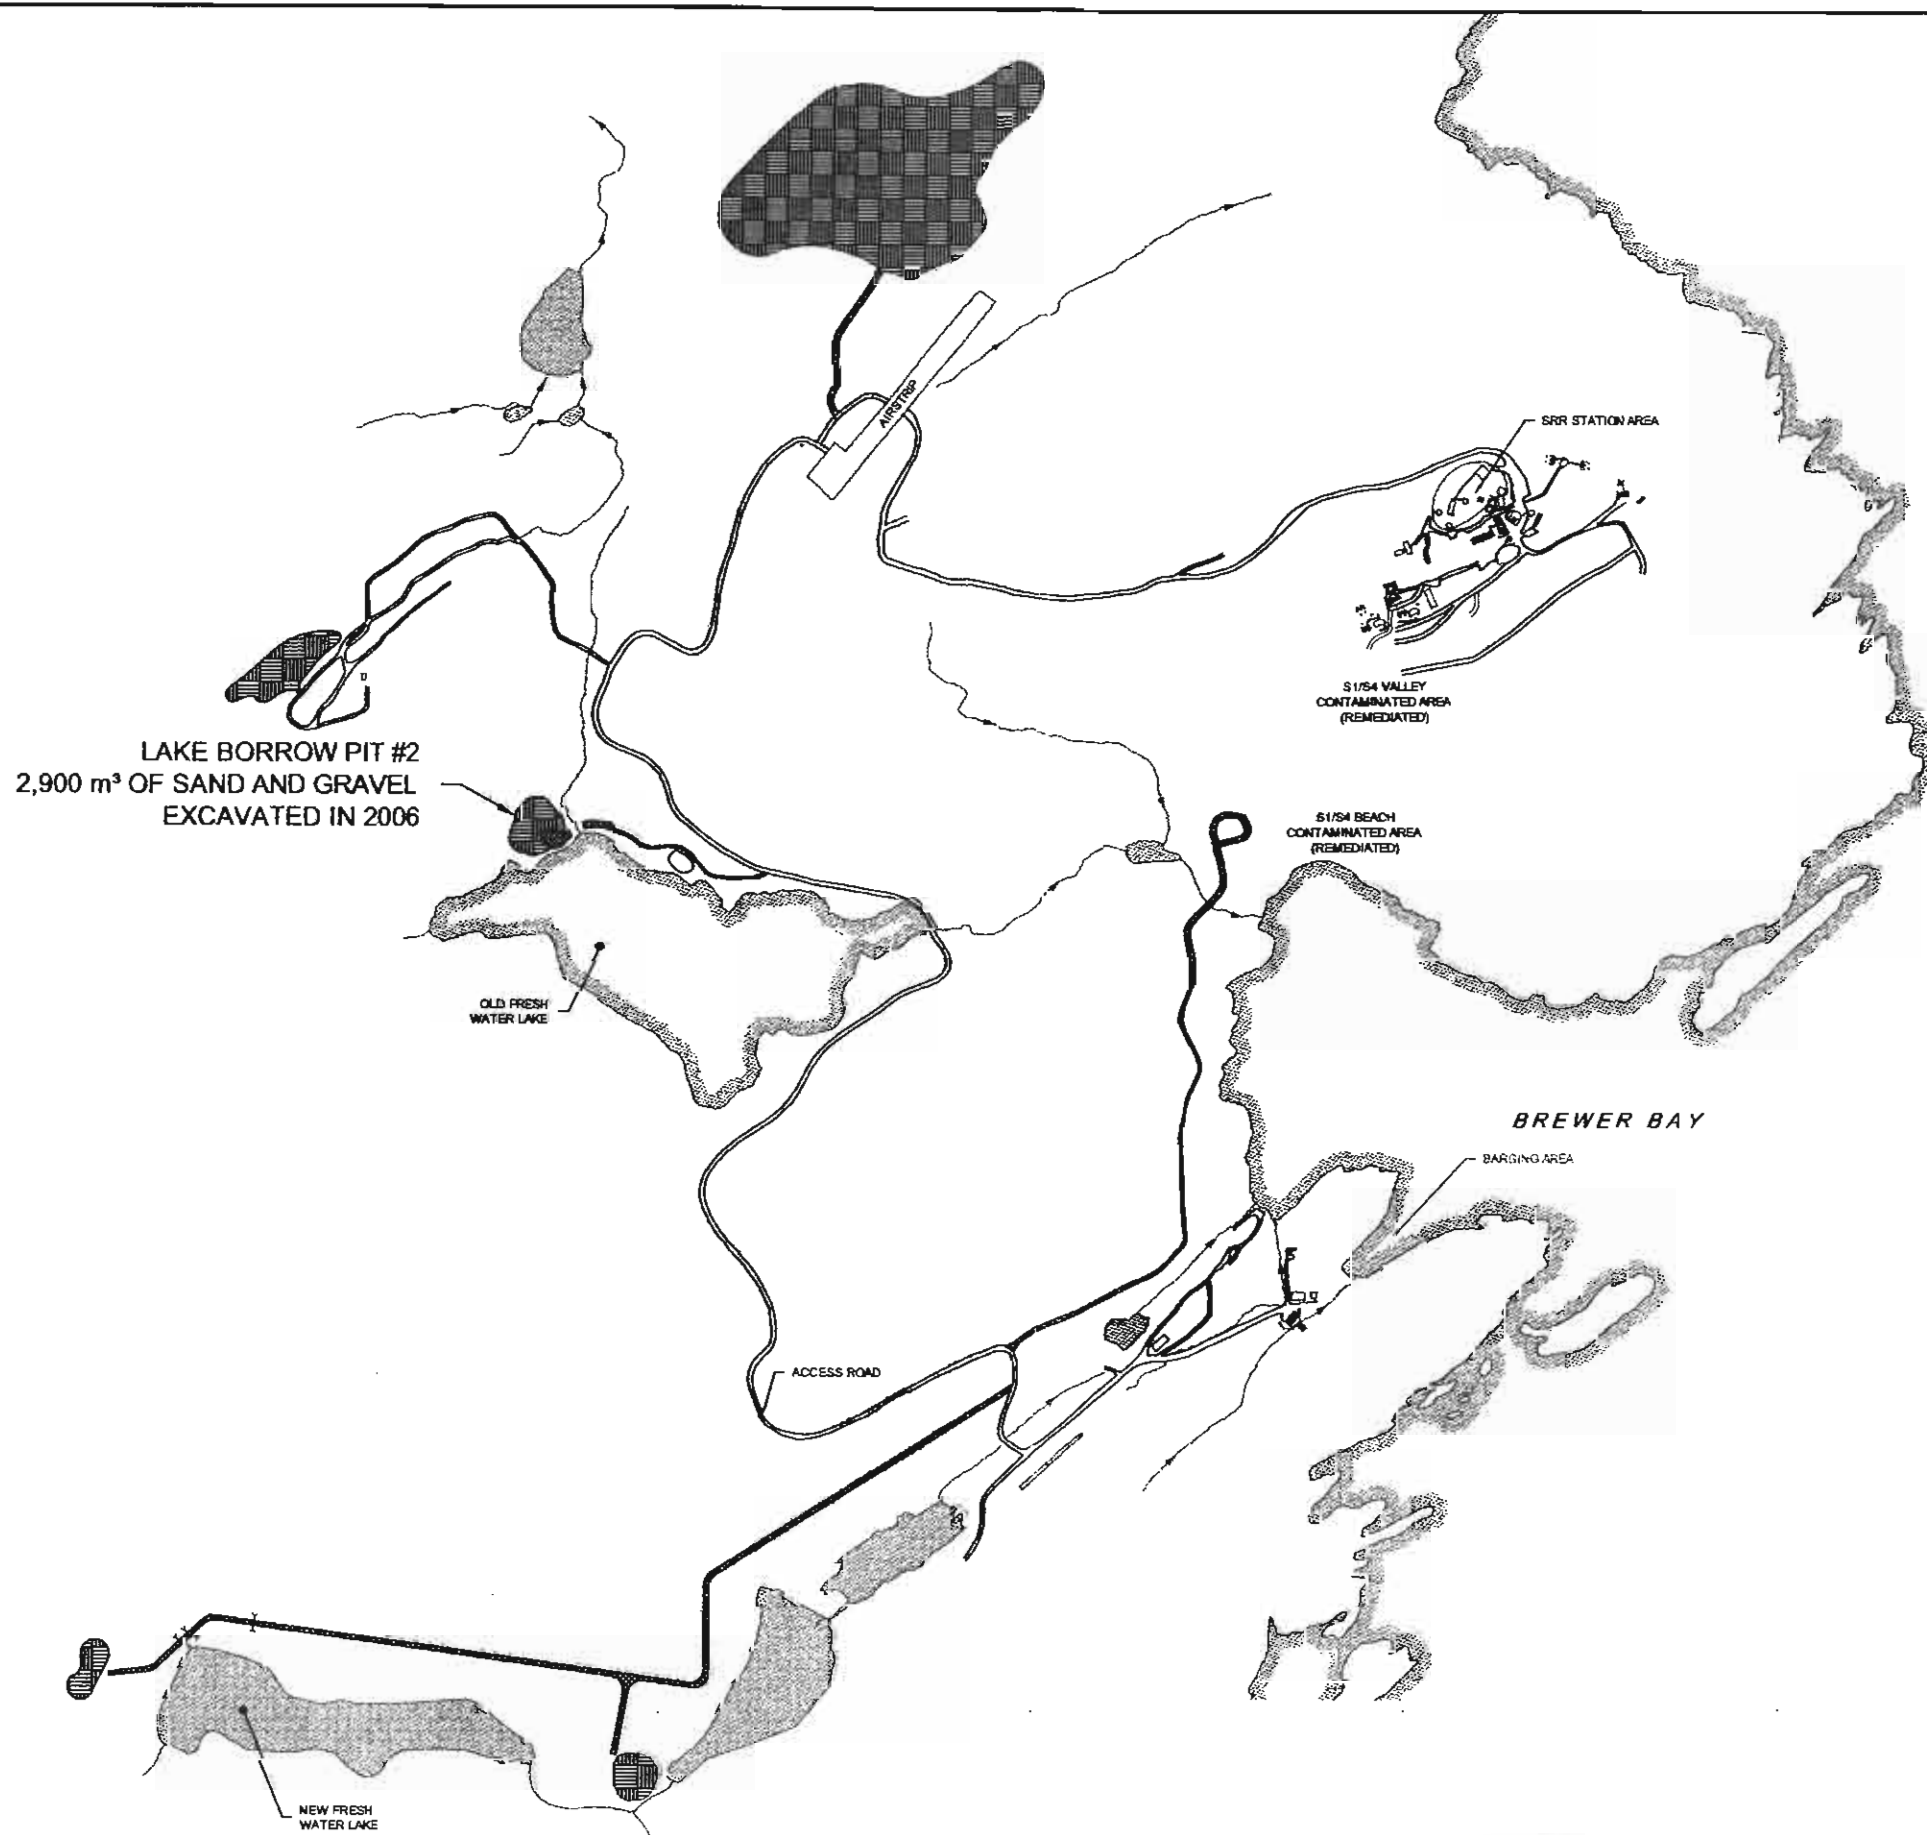

INDIAN AND NORTHERN AFFAIRS CANADA


NUNAVUT REGIONAL OFFICE

- GENERAL NOTES:**
1. LOCATIONS OF BORROW AREAS ARE APPROXIMATE AND NOT SURVEYED.
 2. ALL BORROW PITS AND ACCESS ROADS WERE REGRADED AT THE END OF THE 2006 SEASON TO MATCH NATURAL SURROUNDINGS.
 3. ALL CULVERTS WERE REMOVED FROM DECOMMISSIONED ROADS.

LEGEND:

- REGRADED ROAD
- REGRADED BORROW PIT

NO.	DATE	REVISION	REVISION	APPRO.

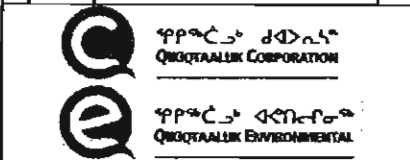

SCALE - ECHELLE 100 50 0 100 200 300 m

PROJECT - PROJET
BAF-5 RESOLUTION ISLAND

© COPYRIGHT HER MAJESTY THE QUEEN
IN THE RIGHT OF CANADA 2006,
AS REPRESENTED BY INDIAN AND
NORTHERN AFFAIRS CANADA

TRADE - MÉTIER **SITING** DATE **2006-01-24**

SUBJECT - SUJET

LOCATION OF BORROW PITS USED DURING THE 2006 SEASON


PRODUCTION	CONCURRENCE - ASSENTIMENT
DESIGNED ÉTUDE	P.S.
DRAWN DESSINE	G.J.
CHECKED VÉRIFIÉ	P.S.
COORDINATION	REVIEWED - REVU C.M.

DWG. NO. - DESSIN NO.
AB-2006-102-01

Canada



PERMIT TO PRACTICE
QIKIQTAAALUK ENVIRONMENTAL
Signature: *G.S. Johnson*
Date: *April 20th 2007*
PERMIT NUMBER: P 530
The Association of Professional Engineers,
Geologists and Geophysicists of the NWT / NU

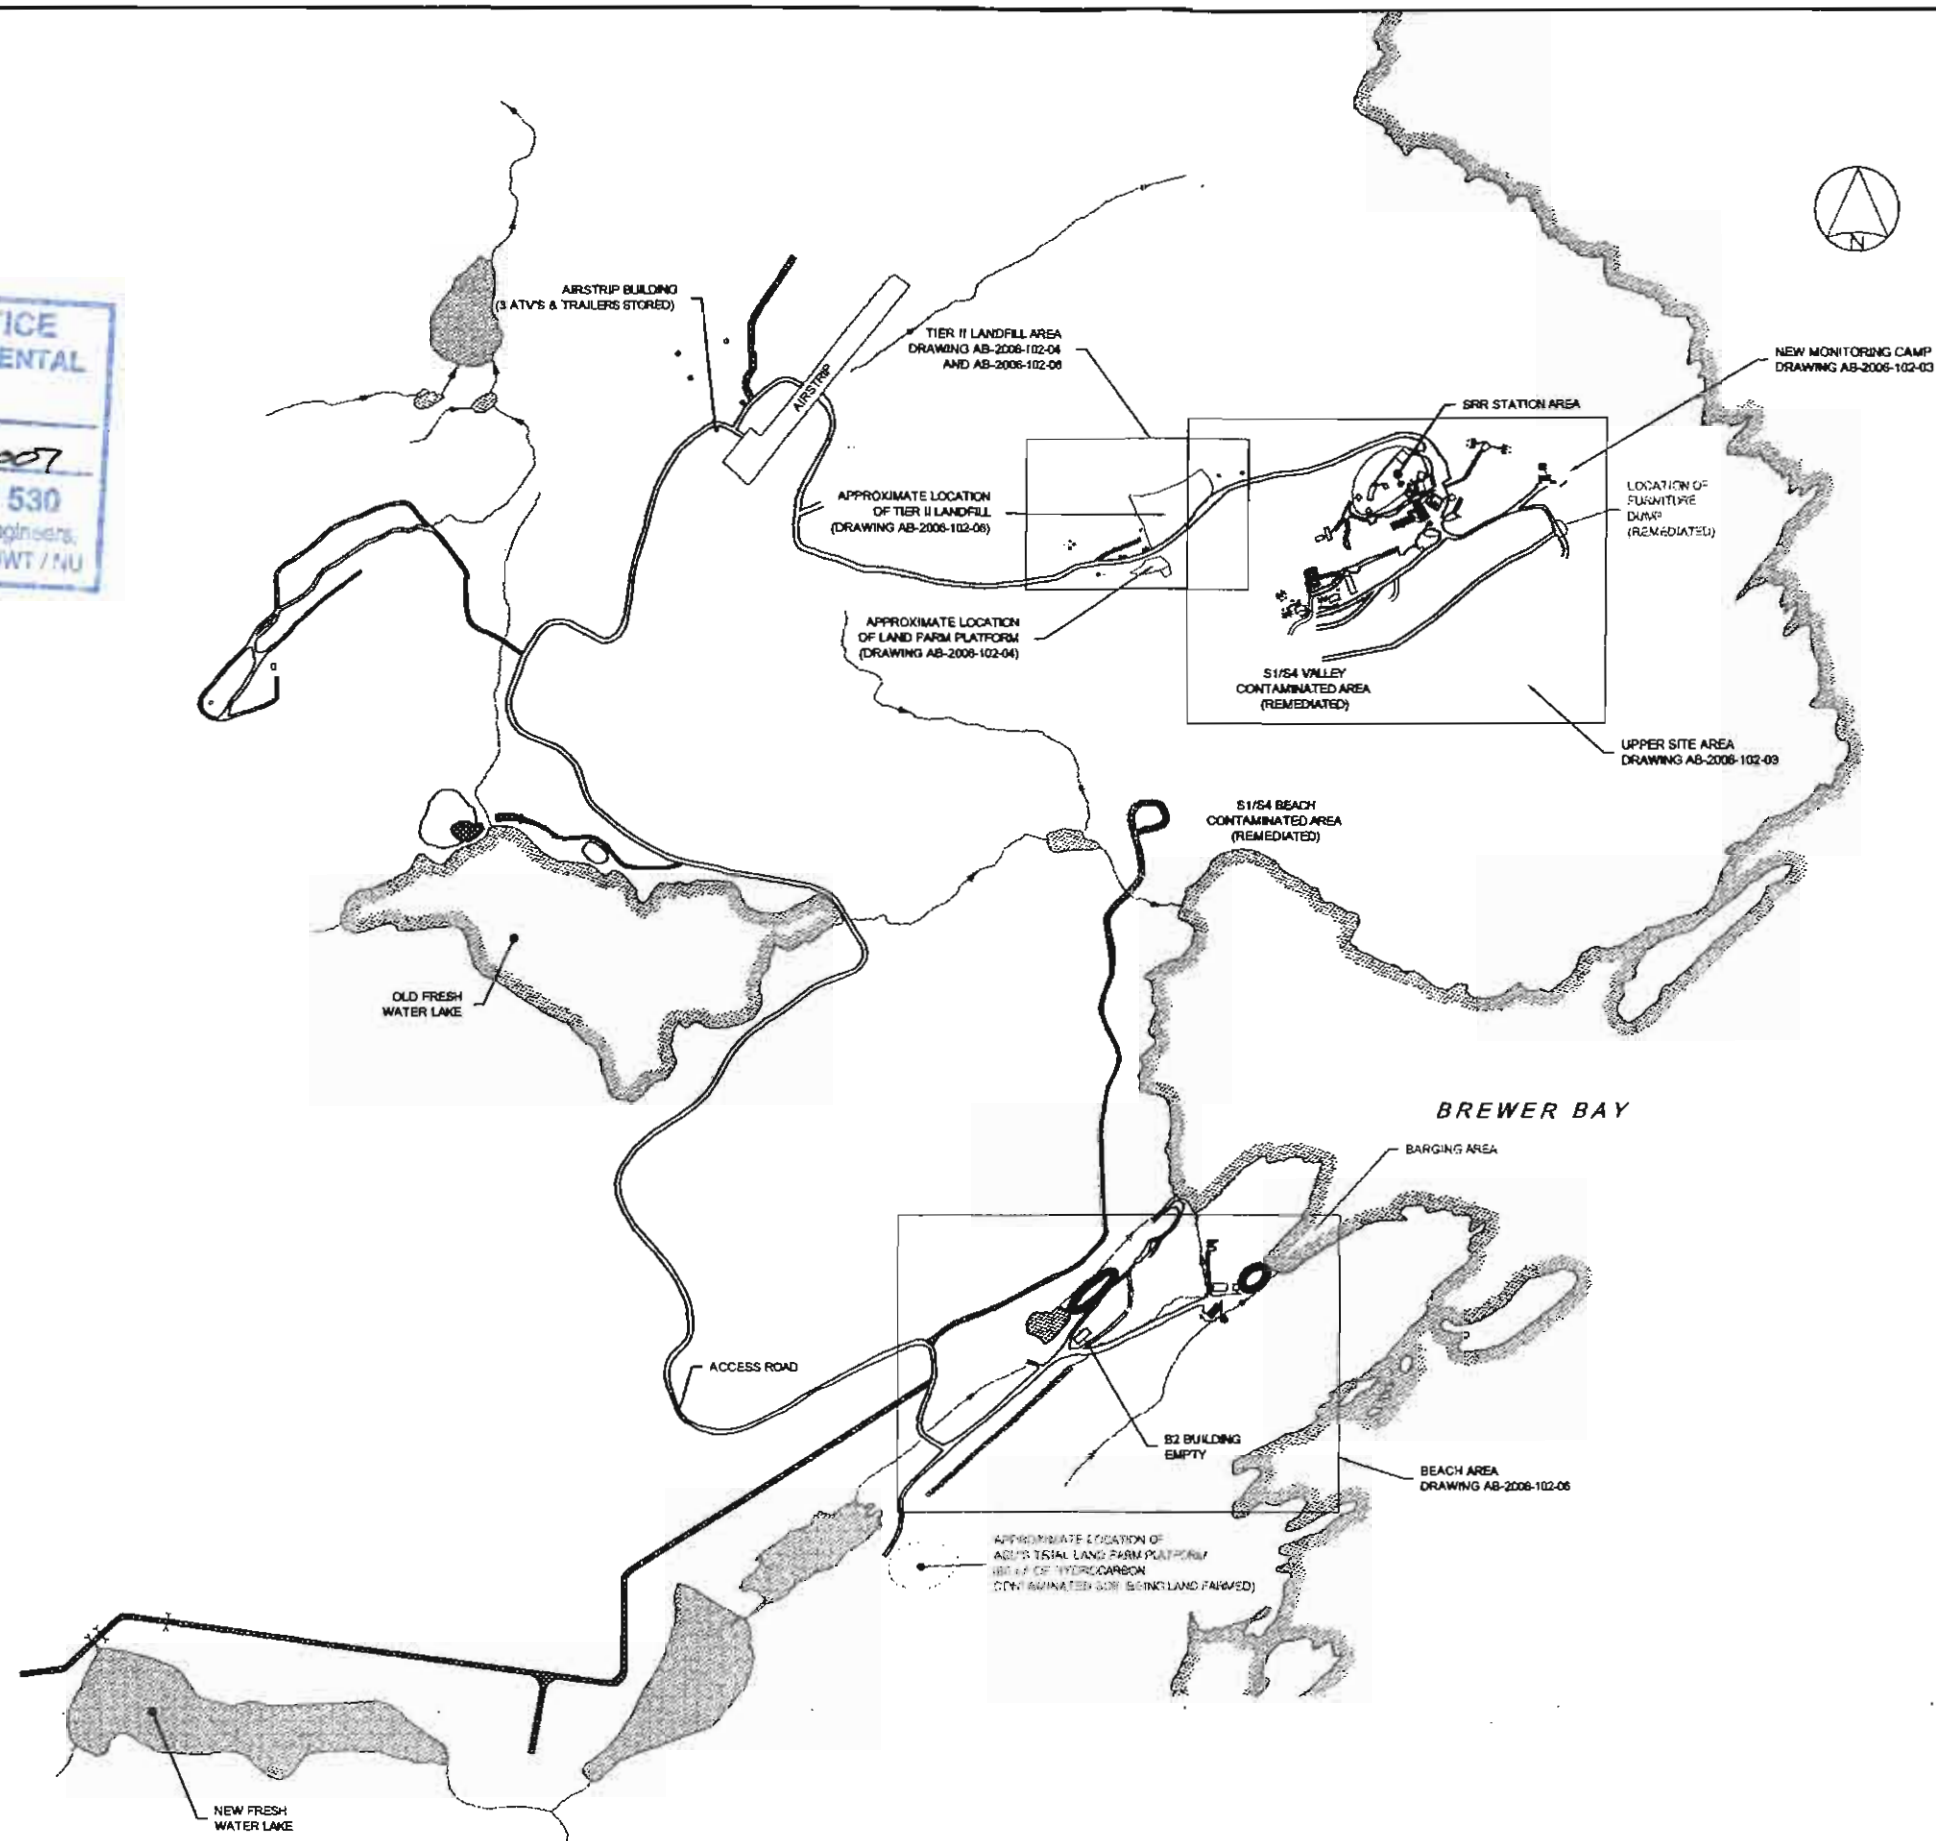


INDIAN AND NORTHERN AFFAIRS CANADA

NUNAVUT REGIONAL OFFICE

General Notes:
1. ALL DECOMMISSIONED ROADS HAD CULVERTS REMOVED AND WERE REGRADED TO MATCH SURROUNDING TERRAIN.

Legend:

No.	DATE	REVISION	REASON	APPR.
-----	------	----------	--------	-------

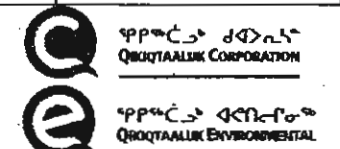

SCALE - ECHELLE 100 50 0 100 200 300 m

PROJECT - PROJET
BAF-5 RESOLUTION ISLAND

© COPYRIGHT HER MAJESTY THE QUEEN
IN THE RIGHT OF CANADA 2006,
AS REPRESENTED BY INDIAN AND
NORTHERN AFFAIRS CANADA


TRADE - METIER
SITING
DATE
2007-01-24

SUBJECT - SUJET
**GENERAL SITE LAYOUT AND AS BUILT DRAWING INDEX
(END OF PROJECT)**

PRODUCTION	CONCURRENCE - ASSENTIMENT
DESIGNED ETUDE	G.J.
DRAWN DESIGNE	G.J.
CHECKED VERIFIE	P.S.
COORDINATION	REVIEWED - REVU C.M.

DWG NO. - DESSIN NO.
AB-2006-102-02

Canada

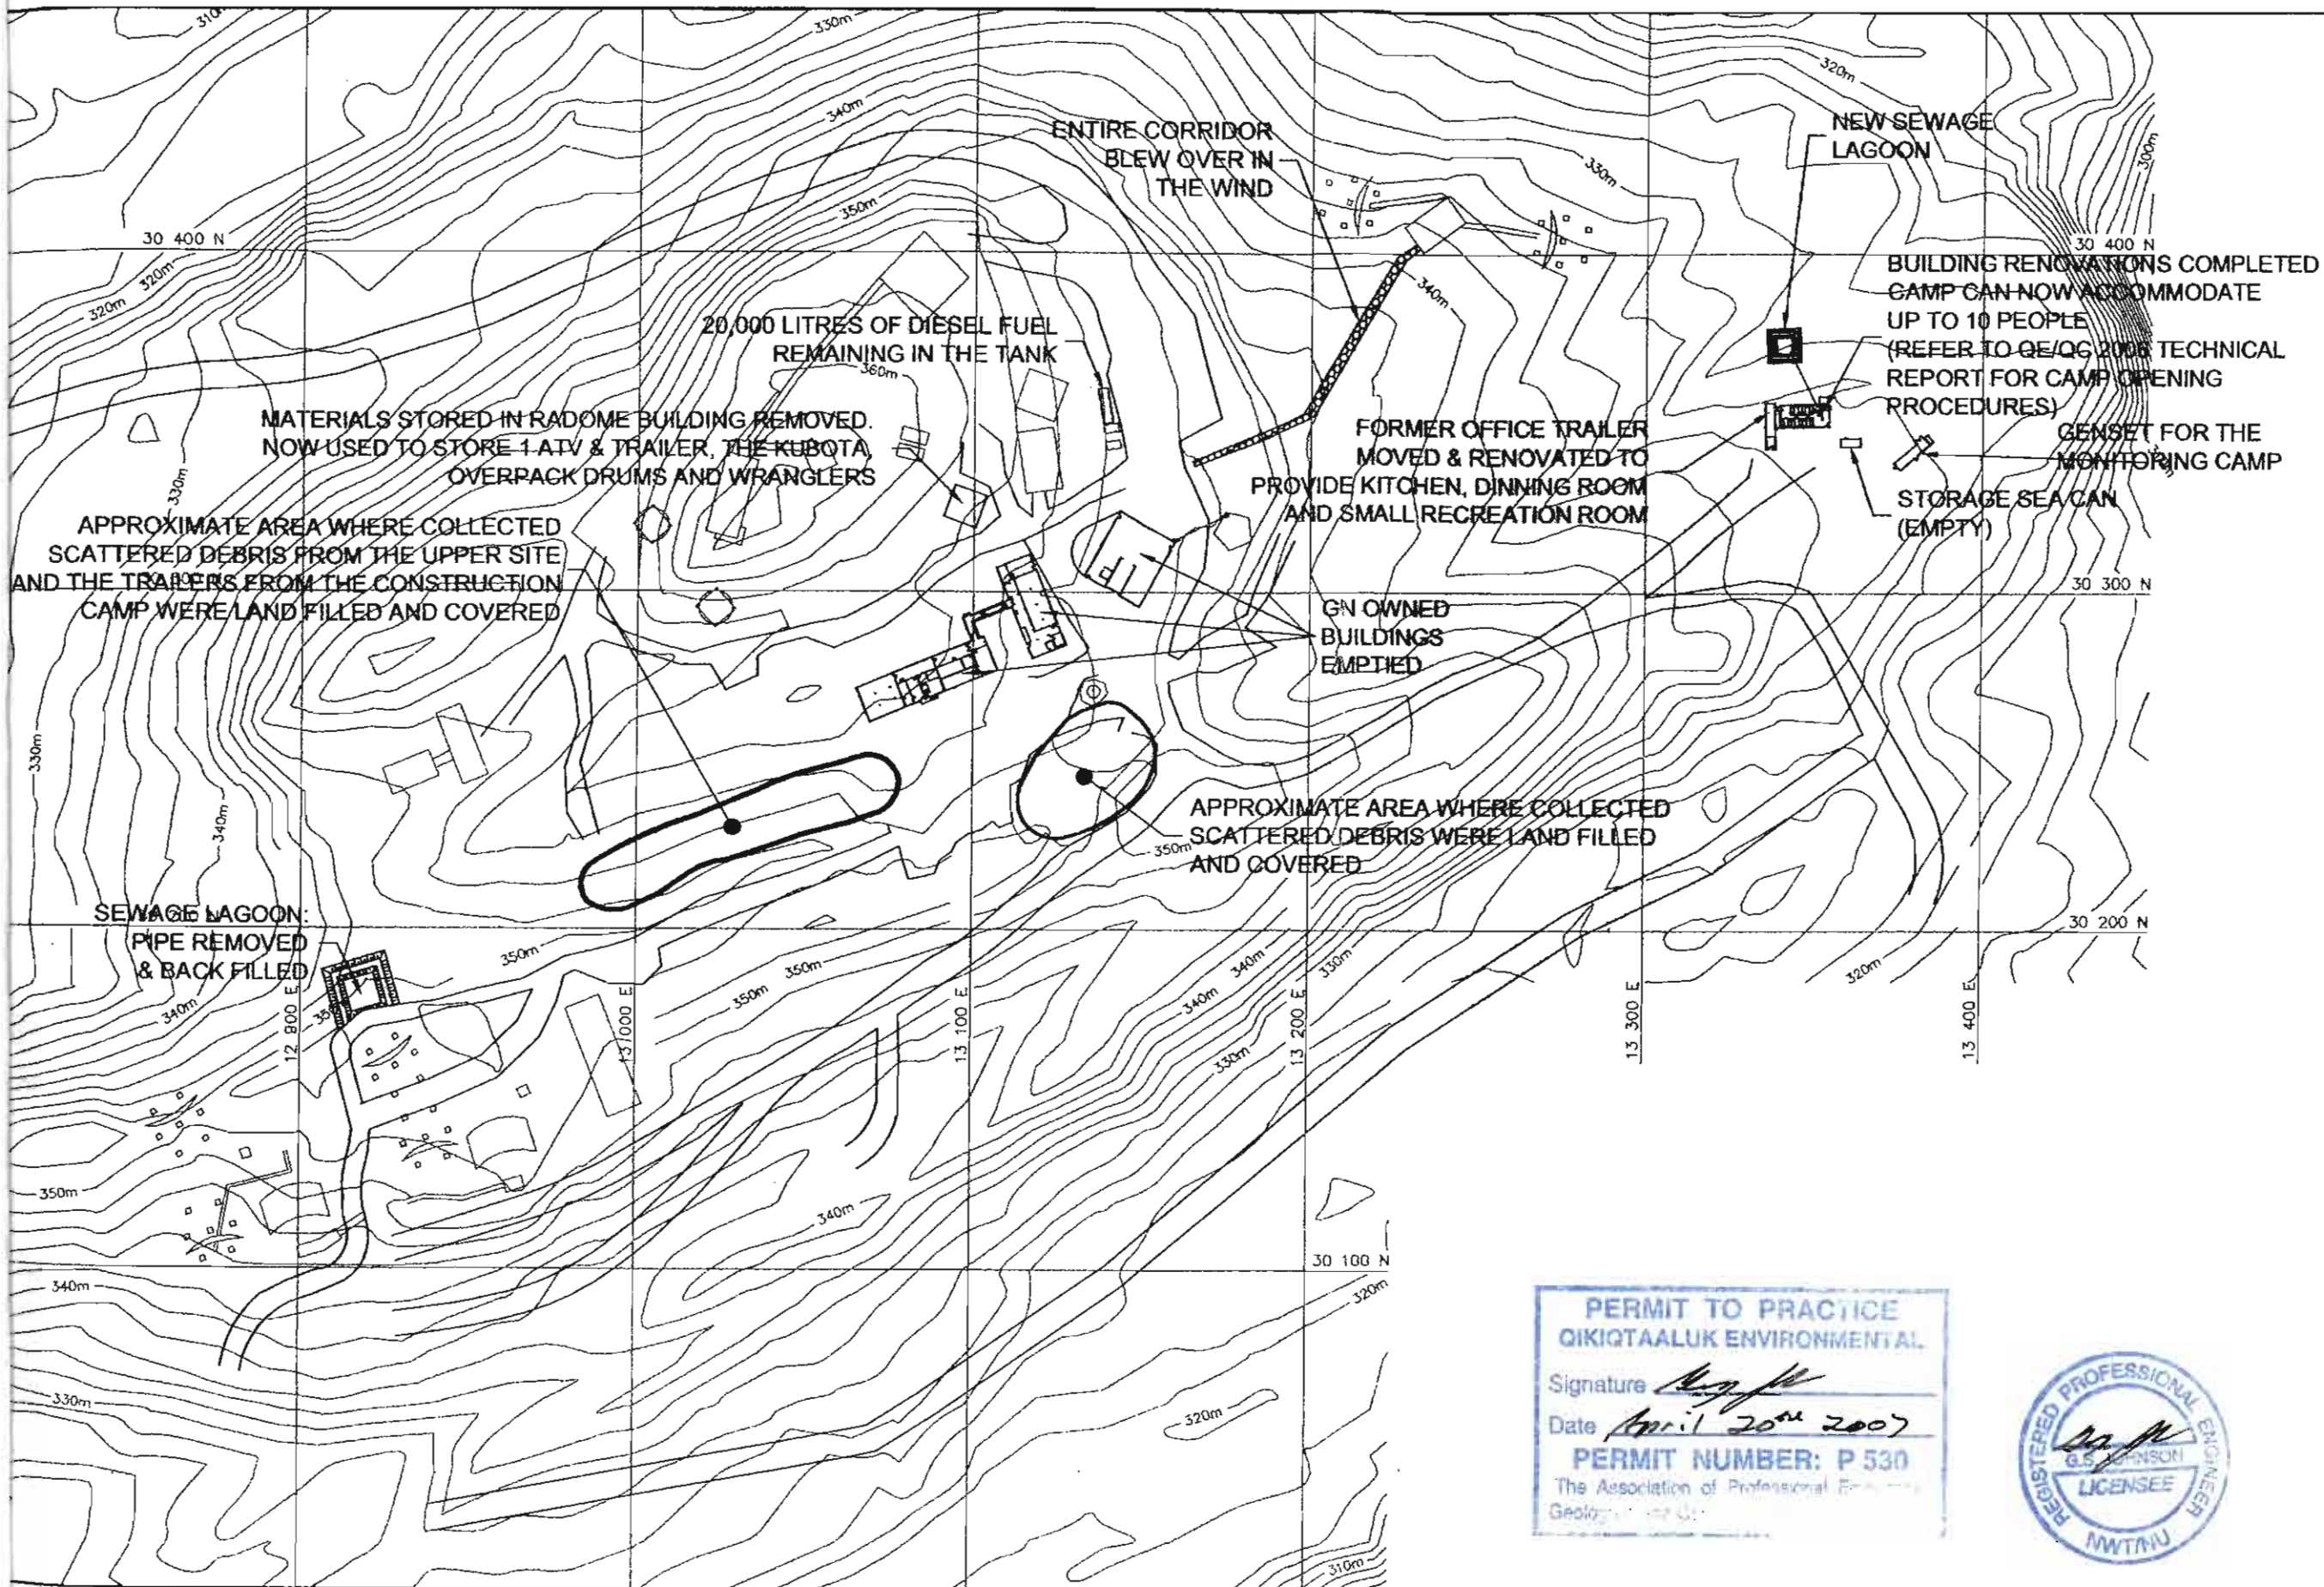

INDIAN AND NORTHERN AFFAIRS CANADA

NUNAVUT REGIONAL OFFICE

GENERAL NOTES:

LEGEND:

NO.	DATE	REVISION	REVISION	APPR.

QIQIQAALUK CORPORATION

QIQIQAALUK ENVIRONMENTAL

SCALE - ECHELLE 25 12.5 0 25 50

PROJECT - PROJET

BAF-5 RESOLUTION ISLAND

© COPYRIGHT HER MAJESTY THE QUEEN IN THE RIGHT OF CANADA 2006, AS REPRESENTED BY INDIAN AND NORTHERN AFFAIRS CANADA

TRADE - METIER	SITING	DATE	2007-01-24
----------------	--------	------	------------

SUBJECT - SUJET

GENERAL LAYOUT OF THE UPPER SITE (END OF PROJECT)

PRODUCTION	CONCURRENCE - ASSESSMENT
REPORTED ETUDE	G.J.
DRAWN DESSINE	G.J.
CHECKED VERIFIE	P.S.
COORDINATION	REVIEWED - REVU C.M.

DWG. NO. - DESIGN NO. AB-2006-105-03

Canada

PERMIT TO PRACTICE

QIQIQAALUK ENVIRONMENTAL

Signature *[Signature]*

Date *April 20th 2007*

PERMIT NUMBER: P 530

The Association of Professional Engineers

Geology

REGISTERED PROFESSIONAL ENGINEER


G.S. JOHNSON

LICENSEE

NWTNU



PERMIT TO PRACTICE
QIKIQTAALUK ENVIRONMENTAL
Signature *[Signature]*
Date *April 20th 2007*
PERMIT NUMBER: P 530
The Association of Professional Engineers,
Geologists and Geophysicists of the NWT / NU

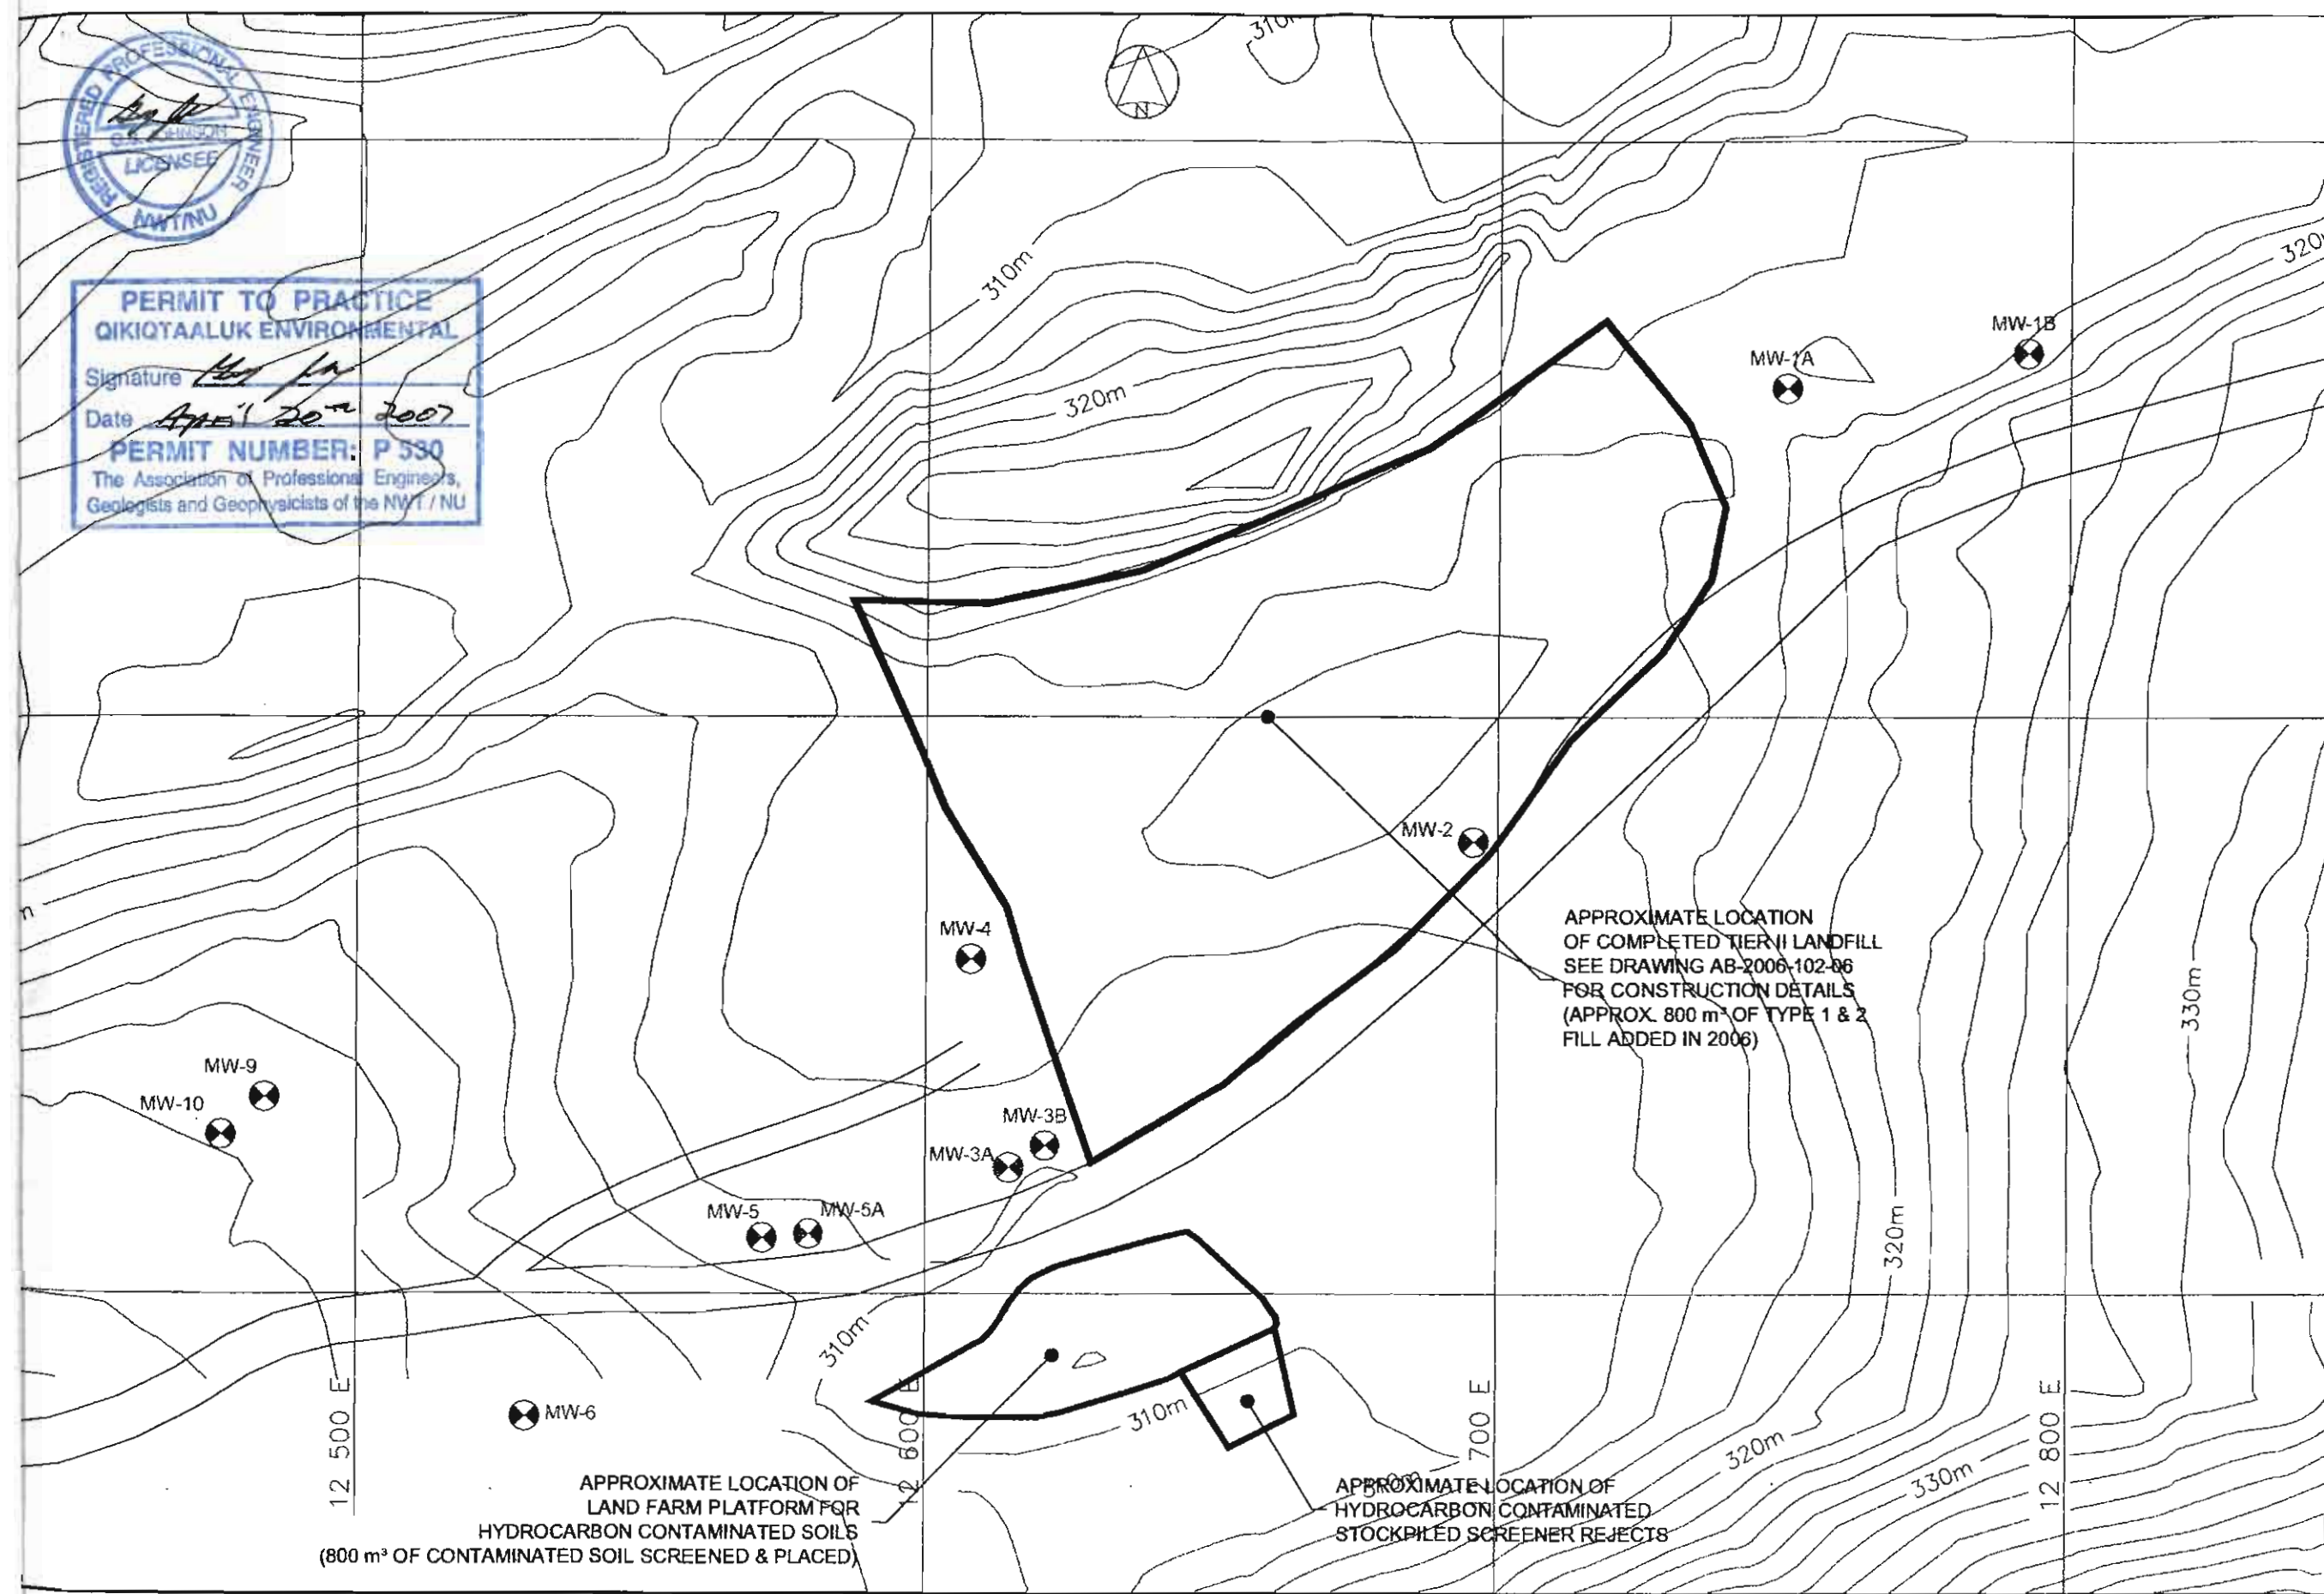

INDIAN AND NORTHERN AFFAIRS CANADA

NUNAVUT REGIONAL OFFICE

General Notes:
1. LOCATIONS OF MONITORING WELLS ARE APPROXIMATE AND NOT SURVEYED.

Legend:
 MONITORING WELLS

NO.	DATE	REVISION	REVISION	APPR.
1				

QIKIQTAALUK CORPORATION

QIKIQTAALUK ENVIRONMENTAL

SCALE - ECHELLE

PROJECT - PROJET
BAF-5 RESOLUTION ISLAND

© COPYRIGHT HER MAJESTY THE QUEEN
IN THE RIGHT OF CANADA 2006,
AS REPRESENTED BY INDIAN AND
NORTHERN AFFAIRS CANADA


TRADE - METIER
SITING









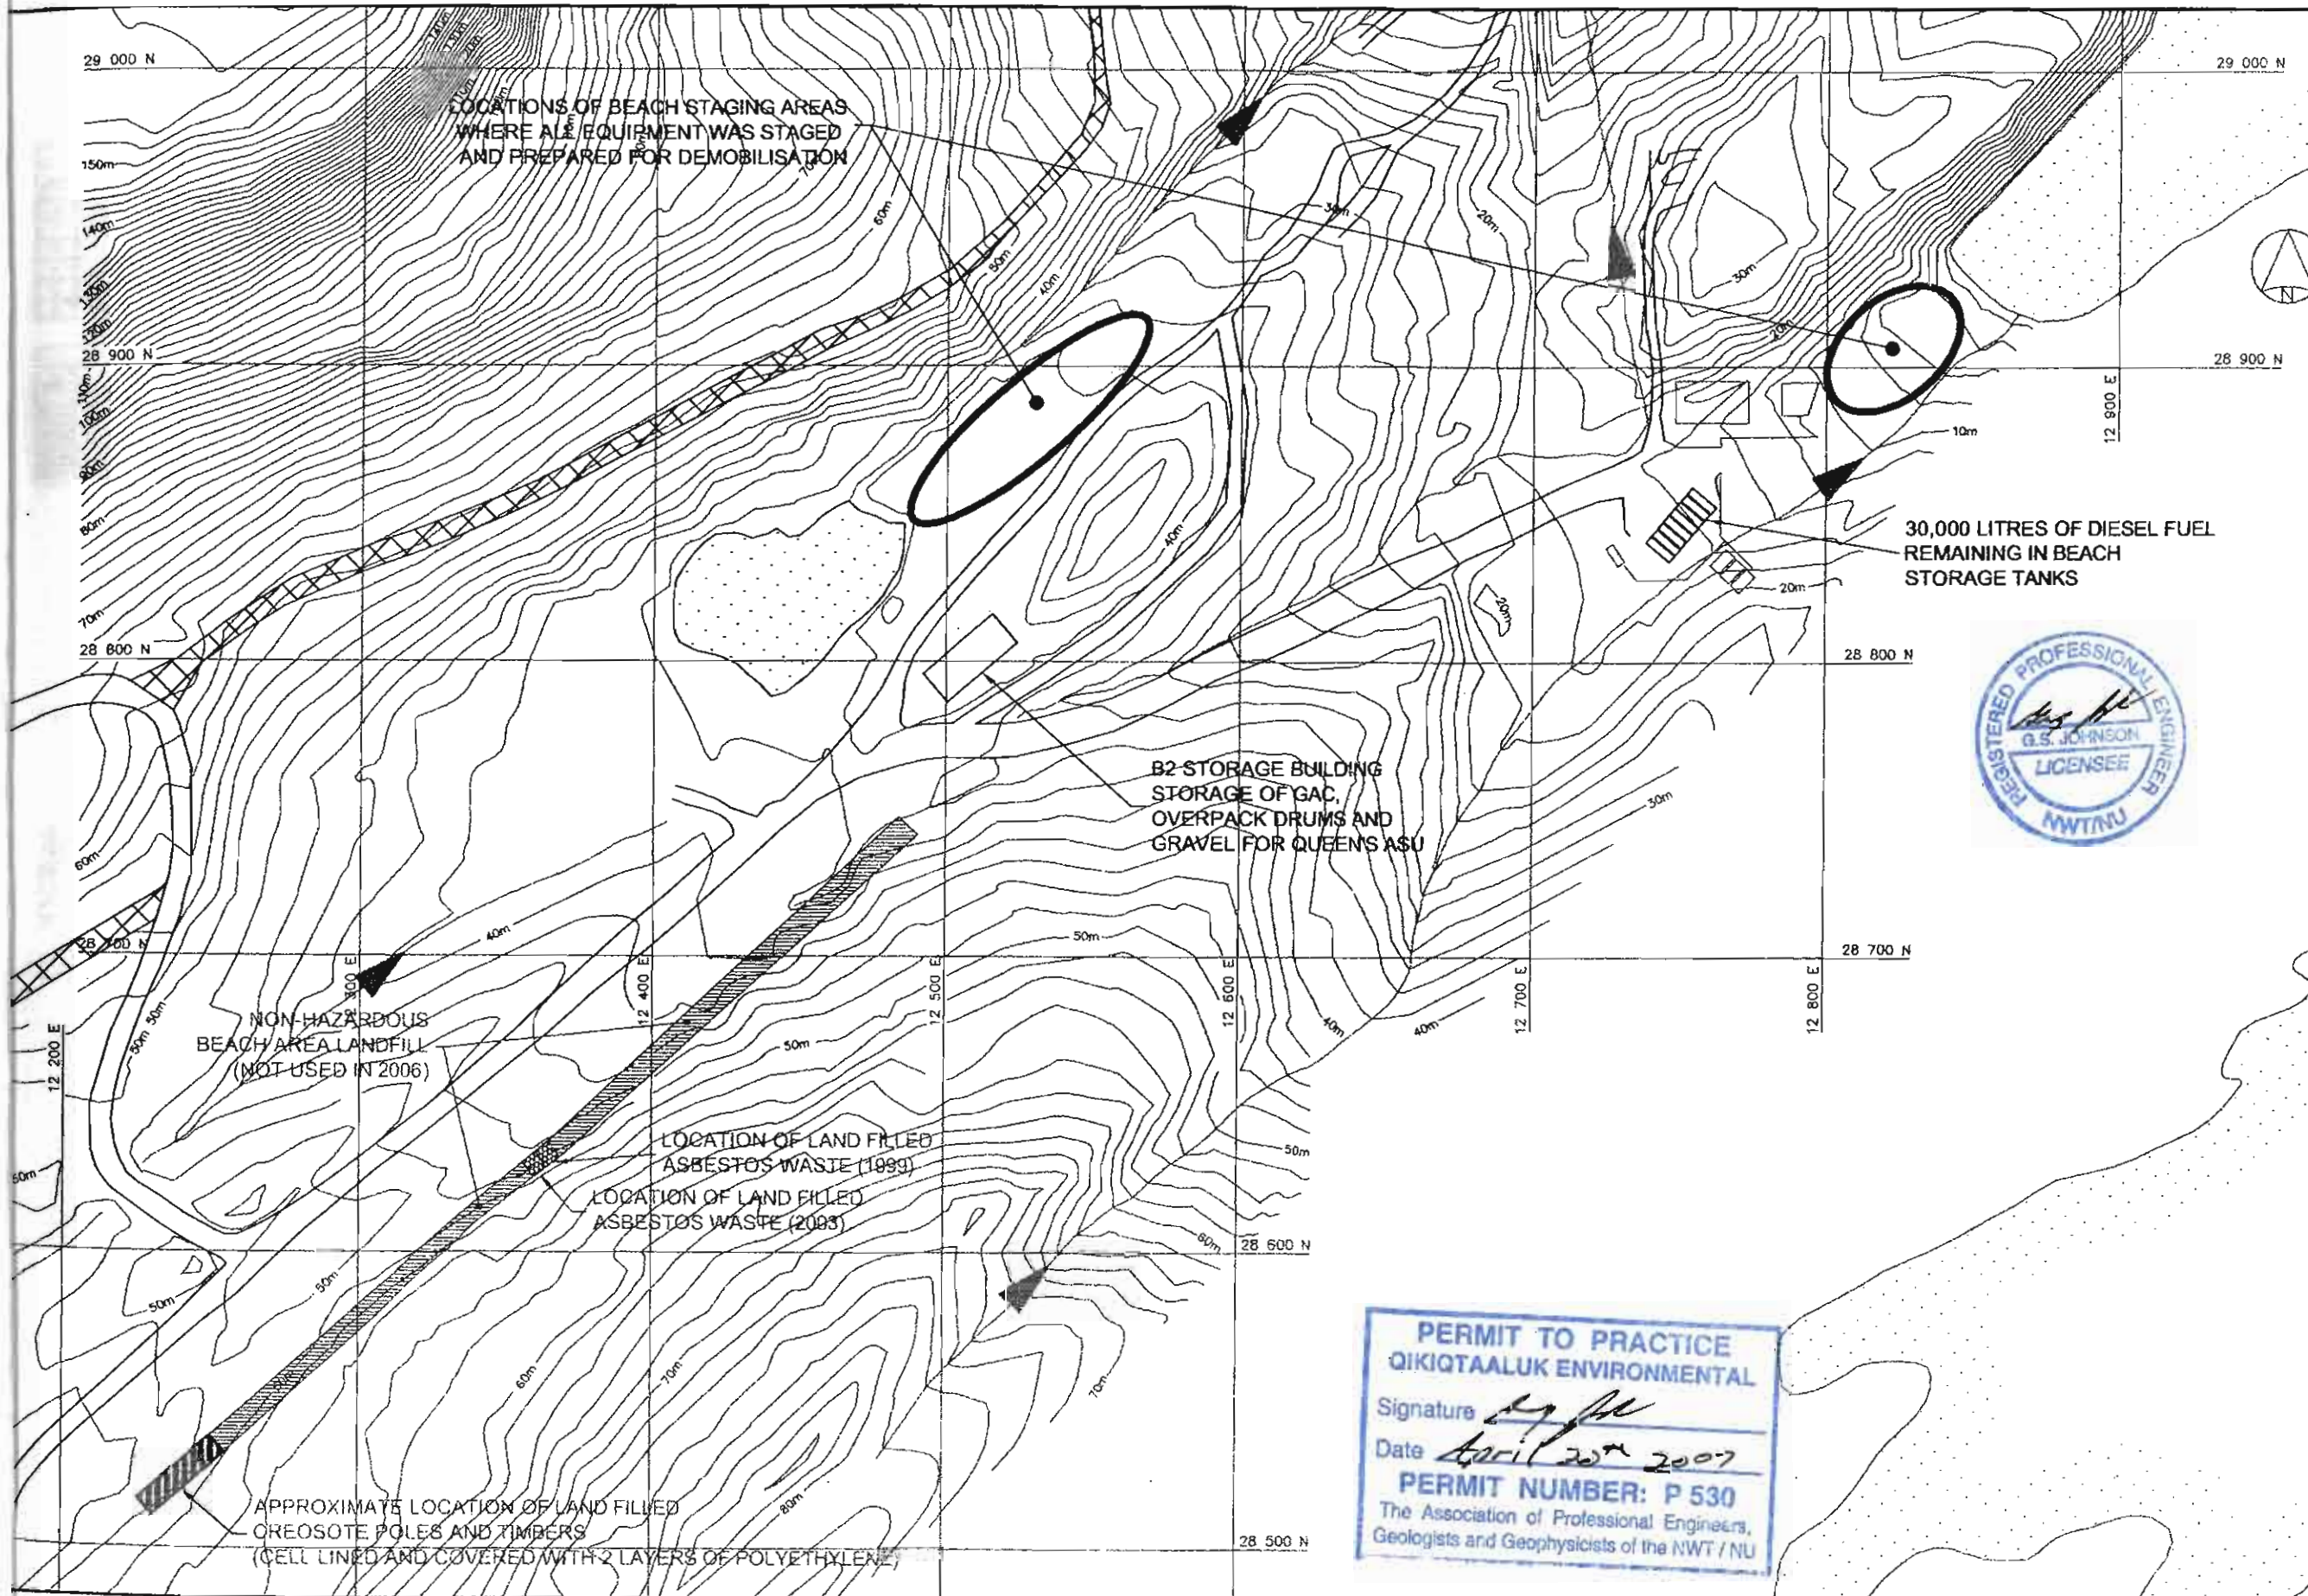





DATE
2007-01-24

SUBJECT - SUJET
GENERAL LAYOUT OF THE AREA SURROUNDING THE
TIER II LANDFILL AND THE LAND FARM PLATFORM
(END OF PROJECT)

PRODUCTION	CONCURRENCE - ASSESSMENT
DESIGNED ETUDIE	G.J.
DRAWN DESINE	G.J.
CHECKED VERIFIE	P.S.
COORDINATION	REVIEWED - REVU C.M.

DWG. NO. - DESSIN NO.
AB-2006-102-04




 INDIAN AND NORTHERN AFFAIRS CANADA																																																																														
NUNAVUT REGIONAL OFFICE																																																																														
General Notes:																																																																														
Legend:																																																																														
 NON-HAZARDOUS WASTE																																																																														
 LOCATION OF LAND FILLED ASBESTOS WASTE																																																																														
 LOCATION OF LAND FILLED CREOSOTE TREATED WOOD																																																																														
 ROAD DECOMMISSIONED (CULVERTS REMOVED AND SURFACE REGRADED)																																																																														
<table border="1"><tr><td>NO.</td><td>DATE</td><td>REVISION</td><td>REVISION</td><td>APPROV.</td></tr><tr><td colspan="5"> QIKIQTAALUK CORPORATION</td></tr><tr><td colspan="5"> QIKIQTAALUK ENVIRONMENTAL</td></tr><tr><td colspan="5">SCALE - ECHELLE 20 10 0 10 20 30 40 50</td></tr><tr><td colspan="5">PROJECT - PROJET BAF-5 RESOLUTION ISLAND</td></tr><tr><td colspan="5">© COPYRIGHT HER MAJESTY THE QUEEN IN THE RIGHT OF CANADA 2006, AS REPRESENTED BY INDIAN AND NORTHERN AFFAIRS CANADA</td></tr><tr><td colspan="2">TRADE - METIER SITING</td><td colspan="3">DATE 2006-01-24</td></tr><tr><td colspan="5">SUBJECT - SUJET GENERAL LAYOUT OF THE BEACH AREA END OF PROJECT</td></tr><tr><td colspan="2">PRODUCTION</td><td colspan="3">CONCURRENCE - ASSENTIMENT</td></tr><tr><td colspan="2">DESIGNED ETUDE</td><td colspan="3">G.J.</td></tr><tr><td colspan="2">DRAWN DESSINE</td><td colspan="3">G.J.</td></tr><tr><td colspan="2">CHECKED VÉRIFIE</td><td colspan="3">P.S.</td></tr><tr><td colspan="2">COORDINATION</td><td colspan="3">REVIEWED - REVU C.M.</td></tr><tr><td colspan="5">DWG NO. - DESIGN NO. AB-2006-102-05</td></tr><tr><td colspan="5"></td></tr></table>				NO.	DATE	REVISION	REVISION	APPROV.	 QIKIQTAALUK CORPORATION					 QIKIQTAALUK ENVIRONMENTAL					SCALE - ECHELLE 20 10 0 10 20 30 40 50					PROJECT - PROJET BAF-5 RESOLUTION ISLAND					© COPYRIGHT HER MAJESTY THE QUEEN IN THE RIGHT OF CANADA 2006, AS REPRESENTED BY INDIAN AND NORTHERN AFFAIRS CANADA					TRADE - METIER SITING		DATE 2006-01-24			SUBJECT - SUJET GENERAL LAYOUT OF THE BEACH AREA END OF PROJECT					PRODUCTION		CONCURRENCE - ASSENTIMENT			DESIGNED ETUDE		G.J.			DRAWN DESSINE		G.J.			CHECKED VÉRIFIE		P.S.			COORDINATION		REVIEWED - REVU C.M.			DWG NO. - DESIGN NO. AB-2006-102-05									
NO.	DATE	REVISION	REVISION	APPROV.																																																																										
 QIKIQTAALUK CORPORATION																																																																														
 QIKIQTAALUK ENVIRONMENTAL																																																																														
SCALE - ECHELLE 20 10 0 10 20 30 40 50																																																																														
PROJECT - PROJET BAF-5 RESOLUTION ISLAND																																																																														
© COPYRIGHT HER MAJESTY THE QUEEN IN THE RIGHT OF CANADA 2006, AS REPRESENTED BY INDIAN AND NORTHERN AFFAIRS CANADA																																																																														
TRADE - METIER SITING		DATE 2006-01-24																																																																												
SUBJECT - SUJET GENERAL LAYOUT OF THE BEACH AREA END OF PROJECT																																																																														
PRODUCTION		CONCURRENCE - ASSENTIMENT																																																																												
DESIGNED ETUDE		G.J.																																																																												
DRAWN DESSINE		G.J.																																																																												
CHECKED VÉRIFIE		P.S.																																																																												
COORDINATION		REVIEWED - REVU C.M.																																																																												
DWG NO. - DESIGN NO. AB-2006-102-05																																																																														
																																																																														



BENCHMARKS				
NO.	COORDINATES		ELEVATION	DESCRIPTION
	NORTH	EAST		
1	6830186.76	412898.66	358.08	MEDALLION
2	6830234.87	412899.16	346.35	MEDALLION
3	6830284.84	412948.08	356.48	MEDALLION
4	6830272.12	412737.94	316.47	CROSS
5	6830296.91	412838.57	330.15	PIPE & NAIL
6	6830369.58	412728.35	316.80	PIPE & NAIL

THERMISTORS				
NO.	COORDINATES		ELEVATION	DESCRIPTION
	NORTH	EAST		
VT-1	6830321.32	412686.28	318.10	PIPE
VT-2	6830298.80	412651.28	317.33	PIPE
VT-3	6830272.50	412674.09	315.88	PIPE
VT-4	6830303.61	412701.22	316.84	PIPE

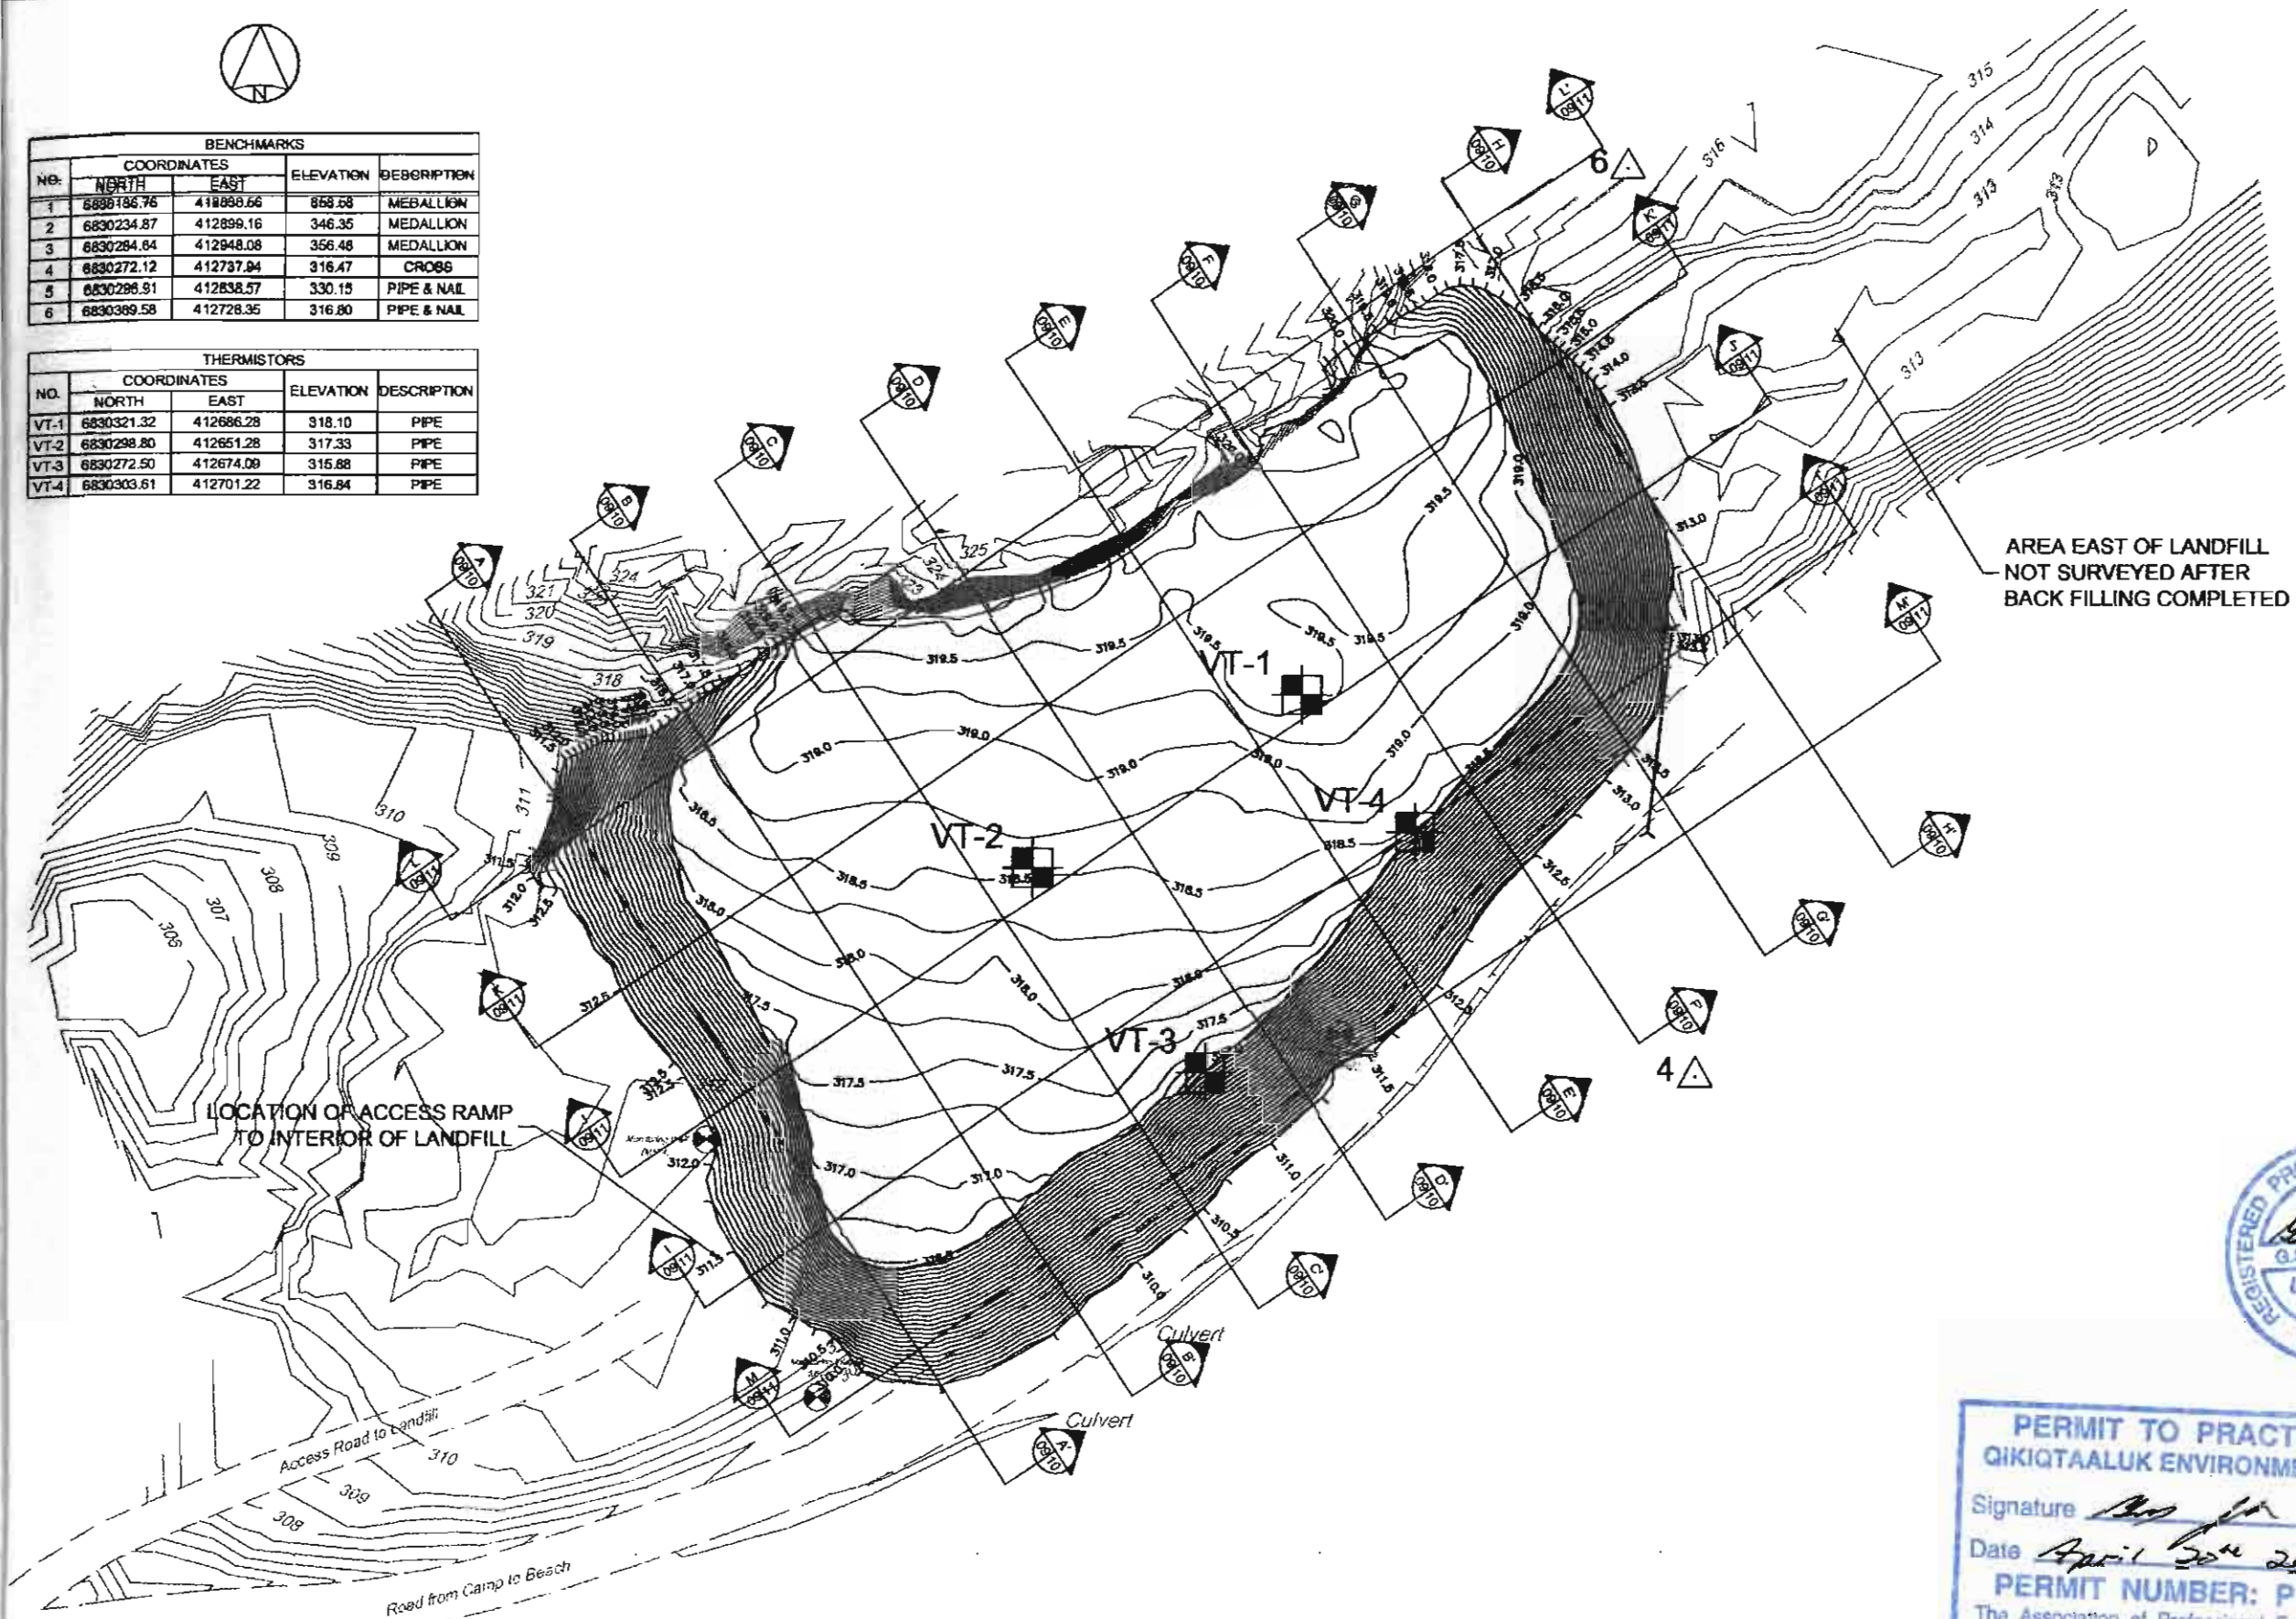

INDIAN AND NORTHERN
AFFAIRS CANADA

NUNAVUT REGIONAL OFFICE

General Notes:

1. THE DRAWING IS NOW ORIENTED ACCURATELY TO NAD83 GRID NORTH BUT MAY BE SEVERAL METERS OFF IN POSITION.
2. BENCH MARKS 1, 2 AND 3 ARE MEDALLIONS SET IN BEDROCK (NOT SHOWN).
3. BENCHMARK 4 IS A CROSS CHISELLED INTO BEDROCK WITH A 3/8 INCH HOLE DRILLED IN THE MIDDLE.
4. BENCHMARKS 5 AND 6 ARE STEEL PIPES GROUTED INTO THE BEDROCK WITH A NAIL STICKING OUT OF THE TOP.
5. MONITORING WELLS INSTALLED DURING THE 2005 SEASON ARE NOT SURVEYED.

Legend:

MONITORING WELL LOCATION


PERMANENT CULVERT

BENCHMARK LOCATION

VT-2 THERMISTOR LOCATION

5

NO.	DATE	REVISION	REVISION	APPROVAL
-----	------	----------	----------	----------

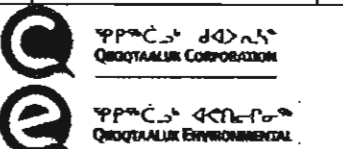

SCALE - ECHELLE 10 0 10 20 m

PROJECT - PROJET
BAF-5 RESOLUTION ISLAND

© COPYRIGHT HER MAJESTY THE QUEEN
IN THE RIGHT OF CANADA 2007,
AS REPRESENTED BY INDIAN AND
NORTHERN AFFAIRS CANADA

TRADE - METIER
SITING
DATE
2007-02-08

SUBJECT - SUJET
SURVEYED DRAWING OF THE TIER II LANDFILL AREA

PRODUCTION	CONCURRENCE - ASSENTIMENT
DESIGNED ETUDE	G.J.
DRAWN DESSINE	G.J.
CHECKED VERIFIE	P.S.
COORDINATION	REVIEWED - REVU C.M.

DWG. NO. - DESSIN NO.
AB-2006-102-06

Canada



1. GREY LINES REPRESENT NATURAL GROUND ELEVATION. BLACK LINES REPRESENT THE GROUND ELEVATIONS AT THE END OF THE 2006 WORK SEASON.

Legend:

— TOP TYPE 1
- - - TOP TYPE 2
... TOP MEMBRANE
- - - TOP TIER I
- - - TOP TIER II

No.	DATE	REVISION	REVISION	APPR.

QIQTAAALUK COMPOSITION
QIQTAAALUK ENVIRONMENTAL

SCALE - ECHILLE AS SHOWN

PROJECT - PROJET
BAF-5 RESOLUTION ISLAND

© COPYRIGHT HER MAJESTY THE QUEEN
IN THE RIGHT OF CANADA 2007,
AS REPRESENTED BY INDIAN AND
NORTHERN AFFAIRS CANADA

TRADE - METIER SITING DATE 2007-02-08


SUBJECT - SUJET

CROSS-SECTIONS OF THE TIER II LANDFILL
(DRAWING 2 OF 2)


PRODUCTION	CONCURRENCE - ASSESSMENT
DESIGNED ETUDE	G.J.
DRAWN DESINE	G.J.
CHECKED VERIFIE	P.S.
COORDINATION	REVIEWED - REVU C.M.

DRAWING NO. - DESSIN NO.
AB-2006-102-08


Canada

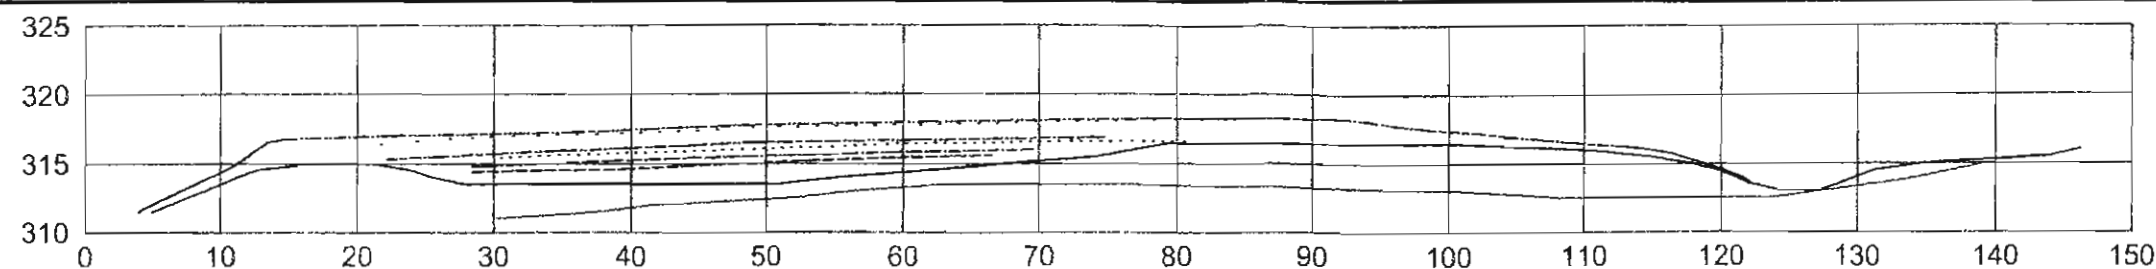


I-I'
09/11

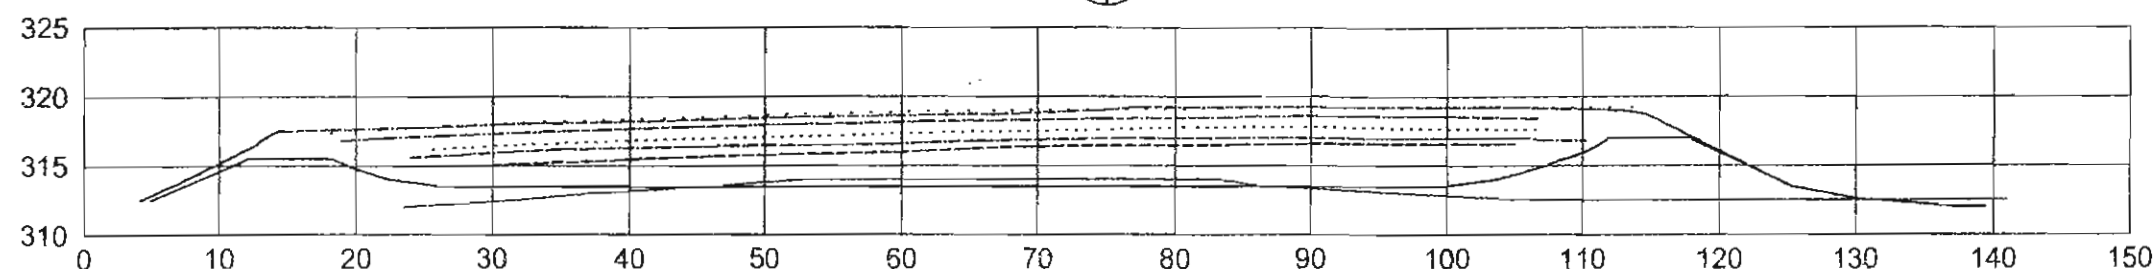


J-J'
09/11

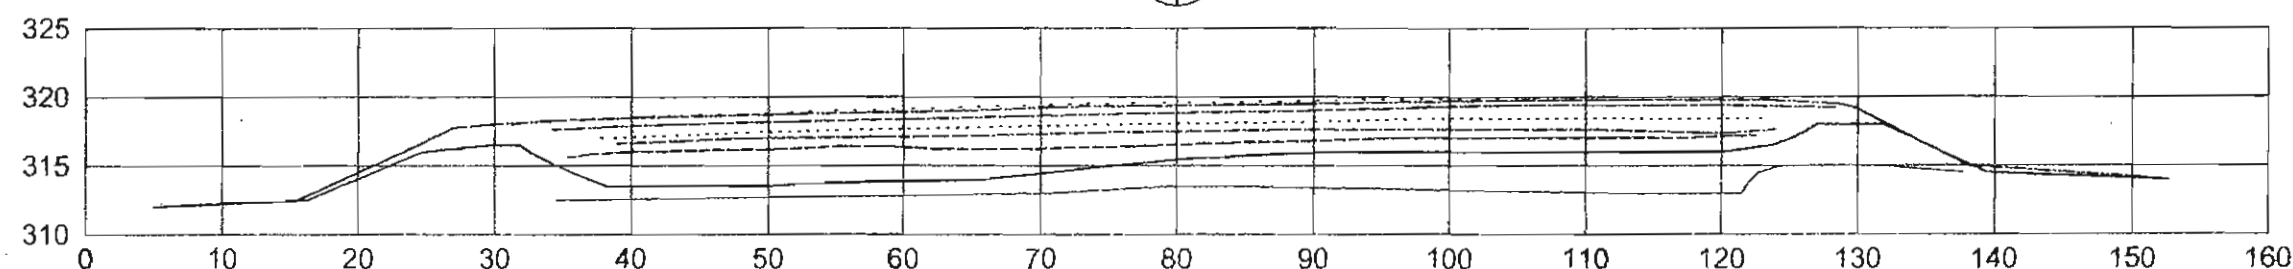

K-K'
09/11

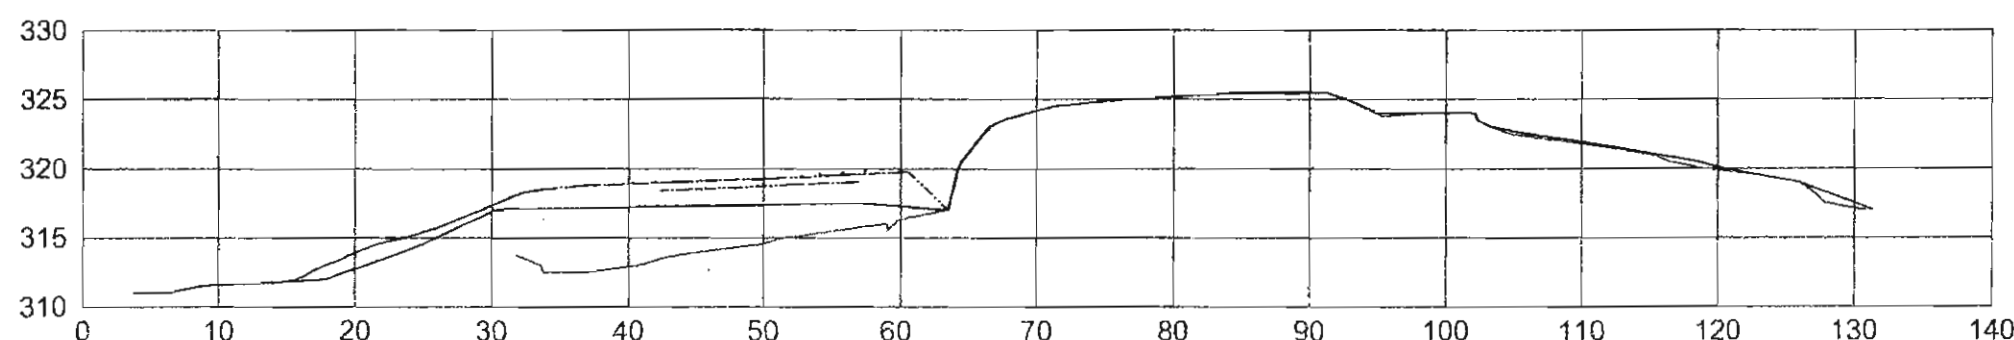


L-L'
09/11

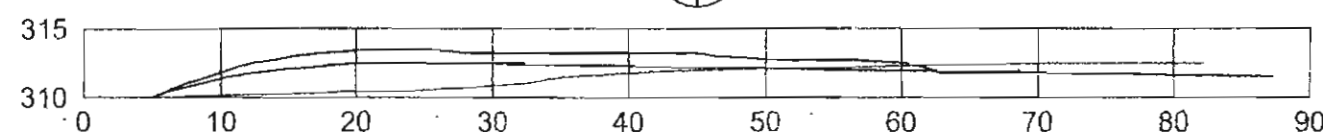


M-M'
09/11

PERMIT TO PRACTICE
QIQTAAALUK ENVIRONMENTAL
Signature *[Signature]*
Date *April 20th 2007*
PERMIT NUMBER: P 530
The Association of Professional Engineers,
Geologists and Geophysicists of the NWT / NU




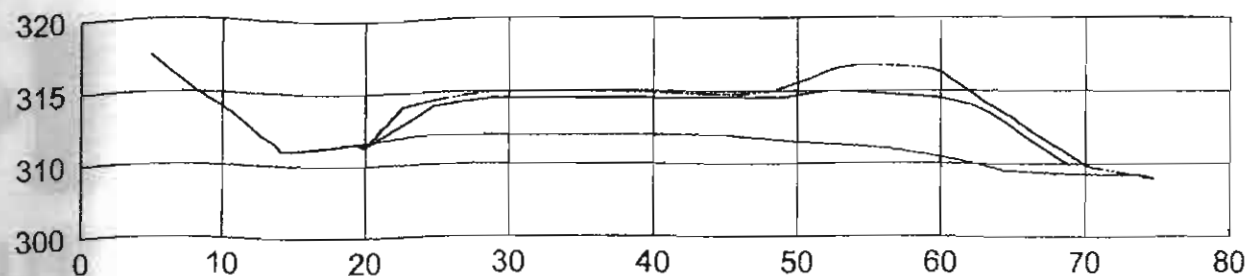


A-A'
09/10

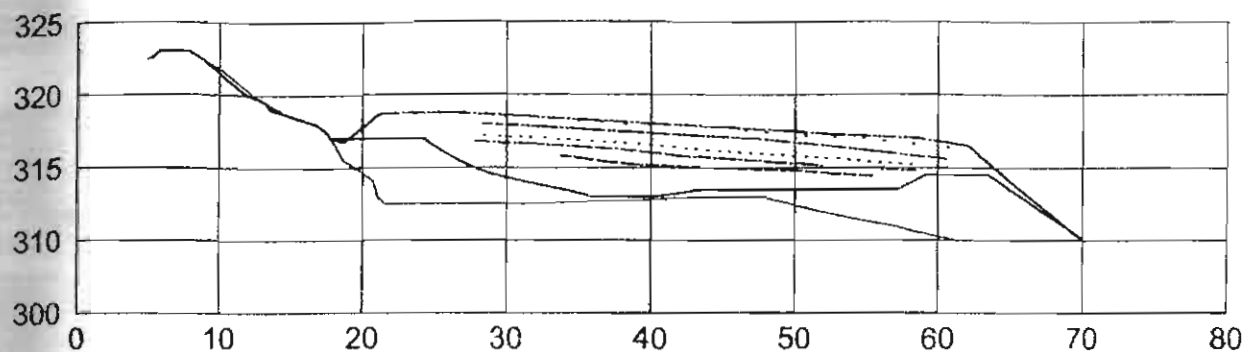


B-B'
09/10

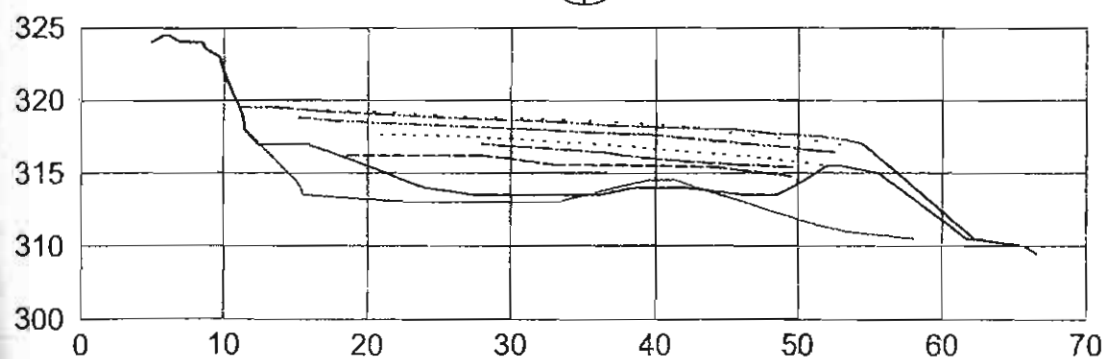


C-C'
09/10

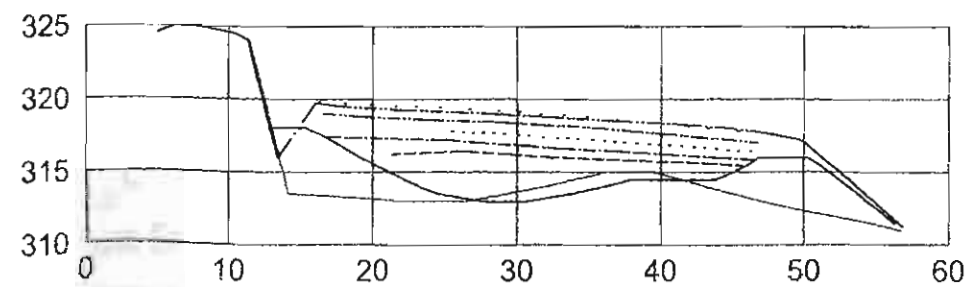


D-D'
09/10

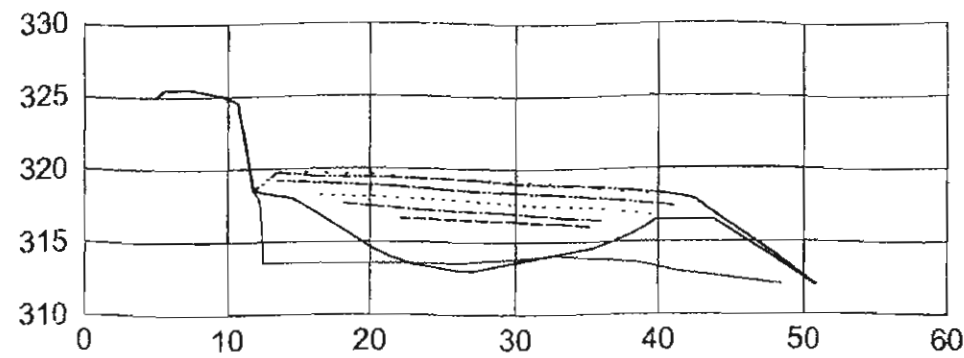


E-E'
09/10

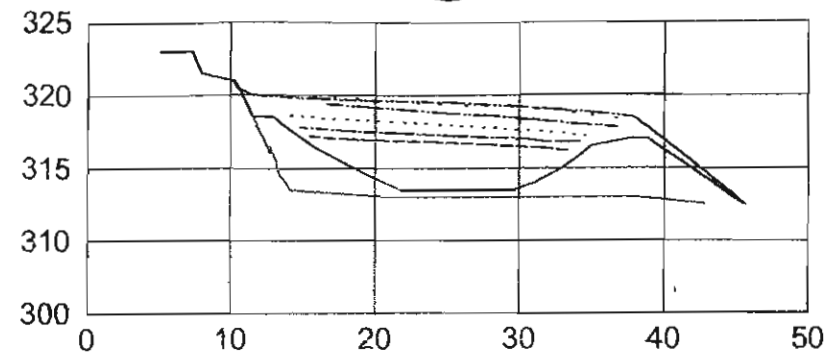

F-F'
09/10

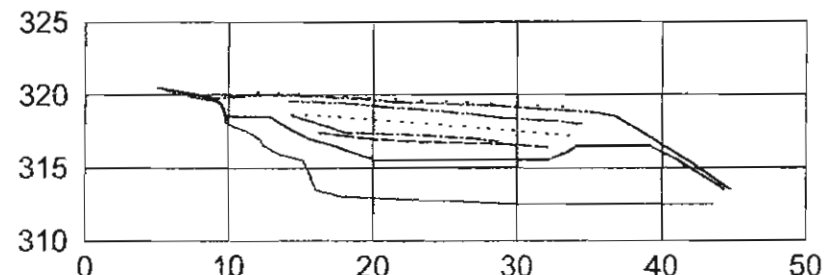

G-G'
09/10

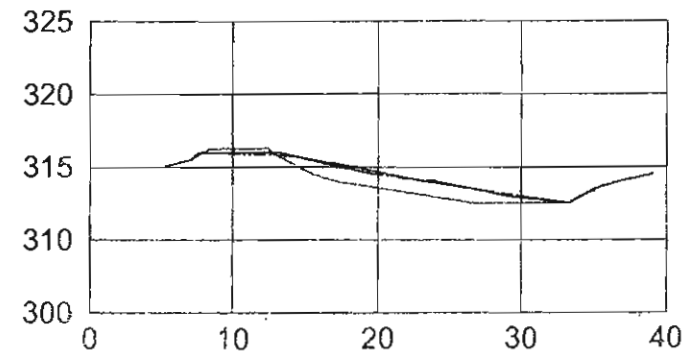

H-H'
09/10



PERMIT TO PRACTICE
QIKIQTAAULUK ENVIRONMENTAL
Signature: *[Signature]*
Date: April 21st 2007
PERMIT NUMBER: P 530
The Association of Professional Engineers,
Geologists and Geophysicists of the NWT / NU

General Notes:
1. GREY LINES REPRESENT NATURAL GROUND ELEVATION. BLACK LINES REPRESENT LEVELS OF FILL AS SHOWN IN THE LEGEND.

- Legend:
- FINAL ELEVATION
 - TOP TYPE 1
 - TOP TYPE 2
 - TOP MEMBRANE
 - TOP TIER I
 - TOP TIER II

NO.	DATE	REVISION	REVISION	APPR.
SCALE - ECHELLE: AS SHOWN				
PROJECT - PROJET: BAF-5 RESOLUTION ISLAND				
© COPYRIGHT HER MAJESTY THE QUEEN IN THE RIGHT OF CANADA 2007, AS REPRESENTED BY INDIAN AND NORTHERN AFFAIRS CANADA				
TRADE - METIER: SITING	DATE: 2007-02-08			
SUBJECT - SUJET: CROSS-SECTIONS OF THE TIER II LANDFILL (DRAWING 1 OF 2)				
DESIGNED ETUDE: G.J.	CONCURRENCE - ASSENTMENT: G.J.			
DRAWN: G.J.				
CHECKED: P.S.				
COORDINATION: REVIEWED - REVU: C.M.				
DWG. NO. - DESIGN NO. AB-2006-102-07				
Canada				