



AS-BUILT DRAWING INDEX	
DRAWING NUMBER	TITLE
SITING	
AB-2003-102-01	LOCATION OF BORROW PITS USED DURING THE SEASON
AB-2003-102-02	GENERAL SITE LAYOUT AND AS-BUILT DRAWING INDEX
AB-2003-102-03	GENERAL LAYOUT OF, AND MODIFICATIONS MADE TO, THE UPPER WORKSITE
AB-2003-102-04	GENERAL LAYOUT OF, AND MODIFICATIONS MADE TO, THE TIER II LANDFILL AND SURROUNDING AREA
AB-2003-102-05	GENERAL LAYOUT OF THE RADIO HILL AREA
AB-2003-102-06	GENERAL LAYOUT OF, AND MODIFICATIONS MADE TO, THE BEACH AREA
AB-2003-102-07	GENERAL LAYOUT OF, AND MODIFICATIONS MADE TO, THE AIRSTRIP DUMP
AB-2003-102-08	S1/S4 BUILDING AND DRAINAGE AREA GRIDDING SYSTEM
AB-2003-102-09	SURVEYOR DRAWING OF THE TIER II LANDFILL AREA
AB-2003-102-10	CROSS-SECTIONS OF THE TIER II LANDFILL (DRAWING 1 OF 2)
AB-2003-102-11	CROSS-SECTIONS OF THE TIER II LANDFILL (DRAWING 2 OF 2)
AB-2003-102-12	CROSS-SECTIONS OF THE BERM CORES CONSTRUCTED DURING THE 2003
AB-2003-102-13	INSTALLATION DETAILS MONITORING WELL NUMBER 2
AB-2003-102-14	INSTALLATION DETAILS MONITORING WELL NUMBER 3
AB-2003-102-15	INSTALLATION DETAILS MONITORING WELL NUMBER 4




**BAF-5 RESOLUTION ISLAND  
2003 AS-BUILT DRAWINGS**

**2003** <ᄢᆞᆯᆡᆫᆺᆸᆮᆺᆷᆻᆯᆺᆷ ᆹᆹᆽᆪᆺᆳᆼᆺᆷ




ᑭᑭᑭᑭᑭᑭ ᑭᑭᑭᑭᑭᑭ  
QIKIQTAALUK CORPORATION

FEBRUARY 2004

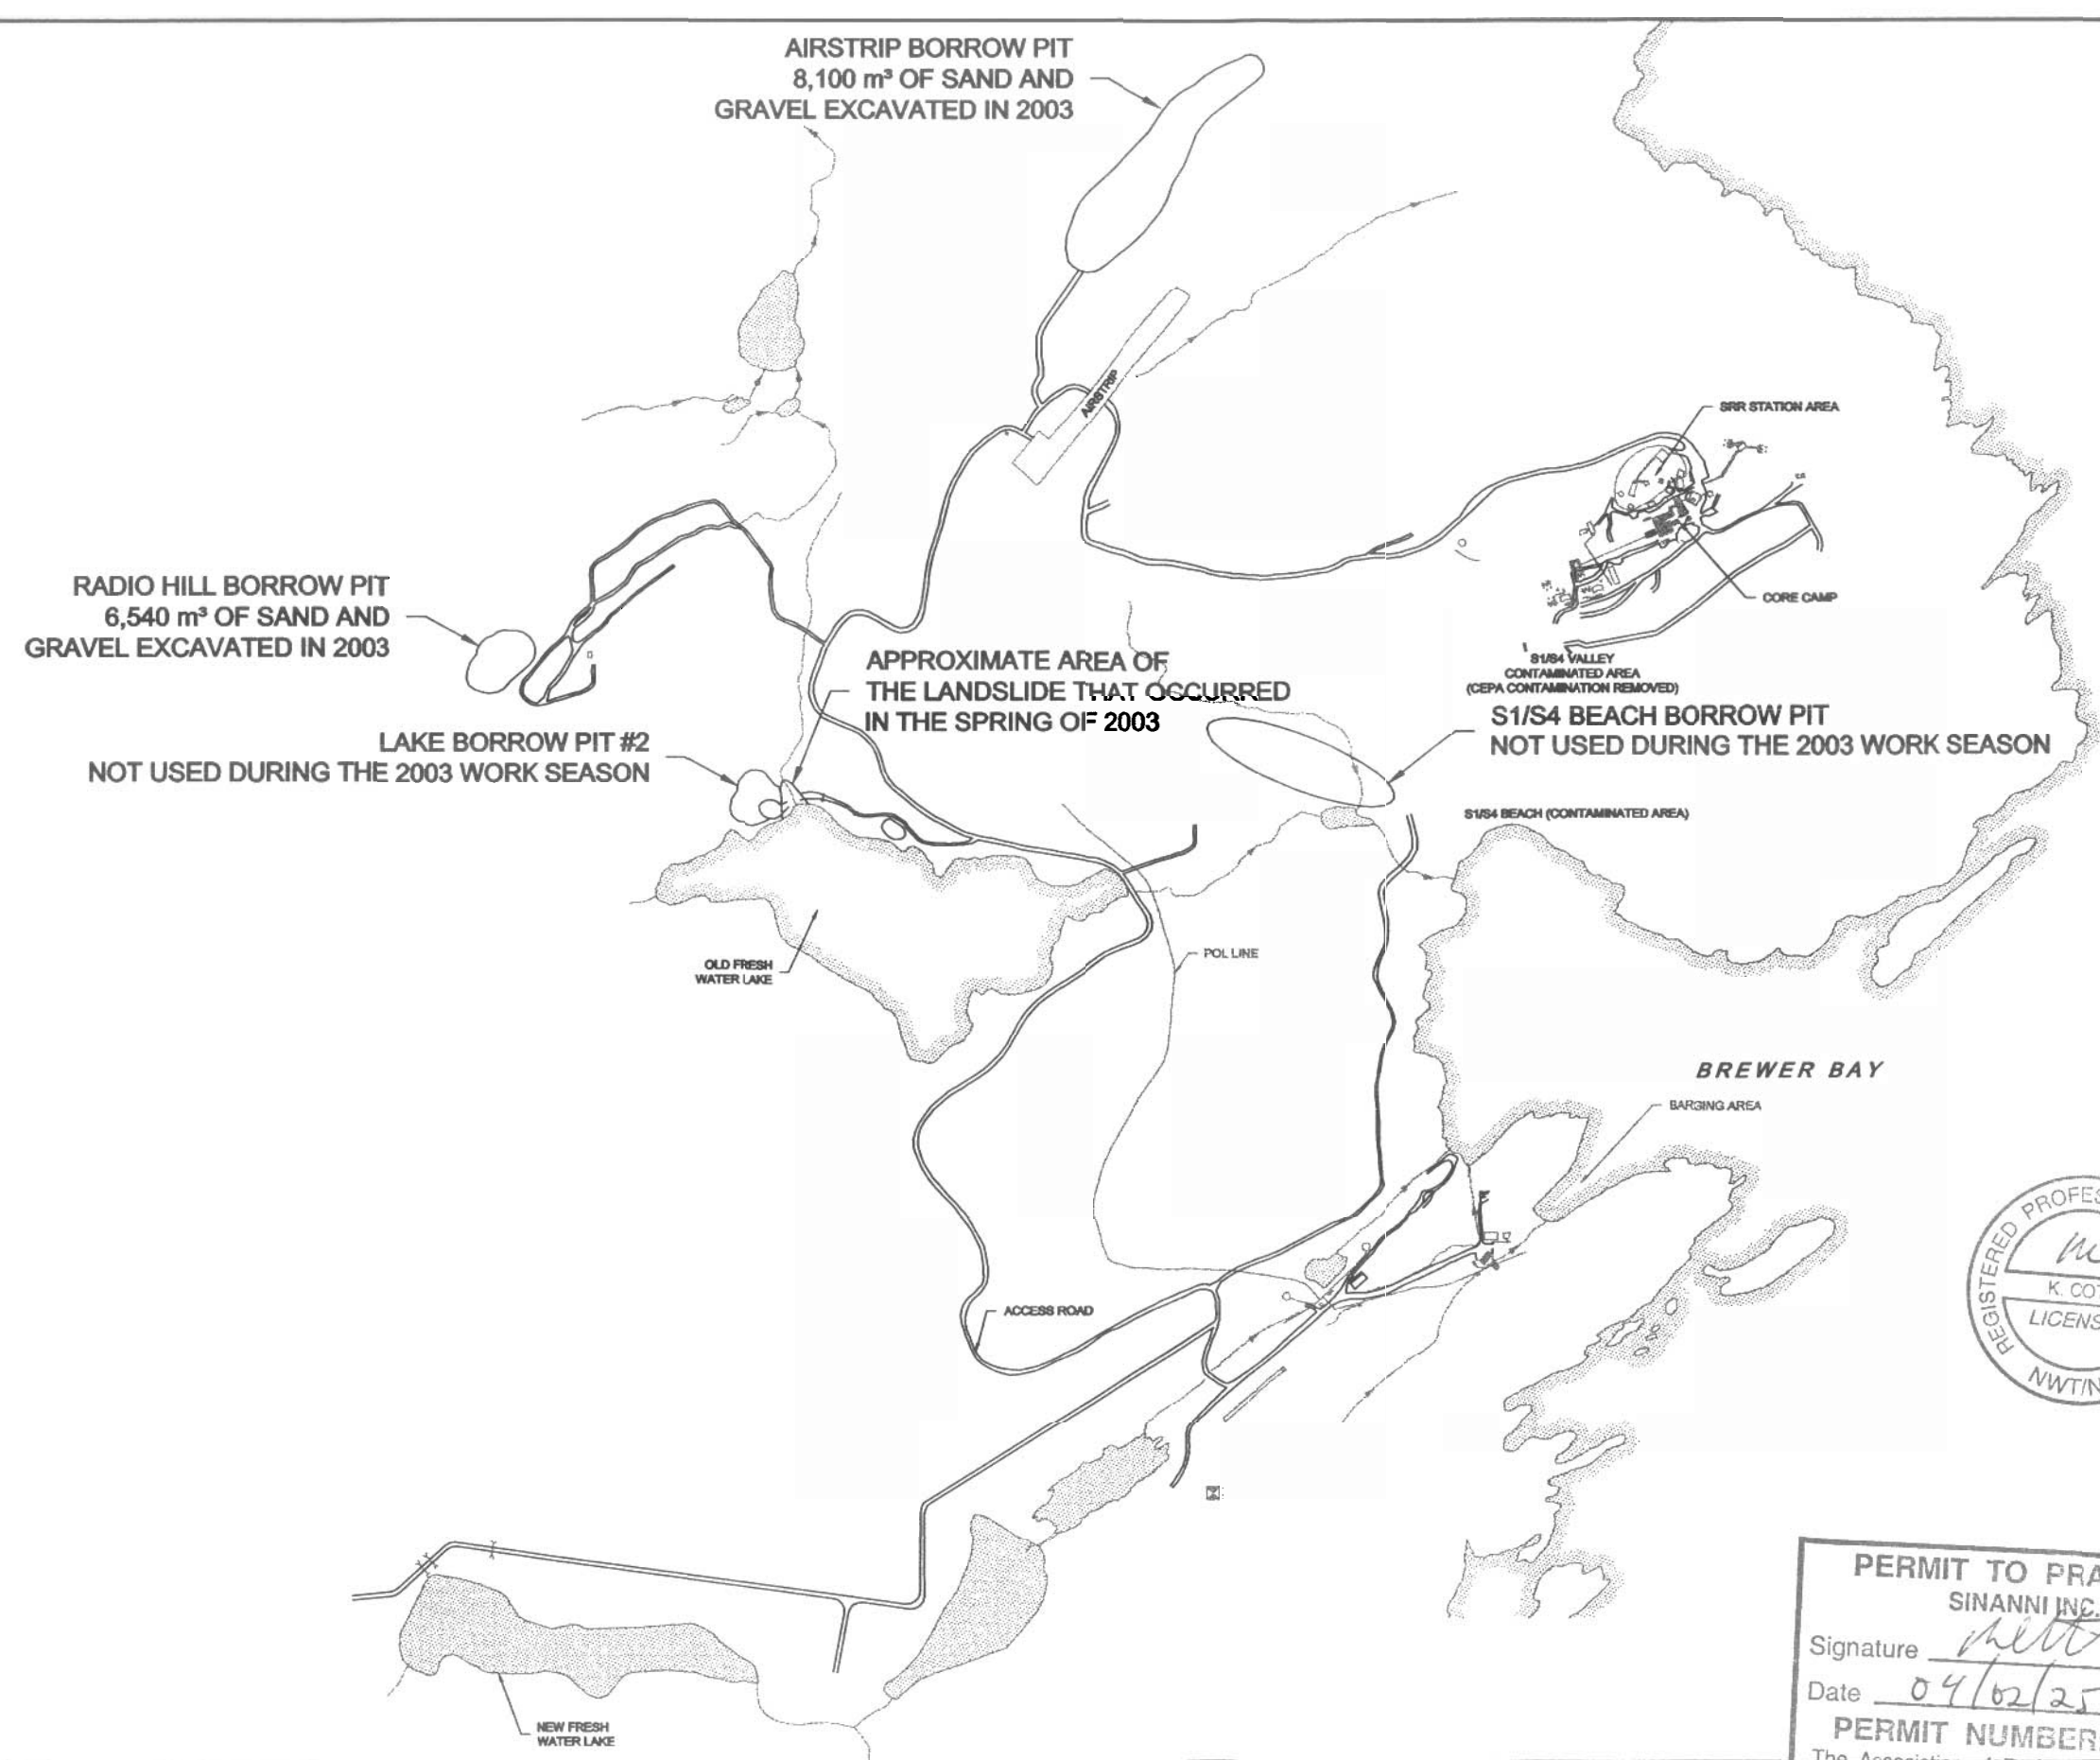

**PERMIT TO PRACTICE**  
**SINANNI INC.**  
Signature *[Signature]*  
Date 04/02/25  
**PERMIT NUMBER: P 410**  
The Association of Professional Engineers,  
Geologists and Geophysicists of the NWT / NU

 <b>INDIAN AND NORTHERN AFFAIRS CANADA</b>														
<b>NUNAVUT REGIONAL OFFICE</b>														
<b>GENERAL NOTES:</b> 1. LOCATIONS OF BORROW AREAS ARE APPROXIMATE AND NOT SURVEYED.														
<b>LEGEND:</b>														
<table border="1"><thead><tr><th>NO.</th><th>DATE</th><th>REVISION</th><th>REVISION</th><th>APPR.</th></tr></thead><tbody><tr><td colspan="5"> </td></tr></tbody></table>					NO.	DATE	REVISION	REVISION	APPR.					
NO.	DATE	REVISION	REVISION	APPR.										
 SCALE - ÉCHELLE: 0 50 100 200 300 m PROJECT - PROJET: <b>BAF-5 RESOLUTION ISLAND</b>														
© COPYRIGHT HER MAJESTY THE QUEEN IN THE RIGHT OF CANADA 2004, AS REPRESENTED BY INDIAN AND NORTHERN AFFAIRS CANADA														
TRADE - MÉTIER: <b>SITING</b>		DATE: <b>2004-02-04</b>												
SUBJECT - SUJET: <b>LOCATION OF BORROW PITS USED DURING THE WORK SEASON</b>														
DESIGNED ETUDE: <b>G.J.</b>		CONCURRENCE - ASSENTIMENT: <b>G.J.</b>												
DRAWN DESSINE: <b>G.J.</b>														
CHECKED VÉRIFIÉ: <b>K.C.</b>														
COORDINATION: <b>P.S.</b>														
DWG. NO. - DESSIN NO.: <b>AB-2003-102-01</b>														
														

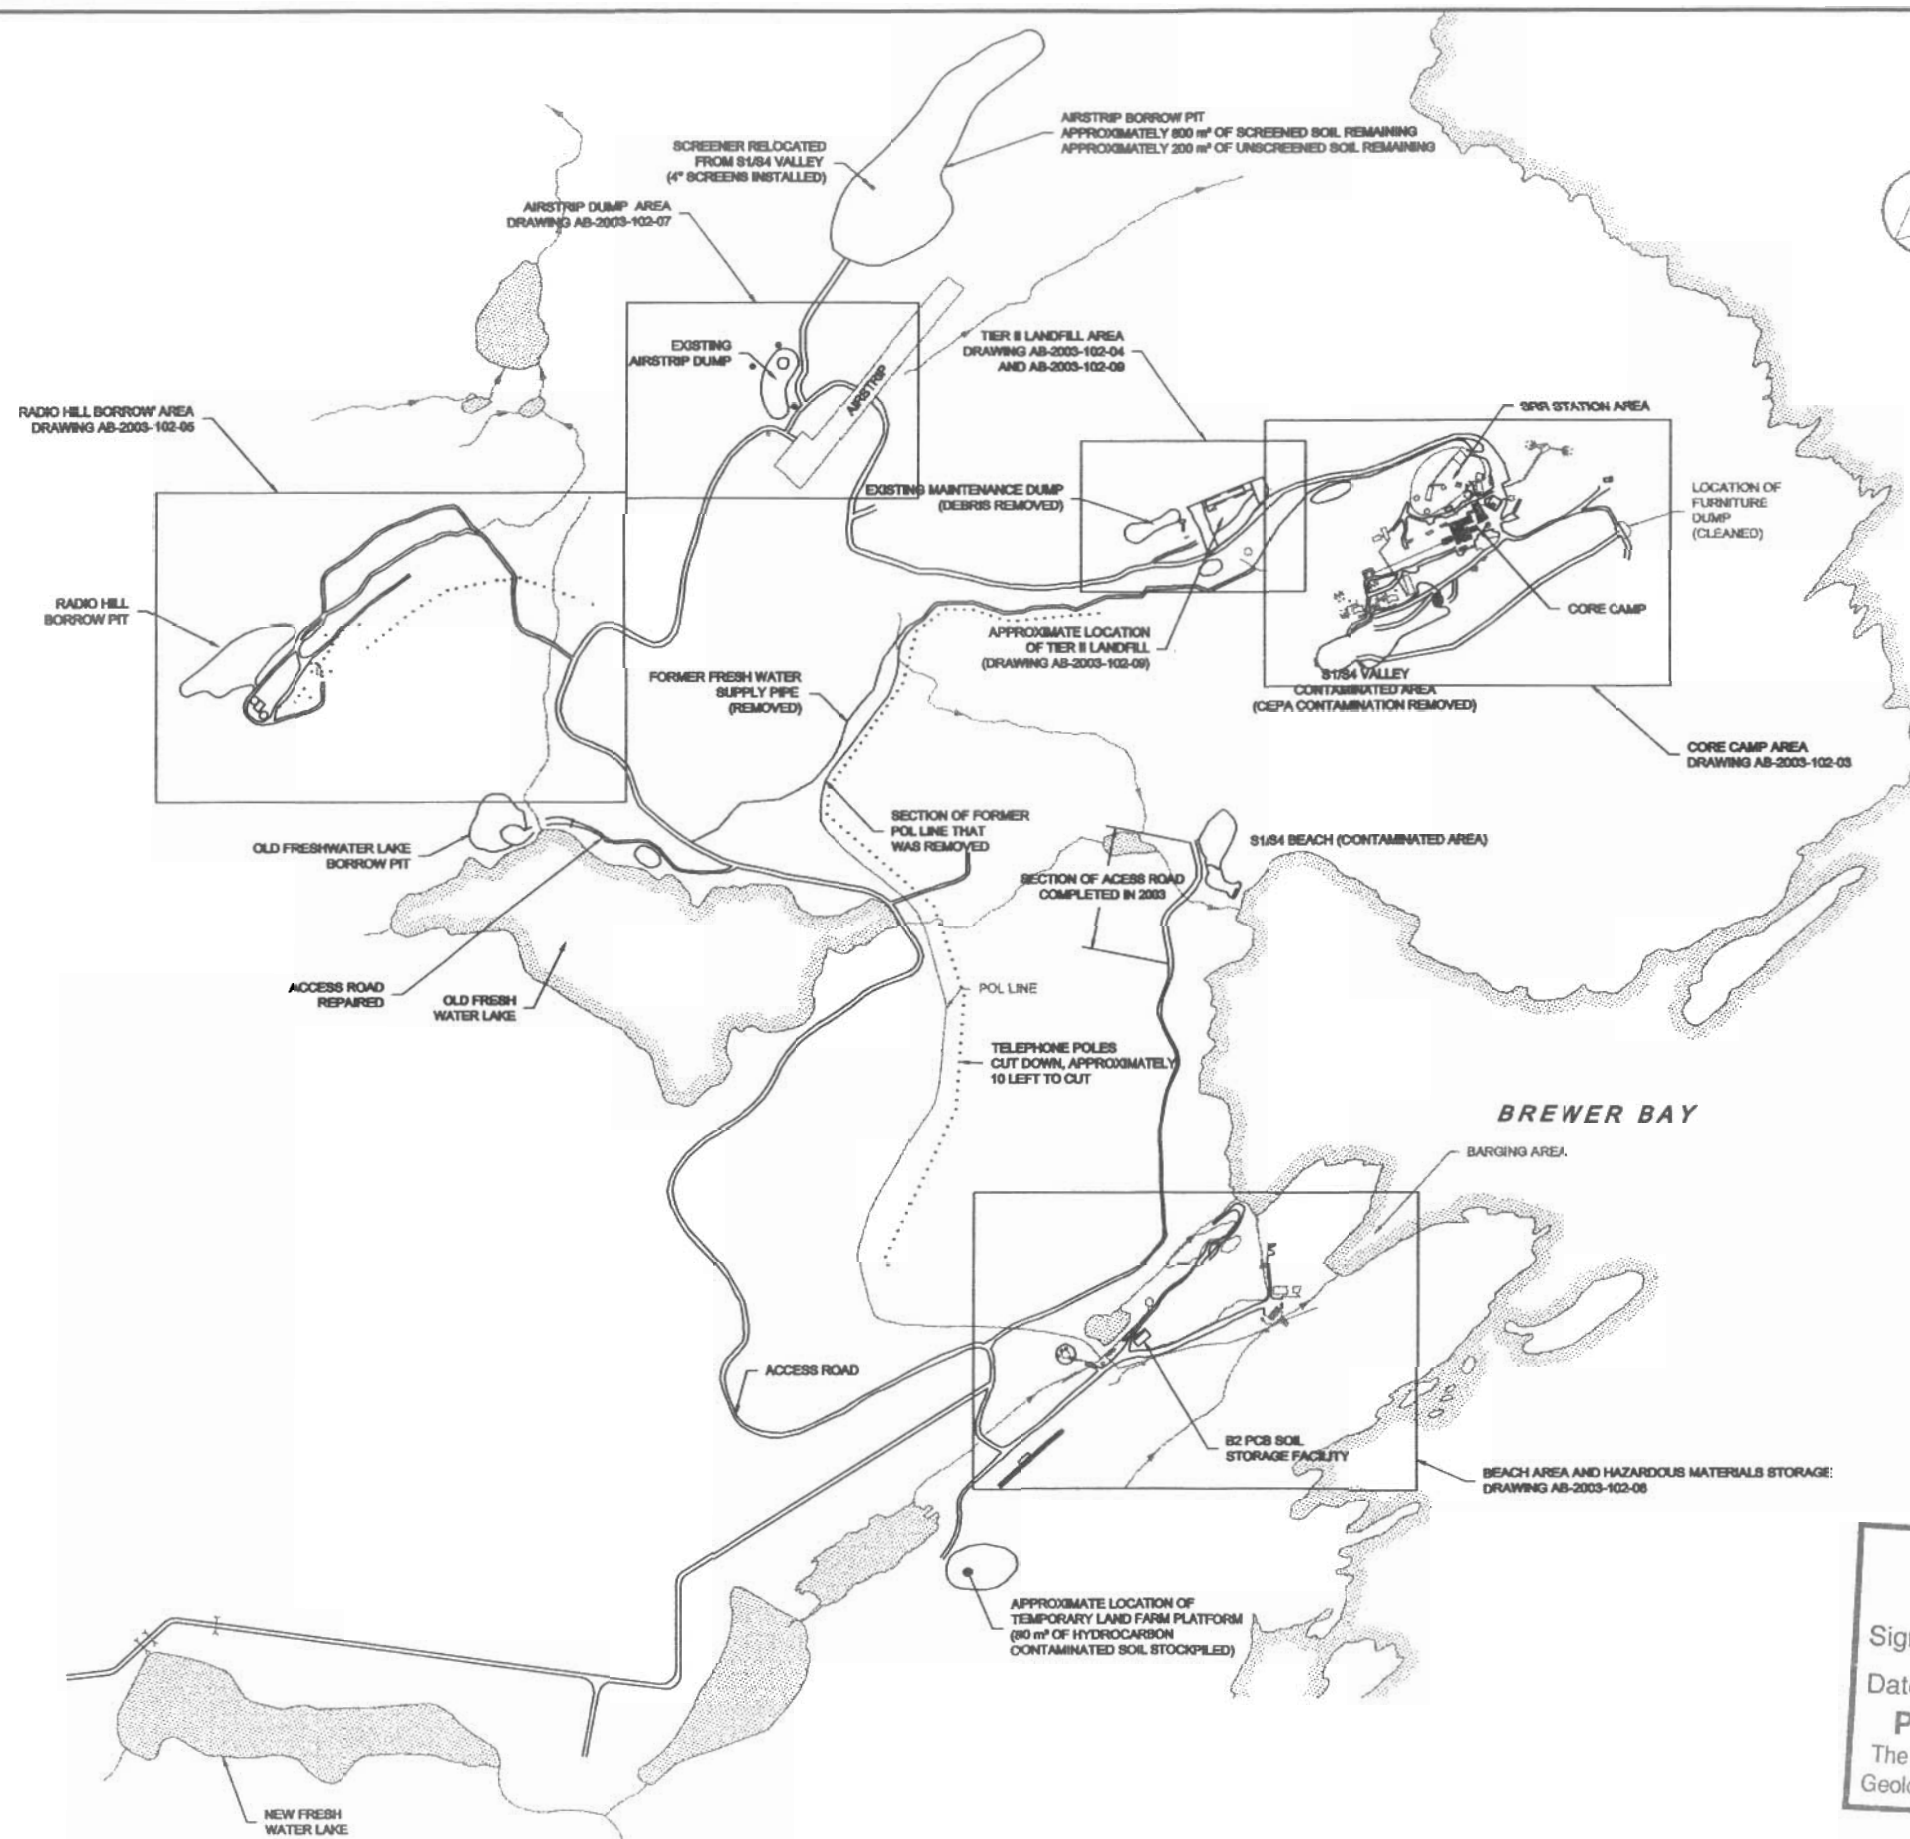

**PERMIT TO PRACTICE**  
**SINANNI INC.**  
 Signature [Signature]  
 Date 04/04/25  
**PERMIT NUMBER: P 410**  
 The Association of Professional Engineers  
 Geologists and Geophysicists of the NWT

INDIAN AND NORTHERN AFFAIRS CANADA

NUNAVUT REGIONAL OFFICE

General Notes:

Legend:

NO.	DATE	REVISION	REVISION	APPR.

SINANNI INC.

SCALE - ÉCHELLE 100 20 0 100 200 300 m

PROJECT - PROJET  
**BAF-5 RESOLUTION ISLAND**

© COPYRIGHT HER MAJESTY THE QUEEN  
 IN THE RIGHT OF CANADA 2004,  
 AS REPRESENTED BY INDIAN AND  
 NORTHERN AFFAIRS CANADA

TRADE - MÉTIER	SITING	DATE	2004-01-30
SUBJECT - SUJET			


GENERAL SITE LAYOUT AND AS BUILT DRAWING INDEX

PRODUCTION	CONCURRENCE - ASSESSMENT
DESIGNED ETUDE	G.J.
DRAWN DESSINÉ	G.J.
CHECKED VÉRIFIÉ	K.C.
COORDINATION	REVIEWED - REVU P.S.

DWG. NO. - DESSIN NO.  
 AB-2003-102-02

Canada



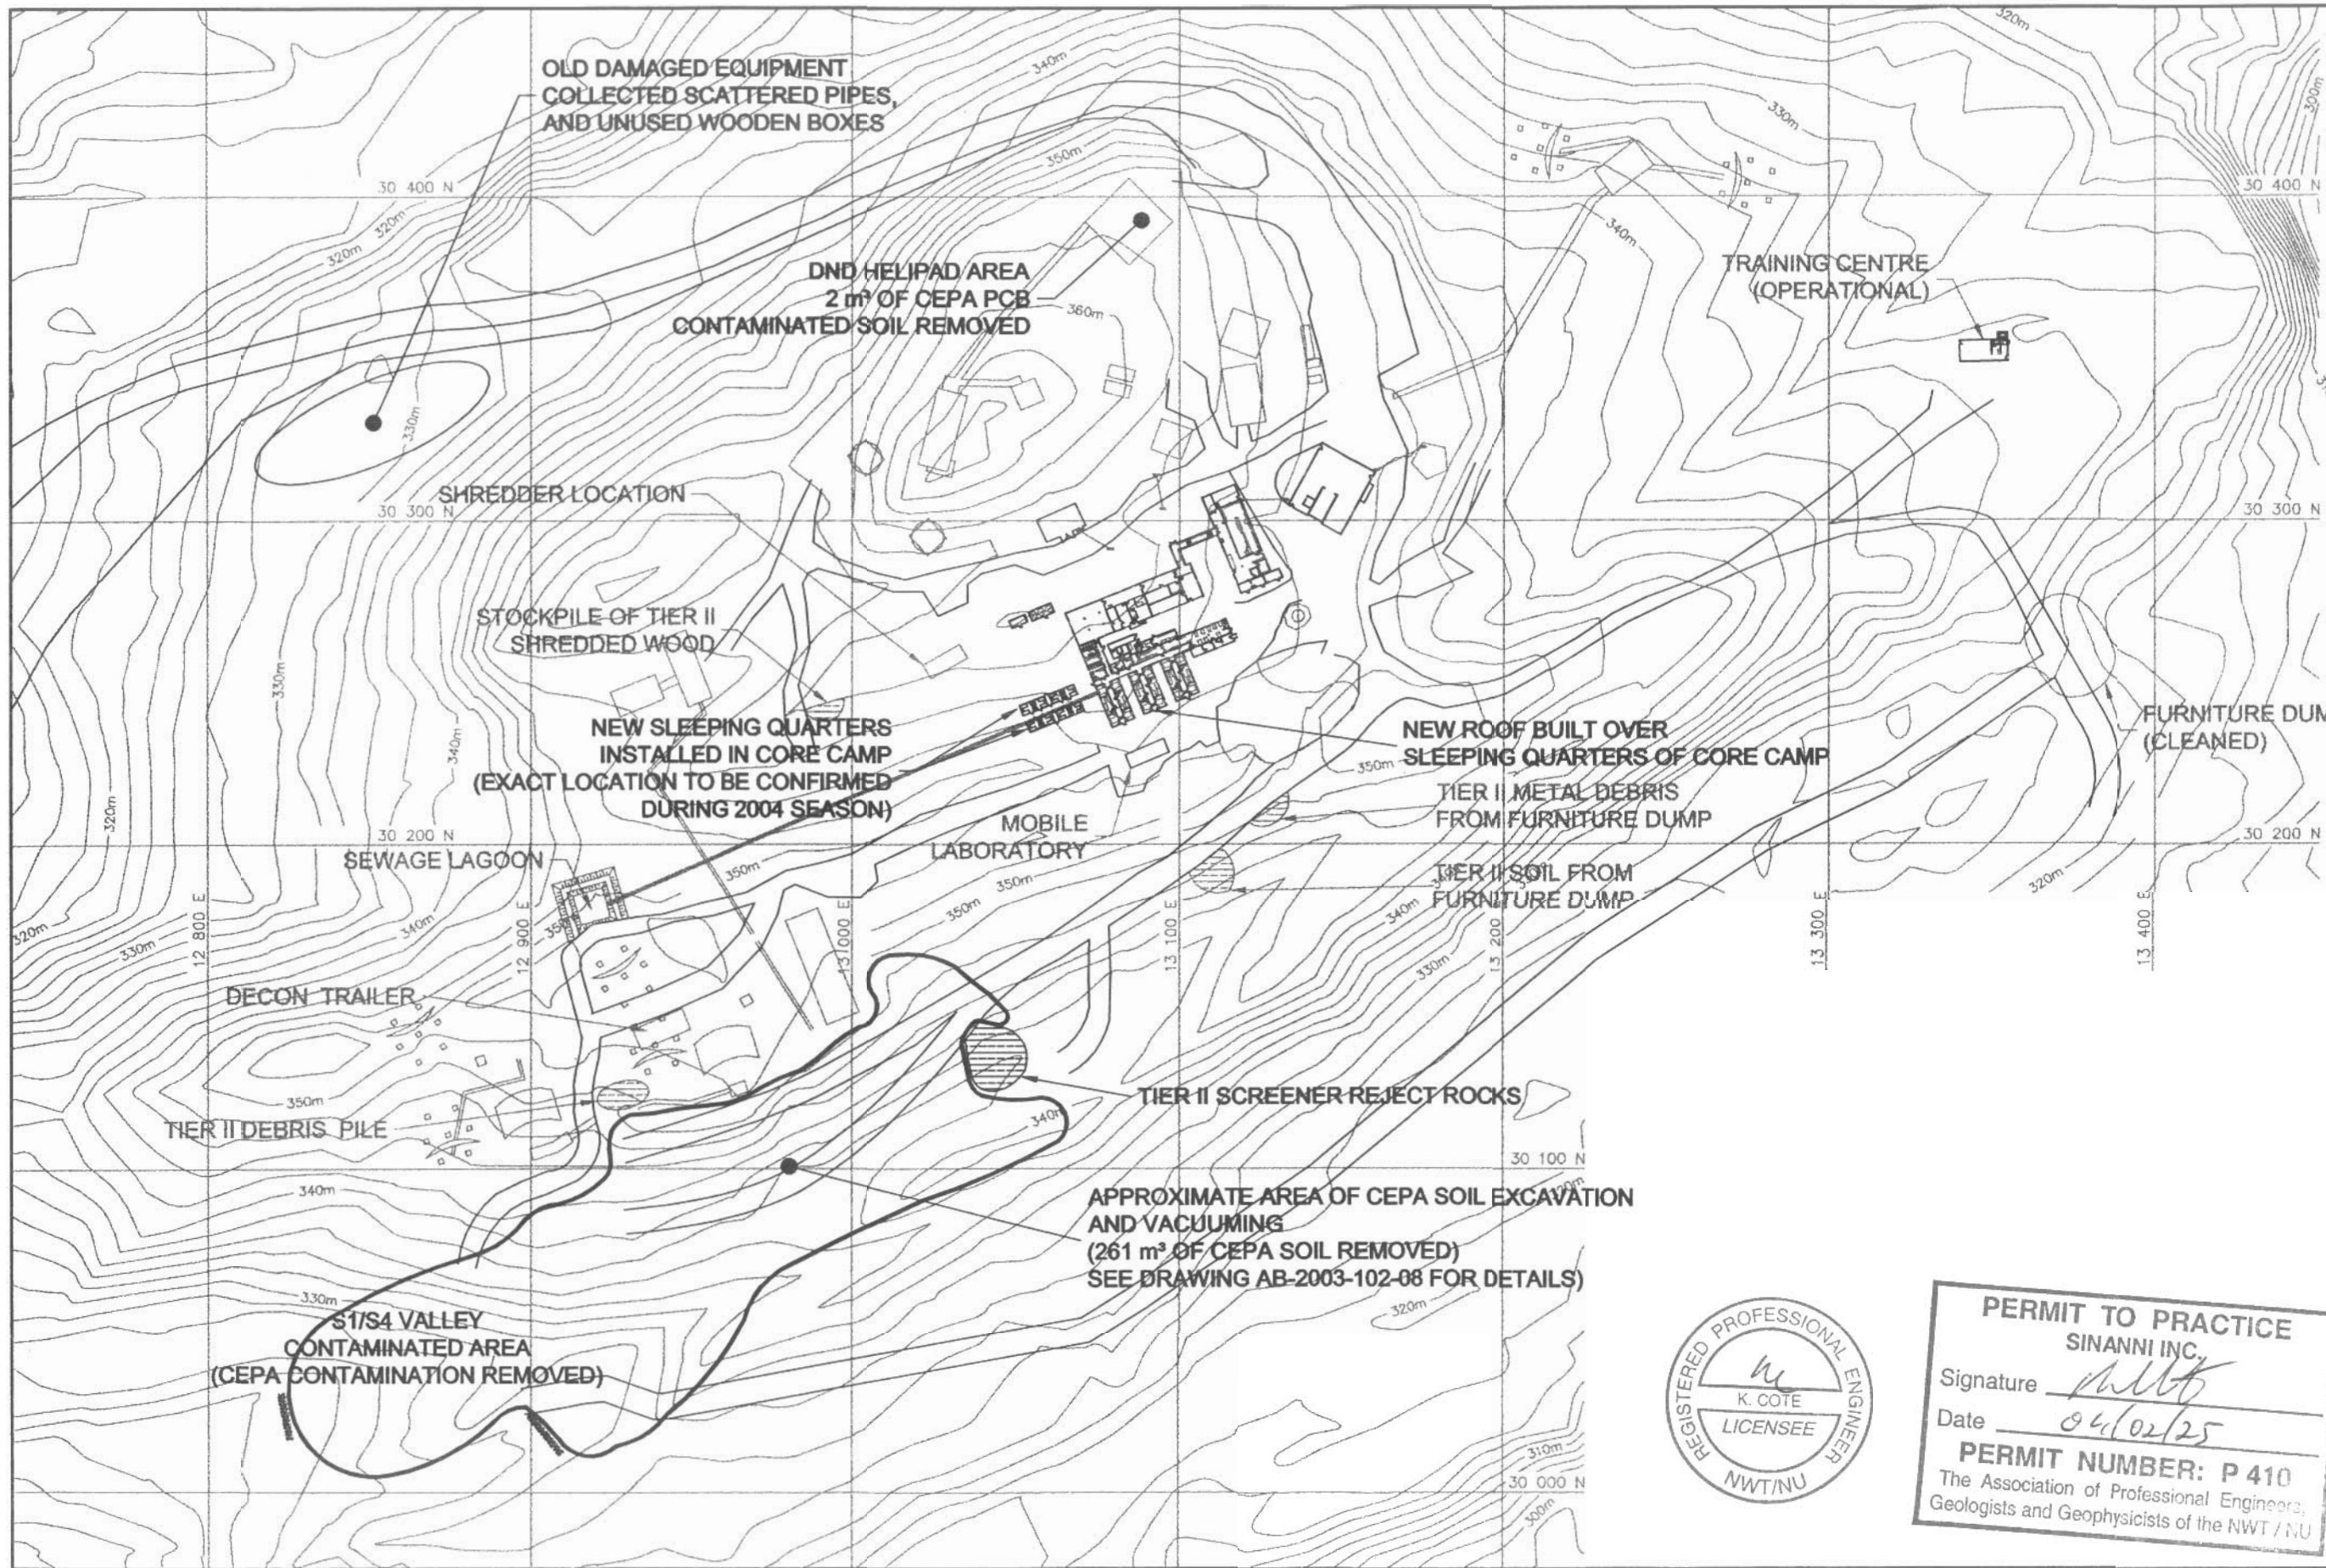

INDIAN AND NORTHERN AFFAIRS CANADA

NUNAVUT REGIONAL OFFICE

GENERAL NOTES:

1. NEW ROAD LOCATIONS ARE APPROXIMATE AND NOT SURVEYED.
2. REFER TO DRAWING AB-2003-102-08 FOR DETAILS ON CONTAMINATED SOIL REMOVAL FROM THE S1/S4 VALLEY AREA.


LEGEND:

— BURIED ELECTRICAL LINE

NO.	DATE	REVISION	REVISION	APPR.
<p>SINANNI INC.</p>				
SCALE - ÉCHELLE 1:500				
PROJECT - PROJET BAF-5 RESOLUTION ISLAND				
© COPYRIGHT HER MAJESTY THE QUEEN IN THE RIGHT OF CANADA 2004, AS REPRESENTED BY INDIAN AND NORTHERN AFFAIRS CANADA				
TRACÉ - MÉTRER	SITING	DATE 2004-01-30		
SUBJECT - SUJET GENERAL LAYOUT OF, AND MODIFICATIONS MADE TO, THE UPPER SITE				
PRODUCTION	CONCURRENCE - ASSENTIMENT			
DESIGNED ÉTUDE	G.J.			
DRAWN DRESSAGE	G.J.			
CHECKED VÉRIFIÉ	K.C.			
COORDINATION	REVISED - RÉVISÉ P.S.			
DWG. NO. - Dessin No. AB-2003-102-03				



**PERMIT TO PRACTICE**  
**SINANNI INC.**  
Signature [Signature]  
Date 04/02/25  
**PERMIT NUMBER: P 410**  
The Association of Professional Engineers,  
Geologists and Geophysicists of the NWT / NU

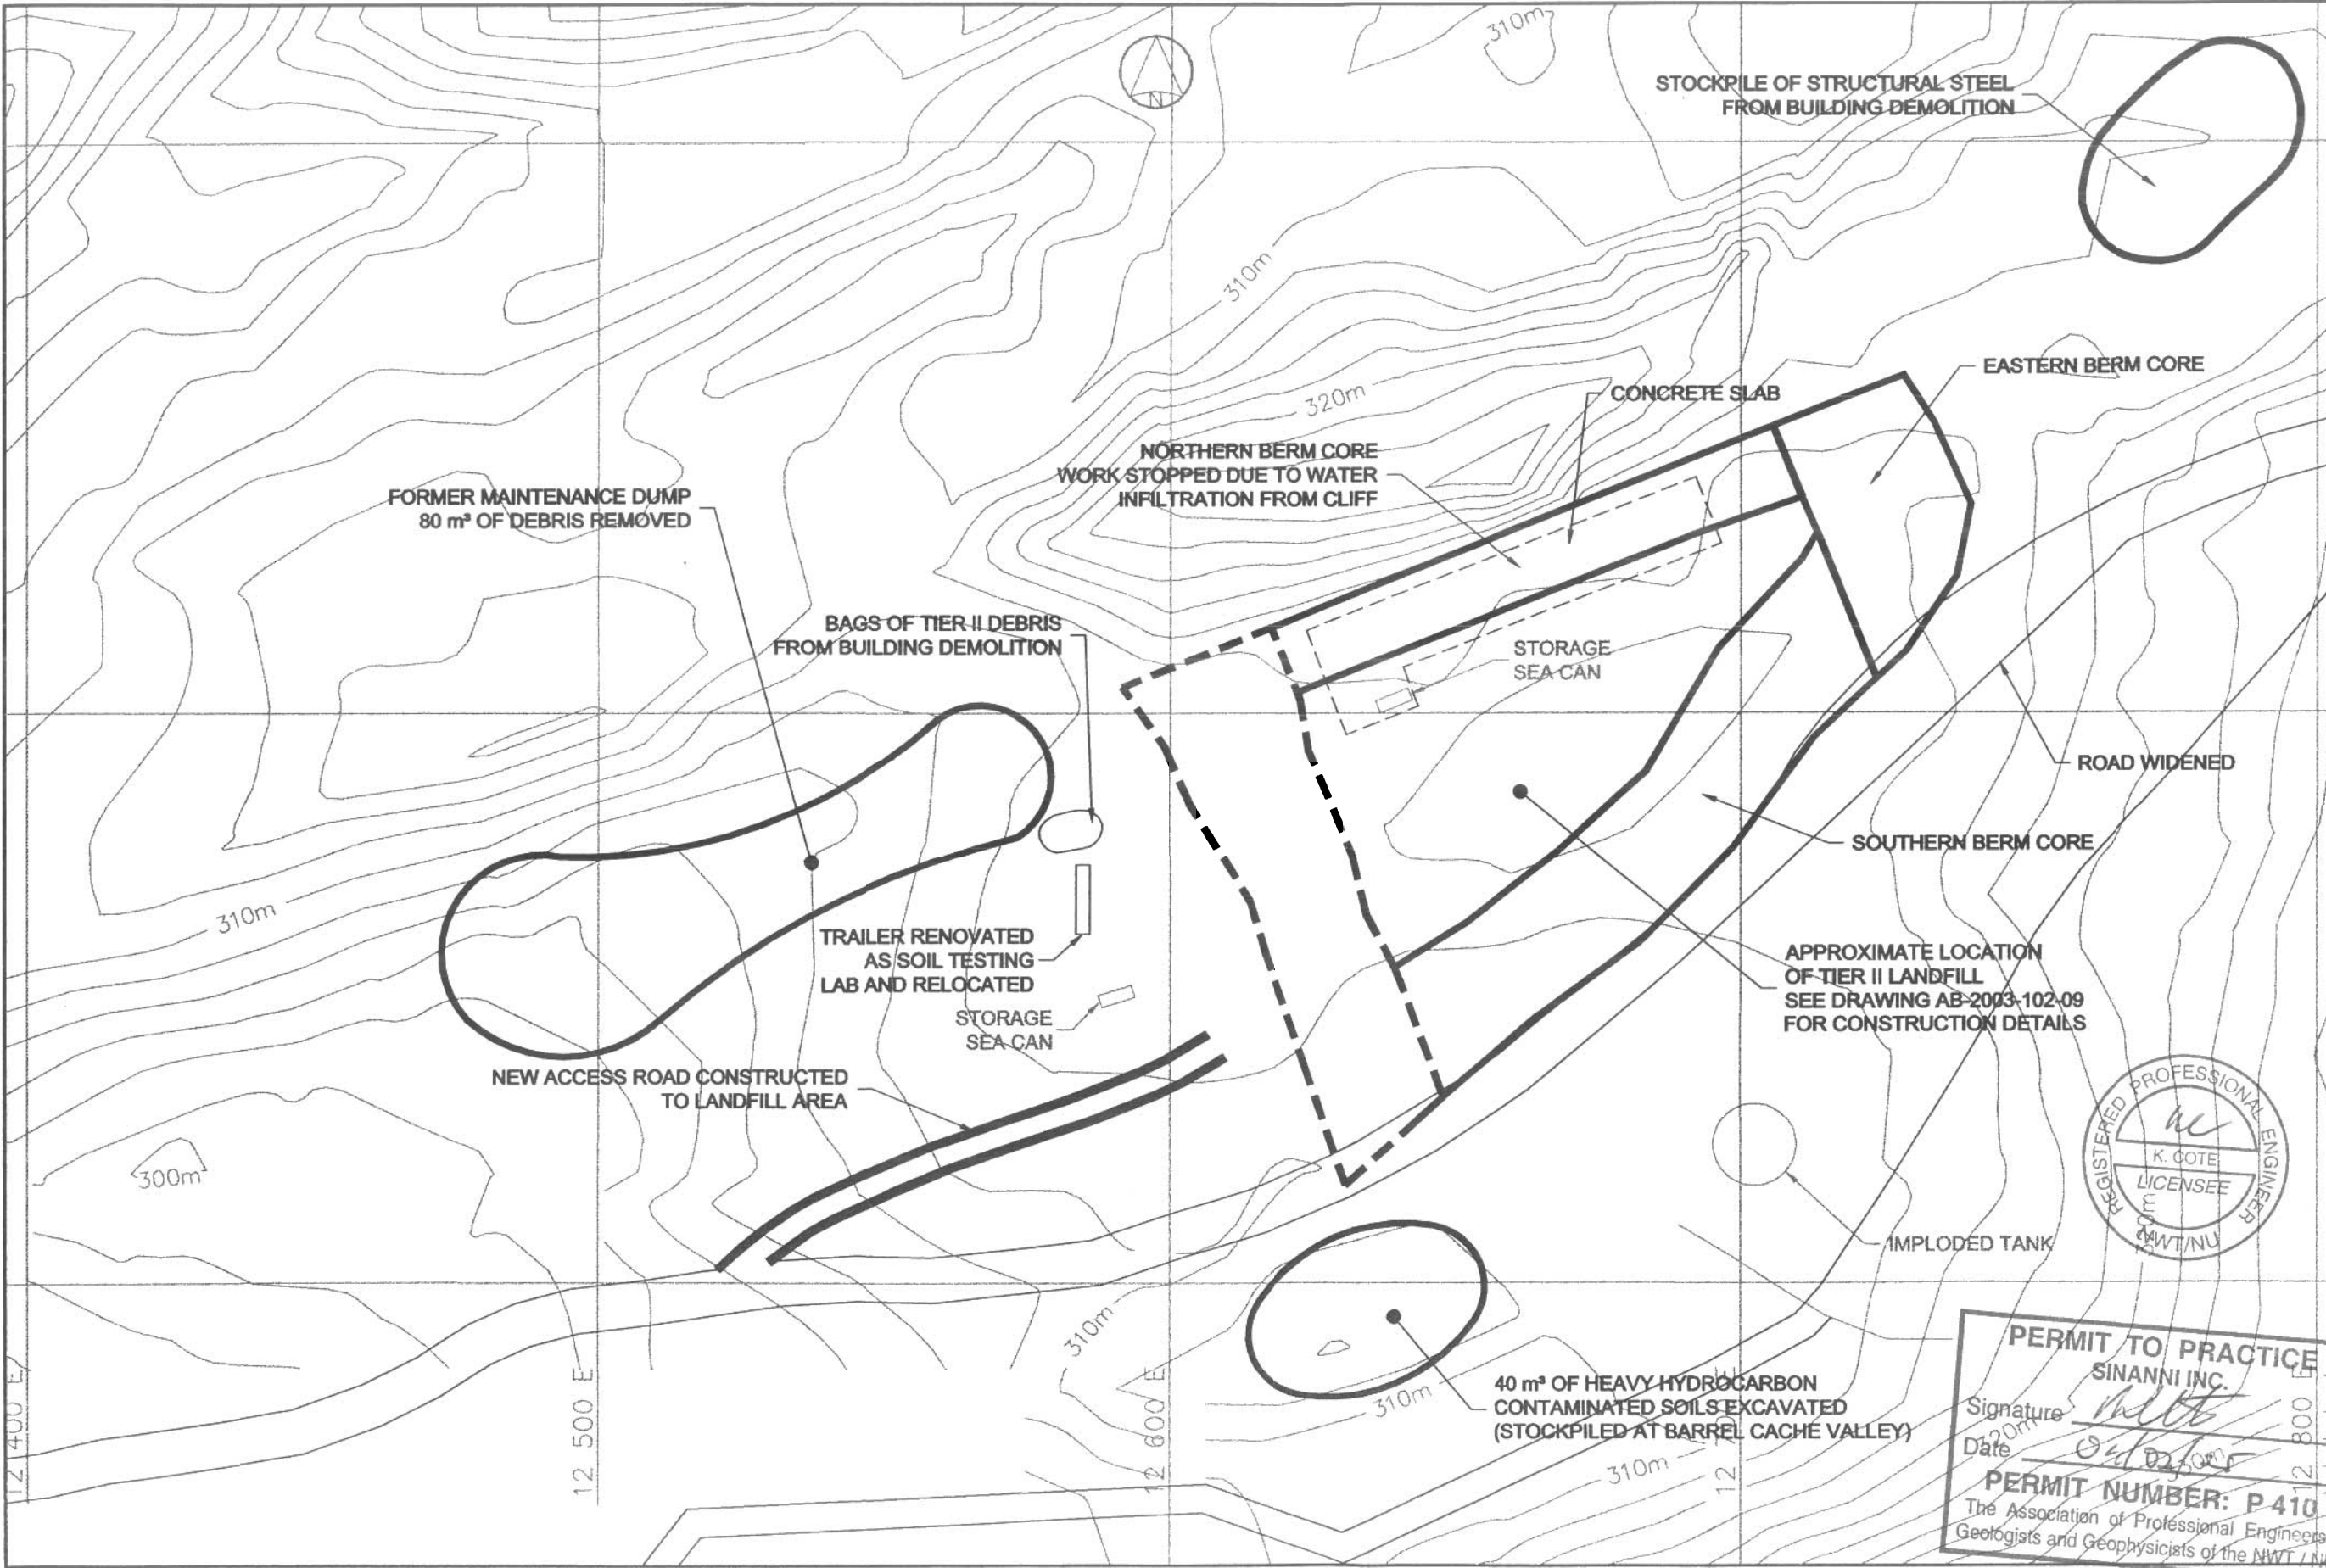

**INDIAN AND NORTHERN AFFAIRS CANADA**

**NUNAVUT REGIONAL OFFICE**

General Notes:

-

Legend:

No.	DATE	REVISION	REVISION	APPR.

**Sinanni Inc.**

SCALE - ÉCHELLE

PROJECT - PROJET

**BAF-5 RESOLUTION ISLAND**

© COPYRIGHT HER MAJESTY THE QUEEN IN THE RIGHT OF CANADA 2004, AS REPRESENTED BY INDIAN AND NORTHERN AFFAIRS CANADA

TRADE - MÉTIER	SITING	DATE
		2004-01-30

SUBJECT - SUJET

GENERAL LAYOUT OF, AND MODIFICATIONS MADE TO, THE TIER II LANDFILL AND SURROUNDING AREA

PRODUCTION	CONCURRENCE - ASSÉNTIMENT
DRAWN	G.J.
SPAWN	G.J.
CHECKED	K.C.
COORDINATION	REVIEWED - REVU
	P.S.

DWG. NO. - DESIG. NO.

AB-2003-102-04

**Canada**

**PERMIT TO PRACTICE**

**SINANNI INC.**


Signature: *[Signature]*

Date: *04/02/05*

**PERMIT NUMBER: P 410**

The Association of Professional Engineers, Geologists and Geophysicists of the NWT / NWT



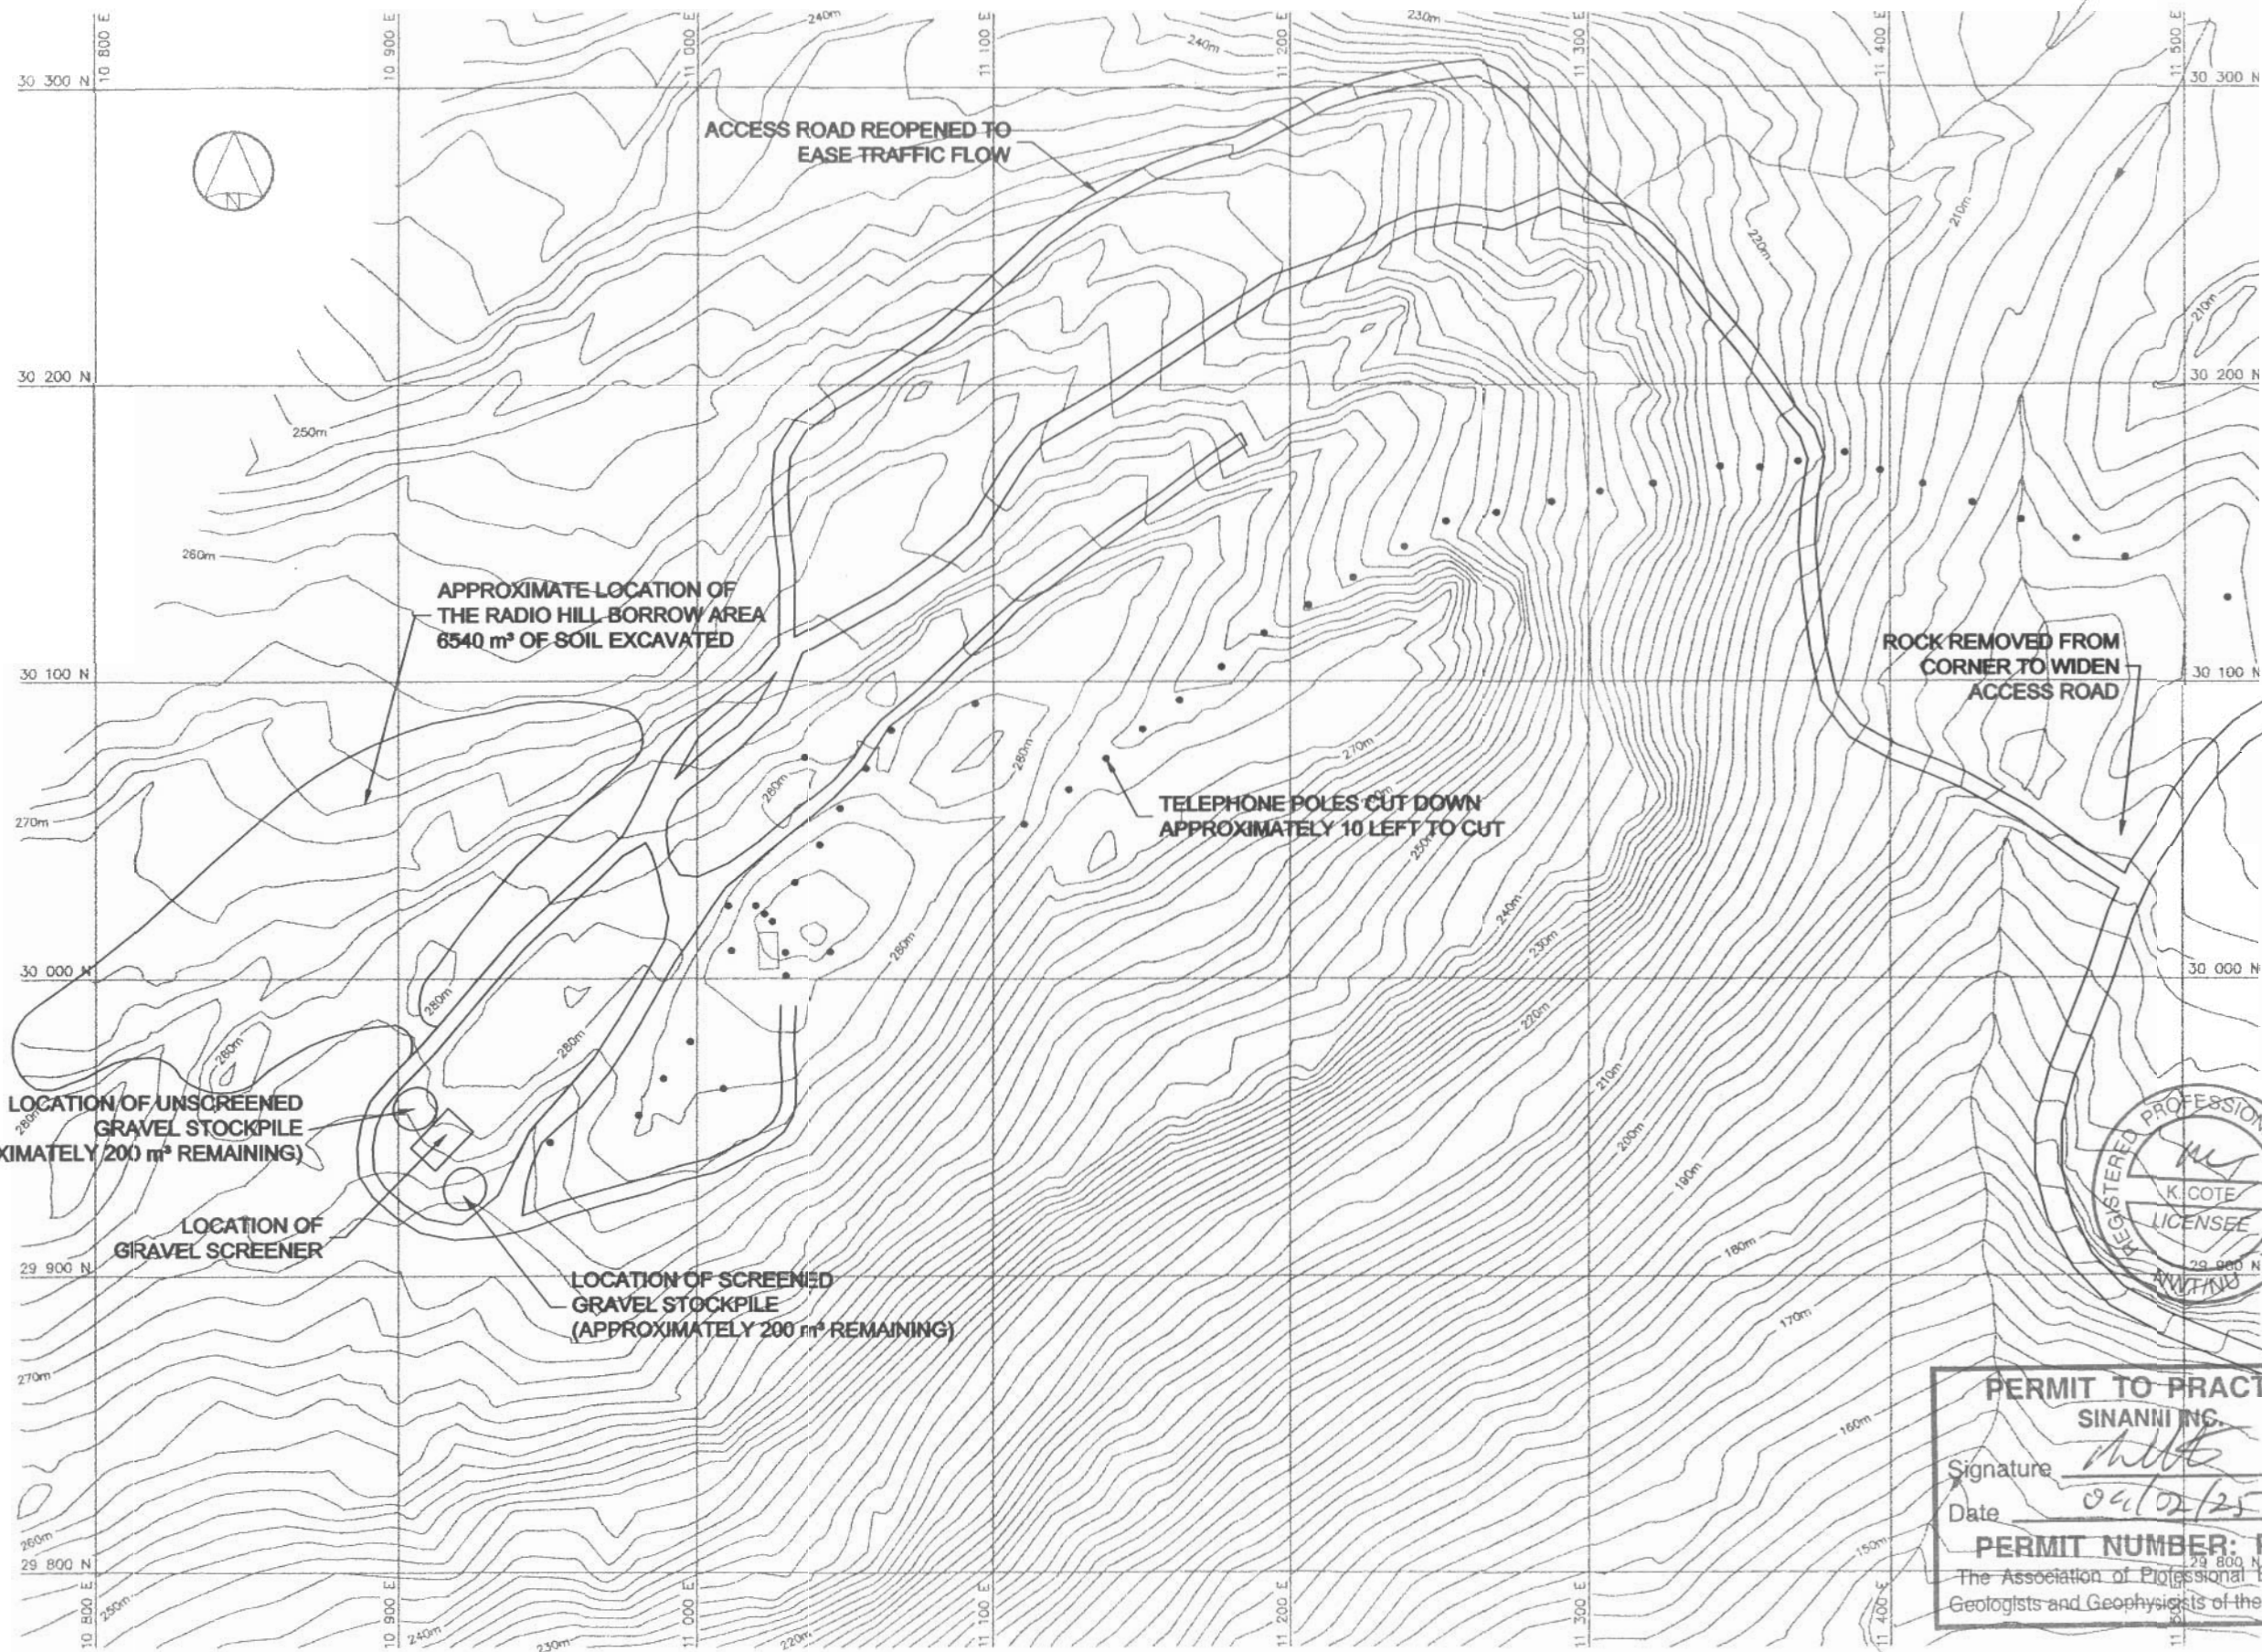

NUNAVUT REGIONAL OFFICE

General Notes:  
1.

Legend:

NO.	DATE	REVISION	REVISION	APPR.
-----	------	----------	----------	-------



SCALE - ÉCHELLE 1:50,000

PROJECT - PROJET  
BAF-5 RESOLUTION ISLAND

© COPYRIGHT HER MAJESTY THE QUEEN  
IN THE RIGHT OF CANADA 2004,  
AS REPRESENTED BY INDIAN AND  
NORTHERN AFFAIRS CANADA

TRADE - MÉTIER  
SITING  
DATE  
2004-01-30

SUBJECT - SUJET

GENERAL LAYOUT OF THE RADIO HILL AREA

PRODUCTION	CONCURRENCE - ASSISEMENT
DESIGNED ETUDE	G.J.
DRAWN DESSINE	G.J.
CHECKED VERIFIE	K.C.
COORDINATION	REVIEWED - REVU P.S.


DWG. NO. - DESSIN NO.  
AS-2003-102-05

Canada



**PERMIT TO PRACTISE**  
**SINANNI INC.**  
Signature *[Signature]*  
Date *04/02/25*  
**PERMIT NUMBER: P 410**  
The Association of Professional Engineers,  
Geologists and Geophysicists of the NWT / NU



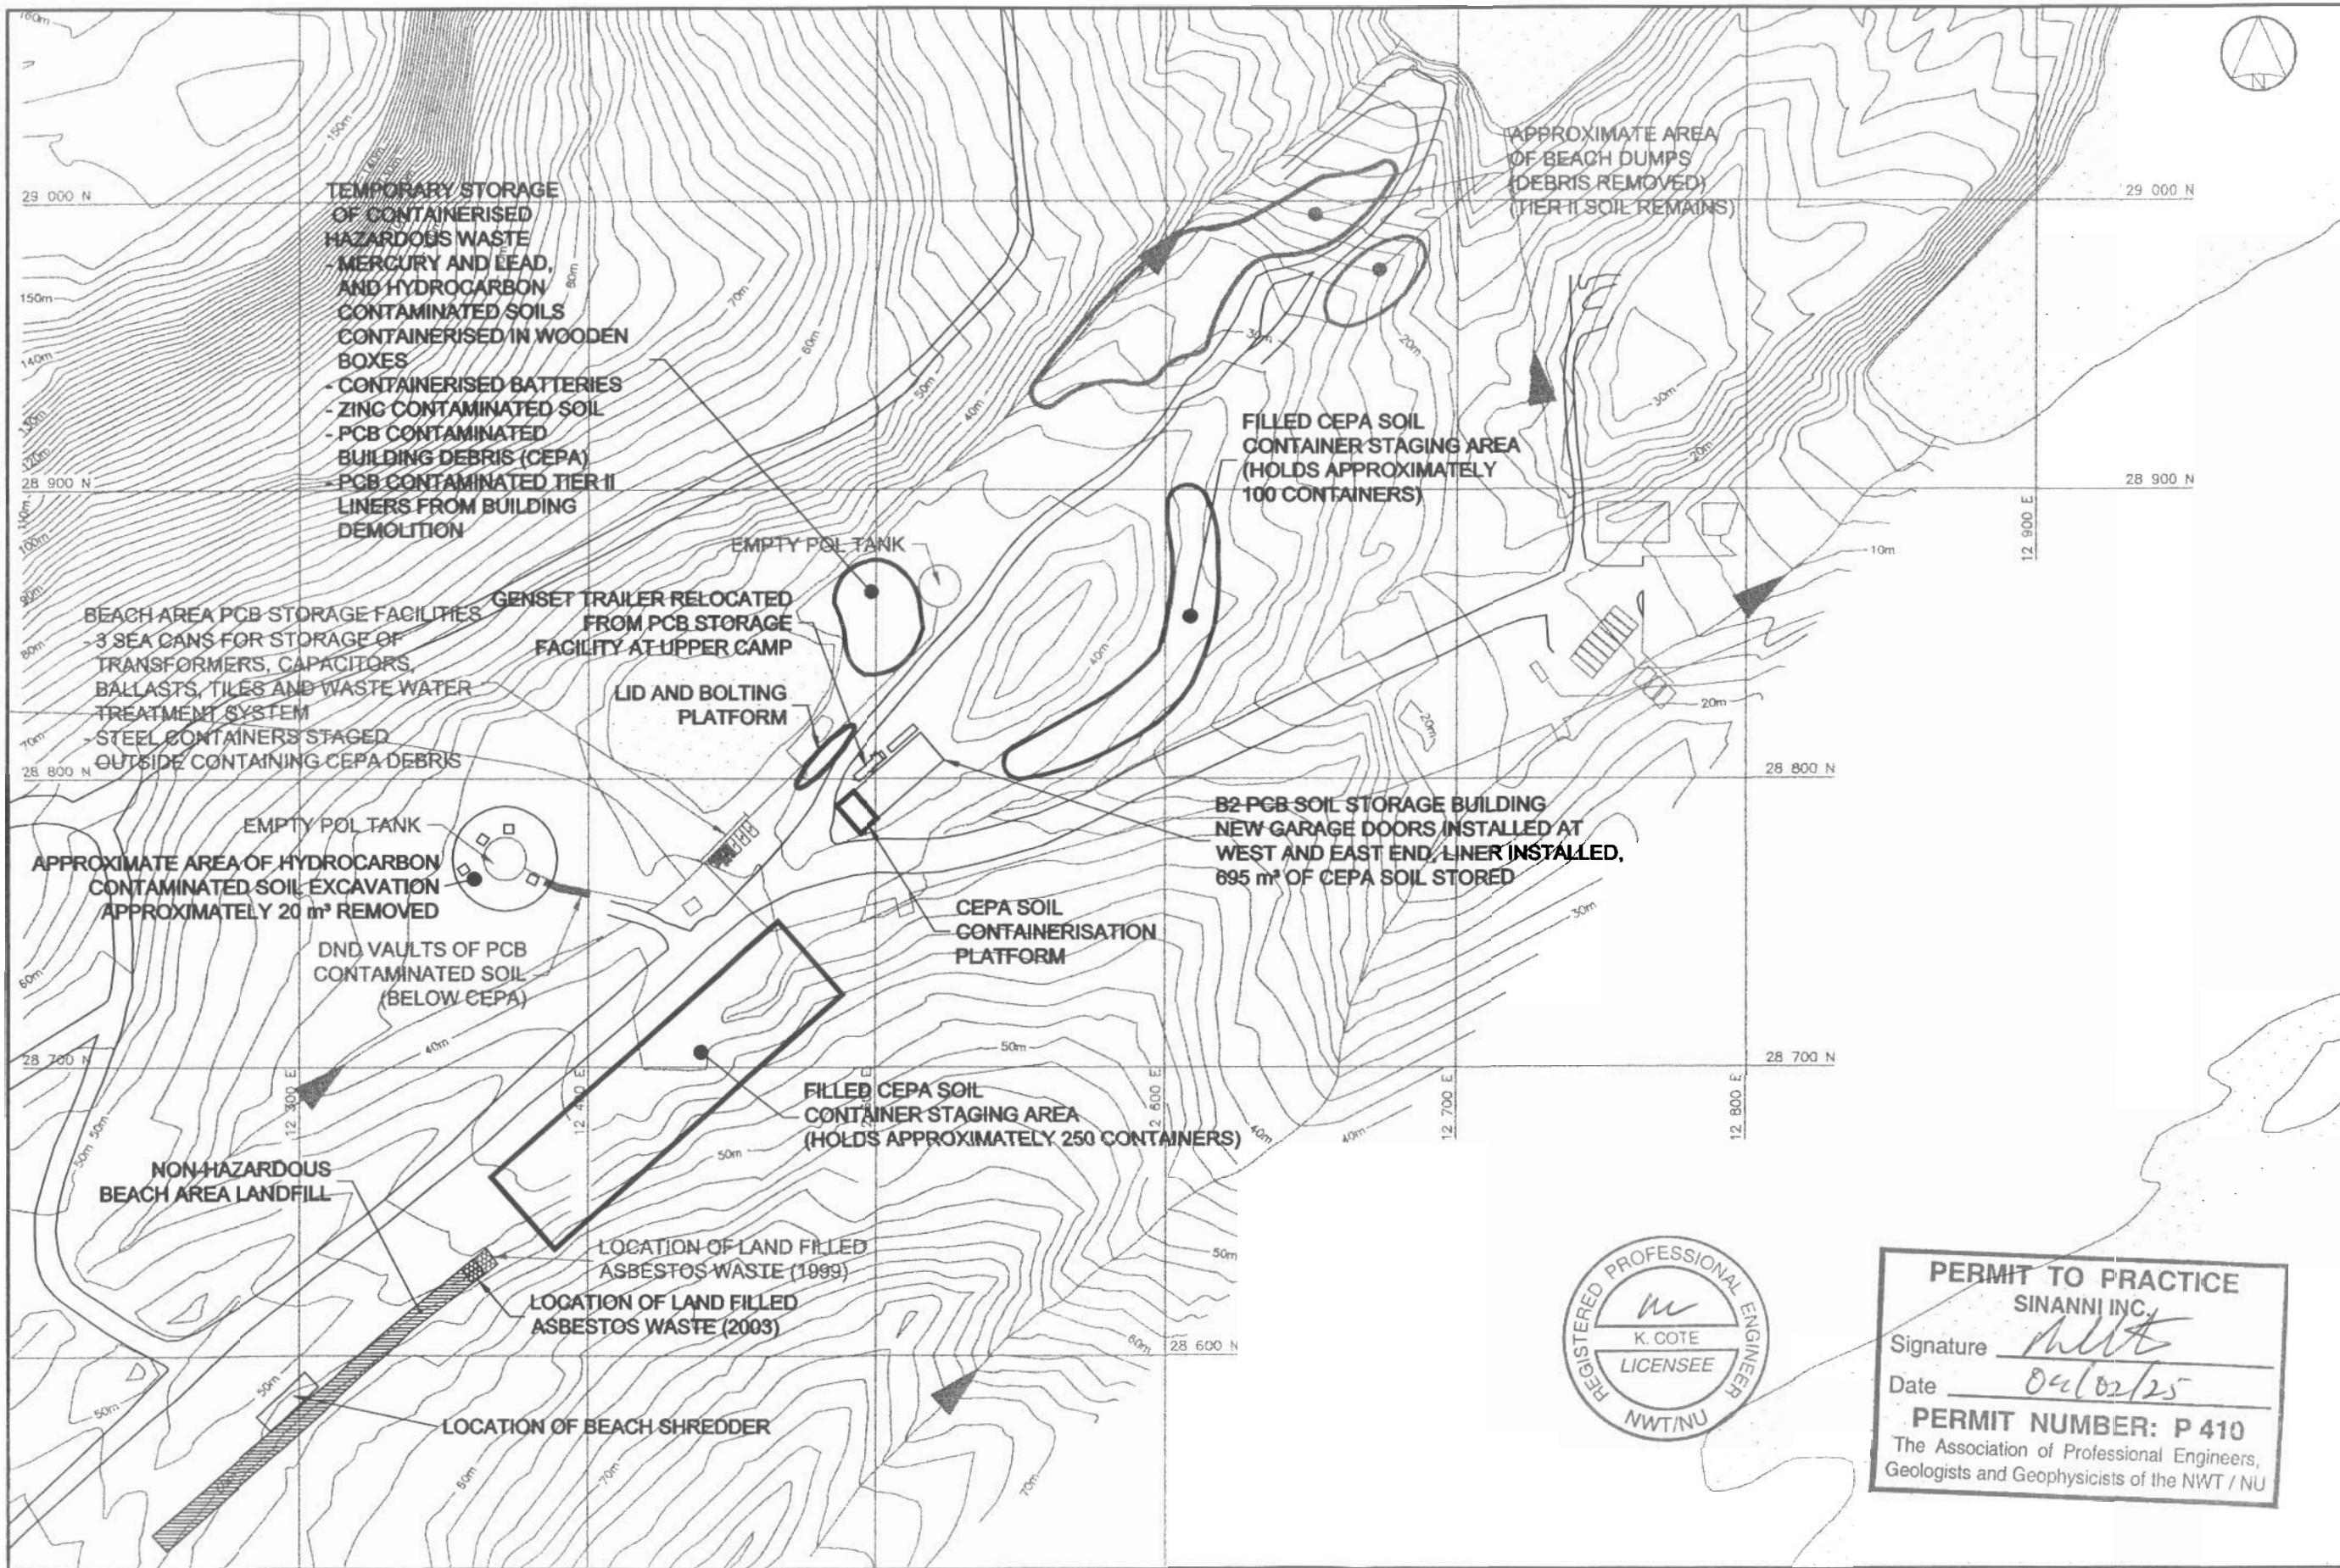

**INDIAN AND NORTHERN AFFAIRS CANADA**

**NUNAVUT REGIONAL OFFICE**


General Notes:

**Legend:**  
 NON-HAZARDOUS WASTE  
 ASBESTOS LANDFILL

NO.	DATE	REVISION	REVISION	APPR.										
 <b>Sinanni Inc.</b> SCALE - ÉCHELLE 1:10,000 PROJECT - PROJET <b>BAF-5 RESOLUTION ISLAND</b> © COPYRIGHT HER MAJESTY THE QUEEN IN THE RIGHT OF CANADA 2004, AS REPRESENTED BY INDIAN AND NORTHERN AFFAIRS CANADA TRADE - MÉTIER <b>SITING</b> DATE <b>2004-01-30</b> SUBJECT - SUJET GENERAL LAYOUT OF, AND MODIFICATIONS MADE TO, THE BEACH AREA <table border="1"><thead><tr><th>PRODUCTION</th><th>CONCURRENCE - ASSENTMENT</th></tr></thead><tbody><tr><td>DESIGNED ETUDE</td><td>G.J.</td></tr><tr><td>DRAWN DESSINE</td><td>G.J.</td></tr><tr><td>CHECKED VÉRIFIÉ</td><td>K.C.</td></tr><tr><td>COORDINATION</td><td>REVIEWED - REVU P.S.</td></tr></tbody></table> <div>DWG. NO. - DESSIN NO. <b>AB-2003-102-05</b> </div>					PRODUCTION	CONCURRENCE - ASSENTMENT	DESIGNED ETUDE	G.J.	DRAWN DESSINE	G.J.	CHECKED VÉRIFIÉ	K.C.	COORDINATION	REVIEWED - REVU P.S.
PRODUCTION	CONCURRENCE - ASSENTMENT													
DESIGNED ETUDE	G.J.													
DRAWN DESSINE	G.J.													
CHECKED VÉRIFIÉ	K.C.													
COORDINATION	REVIEWED - REVU P.S.													



**PERMIT TO PRACTICE**  
**SINANNI INC.**  
Signature *[Signature]*  
Date *04/02/25*  
**PERMIT NUMBER: P 410**  
The Association of Professional Engineers,  
Geologists and Geophysicists of the NWT / NU

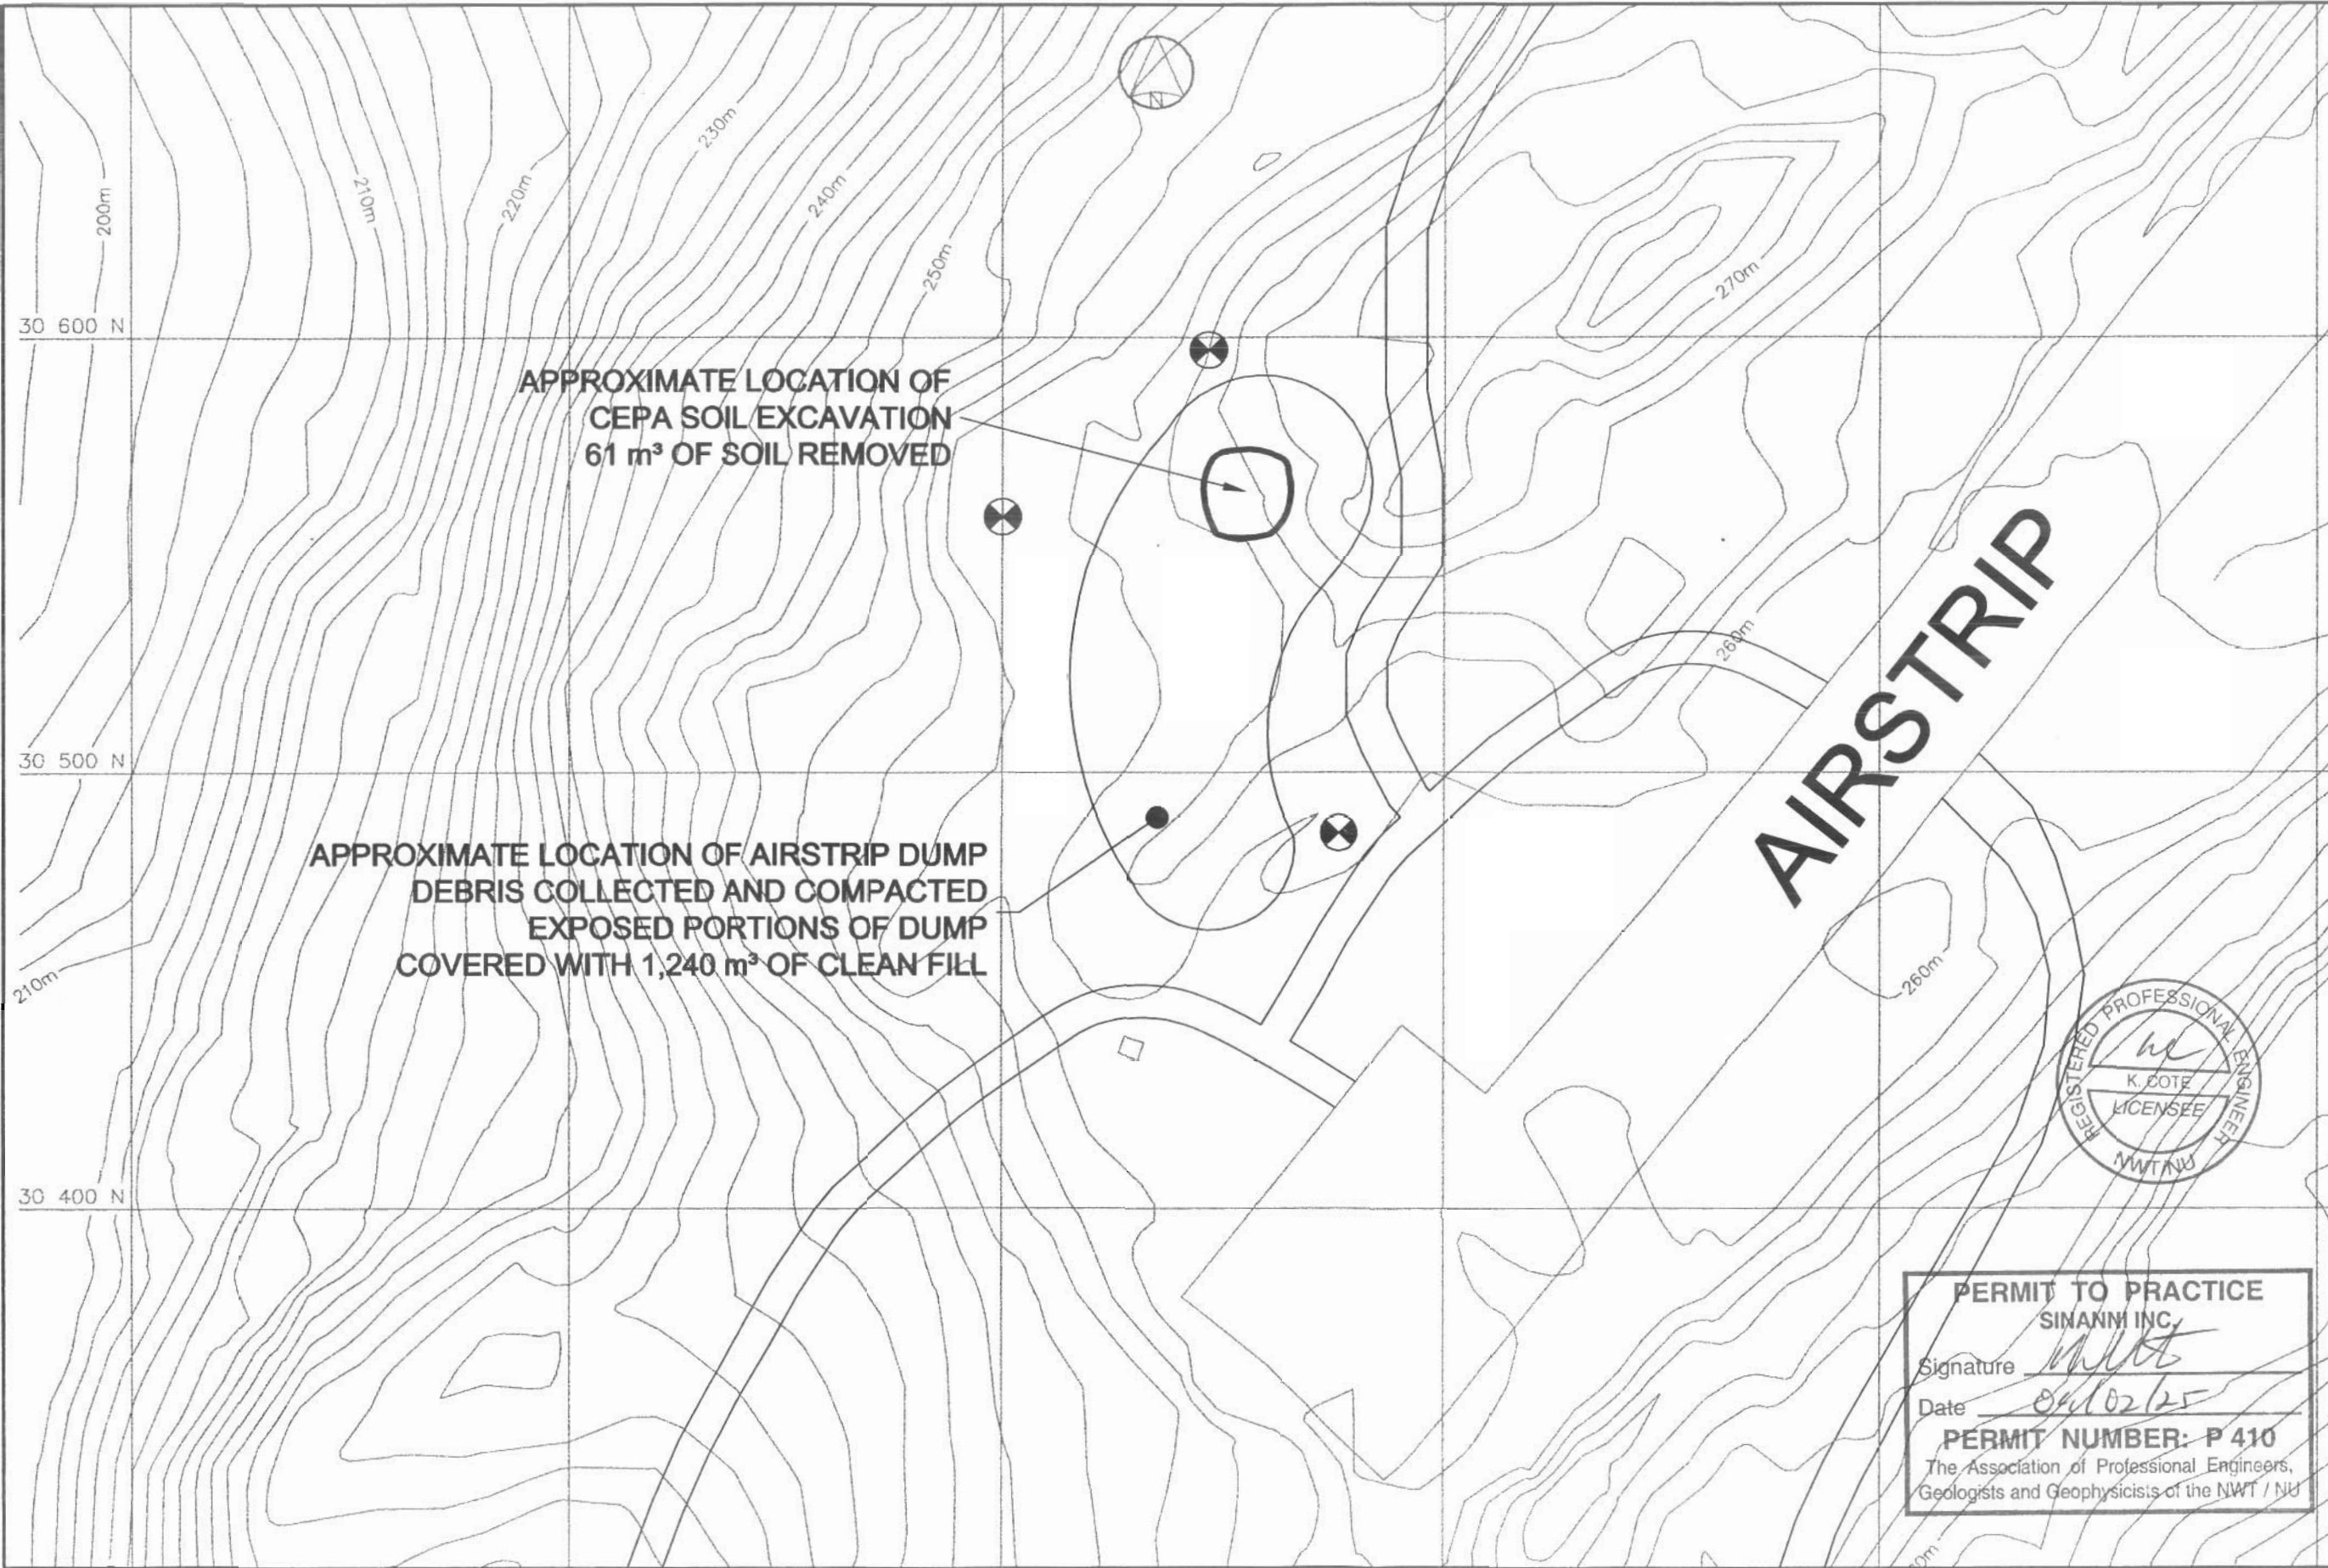

General Notes:  
1.

Legend:  
 APPROXIMATE LOCATION OF  
MONITORING WELLS INSTALLED DURING  
THE 2003 SEASON

NO.	DATE	REVISION	REVISION	APPL.
-----	------	----------	----------	-------



SCALE - ÉCHELLE

PROJECT - PROJET  
BAF-5 RESOLUTION ISLAND

© COPYRIGHT HER MAJESTY THE QUEEN  
IN THE RIGHT OF CANADA 2004,  
AS REPRESENTED BY INDIAN AND  
NORTHERN AFFAIRS CANADA

TRADE - MÉTIER  
SITING  
DATE  
2004-01-30


SUBJECT - SUJET

GENERAL LAYOUT OF, AND MODIFICATIONS MADE  
TO, THE AIR STRIP DUMP

PRODUCTION	CONCURRENCE - ASSENTMENT
DESIGNED ÉTUDE	G.J.
DRAWN DÉSSINÉ	G.J.
CHECKED VÉRIFIÉ	K.C.
COORDINATION	REVIEWED - REVU P.S.

DWG. NO. - DÉSSIN NO.  
AB-2003-102-07

Canada

PERMIT TO PRACTICE  
SINANNI INC.  
Signature   
Date 04/02/25  
PERMIT NUMBER: P 410  
The Association of Professional Engineers,  
Geologists and Geophysicists of the NWT / NU