





A map of the Canadian Arctic region, specifically the area around the Northwest Territories. The map shows the coastline of the Arctic Ocean and the surrounding landmasses. Key locations are labeled: Grise Fiord, Resolute Bay, Pond Inlet, Arctic Bay, Clyde River, Igloolik, Hall Beach, Cape Dorset, Sanikiluaq, and Pangnirtung. A circle is drawn around Pangnirtung, and an inset map shows a closer view of the area around Pangnirtung, highlighting the locations of Iqaluit and Kimmirut. The map is oriented with North at the top.



2004 ⁹C>P⁹C 00⁹C⁹C

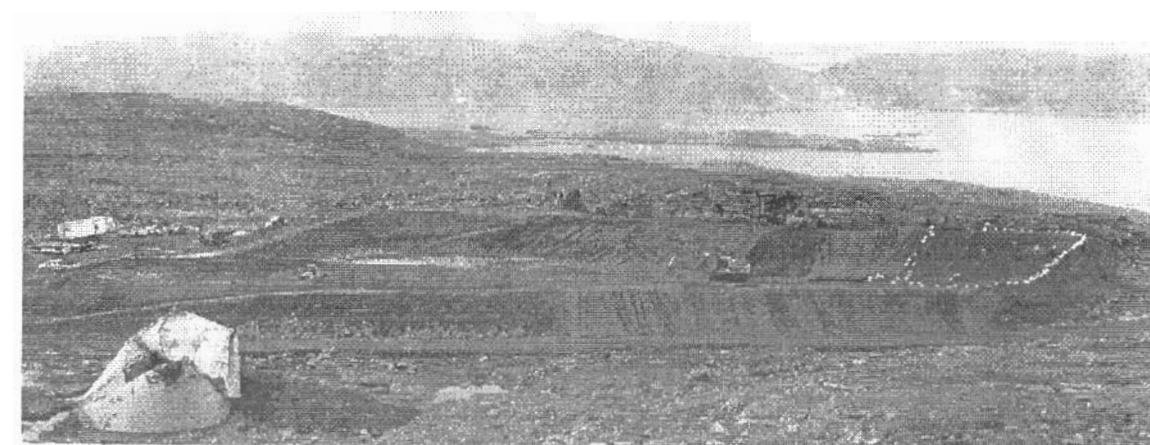

JANUARY 2005

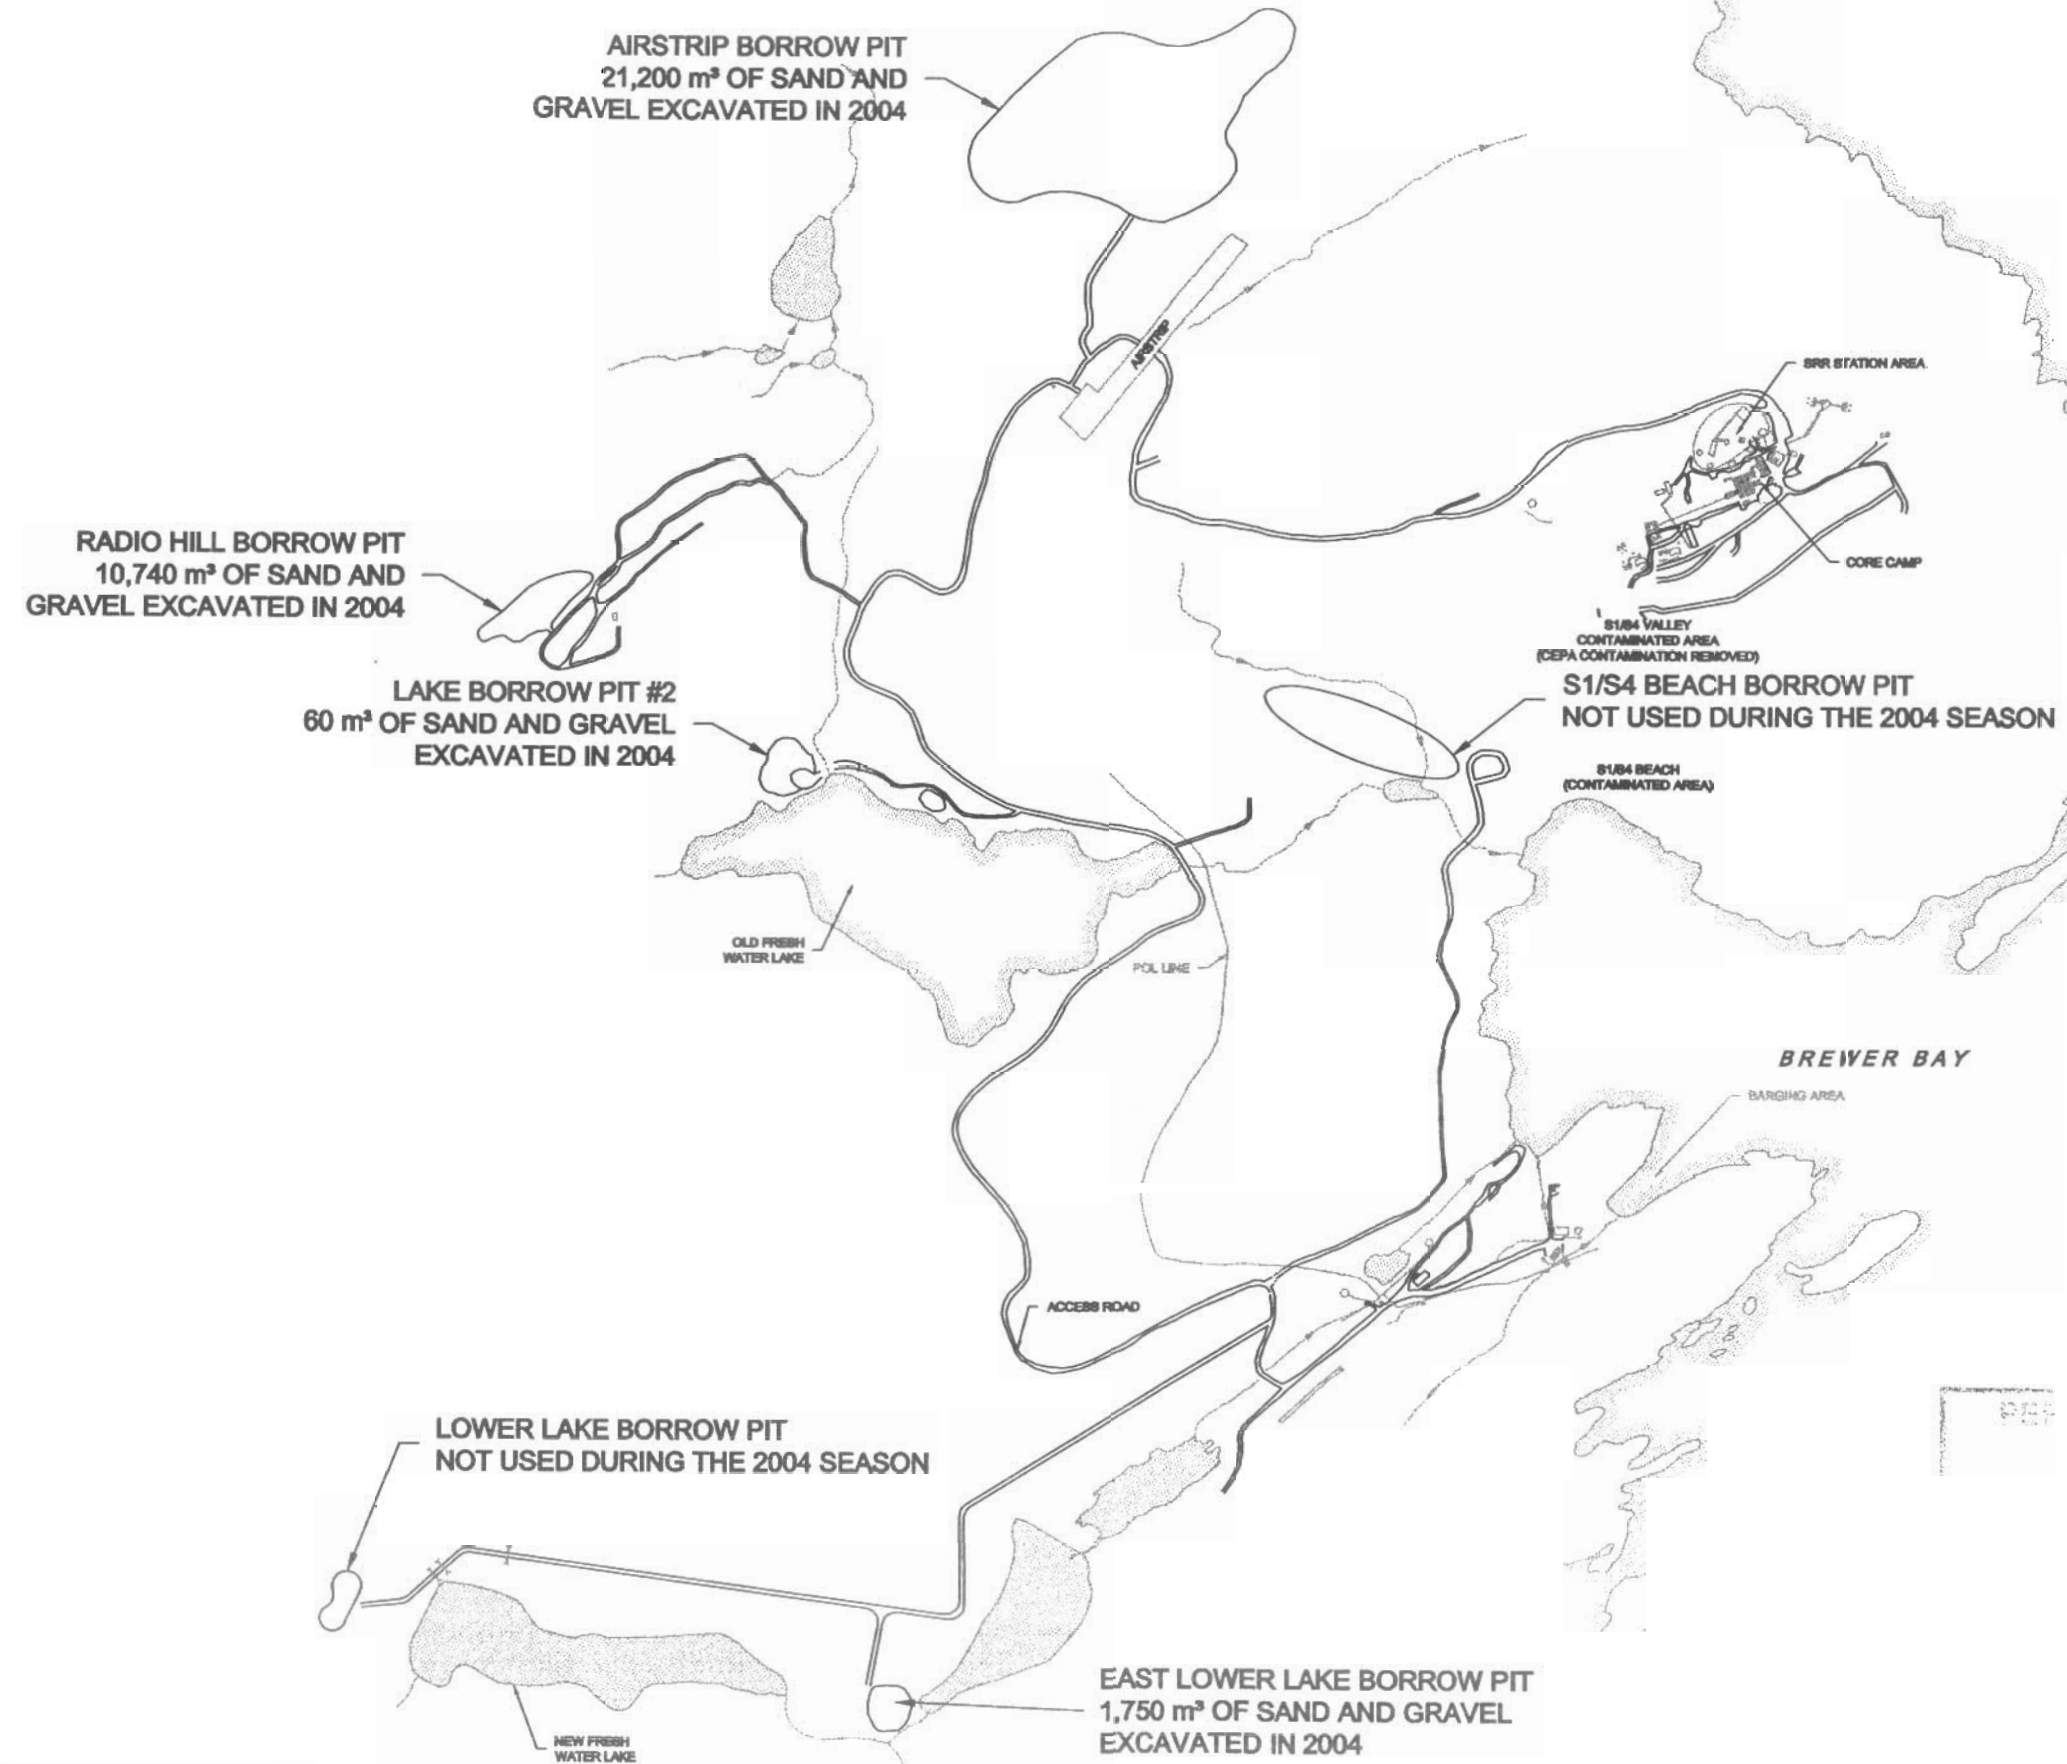

REGISTERED PROFESSIONAL ENGINEER
K. COTE
LICENSEE
NWT/NU

TO PRACTICE
05/01/13

**INDIAN AND NORTHERN AFFAIRS CANADA**

NUNAVUT REGIONAL OFFICE

GENERAL NOTES:
1. LOCATIONS OF BORROW AREAS ARE APPROXIMATE AND NOT SURVEYED.

LEGEND:

NO.	DATE	REVISION	REVISION	APPROV.

**Sinanni Inc.**
SCALE - SCHALE 0 50 100 200 300 M

PROJECT - PROJET
BAF-5 RESOLUTION ISLAND


© COPYRIGHT HER MAJESTY THE QUEEN IN THE RIGHT OF CANADA 2004, AS REPRESENTED BY INDIAN AND NORTHERN AFFAIRS CANADA



TRACÉ - MÉTRER	SITING	DATE
		2004-12-16

SUBJECT - SUJET
LOCATION OF BORROW PIT'S USED DURING THE 2004 SEASON

PRODUCTION	CONCURRENCE - AGREEMENT
DRAWN	G.J.
CHECKED	G.J.
COORDINATION	K.C.
	REVIEWED - REVU P.S.

DRAW. NO. - DESIGN NO.
AB-2004-102-01

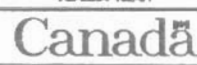

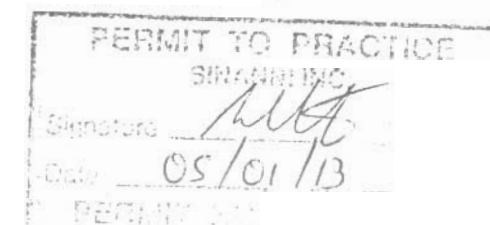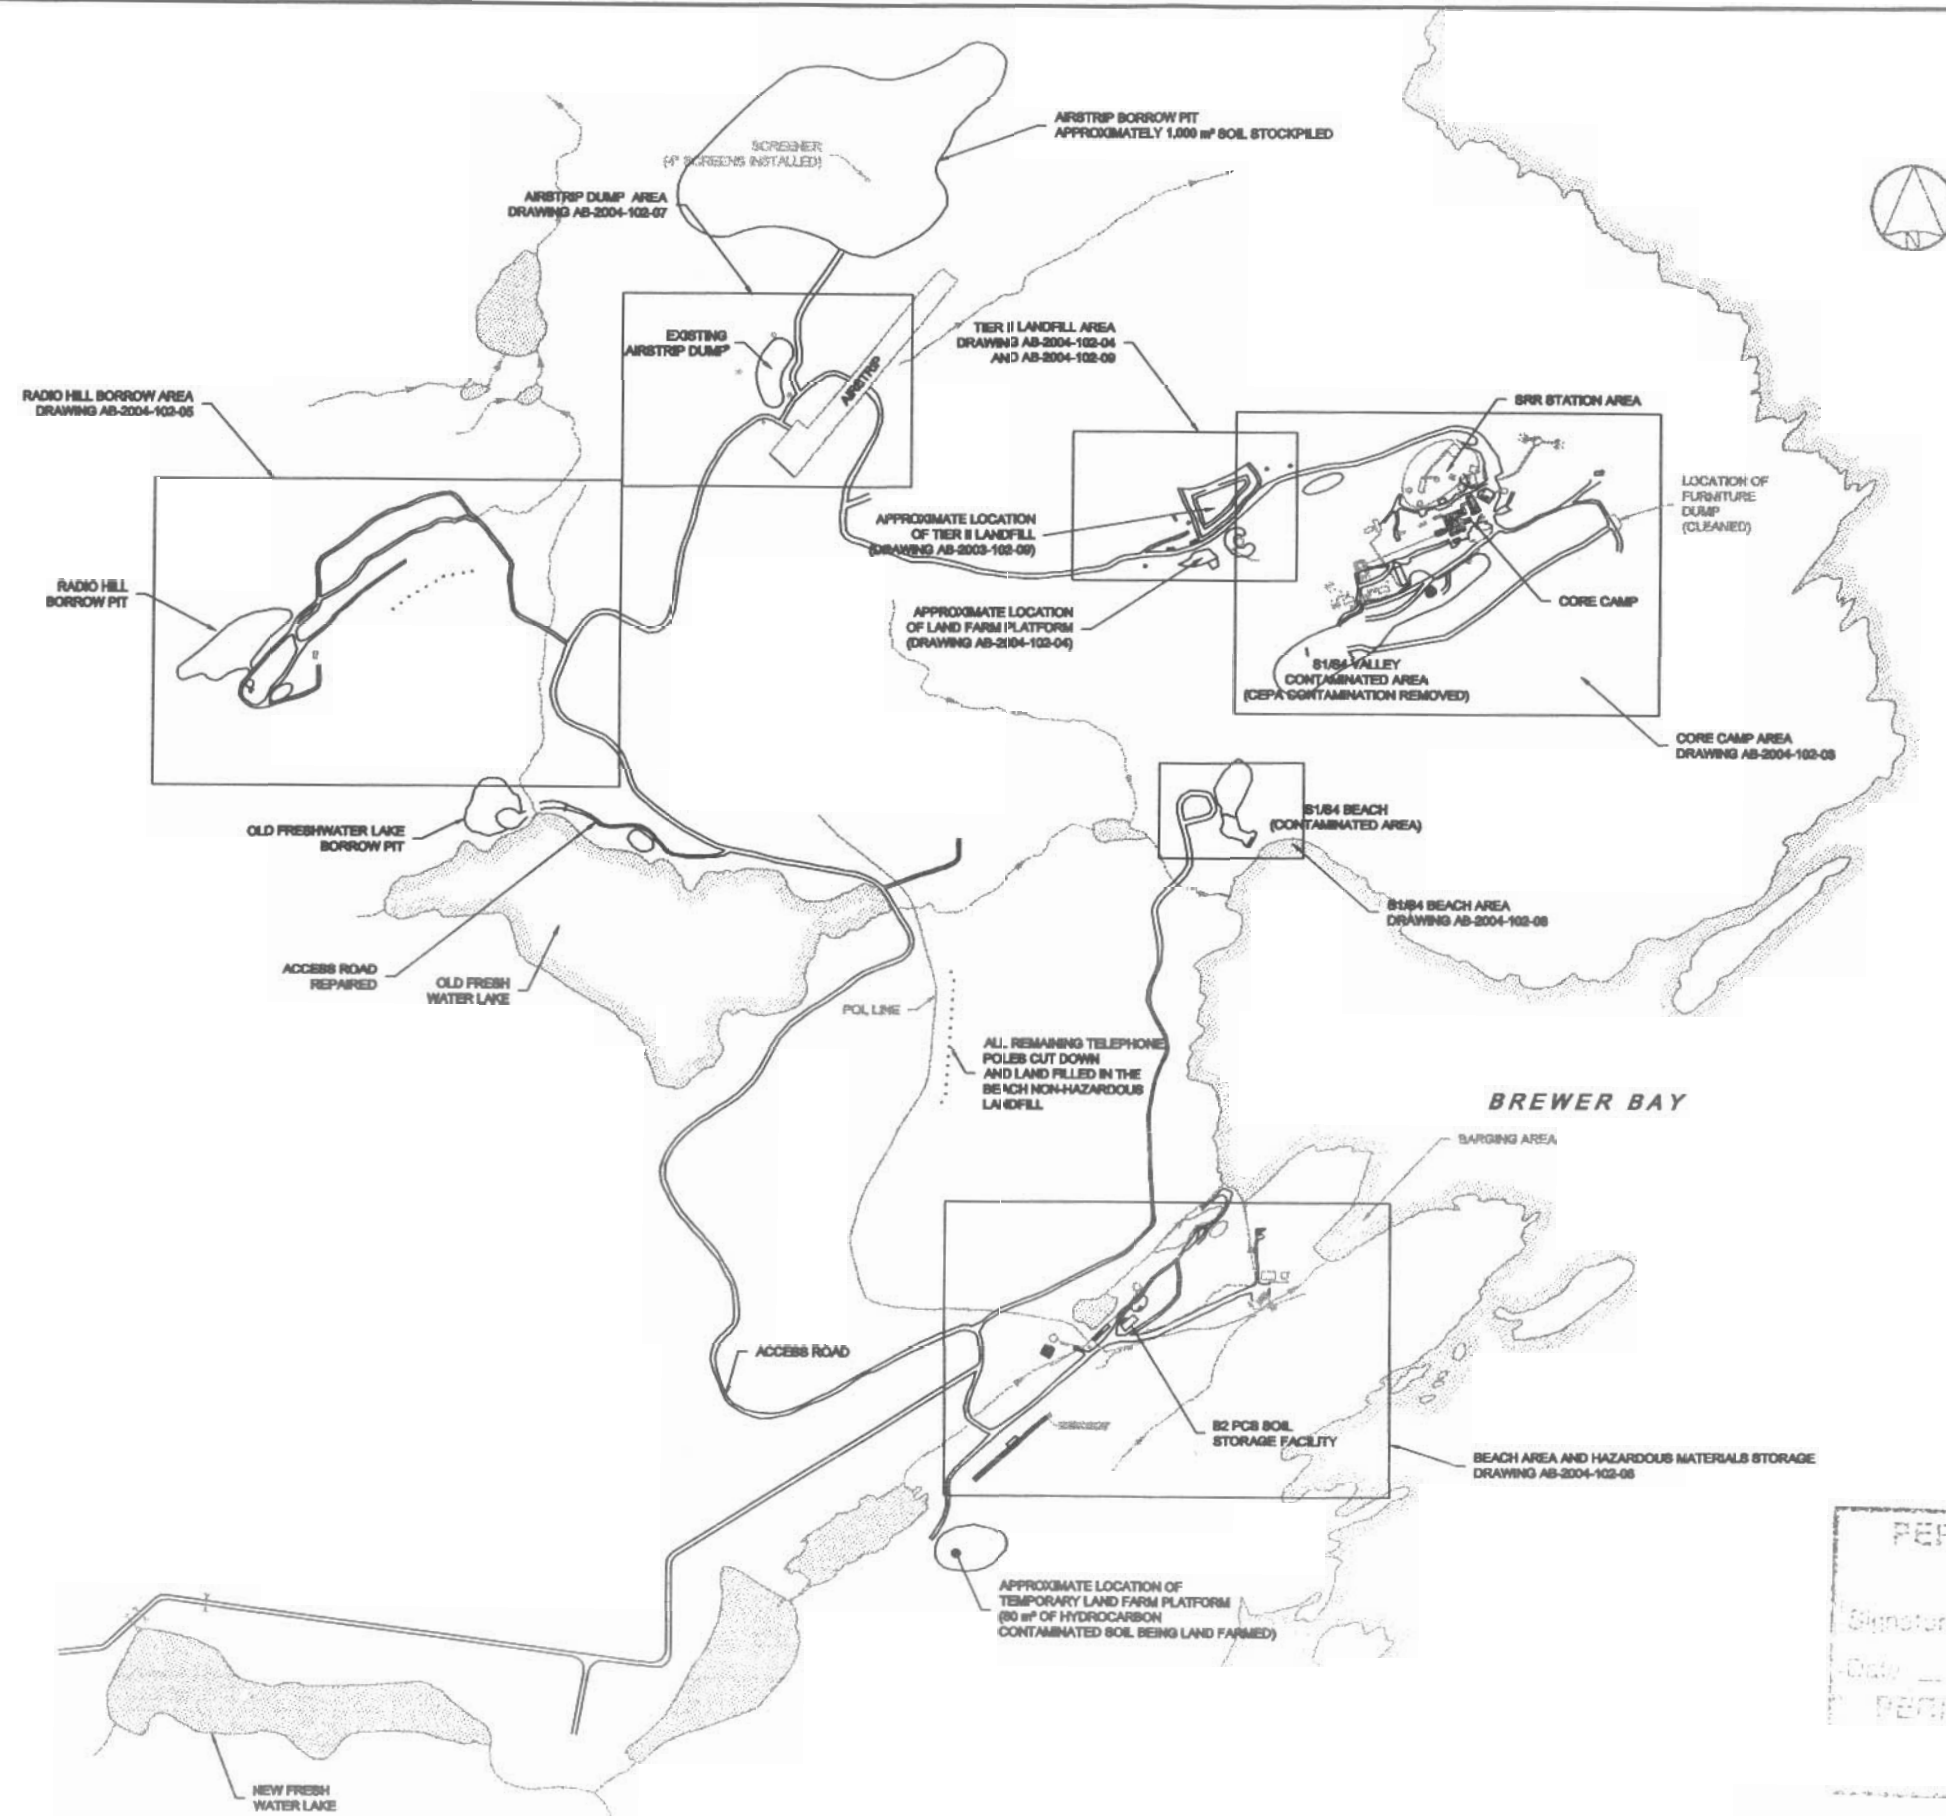

INDIAN AND NORTHERN AFFAIRS CANADA

NUNAVUT REGIONAL OFFICE

General Notes:

Legend:

REV.	DATE	REVISION	REVISION	APPR.

Sinanni Inc.
QINIQTAALUK CORPORATION

SCALE - ECHELLE 1:500

PROJECT - PROJET
BAF-5 RESOLUTION ISLAND

© COPYRIGHT HER MAJESTY THE QUEEN IN THE RIGHT OF CANADA 2004, AS REPRESENTED BY INDIAN AND NORTHERN AFFAIRS CANADA

TRACÉ - MÉTRER	SITING	DATE	2004-12-16
----------------	--------	------	------------


SUBJECT - SUJET
GENERAL SITE LAYOUT AND AS BUILT DRAWING INDEX

PRODUCTION	CONCURRENCE - AMBLEMENT
DRAWN	G.J.
CHECKED	G.J.
VERIFIED	K.C.
COORDINATION	REVIEWED - REVU P.S.

DRAW. NO. - DESIGN NO.
AB-2004-102-02

Canada

PERMIT TO PRACTICE
SINANNI INC.
 Signature *[Signature]*
 Date *05/01/13*
PERMIT NUMBER: P 410
 The Association of Professional Engineers,
 Geologists and Geophysicists of the NWT / NU

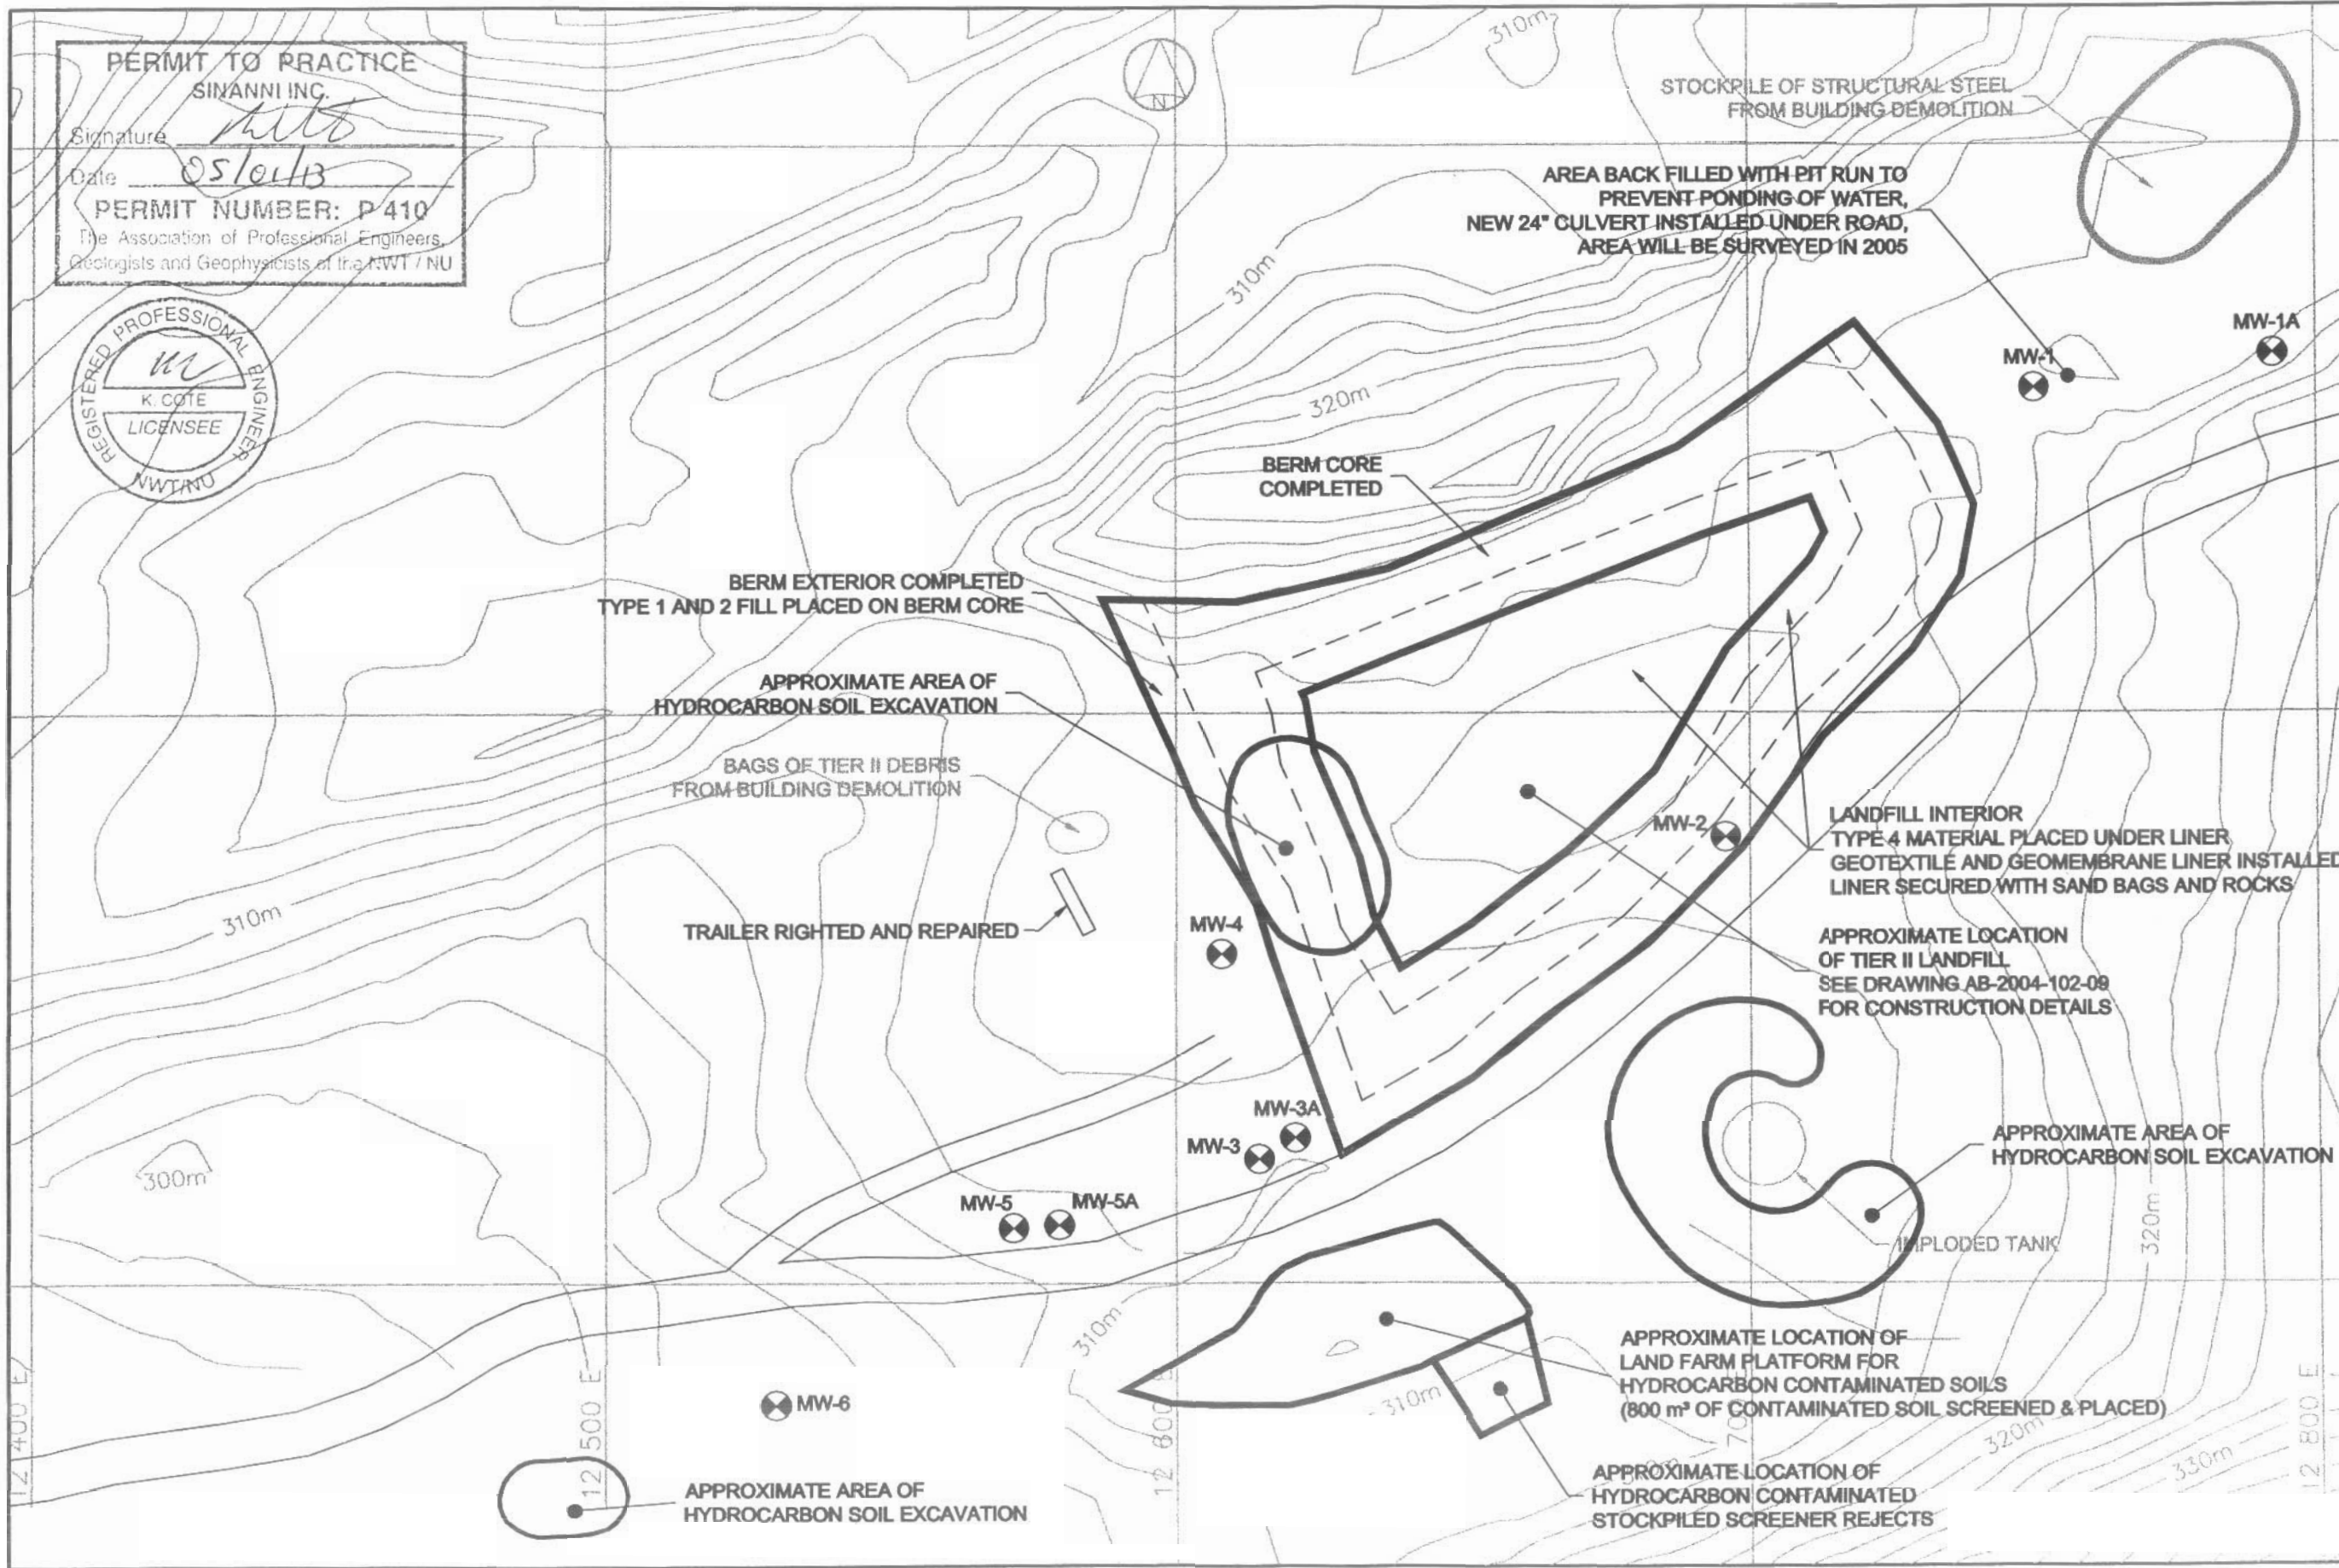

INDIAN AND NORTHERN AFFAIRS CANADA

NUNAVUT REGIONAL OFFICE

General Notes:

- LOCATIONS OF MONITORING WELLS ARE APPROXIMATE AND NOT SURVEYED. MONITORING WELL LOCATIONS WILL BE SURVEYED DURING THE 2005 SEASON.
- LOCATION OF HYDROCARBON EXCAVATIONS ARE APPROXIMATE AND WILL BE CONFIRMED IN QUEEN'S UNIVERSITY'S ANALYTICAL SERVICES UNIT REPORT.

Legend:

 MONITORING WELLS

NO.	DATE	REVISION	REVISION	APPR.

Sinanni Inc.

SCALE - ECHELLE

PROJECT - PROJET
BAF-5 RESOLUTION ISLAND


© COPYRIGHT HER MAJESTY THE QUEEN IN THE RIGHT OF CANADA 2004, AS REPRESENTED BY INDIAN AND NORTHERN AFFAIRS CANADA

TRADE - METIER	SITING	DATE	2004-12-16
SUBJECT - SUJET	GENERAL LAYOUT OF, AND MODIFICATIONS MADE TO, THE TIER II LANDFILL, LAND FARM PLATFORM, AND SURROUNDING AREA		

PRODUCTION	CONCURRENCE - AGREEMENT
DRAWN	G.J.
CHECKED	G.J.
COORDINATION	K.C.
	REVIEWED - REVU
	P.S.

DWG. NO. - DESIGN NO.
 AB-2004-102-04

Canada

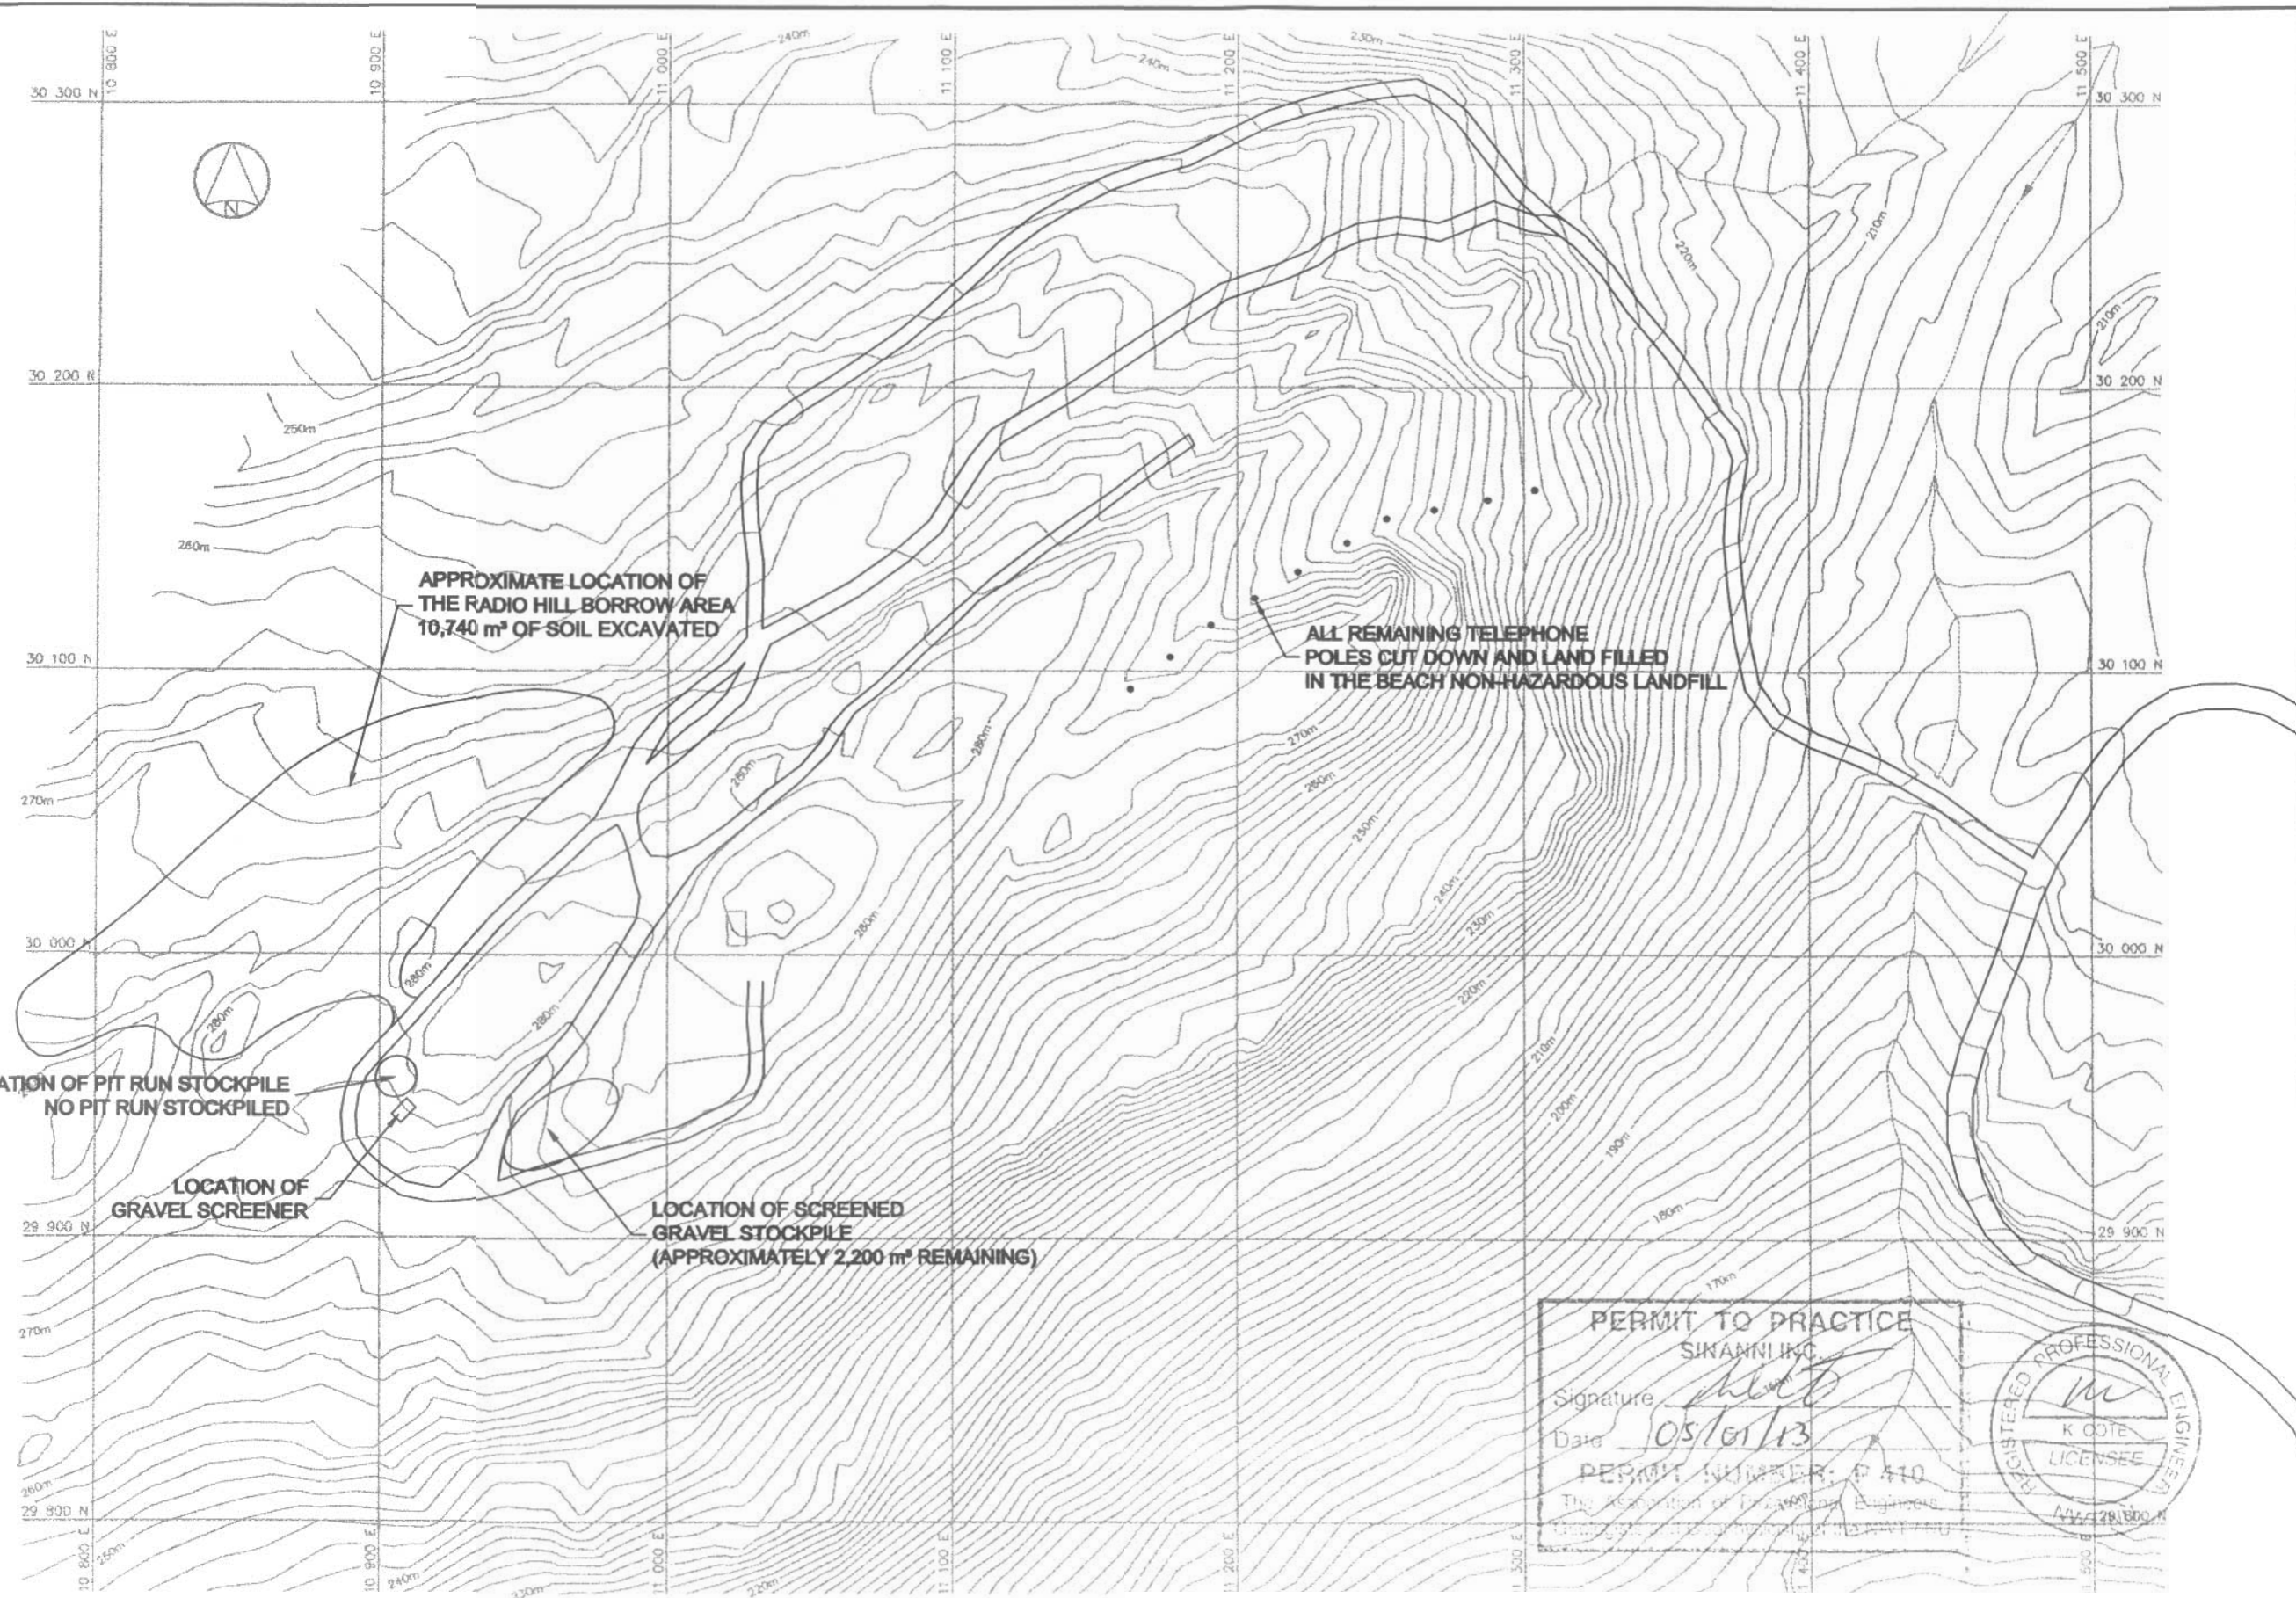

INDIAN AND NORTHERN AFFAIRS CANADA

NUNAVUT REGIONAL OFFICE

General Notes:
1.

Legend:

No.	DATE	REVISION	REVISION	APPR.

Sinanni INC.
SCALE - ÉCHELLE 1:5000

PROJECT - PROJET
BAF-5 RESOLUTION ISLAND

© COPYRIGHT HER MAJESTY THE QUEEN
IN THE RIGHT OF CANADA 2004,
AS REPRESENTED BY INDIAN AND
NORTHERN AFFAIRS CANADA

TRACE - MÉTRER	SITING	DATE 2004-12-16
SUBJECT - SUJET GENERAL LAYOUT OF THE RADIO HILL AREA		


PRODUCTION	CONCURRENCE - ASSENTMENT
DRAWN ETUDE	G.J.
CHECKED VÉRIFIÉ	G.J.
COORDINATION	K.C.
	REVIEWED - REVU P.S.

DRAWN BY - DÉSSINÉ PAR
AB-2004-102-05

Canada

PERMIT TO PRACTICE
SINANNI INC.
Signature *[Signature]*
Date 10/01/13
PERMIT NUMBER: P 410
The Association of Professional Engineers
Engineering and Geomatics Association of Nunavut



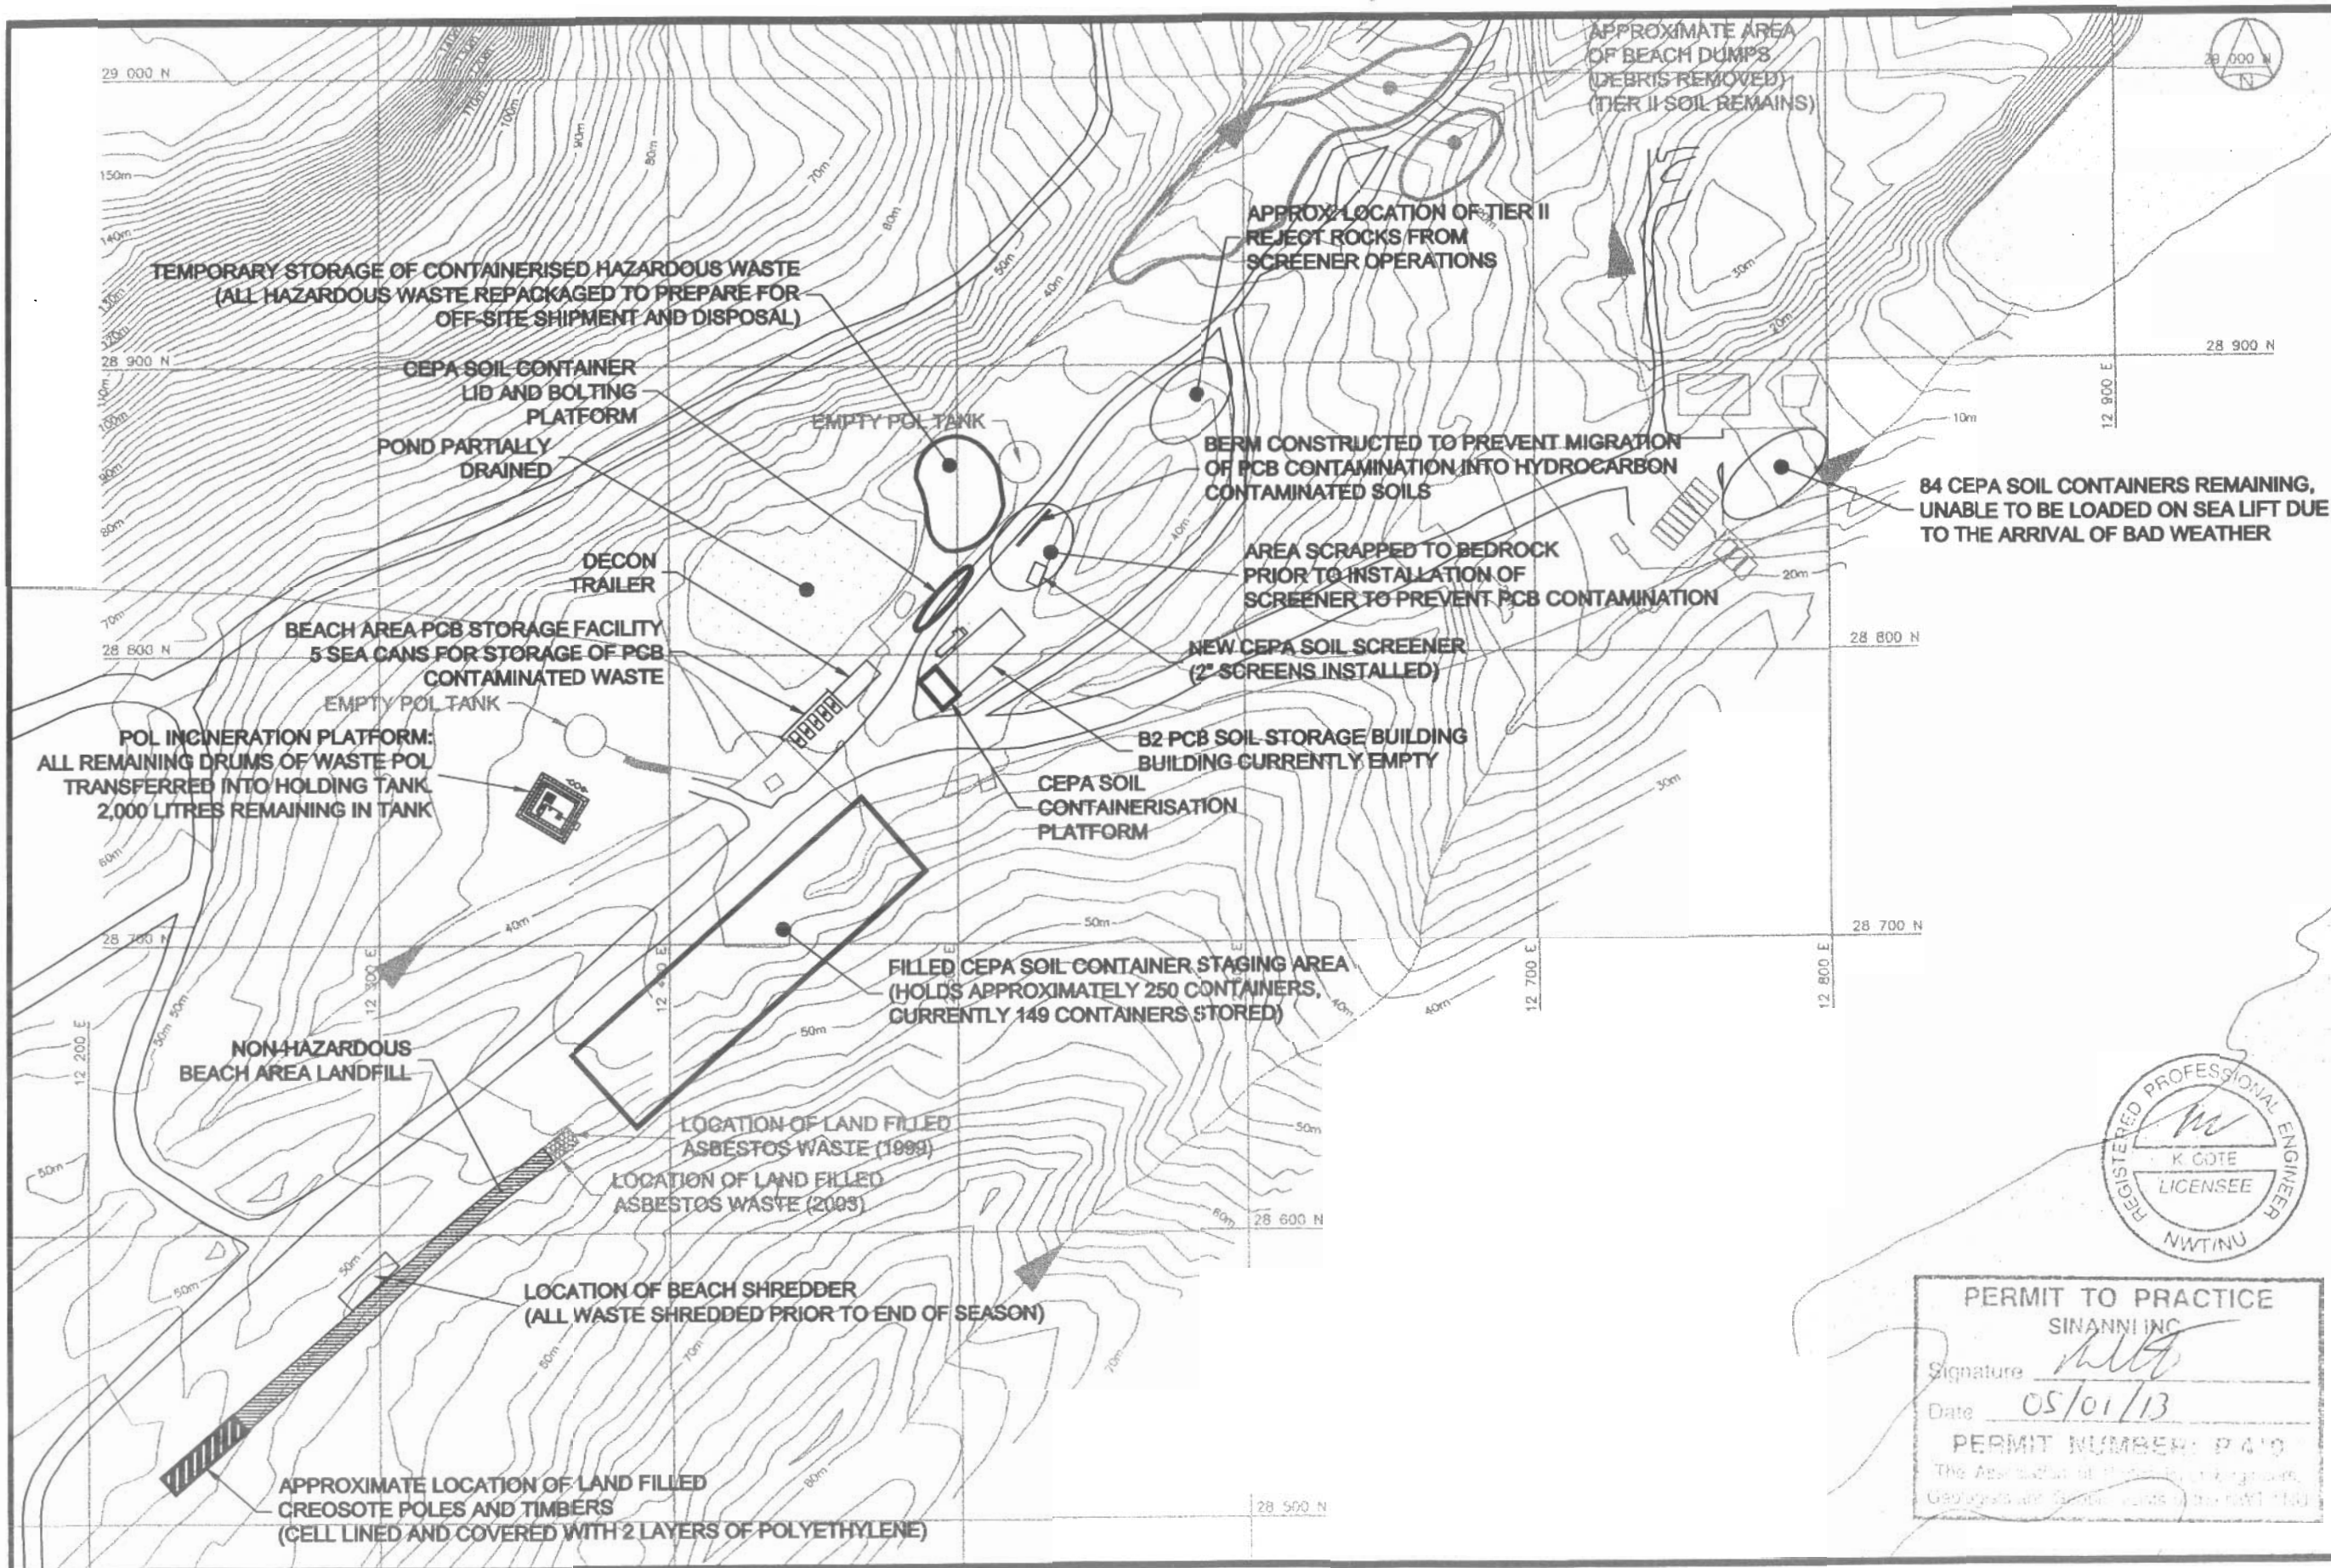

INDIAN AND NORTHERN AFFAIRS CANADA																																																																									
NUNAVUT REGIONAL OFFICE																																																																									
General Notes:																																																																									
Legend: NON-HAZARDOUS WASTE ASBESTOS LANDFILL																																																																									
<table border="1"> <thead> <tr> <th>NO.</th> <th>DATE</th> <th>REVISION</th> <th>REVISION</th> <th>APPR.</th> </tr> </thead> <tbody> <tr> <td colspan="5"> Sinanni Inc. </td> </tr> <tr> <td colspan="5"> BAF-5 RESOLUTION ISLAND </td> </tr> <tr> <td colspan="5"> © COPYRIGHT HER MAJESTY THE QUEEN IN THE RIGHT OF CANADA 2004, AS REPRESENTED BY INDIAN AND NORTHERN AFFAIRS CANADA </td> </tr> <tr> <td colspan="2"> TITLE - MISEN </td> <td colspan="2"> SITING </td> <td> DATE 2004-12-16 </td> </tr> <tr> <td colspan="5"> SUBJECT - SUJET </td> </tr> <tr> <td colspan="5"> GENERAL LAYOUT OF, AND MODIFICATIONS MADE TO, THE BEACH AREA </td> </tr> <tr> <td colspan="2"> PRODUCTION </td> <td colspan="3"> CONCURRENCE - AGREEMENT </td> </tr> <tr> <td colspan="2"> DRAWN </td> <td colspan="3"> G.J. </td> </tr> <tr> <td colspan="2"> CHECKED </td> <td colspan="3"> G.J. </td> </tr> <tr> <td colspan="2"> VERIFIED </td> <td colspan="3"> K.C. </td> </tr> <tr> <td colspan="2"> COORDINATION </td> <td colspan="3"> REVIEWED - REVUE </td> </tr> <tr> <td colspan="2"> DATE </td> <td colspan="3"> P.S. </td> </tr> <tr> <td colspan="5"> Canadā </td> </tr> </tbody> </table>				NO.	DATE	REVISION	REVISION	APPR.	Sinanni Inc.					BAF-5 RESOLUTION ISLAND					© COPYRIGHT HER MAJESTY THE QUEEN IN THE RIGHT OF CANADA 2004, AS REPRESENTED BY INDIAN AND NORTHERN AFFAIRS CANADA					TITLE - MISEN		SITING		DATE 2004-12-16	SUBJECT - SUJET					GENERAL LAYOUT OF, AND MODIFICATIONS MADE TO, THE BEACH AREA					PRODUCTION		CONCURRENCE - AGREEMENT			DRAWN		G.J.			CHECKED		G.J.			VERIFIED		K.C.			COORDINATION		REVIEWED - REVUE			DATE		P.S.			Canadā				
NO.	DATE	REVISION	REVISION	APPR.																																																																					
Sinanni Inc.																																																																									
BAF-5 RESOLUTION ISLAND																																																																									
© COPYRIGHT HER MAJESTY THE QUEEN IN THE RIGHT OF CANADA 2004, AS REPRESENTED BY INDIAN AND NORTHERN AFFAIRS CANADA																																																																									
TITLE - MISEN		SITING		DATE 2004-12-16																																																																					
SUBJECT - SUJET																																																																									
GENERAL LAYOUT OF, AND MODIFICATIONS MADE TO, THE BEACH AREA																																																																									
PRODUCTION		CONCURRENCE - AGREEMENT																																																																							
DRAWN		G.J.																																																																							
CHECKED		G.J.																																																																							
VERIFIED		K.C.																																																																							
COORDINATION		REVIEWED - REVUE																																																																							
DATE		P.S.																																																																							
Canadā																																																																									



PERMIT TO PRACTICE SINANNI INC.	
Signature <i>[Signature]</i>	Date 05/01/13
PERMIT NUMBER: P 410	
The Association of Professional Engineers, Geoscientists and Geotechnical Engineers (NWT)	