
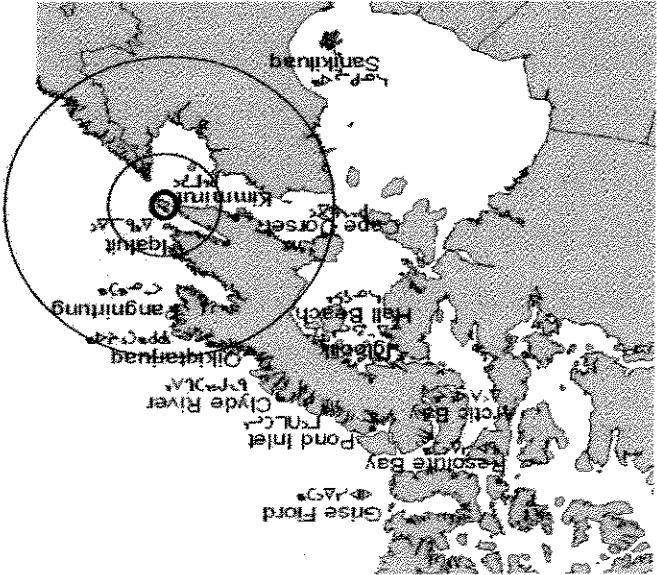



RESOLUTION ISLAND PROJECT

AS-BUILT DRAWING INDEX	
DRAWING NUMBER	TITLE
SITING	
AB-2005-102-01	LOCATION OF BORROW PITS USED DURING THE 2005 SEASON
AB-2005-102-02	GENERAL SITE LAYOUT AND AS-BUILT DRAWING INDEX
AB-2005-102-03	GENERAL LAYOUT OF, AND MODIFICATIONS MADE TO, THE UPPER SITE
AB-2005-102-04	GENERAL LAYOUT OF, AND MODIFICATIONS MADE TO THE AREA SURROUNDING THE TIER II LANDFILL AND THE LAND FARM PLATFORM
AB-2005-102-05	GENERAL LAYOUT OF THE RADIO HILL AREA
AB-2005-102-06	GENERAL LAYOUT OF, AND MODIFICATIONS MADE TO, THE BEACH AREA
AB-2005-102-07	S1/S4 BEACH AREA GRIDDING SYSTEM
AB-2005-102-08	SURVEYED DRAWING OF THE TIER II LANDFILL
AB-2005-102-09	CROSS-SECTIONS OF THE TIER II LANDFILL (DRAWING 1 OF 2)
AB-2005-102-10	CROSS-SECTIONS OF THE TIER II LANDFILL (DRAWING 2 OF 2)

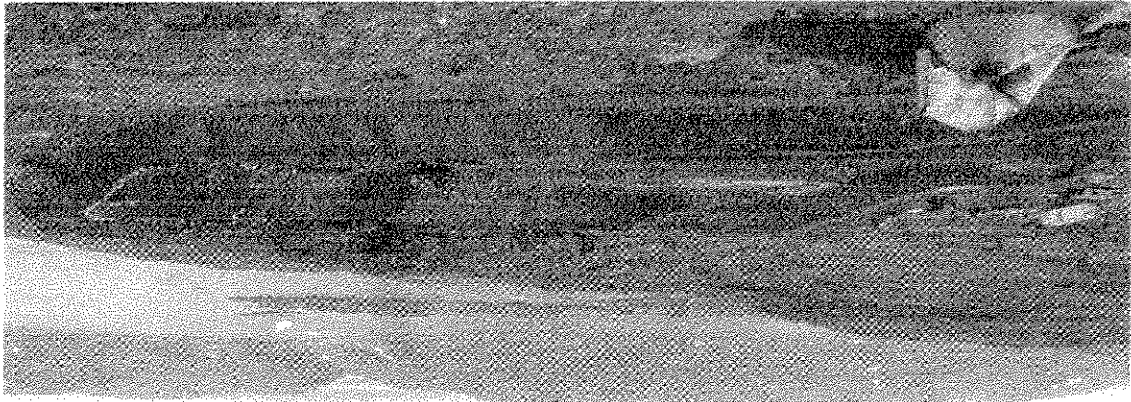

BAF-5 RESOLUTION ISLAND 2005 AS-BUILT DRAWINGS

2005
C4C
> 2005
UN5CJLVC

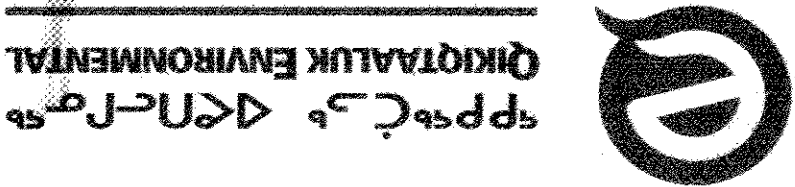

QIKIQTAAUK ENVIRONMENTAL
QIKIQTAAUK ENVIRONMENTAL



QIKIQTAAUK CORPORATION
QIKIQTAAUK CORPORATION

December 2005

GENERAL
1. LOCAL
APPENDIX

LEGEND:

2006	0



SCALE - SCHMIDT

BA

© COPY
IN
AS
N

TRADE & MATTERS

1998-1999

LOCATIO

பெரியகோட்டை

TRANSDUCER

1000

ଆବଶ୍ୟକ

