



PLAN

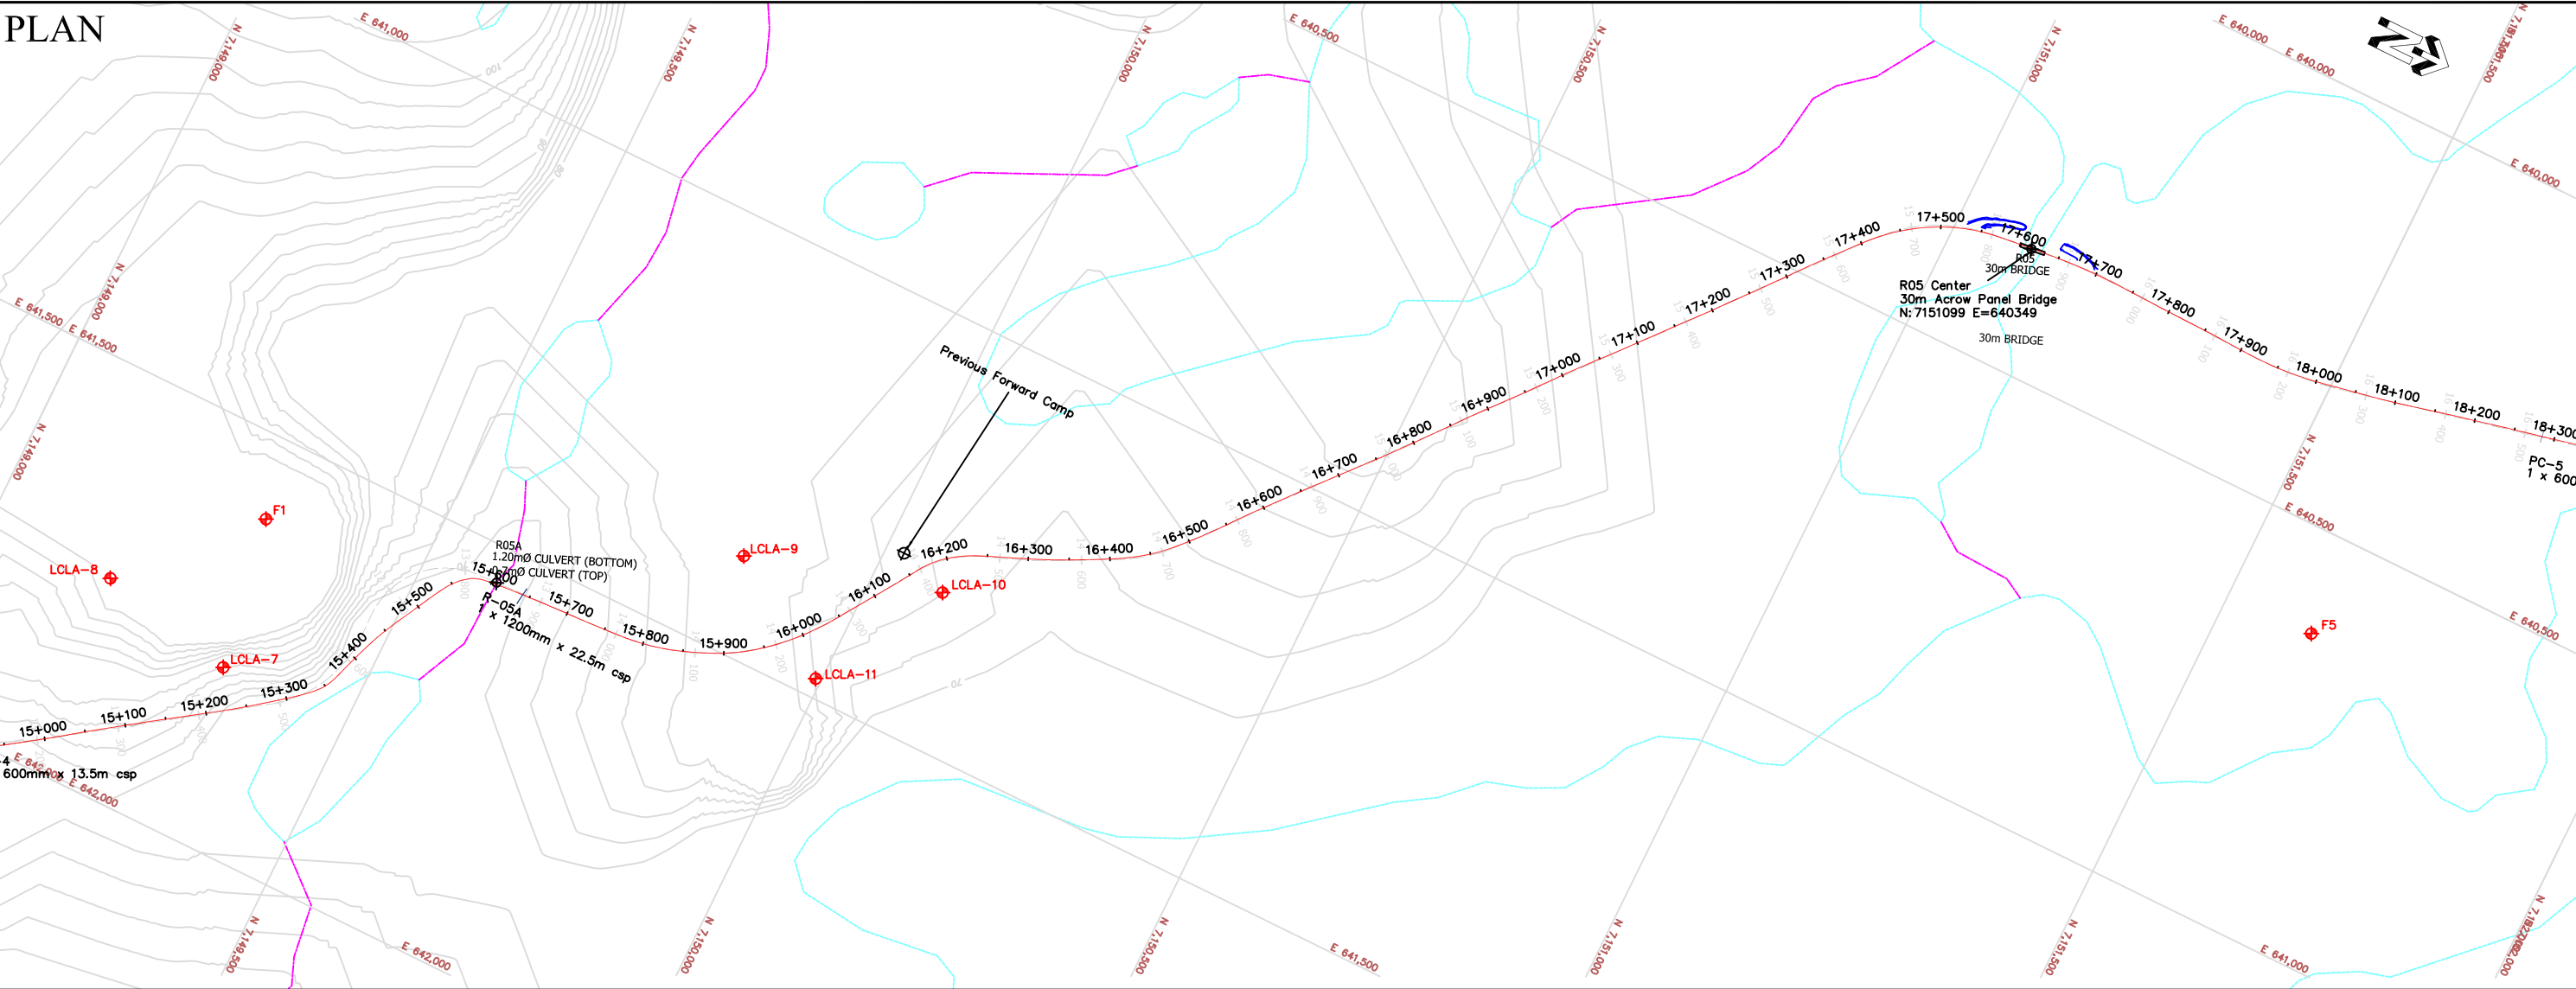

PROFILE

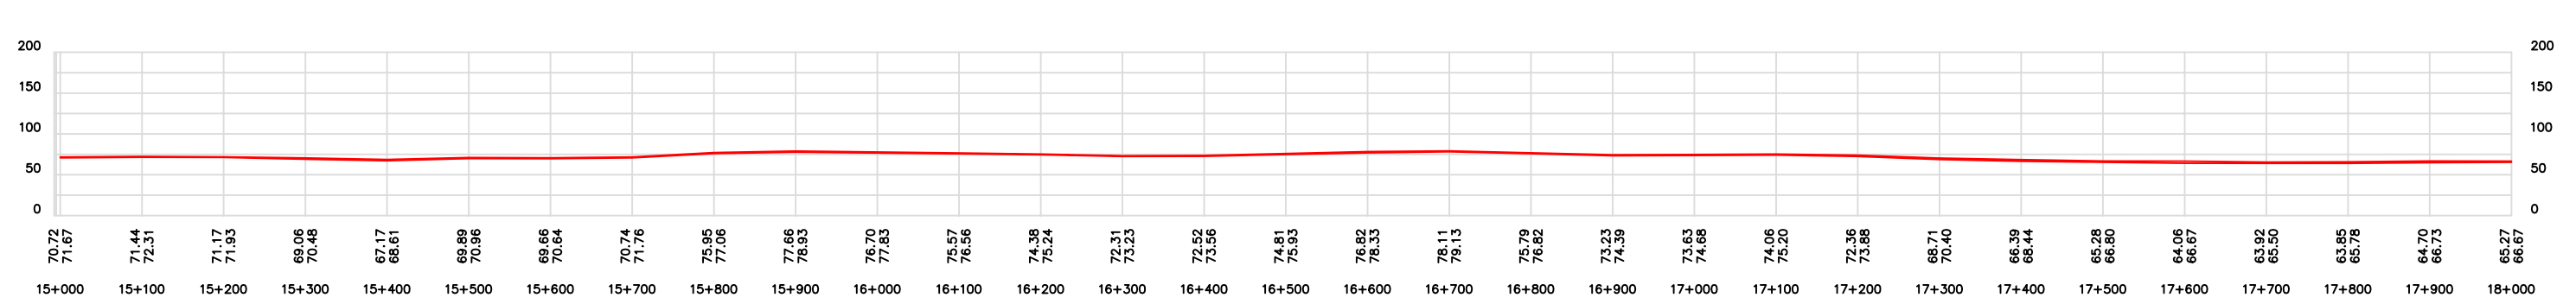

GOLDER DATA				AS CONSTRUCTED DATA				NOTES				OWNER							
LfLa-3 Existing archeological site Pit-13 Proposed quarry site Existing lake/stream SUSCEPTIBILITY High Medium-High Medium Low-Medium Low Unclassified				172 Quarry as-built 2m major contour Quarry as-built 1m minor contour Crest boundary of quarry limit at original ground Toe boundary of quarry excavation at bench grade 0+100 Centerline of road with 100m stations R20 River crossing - culvert 600mm/1200mm dia PC-1 River crossing - bridge 12m / 30m length R02				0m 100m 200m 300m Scale 1: 8000				1. Coordinate system NAD 83 UTM Zone 14N Geoid HTv2. 2. Golder data supplied by Cumberland/Agnico. 3. For quarry data, please refer to table 1. 4. For culvert data, please refer to table 2. 5. For bridge data, please refer to table 3.				PROJECT As constructed drawings - Plan and Profile Stationing 15+000 to 18+000 CAD Check gc cg/hb Date March 31, 2008 Sheet 6 of 35			