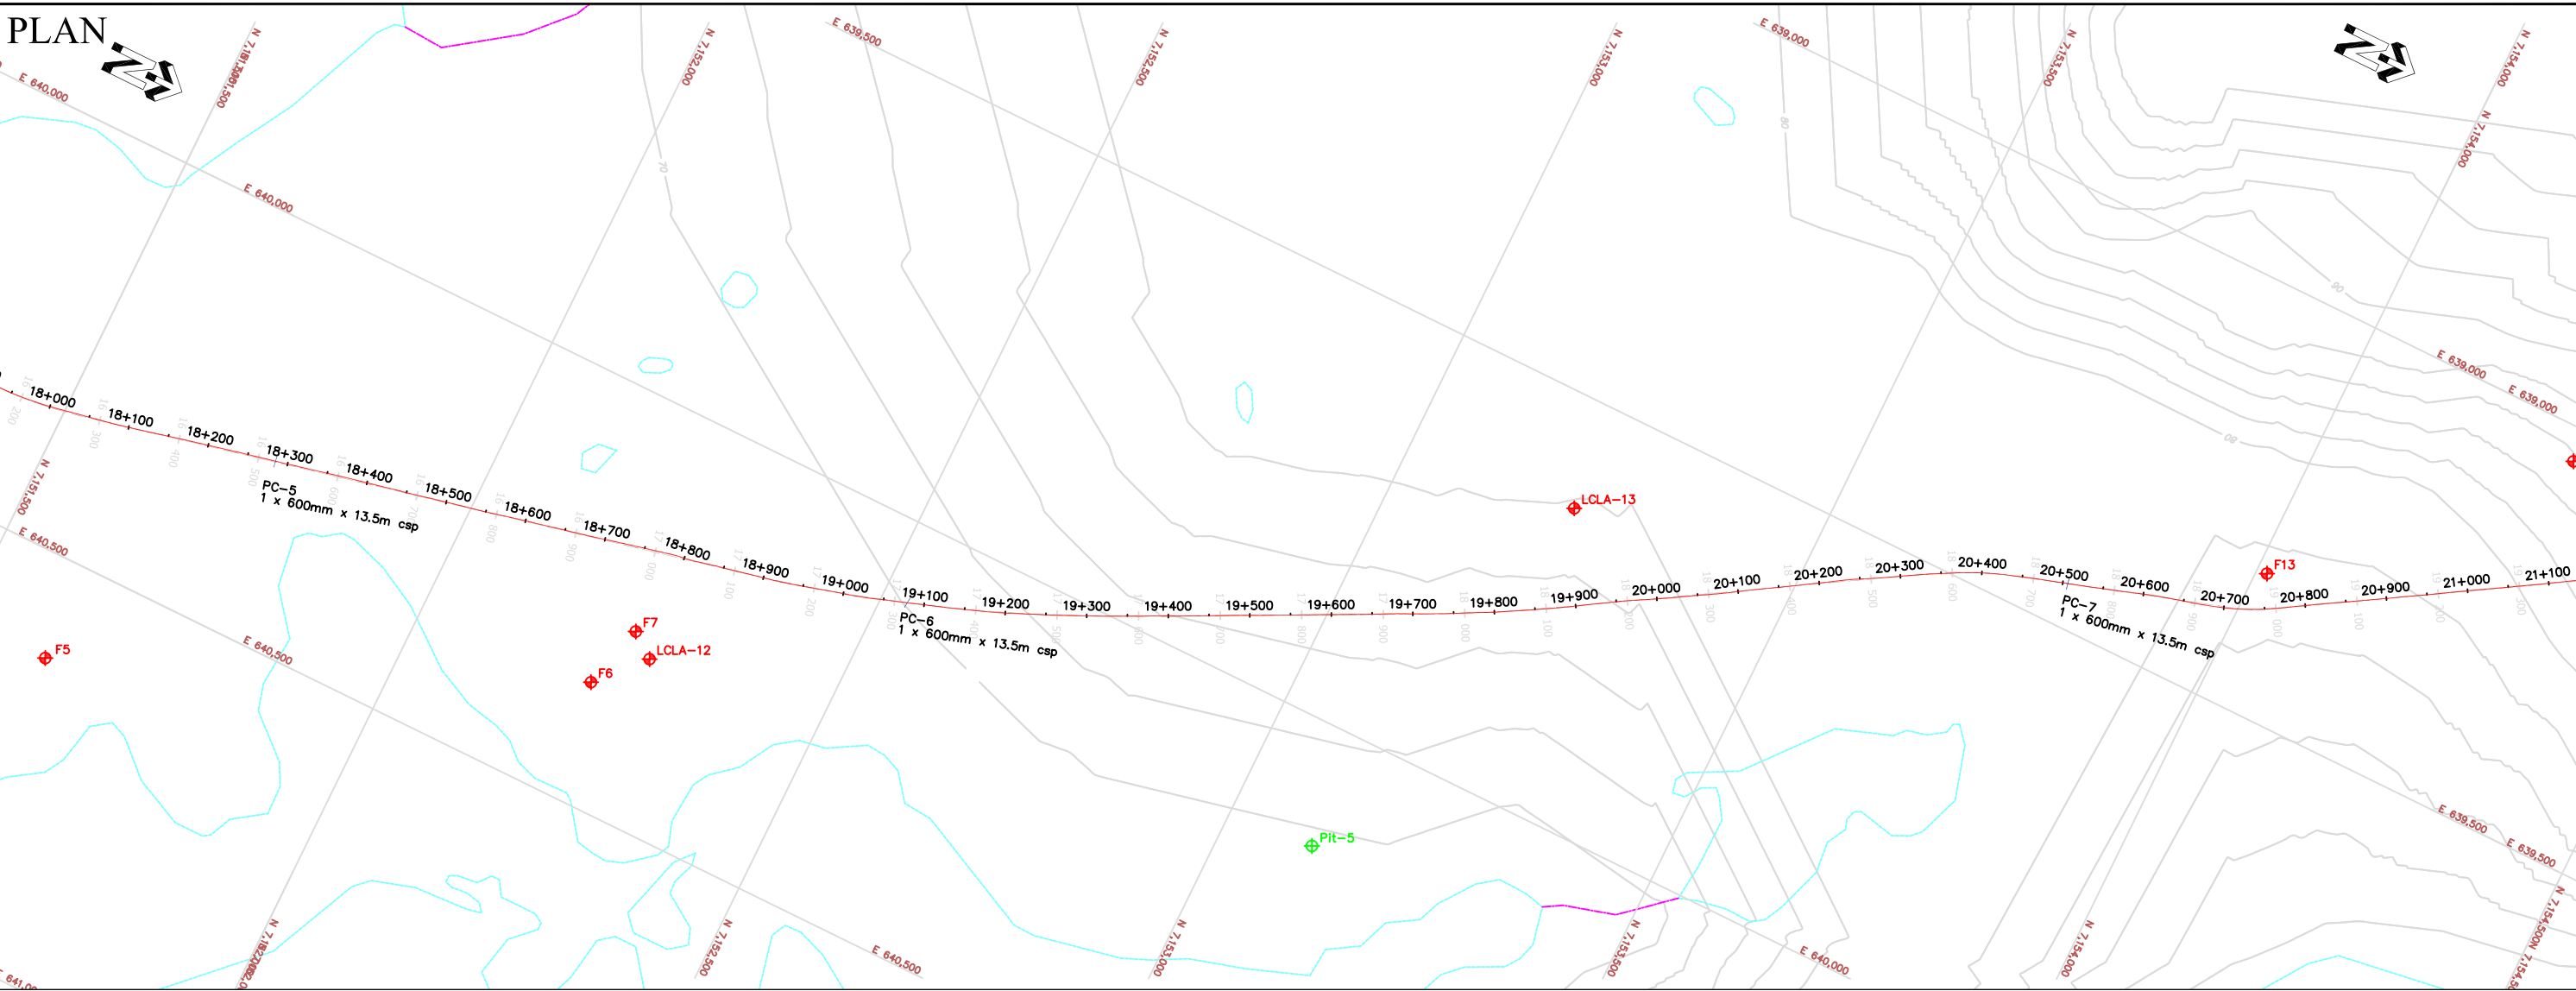


horizontal scale = vertical scale = 1:1

GOLDER DATA

Lfla-3	Existing archeological site	R02	River crossing (crossing structure and dimension)
Pit-13	Proposed quarry site	120	Existing major contour (10m Topo)
	Existing lake/stream		Existing minor contour (interpreted)
			Proposed $\frac{1}{2}$ of road alignment

SUSCEPTIBILITY

High	Medium-High	Medium	Low-Medium	Low	Unclassified
------	-------------	--------	------------	-----	--------------

AS CONSTRUCTED DATA

172	Quarry as-built 2m major contour	0+100	Centerline of road with 100m stations
172	Quarry as-built 1m minor contour	R20	River crossing - culvert 600mm/1200mm dia
	Crest boundary of quarry limit at original ground	PC-1	River crossing - bridge 12m / 30m length
	Toe boundary of quarry excavation at bench grade	R02	

0m 100m 200m 300m

Scale 1: 8000

NOTES

- Coordinate system NAD 83 UTM Zone 14N Geoid HTv2.
- Golder data supplied by Cumberland/Agnico.
- For quarry data, please refer to table 1.
- For culvert data, please refer to table 2.
- For bridge data, please refer to table 3.

OWNER	Agnico-Eagle Mines Ltd.		Nunavut
PROJECT	Meadowbank Gold Project Tehek Access Road Construction		
TITLE	As constructed drawings - Plan and Profile		
	Stationing 18+000 to 21+000	Sheet 7 of 35	
CAD gc	Check cg/hb	Date March 31, 2008	