



## CONSTRUCTION SUMMARY REPORT: Roberts Bay Discharge System



Type "A" Water Licence 2AM-DOH1335  
Hope Bay Project  
TMAC Resources Inc.  
November 04, 2020

Prepared For:  
Nunavut Water Board  
Gjoa Haven, NU

Prepared By:  
TMAC Resources Inc.  
Toronto, Ontario

## Table of Contents

1	INTRODUCTION.....	1
2	RBDS System Components.....	1
3	WATER LICENCE CONDITIONS.....	4
3.1	SCHEDULE D PART 2A – FINAL DESIGN AND CONSTRUCTION DRAWINGS.....	4
3.2	SCHEDULE D PART 2e – GEOCHEMICAL ANALYSIS OF WASTE ROCKS AND FILLS.....	4
3.3	SCHEDULE D PART 2F – PHOTOGRAPHIC RECORDS.....	4
3.3.1	TIA Water Pump House (Area 710).....	4
3.3.2	Outfall Pump Station Building (Area 720).....	6
3.3.3	Outfall Discharge System (Area 730).....	8
3.3.4	Underground Pumping Station (Area 1000).....	12
3.3.5	Water Treatment Plant (Area 740).....	13
3.4	SCHEDULE D PART 2G – AS-BUILT DRAWINGS.....	15
3.5	SCHEDULE D PART 2H – FIELD DECISIONS AND DESIGN CHANGES.....	15
3.6	SCHEDULE D PART 2I – MITIGATION MEASURES.....	18
3.7	SCHEDULE D PART 2J – MONITORING ACTIVITIES.....	19
3.8	SCHEDULE D PART 2K – BLAST VIBRATION MONITORING.....	19
3.9	SCHEDULE D PART 2L - MONITORING EROSION PROTECTION MEASURES.....	19
3.10	SCHEDULE D PART 2M – MONITORING OF WATER USE FROM DUST SUPPRESION.....	19
3.11	SCHEDULE D PART 2N – MONITORING OF CONTRACTOR’S GROUND IMPACTS.....	19
3.12	SCHEDULE D PART 2P – SUMMARY OF QUARRY ROCK SEEPAGE.....	19
4	REFERENCES.....	20

## List of Appendices

APPENDIX A - ISSUED FOR CONSTRUCTION DRAWINGS

APPENDIX B - AS-BUILT DRAWINGS

## 1 INTRODUCTION

The Roberts Bay Discharge System (“**RBDS**”) at the Hope Bay Project in Nunavut, Canada is designed to discharge water from the Doris Tailings Impoundment Area (“**TIA**”) and underground mine areas, to the marine environment in Roberts Bay. The RBDS was initially authorized under the amended Doris Project Certificate No: 003 and Doris Type A Water Licence 2AM-DOH1323 (since superseded by Type A Water Licence 2AM-DOH1335). TMAC Resources Inc. (“**TMAC**”) completed the construction of the RBDS in 2020 and discharges, compliant with the Metal and Diamond Mining Effluent Regulations (“**MDMER**”), commenced on February 1st 2020.

This Construction Summary Report (“**CSR**”) is being provided to the Nunavut Water Board (“**NWB**”), as required under Part D Item 11 of Water Licence 2AM-DOH1335. The CSR documents field decisions, supporting data and mitigation measures employed as a result of the installation the discharge system, as required under Schedule D, Item 2 of the NWB Water Licence 2AM-DOH1335.

## 2 RBDS SYSTEM COMPONENTS

The primary system components of the RBDS are described below. For more information, please see the RBDS Process Flow Diagram in Appendix B.

1) TIA Water Pump House (Area 710), located on the reclaim jetty at the TIA, pumps the water from the TIA reclaim pond into the outfall pump box of the 720 building.

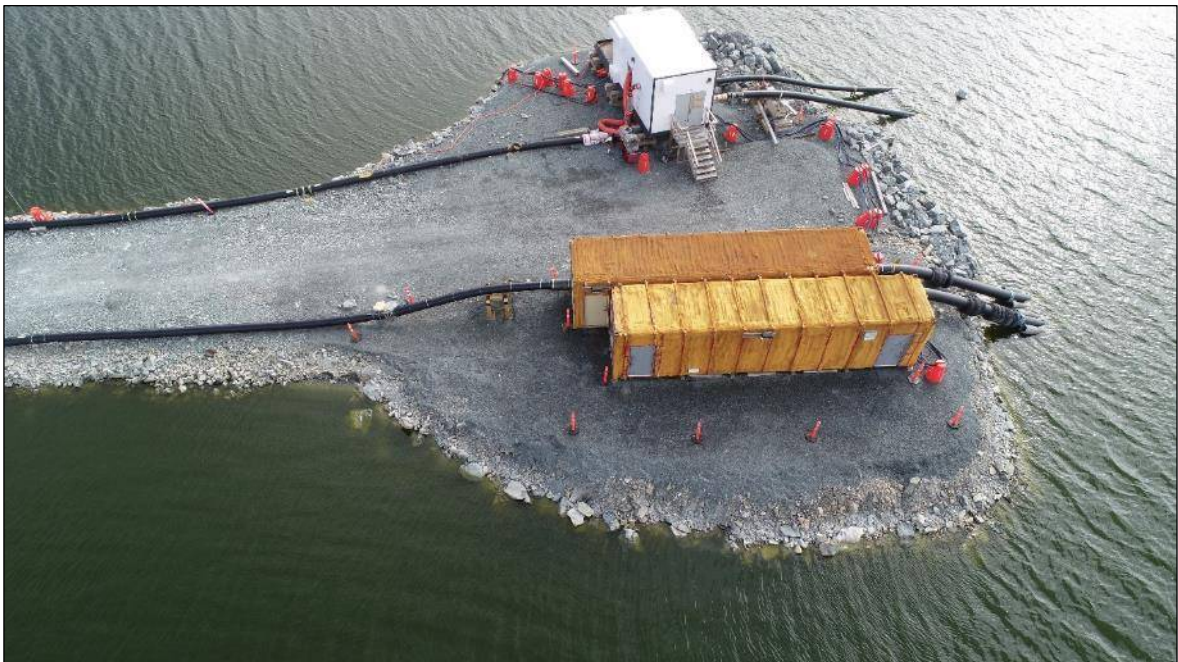


Photo 1: Showing the Reclaim Jetty where the new pump house and electrical room is location (orange insulation).



2) The Outfall Pump Station Building (Area 720), located between the mobile shop and the sedimentation control pond, pumps the water from the outfall pump box to the 730 building on the marine outfall berm on the shore of Roberts Bay.



Photo 2: Outfall pumping system (720) and TSS filtration plant (740) next to the sediment pond. 720 in beige on the right and 740 in orange/white on the left.

3) Water Treatment Plant (Area 740), filters water from underground using a lamella clarifier and a set of four (4) multimedia filters. Located right next to 720 building, on the north side.



Photo 3: 720 and 740 buildings after completion of construction

4) Marine Outfall Discharge System (Area 730), contains the outfall pipe, flushing system that prevents freezing during a shutdown, as well as instrumentation and valves. Located on Marine Outfall Berm, west of existing Jetty, in Roberts Bay.





Photo 4: 730 building on the outfall jetty after construction is completed

5) Underground pumping station(s) (Area 1000): Pumps the water collected underground to the Water Treatment Plant (Area 740). Water undergoes primary treatment (settling in underground sumps) before reaching Area 720 to reduce total suspended solids (TSS) in the water treatment plant.



Photo 5: Underground pump station (Area 1000)

6) Surface pipelines and various areas of the system are linked with over 11km of surface HDPE pipeline that is insulated and heat traced to prevent freezing.

### 3 WATER LICENCE CONDITIONS

The following sections are aligned with the CSR requirements as per Schedule D, Item 2 of Water Licence 2AM-DOH1335.

#### 3.1 SCHEDULE D PART 2A - FINAL DESIGN AND CONSTRUCTION DRAWINGS

Issued for Construction (“IFC”) drawings are provided in Appendix A.

#### 3.2 SCHEDULE D PART 2e - GEOCHEMICAL ANALYSIS OF WASTE ROCKS AND FILLS

Crushed material sourced from Quarry 2 was used as construction material for the Robert’s Bay Marine Outfall Berm and access road. Run of Quarry (“ROQ”) was used to construct the access road, crushed material was used for surfacing, and larger boulders were used for armouring the Marine Outfall Berm. Quarry material was determined to be geochemically stable (non-acid generating or metal leaching) as per the Hope Bay Project Quarry Management and Monitoring Plan (December 2017).

#### 3.3 SCHEDULE D PART 2F - PHOTOGRAPHIC RECORDS

Photographic records are provided below. A brief narrative for each photograph is included describing the activity being performed.

##### 3.3.1 TIA Water Pump House (Area 710)

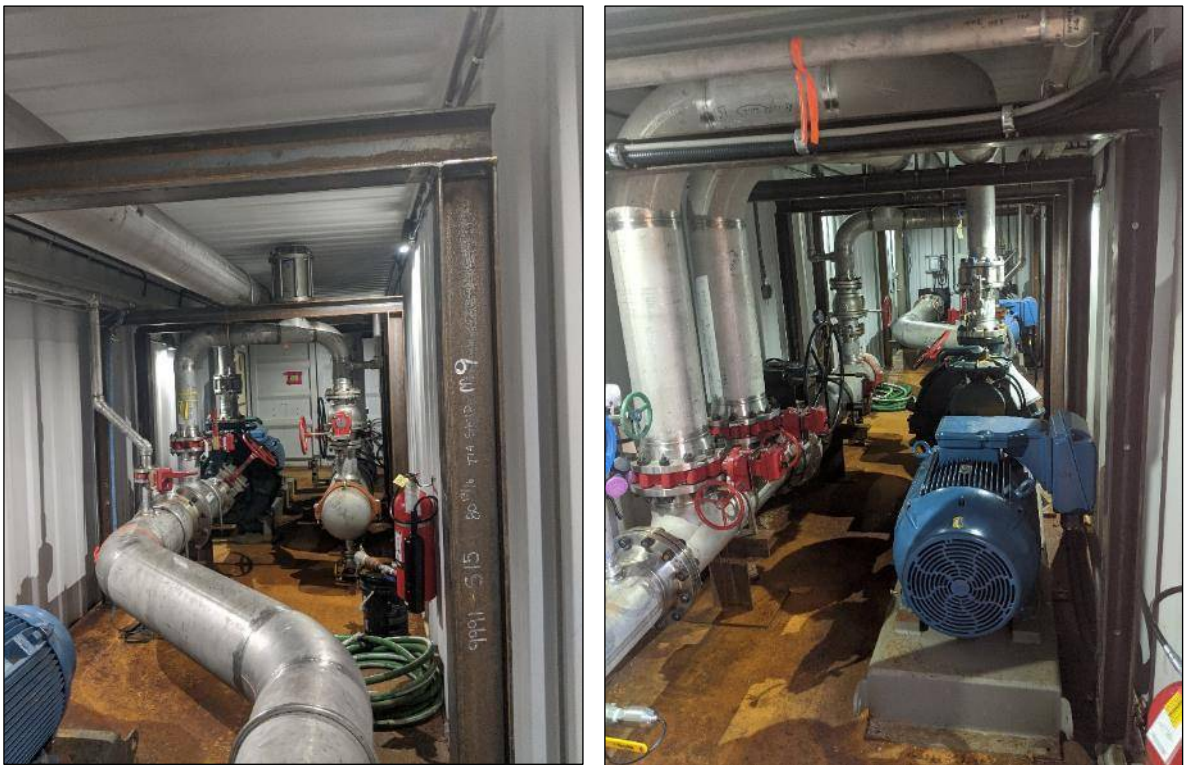


Photo 6: Inside of 710 TIA Water Pump House after completion





Photo 7: Electrician finalising the installation of heat trace on the 710 pump station. Pumping station in beige, electrical room in red.



Photo 8: Showing the 710 buildings after insulation. Main power cables coming into the electrical room and the two stainless steel connections for reclaim pipelines.



Photo 9: Crew deploying one of the 14" suction for the TIA pumps in the 710 Area.



### 3.3.2 Outfall Pump Station Building (Area 720)



Photo 10: Large outfall transfer pump 720-PU-001 during construction.



Photo 11: Compressor system for pigging the line installed and ready for commissioning.



Picture 12: Electrical room in the outfall pumping building (720) during construction, with equipment locked out.



### 3.3.3 Outfall Discharge System (Area 730)



Picture 13: Construction of Marine Outfall Berm and access road. Silt curtains were installed to contain sediments.



Picture 14: Showing 730 pump house assembled.





Picture 15: 730 mechanical pump house after connection with intake and discharge pipeline.



Picture 16: Showing fully assembled diffuser and 200' sections of weighted pipe ready to be deployed and staged on the Marine Outfall Berm and access road.



Picture 17: Tugboat keeping tension and controlling the discharge pipeline and diffuser floating on the water surface during deployment.



Picture 18: Crew working from Marine Outfall Berm, and a smaller boat for the deployment of the underwater pipeline and diffuser.





Photo 19: With the help of a crane, deploying the 8" assembly of the recirculation line at the Marine Outfall Berm. Concrete weights are used to submerge the pipeline.



### 3.3.4 Underground Pumping Station (Area 1000)



Photo 20: Pumps and piping shown on the left side. Electrical, instrumentation and controls shown on the right side.

### 3.3.5 Water Treatment Plant (Area 740)



Photo 21: Installation of Area 740 plant supplied by BQE Water, on its pad.



Photo 22: Offloading Area 740 clarifier from truck prior to installation.





Photo 23: Installation of PVC piping using a scissor lift to connect the Area 740 plant to the 720 building. Outfall discharge pump box showing on the left side (opaque white tank).



Photo 24: Left side: Showing the inside of the TSS treatment plant (Area 740). Right side: showing the inside of the outfall pumping building (Area 720)



### 3.4 SCHEDULE D PART 2G - AS-BUILT DRAWINGS

As-built drawings are provided in Appendix B.

### 3.5 SCHEDULE D PART 2H - FIELD DECISIONS AND DESIGN CHANGES

In general, the RBDS was built to the design requirements. Deviations from the design were completed to adapt the design to encountered field and operational conditions. These changes include:

- The installation of intake at the tailings pond (710) was completed using hollow cylindrical weight from the outfall discharge and decommissioned rubber tires. The engineer of record, Great Pacific, confirmed modification from a concrete weight was acceptable as load criteria was maintained.
- 730 pump house is equipped with an air release valve which previously wasn't considered to ensure air doesn't reach the underwater pipeline when pigging the line, causing it to float.



Photo 25: Showing new air release valve installed in the 710 Building.

- TMAC installed a pipeline from the existing TIA reclaim pond reclaim pipeline to water treatment plant to ensure sufficient water pressure would be available for start-up. Previously not considered.
- Two sections of pipelines that were initially designed to be double walled (at water crossings) were installed using single walled pipeline. The decision was made based on the increased ability to maintain and visually inspect the pipeline. The pipeline alignment at water crossings was installed in a straight section (no bends) to facilitate low wear rates. The pipeline will be inspected at regular intervals and a leak detection system based on flow balances was implemented.

- Initial flocculent dosing system proposed by BQE water was determined to be labour intensive and a safety risk due slippery nature of flocculant. John Brooks Company was engaged to design and supply an automated system.



Photo 26: Flocculent dosing skid supplied by John Brooks

- A concrete floor and sump with overflow to adjacent sedimentation pond was added during commissioning to manage any potential major overflows or spills in building; instead of initially planned gravel floor and sump which required active pumping.



Photo 27: Showing the new overflow pipe coming from the concrete foundation of the 720 building into the sedimentation pond.

- As-built surface pipeline alignment did not follow design as the alignment was routed on the east side of the airstrip. It was determined that the west side of the airstrip provided easier access, while minimizing interference with snow removal in area.





Photo 28: Showing pipeline alignment on the east side of the road and crossing on the west side before the airstrip.

- To mitigate the risk of a negative pressure collapse in the pipeline at higher elevation points, four (4) vacuum breakers that were not previously considered were installed, with heated shelters, along the alignment.



Photo 29: A vacuum breaker with insulated and heated shelter.

- Original clarifier pumps, P-116A/B, did not provide sufficient flowrate when pumping slurries with high solid content, so new hose pumps with enough capacity to ‘shock’ the clarifier were installed. Shocking uses a high flowrate of water to discharge debris and clean the lamella clarifiers.



Picture 30: New hose pump installed on new concrete floor in the 740 building, at the underflow of clarifier.

- Initial design contemplated a remote underwater camera at the diffuser in Roberts Bay to visually monitor that location. After assessment, it was determined the visual data provided would offer very little useful information and a remote underwater camera in the Arctic Ocean would be difficult, and potentially dangerous, to maintain. The operation of the system will be monitored from instrumentation in the outfall discharge building (Area 730), including pressure and flow monitoring. If underwater work is needed, professional, certified, and experienced Arctic divers will be engaged to inspect or maintain the pipeline.
- Heat trace at the outfall was changed from immersion heaters to electric heat trace cable. The design change was initiated due to the impracticality of installing immersion heaters as per the original design. In addition, the redesign is expected to be more reliable during operations.

### 3.6 SCHEDULE D PART 21 - MITIGATION MEASURES

TMAC has a functioning environmental management system composed of numerous management plans that were developed and approved under its NIRB Project Certificate No. 003 and No.009 and, Type A Water Licence 2AM-DOH1335 that apply to all development at Hope Bay.

The following project-specific mitigation measures of note were implemented:

- For construction of Marine Outfall Berm, mitigations listed in Letter of Advice from Department of Fisheries and Oceans Canada, RE: Implementation of mitigation measures to avoid and mitigate serious harm to fish - Marine Outfall Berm - Project Certificate No. 003 Amendment (Doris North Gold Mine Project), issued to TMAC on August 30, 2016. This included minimizing the distance of the turbidity curtain to 25 m from the outfall berm and stopping work if a marine mammal is observed approaching the barrier or has gain entry past the barrier.



- Equipment used in the project stayed in existing or in construction road at all time to prevent damage to the tundra.
- Piping was built adjacent to the road to be accessible in the future while minimizing disturbance to tundra with equipment.
- Silt curtains were used during the construction of the Marine Outfall Berm to prevent impacts to the marine environment.

No additional erosion or sedimentation controls were required for the duration of the construction due to the mitigation measures listed above.

The effectiveness of the mitigation measures is discussed in Section 3.7.

### **3.7 SCHEDULE D PART 2J - MONITORING ACTIVITIES**

Visual monitoring of the construction area was conducted prior to, during, and upon completion of the construction activity. The mitigations in place were effective and no tundra damage or marine mammals were observed. Monitoring will continue to be undertaken in compliance with Part D of the Water Licence.

### **3.8 SCHEDULE D PART 2K - BLAST VIBRATION MONITORING**

For RBDS construction, no quarrying activities were performed in proximity to fish bearing waters, and therefore no blast vibration monitoring was done for the project.

### **3.9 SCHEDULE D PART 2L - MONITORING EROSION PROTECTION MEASURES**

Erosion protection is discussed in Section 3.6.

### **3.10 SCHEDULE D PART 2M - MONITORING OF WATER USE FROM DUST SUPPRESSION**

Dust suppression was not specifically required as part of RBDS construction.

### **3.11 SCHEDULE D PART 2N - MONITORING OF CONTRACTOR'S GROUND IMPACTS**

Since all construction activities were performed from the road, no impacts to tundra were observed. The construction area was visually monitored to confirm.

### **3.12 SCHEDULE D PART 2P - SUMMARY OF QUARRY ROCK SEEPAGE**

The area surrounding the access road and Marine Outfall Berm was included in the 2020 seepage survey. If seepage is observed the results will be included in the 2020 Waste Rock, Quarry and Tailings Monitoring Report, Doris and Madrid North Mines (expected to be issued Q1 2021).

#### **4 REFERENCES**

TMAC Resources Inc., 2017. Hope Bay Project Quarry Management and Monitoring Plan. December 2017.

2019 Waste Rock, Quarry and Tailings Monitoring Report, Doris and Madrid North Mines, Hope Bay Project. SRK Consulting. March 2020



This Report: “Roberts Bay Discharge System – Construction Summary Report” was prepared under the direction of Brendan Barron, P.Eng. Information provided for the compilation of this report was provided from various sources and resources. While every effort has been made to ensure the accuracy of the information contained in the report, errors and omissions contained in source information used to prepare this report will, when discovered, will be brought to the attention of the Nunavut Water Board.




Brendan Barron, P.Eng.  
Project Director  
TMAC Resources Inc.



APPENDIX A  
ISSUED FOR CONSTRUCTION DRAWINGS


Pipeline Alignment (Paterson & Cook)  
730 Outfall Jetty (SRK Consulting)



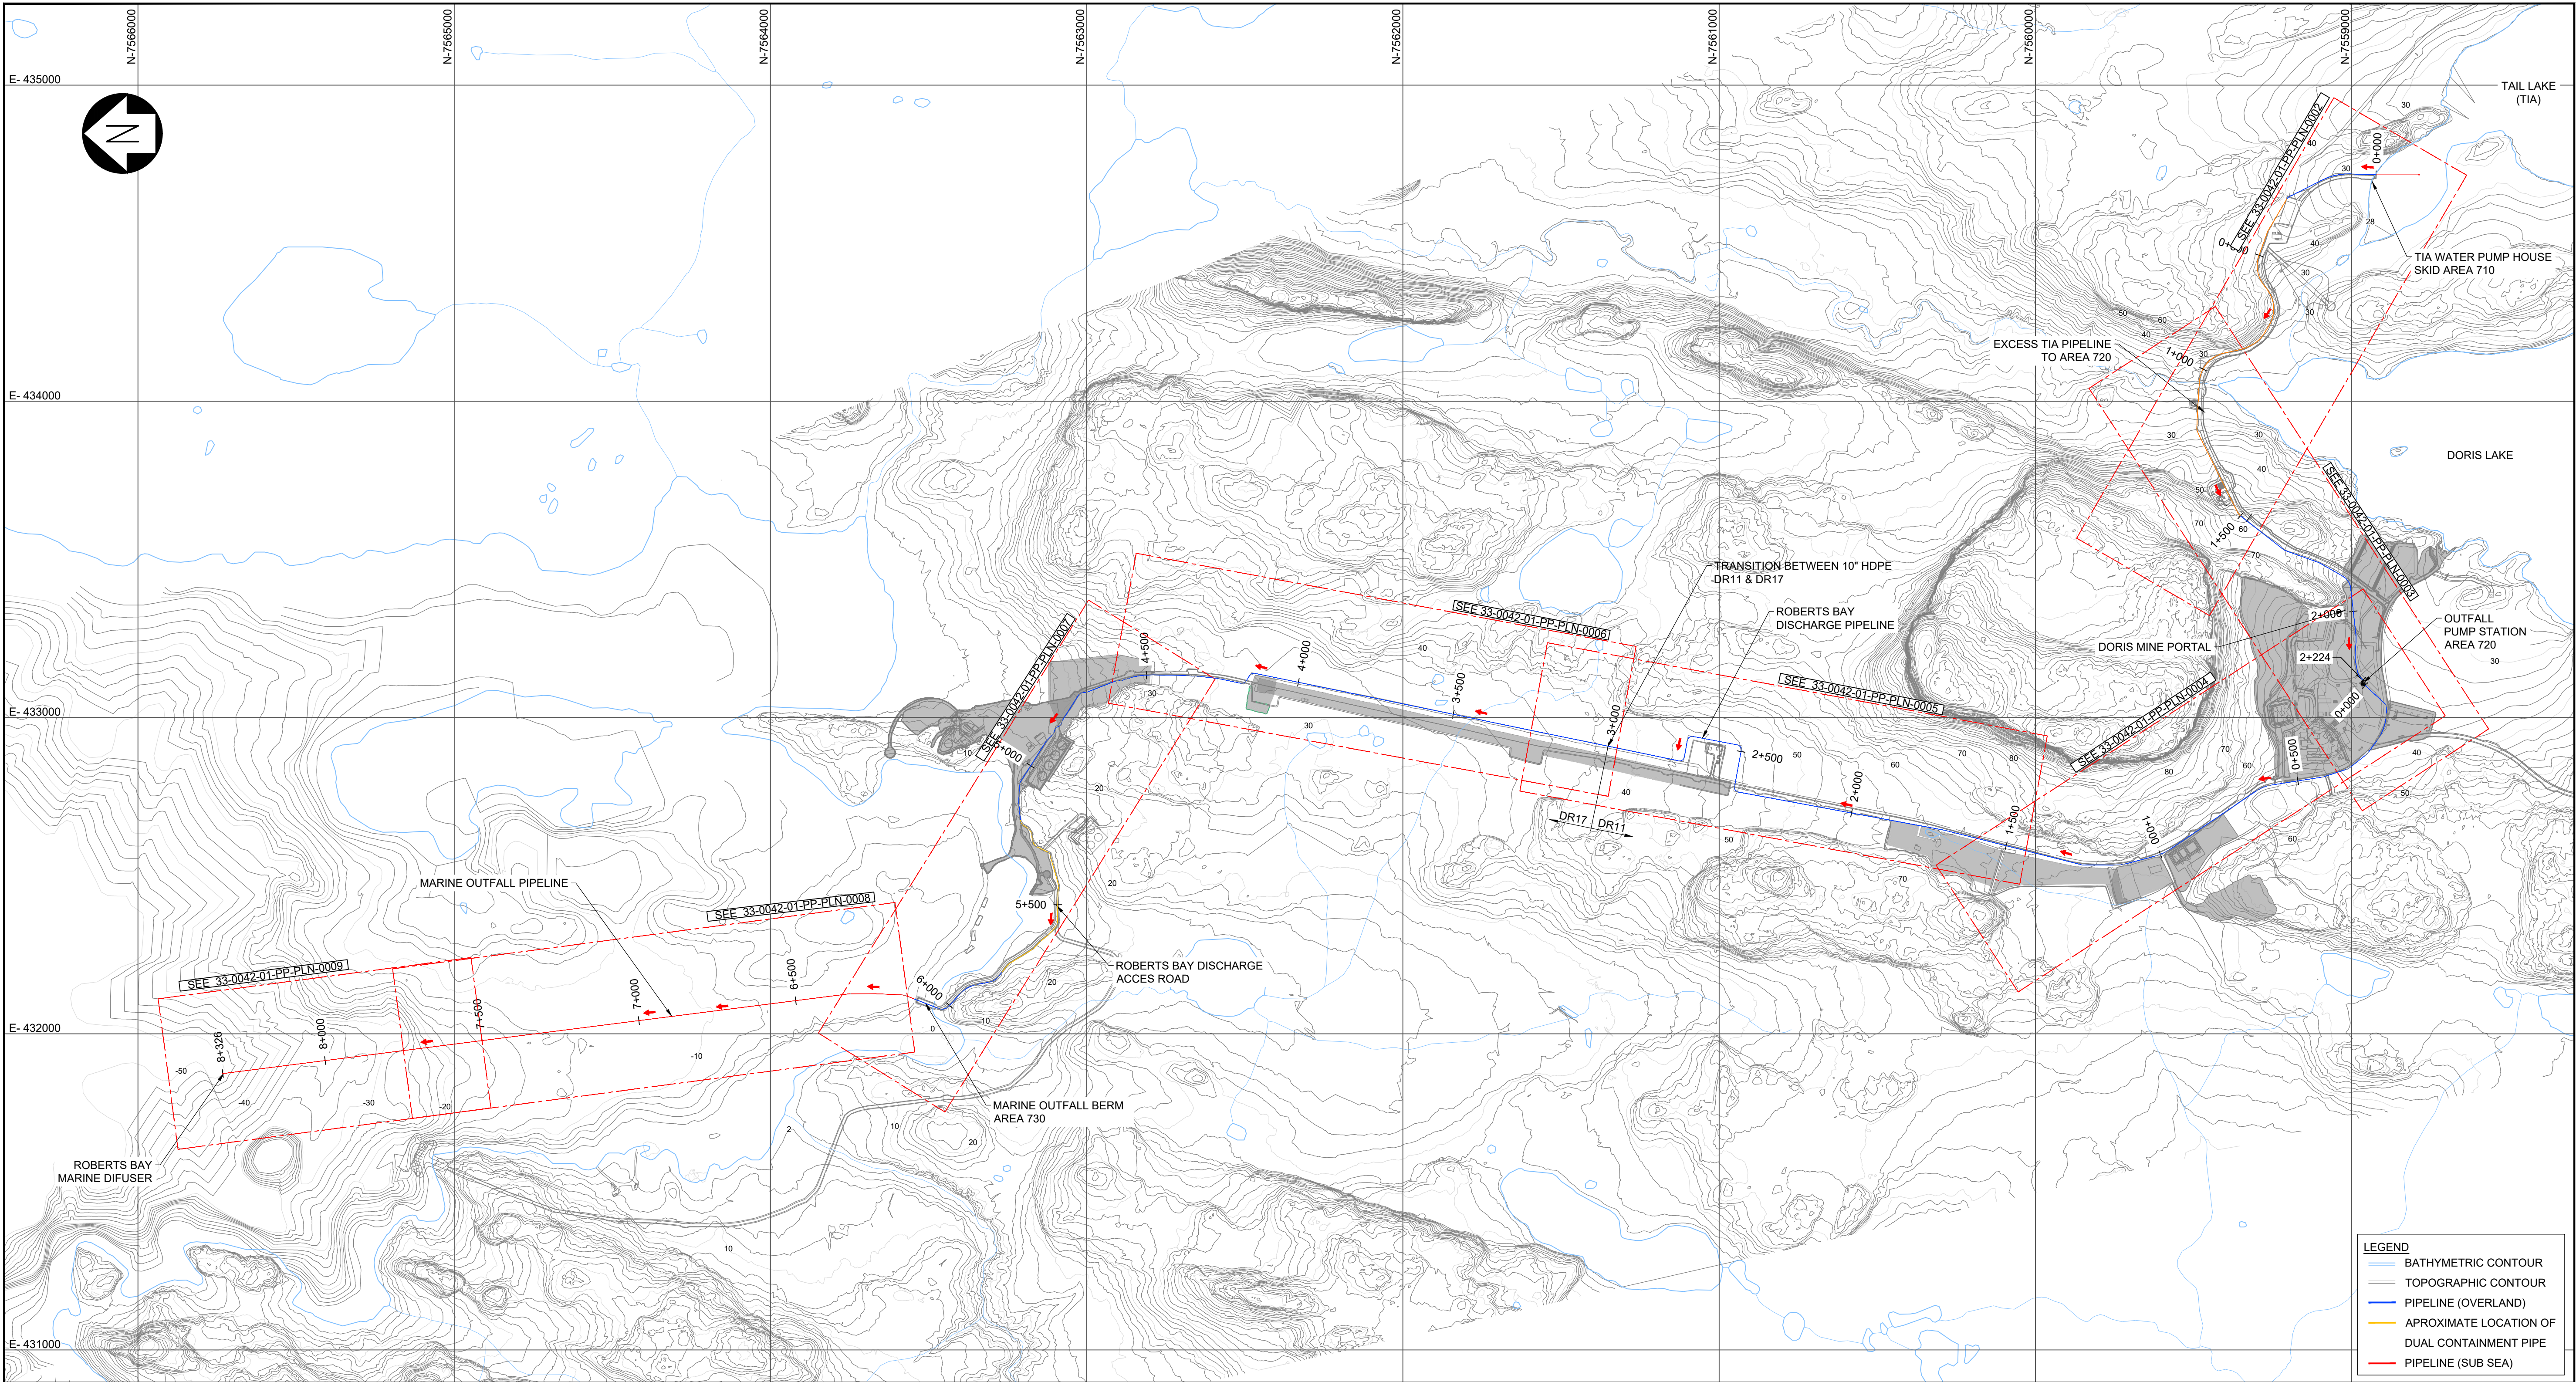


- NOTES
1. ALL DIMENSIONS ARE IN METERS UNLESS OTHERWISE STATED.
  2. TOPOGRAPHY NAD83 UTM ZONE 13.
  3. THE REQUIREMENT OF THE DUAL CONTAINMENT PIPE END SEALS SHALL BE DETERMINED BY OTHERS. P&C SHALL NOT BE RESPONSIBLE FOR ANY OMISSION OR DEVIATION FROM ANY ENVIRONMENTAL REQUIREMENTS.
  4. PIPELINE SHALL BE JOINED USING FUSION WELDING IN ACCORDANCE WITH ASME B31.3 AND ASME SEC. IX WELDING QUALIFICATION. ALL WELDS SHALL BE 100% VISUALLY INSPECTED AND 100% VOLUMETRIC NON-DESTRUCTIVE TESTED USING UT/PAUT OR OTFD.

ROBERTS BAY DISCHARGE SYSTEM - MASTER SITE PLAN  
SCALE 1:10000

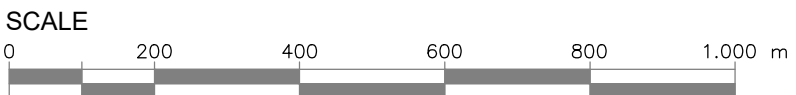

																																																																																																																																																																																																																																																																																																																																																																																																																																																																																																																																																																																																																																																																																																																																																																																																																																																																																																																																																																																																																																																																																																																																																																																																																																																																																																																																																																																																																															</
--	--	----



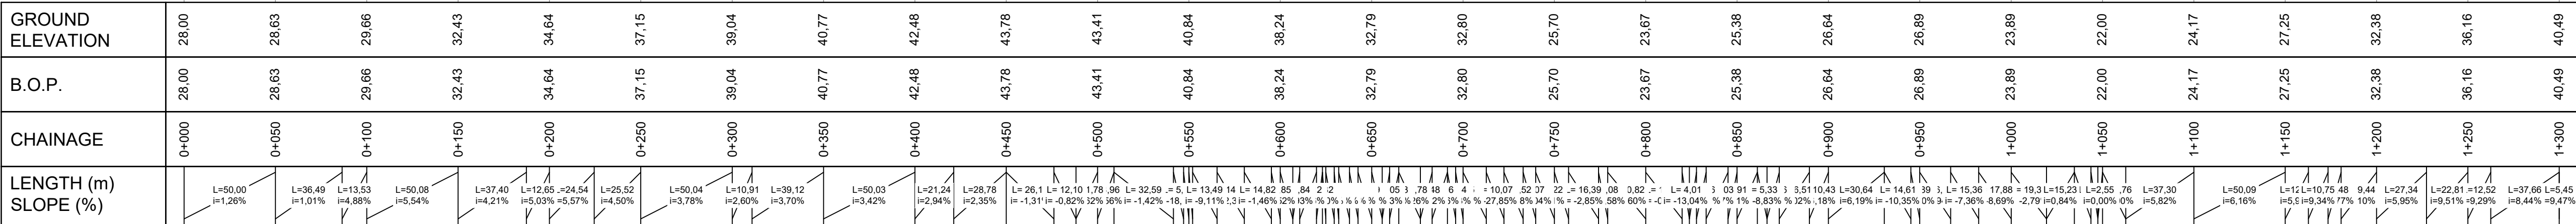


SCALE H 1:2000  
V 1:500


1. ALL DIMENSIONS ARE IN METERS UNLESS OTHERWISE STATED.
2. TOPOGRAPHY NAD83 UTM ZONE 13.
3. THE REQUIREMENT OF THE DUAL CONTAINMENT PIPE END SEALS SHALL BE DETERMINED BY OTHERS. P&C SHALL NOT BE RESPONSIBLE FOR ANY OMISSION OR DEVIATION FROM ANY ENVIRONMENTAL REQUIREMENTS.
4. PIPELINE SHALL BE JOINED USING FUSION WELDING IN ACCORDANCE WITH ASME B31.3 AND ASME SECC. IX WELDING QUALIFICATION. ALL WELDS SHALL BE 100% VISUALLY INSPECTED AND 100% VOLUMETRIC NON-DESTRUCTIVE TESTED USING UT/PAUT OR OTFD.

[illegible]



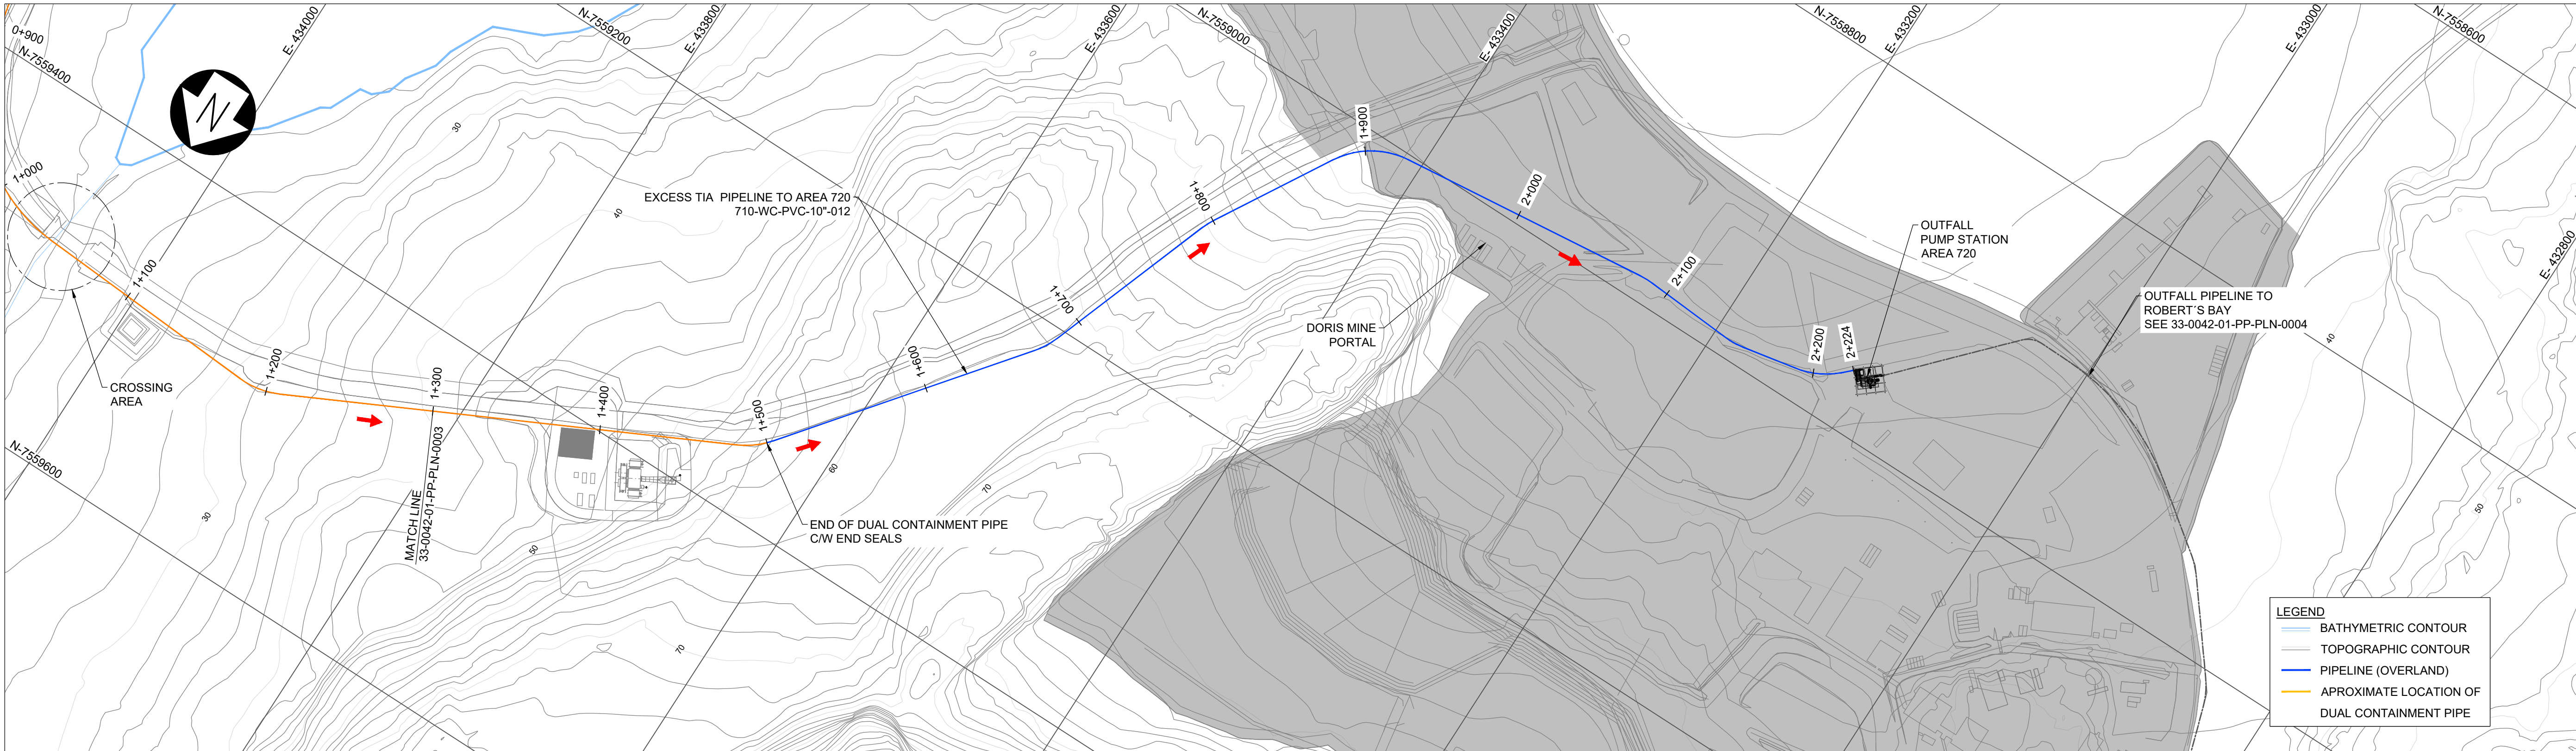

ALIGNMENT - PLAN VIEW  
SCALE 1:2000

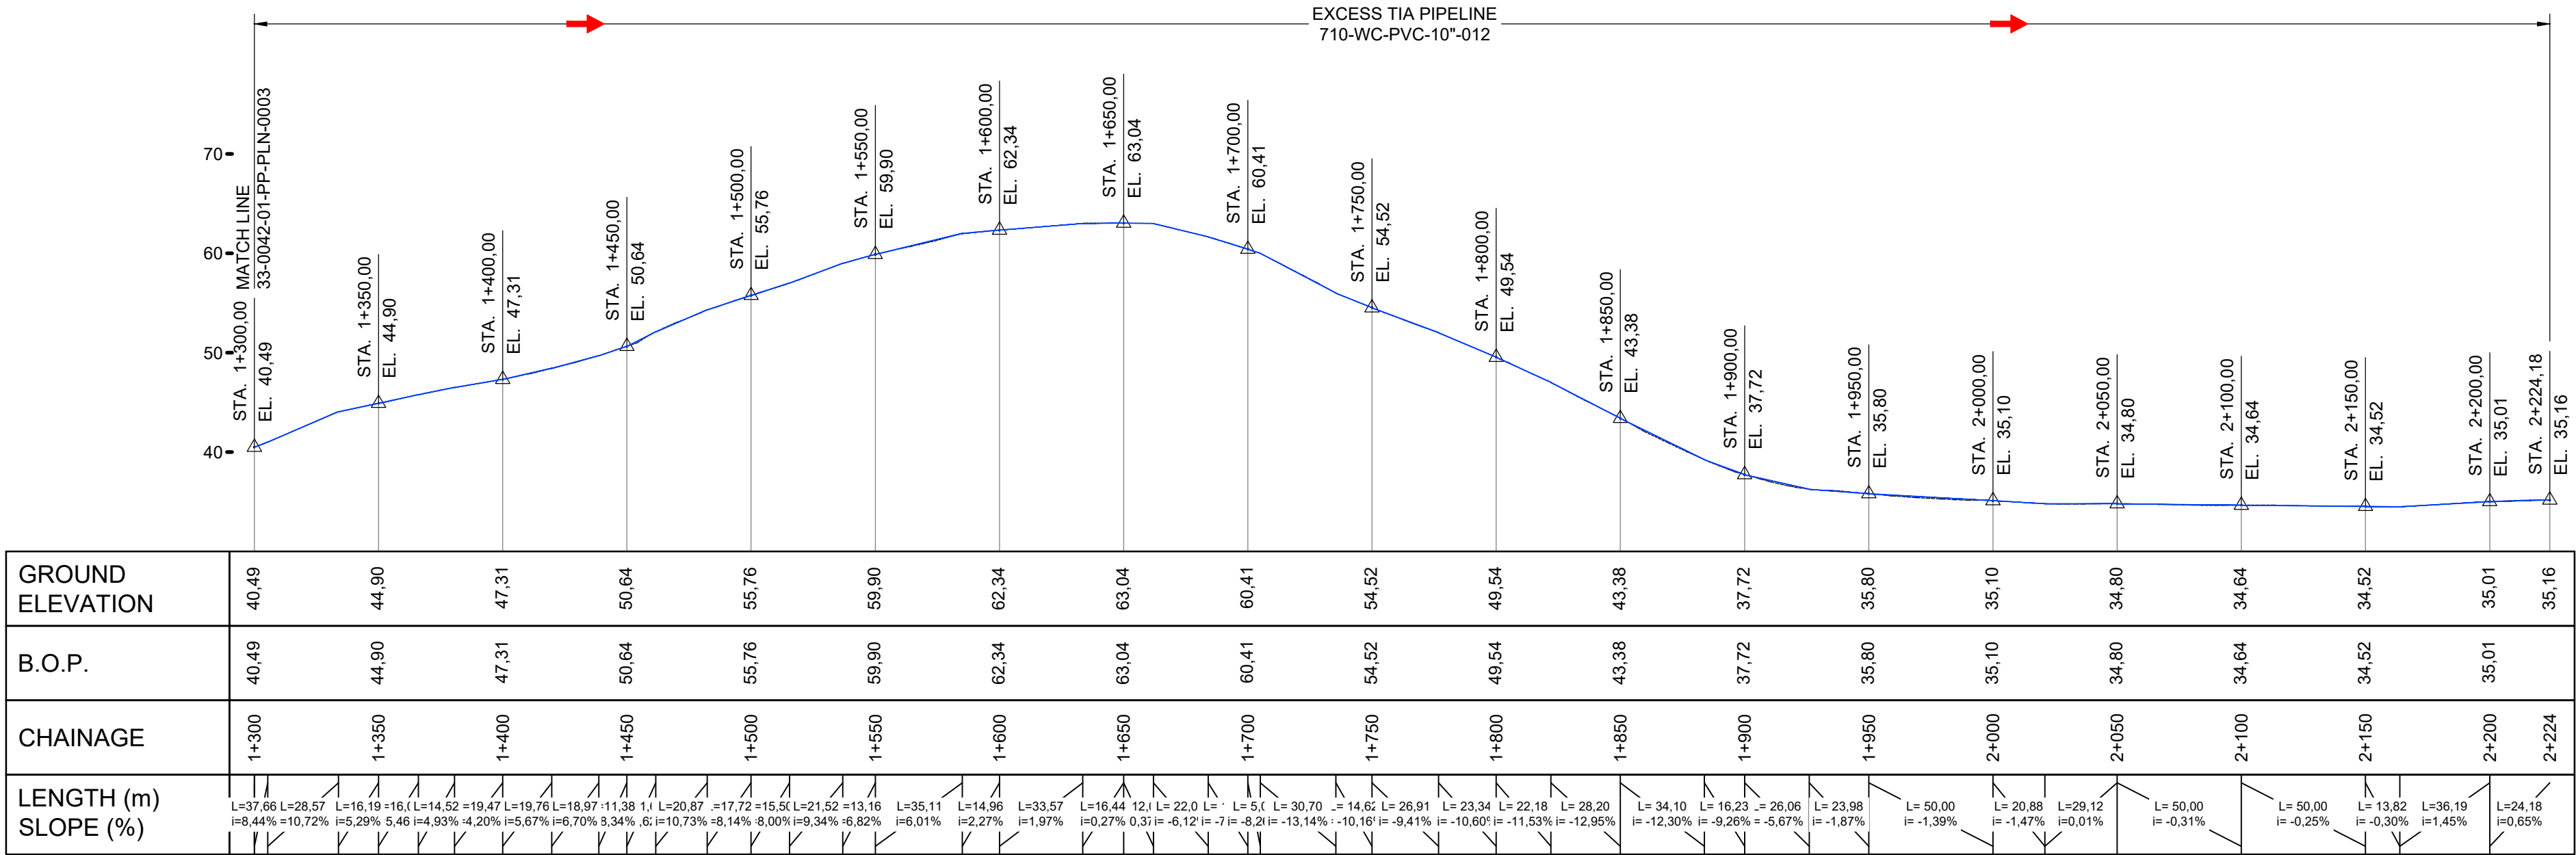

ALIGNMENT - PROFILE  
SCALE H 1:2000  
V 1:500

- NOTES
1. ALL DIMENSIONS ARE IN METERS UNLESS OTHERWISE STATED.
  2. TOPOGRAPHY NAD83 UTM ZONE 13.
  3. THE REQUIREMENT OF THE DUAL CONTAINMENT PIPE END SEALS SHALL BE DETERMINED BY OTHERS. P&C SHALL NOT BE RESPONSIBLE FOR ANY OMISSION OR DEVIATION FROM ANY ENVIRONMENTAL REQUIREMENTS.
  4. PIPELINE SHALL BE JOINED USING FUSION WELDING IN ACCORDANCE WITH ASME B31.3 AND ASME SEC. IX WELDING QUALIFICATION. ALL WELDS SHALL BE 100% VISUALLY INSPECTED AND 100% VOLUMETRIC NON-DESTRUCTIVE TESTED USING UT/PAUT OR OTFD.

												Engineer's Stamp		CLIENT		<div><div><div></div><div>PATERSON &amp; COOKE</div><div>PATERSON &amp; COOKE CANADA INC. 306-595 HOWE STREET VANCOUVER, BRITISH COLUMBIA, CANADA TEL : 604-687-7704 WWW.PATERSONCOOKE.COM COPYRIGHT RESERVED PATERSON &amp; COOKE</div></div><div><div>HOPE BAY WATER DISCHARGE</div><div>OUTFALL DISCHARGE SYSTEM EXCESS TIA PIPELINE PLAN VIEW AND PROFILE (STA 1+300 TO STA 2+224,18)</div></div></div>	
33-0042-00-PP-PLN-0001		EXCESS TIA WATER AND OUTFALL PIPELINE - MASTER SITE PLAN		0		27-08-2018		ISSUED FOR DESIGN		MJ		AZ		NB			
Drawing No.		Description		Rev.		Date		Description		Originator		Drawn		Checked			
Reference Drawings								Revisions									






NOTES

1. ALL DIMENSIONS ARE IN METERS UNLESS OTHERWISE STATED.
2. TOPOGRAPHY NAD83 UTM ZONE 13.
3. THE REQUIREMENT OF THE DUAL CONTAINMENT PIPE END SEALS SHALL BE DETERMINED BY OTHERS. P&C SHALL NOT BE RESPONSIBLE FOR ANY OMISSION OR DEVIATION FROM ANY ENVIRONMENTAL REQUIREMENTS.
4. PIPELINE SHALL BE JOINED USING FUSION WELDING IN ACCORDANCE WITH ASME B31.3 AND ASME SEC. IX WELDING QUALIFICATION. ALL WELDS SHALL BE 100% VISUALLY INSPECTED AND 100% VOLUMETRIC NON-DESTRUCTIVE TESTED USING UT/PAUT OR OTFD.

[illegible]



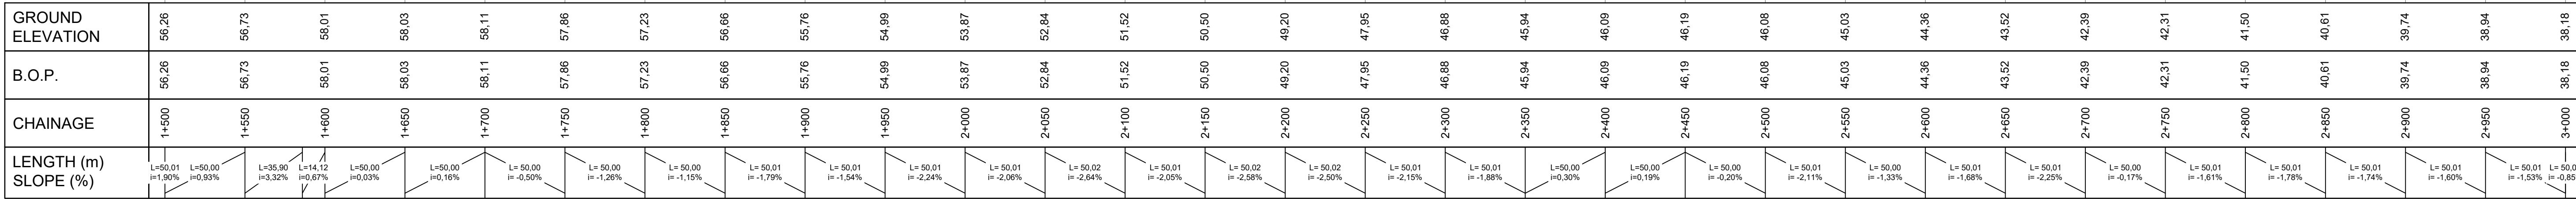


# ALIGNMENT - PROFILE



SCALE H 1:2000  
V 1:500

[illegible]



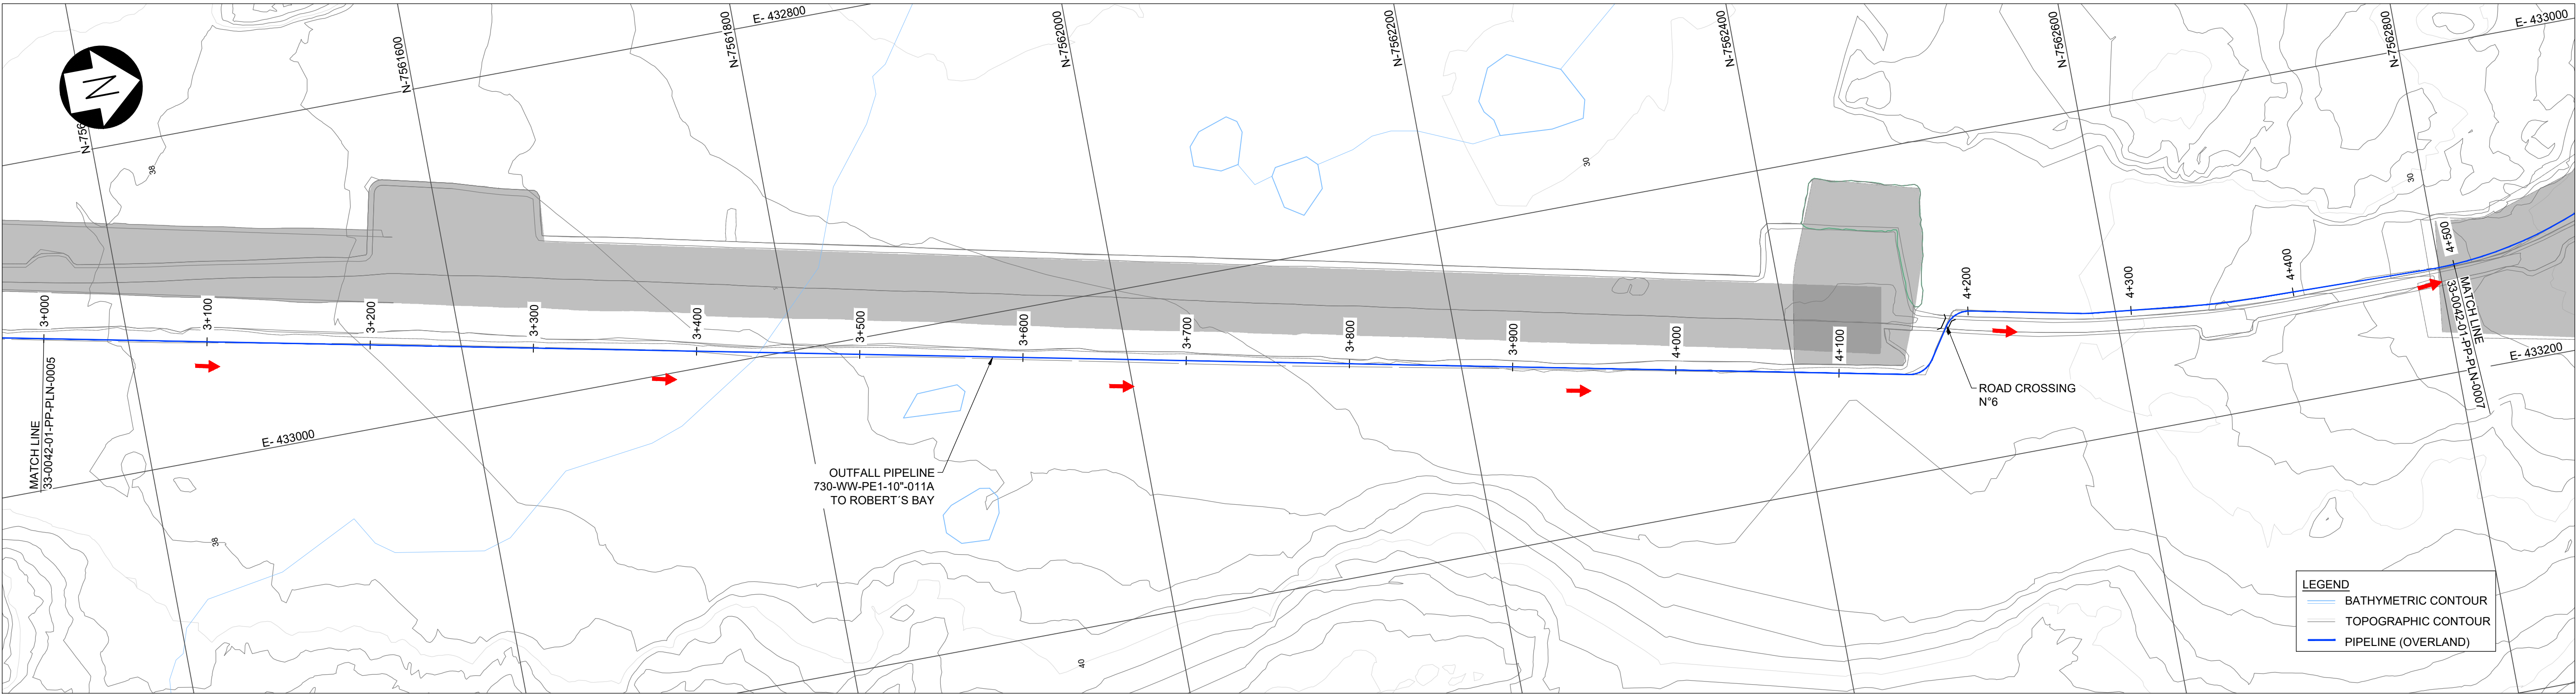

ALIGNMENT - PLAN VIEW  
SCALE 1:2000

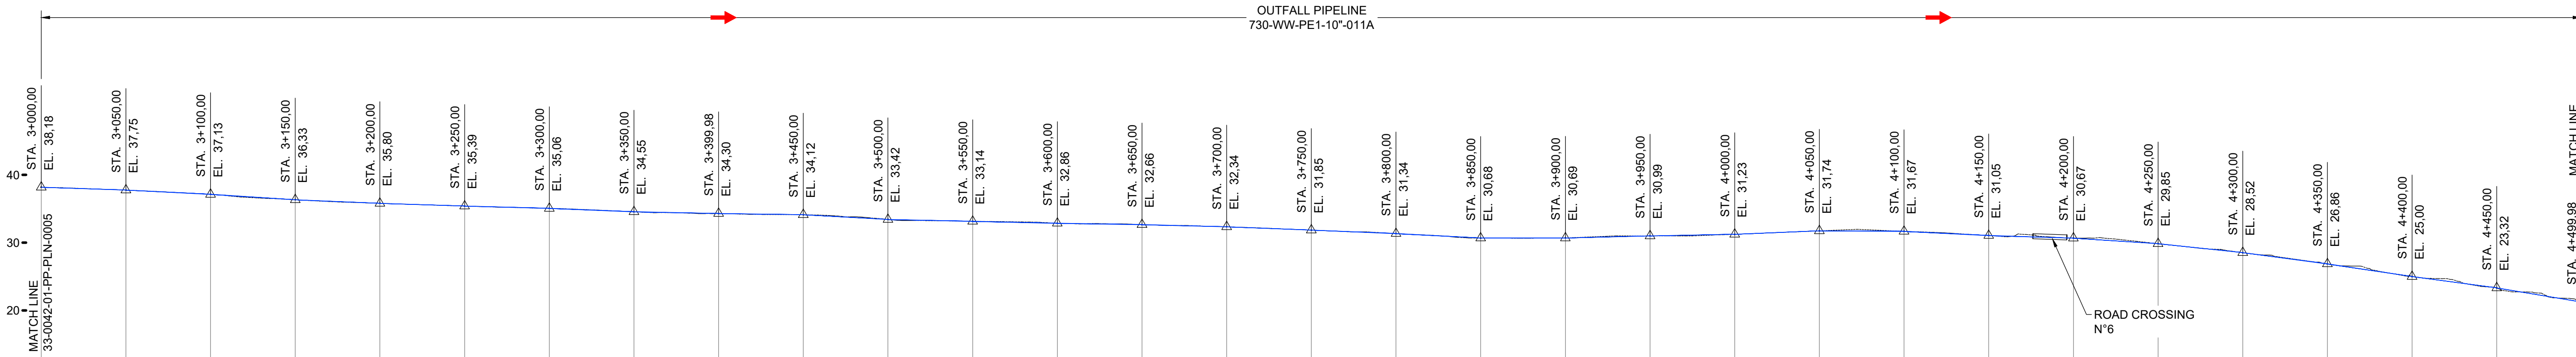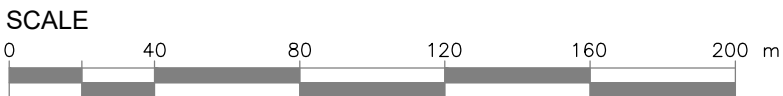

GROUND ELEVATION	38.18	37.75	37.13	36.33	35.80	35.39	35.06	34.55	34.30	34.12	33.42	33.14	32.86	32.66	32.34	31.85	31.34	30.68	30.69	30.99	31.23	31.74	31.67	31.05	30.67	29.85	28.52	26.86	25.00	23.32	21.23	
B.O.P.	38.18	37.75	37.13	36.33	35.80	35.39	35.06	34.55	34.30	34.12	33.42	33.14	32.86	32.66	32.34	31.85	31.34	30.68	30.69	30.99	31.23	31.74	31.67	31.05	30.67	29.85	28.52	26.86	25.00	23.32	21.23	
CHAINAGE	3+000	3+050	3+100	3+150	3+200	3+250	3+300	3+350	3+400	3+450	3+500	3+550	3+600	3+650	3+700	3+750	3+800	3+850	3+900	3+950	4+000	4+050	4+100	4+150	4+200	4+250	4+300	4+350	4+400	4+450	4+500	
LENGTH (m) SLOPE (%)	L= 50.01 I= -1.53%	L= 50.00 I= -0.85%	L= 50.00 I= -1.25%	L= 50.01 I= -1.60%	L= 50.00 I= -1.05%	L= 50.00 I= -0.82%	L= 50.00 I= -0.67%	L= 50.00 I= -1.01%	L= 49.98 I= -0.51%	L= 50.02 I= -0.36%	L= 50.00 I= -1.39%	L= 50.00 I= -0.56%	L= 50.00 I= -0.57%	L= 50.00 I= -0.40%	L= 50.00 I= -0.63%	L= 50.01 I= -0.99%	L= 50.00 I= -1.02%	L= 50.00 I= -1.32%	L= 50.00 I= 0.03%	L= 50.00 I= 0.60%	L= 50.00 I= 0.47%	L= 50.00 I= 1.01%	L= 50.00 I= -0.14%	L= 50.00 I= -1.23%	L= 50.00 I= -0.77%	L= 50.01 I= -1.63%	L= 50.02 I= -2.66%	L= 50.03 I= -3.32%	L= 50.03 I= -3.73%	L= 50.03 I= -3.35%	L= 50.02 I= -4.18%	L= 50.00 I= -4.93%

ALIGNMENT - PROFILE  
SCALE H 1:2000  
V 1:500

- NOTES
- ALL DIMENSIONS ARE IN METERS UNLESS OTHERWISE STATED.
  - TOPOGRAPHY NAD83 UTM ZONE 13.
  - THE REQUIREMENT OF THE DUAL CONTAINMENT PIPE END SEALS SHALL BE DETERMINED BY OTHERS. P&C SHALL NOT BE RESPONSIBLE FOR ANY OMISSION OR DEVIATION FROM ANY ENVIRONMENTAL REQUIREMENTS.
  - PIPELINE SHALL BE JOINED USING FUSION WELDING IN ACCORDANCE WITH ASME B31.3 AND ASME SEC. IX WELDING QUALIFICATION. ALL WELDS SHALL BE 100% VISUALLY INSPECTED AND 100% VOLUMETRIC NON-DESTRUCTIVE TESTED USING UT/PAUT OR OTFD.

												Engineer's Stamp		<div>CLIENT</div> <div></div>		<div> <b>PATERSON &amp; COOKE</b></div> <div>PATERSON &amp; COOKE CANADA INC. 306-595 HOWE STREET VANCOUVER, BRITISH COLUMBIA, CANADA TEL : 604-687-7704 WWW.PATERSONCOOKE.COM COPYRIGHT RESERVED PATERSON &amp; COOKE</div>		<div>HOPE BAY WATER DISCHARGE</div> <div>OUTFALL DISCHARGE SYSTEM OUTFALL PIPELINE PLAN VIEW AND PROFILE (STA 3+000 TO STA 4+500)</div>					
33-0042-00-PP-PLN-0001		EXCESS TIA WATER AND OUTFALL PIPELINE - MASTER SITE PLAN		0		27-08-2018		ISSUED FOR DESIGN		MJ		AZ		NB									
Drawing No.		Description		Rev.		Date		Description		Originator		Drawn		Checked									
Reference Drawings				Revisions																			





NOTES

1. ALL DIMENSIONS ARE IN METERS UNLESS OTHERWISE STATED.
2. TOPOGRAPHY NAD83 UTM ZONE 13.
3. THE REQUIREMENT OF THE DUAL CONTAINMENT PIPE END SEALS SHALL BE DETERMINED BY OTHERS. P&C SHALL NOT BE RESPONSIBLE FOR ANY OMISSION OR DEVIATION FROM ANY ENVIRONMENTAL REQUIREMENTS.
4. PIPELINE SHALL BE JOINED USING FUSION WELDING IN ACCORDANCE WITH ASME B31.3 AND ASME SEC. IX WELDING QUALIFICATION. ALL WELDS SHALL BE 100% VISUALLY INSPECTED AND 100% VOLUMETRIC NON-DESTRUCTIVE TESTED USING UT/PAUT OR OTFD.

[illegible]






33-0042-00-PP-PLN-0001	EXCESS TIA WATER AND OUTFALL PIPELINE - MASTER SITE PLAN	0	27-08-2018	ISSUED FOR DESIGN	MJ	AZ	NB
Drawing No.	Description	Rev.	Date	Description	Originator	Drawn	Checked
Reference Drawings		Revisions					


Scale	Document No							
	Off. Code	Proj. Code	Area Code	Disc. Code	Doc. Type	Unique. No	Sheet No	Rev.
ANSI D	33	0042	00	PP	PLN	0008	5 OF 6	0



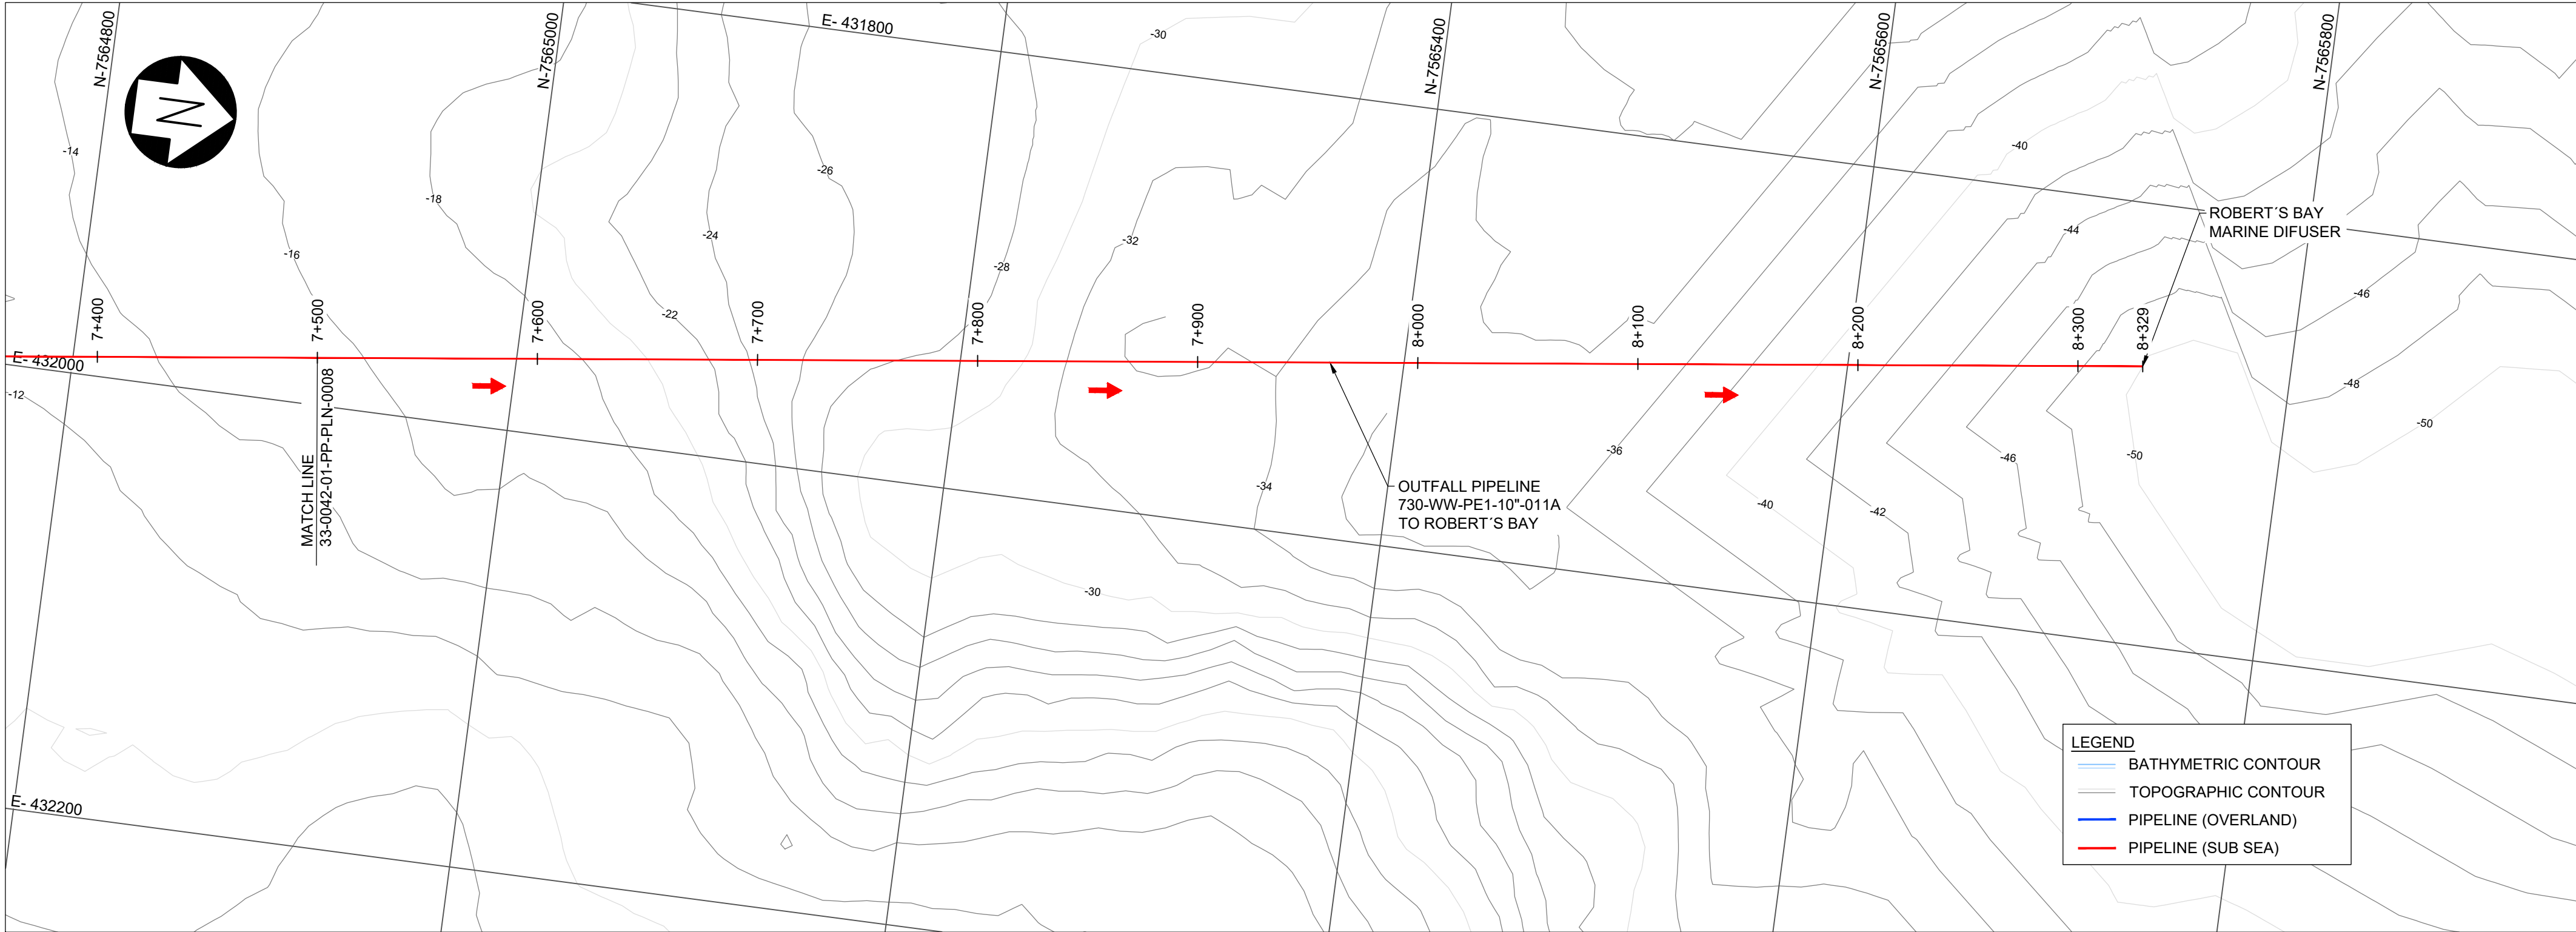

ALIGNMENT - PLAN VIEW

SCALE 1:2000

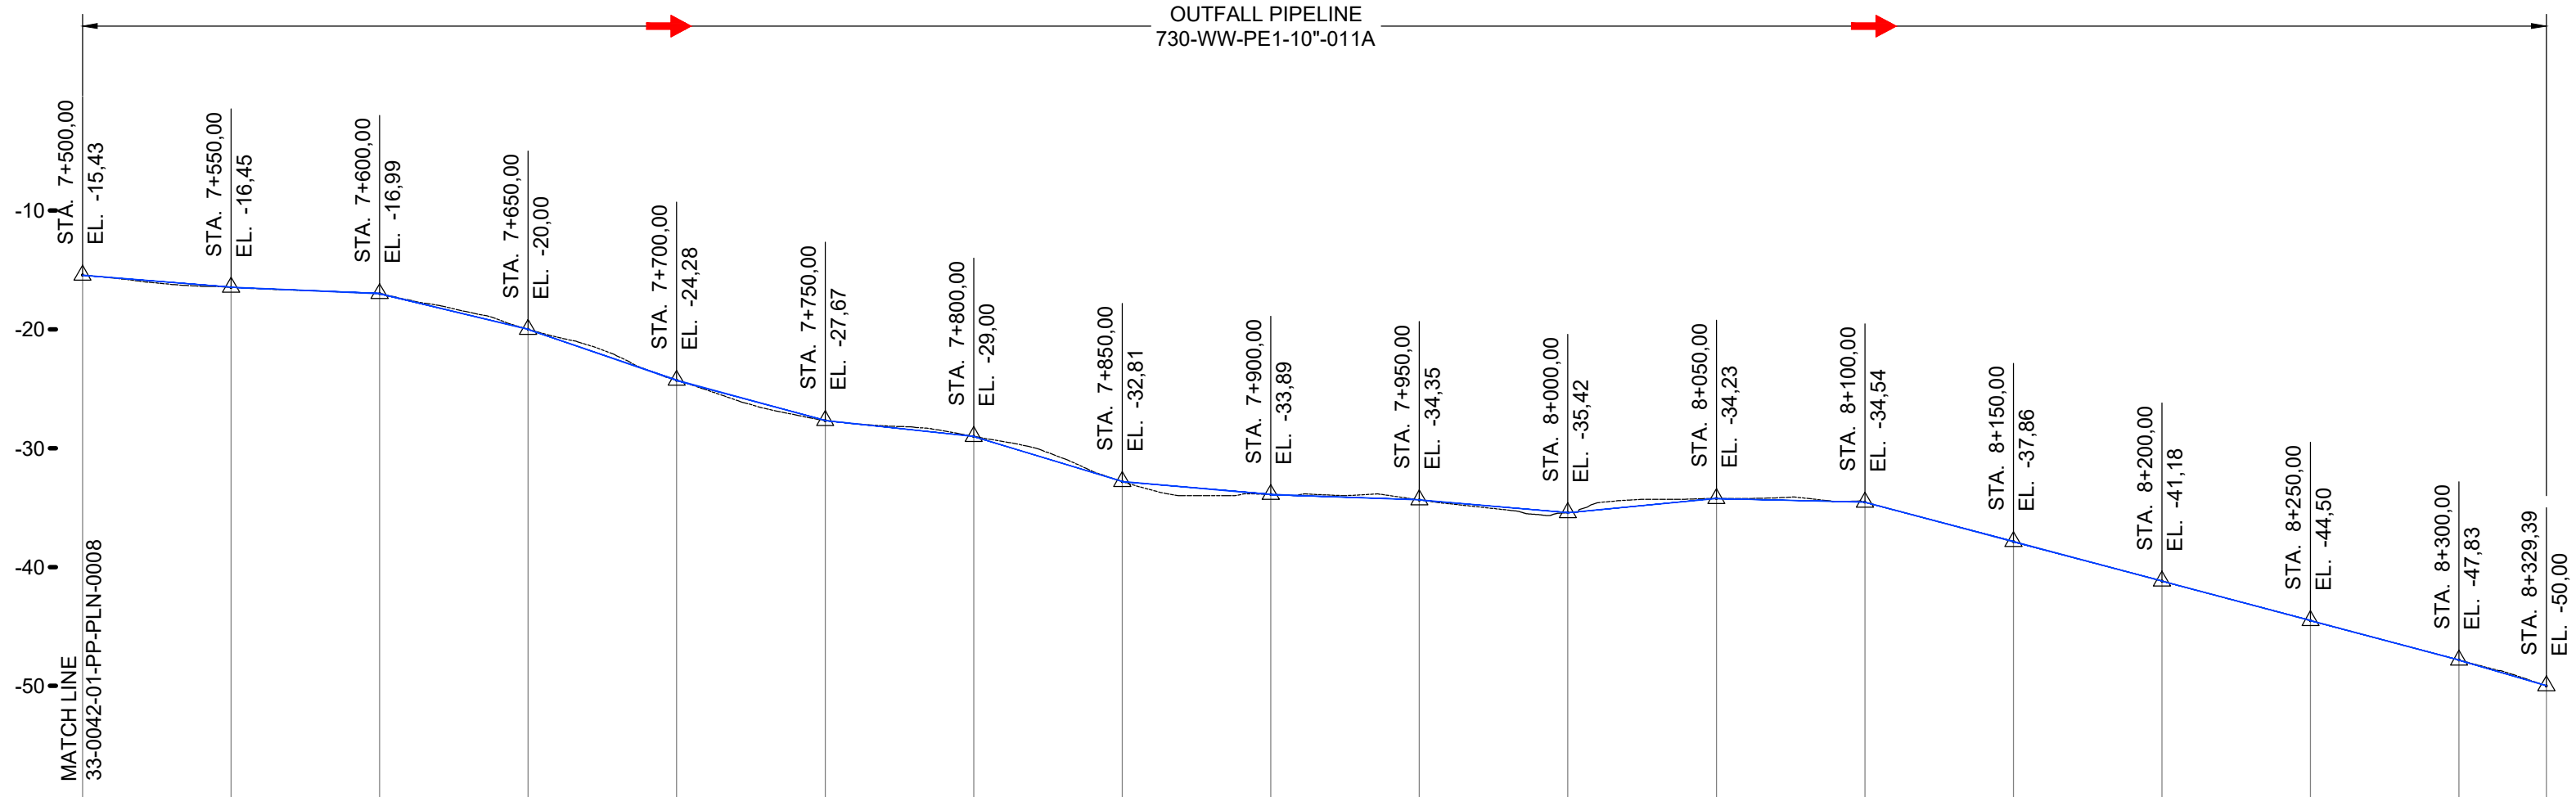

GROUND ELEVATION	-15.43	-16.45	-16.99	-20.00	-24.28	-27.67	-29.00	-32.81	-33.89	-34.35	-35.42	-34.23	-34.54	-37.86	-41.18	-44.50	-47.83	-50.00
B.O.P.	-15.43	-16.45	-16.99	-20.00	-24.28	-27.67	-29.00	-32.81	-33.89	-34.35	-35.42	-34.23	-34.54	-37.86	-41.18	-44.50	-47.83	-50.00
CHAINAGE	7+500	7+550	7+600	7+650	7+700	7+750	7+800	7+850	7+900	7+950	8+000	8+050	8+100	8+150	8+200	8+250	8+300	8+329
LENGTH (m)	L= 50.00	L= 50.01	L= 50.00	L= 50.09	L= 50.18	L= 50.11	L= 50.02	L= 50.14	L= 50.01	L= 50.00	L= 50.01	L= 50.01	L= 50.00	L= 50.11	L= 50.11	L= 50.11	L= 50.11	L= 29.47
SLOPE (%)	I= -1.29%	I= -2.04%	I= -1.08%	I= -4.01%	I= -8.57%	I= -6.77%	I= -2.67%	I= -7.61%	I= -2.16%	I= -4.91%	I= -2.15%	I= 2.39%	I= -0.65%	I= -6.64%	I= -6.64%	I= -6.64%	I= -6.64%	I= -7.38%

ALIGNMENT - PROFILE

SCALE H 1:2000

V 1:500

- NOTES
- ALL DIMENSIONS ARE IN METERS UNLESS OTHERWISE STATED.
  - TOPOGRAPHY NAD83 UTM ZONE 13.
  - THE REQUIREMENT OF THE DUAL CONTAINMENT PIPE END SEALS SHALL BE DETERMINED BY OTHERS. P&C SHALL NOT BE RESPONSIBLE FOR ANY OMISSION OR DEVIATION FROM ANY ENVIRONMENTAL REQUIREMENTS.
  - PIPELINE SHALL BE JOINED USING FUSION WELDING IN ACCORDANCE WITH ASME B31.3 AND ASME SEC. IX WELDING QUALIFICATION. ALL WELDS SHALL BE 100% VISUALLY INSPECTED AND 100% VOLUMETRIC NON-DESTRUCTIVE TESTED USING UT/PAUT OR OTFD.

--	--	



# Doris North Project

## Engineering Drawings for Roberts Bay Marine Outfall Berm

Drawing Number	Drawing Title	Issue	Date	Revision	Old / Replaced Revisions
RMOB-01	General Arrangements	Issued for Construction	May 10, 2018	0	
RMOB-02	Plan and Profile	Issued for Construction	May 16, 2018	0	
RMOB-03	Pipe Ramp	Issued for Construction	May 10, 2018	0	
RMOB-04	Geogrid Layout Pattern	Issued for Construction	May 10, 2018	0	
RMOB-05	Schedule of Quantities	Issues for Construction	May 10, 2018	0	



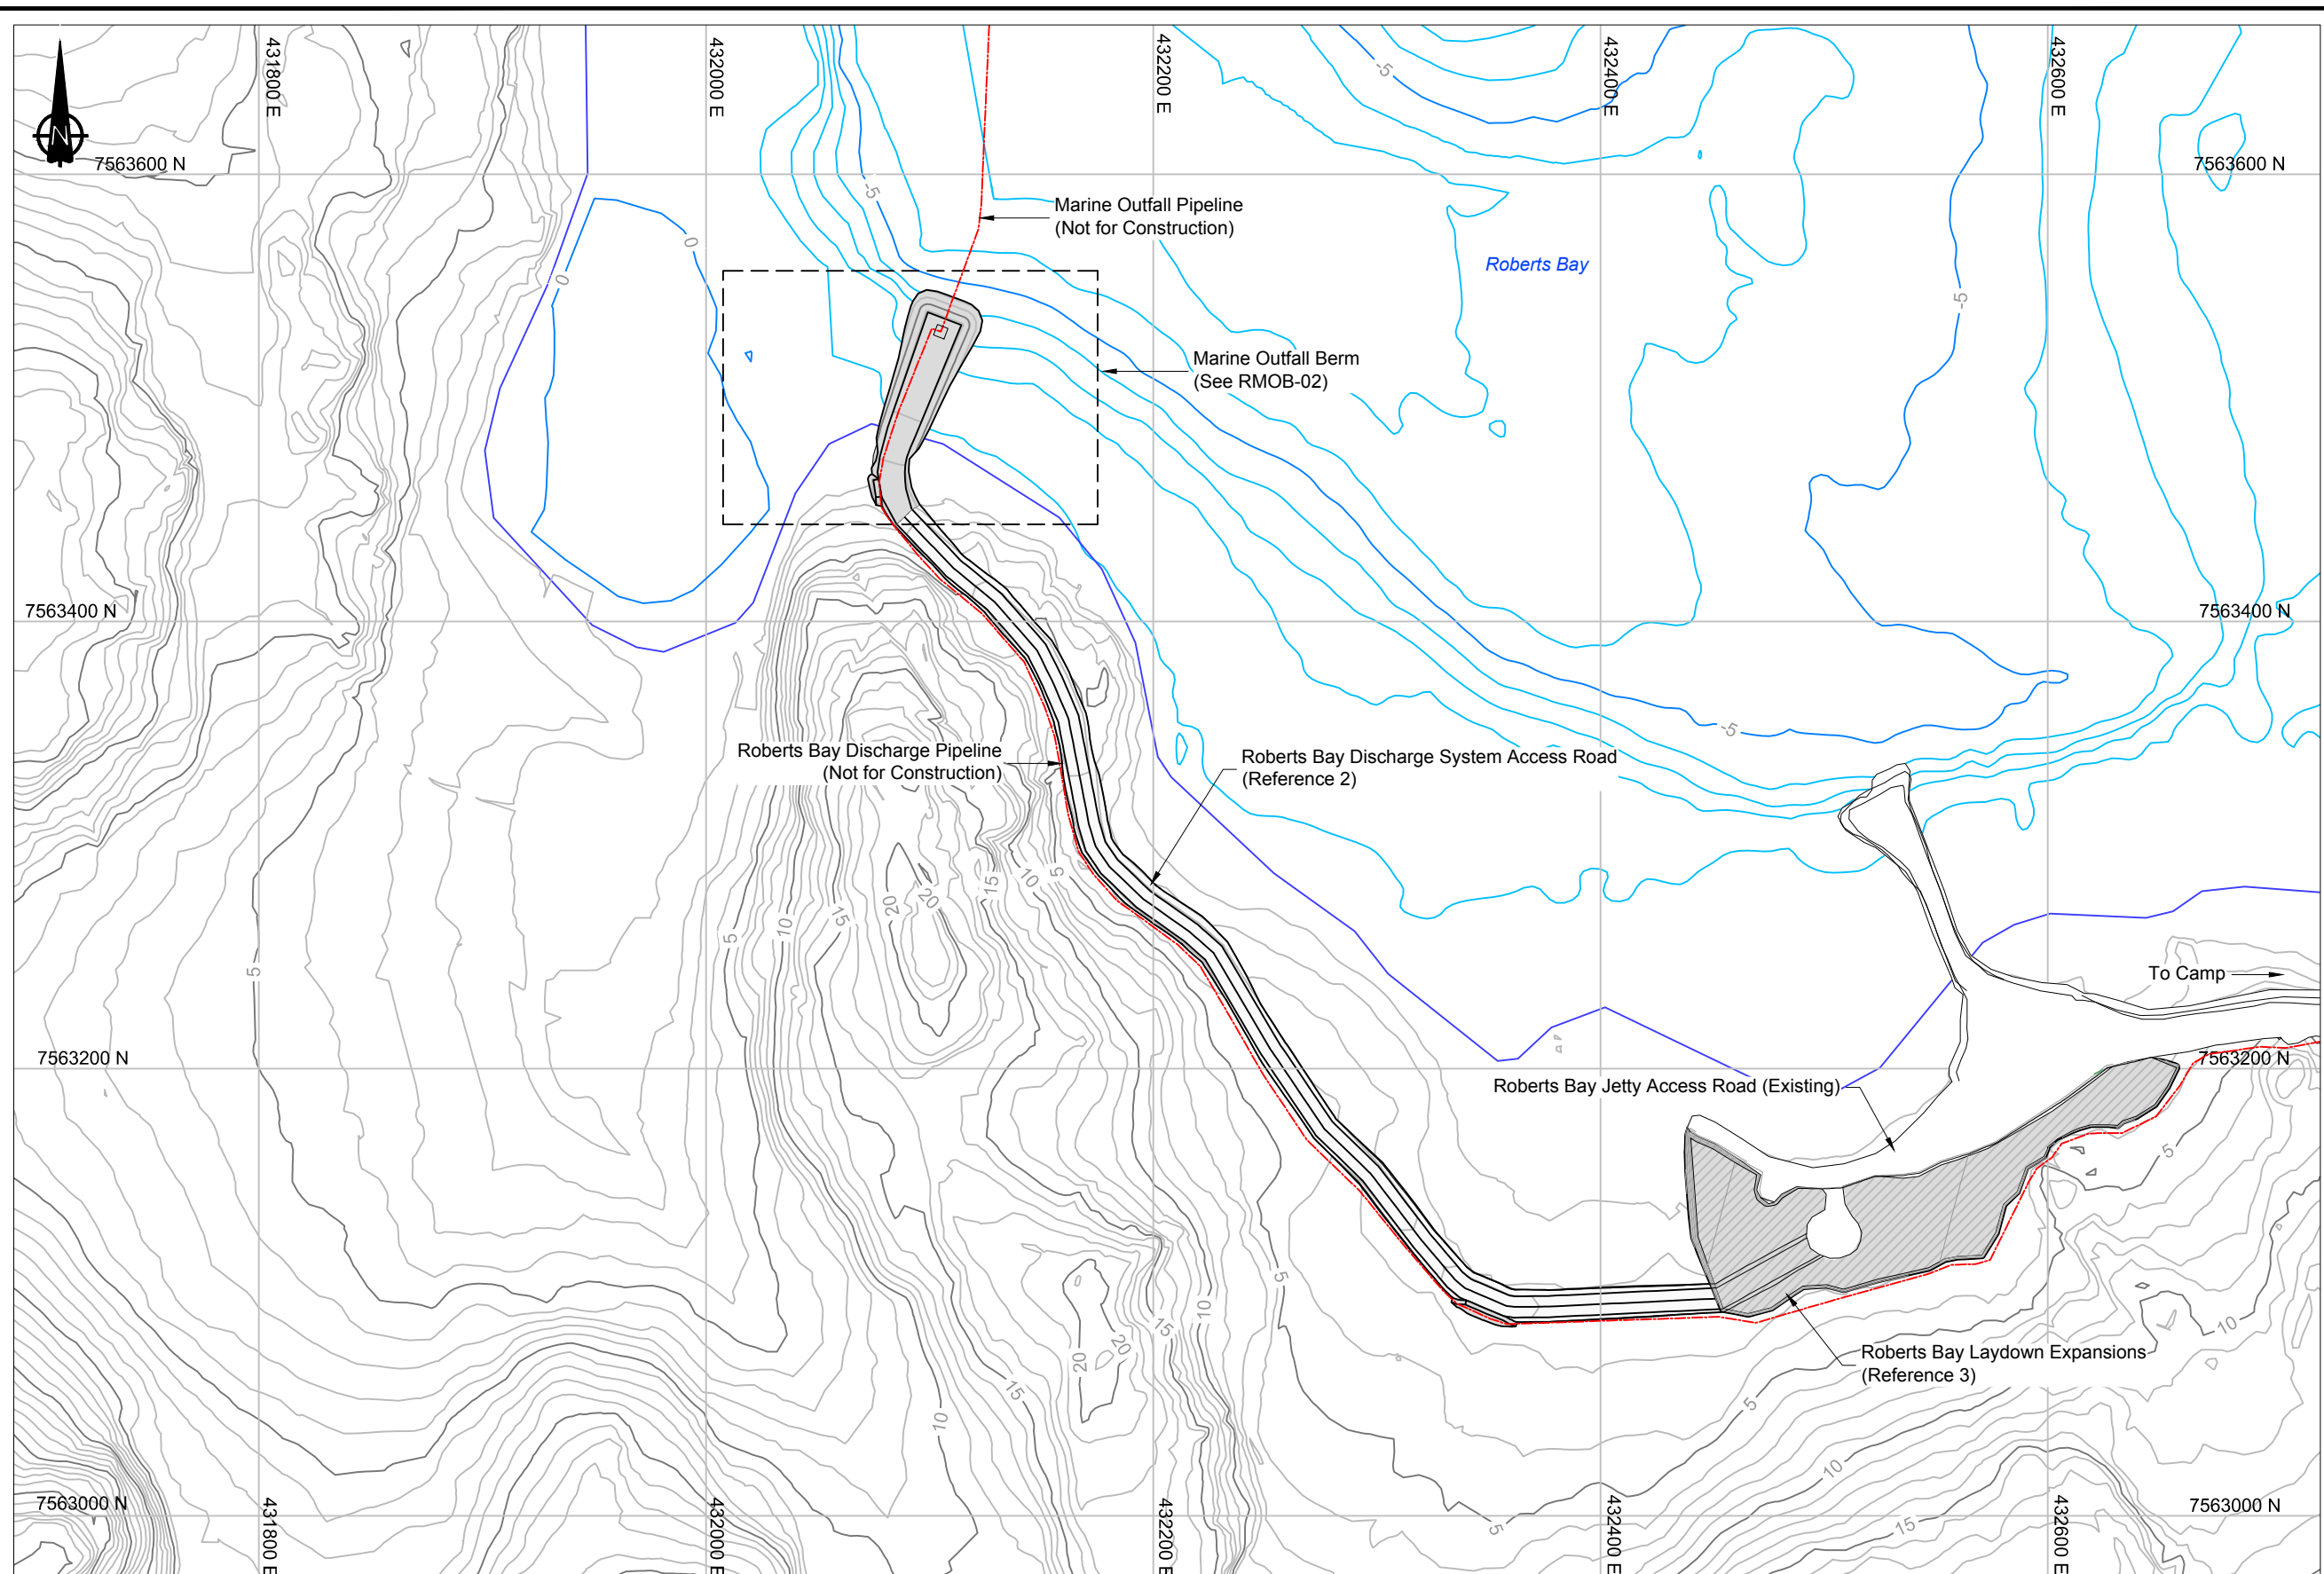

## LEGEND


-  Bathymetric Contour  
 Topographic Contour  
 Discharge Pipeline

## NOTES

1. All dimensions are in meters unless otherwise stated.
2. Contours shown at 1.0m intervals.

## REFERENCES

1. NAD83 UTM Zone 13.
2. SRK Consulting (Canada) Inc., 2018  
Engineering Drawings for the Roberts Bay  
Discharge System Access Road. Doris  
North Project, Nunavut, Canada. Issued  
for Construction. Drawings prepared for  
Hope Bay Mining Limited. Project number  
1CT022.030. January 30, 2018.
3. SRK Consulting (Canada) Inc., 2011.  
Engineering Drawings for the Roberts Bay  
Laydown Expansions, Doris North Project,  
Nunavut, Canada. Water License  
Amendment. Revision A. Issued for  
Discussion. Drawings prepared for Hope  
Bay Mining Limited. Project Number  
1CH008.049. June 13, 2011.

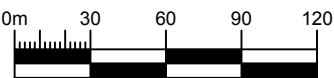[illegible]

Original Drawings  
Stamped and  
Signed by Engineer

This drawing is uncontrolled when printed unless stamped and signed with original ink and recorded on a Distribution Register.

PROFESSIONAL ENGINEERS STAMP



DESIGN:	CH	DRAWN:	TAH	REVIEWED:	
CHECKED:		APPROVED:		DATE:	2018/05/10
FILE NAME:	1CT022.002 MOB-GA.dwg				



HOPE BAY PROJECT

SRK JOB NO.: 1CT022.002

## Roberts Bay Marine Outfall Berm

DRAWING TITLE:

## General Arrangement

DRAWING NO.


RMOB-01

SHEET

1 OF 5

C




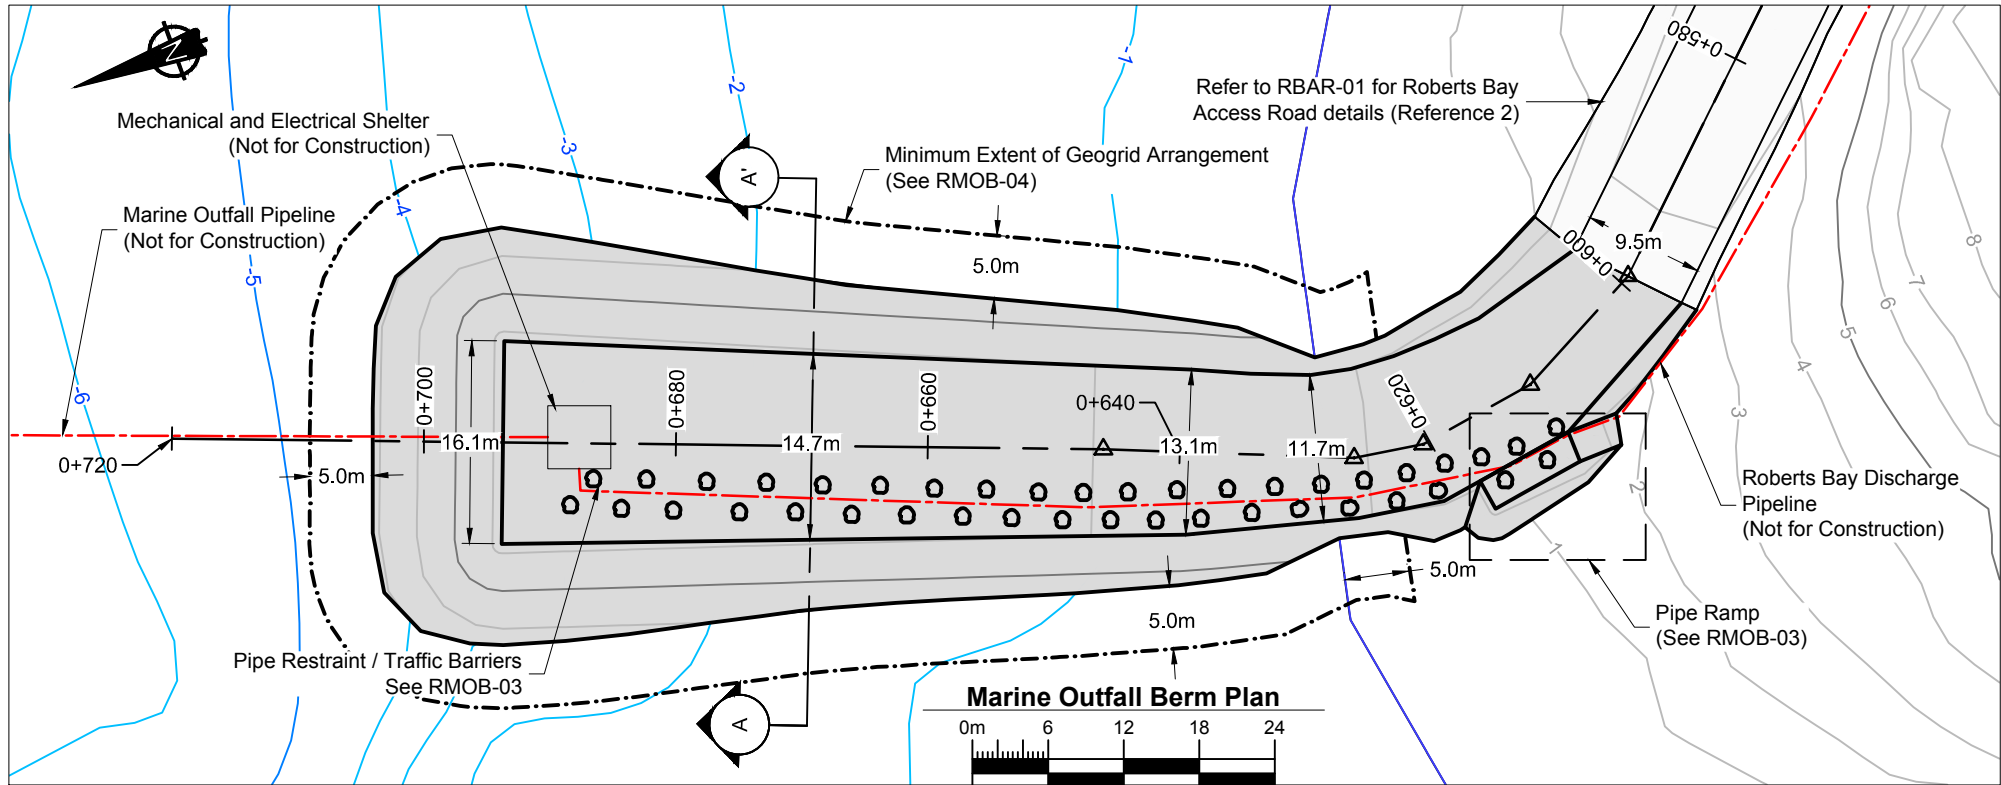




LEGEND		
---	Geotextile	Topographic Contour
-.-	Geogrid	Discharge Pipeline
---	Bathymetric Contour	Rip Rap Armour
		ROQ Material
		Surfacing Material
		Traffic Barrier

- NOTES**
- All dimensions are in meters unless noted otherwise.
  - Contours shown at 1m interval, and are based on aerial photography.
  - For details on Roberts Bay Discharge System Access road from 0+000 to 0+600, refer to drawings RBAR-01 to 04.
  - It is the Contractor's responsibility to ensure that the geogrid is installed in advance of the construction fill being placed. The Contractor must submit a construction procedure to the Engineer for approval before commencing this work.
  - Significant settlement of placed ROQ into the sea bed is expected during placement, even with geogrid installation.
  - The Contractor is responsible for silt and sediment control during construction. The construction methods by the Contractor must comply with TMAC environmental policies and permits and in line with requirements specified in References 1, 3, and 4.
  - The design provided considers the likely settlement of the marine outfall berm, and is deliberately raised and graded to account for this settlement. The final design is to have a horizontal crest at 1.5m elevation with 9.5m width (excluding armoring). Future 'repair' work designs should reflect this final design and not this initial construction design.


- REFERENCES**
- TMAC Resources Inc. Amendment Application No. 1 of Project Certificate No. 003 and Water License 2AM-DOH1323 (TMAC 2015).
  - SRK Consulting (Canada) Inc., 2018. Engineering Drawings for the Roberts Bay Discharge System Access Road. Doris North Project, Nunavut, Canada. Issued for Construction. Drawings prepared for Hope Bay Mining Limited. Project number 1CT022.030. January 30, 2018
  - Fisheries and Oceans Canada. Letter to TMAC Resources, Inc., ATTN: Mr. Roberts. Subject: Implementation of mitigation measures to avoid and mitigate serious harm to fish - Marine Outfall Berm - Project Certification No. 003 Amendment (Doris North Gold Mine Project). File 02-HCAA-CA7-0017. August 30, 2016.
  - Fisheries and Oceans Canada, Request for Review form, TMAC Resources Inc. Doris North Project - Marine Outfall Berm, Project Certificate No. 003 Amendment. Document name: 2AM-DOH1323 (TMAC 2015)

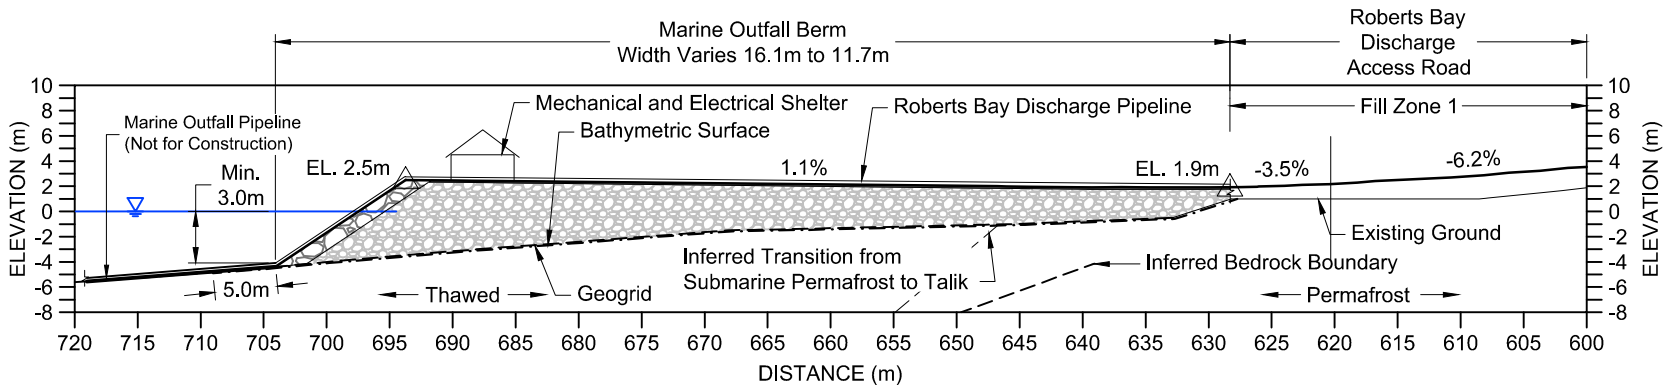

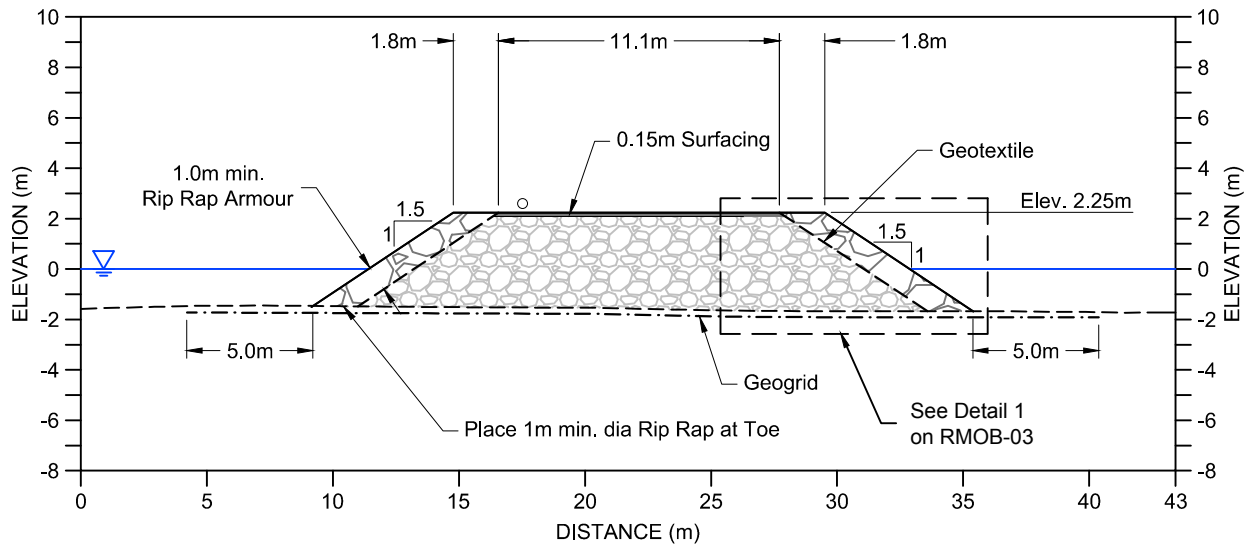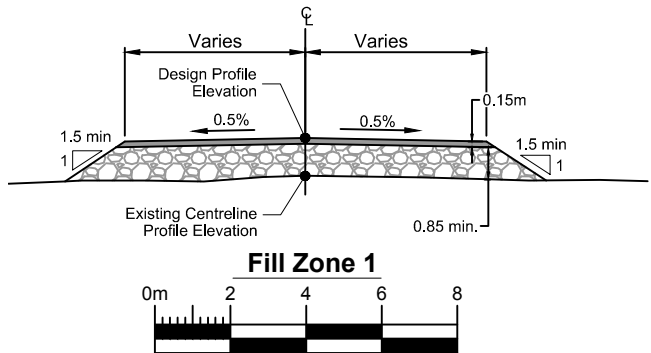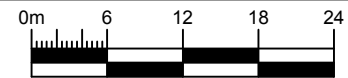

Marine Outfall Berm Profile




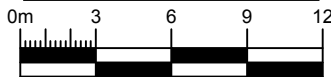


Cross Section A-A'



P:\01\_SITES\Hope Bay\ACAD\Roberts Bay Discharge System\1CT022.002\_MOB.dwg

										Original Drawings Stamped and Signed by Engineer						Roberts Bay Marine Outfall Berm		
																DRAWING TITLE:  Plan and Profile		
										DESIGN: CH		DRAWN: TAH		REVIEWED:		HOPE BAY PROJECT		
										CHECKED:		APPROVED:		DATE:		SRK JOB NO.: 1CT022.002		
														2018/05/16				
										PROFESSIONAL ENGINEERS STAMP		FILE NAME: 1CT022.002_MOB.dwg				RMOB-02		
																SHEET 2 OF 5		
																REVISION NO. 0		

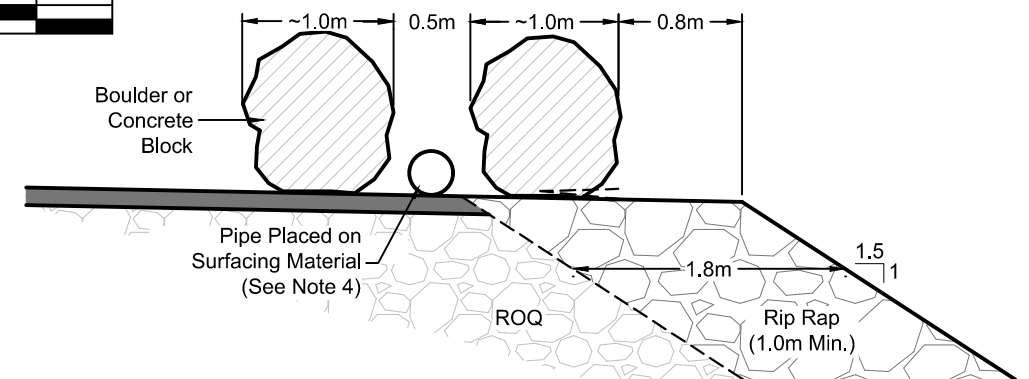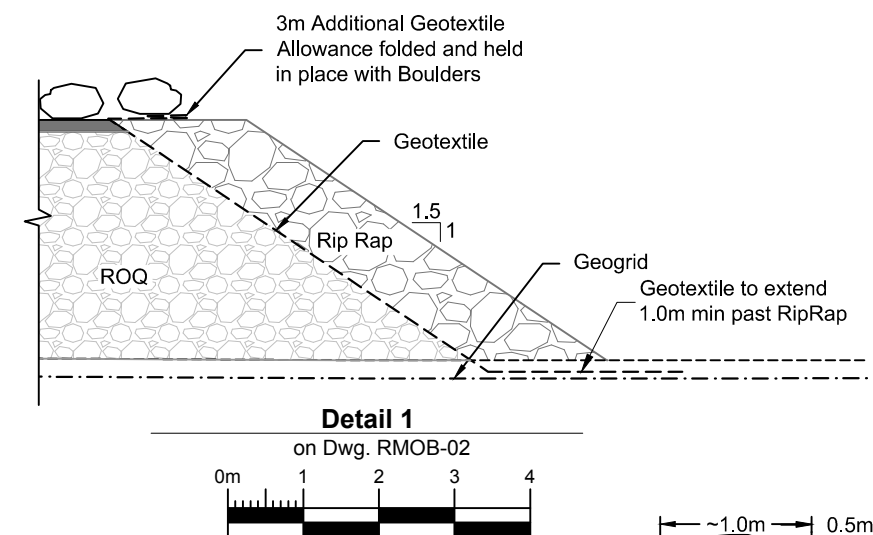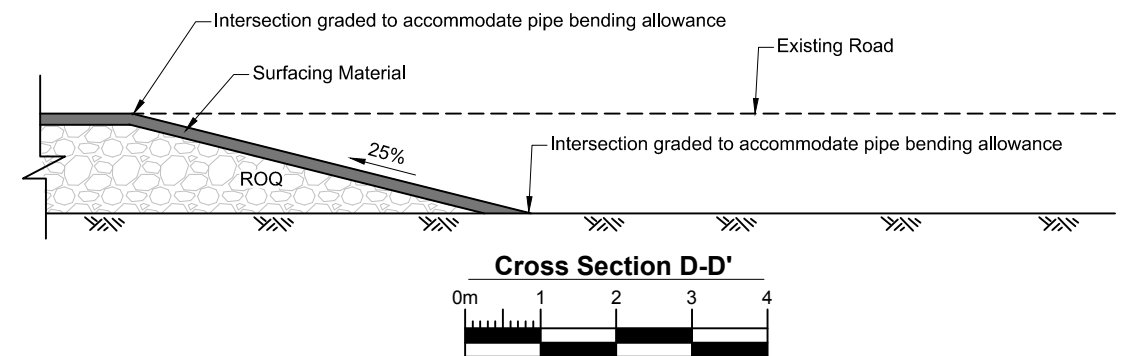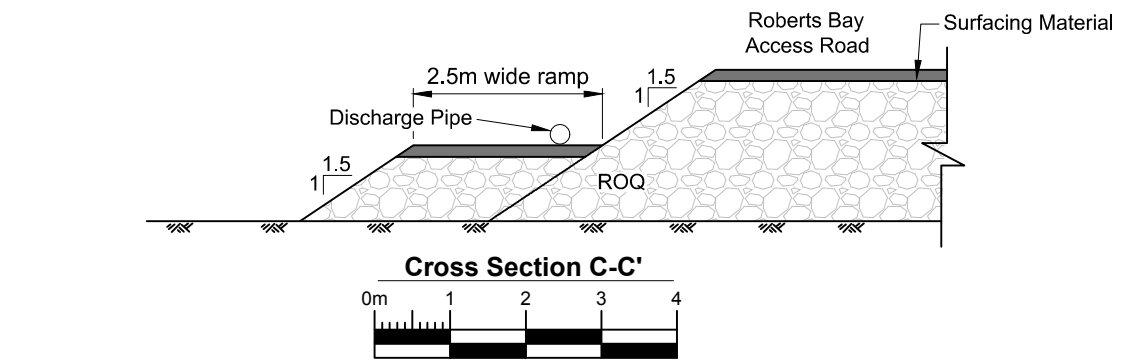

**Pipe Restraint / Traffic Barriers**  
Not To Scale

[illegible]

Original Drawings  
Stamped and  
Signed by Engineer

This drawing is uncontrolled when printed unless  
stamped and signed with original ink and recorded on a  
Distribution Register.



DESIGN:	CH	DRAWN:	TAH	REVIEWED:
CHECKED:		APPROVED:		DATE: 2018/05/10
FILE NAME:	1CT022.002 MOB.dwg			



**MAC**  
RESOURCES

HOPE BAY PROJECT

Roberts Bay Marine Outfall Berm

DRAWING TITLE:

## Pipe Ramp

DRAWING NO.	SHEET	REVISION NO.
RMOB-03	3 OF 5	0

SHEET 3 OF 5	REVISION NO. 0
-----------------	-------------------

OWN NO.  
0






P:\01\_SITES\Hope Bay\ACAD\Roberts Bay Discharge System\1CT022.002\_MOB.dwg

Materials List and Quantity Estimates


Item	Quantity / Area / Volume		Description
1. Run of Quarry Material	ROQ (cu.m.)		Approximate In-Place Neat-line Volume (3D volume based on Civil 3D surfaces - no allowance has been made for losses and embedment) Access Road volume for 0+600 to 0+630 only.
	Roberts Bay Discharge Pipeline Access Road	470	
	Marine Outfall Berm	4,800	
	Pipe Ramp	35	
	Total	5,305	
2. Surface Grade Material	Surfacing Material (cu.m.)		Approximate In-Place Neat-line Volume Access Road volume for 0+600 to 0+630 only
	Roberts Bay Discharge Access Road	22	
	Marine Outfall Berm	150	
	Pipe Ramp	4	
	Total	176	
3. Rip Rap	Total	2,200 cu.m.	Based on Marine Outfall Berm Outer Surface 3D Area - no allowance has been made for losses and embedment.
4. Geogrid	Base of ROQ area	2,380sq.m.	Based on Marine Outfall Berm Footprint
	5m extension beyond ROQ toe	980 sq.m.	
	Total	3,360 sq.m.	
5. Geotextile	Total	1,215 sq.m.	Based on Marine Outfall Berm Outer Surface 3D Area

- NOTES**
- All quantities are based on neat line Civil 3D surfaces and do not account for losses due to embedment and settlement. It is expected that there will significant settlement of the rockfill into the seabed and as such the required quantities will be significantly higher than those presented.

																																																																																																																																																																																																																																																																																																																																																																																																																																																																																																																																																																																																																																																																																																																																																																																																																																																																																																																																																																																																																																																																																																																																																																																																																																																																																																																																																																																																																															</
--	--	----

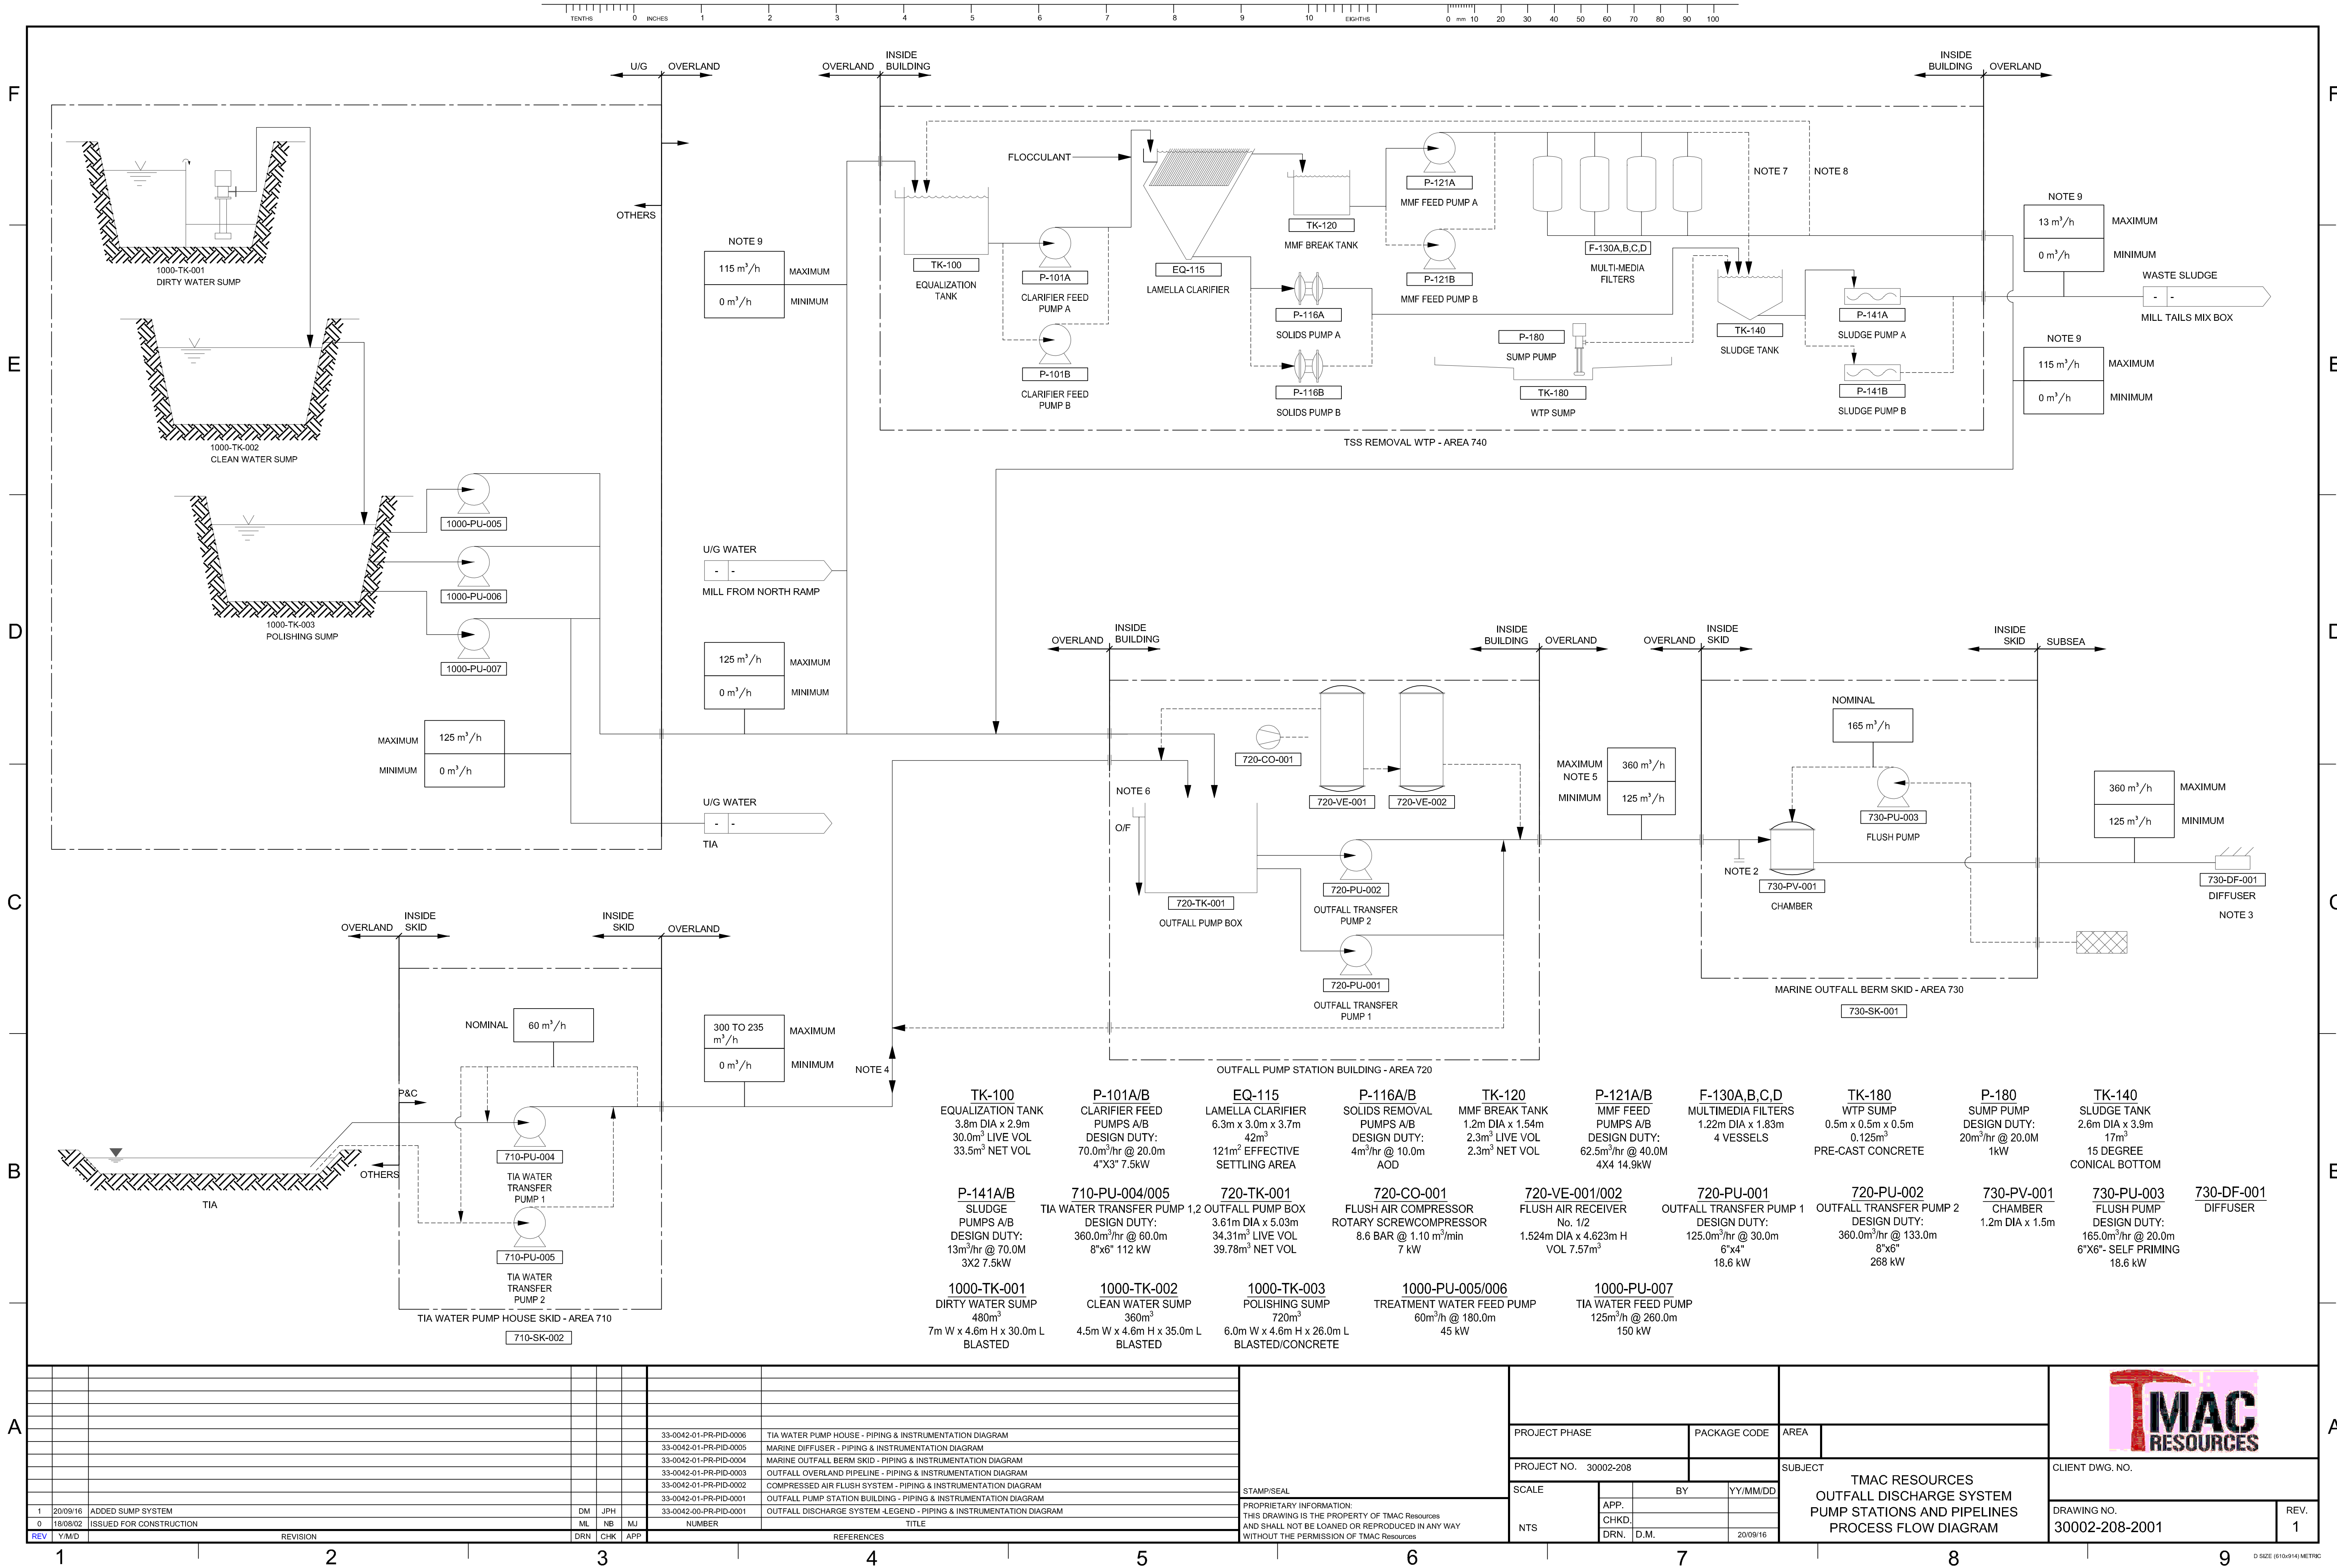




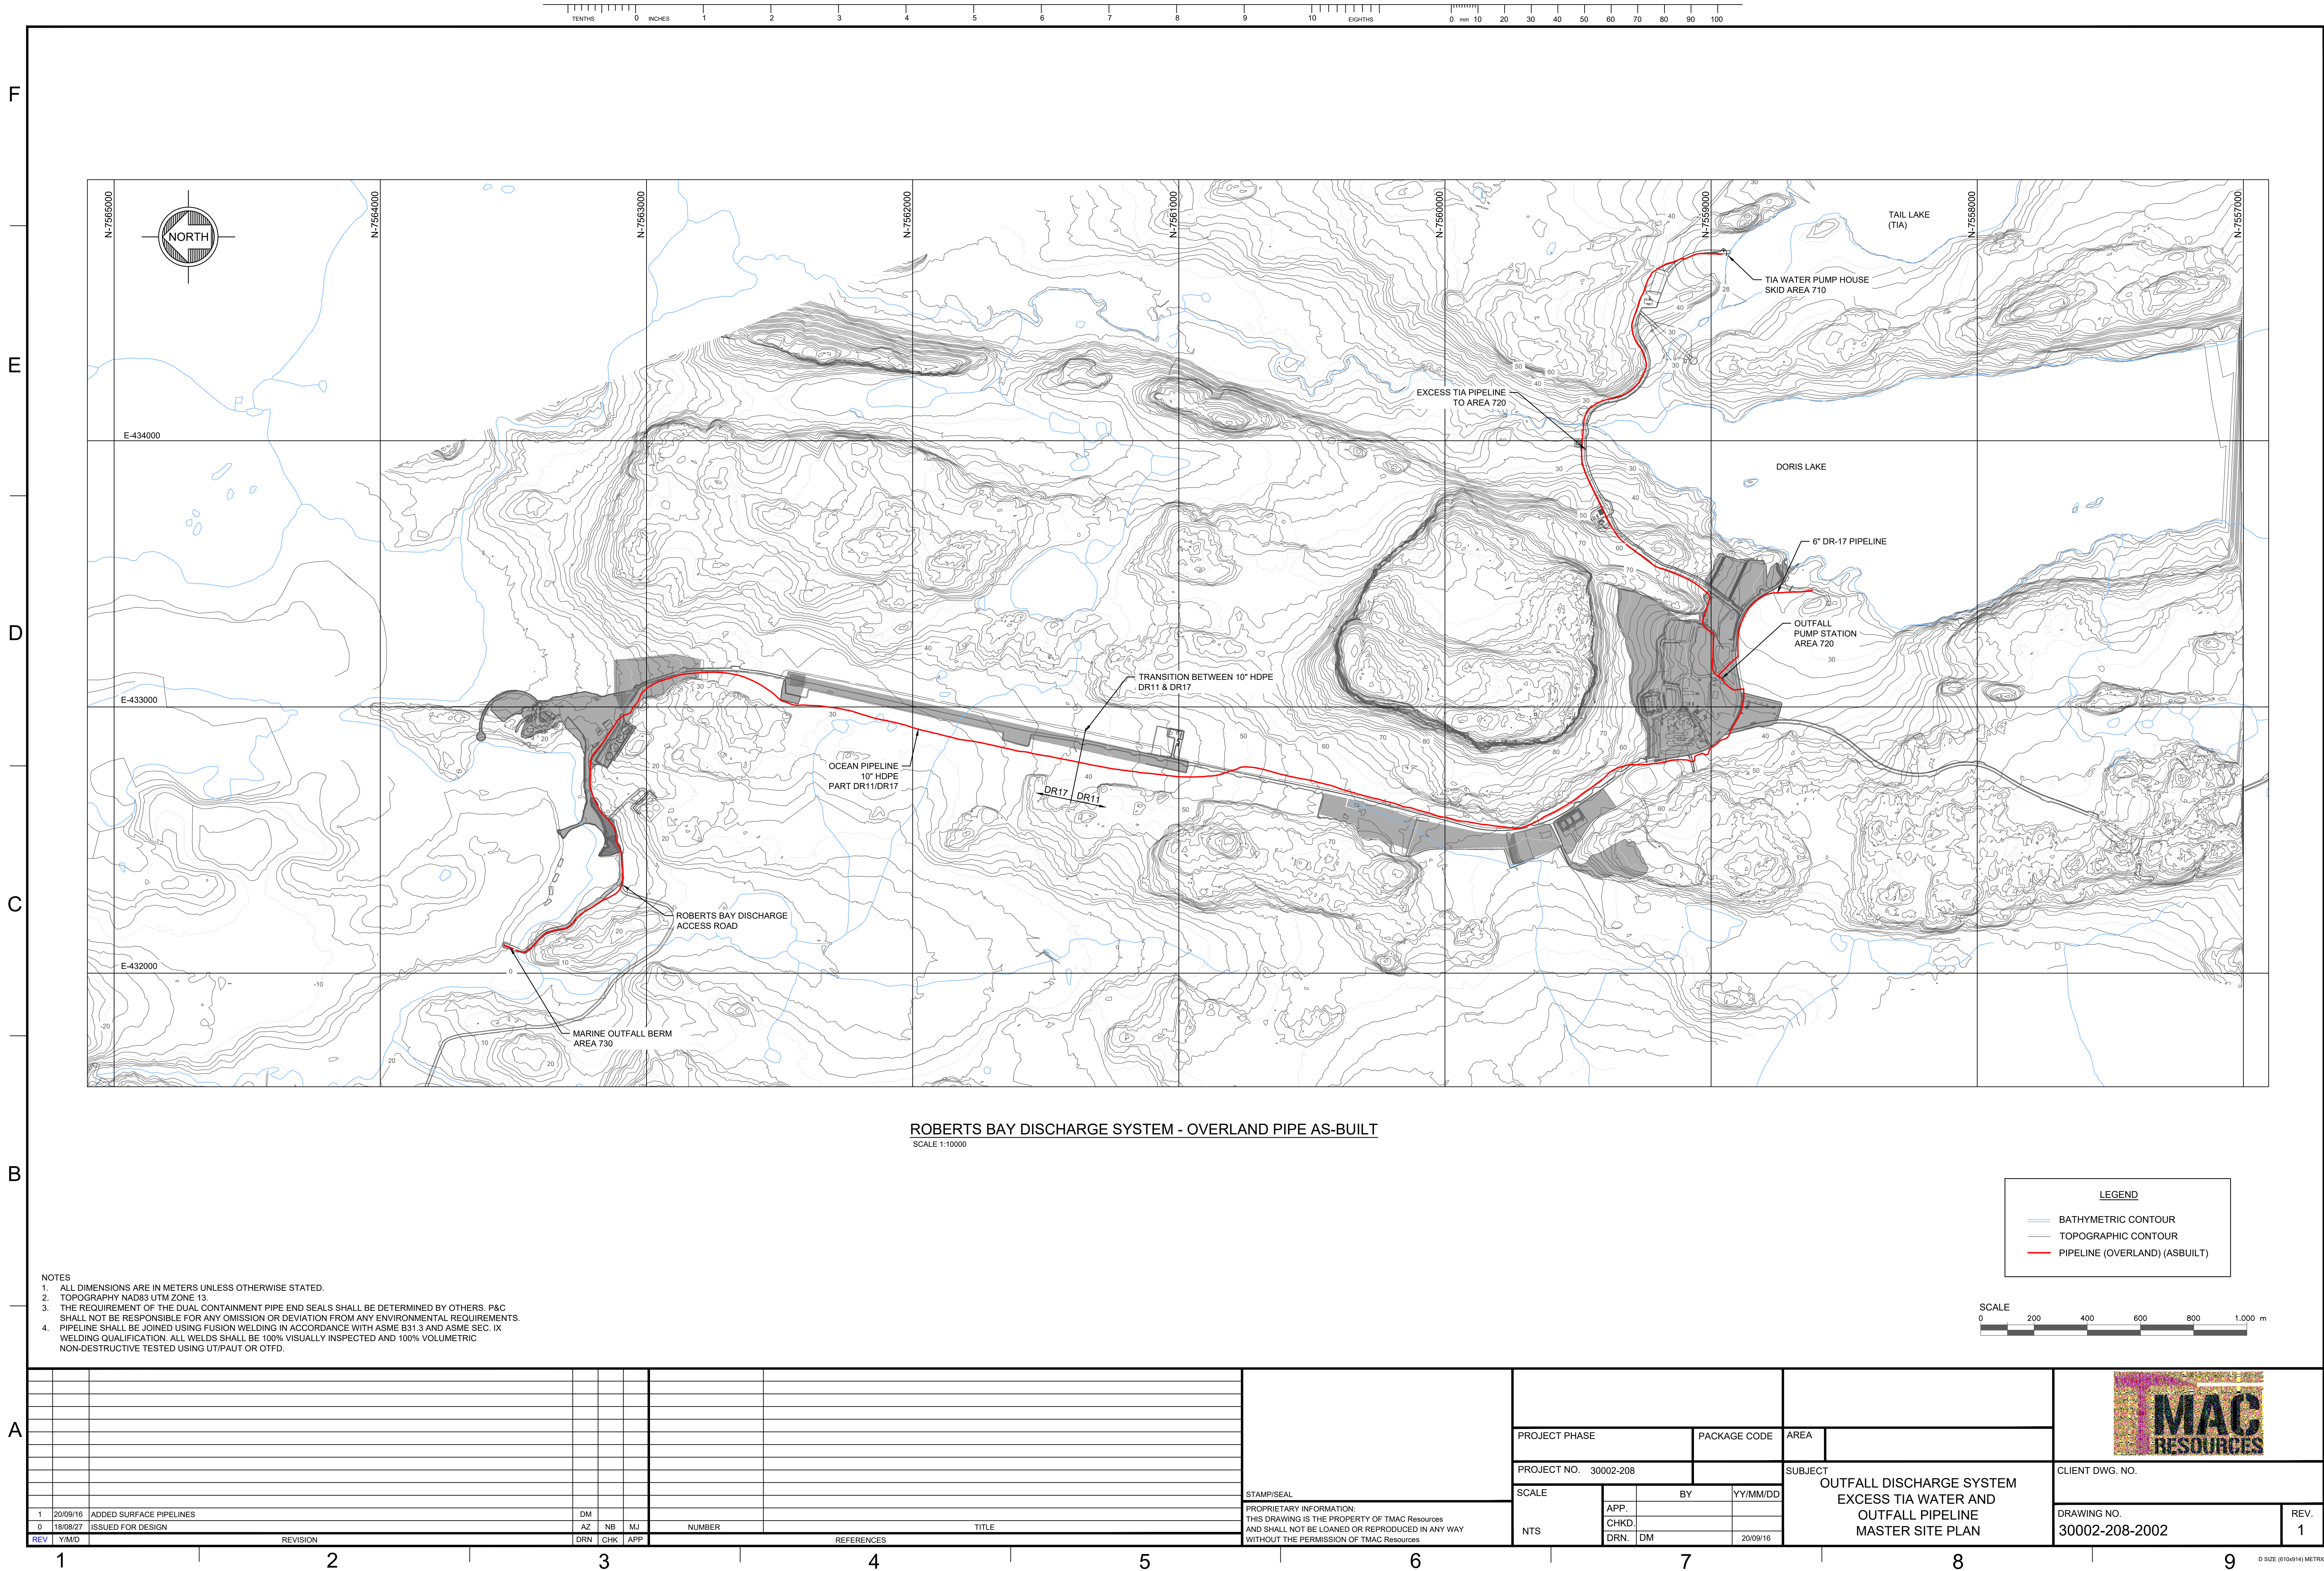





TMAC RESOURCES INC.  
HOPE BAY, NUNAVUT CANADA  
ROBERTS BAY DISCHARGE SYSTEM  
MARINE OUTFALL AND INTAKE

RECORD DRAWINGS

PROJECT NUMBER: 1065-001/002  
DATE: 2019-11-25  
REVISION: 0

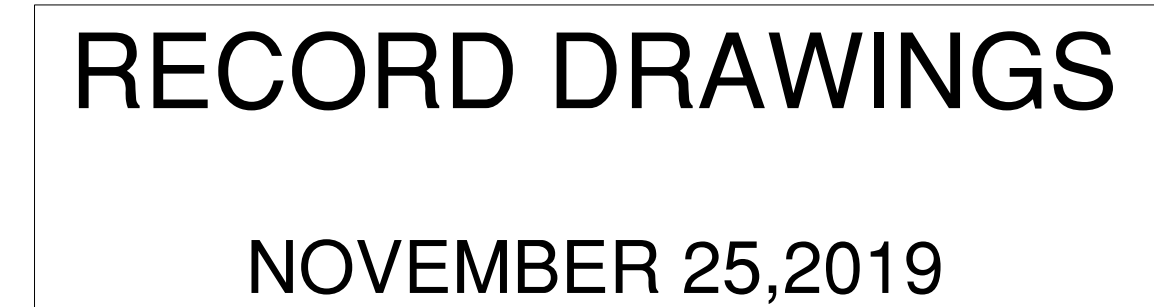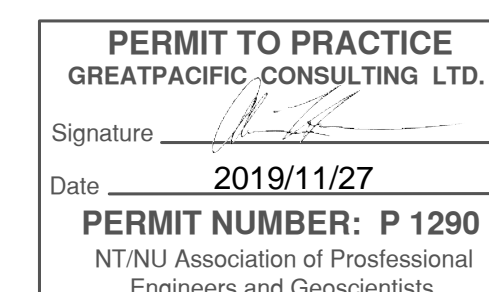



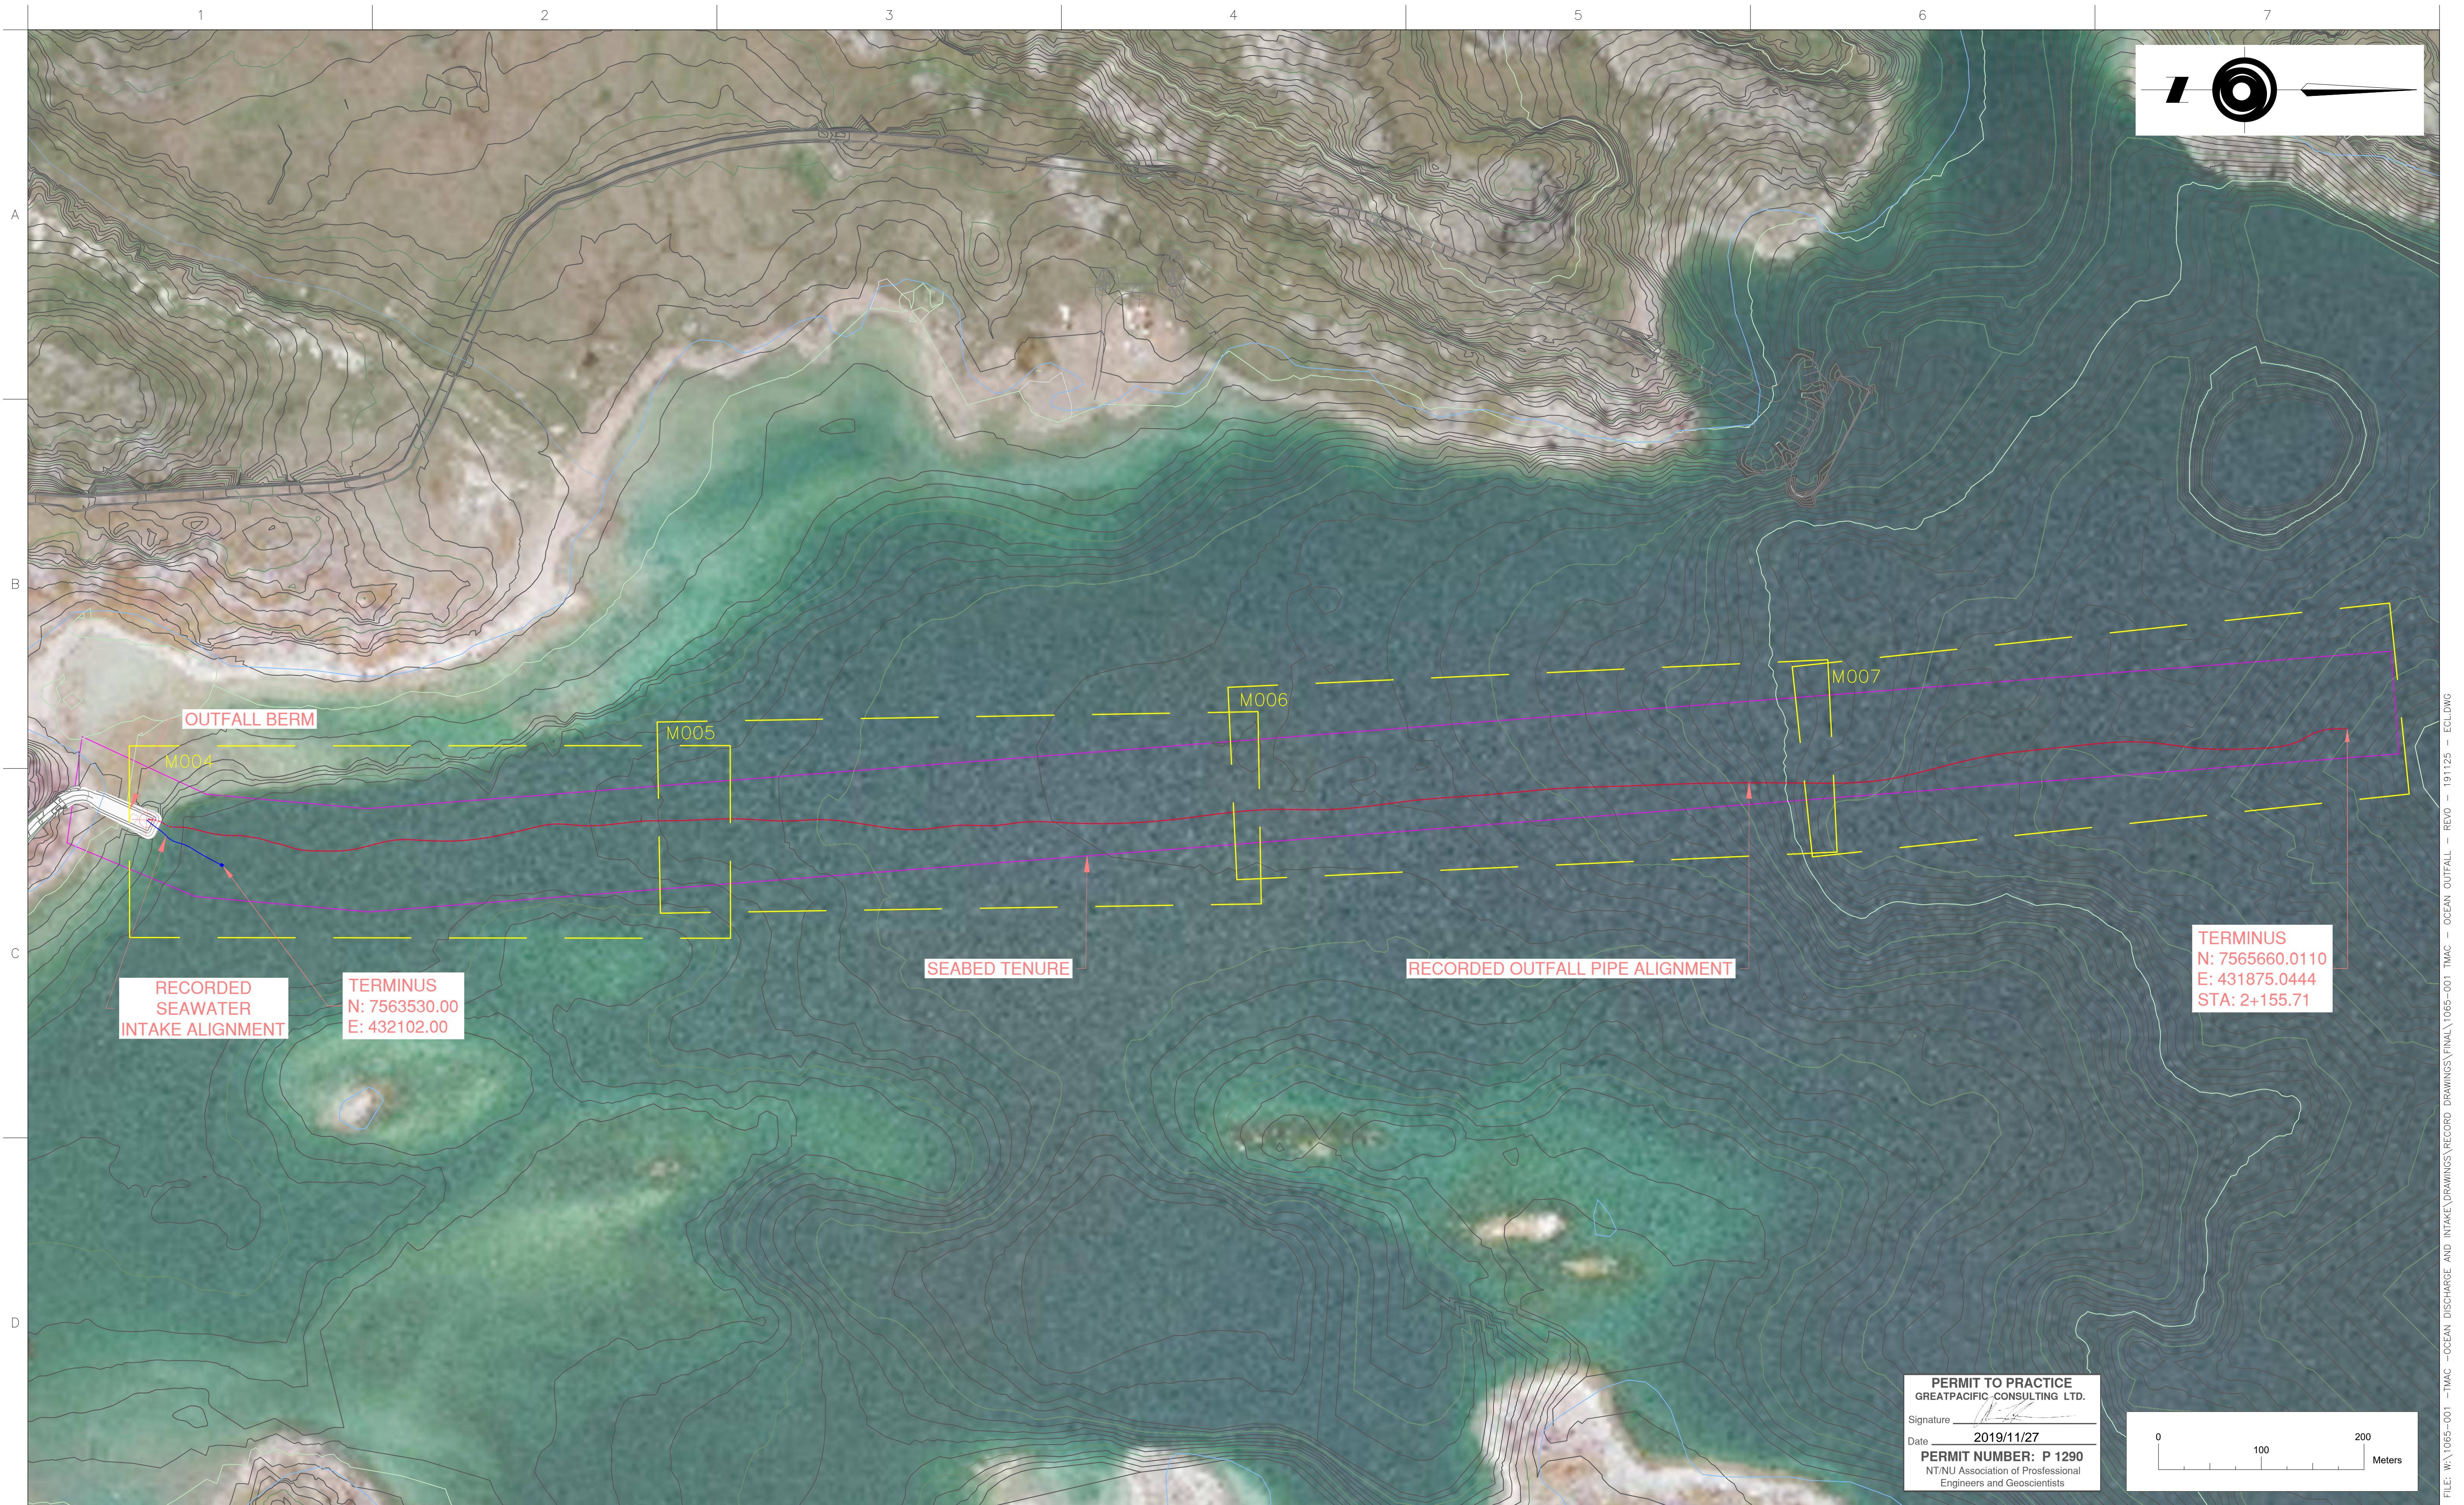

19-11-25	REV 0	ECL	AH	AH
19-11-22	AS RECORDED FOR CLIENT REVIEW	ECL	AH	JC
19-09-16	AS RECORDED FOR CLIENT REVIEW	TRB	AH	JC
DATE	DESCRIPTION	DRAWN	DESIGNED	APPROVED



**GREATPACIFIC**  
ENGINEERING & ENVIRONMENT

GREATPACIFIC CONSULTING LTD  
202-2780 VETERANS MEMORIAL PARKWAY  
VICTORIA, BC V9B 3S6  
778-433-2672  
www.greatpacific.ca

PERMIT/STAMP:

NOTES:

- GREATPACIFIC RECORDED DEPLOYED INTAKE ALIGNMENT ON 2019/08/19 AND DEPLOYED OUTFALL ALIGNMENT ON 2019/08/15 USING A SINGLE BEAM LOWRANCE HDS9 GEN 2 CHART PLOTTER/ECHO SOUNDER WITH A POINT-1 GPS ANTENNA/DIGITAL COMPASS.
- WATER LEVELS ADJUSTED TO GEODETIC DATA. (RESCAN, 2011)

CLIENT:



PROJECT NUMBER:

1065-001

OUTFALL  
RECORDED ALIGNMENT  
PLAN AND PROFILE

DRAWING NUMBER:

M001

SCALE:



1:3000



REV:

REV 0

FILE: W:\1065-001 -TMAC- OCEAN DISCHARGE AND INTAKE\DRAWINGS\RECORD DRAWINGS\FINAL\1065-001 -TMAC- OCEAN OUTFALL - REV0 - 191125 - ECLDWS  
DATE/TIME: 2019-11-18 11:24 AM

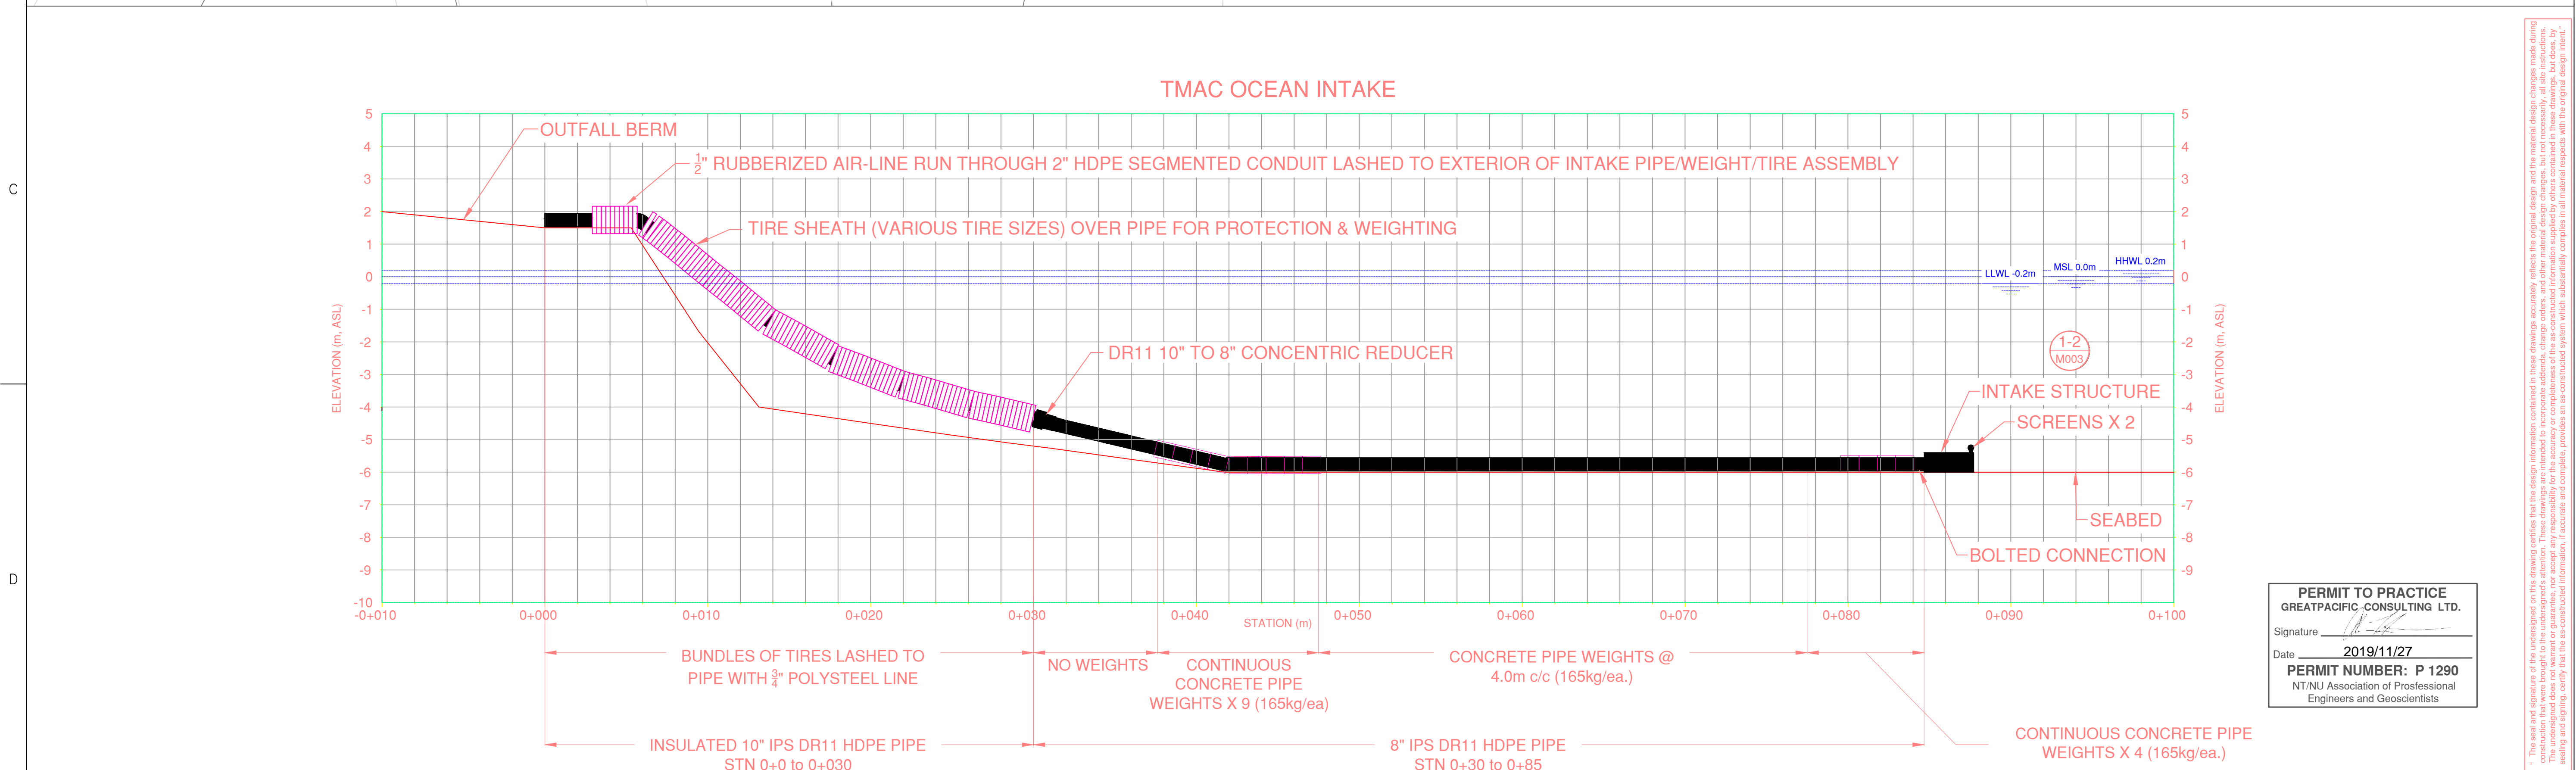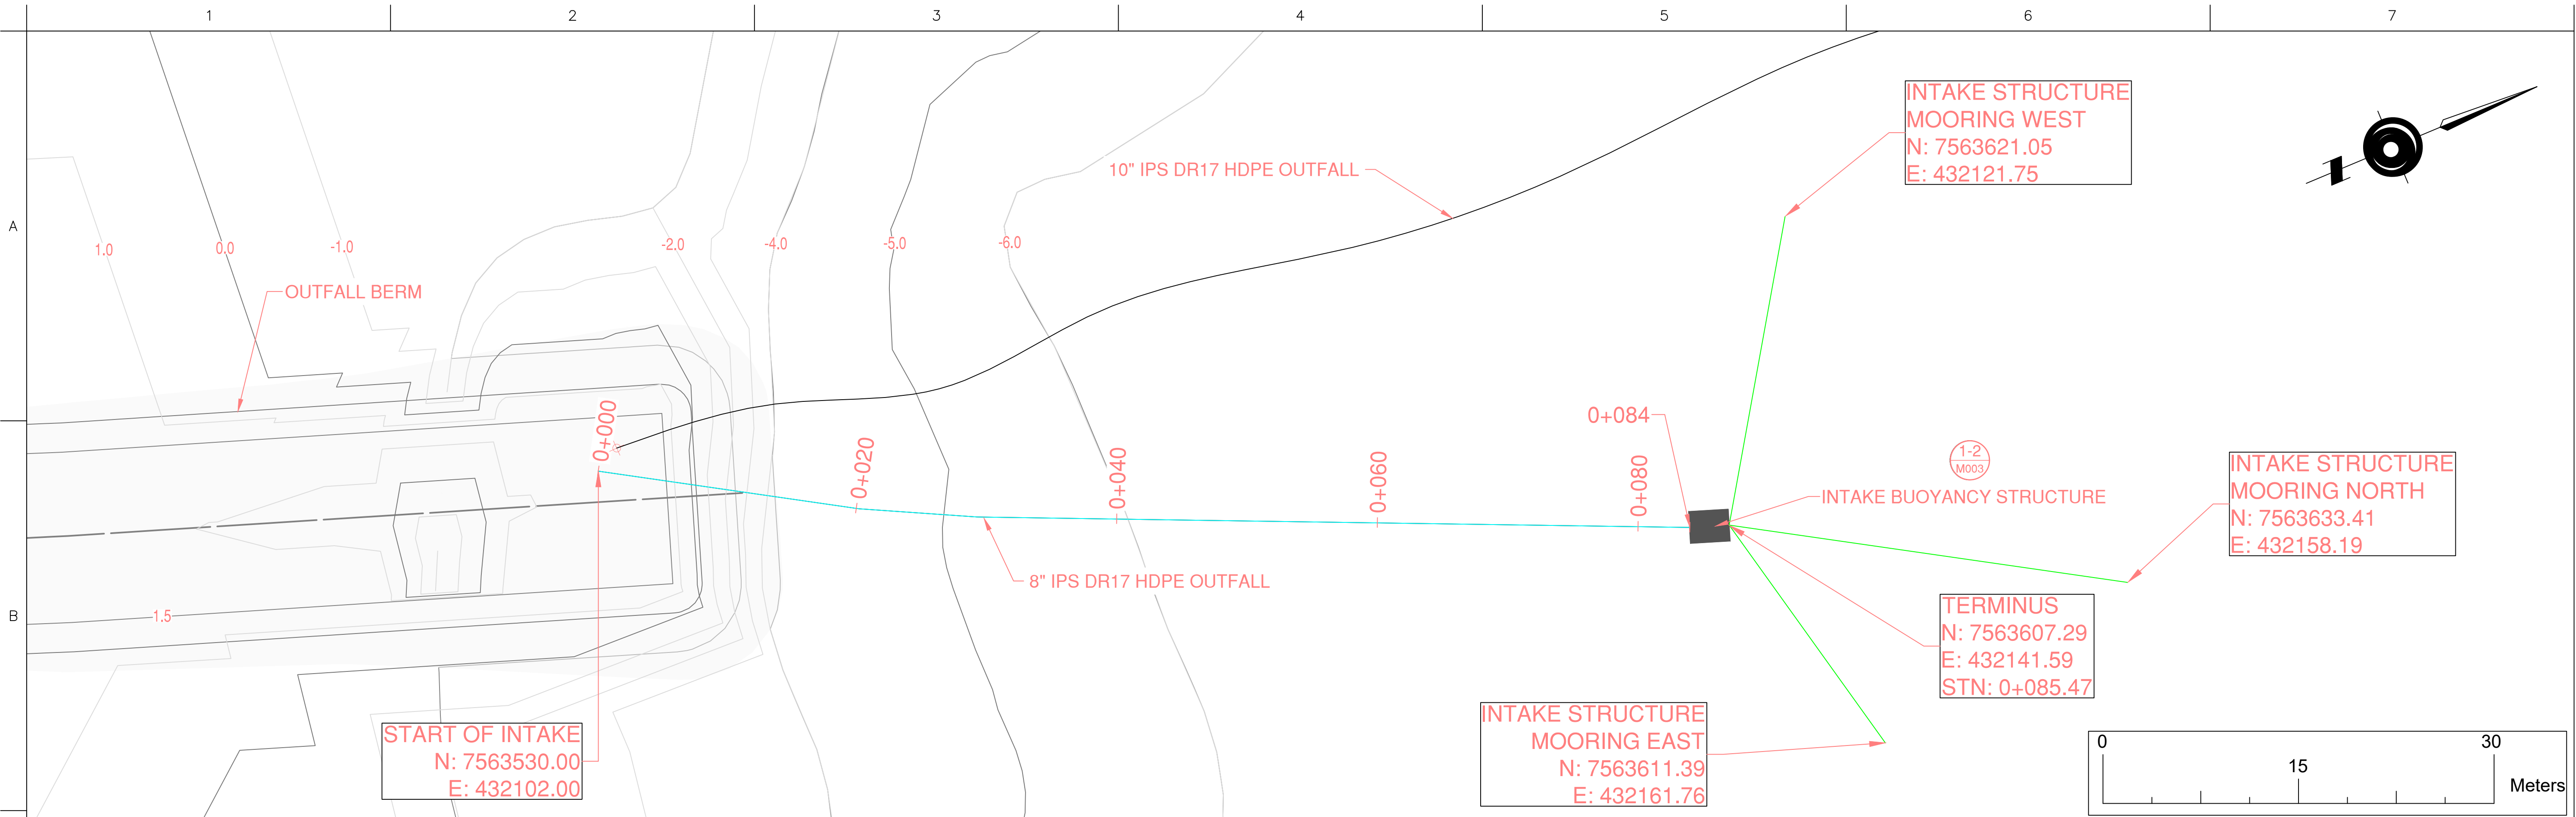




<table><tr><td>19-11-25</td><td>REV 0</td><td>ECL</td><td>AH</td><td>AH</td></tr><tr><td>19-11-22</td><td>RECORD DRAWING</td><td>ECL</td><td>AH</td><td>AH</td></tr><tr><td>19-10-07</td><td>RECORD DRAWING</td><td>TRB</td><td>AH</td><td>AH</td></tr><tr><td>DATE</td><td>DESCRIPTION</td><td>DRAWN</td><td>DESIGNED</td><td>APPROVED</td></tr></table>					19-11-25	REV 0	ECL	AH	AH	19-11-22	RECORD DRAWING	ECL	AH	AH	19-10-07	RECORD DRAWING	TRB	AH	AH	DATE	DESCRIPTION	DRAWN	DESIGNED	APPROVED	<div><b>GREATPACIFIC</b> ENGINEERING &amp; ENVIRONMENT GREATPACIFIC CONSULTING LTD 202-2780 VETERANS MEMORIAL PARKWAY VICTORIA, BC V9B 3S6 778-433-2672 www.greatpacific.ca</div>		PERMIT/STAMP:	NOTES: <ul style="list-style-type: none"><li>1. GREATPACIFIC RECORDED DEPLOYED INTAKE ALIGNMENT ON 2019/08/19 USING A SINGLE BEAM LOWRANCE HDS9 GEN 2 CHART PLOTTER/ECHO SOUNDER WITH A POINT-1 GPS ANTENNA/DIGITAL COMPASS.</li><li>2. WATER LEVELS ADJUSTED TO GEODETIC DATA. (RESCAN, 2011)</li></ul>	CLIENT: <div></div> <div>PROJECT NUMBER: 1065-001</div>	<div>HOPE BAY NUNAVUT, CANADA OCEAN INTAKE</div> <div>DRAWING NUMBER: M002</div> <div>SCALE: 1:250</div> <div>REV: REV 0</div>	
19-11-25	REV 0	ECL	AH	AH																											
19-11-22	RECORD DRAWING	ECL	AH	AH																											
19-10-07	RECORD DRAWING	TRB	AH	AH																											
DATE	DESCRIPTION	DRAWN	DESIGNED	APPROVED																											

\* The seal and signature of the undersigned on this drawing certifies that the design information contained in these drawings accurately reflects the original design and the material design charges made during construction that were brought to the undersigned's attention. These drawings are intended to incorporate addenda, change orders, and other material design charges, but not necessarily, all site instructions, field notes, or other information. The undersigned, by signing these drawings, certifies that the design information is accurate and complete, provides an as-constructed system which substantially complies in all material respects with the original design intent.



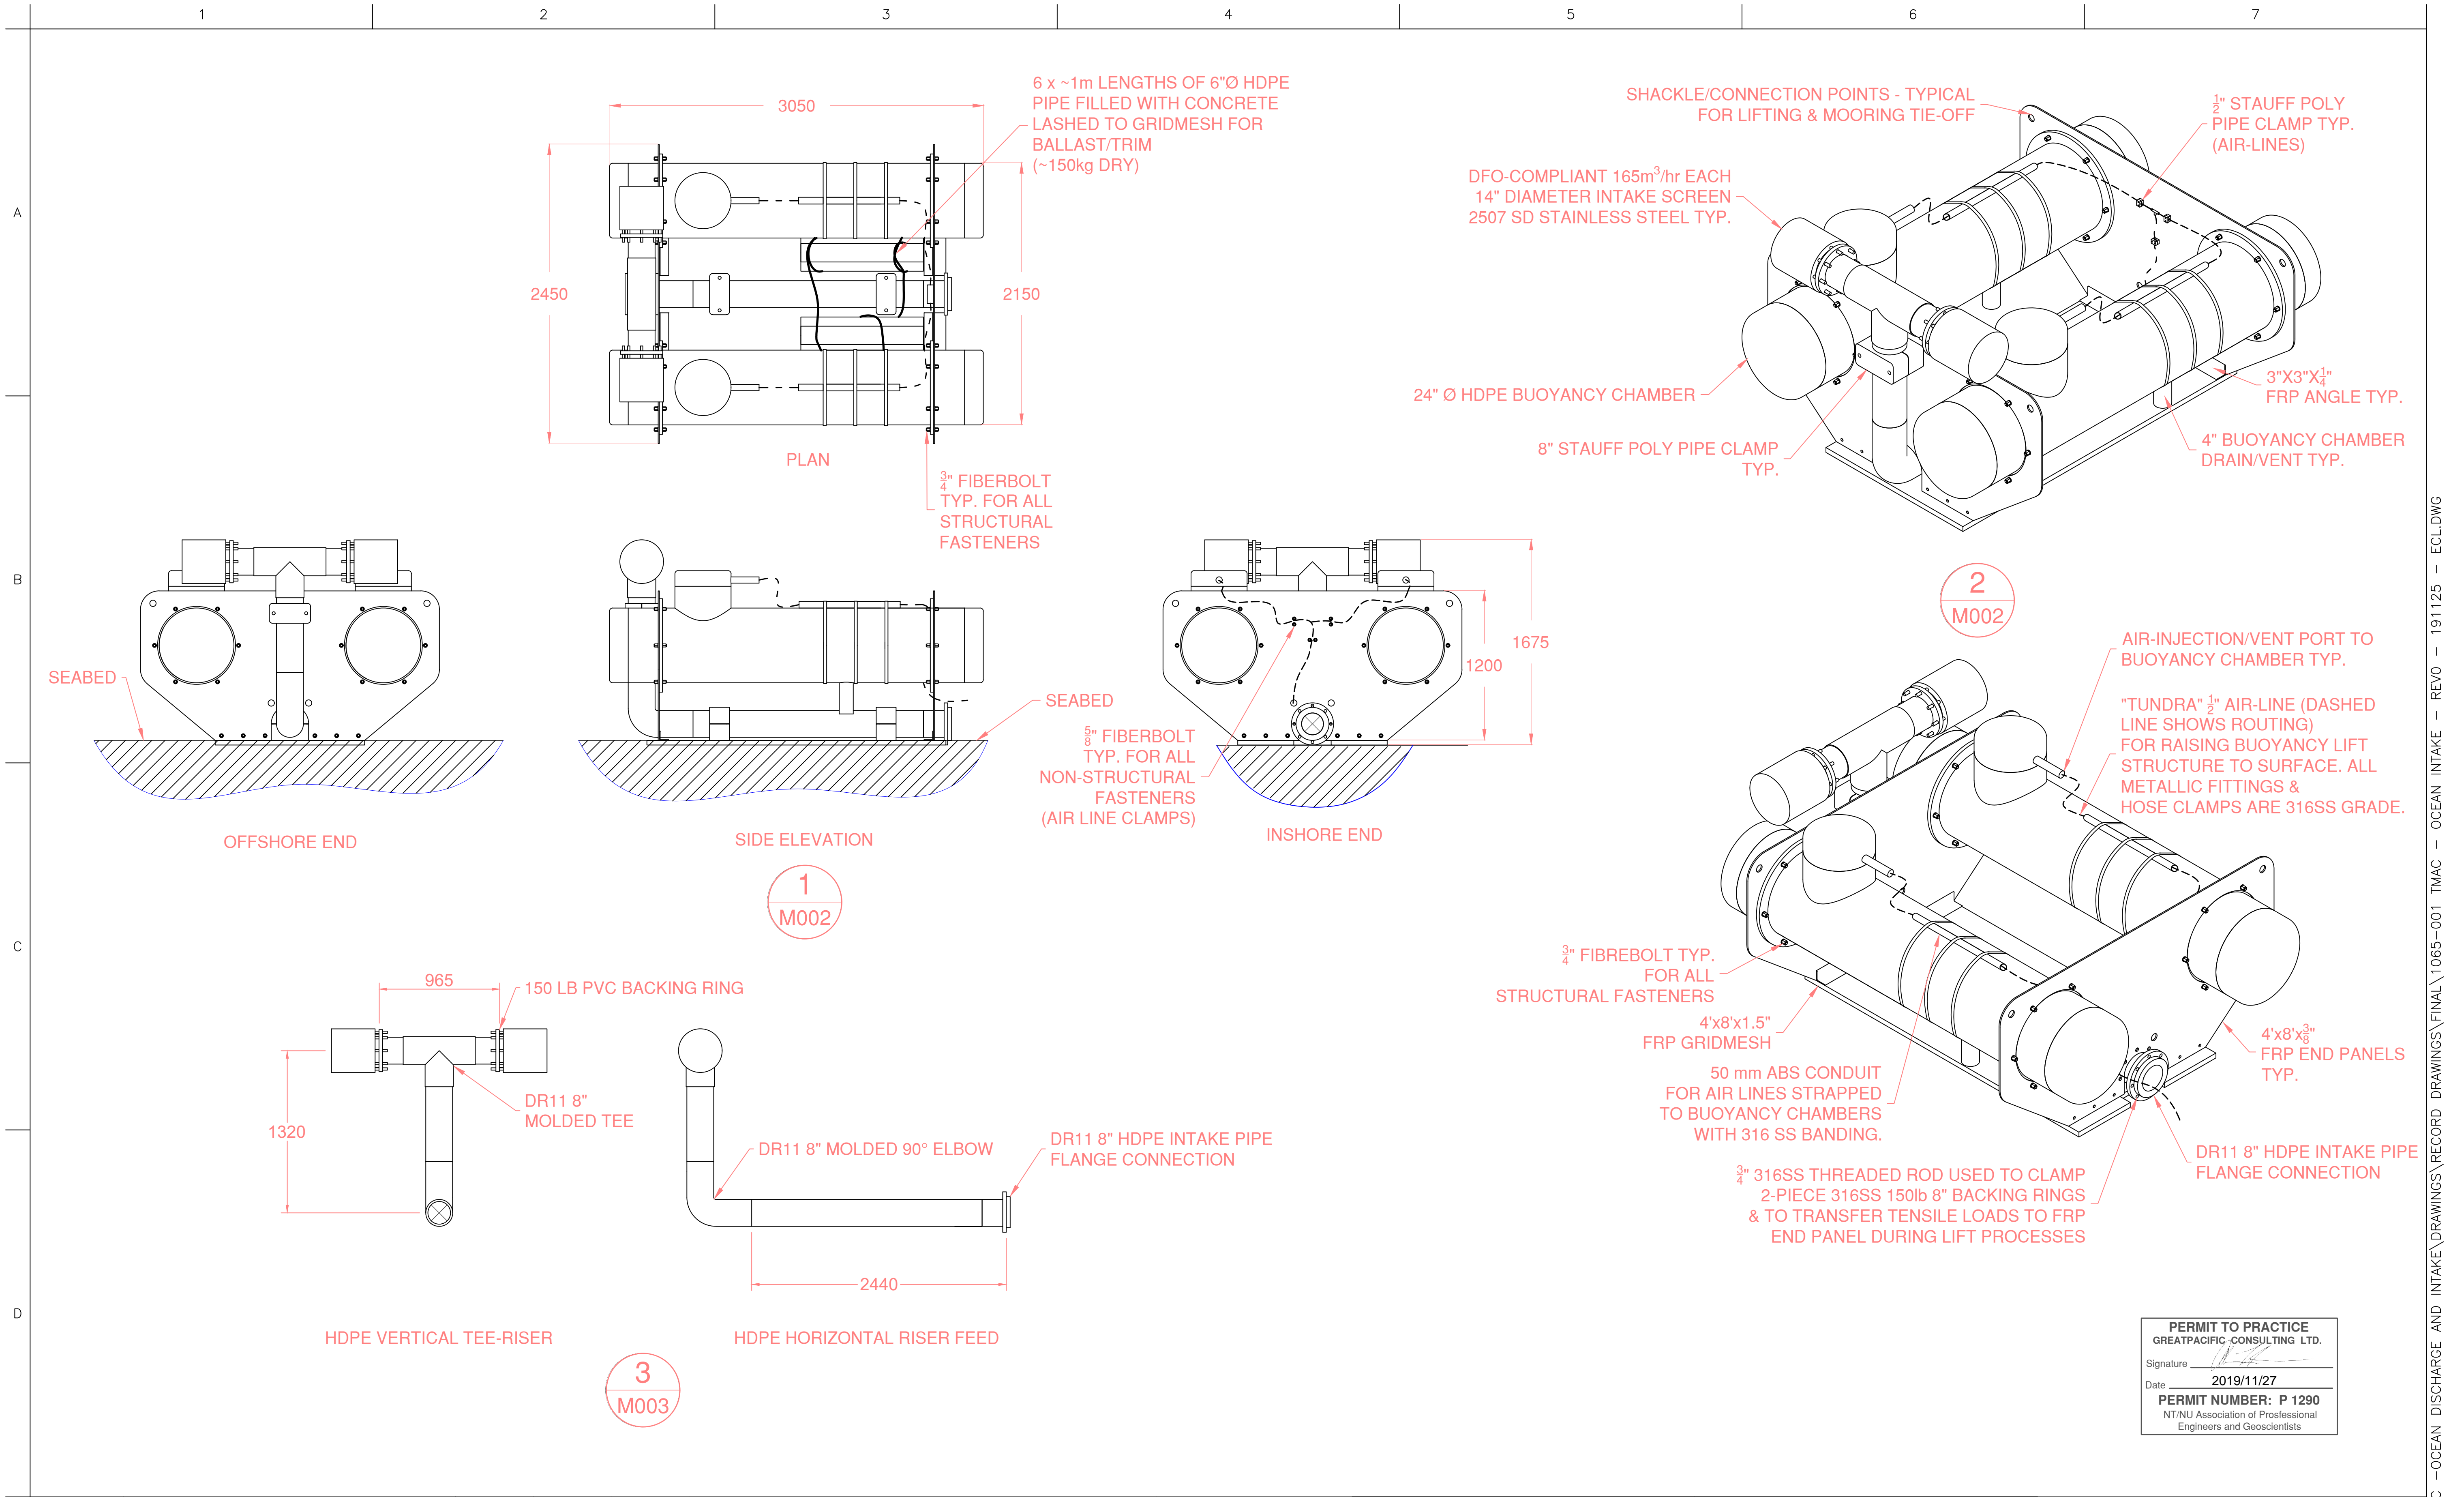

19-11-25	REV 0	ECL	AH	AH
19-11-22	RECORD DRAWING	ECL	AH	AH
19-10-08	RECORD DRAWING	TRB	AH	AH
DATE	DESCRIPTION	DRAWN	DESIGNED	APPROVED

**GREATPACIFIC**  
ENGINEERING & ENVIRONMENT

GREATPACIFIC CONSULTING LTD  
202-2780 VETERANS MEMORIAL PARKWAY  
VICTORIA, BC V9B 3S6  
778-433-2672  
www.greatpacific.ca

PERMIT/STAMP:

NOTES:

- ALL DISTANCES ARE IN MILLIMETERS AND DECIMALS THEREOF UNLESS OTHERWISE STATED.
- DO NOT SCALE FROM DRAWINGS.
- BUOYANCY STRUCTURE CAN BE BROUGHT TO THE SURFACE DURING ICE-FREE PERIODS OF CALM WEATHER (<5 knot WINDS, <0.25m WAVES) TO INSPECT & CLEAN INTAKE SCREENS OF BIOFOULING/DEBRIS.
- MOORINGS (x3) COMPRISED OF DANFORTH ANCHOR (75lb NORTH, 40lb EAST&WEST), 3/8" GALVANIZED CHAIN AND 3/4" POLYSTEEL SYNTHETIC LINE. MOORING SCOPE IS ~3:1.

CLIENT:



PROJECT NUMBER:

1065-001

SEAWATER INTAKE &  
MARINE EFFLUENT OUTFALL  
DETAILS

DRAWING NUMBER:

M003

SCALE:



AS SHOWN

REV:

REV 0

FILE: W:\1065-001 -TMAC -OCEAN DISCHARGE AND INTAKE\DRAWINGS\RECORD DRAWINGS\FINAL\1065-001 TMAC - OCEAN INTAKE - REV0 - 191125 - ECL.DWG



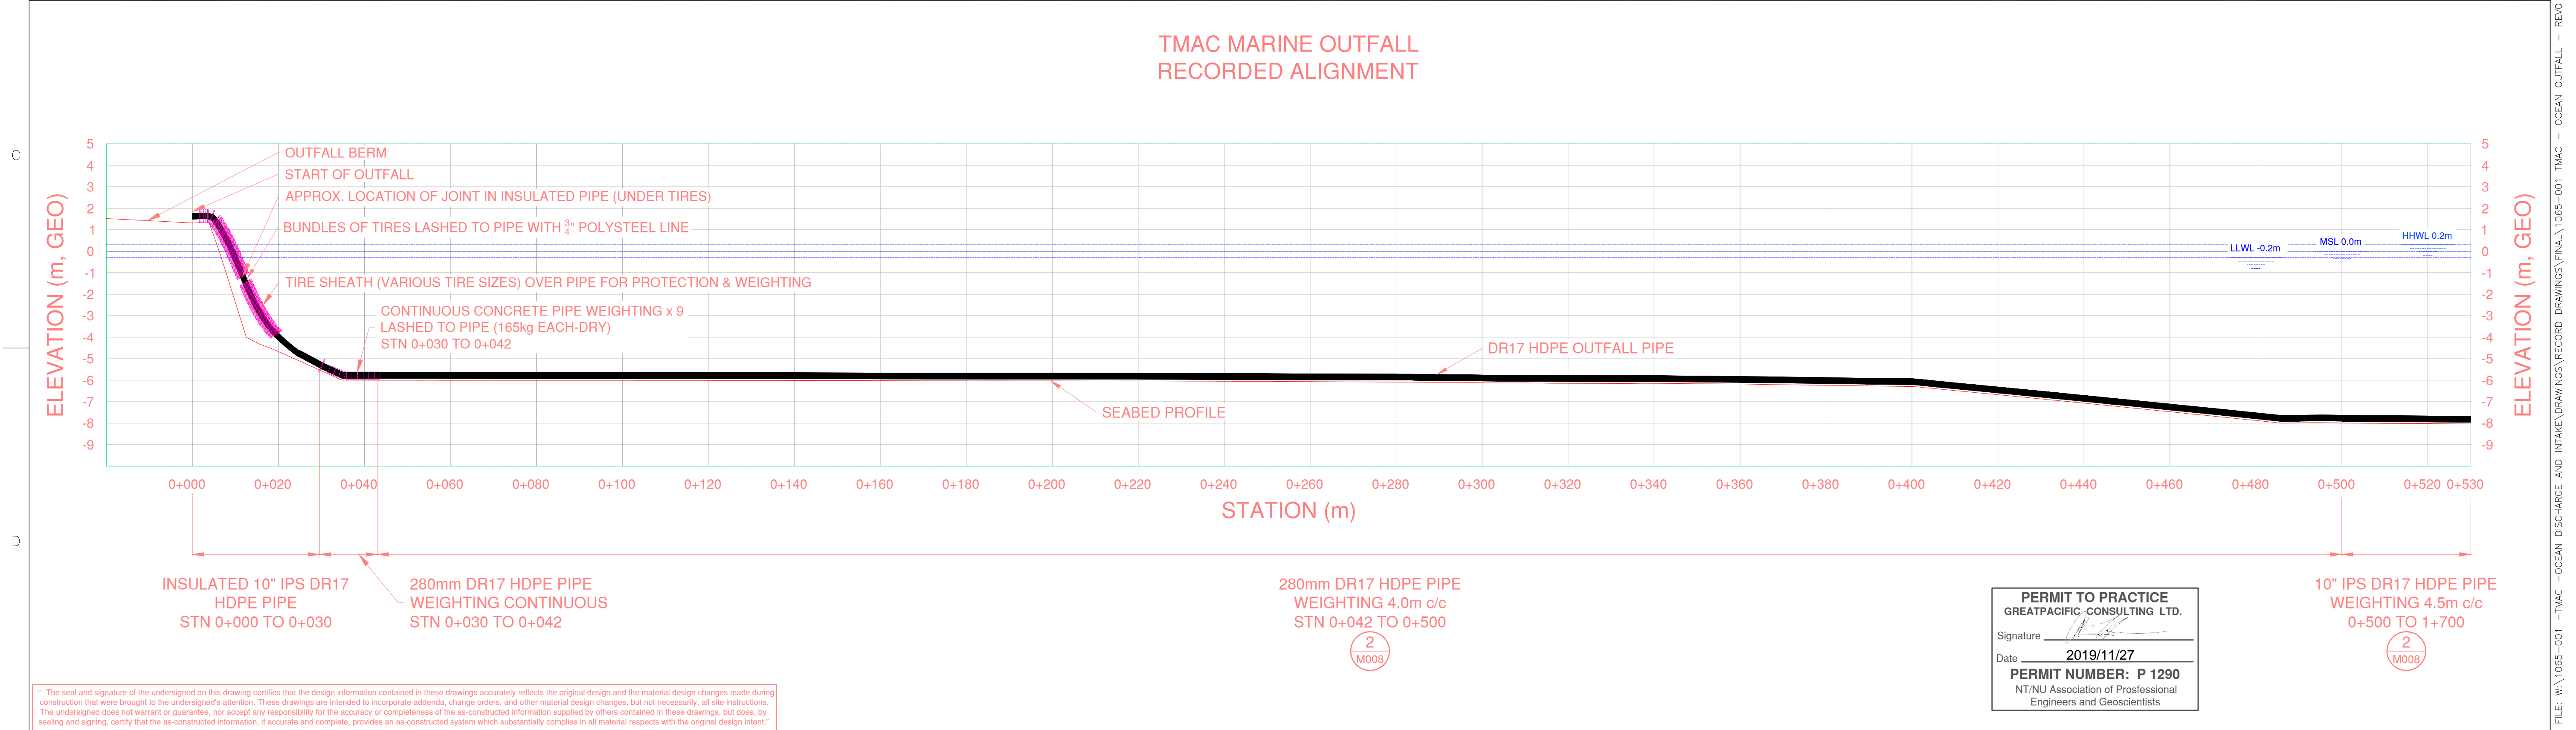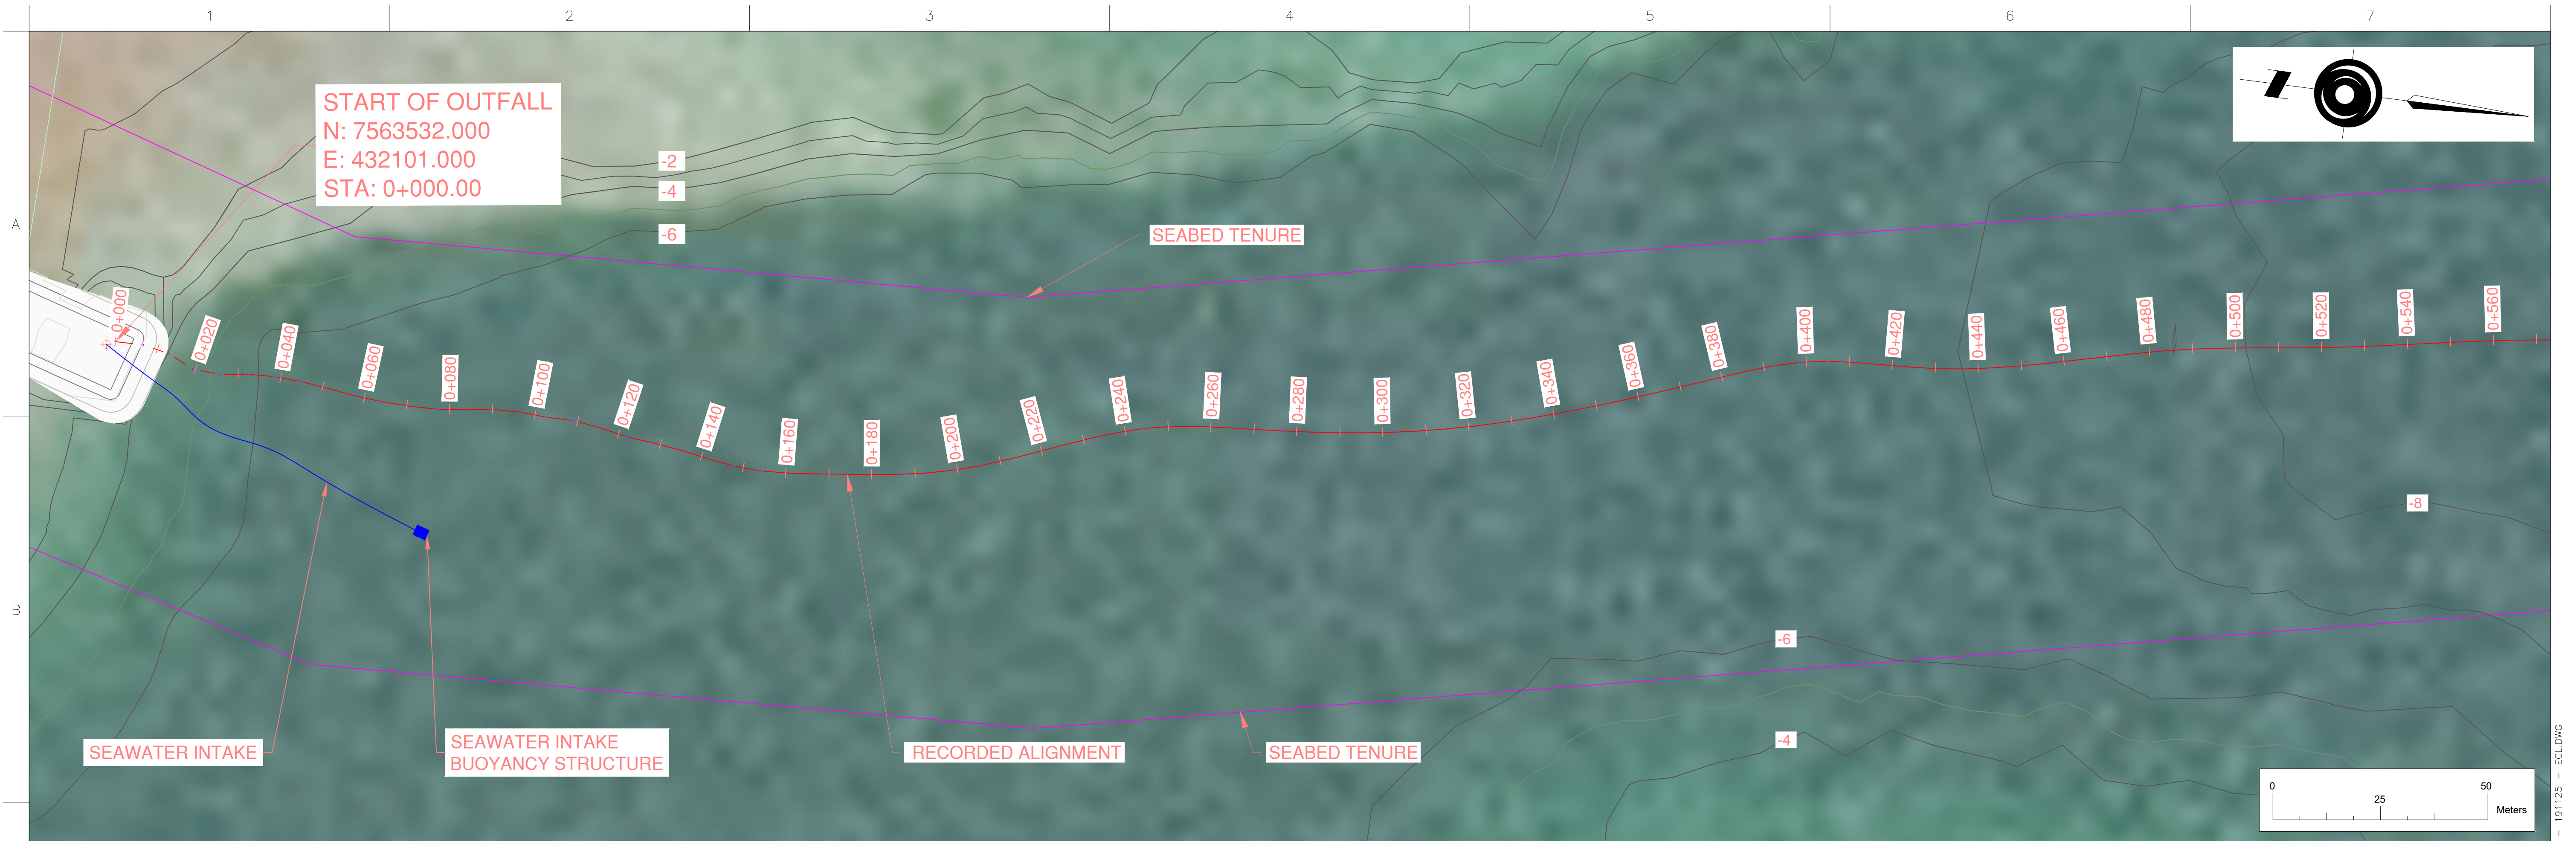

\* The seal and signature of the undersigned on this drawing certifies that the design information contained in these drawings accurately reflects the original design and the material design changes made during construction that were brought to the undersigned's attention. These drawings are intended to incorporate addenda, change orders, and other material design changes, but not necessarily, all site instructions. The undersigned does not warrant or guarantee, nor accept any responsibility for the accuracy or completeness of the as-constructed information supplied by others contained in these drawings, but does, by sealing and signing, certify that the as-constructed information, if accurate and complete, provides an as-constructed system which substantially complies in all material respects with the original design intent.\*

19-11-25	REV 0	ECL	AH	AH
19-11-22	AS RECORDED FOR CLIENT REVIEW	ECL	AH	JC
19-09-16	AS RECORDED FOR CLIENT REVIEW	TRB	AH	JC
DATE	DESCRIPTION	DRAWN	DESIGNED	APPROVED

 **GREATPACIFIC**  
ENGINEERING & ENVIRONMENT

GREATPACIFIC CONSULTING LTD  
202-2780 VETERANS MEMORIAL PARKWAY  
VICTORIA, BC V9B 3S6  
778-433-2672  
www.greatpacific.ca

PERMIT/STAMP:

NOTES:

- GREATPACIFIC RECORDED DEPLOYED OUTFALL ALIGNMENT ON 2019/08/15 USING A SINGLE BEAM LOWRANCE HDS9 GEN 2 CHART PLOTTER/ECHO SOUNDER WITH A POINT-1 GPS ANTENNA/DIGITAL COMPASS. WATER LEVELS ADJUSTED TO GEODETIC DATA. (RESCAN, 2011)

CLIENT:



PROJECT NUMBER:

1065-001

OUTFALL  
RECORDED ALIGNMENT  
PLAN AND PROFILE

DRAWING NUMBER:

M004



SCALE:

1:750

REV:

REV 0



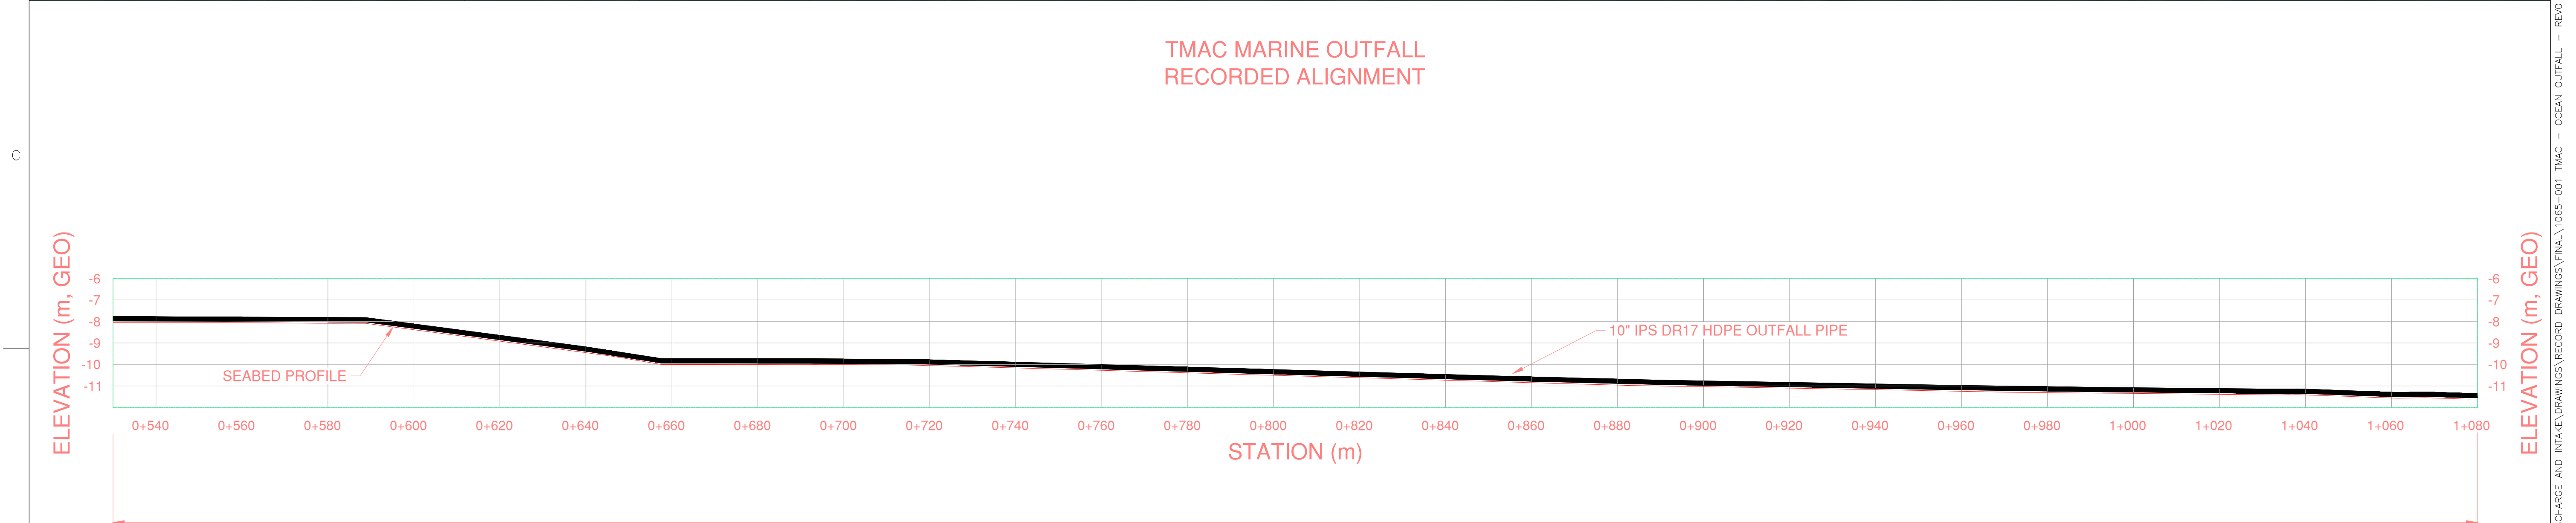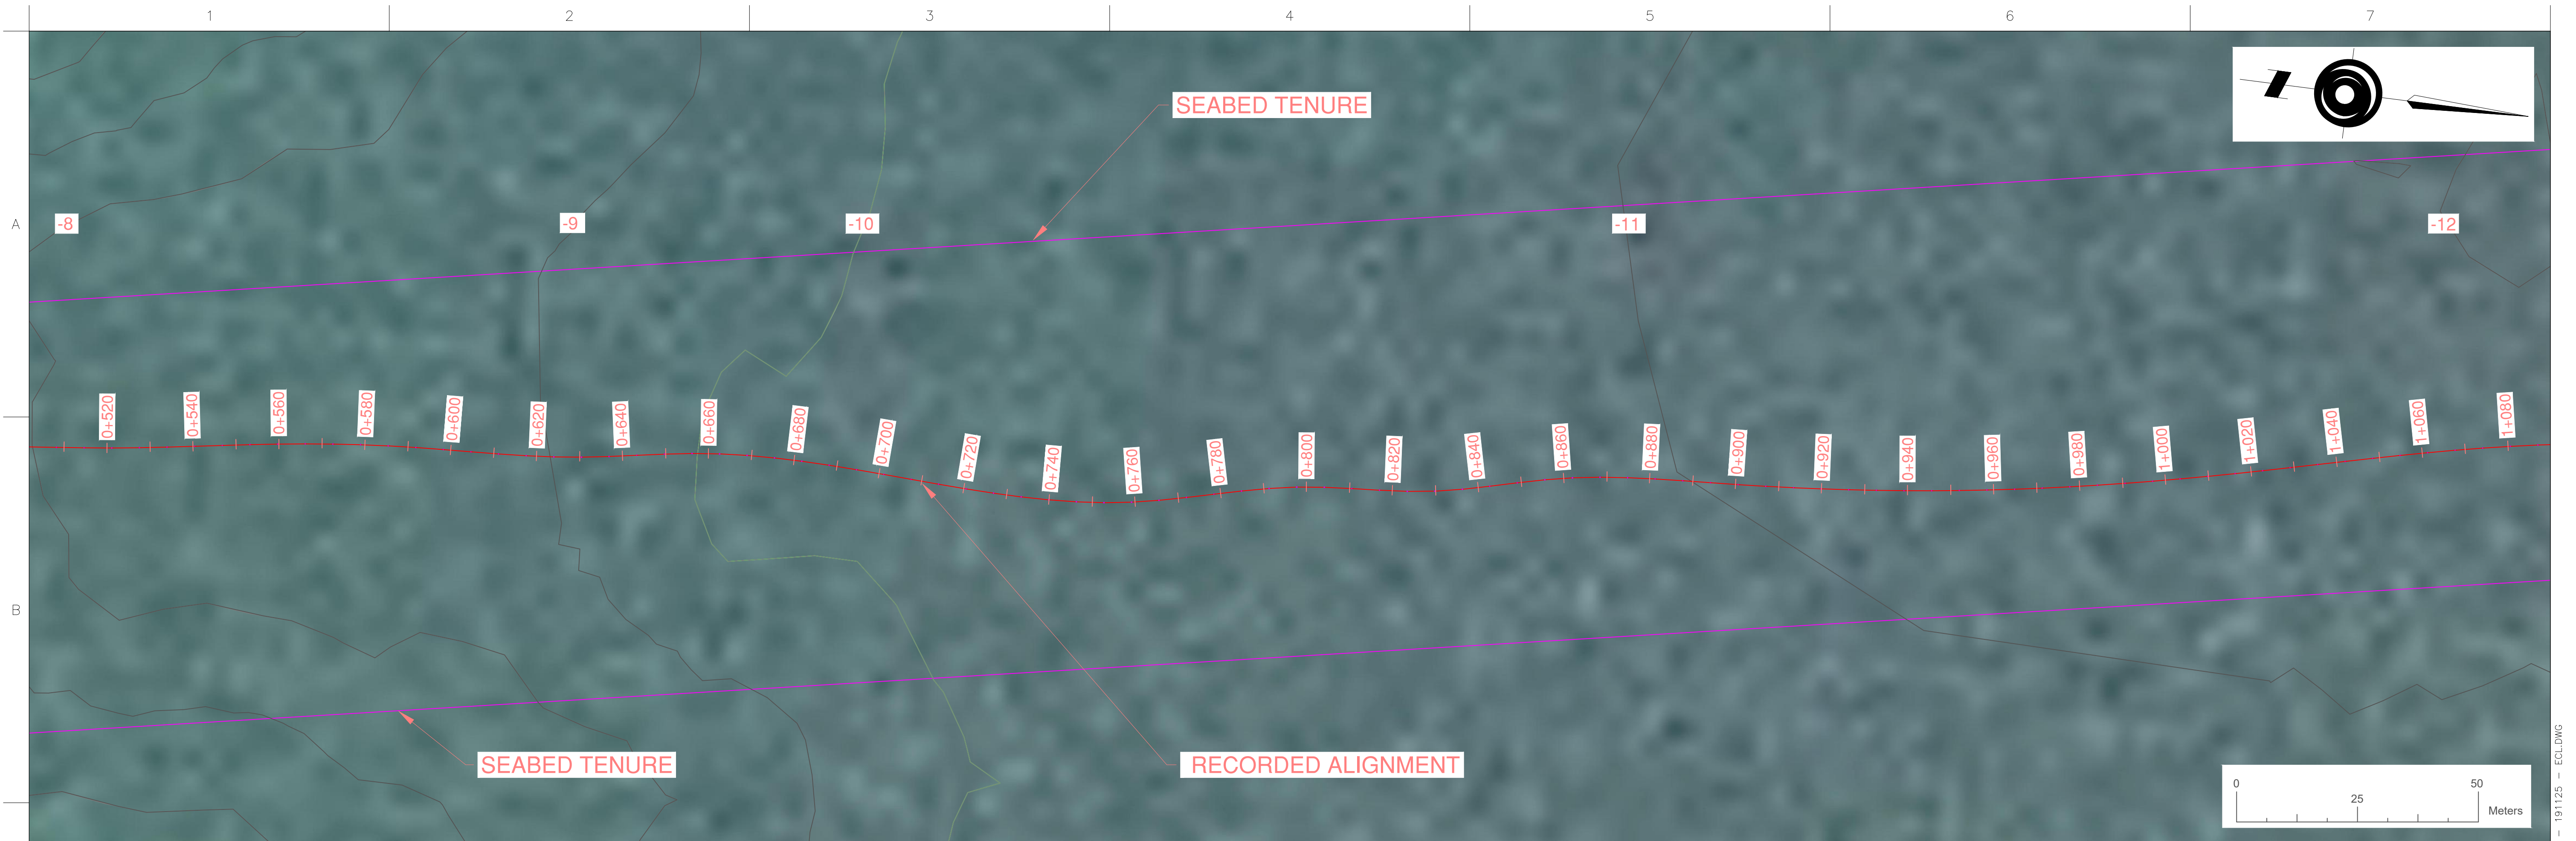



10" IPS DR17 HDPE PIPE  
WEIGHTING 4.5m c/c  
STN: 0+500 TO 1+700

2



M008

PERMIT TO PRACTICE  
GREATPACIFIC CONSULTING LTD.  
Signature  
Date 2019/11/27  
PERMIT NUMBER: P 1290  
NT/NU Association of Professional  
Engineers and Geoscientists

					<div><div><b>GREATPACIFIC</b> ENGINEERING &amp; ENVIRONMENT</div><div>GREATPACIFIC CONSULTING LTD 202-2780 VETERANS MEMORIAL PARKWAY VICTORIA, BC V9B 3S6 778-433-2672 www.greatpacific.ca</div></div>	PERMIT/STAMP:	NOTES:  1. GREATPACIFIC RECORDED DEPLOYED OUTFALL ALIGNMENT ON 2019/08/15 USING A SINGLE BEAM LOWRANCE HDS9 GEN 2 CHART PLOTTER/ECHO SOUNDER WITH A POINT-1 GPS ANTENNA/DIGITAL COMPASS. 2. WATER LEVELS ADJUSTED TO GEODETIC DATA. (RESCAN, 2011)	<div></div>	MARINE OUTFALL RECORDED ALIGNMENT PLAN AND PROFILE					
									DRAWING NUMBER:	M005				
19-11-25	REV 0	ECL	AH	AH					PROJECT NUMBER:	1065-001	SCALE:	1:750	REV:	REV 0
19-11-22	AS RECORDED FOR CLIENT REVIEW	ECL	AH	JC										
19-09-16	AS RECORDED FOR CLIENT REVIEW	TRB	AH	JC										
DATE	DESCRIPTION	DRAWN	DESIGNED	APPROVED										

FILE: W:\1065-001 -TMAC -OCEAN DISCHARGE AND INTAKE\DRAWINGS\RECORD DRAWINGS\1065-001 TMAC - OCEAN OUTFALL - REV0 - 191125 - ECL.DWG  
DATE/TIME: 2019-11-18 11:24 AM



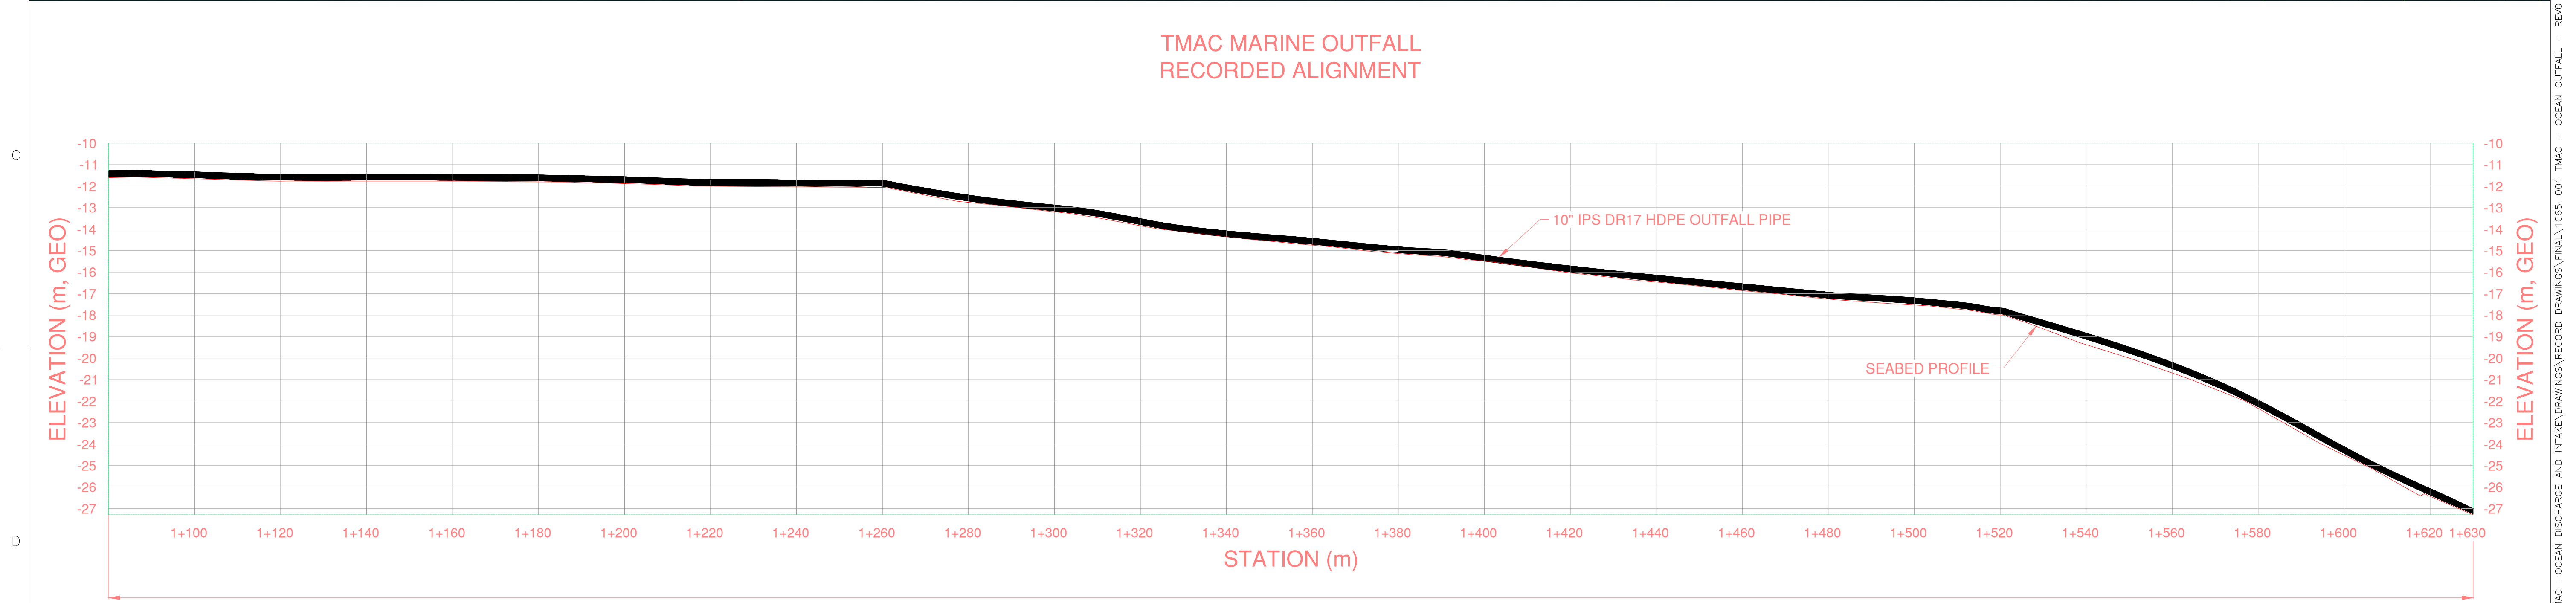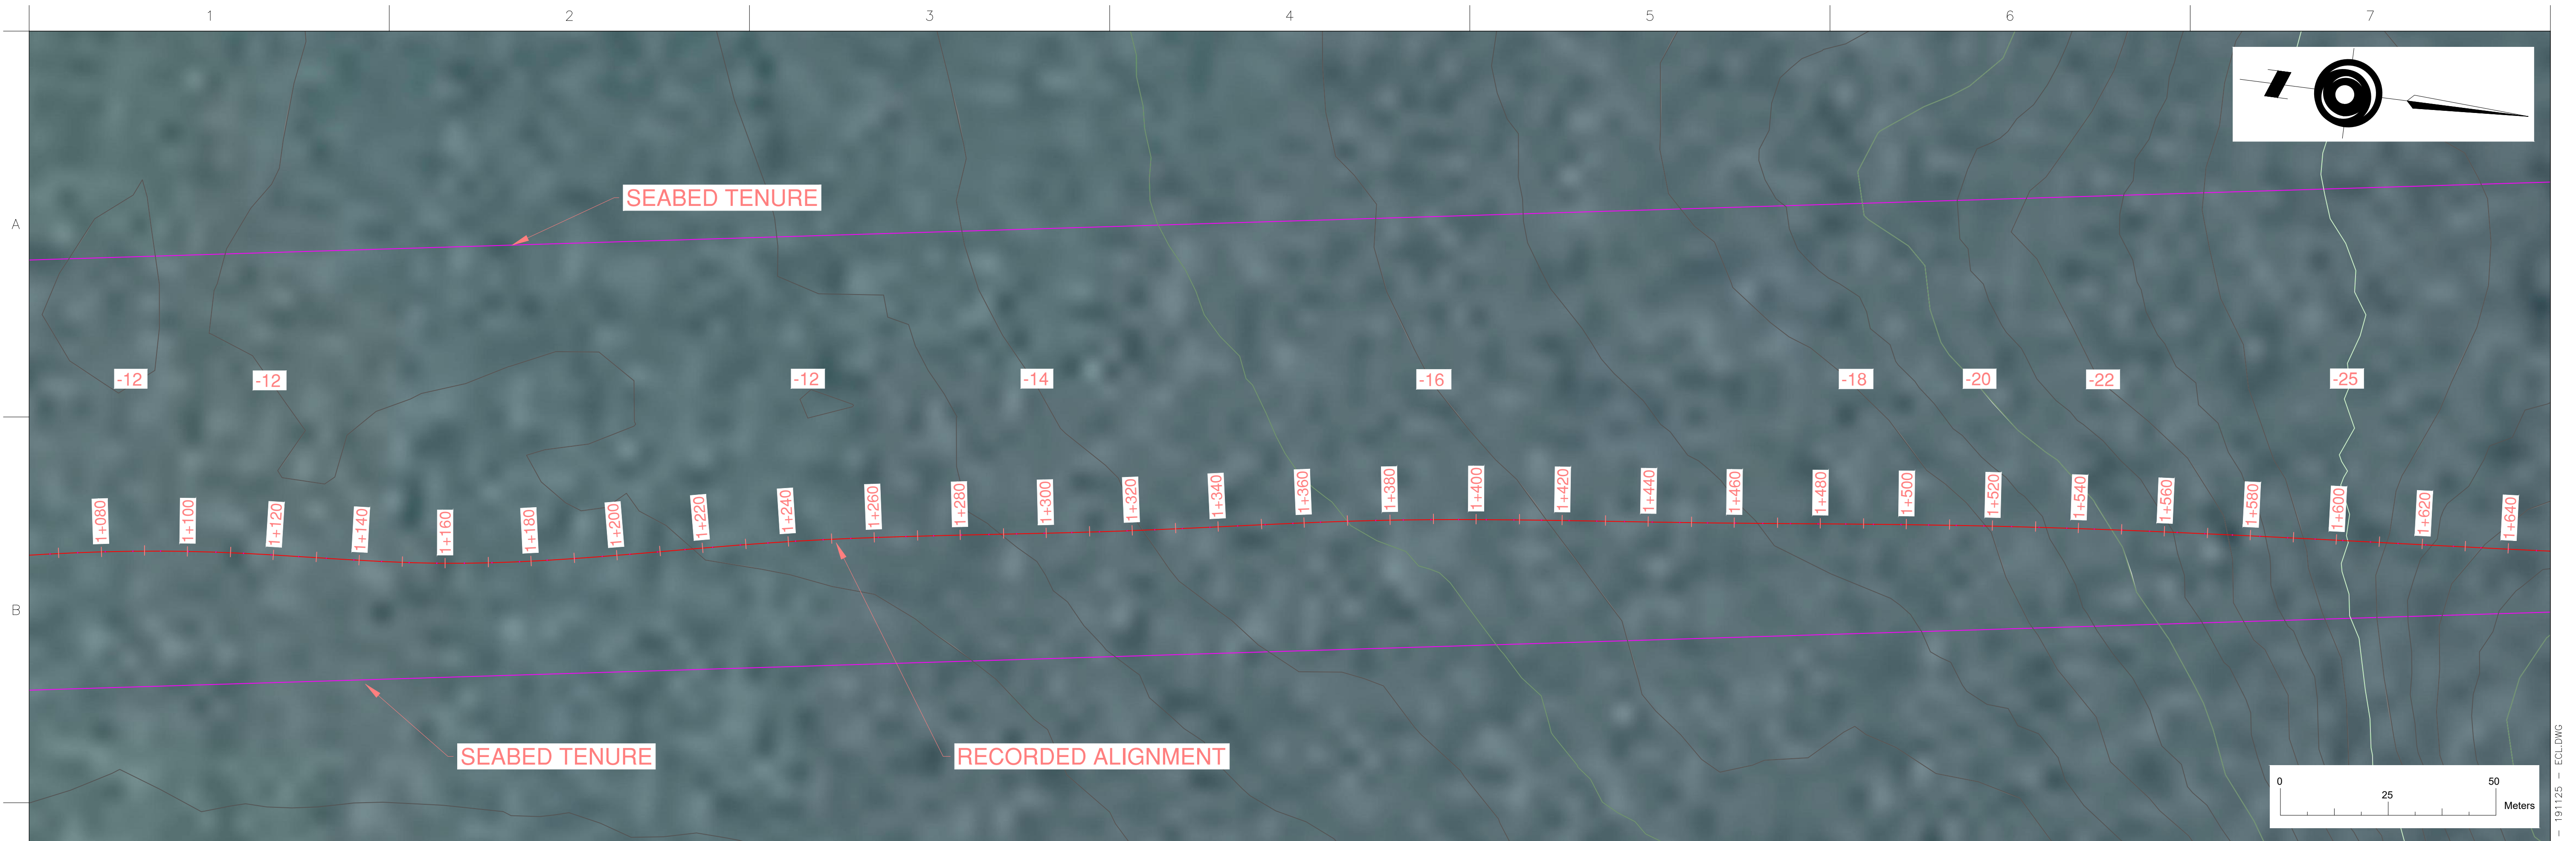

\* The seal and signature of the undersigned on this drawing certifies that the design information contained in these drawings accurately reflects the original design and the material design changes made during construction that were brought to the undersigned's attention. These drawings are intended to incorporate addenda, change orders, and other material design changes, but not necessarily, all site instructions. The undersigned does not warrant or guarantee, nor accept any responsibility for the accuracy or completeness of the as-constructed information supplied by others contained in these drawings, but does, by sealing and signing, certify that the as-constructed information, if accurate and complete, provides an as-constructed system which substantially complies in all material respects with the original design intent.\*

19-11-25	REV 0	ECL	AH	AH
19-11-22	AS RECORDED FOR CLIENT REVIEW	ECL	AH	JC
19-09-16	AS RECORDED FOR CLIENT REVIEW	TRB	AH	JC
DATE	DESCRIPTION	DRAWN	DESIGNED	APPROVED



**GREATPACIFIC**  
ENGINEERING & ENVIRONMENT

GREATPACIFIC CONSULTING LTD  
202-2780 VETERANS MEMORIAL PARKWAY  
VICTORIA, BC V9B 3S6  
778-433-2672  
www.greatpacific.ca

PERMIT/STAMP:

2  
M008

NOTES:

- GREATPACIFIC RECORDED OUTFALL ALIGNMENT ON 2019/08/15 USING A SINGLE BEAM LOWRANCE HDS9 GEN 2 CHART PLOTTER/ECHO SOUNDER WITH A POINT-1 GPS ANTENNA/DIGITAL COMPASS.
- WATER LEVELS ADJUSTED TO GEODETIC DATA. (RESCAN, 2011)

CLIENT:



PROJECT NUMBER:

1065-001

MARINE OUTFALL  
RECORDED ALIGNMENT  
PLAN AND PROFILE

DRAWING NUMBER:

M006



SCALE:

1:750

REV:

REV 0



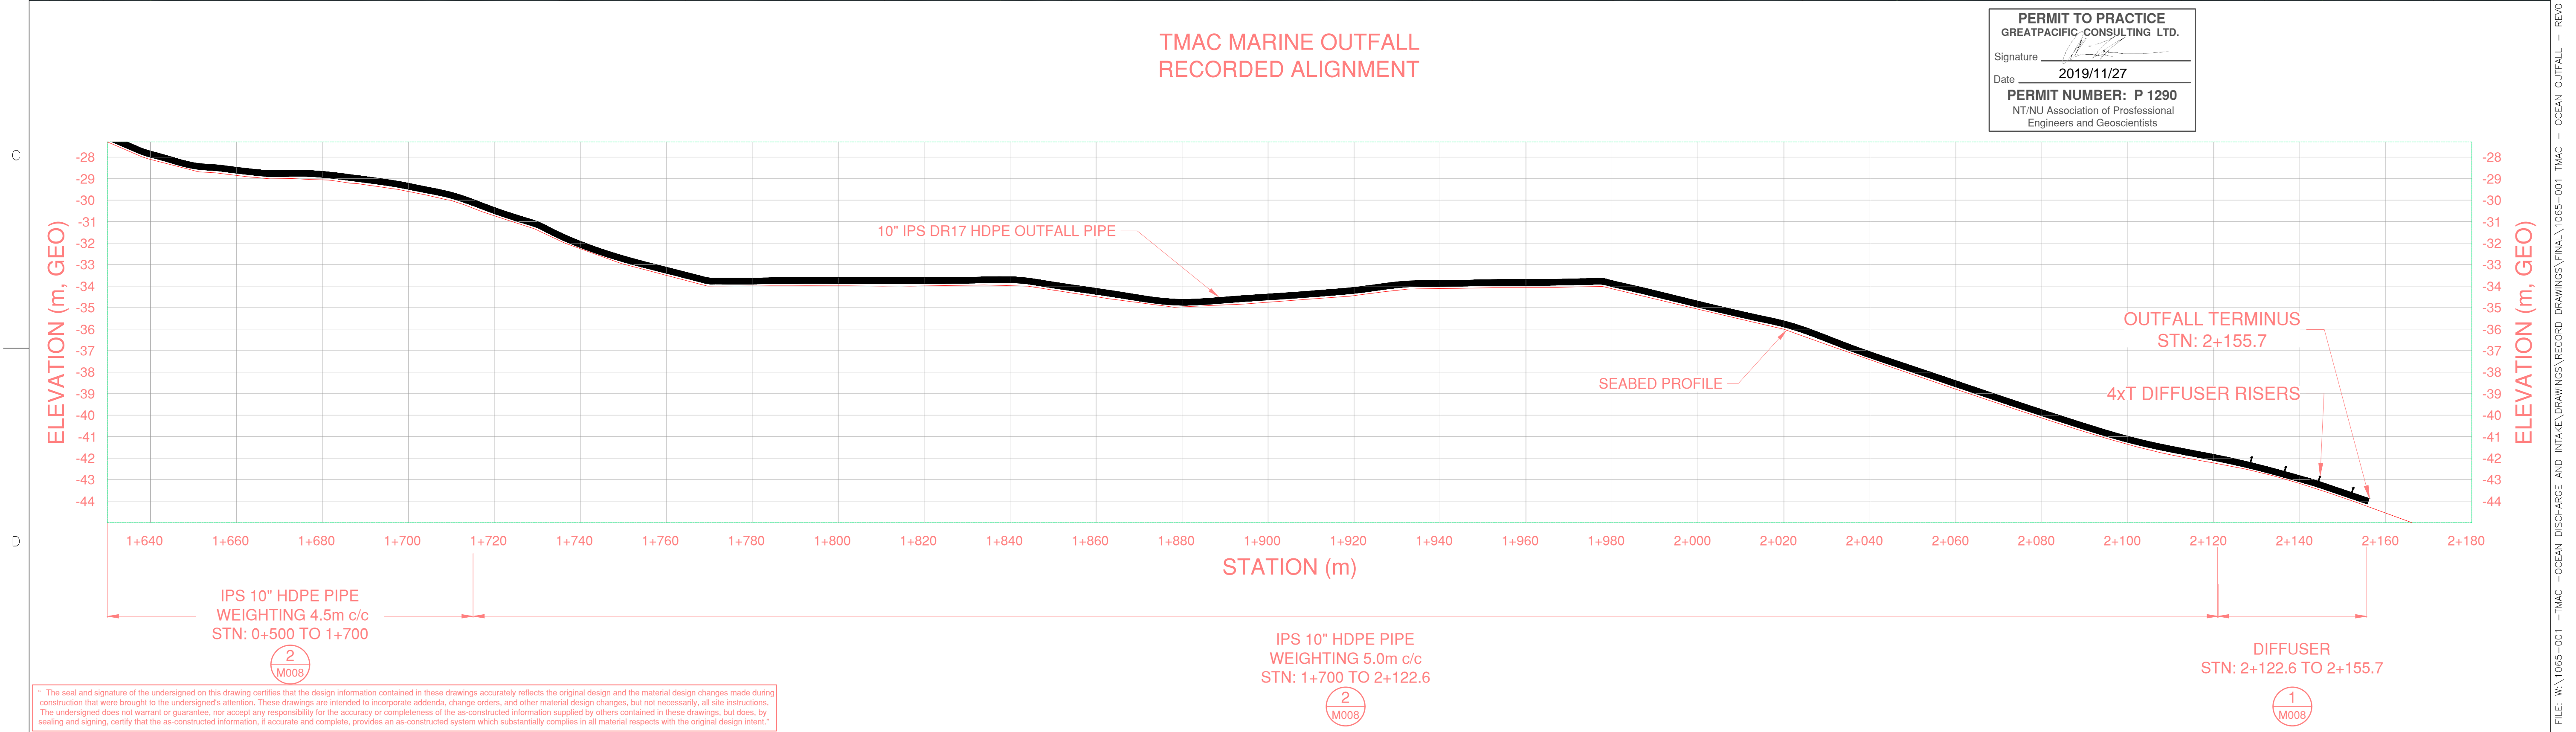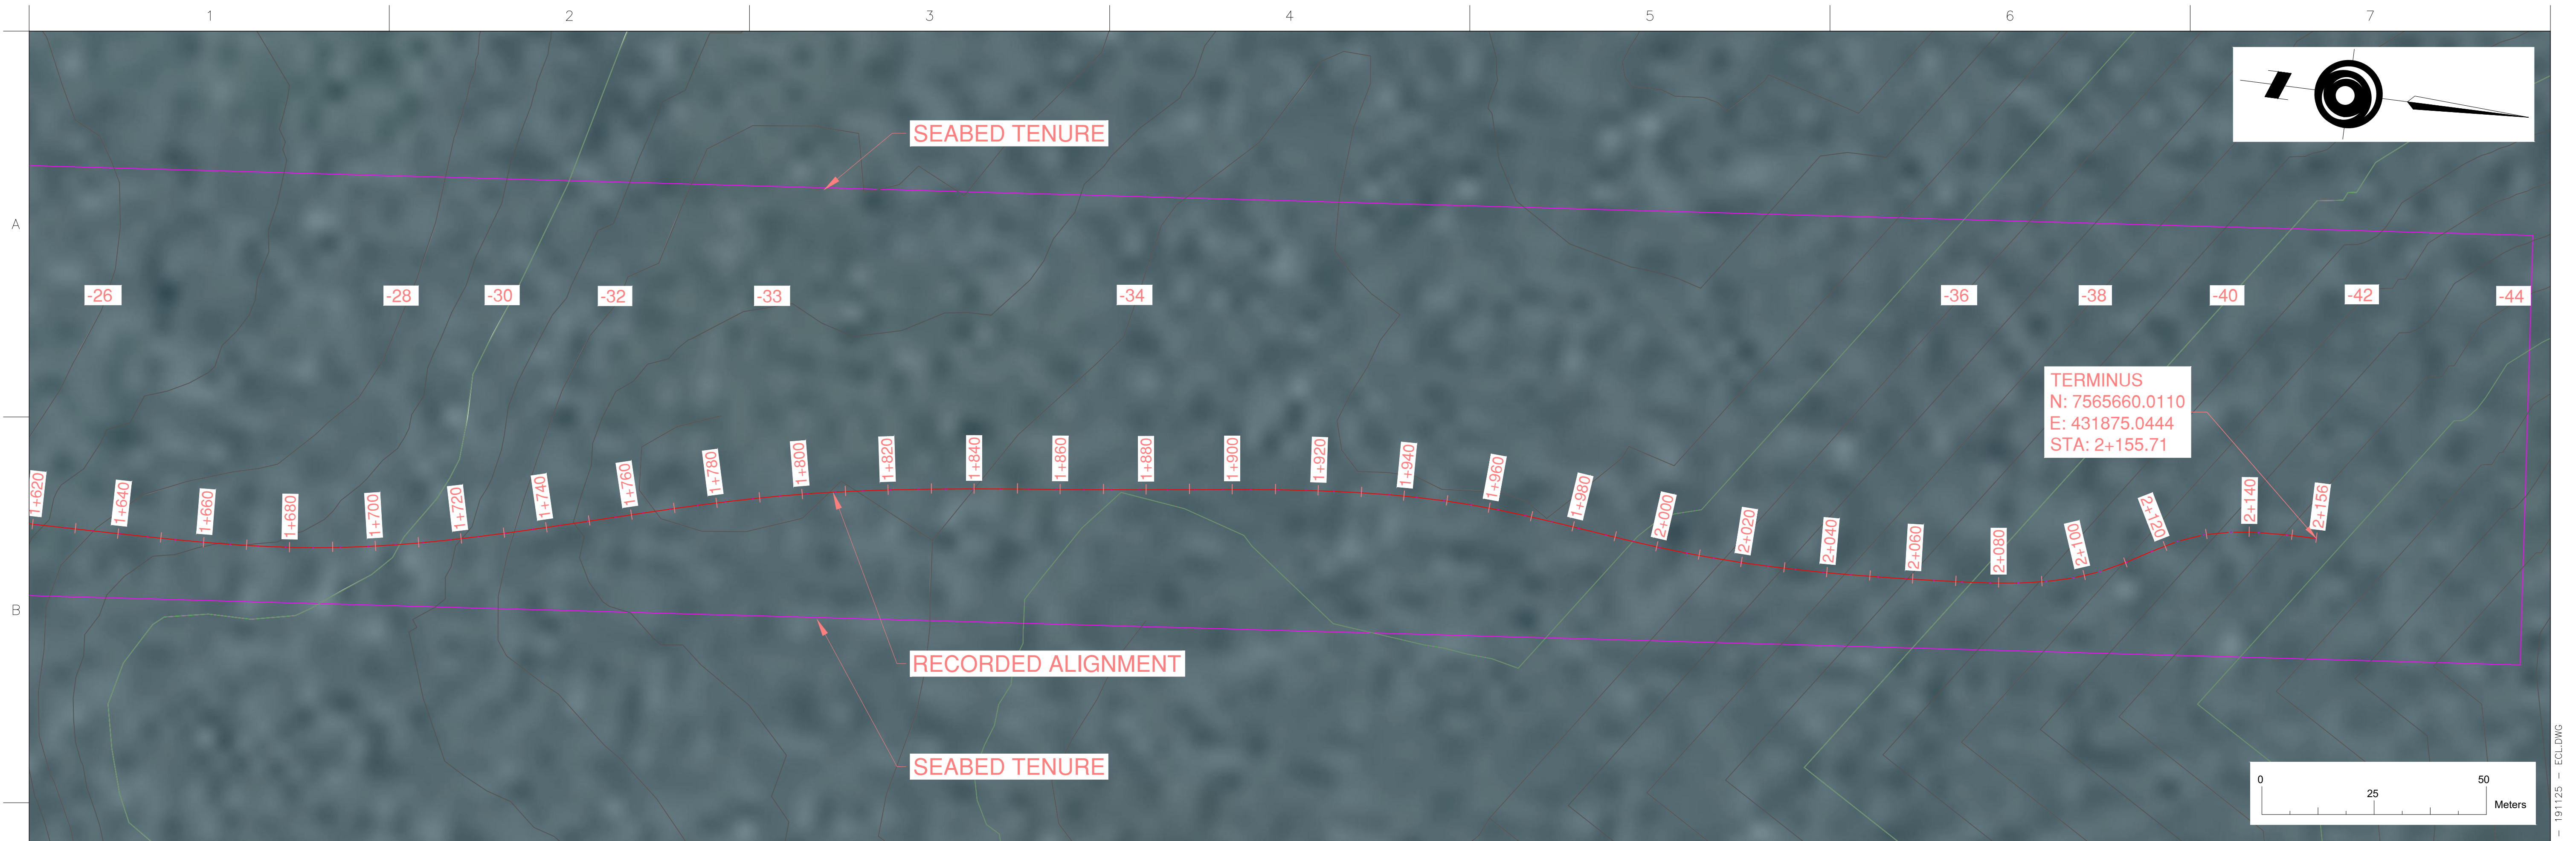

\* The seal and signature of the undersigned on this drawing certifies that the design information contained in these drawings accurately reflects the original design and the material design changes made during construction that were brought to the undersigned's attention. These drawings are intended to incorporate addenda, change orders, and other material design changes, but not necessarily, all site instructions. The undersigned does not warrant or guarantee, nor accept any responsibility for the accuracy or completeness of the as-constructed information supplied by others contained in these drawings, but does, by sealing and signing, certify that the as-constructed information, if accurate and complete, provides an as-constructed system which substantially complies in all material respects with the original design intent.\*

19-11-25	REV 0	ECL	AH	AH
19-11-22	AS RECORDED FOR CLIENT REVIEW	ECL	AH	JC
19-09-16	AS RECORDED FOR CLIENT REVIEW	TRB	AH	JC
DATE	DESCRIPTION	DRAWN	DESIGNED	APPROVED



**GREATPACIFIC**  
ENGINEERING & ENVIRONMENT

GREATPACIFIC CONSULTING LTD  
202-2780 VETERANS MEMORIAL PARKWAY  
VICTORIA, BC V9B 3S6  
778-433-2672  
www.greatpacific.ca

PERMIT/STAMP:

NOTES:

- GREATPACIFIC RECORDED DEPLOYED OUTFALL ALIGNMENT ON 2019/08/15 USING A SINGLE BEAM LOWRANCE HDS9 GEN 2 CHART PLOTTER/ECHO SOUNDER WITH A POINT-1 GPS ANTENNA/DIGITAL COMPASS.
- WATER LEVELS ADJUSTED TO GEODETIC DATA. (RESCAN, 2011)

CLIENT:



PROJECT NUMBER:

1065-001

MARINE OUTFALL  
RECORDED ALIGNMENT  
PLAN AND PROFILE

DRAWING NUMBER:

M007


SCALE:

1:750

REV:

REV 0



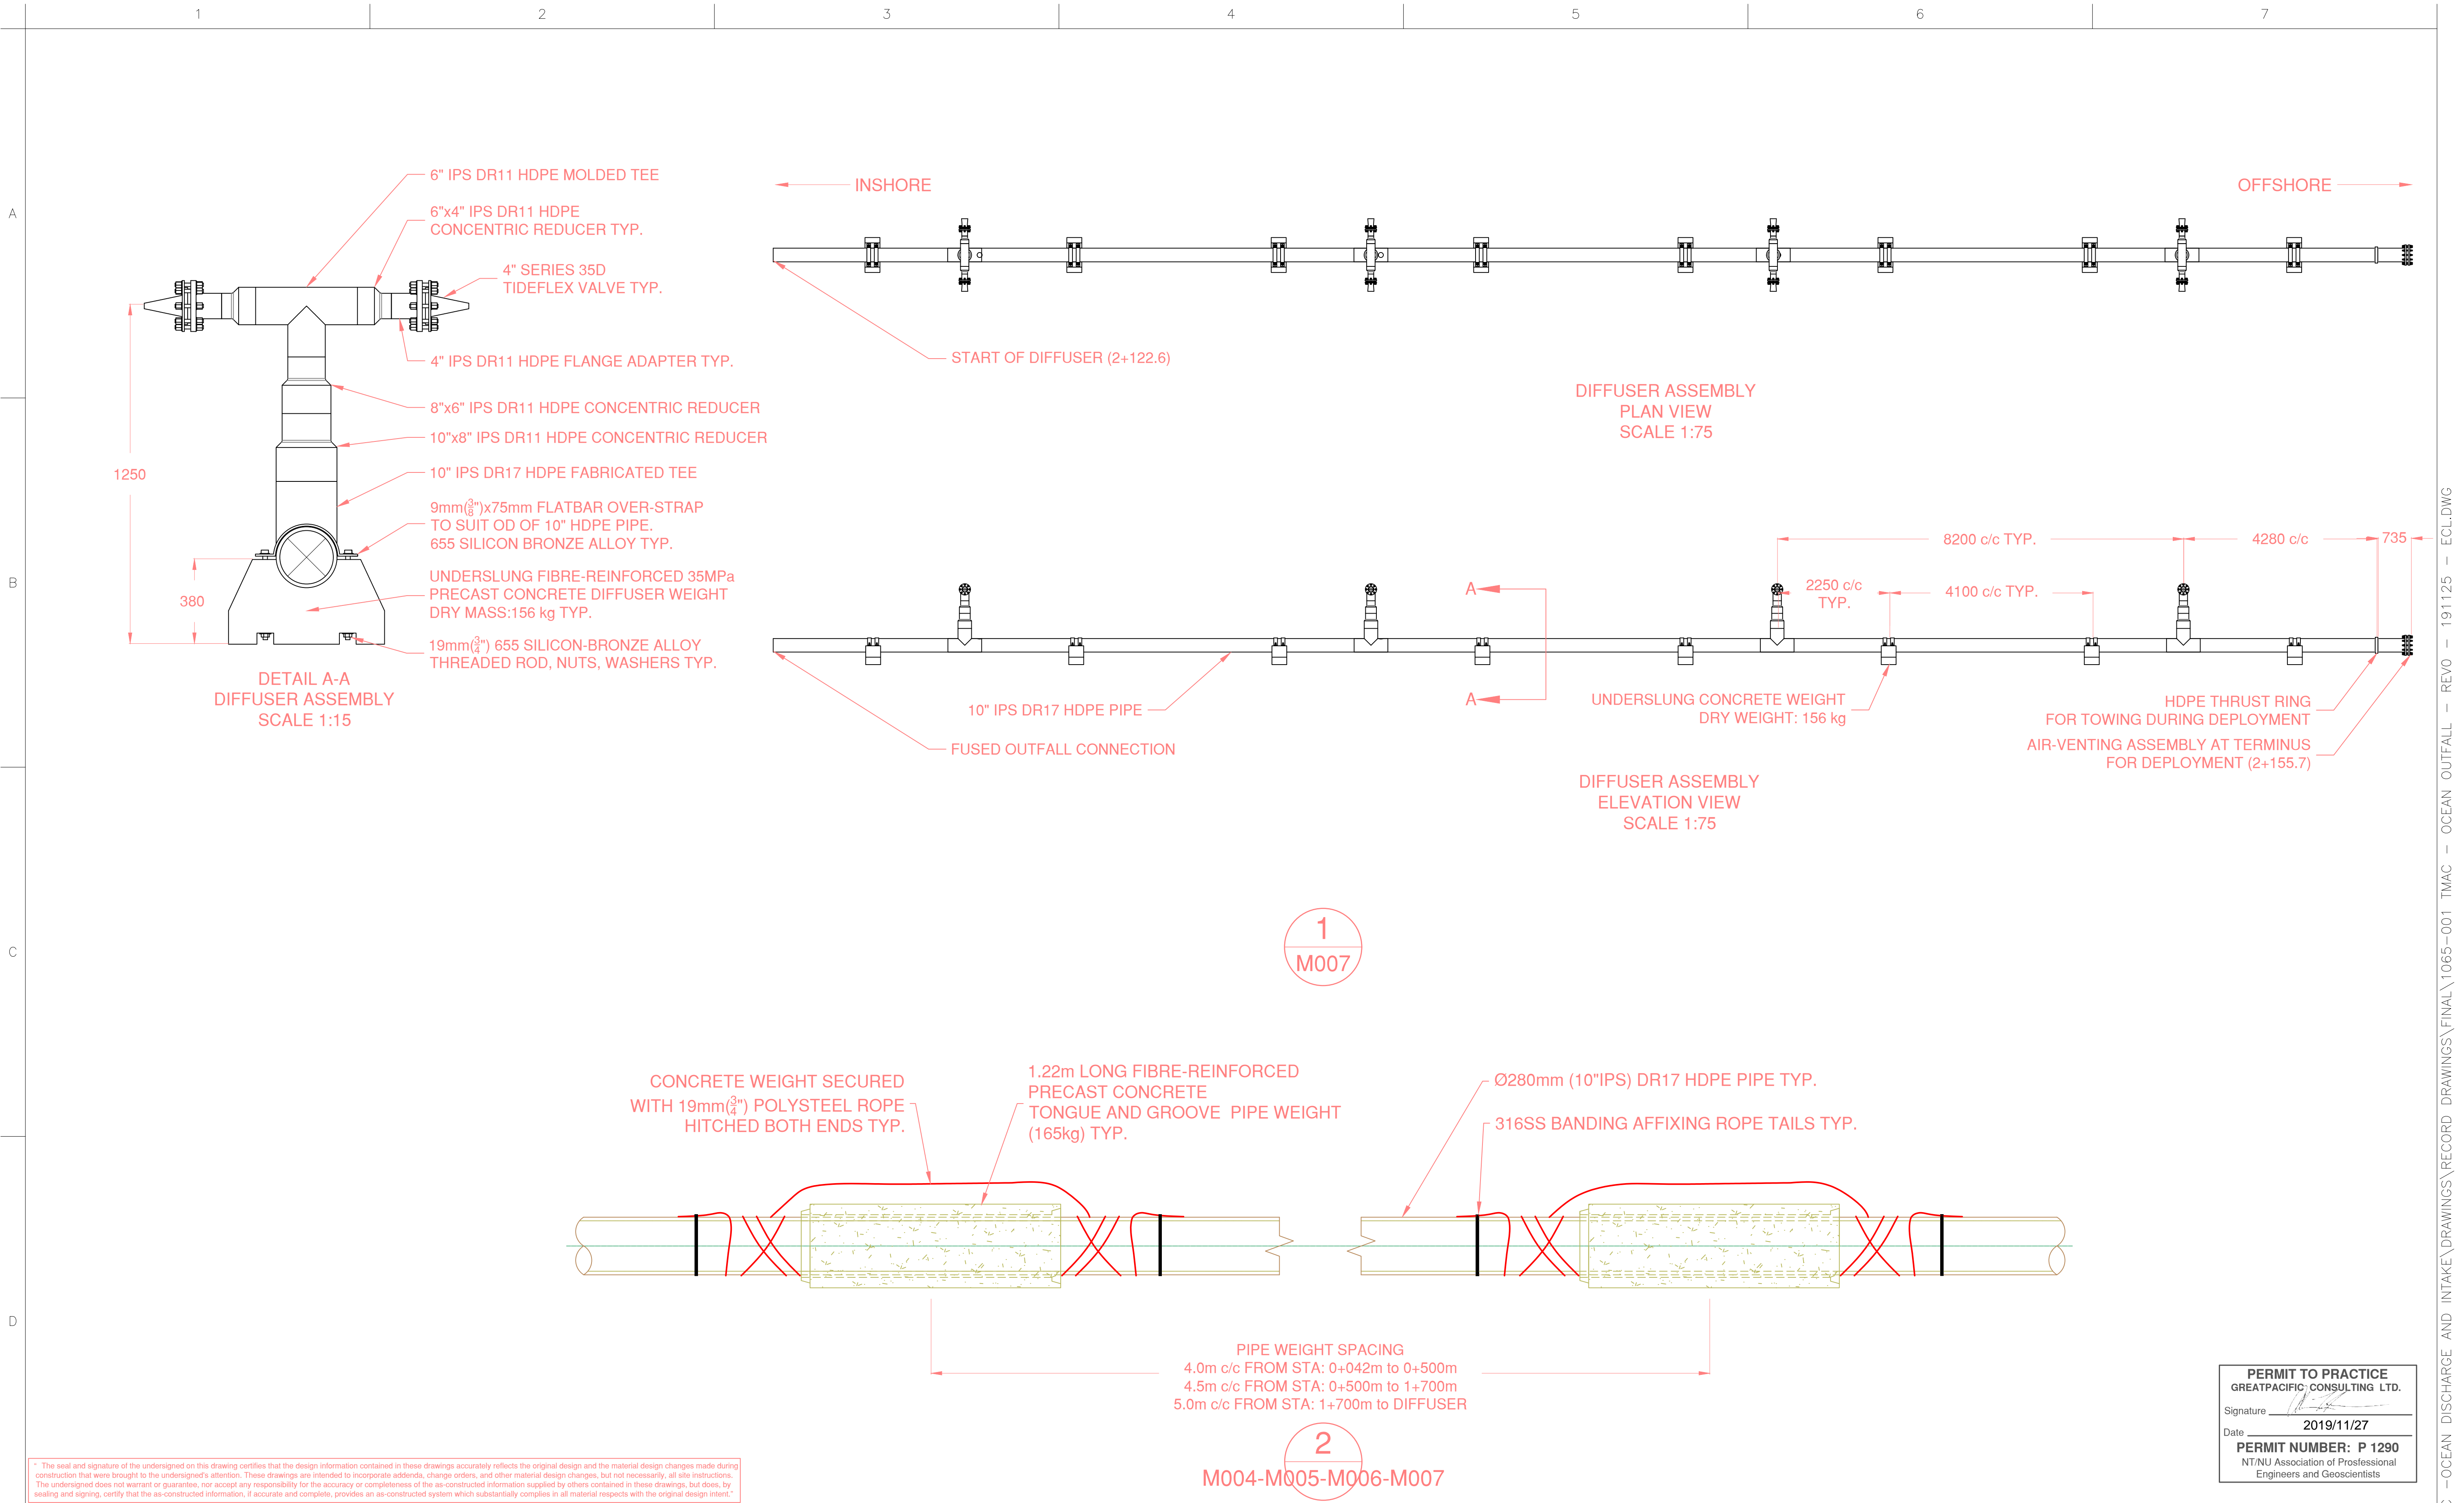

\* The seal and signature of the undersigned on this drawing certifies that the design information contained in these drawings accurately reflects the original design and the material design changes made during construction that were brought to the undersigned's attention. These drawings are intended to incorporate addenda, change orders, and other material design changes, but not necessarily, all site instructions. The undersigned does not warrant or guarantee, nor accept any responsibility for the accuracy or completeness of the as-constructed information supplied by others contained in these drawings, but does, by sealing and signing, certify that the as-constructed information, if accurate and complete, provides an as-constructed system which substantially complies in all material respects with the original design intent.\*

19-11-25	REV 0	ECL	AH	AH
19-11-22	AS RECORDED FOR CLIENT REVIEW	ECL	AH	AH
19-10-08	AS RECORDED FOR CLIENT REVIEW	BC	AH	AH
DATE	DESCRIPTION	DRAWN	DESIGNED	APPROVED

**GREATPACIFIC**  
ENGINEERING & ENVIRONMENT

GREATPACIFIC CONSULTING LTD  
202-2780 VETERANS MEMORIAL PARKWAY  
VICTORIA, BC V9B 3S6  
778-433-2672  
www.greatpacific.ca

PERMIT/STAMP:

NOTES:

- ALL DISTANCES ARE IN MILLIMETERS AND DECIMALS THEREOF UNLESS OTHERWISE STATED.
- DO NOT SCALE FROM DRAWINGS.

CLIENT:



PROJECT NUMBER:

1065-001

SEAWATER INTAKE &  
MARINE EFFLUENT OUTFALL  
DETAILS

DRAWING NUMBER:

M008

SCALE:

AS SHOWN

REV:

























REV 0

FILE: W:\1065-001 -TMAC -OCEAN DISCHARGE AND INTAKE\DRAWINGS\RECORD DRAWINGS\FINAL\1065-001 TMAC - OCEAN OUTFALL - REV0 - 191125 - ECL.DWG



D SIZE (610x914) METRIC



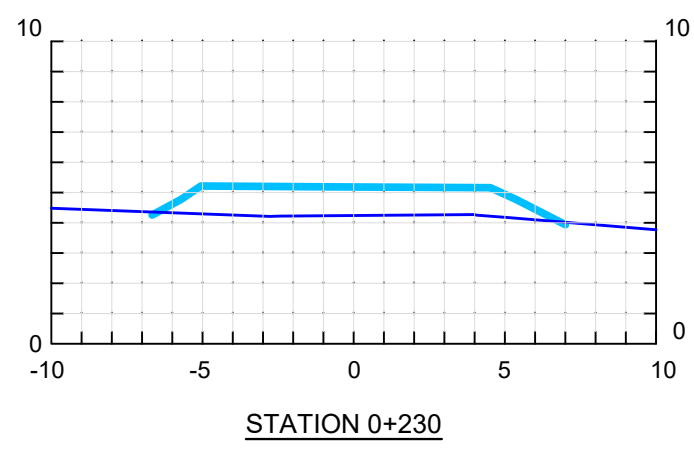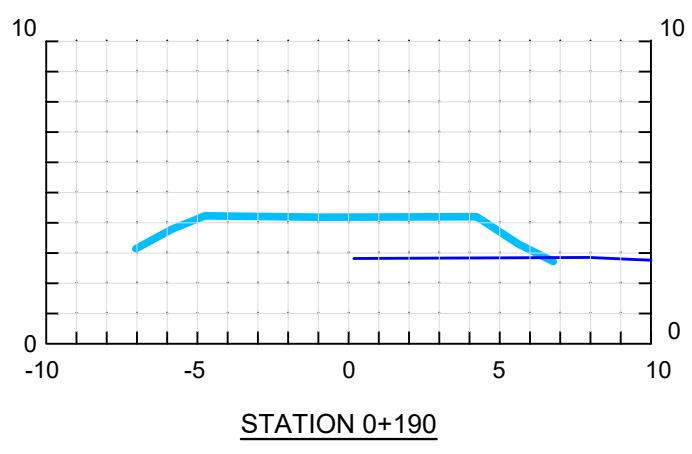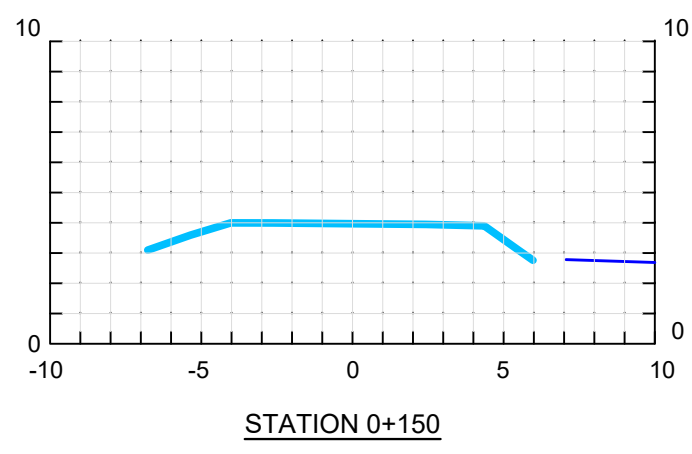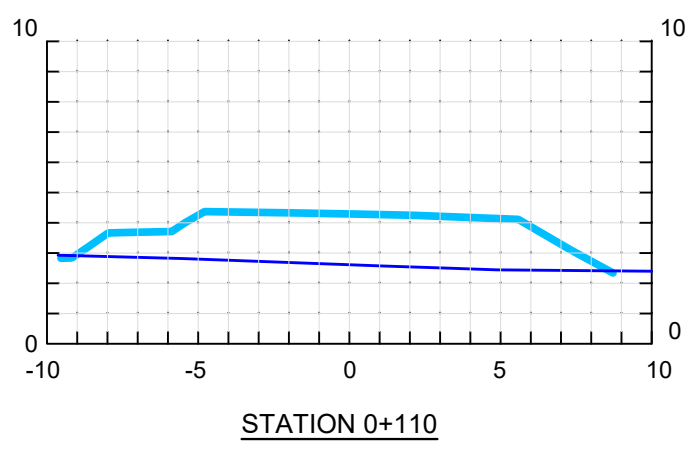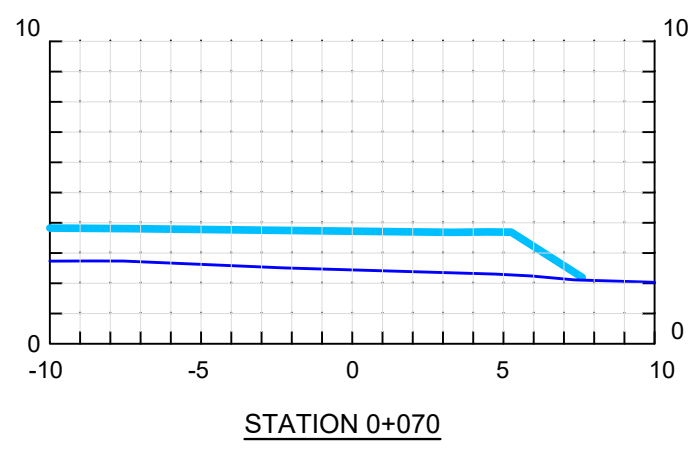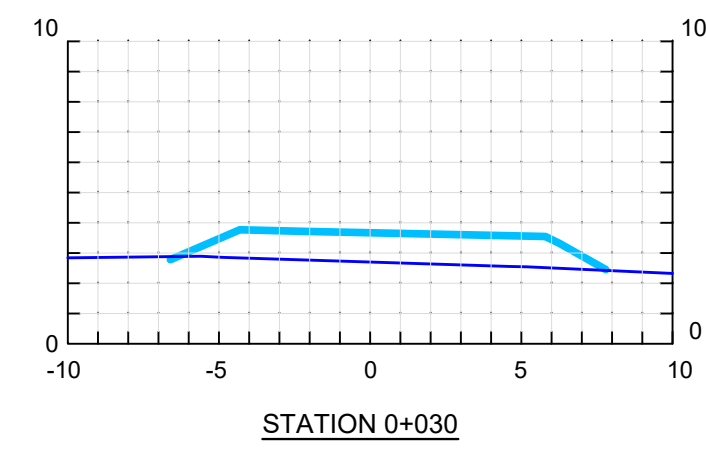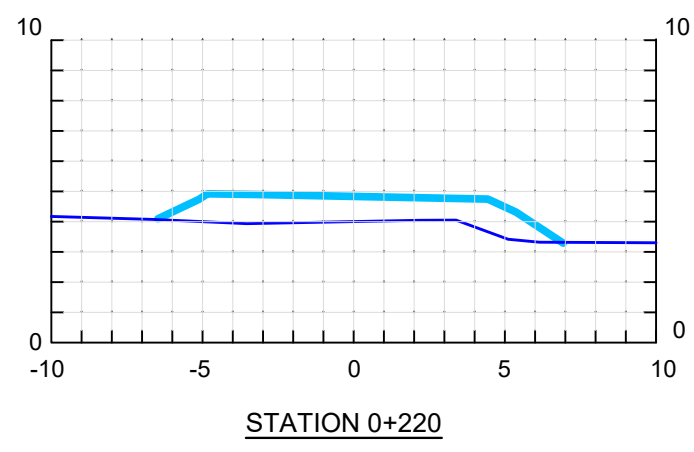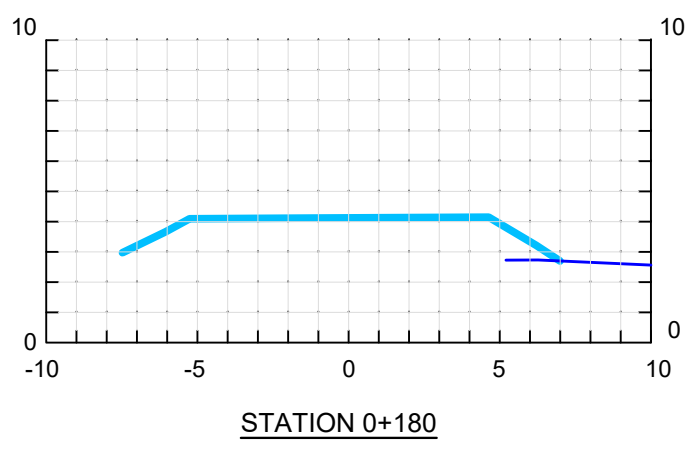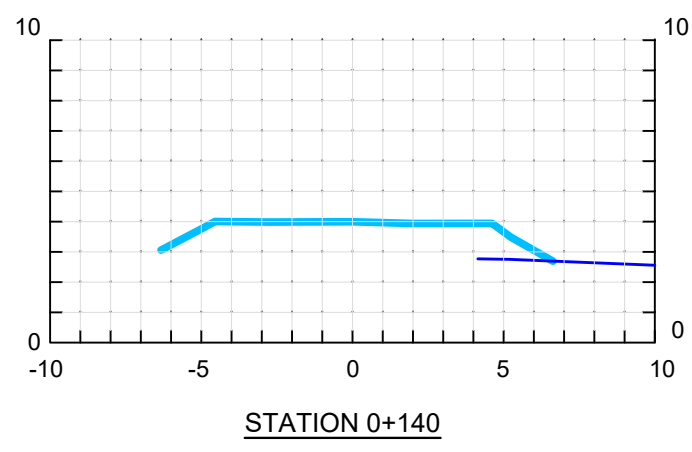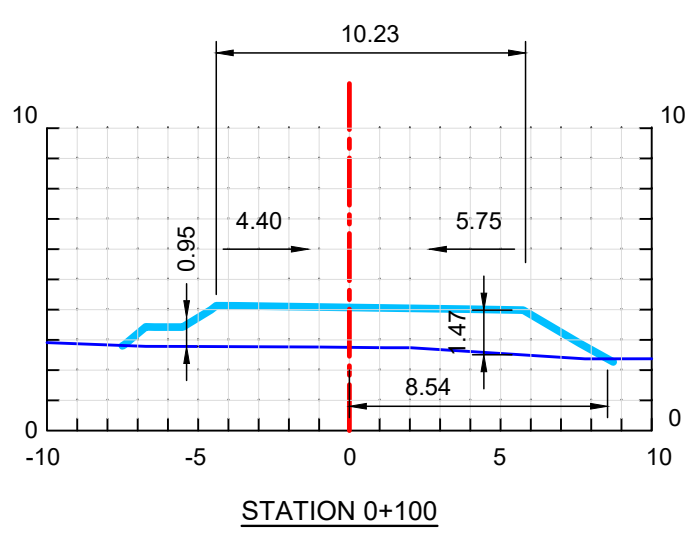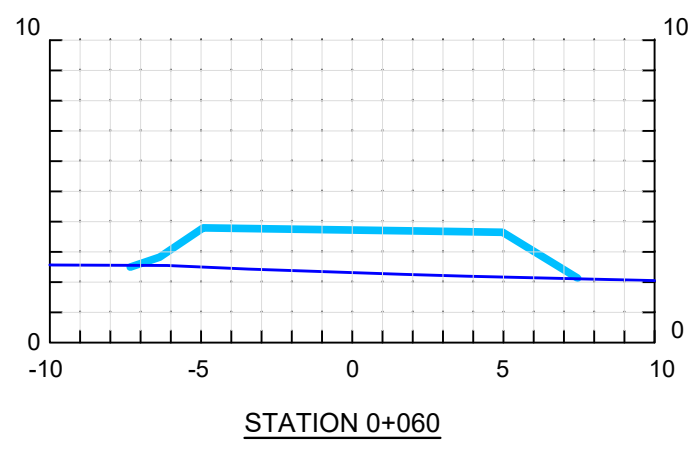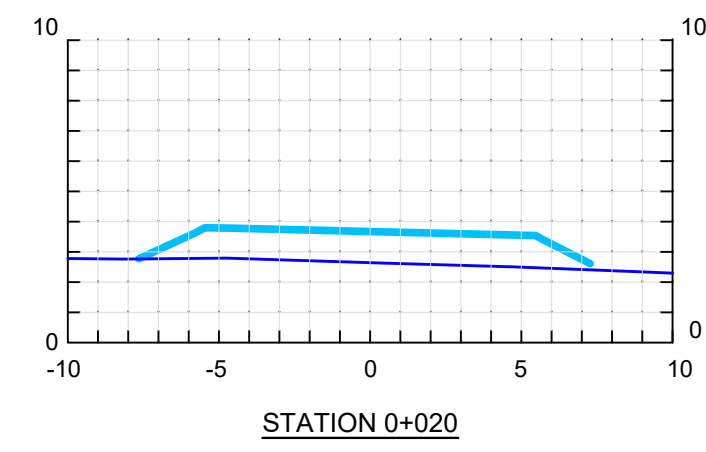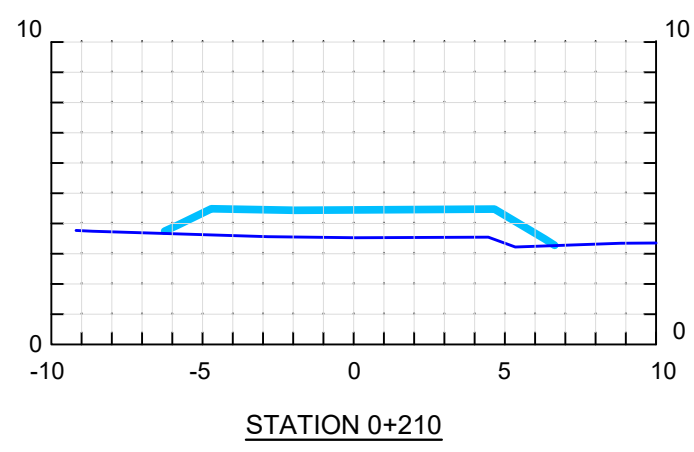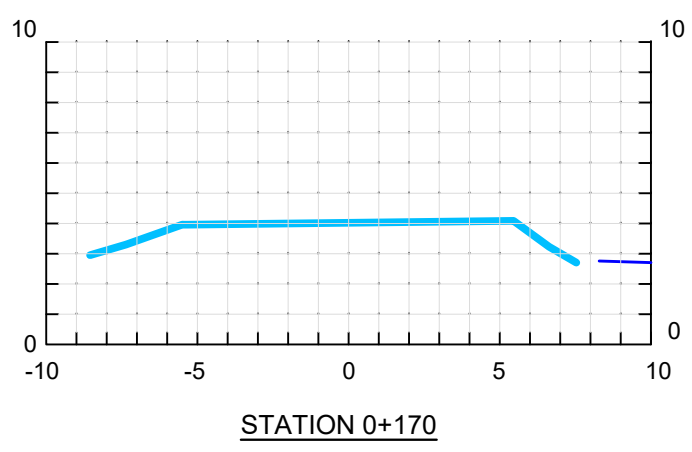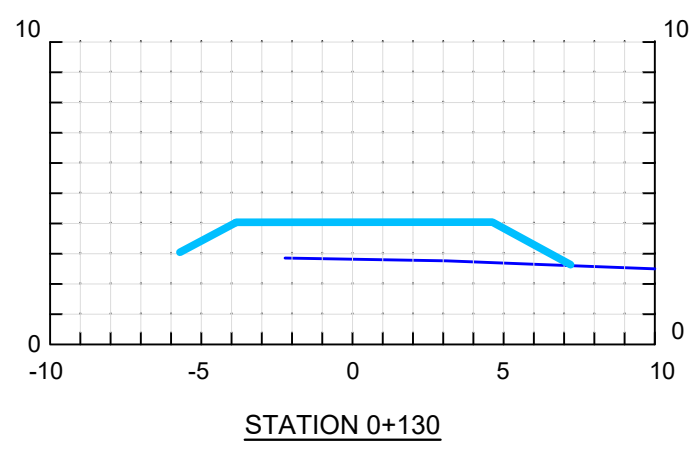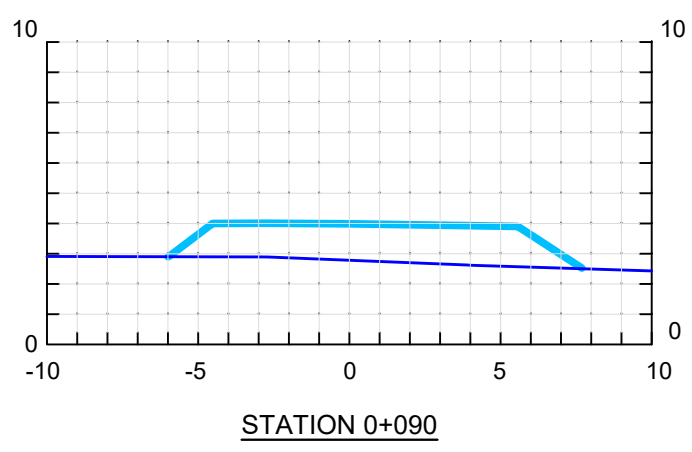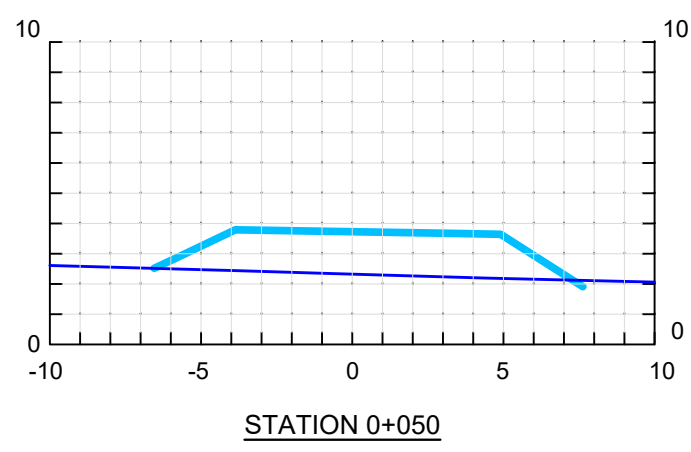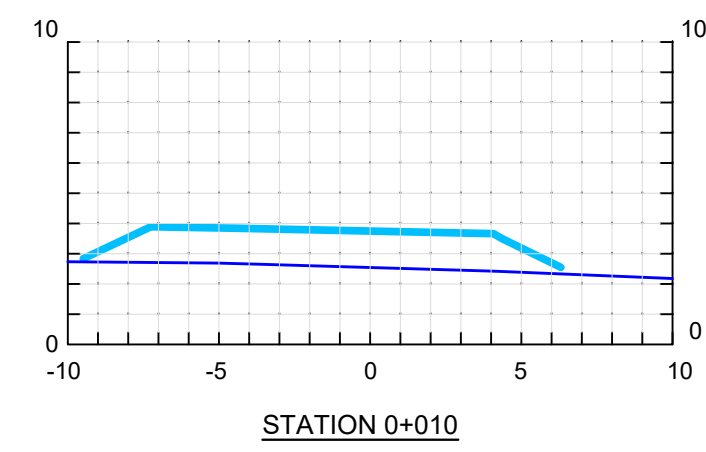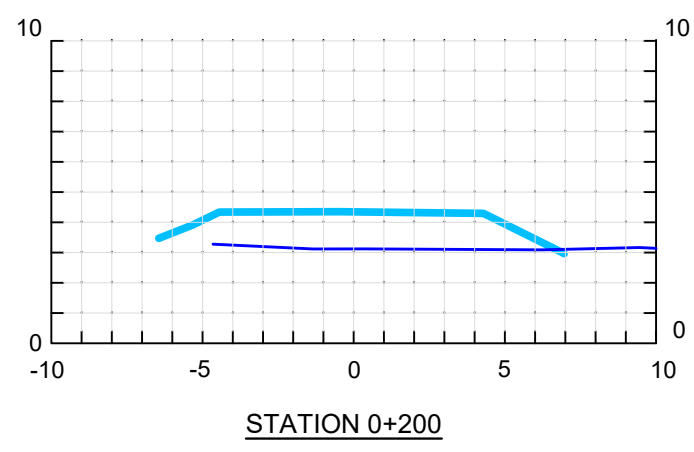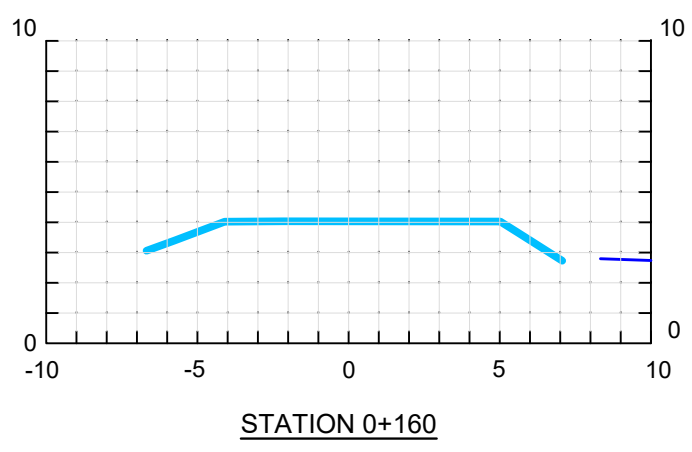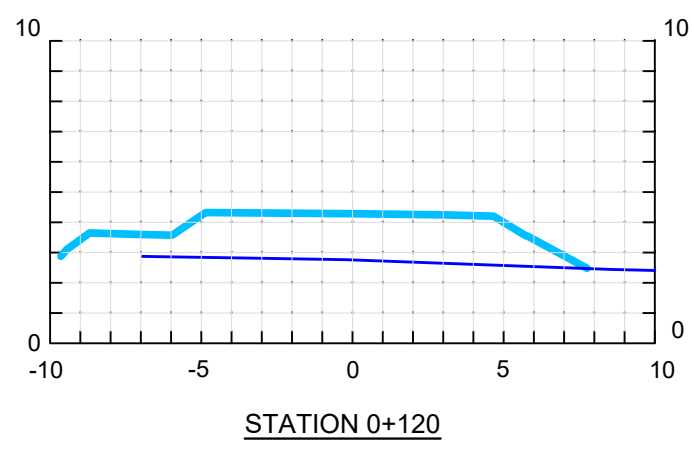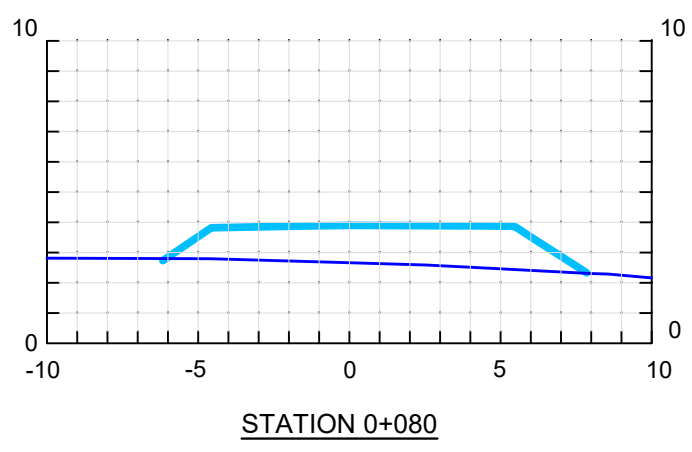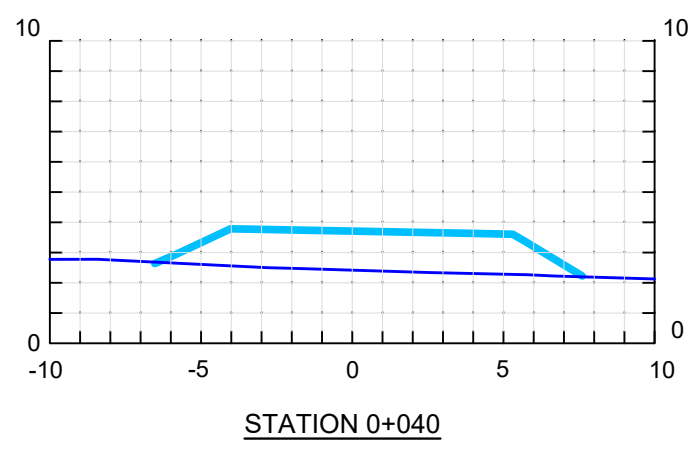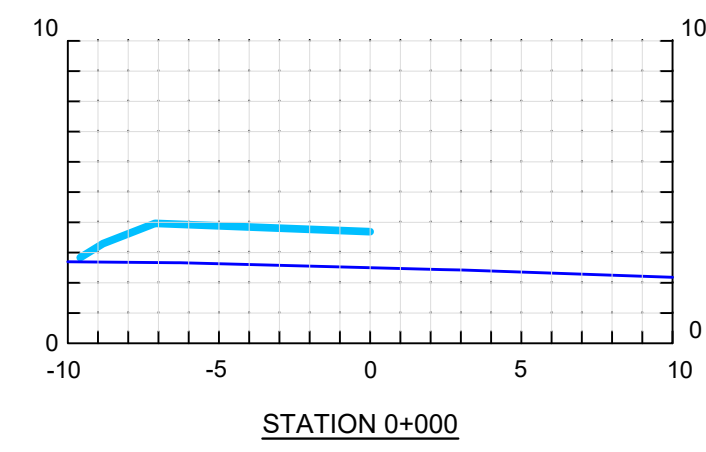


ROBERTS BAY DISCHARGE SYSTEM - JETTY AS-BUILT CROSS-SECTIONS STA.0+000 TO STA. 0+230

SCALE 1:250 HORIZONTAL  
1:250 VERTICAL

## NOTES

1. ALL DIMENSIONS ARE IN METERS UNLESS OTHERWISE STATED.
2. TOPOGRAPHY NAD83 UTM ZONE 13.
3. REFER TO DRAWING 30002-208-2003 FOR JETTY AS-BUILT PLAN
4. REFER TO DRAWING 30002-208-2005, AND 2006  
FOR CROSS SECTIONS.

SCALE



0 5 10 15 20 25m

### LEGEND

— AGGREGATE SUBBASE  
— GRADE

[illegible]













APPENDIX B  
AS-BUILT DRAWINGS


Roberts Bay Discharge System Process Flow Diagram (TMAC)

Overland Pipeline Alignment (TMAC)


Marine Outfall and Intake, Record Drawings (Great Pacific Engineering and Environment)

Marine Outfall Berm and Access Road (TMAC)



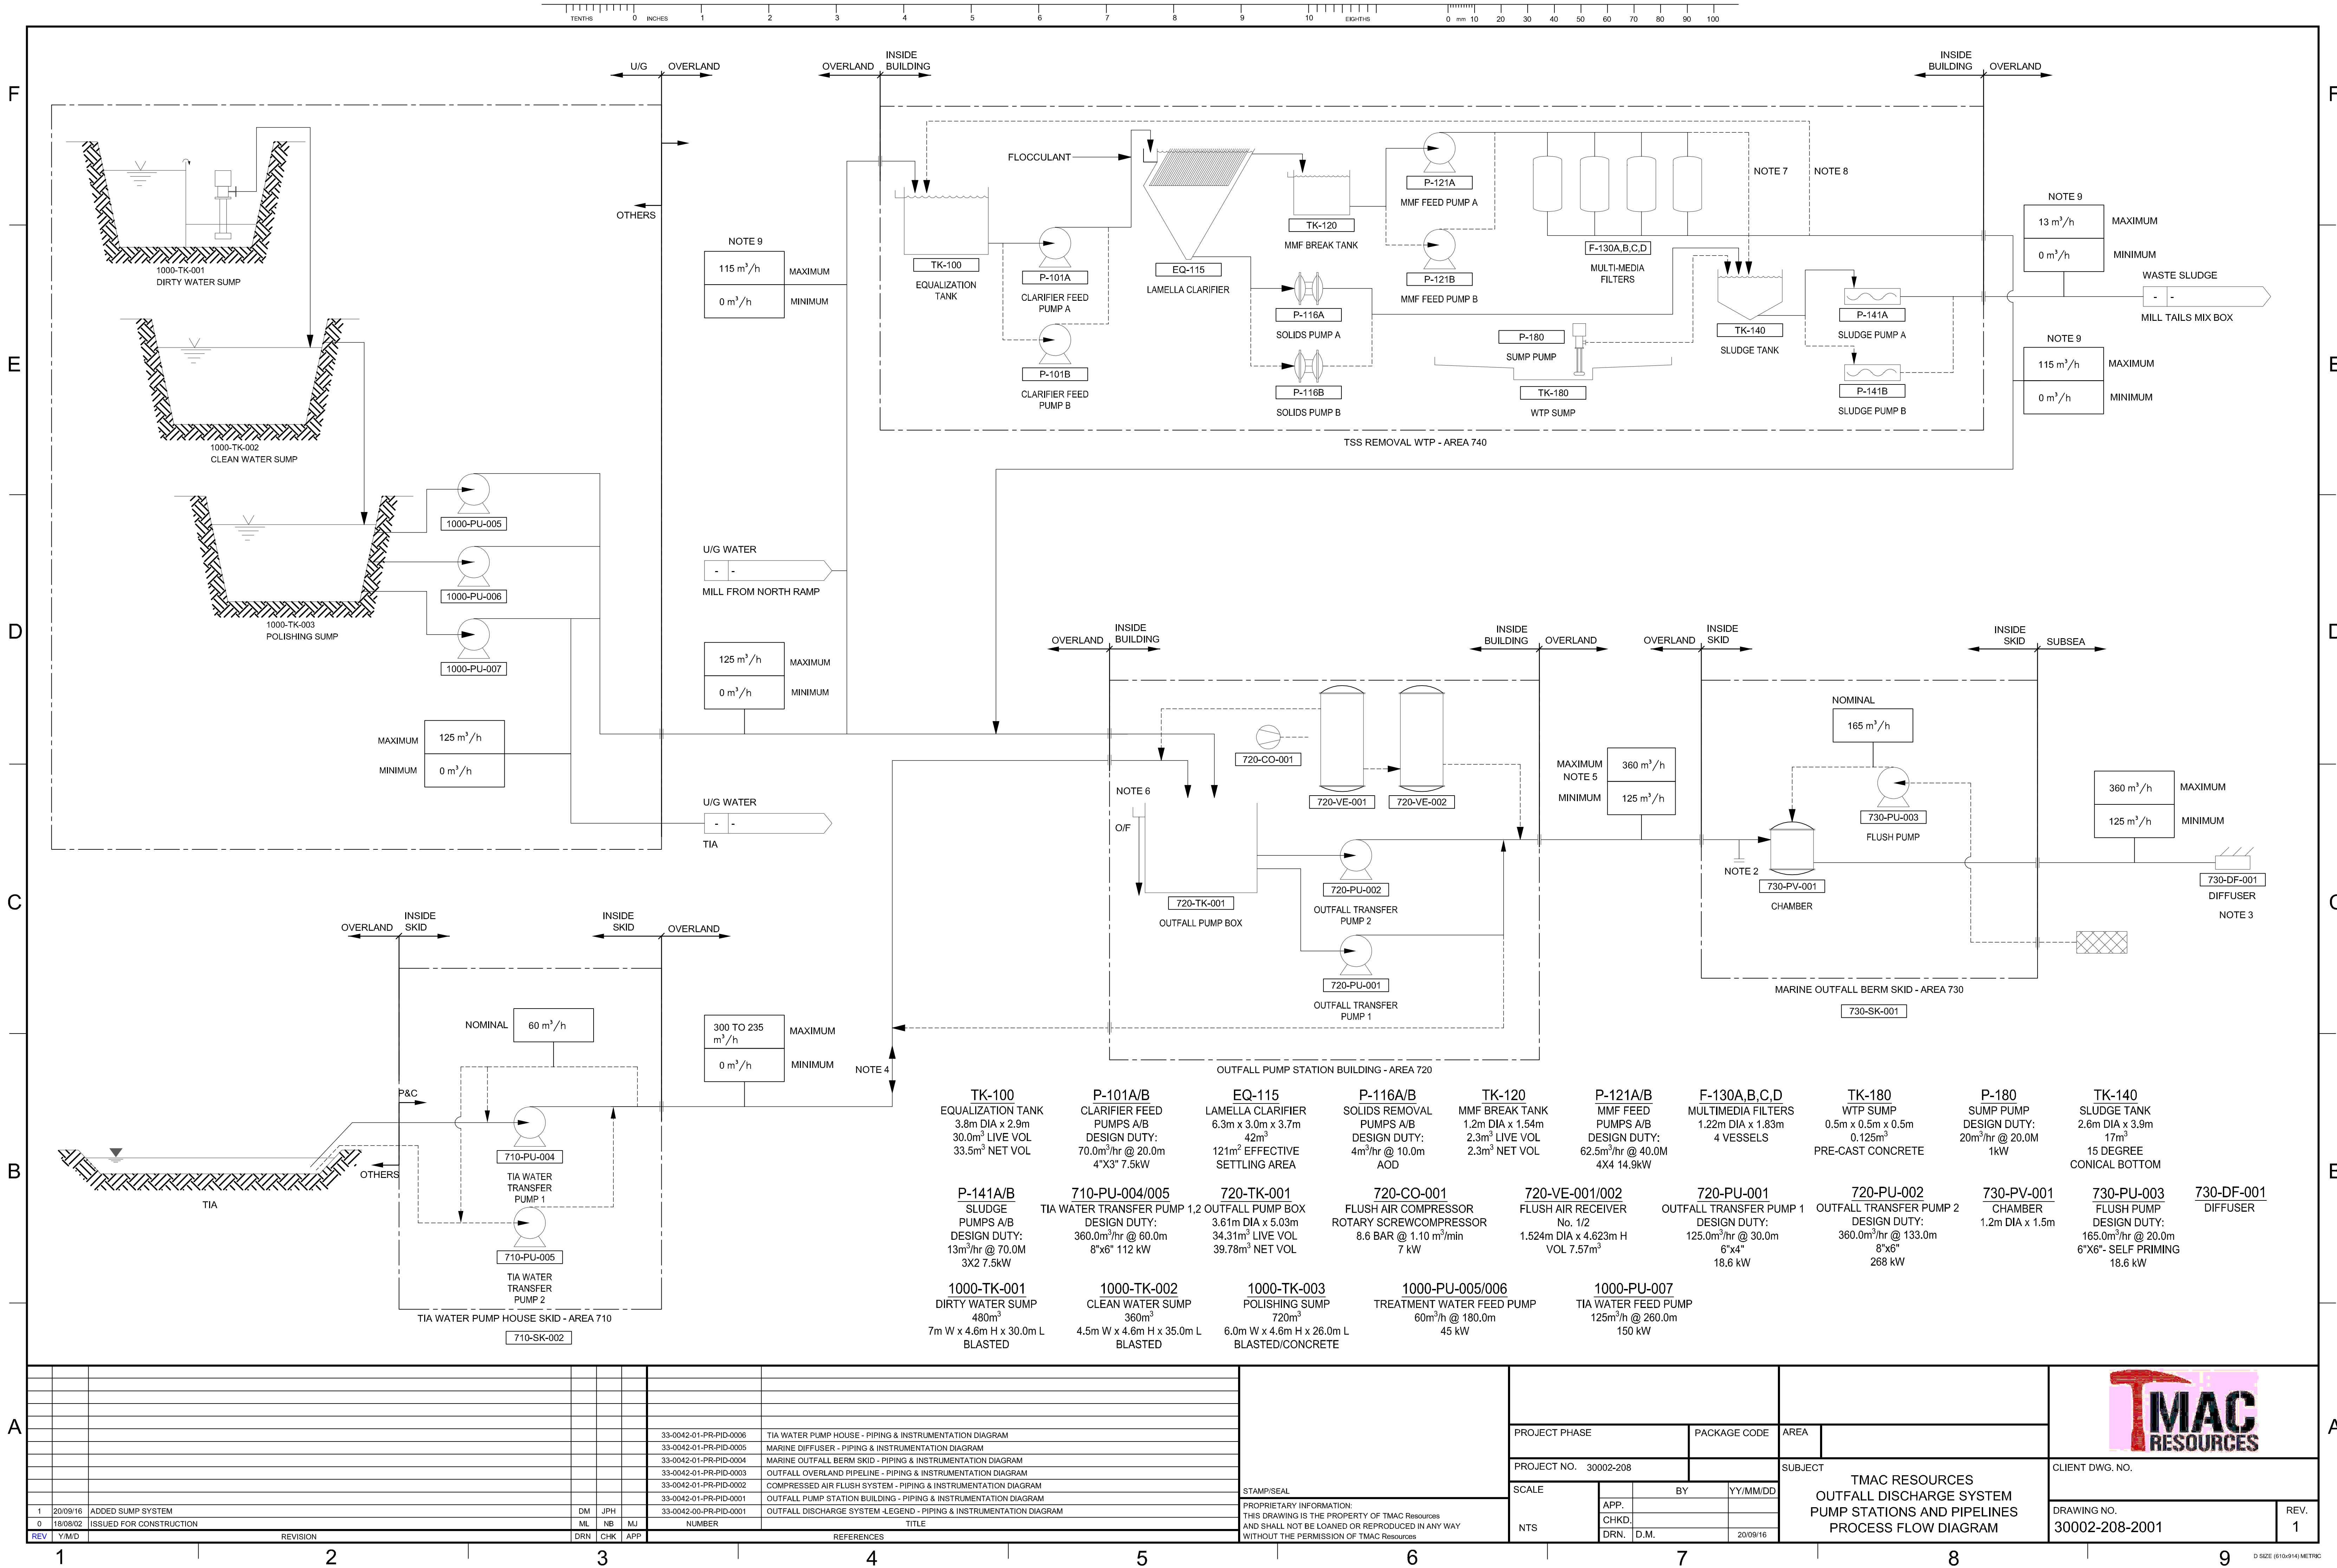




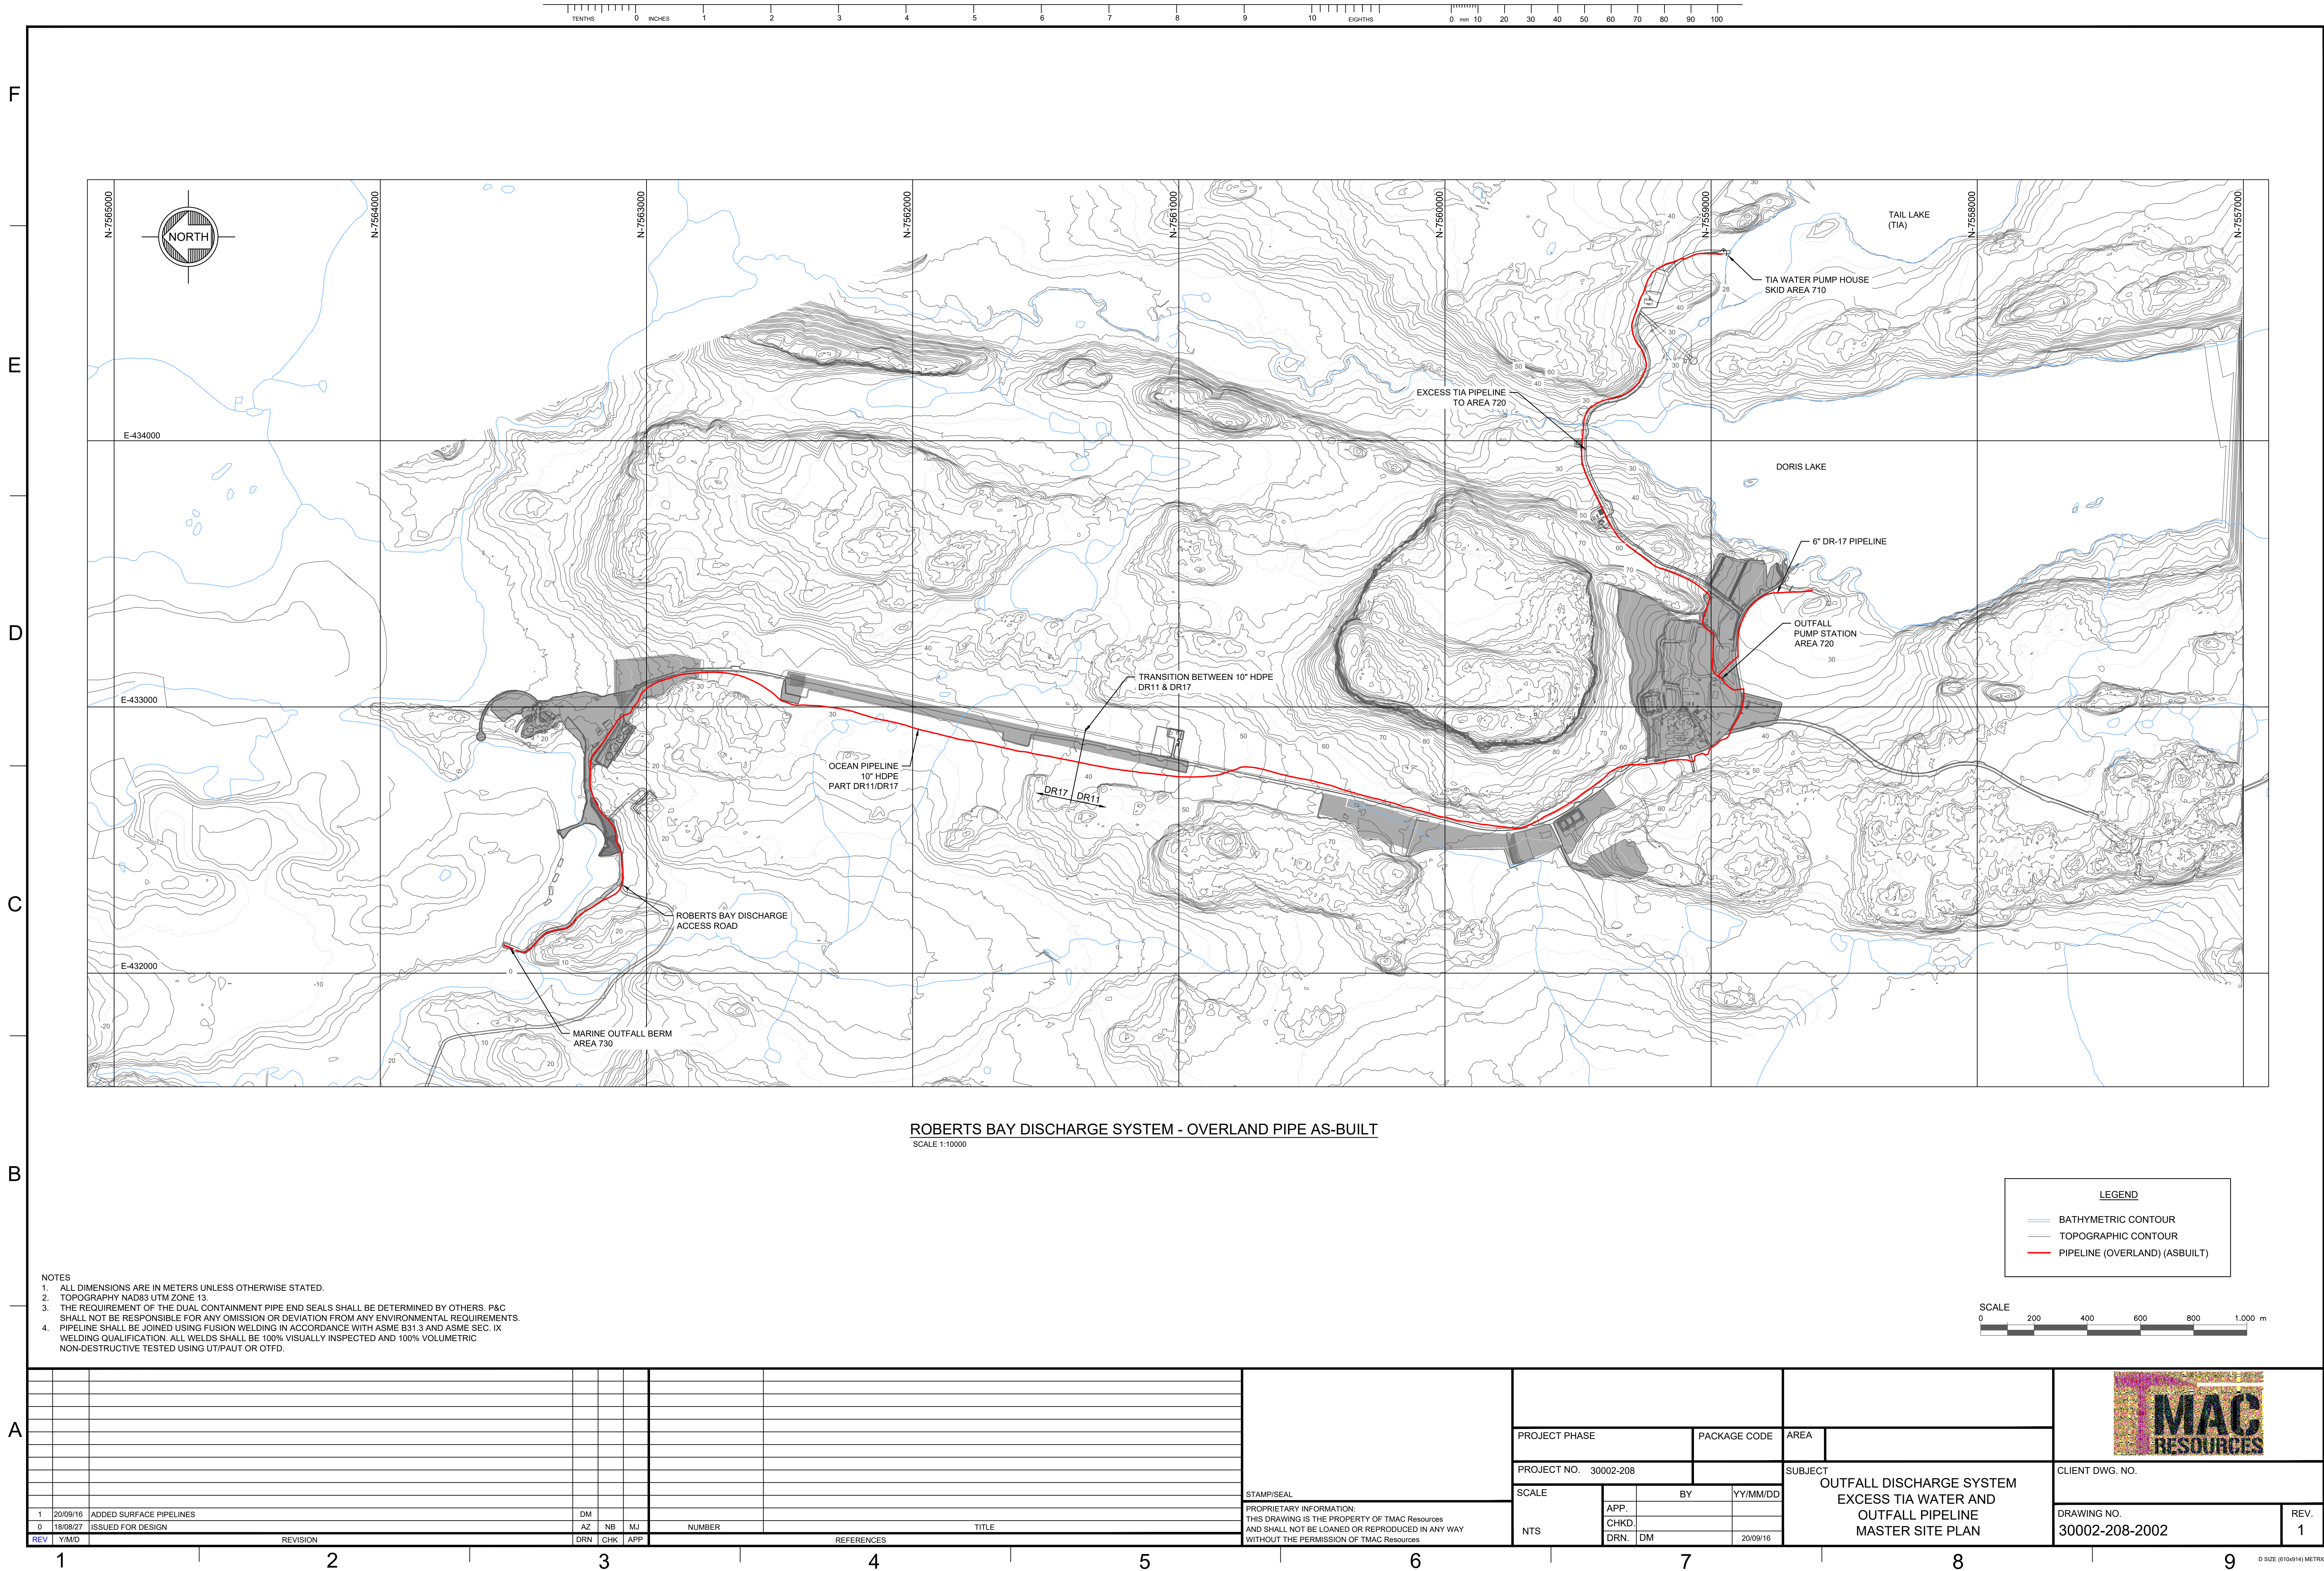





TMAC RESOURCES INC.  
HOPE BAY, NUNAVUT CANADA  
ROBERTS BAY DISCHARGE SYSTEM  
MARINE OUTFALL AND INTAKE

RECORD DRAWINGS

PROJECT NUMBER: 1065-001/002  
DATE: 2019-11-25  
REVISION: 0

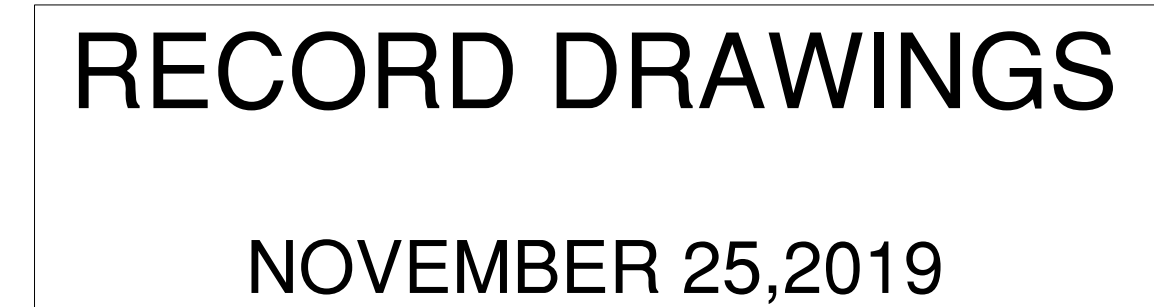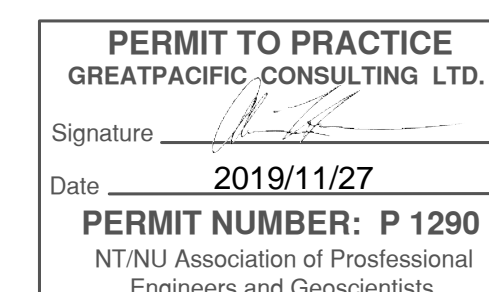



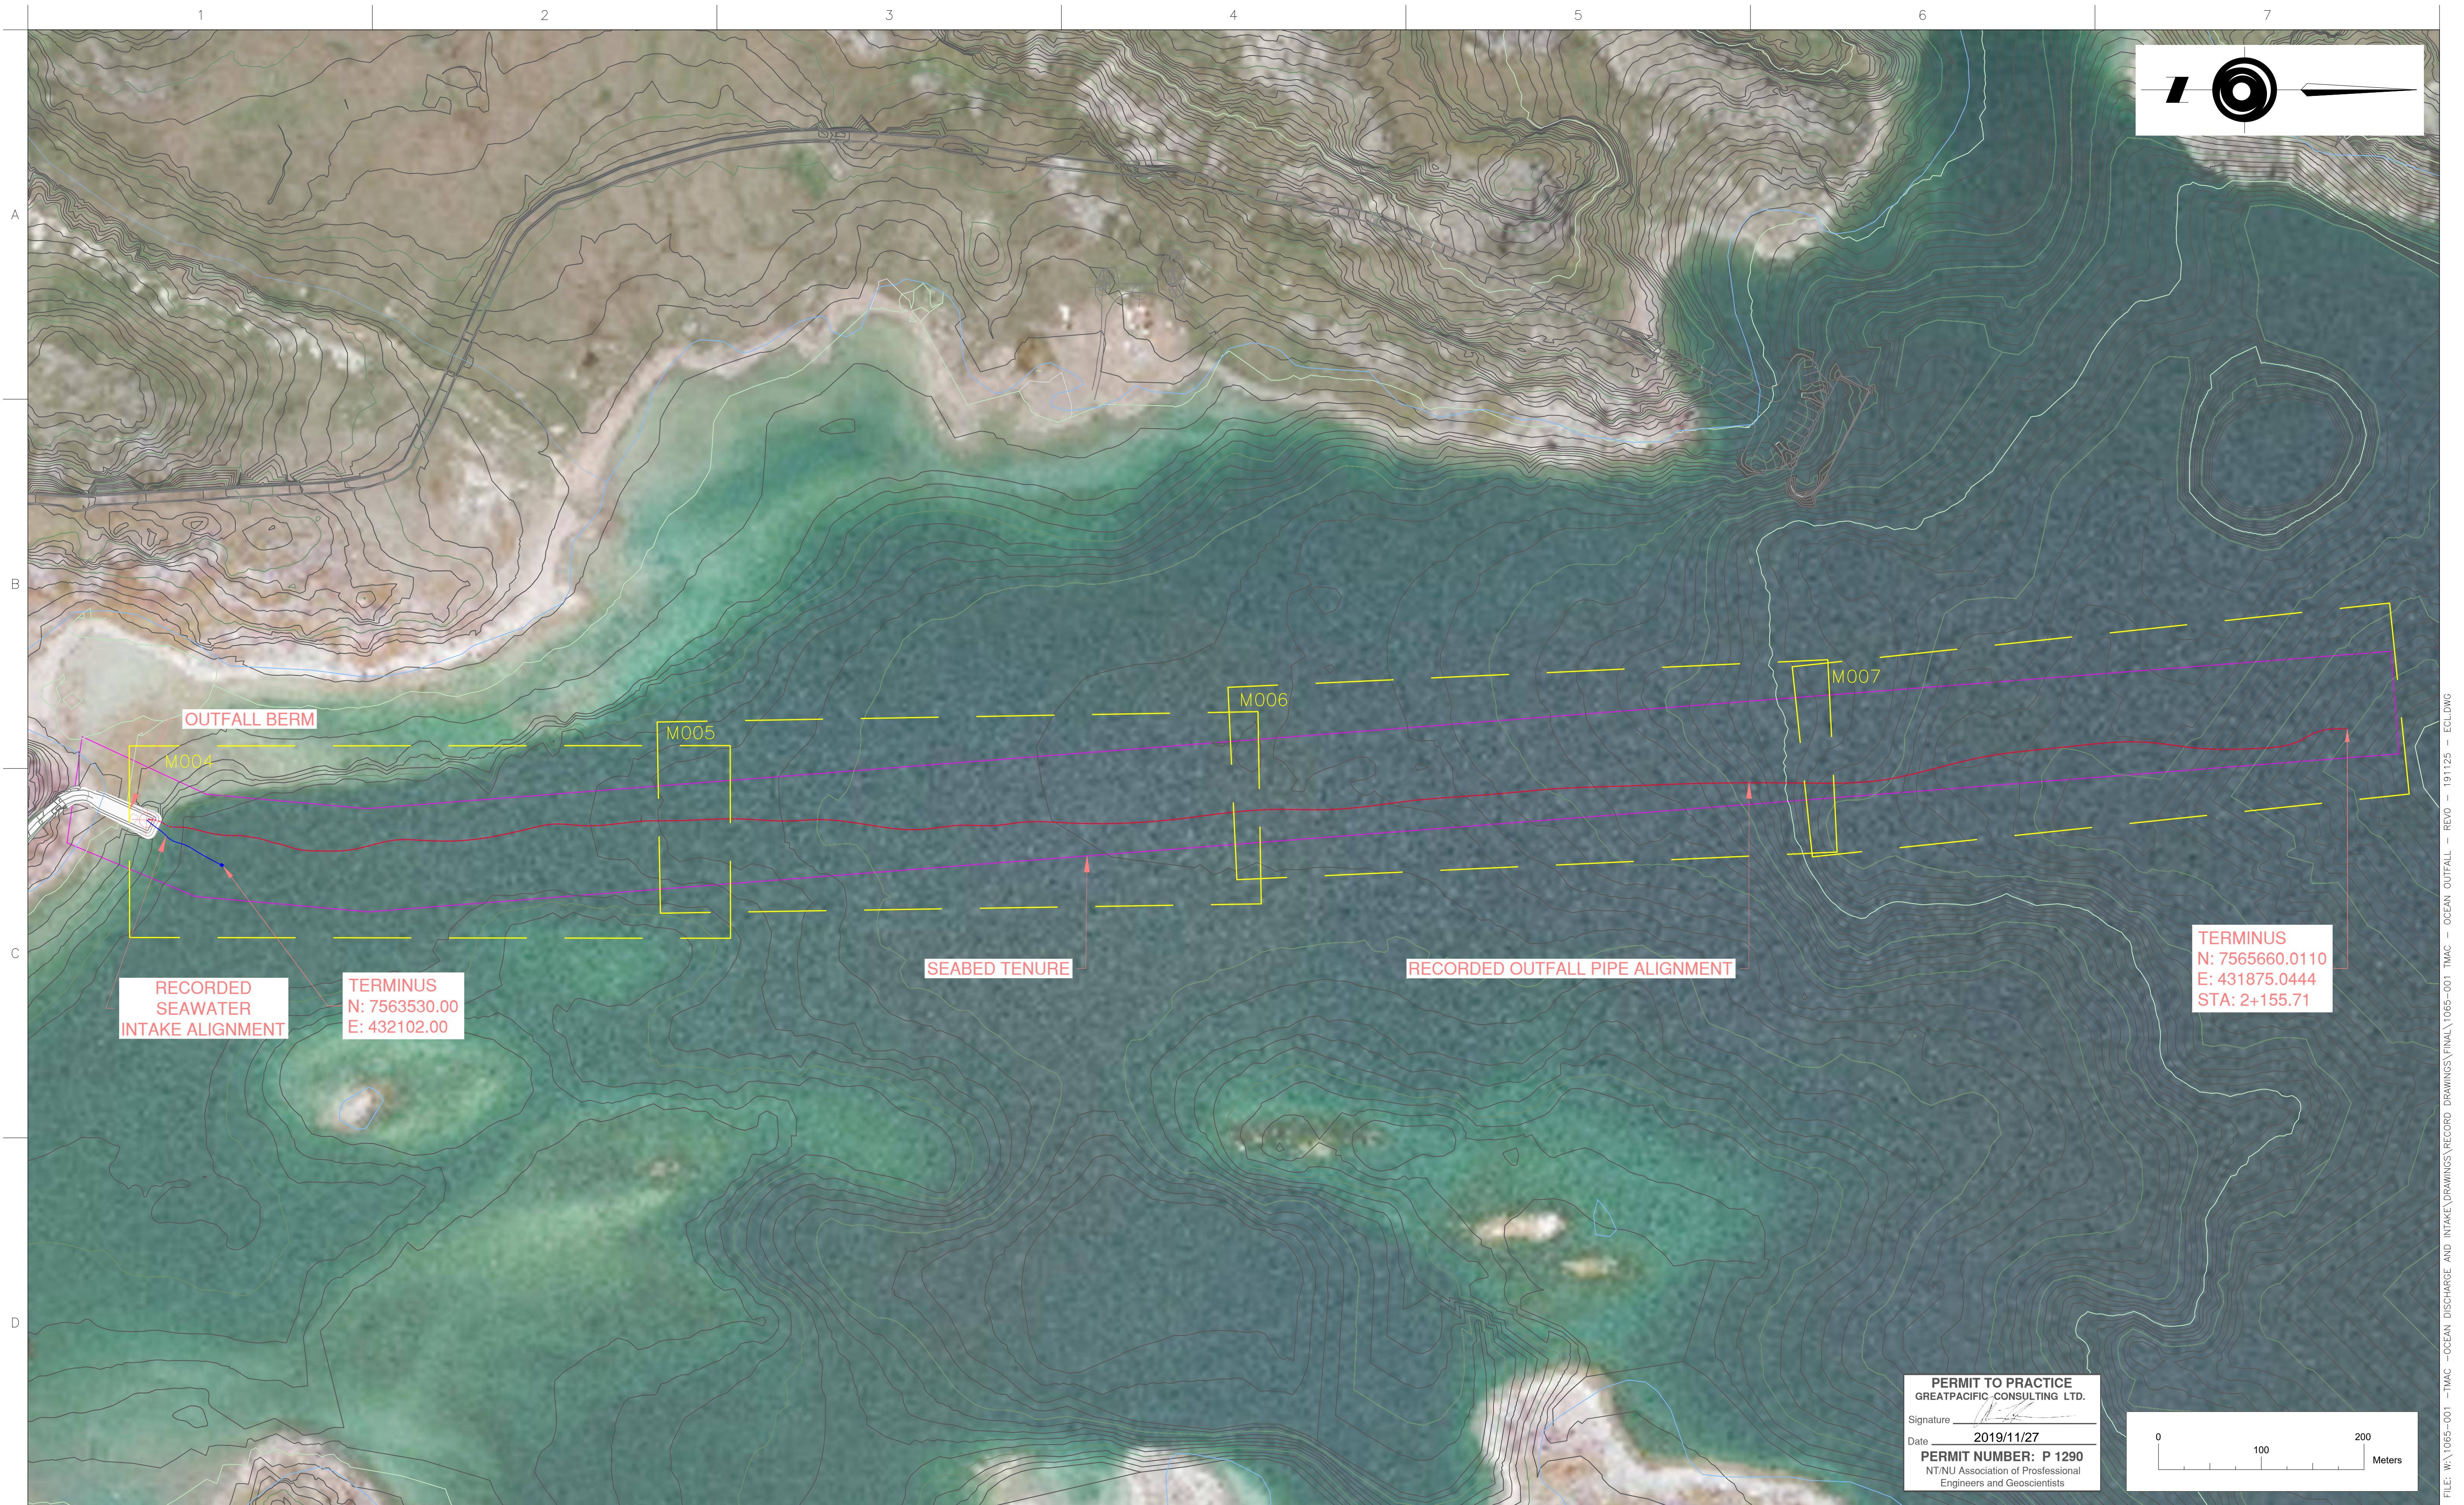

19-11-25	REV 0	ECL	AH	AH
19-11-22	AS RECORDED FOR CLIENT REVIEW	ECL	AH	JC
19-09-16	AS RECORDED FOR CLIENT REVIEW	TRB	AH	JC
DATE	DESCRIPTION	DRAWN	DESIGNED	APPROVED



**GREATPACIFIC**  
ENGINEERING & ENVIRONMENT

GREATPACIFIC CONSULTING LTD

202-2780 VETERANS MEMORIAL PARKWAY  
VICTORIA, BC V9B 3S6  
778-433-2672  
www.greatpacific.ca

PERMIT/STAMP:

NOTES:

- GREATPACIFIC RECORDED DEPLOYED INTAKE ALIGNMENT ON 2019/08/19 AND DEPLOYED OUTFALL ALIGNMENT ON 2019/08/15 USING A SINGLE BEAM LOWRANCE HDS9 GEN 2 CHART PLOTTER/ECHO SOUNDER WITH A POINT-1 GPS ANTENNA/DIGITAL COMPASS.
- WATER LEVELS ADJUSTED TO GEODETIC DATA. (RESCAN, 2011)

CLIENT:



PROJECT NUMBER:

1065-001

OUTFALL  
RECORDED ALIGNMENT  
PLAN AND PROFILE

DRAWING NUMBER:

M001

SCALE:



1:3000



REV:

REV 0


FILE: W:\1065-001 -TMAC- OCEAN DISCHARGE AND INTAKE\DRAWINGS\RECORD DRAWINGS\FINAL\1065-001 -TMAC- OCEAN OUTFALL - REV0 - 191125 - ECLDWG DATE/TIME: 2019-11-18 11:24 AM

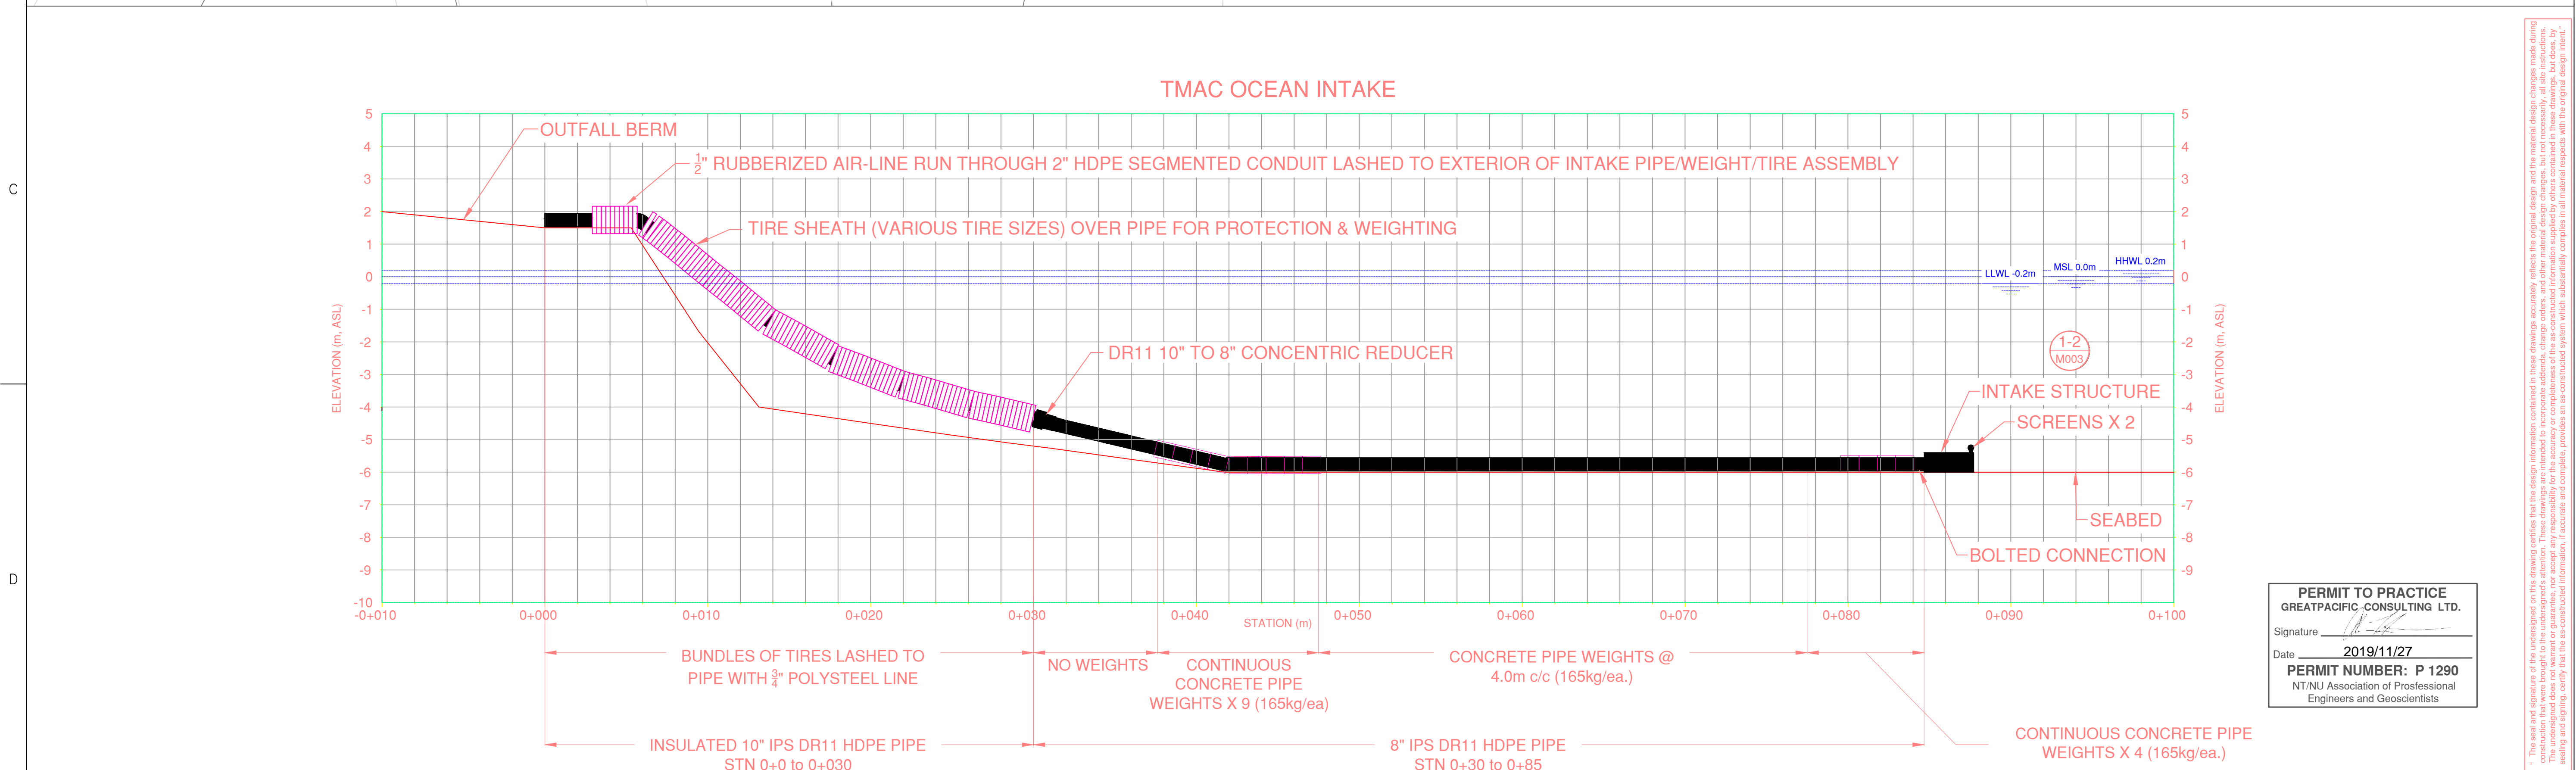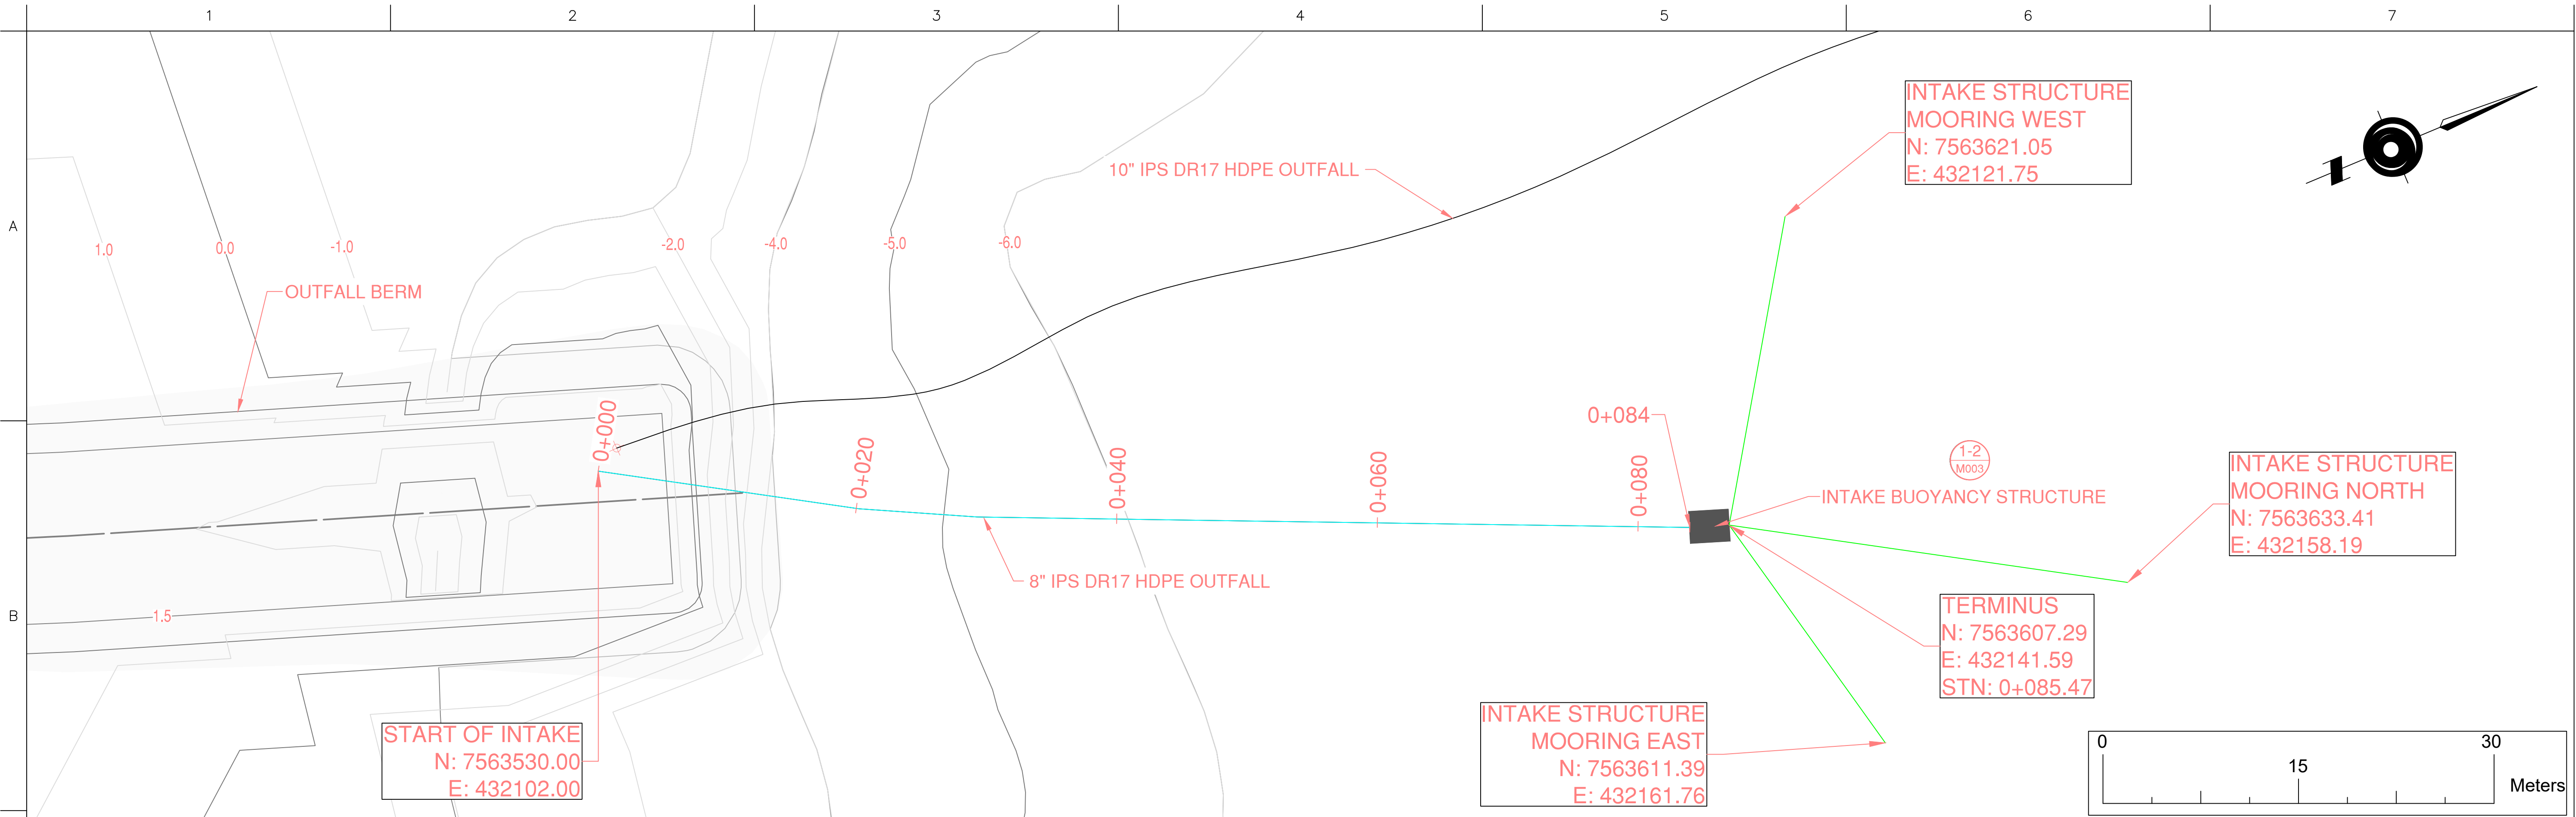



<table><tr><td>19-11-25</td><td>REV 0</td><td>ECL</td><td>AH</td><td>AH</td></tr><tr><td>19-11-22</td><td>RECORD DRAWING</td><td>ECL</td><td>AH</td><td>AH</td></tr><tr><td>19-10-07</td><td>RECORD DRAWING</td><td>TRB</td><td>AH</td><td>AH</td></tr><tr><td>DATE</td><td>DESCRIPTION</td><td>DRAWN</td><td>DESIGNED</td><td>APPROVED</td></tr></table>					19-11-25	REV 0	ECL	AH	AH	19-11-22	RECORD DRAWING	ECL	AH	AH	19-10-07	RECORD DRAWING	TRB	AH	AH	DATE	DESCRIPTION	DRAWN	DESIGNED	APPROVED	<div><b>GREATPACIFIC</b> ENGINEERING &amp; ENVIRONMENT GREATPACIFIC CONSULTING LTD 202-2780 VETERANS MEMORIAL PARKWAY VICTORIA, BC V9B 3S6 778-433-2672 www.greatpacific.ca</div>		PERMIT/STAMP:	NOTES: <ul style="list-style-type: none"><li>1. GREATPACIFIC RECORDED DEPLOYED INTAKE ALIGNMENT ON 2019/08/19 USING A SINGLE BEAM LOWRANCE HDS9 GEN 2 CHART PLOTTER/ECHO SOUNDER WITH A POINT-1 GPS ANTENNA/DIGITAL COMPASS.</li><li>2. WATER LEVELS ADJUSTED TO GEODETIC DATA. (RESCAN, 2011)</li></ul>	CLIENT: <div></div> PROJECT NUMBER: 1065-001	<div>HOPE BAY NUNAVUT, CANADA OCEAN INTAKE</div> DRAWING NUMBER: M002 SCALE: 1:250 REV: REV 0	
19-11-25	REV 0	ECL	AH	AH																											
19-11-22	RECORD DRAWING	ECL	AH	AH																											
19-10-07	RECORD DRAWING	TRB	AH	AH																											
DATE	DESCRIPTION	DRAWN	DESIGNED	APPROVED																											



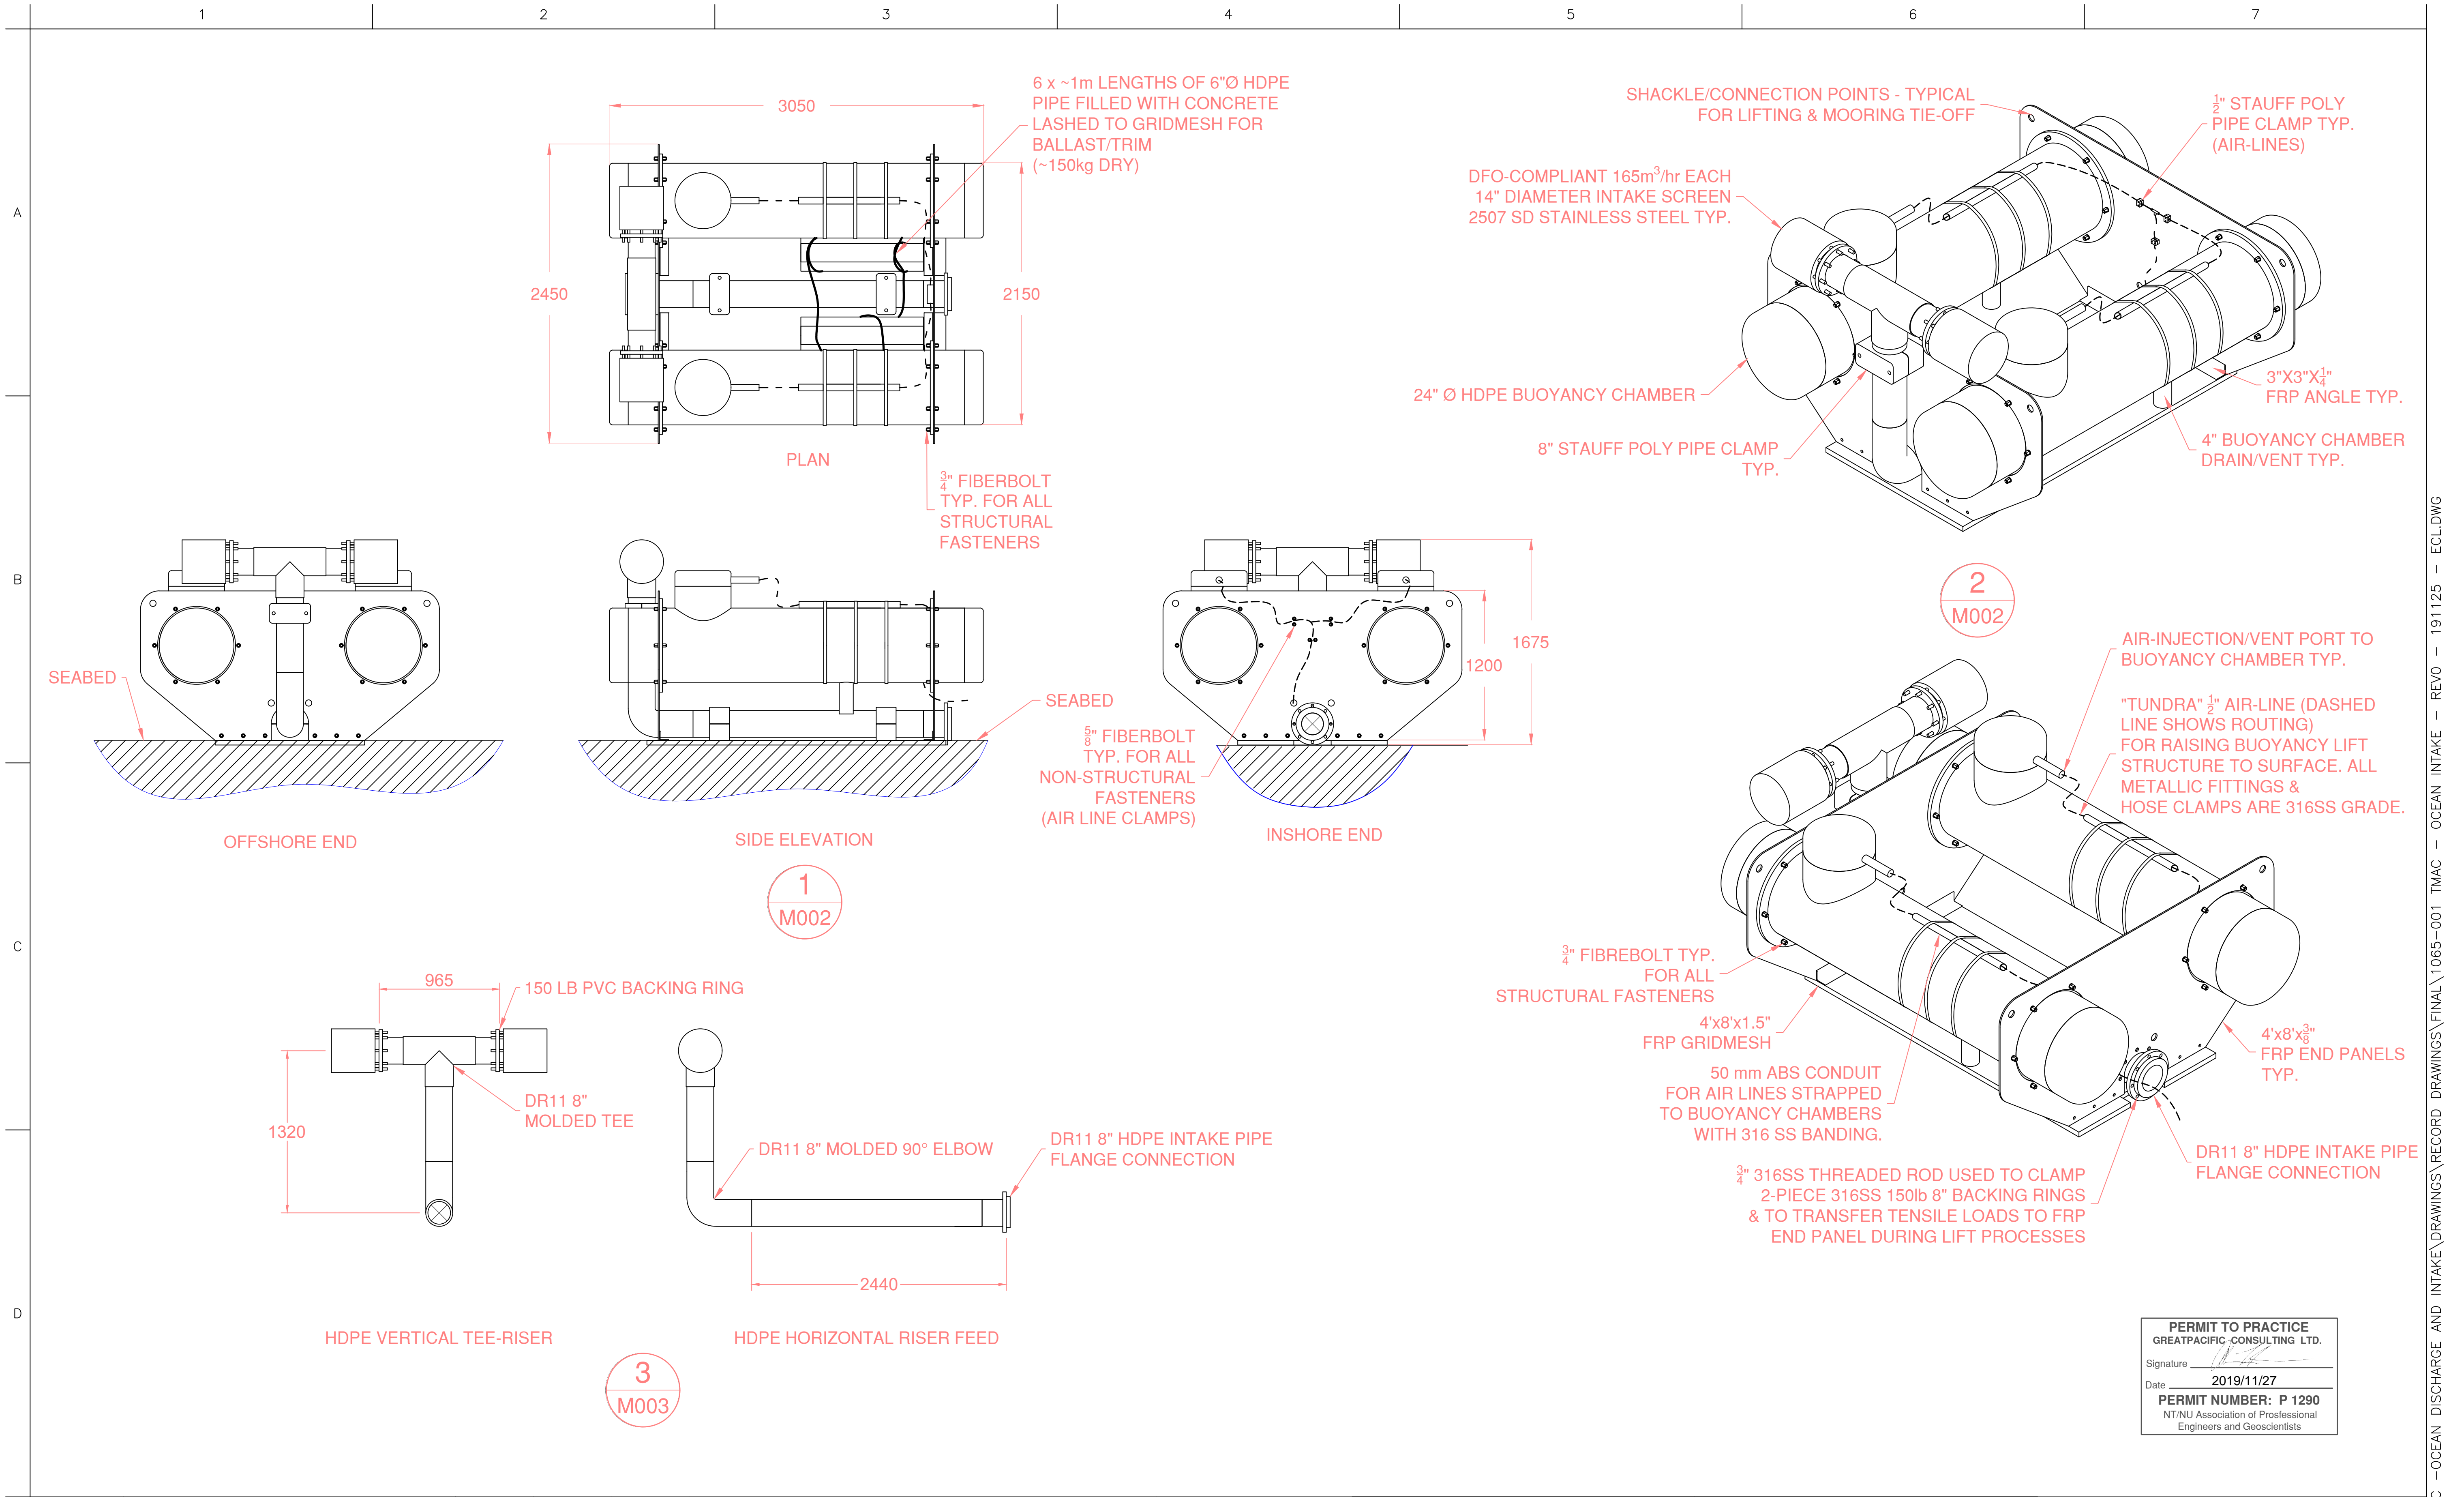

19-11-25	REV 0	ECL	AH	AH
19-11-22	RECORD DRAWING	ECL	AH	AH
19-10-08	RECORD DRAWING	TRB	AH	AH
DATE	DESCRIPTION	DRAWN	DESIGNED	APPROVED

**GREATPACIFIC**  
ENGINEERING & ENVIRONMENT

GREATPACIFIC CONSULTING LTD  
202-2780 VETERANS MEMORIAL PARKWAY  
VICTORIA, BC V9B 3S6  
778-433-2672  
www.greatpacific.ca

PERMIT/STAMP:

NOTES:

- ALL DISTANCES ARE IN MILLIMETERS AND DECIMALS THEREOF UNLESS OTHERWISE STATED.
- DO NOT SCALE FROM DRAWINGS.
- BUOYANCY STRUCTURE CAN BE BROUGHT TO THE SURFACE DURING ICE-FREE PERIODS OF CALM WEATHER (<5 knot WINDS, <0.25m WAVES) TO INSPECT & CLEAN INTAKE SCREENS OF BIOFOULING/DEBRIS.
- MOORINGS (x3) COMPRISED OF DANFORTH ANCHOR (75lb NORTH, 40lb EAST&WEST), 3/8" GALVANIZED CHAIN AND 3/4" POLYSTEEL SYNTHETIC LINE. MOORING SCOPE IS ~3:1.

CLIENT:



PROJECT NUMBER:

1065-001

SEAWATER INTAKE &  
MARINE EFFLUENT OUTFALL  
DETAILS

DRAWING NUMBER:

M003

SCALE:



AS SHOWN

REV:

REV 0

FILE: W:\1065-001 -TMAC -OCEAN DISCHARGE AND INTAKE\DRAWINGS\RECORD DRAWINGS\FINAL\1065-001 TMAC - OCEAN INTAKE - REV0 - 191125 - ECL.DWG



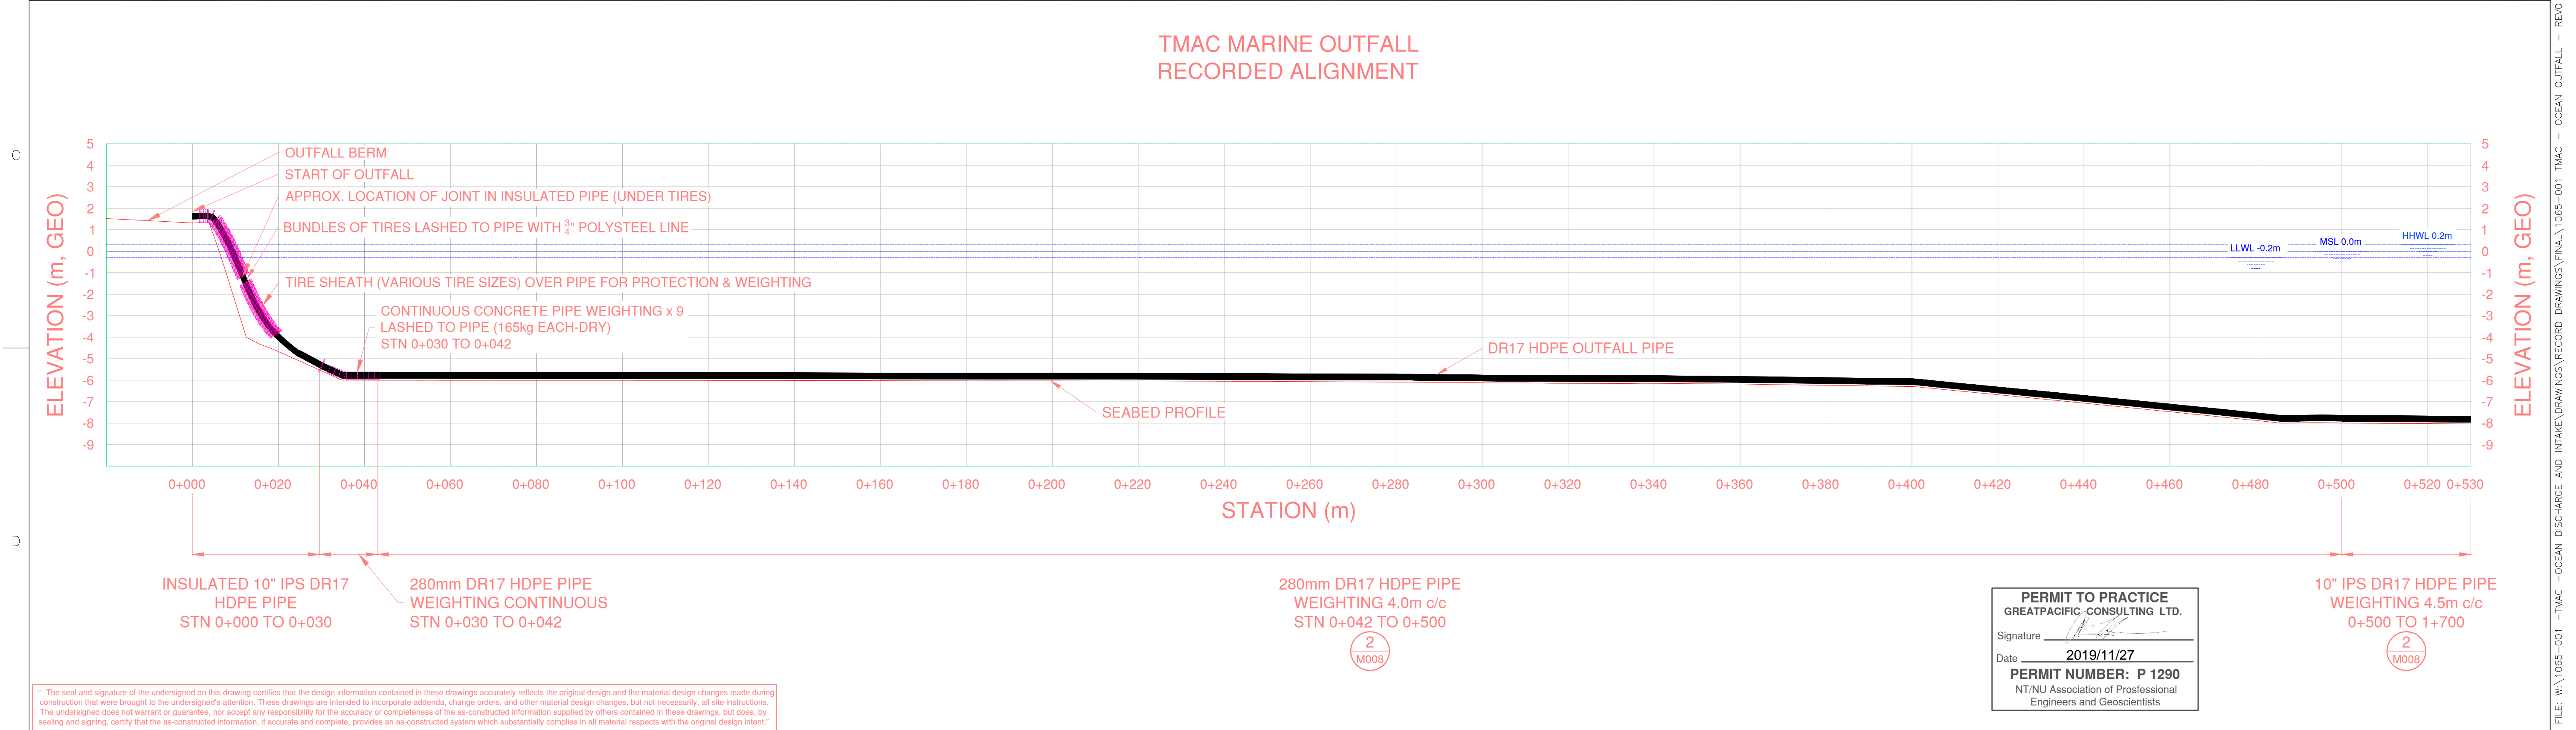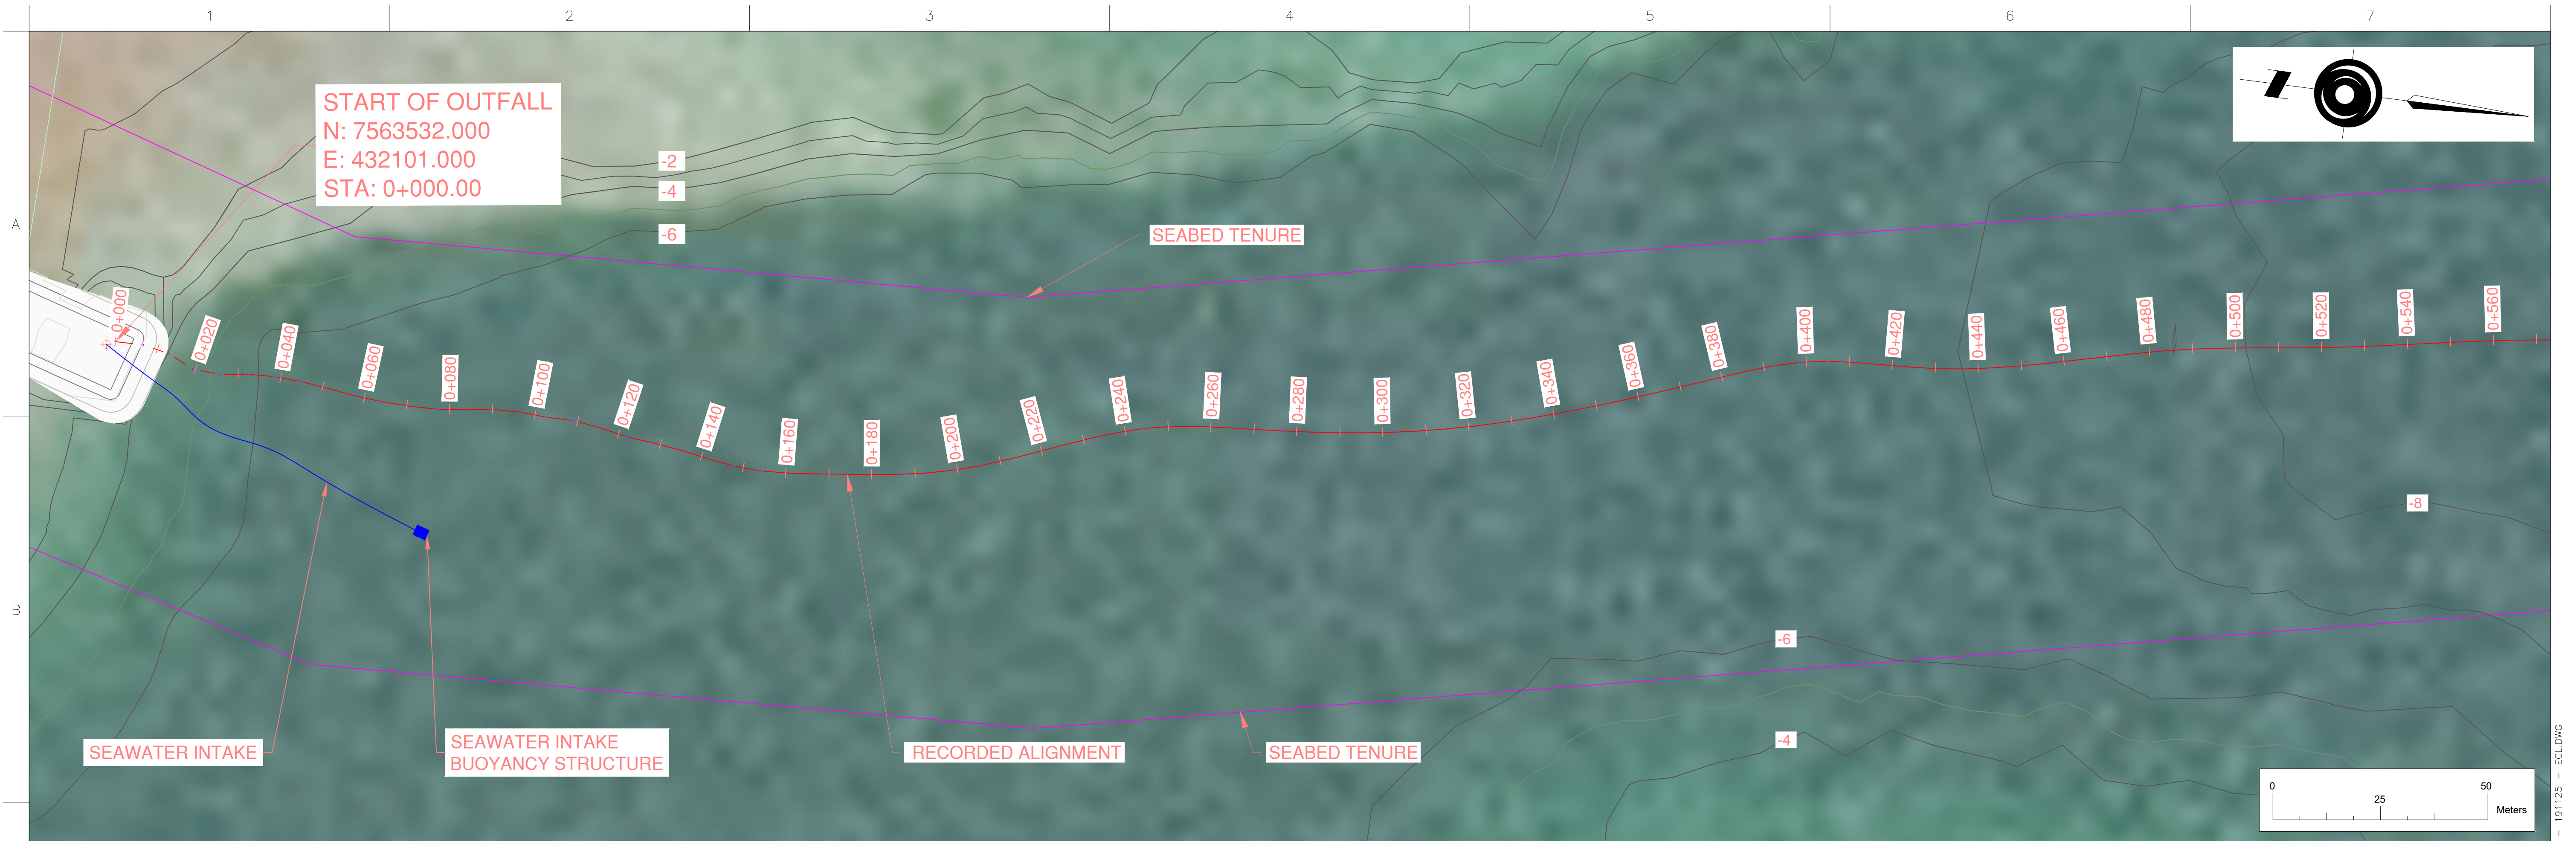

\* The seal and signature of the undersigned on this drawing certifies that the design information contained in these drawings accurately reflects the original design and the material design changes made during construction that were brought to the undersigned's attention. These drawings are intended to incorporate addenda, change orders, and other material design changes, but not necessarily, all site instructions. The undersigned does not warrant or guarantee, nor accept any responsibility for the accuracy or completeness of the as-constructed information supplied by others contained in these drawings, but does, by sealing and signing, certify that the as-constructed information, if accurate and complete, provides an as-constructed system which substantially complies in all material respects with the original design intent.\*

19-11-25	REV 0	ECL	AH	AH
19-11-22	AS RECORDED FOR CLIENT REVIEW	ECL	AH	JC
19-09-16	AS RECORDED FOR CLIENT REVIEW	TRB	AH	JC
DATE	DESCRIPTION	DRAWN	DESIGNED	APPROVED

 **GREATPACIFIC**  
ENGINEERING & ENVIRONMENT

GREATPACIFIC CONSULTING LTD  
202-2780 VETERANS MEMORIAL PARKWAY  
VICTORIA, BC V9B 3S6  
778-433-2672  
www.greatpacific.ca

PERMIT/STAMP:

NOTES:

- GREATPACIFIC RECORDED DEPLOYED OUTFALL ALIGNMENT ON 2019/08/15 USING A SINGLE BEAM LOWRANCE HDS9 GEN 2 CHART PLOTTER/ECHO SOUNDER WITH A POINT-1 GPS ANTENNA/DIGITAL COMPASS. WATER LEVELS ADJUSTED TO GEODETIC DATA. (RESCAN, 2011)

CLIENT:



PROJECT NUMBER:

1065-001

OUTFALL  
RECORDED ALIGNMENT  
PLAN AND PROFILE

DRAWING NUMBER:

M004



SCALE:

1:750

REV:

REV 0



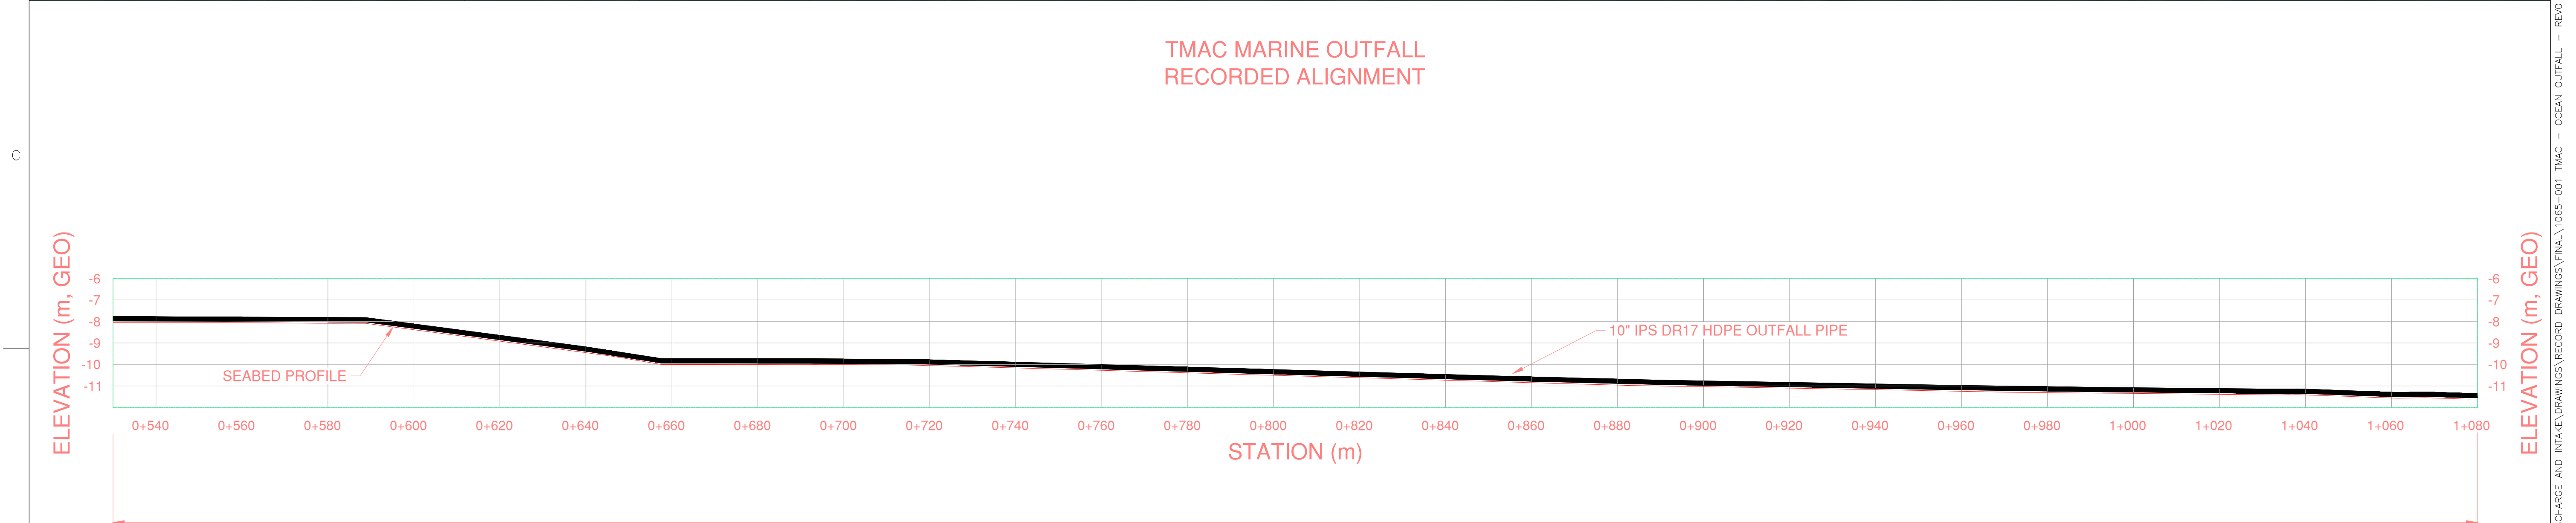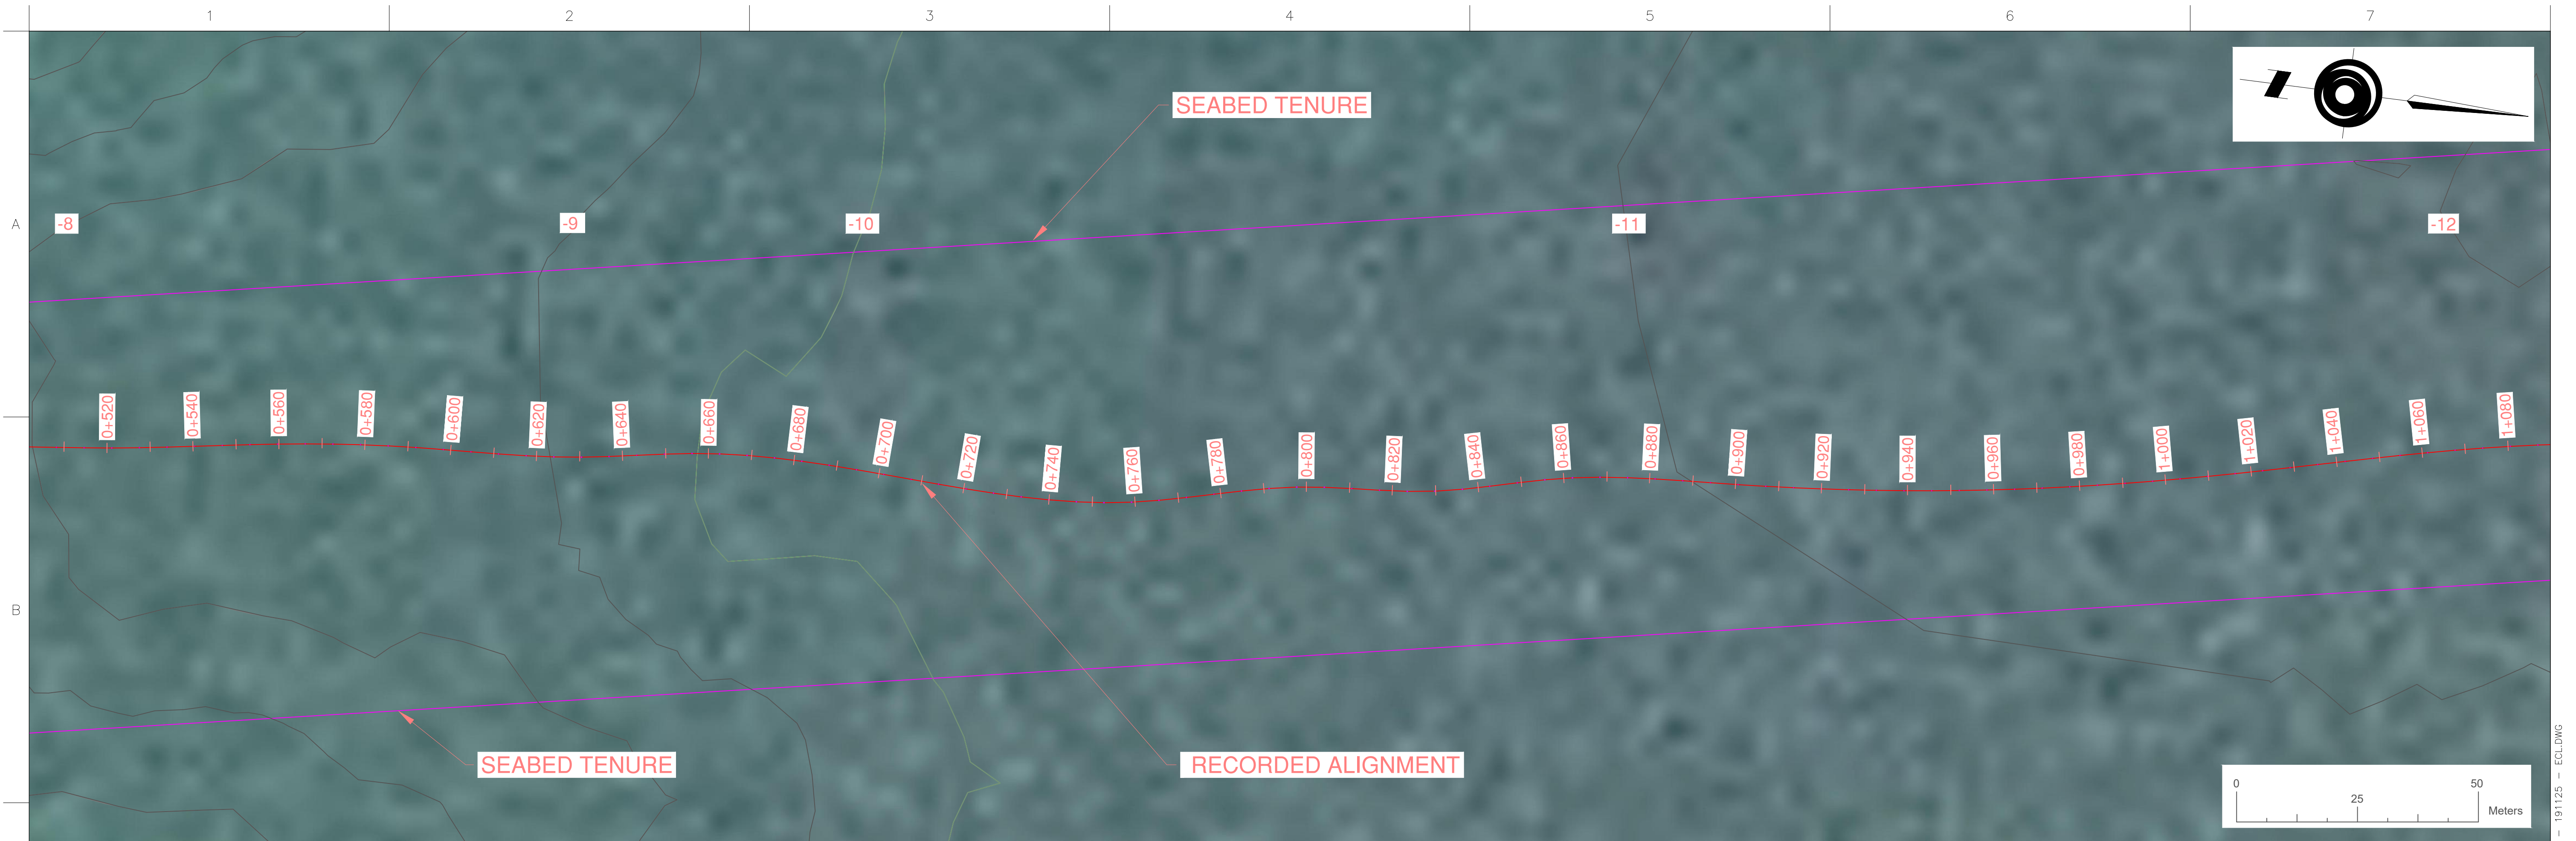

10" IPS DR17 HDPE PIPE  
WEIGHTING 4.5m c/c  
STN: 0+500 TO 1+700

2



M008

PERMIT TO PRACTICE  
GREATPACIFIC CONSULTING LTD.  
Signature  
Date 2019/11/27  
PERMIT NUMBER: P 1290  
NT/NU Association of Professional  
Engineers and Geoscientists

<div><div><div><div></div><div></div><div></div><div></div><div></div></div><div><div>19-11-25</div><div>REV 0</div><div>ECL</div><div>AH</div><div>AH</div></div><div><div>19-11-22</div><div>AS RECORDED FOR CLIENT REVIEW</div><div>ECL</div><div>AH</div><div>JC</div></div><div><div>19-09-16</div><div>AS RECORDED FOR CLIENT REVIEW</div><div>TRB</div><div>AH</div><div>JC</div></div><div><div>DATE</div><div>DESCRIPTION</div><div>DRAWN</div><div>DESIGNED</div><div>APPROVED</div></div></div></div> <div><div><div><div></div><div></div><div></div></div><div><div>GREATPACIFIC</div><div>ENGINEERING &amp; ENVIRONMENT</div><div>GREATPACIFIC CONSULTING LTD</div><div>202-2780 VETERANS MEMORIAL PARKWAY</div><div>VICTORIA, BC V9B 3S6</div><div>778-433-2672</div><div>www.greatpacific.ca</div></div></div></div> <div><div>PERMIT/STAMP:</div><div>NOTES:<div><div>1.</div><div>GREATPACIFIC RECORDED DEPLOYED OUTFALL ALIGNMENT ON 2019/08/15 USING A SINGLE BEAM LOWRANCE HDS9 GEN 2 CHART PLOTTER/ECHO SOUNDER WITH A POINT-1 GPS ANTENNA/DIGITAL COMPASS. WATER LEVELS ADJUSTED TO GEODETIC DATA. (RESCAN, 2011)</div></div></div></div> <div><div>CLIENT:</div><div><div><div></div><div>TMAC</div><div>RESOURCES</div></div></div><div><div>PROJECT NUMBER:</div><div>1065-001</div></div></div> <div><div>MARINE OUTFALL RECORDED ALIGNMENT PLAN AND PROFILE</div><div><div>DRAWING NUMBER:</div><div>M005</div></div><div><div>SCALE:</div><div>1:750</div></div><div><div>REV:</div><div>REV 0</div></div></div>
---

FILE: W:\1065-001 -TMAC -OCEAN DISCHARGE AND INTAKE\DRAWINGS\RECORD DRAWINGS\1065-001 TMAC - OCEAN OUTFALL - REV0 - 191125 - ECL.DWG  
DATE/TIME: 2019-11-18 11:24 AM



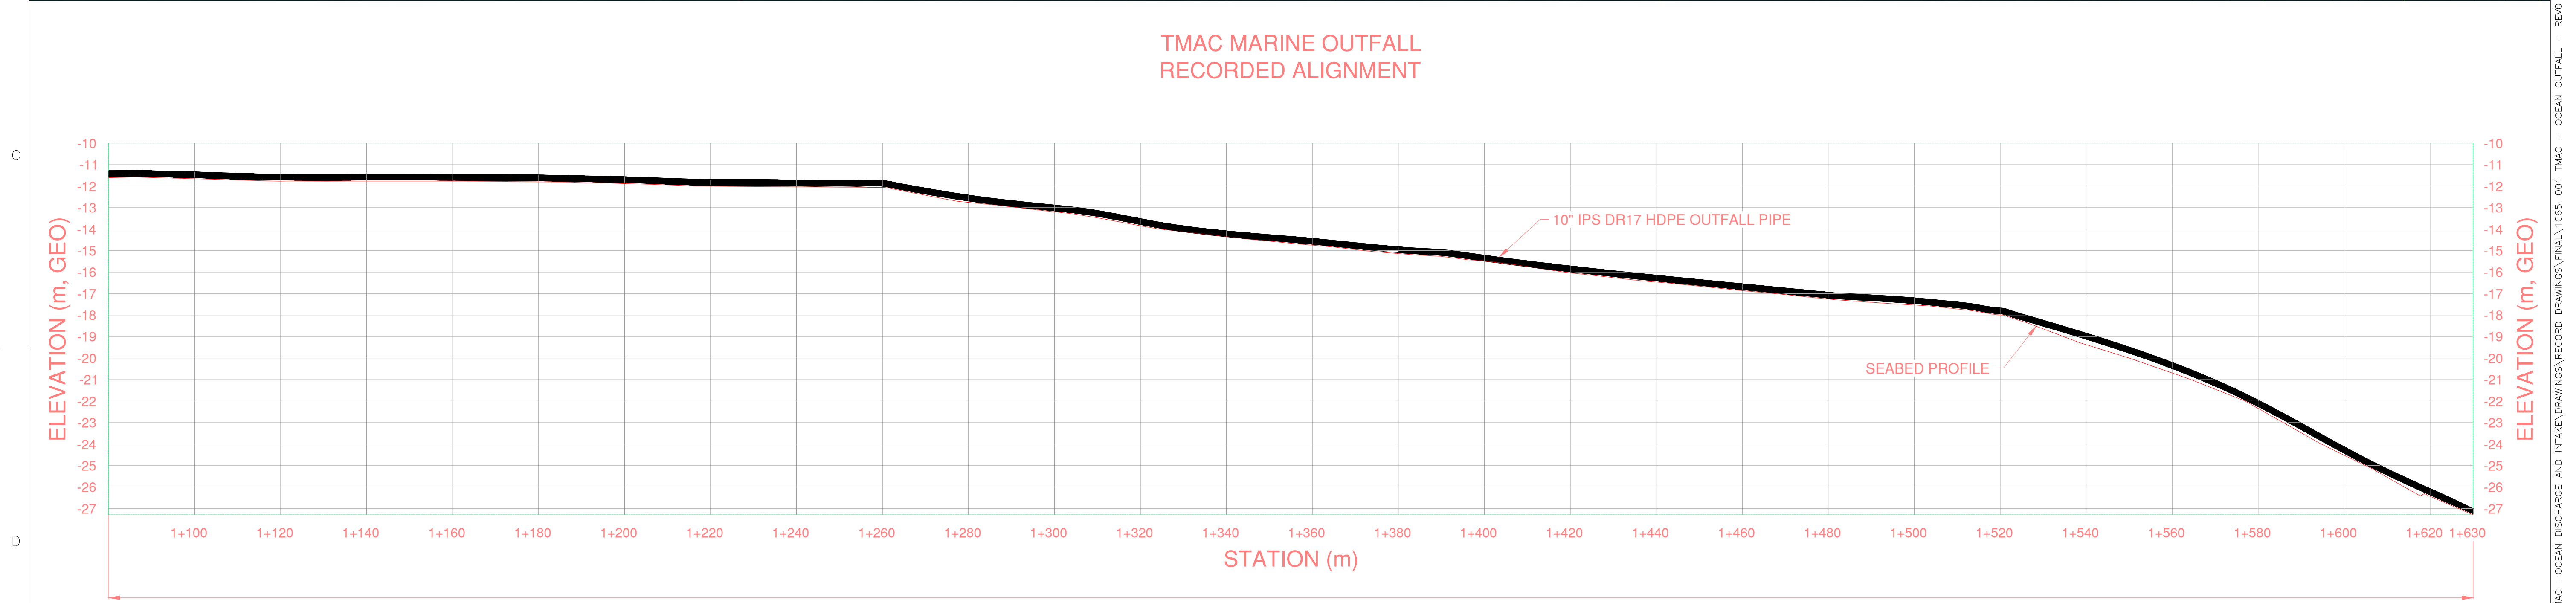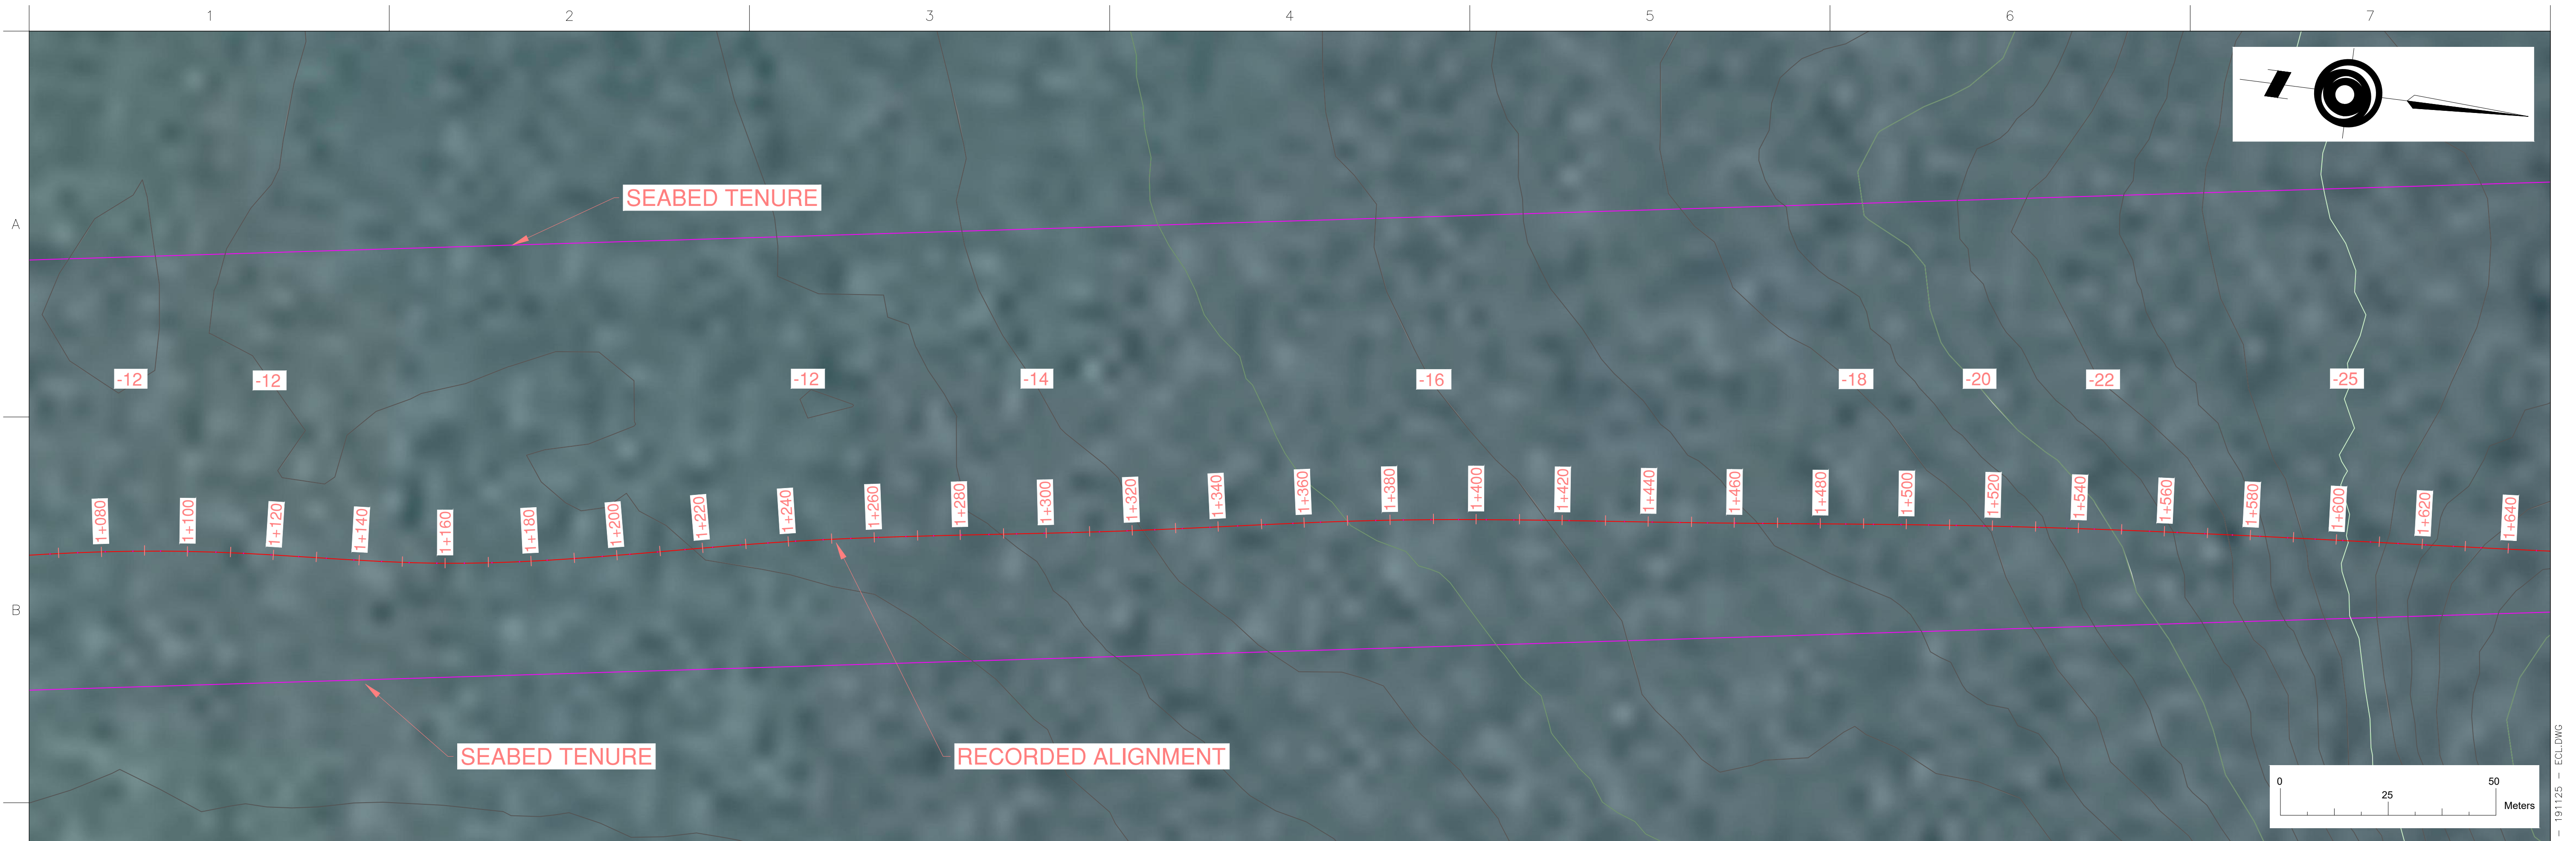

\* The seal and signature of the undersigned on this drawing certifies that the design information contained in these drawings accurately reflects the original design and the material design changes made during construction that were brought to the undersigned's attention. These drawings are intended to incorporate addenda, change orders, and other material design changes, but not necessarily, all site instructions. The undersigned does not warrant or guarantee, nor accept any responsibility for the accuracy or completeness of the as-constructed information supplied by others contained in these drawings, but does, by sealing and signing, certify that the as-constructed information, if accurate and complete, provides an as-constructed system which substantially complies in all material respects with the original design intent.\*

19-11-25	REV 0	ECL	AH	AH
19-11-22	AS RECORDED FOR CLIENT REVIEW	ECL	AH	JC
19-09-16	AS RECORDED FOR CLIENT REVIEW	TRB	AH	JC
DATE	DESCRIPTION	DRAWN	DESIGNED	APPROVED



**GREATPACIFIC**  
ENGINEERING & ENVIRONMENT

GREATPACIFIC CONSULTING LTD  
202-2780 VETERANS MEMORIAL PARKWAY  
VICTORIA, BC V9B 3S6  
778-433-2672  
www.greatpacific.ca

PERMIT/STAMP:

2  
M008

NOTES:

- GREATPACIFIC RECORDED OUTFALL ALIGNMENT ON 2019/08/15 USING A SINGLE BEAM LOWRANCE HDS9 GEN 2 CHART PLOTTER/ECHO SOUNDER WITH A POINT-1 GPS ANTENNA/DIGITAL COMPASS.
- WATER LEVELS ADJUSTED TO GEODETIC DATA. (RESCAN, 2011)

CLIENT:



PROJECT NUMBER:

1065-001

MARINE OUTFALL  
RECORDED ALIGNMENT  
PLAN AND PROFILE

DRAWING NUMBER:

M006



SCALE:

1:750

REV:

REV 0



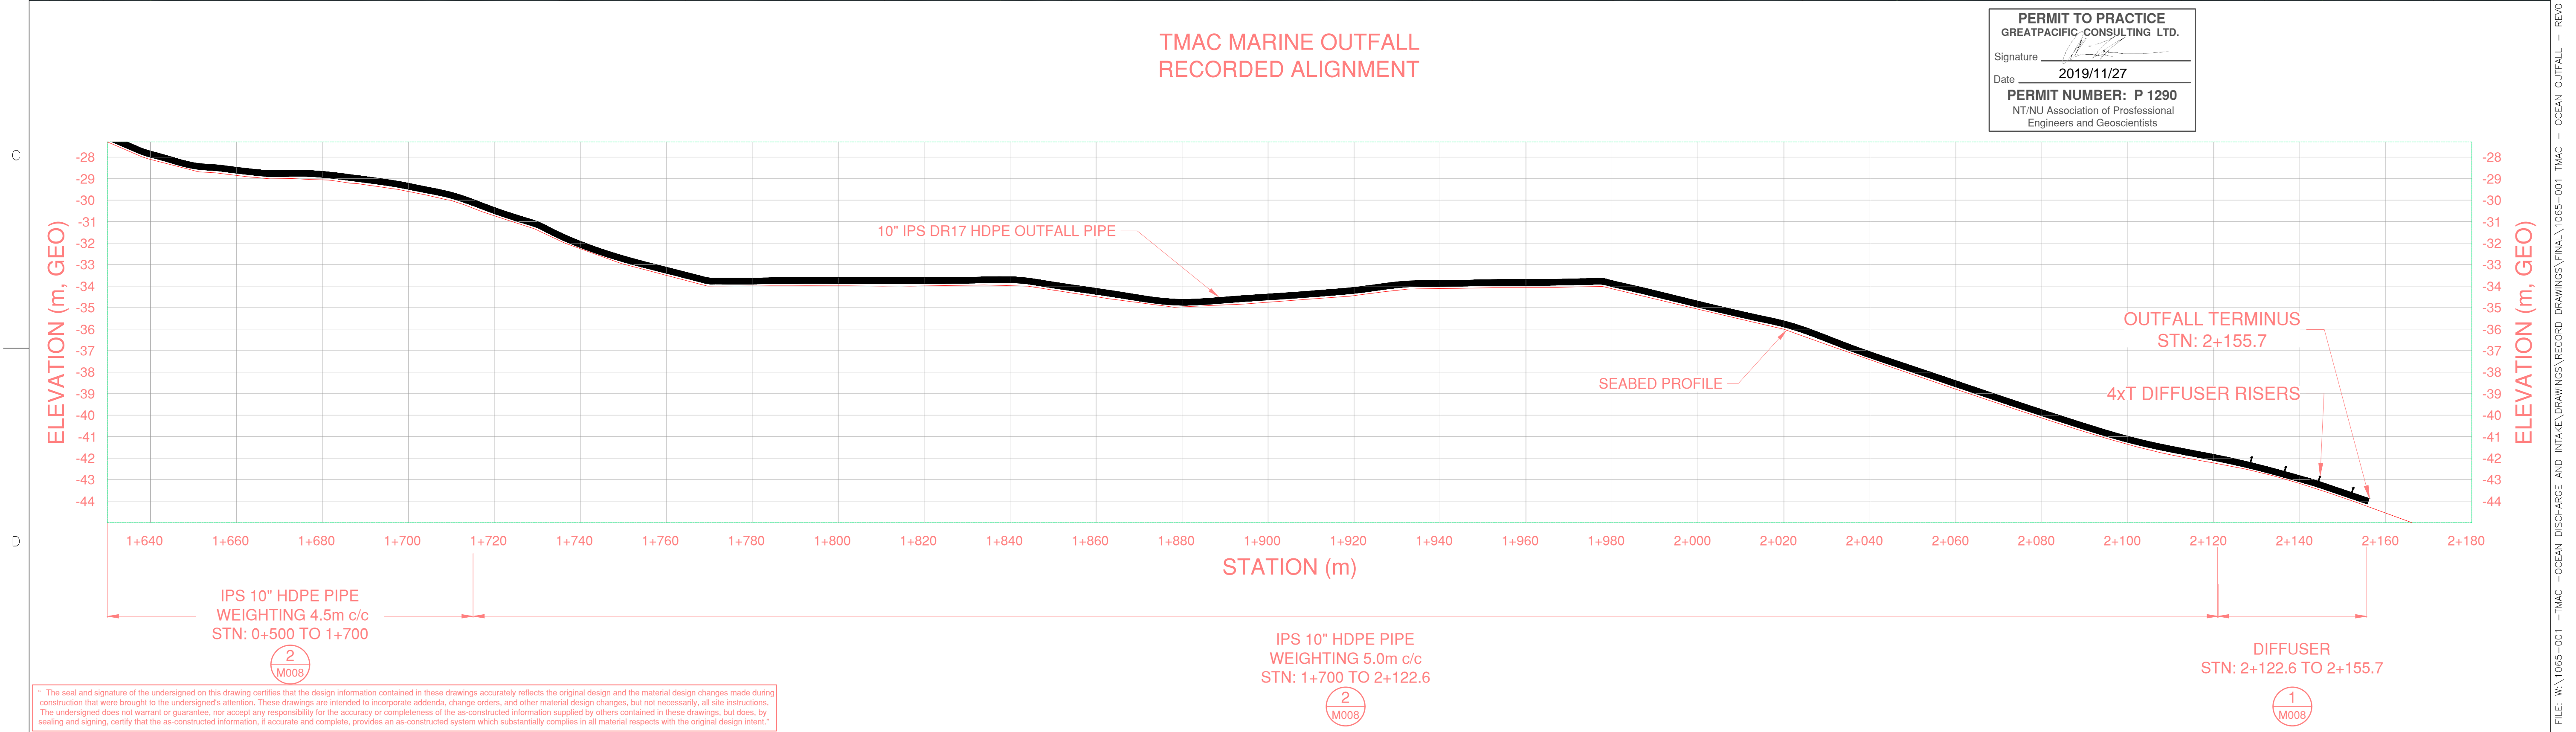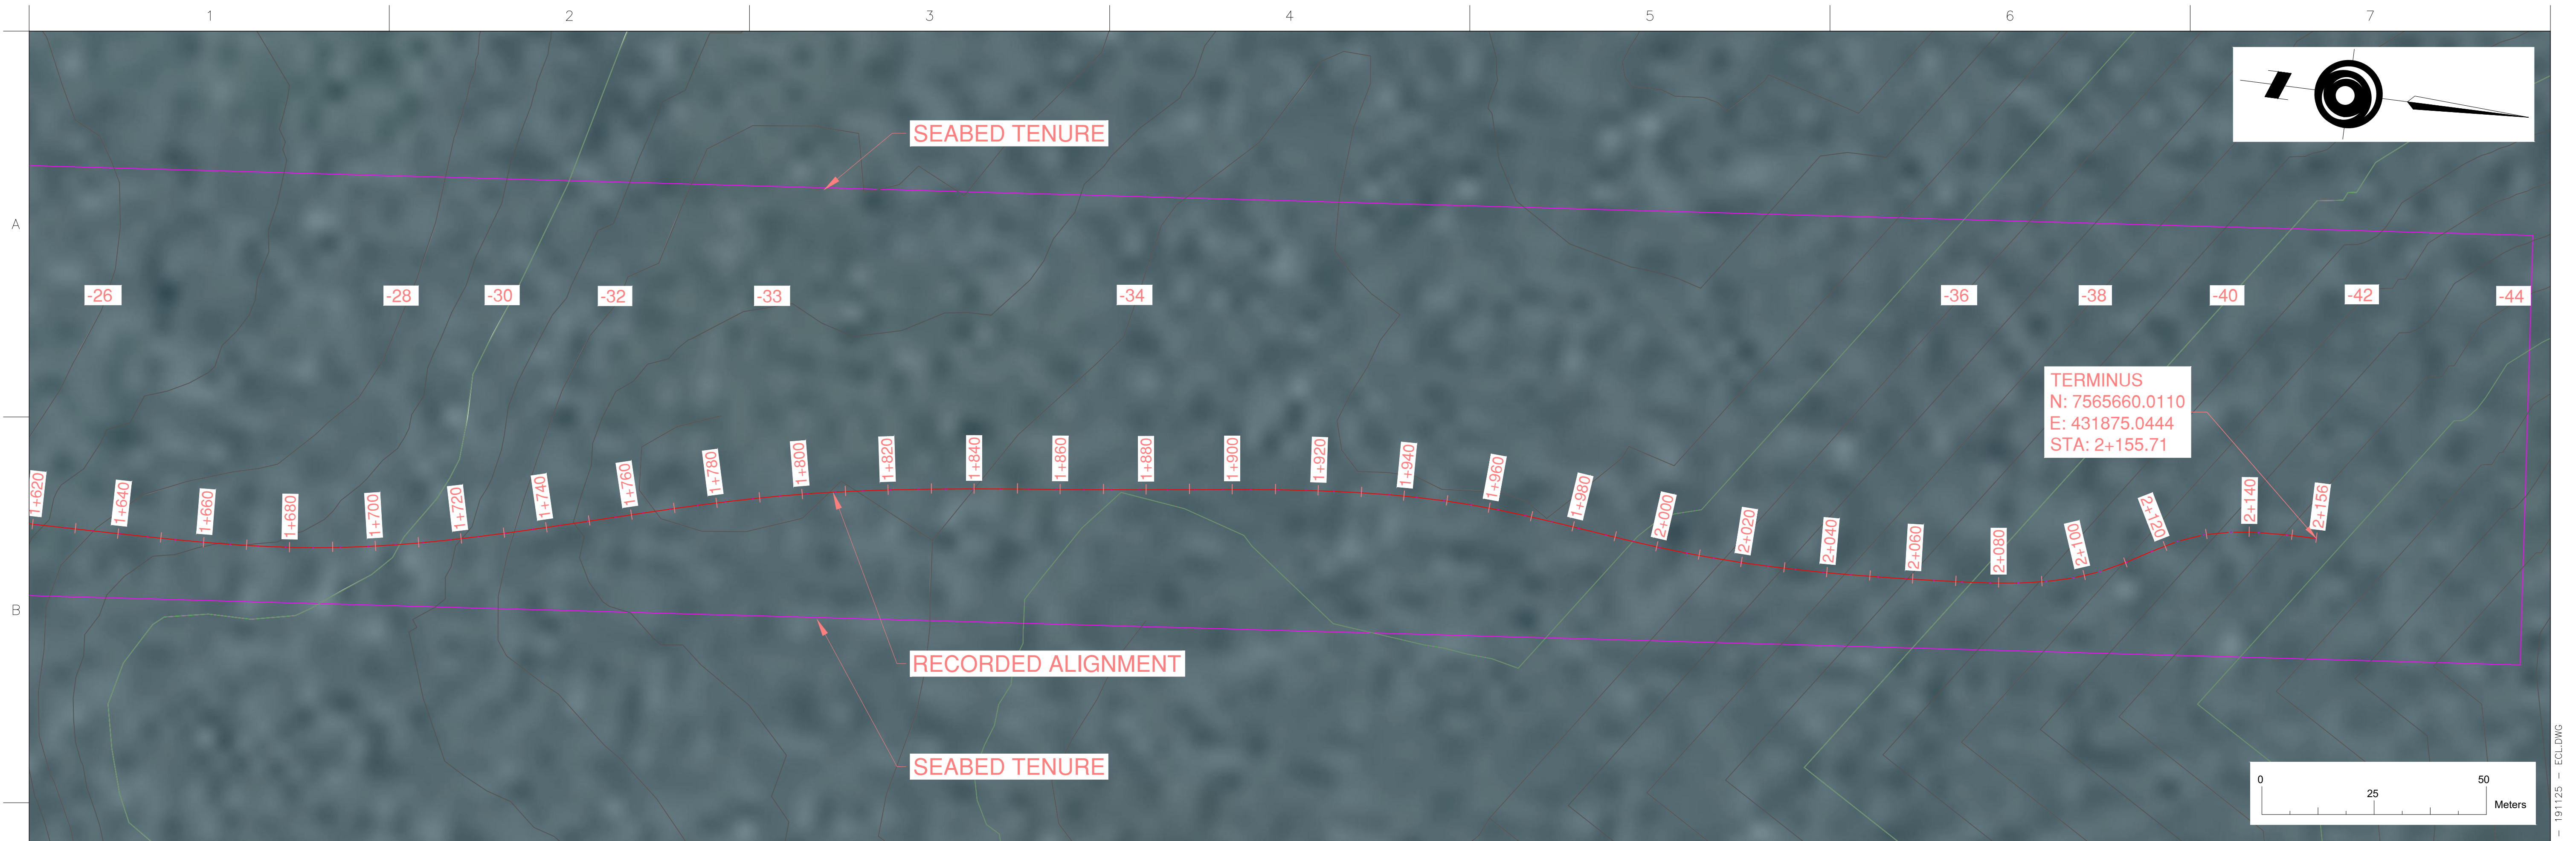

\* The seal and signature of the undersigned on this drawing certifies that the design information contained in these drawings accurately reflects the original design and the material design changes made during construction that were brought to the undersigned's attention. These drawings are intended to incorporate addenda, change orders, and other material design changes, but not necessarily, all site instructions. The undersigned does not warrant or guarantee, nor accept any responsibility for the accuracy or completeness of the as-constructed information supplied by others contained in these drawings, but does, by sealing and signing, certify that the as-constructed information, if accurate and complete, provides an as-constructed system which substantially complies in all material respects with the original design intent.\*

19-11-25	REV 0	ECL	AH	AH
19-11-22	AS RECORDED FOR CLIENT REVIEW	ECL	AH	JC
19-09-16	AS RECORDED FOR CLIENT REVIEW	TRB	AH	JC
DATE	DESCRIPTION	DRAWN	DESIGNED	APPROVED



**GREATPACIFIC**  
ENGINEERING & ENVIRONMENT

GREATPACIFIC CONSULTING LTD  
202-2780 VETERANS MEMORIAL PARKWAY  
VICTORIA, BC V9B 3S6  
778-433-2672  
www.greatpacific.ca

PERMIT/STAMP:

NOTES:

- GREATPACIFIC RECORDED DEPLOYED OUTFALL ALIGNMENT ON 2019/08/15 USING A SINGLE BEAM LOWRANCE HDS9 GEN 2 CHART PLOTTER/ECHO SOUNDER WITH A POINT-1 GPS ANTENNA/DIGITAL COMPASS.
- WATER LEVELS ADJUSTED TO GEODETIC DATA. (RESCAN, 2011)

CLIENT:



PROJECT NUMBER:

1065-001

MARINE OUTFALL  
RECORDED ALIGNMENT  
PLAN AND PROFILE

DRAWING NUMBER:

M007


SCALE:

1:750

REV:

REV 0



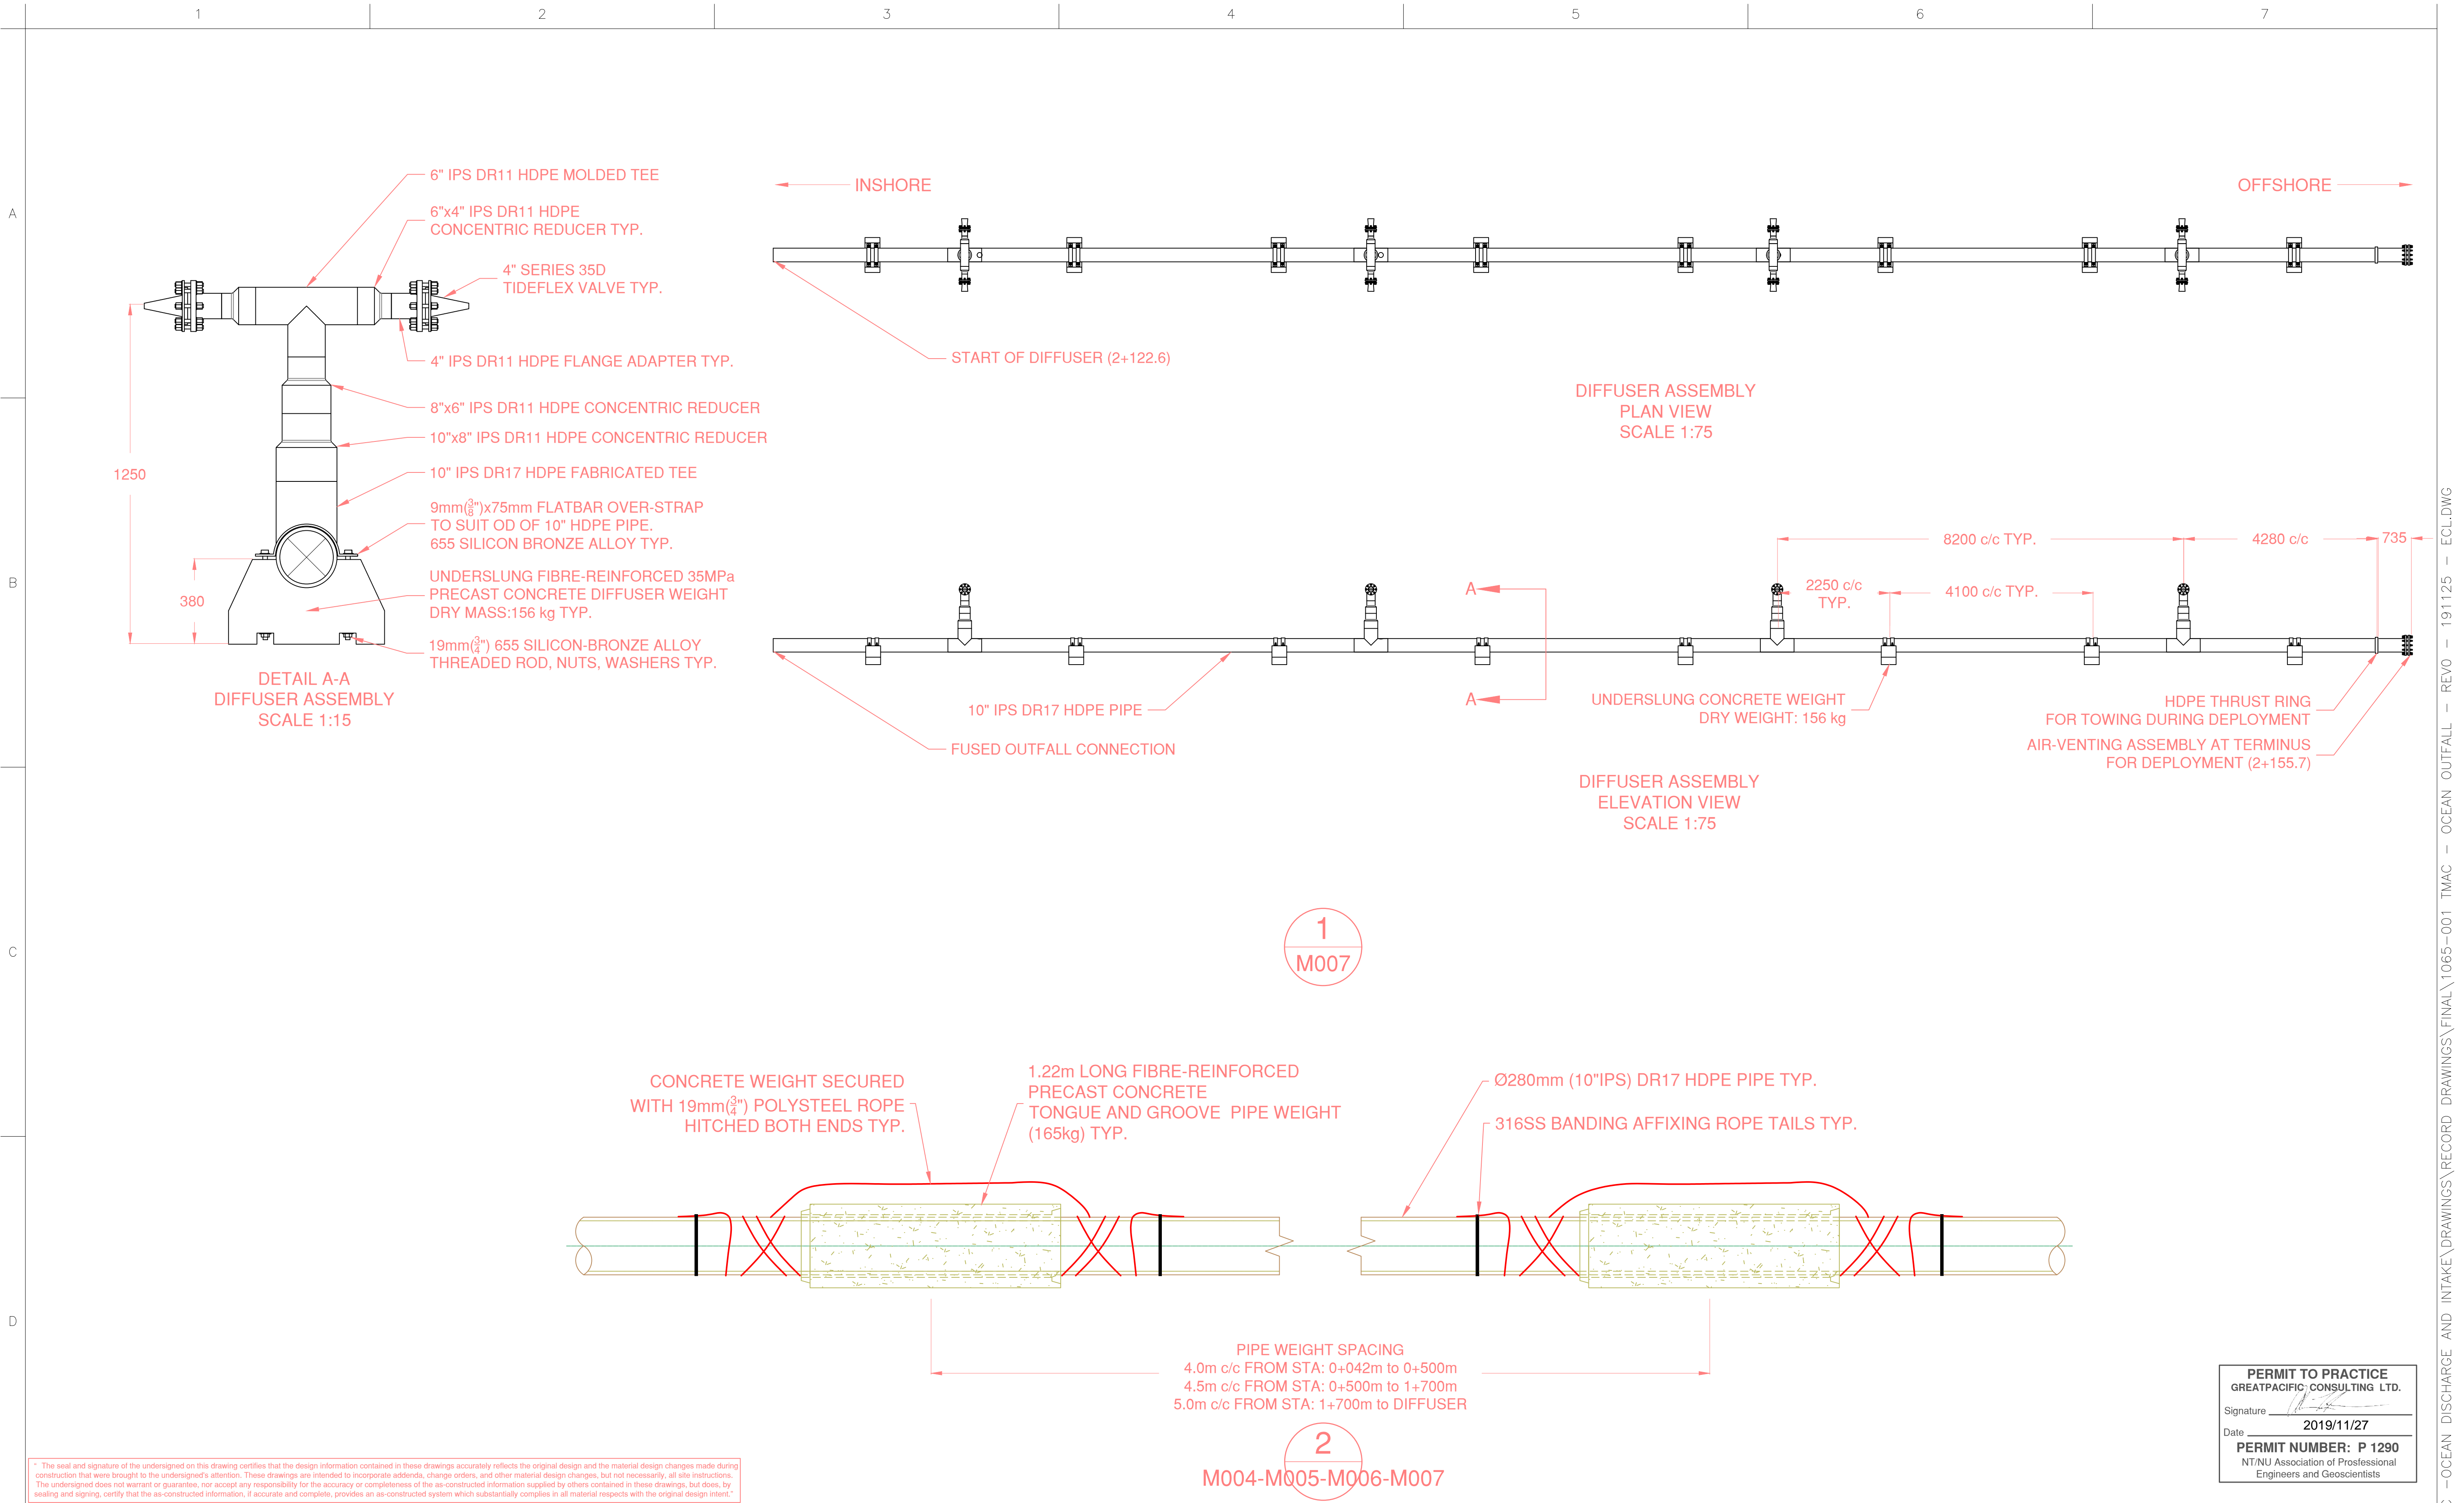

\* The seal and signature of the undersigned on this drawing certifies that the design information contained in these drawings accurately reflects the original design and the material design changes made during construction that were brought to the undersigned's attention. These drawings are intended to incorporate addenda, change orders, and other material design changes, but not necessarily, all site instructions. The undersigned does not warrant or guarantee, nor accept any responsibility for the accuracy or completeness of the as-constructed information supplied by others contained in these drawings, but does, by sealing and signing, certify that the as-constructed information, if accurate and complete, provides an as-constructed system which substantially complies in all material respects with the original design intent.\*

19-11-25	REV 0	ECL	AH	AH
19-11-22	AS RECORDED FOR CLIENT REVIEW	ECL	AH	AH
19-10-08	AS RECORDED FOR CLIENT REVIEW	BC	AH	AH
DATE	DESCRIPTION	DRAWN	DESIGNED	APPROVED

**GREATPACIFIC**  
ENGINEERING & ENVIRONMENT

GREATPACIFIC CONSULTING LTD  
202-2780 VETERANS MEMORIAL PARKWAY  
VICTORIA, BC V9B 3S6  
778-433-2672  
www.greatpacific.ca

PERMIT/STAMP:

NOTES:

- ALL DISTANCES ARE IN MILLIMETERS AND DECIMALS THEREOF UNLESS OTHERWISE STATED.
- DO NOT SCALE FROM DRAWINGS.

CLIENT:



PROJECT NUMBER:

1065-001

SEAWATER INTAKE &  
MARINE EFFLUENT OUTFALL  
DETAILS

DRAWING NUMBER:

M008

SCALE:

AS SHOWN

REV:

REV 0

FILE: W:\1065-001 -TMAC -OCEAN DISCHARGE AND INTAKE\DRAWINGS\RECORD DRAWINGS\FINAL\1065-001 TMAC - OCEAN OUTFALL - REV0 - 191125 - ECL.DWG















