

Memo

| | | | |
|---------------------|---|--------------------|---------------------|
| To: | Oliver Curran, Vice President Environmental Affairs | Client: | TMAC Resources Inc. |
| From: | Jasur Umarov Cameron Hore, PEng | Project No: | 1CT022.026 |
| Reviewed By: | Maritz Rykaart, PhD PEng | Date: | September 18, 2018 |
| Subject: | Doris North Construction Summary Report | | |

1 Introduction

This memo provides a summary of formal documentation related to the engineering and construction support of the following three facilities at TMAC Resources Inc's Hope Bay site:

- Doris North Tailings Catchment Basin
- Doris North Reagent Pad
- Doris North Airstrip De-icing Apron

SRK Consulting (Canada) Inc. provided Issue for Construction (IFC) drawings. HDPE liner installation was performed by Blomberg Building Group. Earthworks were completed by Nuna Logistics Ltd. and as-built surveys were conducted by Sub-Arctic Surveys Ltd. SRK has produced the as-built drawings based on the survey data provided by Sub-Arctic.

2 Summary of Attachments

The Blomberg Building Group Projects Reports are provided in Attachment 1 – BBG Project Reports.

Attachment 2 is separated into two sections. Attachment 2.1 contains the Issued for Construction (IFC) drawing sets for each facility and Attachment 2.2 contains the As-built drawings for each facility.

Quality Assurance/Quality Control (QA/QC) Reports, prepared by Blomberg Building Group, are provided in Attachment 3 – QA/QC Reports.

Blomberg Building Group also collected HDPE Seam samples to perform Same Day Peel and Shear Tests. Some of the tests were conducted on site and the remainder were sent to an independent laboratory, TRI/Environmental Inc. (TRI). The results of on site test are summarised with the QA/QC Reports in Attachment 3. The geosynthetic testing results conducted by TRI and

the corresponding test request forms are found in Attachment 4 – QA/QC Data. These test results are arranged into sub-appendices by the facility location.

The contents of all attachments are summarized in Table 1.

Table 1: Contents of Attachments

| Attachment | | Topic | Contents |
|------------|-----|----------------------------------|---|
| 1 | | BBG Project Reports | Project Reports organised by facility location |
| 2 | 2.1 | Issued for Construction Drawings | Doris North Tailings Catchment Basin |
| | | | Doris North Reagent Pad |
| | | | Doris North Airstrip De-icing Apron |
| | 2.2 | As-built Drawings | |
| | | | |
| | | | |
| 3 | | QA/QC Reports | QA/QC Reports organised by facility location |
| 4 | 4.1 | QA/QC Data | Doris North Tailings Catchment Basin QA/QC Data |
| | 4.2 | | Doris North Reagent Pad QA/QC Data |
| | 4.3 | | Doris North Airstrip De-icing Apron QA/QC Data |

Disclaimer—SRK Consulting (Canada) Inc. has prepared this document for TMAC Resources Inc. Any use or decisions by which a third party makes of this document are the responsibility of such third parties. In no circumstance does SRK accept any consequential liability arising from commercial decisions or actions resulting from the use of this report by a third party.

The opinions expressed in this report have been based on the information available to SRK at the time of preparation. SRK has exercised all due care in reviewing information supplied by others for use on this project. Whilst SRK has compared key supplied data with expected values, the accuracy of the results and conclusions from the review are entirely reliant on the accuracy and completeness of the supplied data. SRK does not accept responsibility for any errors or omissions in the supplied information, except to the extent that SRK was hired to verify the data.



Blomberg Building Group

TRL Catch Basin Project Report

Earthworks:

The foundation for the TLR Catch Basin was prepared for Geosynthetics by Nuna Logistics Ltd. Elevations and parameters were surveyed by Sub-Arctic Surveys Ltd. The same was done for the backfill of the TLR Catch Basin.

Base Layer Geotextile:

Non-woven geotextile was used for the base layer. It was installed in a north-south direction covering the entire TLR Catch Basin footprint.

The first row began on the east side of the apron and each successive piece was laid out with a minimum overlap of 200mm, until the west edge of the reagent pad was reached. Geotextile rolls were rolled out by hand and heat welded with a tiger torch as it was unrolled.

Sandbags were used to hold down the geotextile until the HDPE could be rolled out on top.

The surface of the Geotextile was cleared of all sandbags and debris before the HDPE was rolled out on top.

HDPE Liner Installation:

The HDPE was transported to Hope Bay site by TMac and to the TLR catchment basin by BBG. A visual inspection of the HDPE rolls was conducted before seaming. Rolls with excessive amounts of damage as a result of transportation had the effected sections removed before seaming.

HDPE pieces were rolled out to length prior to being transported. Once pieces were at the catchment basin they were rolled out by hand and inspected. Sandbags were used to secure the edges of the HDPE to prevent wind uplift.

The HDPE was placed in a north to south orientation when installed on top of the geomembrane. The HDPE extends a minimum of 2m past the top of the berm in all directions. Before welding, the seams were wiped clean and dry. A total of 3 HDPE seams were welded to cover the footprint of the catch basin.

HDPE Seaming and Welding:

Extrusion welds were carried out over sample cut-outs and all other holes in the HDPE liner. In total, there are 5 extrusion welds on TLR catch basin liner. All welds were carried out in accordance with SRK Consulting's Technical Specification- Revision G on Geosynthetics. All weld test results are documented in the TLR Catch Basin QAQC.

HDPE Testing:

Seam Welds:

Samples were removed, and their locations labelled. From these samples on site destructive tests were performed. There were also samples sent off site for third party destructive testing as well.

Air channel testing was performed on all seams with results documented in the QAQC. Air channel tests were performed in accordance with SRK Consulting's *Technical Specification- Revision G* on Geosynthetics.

Extrusion Welds:

Non-destructive vacuum testing was performed on all extrusion welds in accordance with SRK Consulting's *Technical Specification- Revision G* on Geosynthetics.

Samples were removed, and their locations labelled, and were sent off site for third party destructive testing.



Blomberg Building Group

Doris North Reagent Pad Project Report

Earthworks:

The foundation for the Doris North Reagent Pad was prepared for Geosynthetics by Nuna Logistics Ltd. Elevations and parameters were surveyed by Sub-Arctic Surveys Ltd. The same was done for the backfill of the Doris North Reagent pad.

Base Layer Geotextile:

Non-woven geotextile was used for the base layer. It was installed in a north-south direction covering the entire reagent pad footprint.

The first row began on the east side of the apron and each successive piece was laid out with a minimum overlap of 200mm, until the west edge of the reagent pad was reached. Geotextile rolls were rolled out by hand and heat welded together with a tiger torch as it was unrolled.

Sandbags were used to hold down the geotextile until the HDPE could be rolled out on top.

The surface of the Geotextile was cleared of all debris before the HDPE was rolled out on top.

HDPE Installation:

The HDPE was transported to Hope Bay site by TMac and to the Doris North Reagent Pad by Nuna Logistics Ltd. A visual inspection of the HDPE rolls was conducted before seaming after each roll had been laid out. Rolls with excessive amounts of damage as a result of transportation had the effected layers removed before seaming.

The HDPE was suspended from a spreader bar attached to a telehandler for the unrolling process. This limited the amount of damage that could be caused to the underlying surface.

The HDPE was placed in a north to south orientation when installed on top of the geomembrane. The HDPE extends a minimum of 2000mm across the top of the berm in all directions. Before welding, the seams were wiped clean and dry.

Due to high winds at the time of installation 1500kg cement bags were used to hold down the edges of HDPE to prevent wind uplift. The HDPE in the middle of the Reagent Pad was held down with sand bags to prevent wind from getting underneath and causing wrinkles.

HDPE Seaming and Welding:

A total of 7 HDPE seams were welded to cover the footprint of the reagent pad. Before seaming the HDPE, the area before the wedge welder was wiped dry, and cleaned of all debris.

Extrusion welds were carried out over sample cut-outs and other holes in the HDPE liner. In total, there are 34 extrusion welds on the Doris North Reagent Pad liner. All welds were

carried out in accordance with SRK Consulting's *Technical Specification- Revision G* on Geosynthetics. All weld test results are documented in the Doris North Project QAQC.

HDPE Testing:

Seam Welds:

Samples were removed, and their locations labelled. From these samples on site destructive tests were performed. There were also samples sent off site for third party destructive testing as well.

Air channel testing was performed on all seams with results documented in the QAQC. Air channel tests were performed in accordance with SRK Consulting's *Technical Specification- Revision G* on Geosynthetics.

Extrusion Welds:

Non-destructive vacuum testing was performed on all extrusion welds in accordance with SRK Consulting's *Technical Specification- Revision G* on Geosynthetics.

Top Layer Geotextile:

Non-woven geotextile was used for the top-layer. It was installed in a north-south direction covering the entire reagent pad footprint. The first row began on the east side of the apron and each successive piece was overlapped a minimum of 200mm, until the west edge of the reagent pad was reached. All seams were heat bonded together using a tiger torch. The HDPE was swept clear of any debris and inspected for defects/holes prior to being covered by the top-layer of geotextile.

Sump Installation:

Sump was provided by Sandale and approved by SRK before installation. Sumps were installed as per engineered specifications provided.



Blomberg Building Group

Airstrip De-icing Apron Containment Liner

Earthworks:

The foundation for the Airstrip De-icing Apron was prepared for Geosynthetics by Nuna Logistics Ltd. Elevations and parameters were surveyed by Sub-Arctic Surveys Ltd. The same was done for the backfill of the Airstrip De-icing Apron.

Snow Removal:

Due to a delay between final date of earthworks and the start date of Geosynthetics, snow had to be removed from the area. Snow was removed with small pieces of machinery as to not disturb the existing earthworks.

Base Layer Geotextile:

Non-woven geotextile was used for the base layer. It was installed in a north-south direction covering the Airstrip De-icing Apron footprint.

The first row began on the east side of the apron and each successive piece was laid out with a minimum overlap of 200mm, until the west edge of the reagent pad was reached. Geotextile rolls were rolled out by hand and heat welded together with a tiger torch as it was unrolled.

Sandbags were used to hold down the geotextile until the HDPE could be rolled out on top.

The surface of the Geotextile was cleared of all snow build-up and debris before the HDPE was rolled out on top.

HDPE Liner Installation:

The HDPE was transported to Hope Bay site by TMac and to the Airstrip De-icing Apron by Blomberg Building Group Ltd. A visual inspection of the HDPE rolls was conducted before seaming after each roll had been rolled out. Rolls with excessive amounts of damage as a result of transportation had the effected sections removed or marked for repair before seaming.

The HDPE was suspended from a reach stacker with the rolling pins inserted for the unrolling process. This limited the amount of damage that could be caused to the underlying surface.

The HDPE was placed in a north to south orientation when installed on top of the geomembrane. The HDPE extends a minimum of 2m across the top of the berm in all directions. Before welding, the seams were wiped clean and dry.

Due to high winds at the time of installation 1500kg cement bags were used to hold down the edges of HDPE to prevent wind uplift. The HDPE in the middle of the Reagent Pad was held down with sand bags to prevent wind from getting underneath and causing wrinkles.



HDPE Seaming and Welding:

A total of 9 seams were welded to cover the entire basin and 2m past the end of the berm. Before seaming the HDPE, the area before the wedge welder was wiped dry, and cleaned of all debris.

Extrusion welds were carried out over sample cut-outs and other holes in the HDPE liner. In total, there are 6 extrusion welds on the De-icing Apron HDPE liner. All welds were carried out in accordance with SRK Consulting's *Technical Specification- Revision G* on Geosynthetics. Locations of welds are available on QAQC.

HDPE Testing:

Seam Welds:

Samples were removed, and their locations labelled. From these samples on site destructive tests were performed. There were also samples sent off site for third party destructive testing as well. Air channel testing was performed on all seams with results documented in the QAQC. Air channel tests were performed in accordance with SRK Consulting's *Technical Specification- Revision G* on Geosynthetics.

Extrusion Welds:

Non-destructive vacuum testing was performed on all extrusion welds in accordance with SRK Consulting's *Technical Specification- Revision G* on Geosynthetics.

Top Layer Geotextile:

Non-woven geotextile was used for the top-layer. It was installed in a north-south direction covering the entire reagent pad footprint. The first row began on the east side of the apron and each successive piece was overlapped a minimum of 200mm, until the west edge of the reagent pad was reached. All seams were heat bonded together using a tiger torch. The HDPE was swept clear of all snow build up, debris and inspected for defects/holes prior to being covered by the top-layer of geotextile.

Sump Installation:

Backfill:

The Airstrip De-icing Apron was backfilled as per SRK Consulting's *Technical Specification- Revision G* on Geosynthetics. *Section 6.3.3 Liner Cover* specifications.

Sub Arctic Surveys shot elevations after the transition material was laid down to ensure the grade was still correct and sloping towards the sump.

Attachment 2
Issued Drawings

Attachment 2.1
Drawings Issued for Construction

Engineering Drawings for the Tailings Catch Basin, Hope Bay Project, Nunavut, Canada

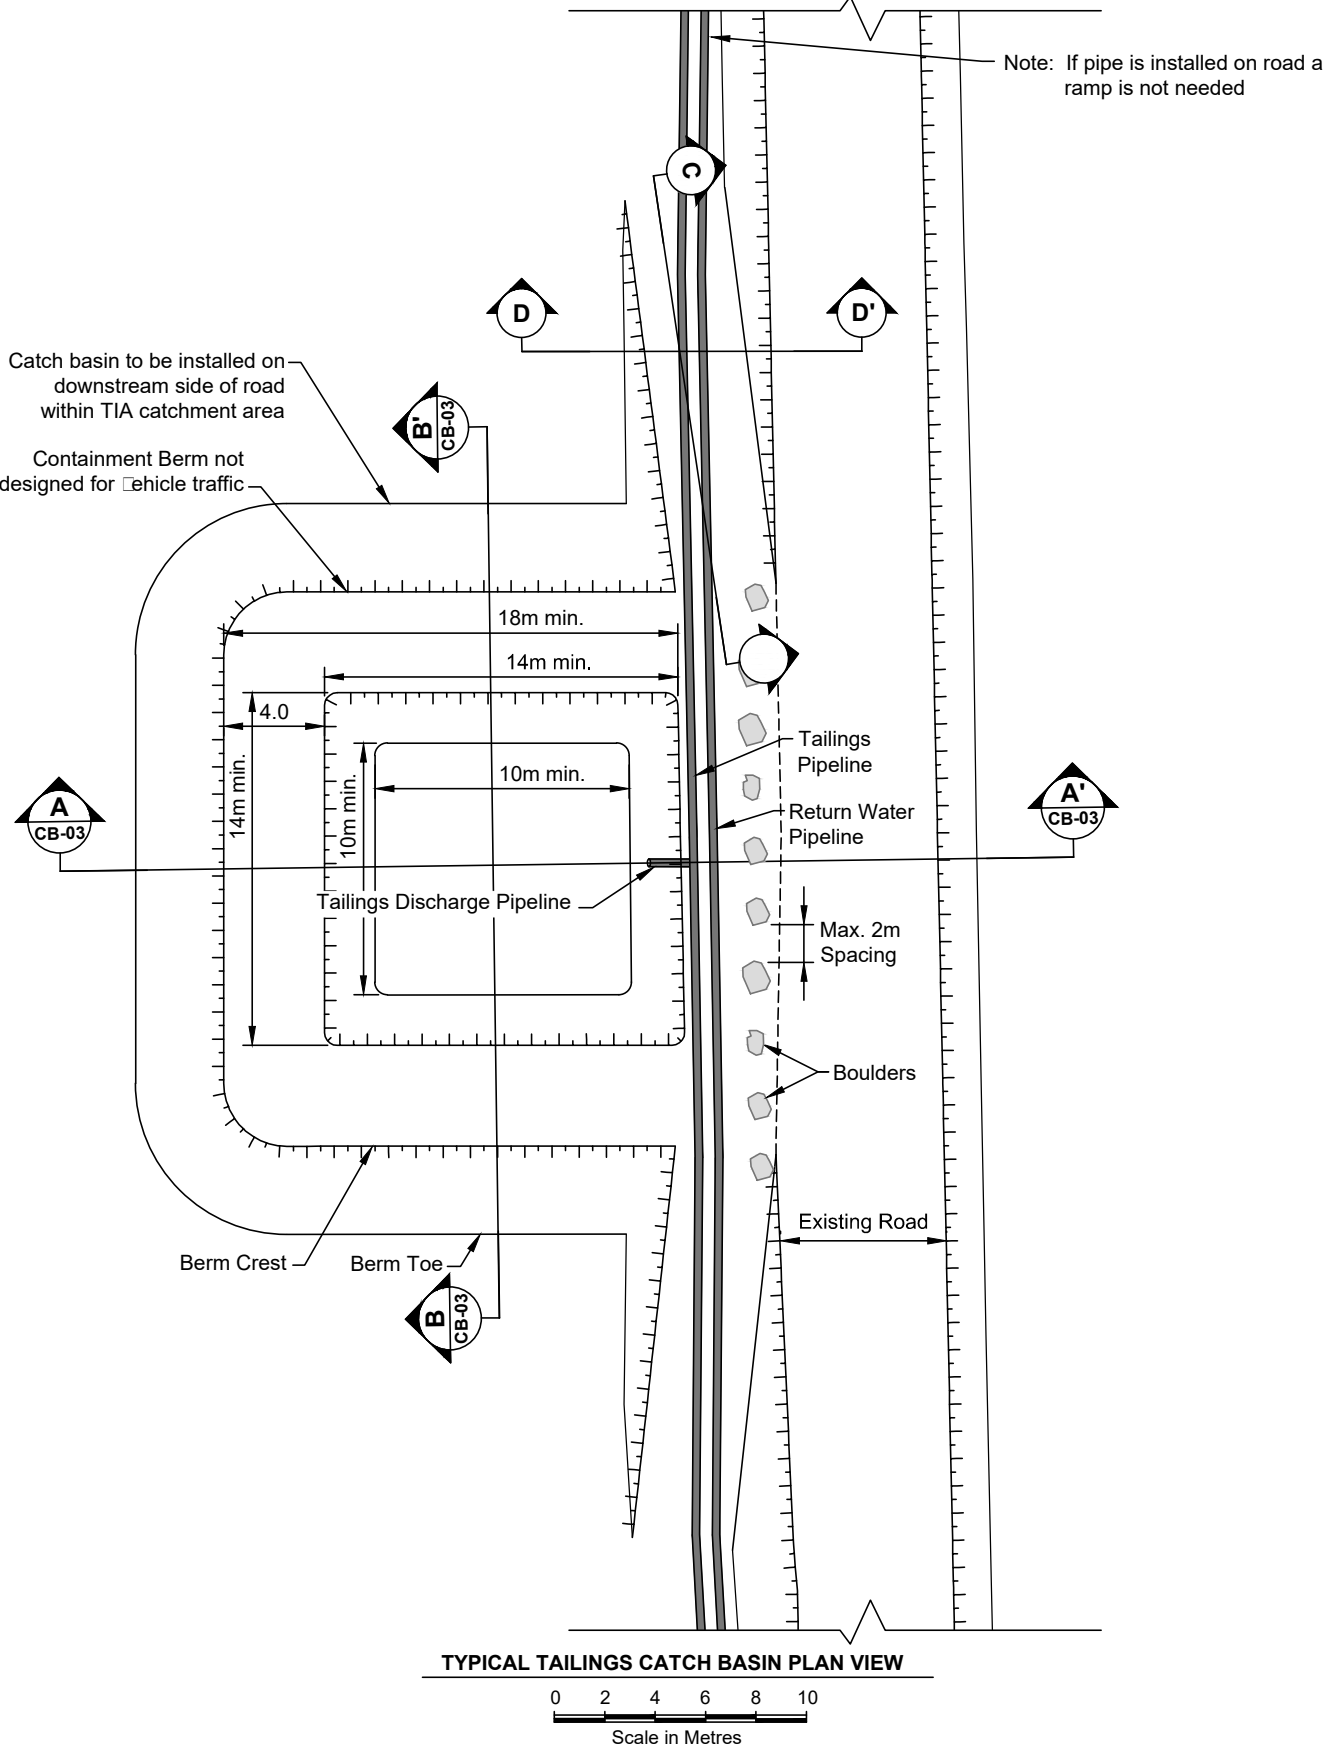
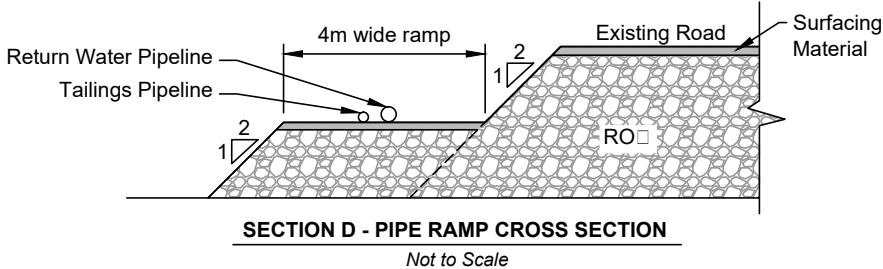
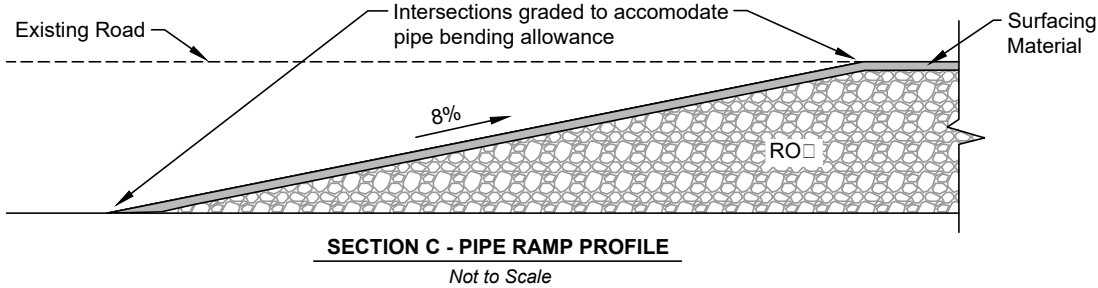
ACTIVE DRAWING STATUS

| DWG NUMBER | DRAWING TITLE | REVISION | DATE | STATUS |
|------------|---|----------|---------------|-------------------------|
| CB-01 | Engineering Drawings for the Tailings Catch Basin, Hope Bay Project, Nunavut, Canada | 0 | Mar. 21, 2017 | Issued for Construction |
| CB-02 | Typical Tailings Catch Basin Layout | 0 | Mar. 21, 2017 | Issued for Construction |
| CB-03 | Typical Tailings Catch Basin Sections | 0 | Mar. 21, 2017 | Issued for Construction |



PROJECT NO: 1CT022.020
Revision 0
March 21, 2017
Drawing CB-01


- NOTES**
1. All dimensions are in metric units, unless specifically mentioned.
 2. All drawings are scaled appropriately for D-Siē construction drawings. Scales may not be correct if these drawings are reproduced and presented in any other siē format.
 3. The Contractor and Construction Manager shall familiē themselēs with all appropriate Licenses and/or Permits pertaining to execution of the Works. The Engineer will not be responsible for any infringements.
 4. The Contractor is to take due care that no wildlife or birdsē nest are disturbed during construction. The Construction Manager is to be immediately notified if such sites are found.
 5. The Contractor will employ best practices to identify archaeological sites, and maintain archaeological site exclusion boundaries of 30m minimum radius from any of these works.
 6. These works must be executed in accordance with the standard TMAC health and safety, and enēromental standards and protocols. It is the Contractors responsibility to familiē himself with these documents.
 7. The final locations of the Tailings Catch Basins will be confirmed by the site engineer.
 8. Tailings Catch Basins are to be located on the downstream side of the existing road within TIA catchment area.
 9. The road will be widened at catch basin locations, to provide space for the tailings pipeline and traffic protection boulders.
 10. The final constructed containment ēolume of the Tailings Catch Basins will be minimum of 120 m³ to liner crest eleēation.
 11. The Contractor shall be responsible to maintain and clear snow from the roadway with out damaging ēmoēing the boulders or the tailings pipeline.
 12. Snow shall neēer be remoēed from the Tailings Catch Basin to prevent damaging the geomembrane lining.
 13. Surēey to be undertaken at placement of each material layer to enable ēerification of layer thicknesses.
 14. Construction shall be in accordance with the following Technical Specifications: Earthworks and Geotechnical Engineering, Hope Bay project, Nunaēut, Canada, reēision G -Issue for Construction.
 15. Existing road height ēaries. Road eleēation must be ēēual or greater than catch basin embankments where ēining. Where possible the widened section should finish at the same eleēation as the existing road. Road must be raised if reēquired.
 16. Notes in this drawing apply to all other actiē drawings.



\\nars-00\Project\01_SITES\Hope Bay\1CT022.020-1_Phase 2 DEIS_Engineering Support\1040_AutoCAD\Metric\TIA_Road\1CT022.020-1_MN-TIA RD.dwg

| |
|---|
| |</ |
|---|

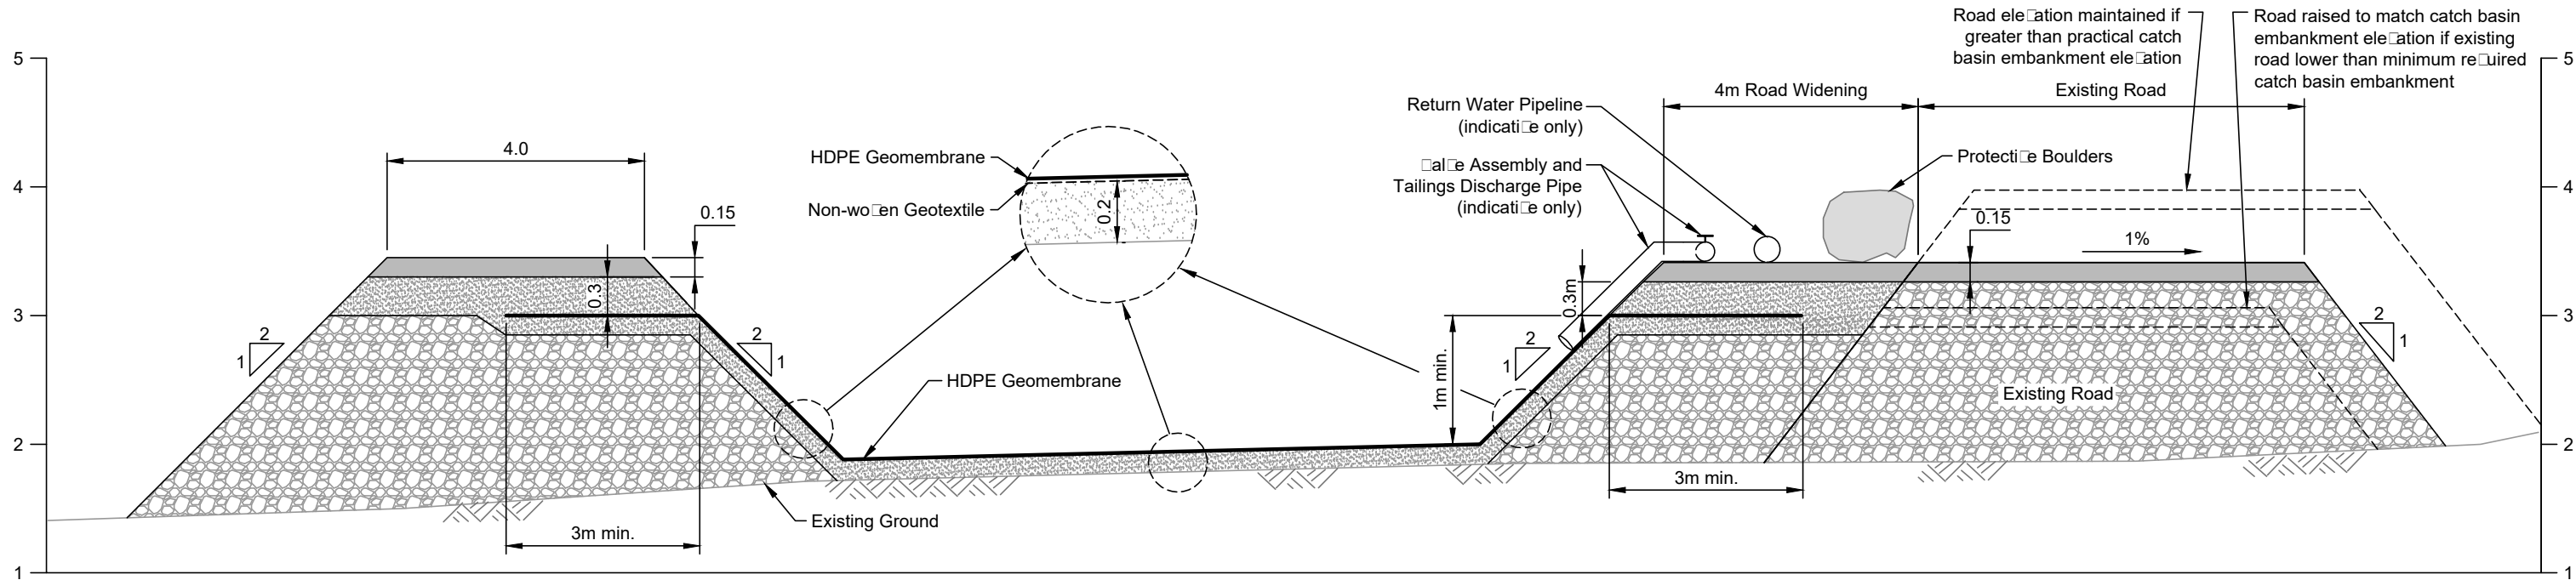\\nas01\Projects\01_SITES\Hope Bay\1CT022.020_004_Phase 2 DEIS_Engineering Support\1040_AutoCAD\Metric\TA_Road\1CT022.020-4_MN-TA RD.dwg




A
CB-02

SECTION A

0 1 2 3 4 5

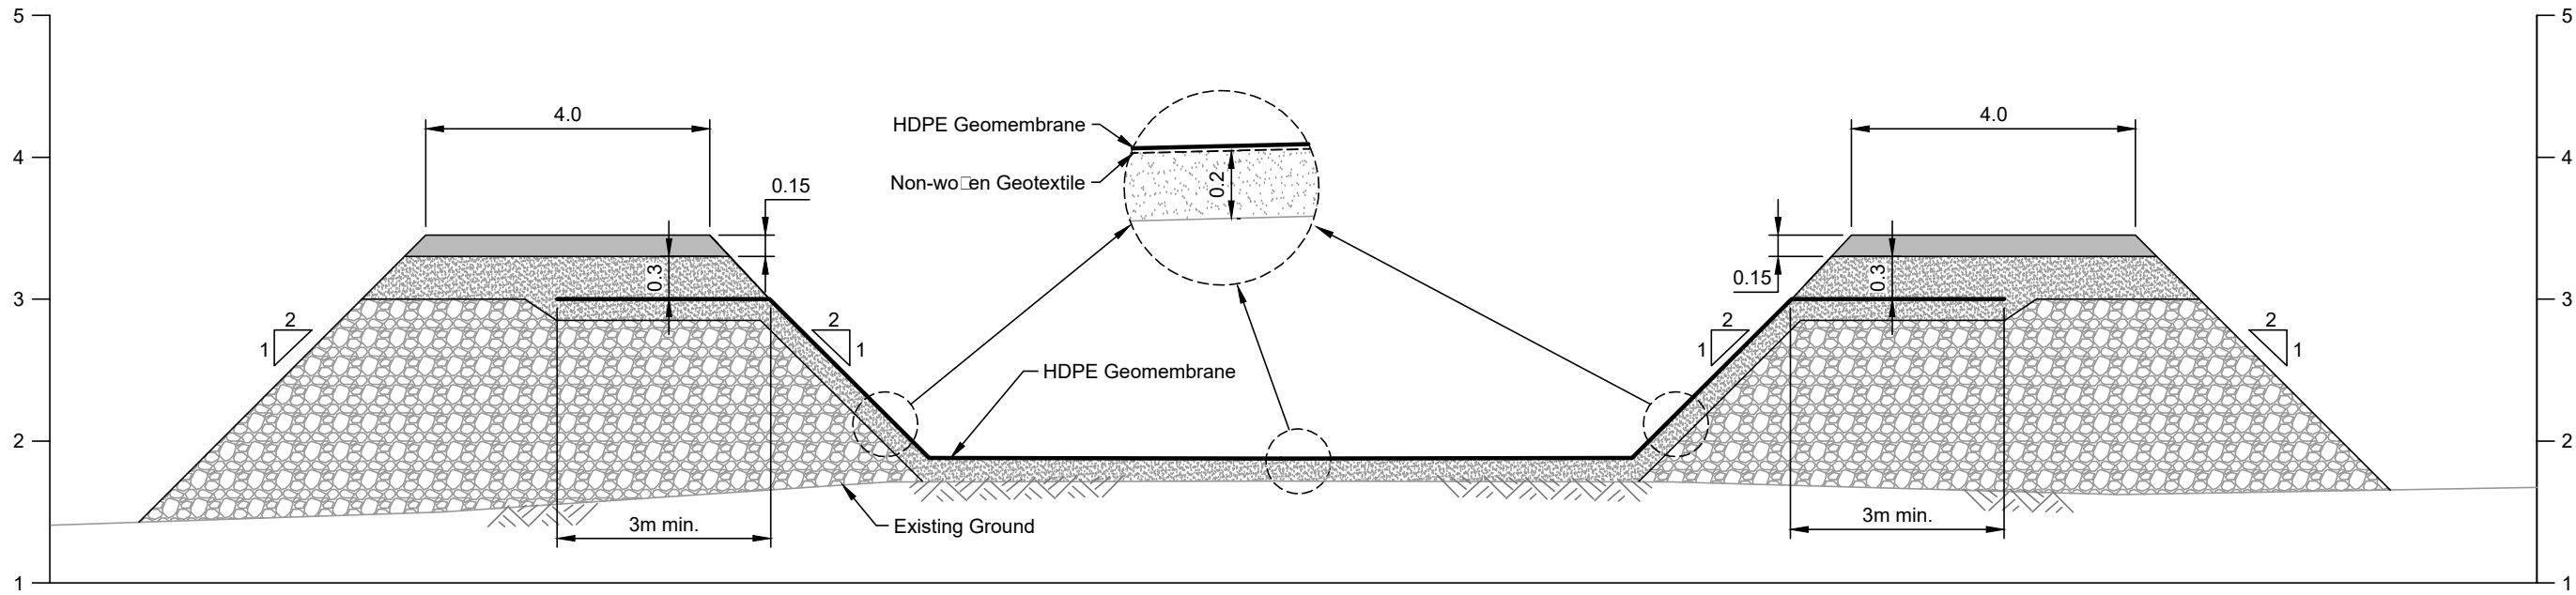Horizontal Scale in Metres
Vertical Exaggeration 2X





B
CB-02

SECTION B

0 1 2 3 4 5

Horizontal Scale in Metres
Vertical Exaggeration 2X

| LEGEND | | | |
|--------|------------------------|--|----------------------------|
| | Surfacing Material | | 60 mil HDPE Geomembrane |
| | Bedding Material | | 12 oz Non-woven Geotextile |
| | Run-of-quarry Material | | |

| | | | | | | | | | | | | | | | | | | | | | | | | | | | | | | | | | | | | | | | | | | | | | | | | | |
|--|--|--|--|--|--|--|--|--|--|--|--|--|--|--|--|--|--|--|--|---|--|--|--|--|--|--|--|--|--|---|--|--|--|--|--|--|--|--|--|---------------------------------------|--|--|--|--|--|--|--|--|--|
| | | | | | | | | | | | | | | | | | | | |  | | | | | | | | | |  | | | | | | | | | | Tailings Catch Basin | | | | | | | | | |
| | | | | | | | | | | | | | | | | | | | | | | | | | | | | | | | | | | | | | | | | DRAWING TITLE: | | | | | | | | | |
| | | | | | | | | | | | | | | | | | | | | | | | | | | | | | | | | | | | | | | | | Typical Tailings Catch Basin Sections | | | | | | | | | |
| | | | | | | | | | | | | | | | | | | | | | | | | | | | | | | | | | | | | | | | | DRAWING NO. | | | | | | | | | |
| | | | | | | | | | | | | | | | | | | | | | | | | | | | | | | | | | | | | | | | | CB-03 | | | | | | | | | |
| | | | | | | | | | | | | | | | | | | | | | | | | | | | | | | | | | | | | | | | | SHEET | | | | | | | | | |
| | | | | | | | | | | | | | | | | | | | | | | | | | | | | | | | | | | | | | | | | 3 OF 3 | | | | | | | | | |
| | | | | | | | | | | | | | | | | | | | | | | | | | | | | | | | | | | | | | | | | REVISION NO. | | | | | | | | | |
| | | | | | | | | | | | | | | | | | | | | | | | | | | | | | | | | | | | | | | | | 0 | | | | | | | | | |

| | | | | | | |
|---------------------------|-------------|-------|-------|------|-----|---------|
| 0 Issued for Construction | | | | CH | EMR | 21Mar17 |
| NO. | DESCRIPTION | CHK'D | APP'D | DATE | | |

| | | | | | | | | | | | |
|------------------------------|--|--|--|---|--|--|--|-------------------------|--|--|--|
| PROFESSIONAL ENGINEERS STAMP | | | | FILE NAME: 1CT022.020-1_Catch Basin.dwg | | | | SRK JOB NO.: 1CT022.020 | | | |
|------------------------------|--|--|--|---|--|--|--|-------------------------|--|--|--|

| | | | | | | | | | | | |
|-------------|--|--|--|---------------|--|--|--|---------------------|--|--|--|
| DESIGN: CH | | | | DRAWN: NV | | | | REVIEWED: CH | | | |
| CHECKED: CH | | | | APPROVED: EMR | | | | DATE: Mar. 21, 2017 | | | |

| | | | | | | | | | | | |
|-------------|--|--|--|---------------|--|--|--|-------------|--|--|--|
| DRAWING NO. | | | | DRAWING TITLE | | | | DRAWING NO. | | | |
| | | | | | | | | | | | |
| | | | | | | | | | | | |
Engineering Drawings for the Doris North Reagent Pad, Doris North Project, Nunavut, Canada

ACTIVE DRAWING STATUS

| DWG NUMBER | DRAWING TITLE | REVISION | DATE | STATUS | PREVIOUS REVISION HISTORY | | |
|------------|--|----------|---------------|-----------------------|---------------------------|--|--|
| DN-RP-00 | Engineering Drawings for the Doris North Reagent Pad, Doris North Project, Nunavut, Canada | A | Oct. 13, 2016 | Issued for Discussion | | | |
| DN-RP-01 | Final Layout Design | A | Oct. 13, 2016 | Issued for Discussion | | | |
| DN-RP-02 | Reagent Pad Berms and Top of Bedding Material/Liner Plan Views | A | Oct. 13, 2016 | Issued for Discussion | | | |
| DN-RP-03 | Liner Protection Layer and Final Pad Floor Layout | A | Oct. 13, 2016 | Issued for Discussion | | | |
| DN-RP-04 | Sections | A | Oct. 13, 2016 | Issued for Discussion | | | |
| DN-RP-05 | Details | A | Oct. 13, 2016 | Issued for Discussion | | | |



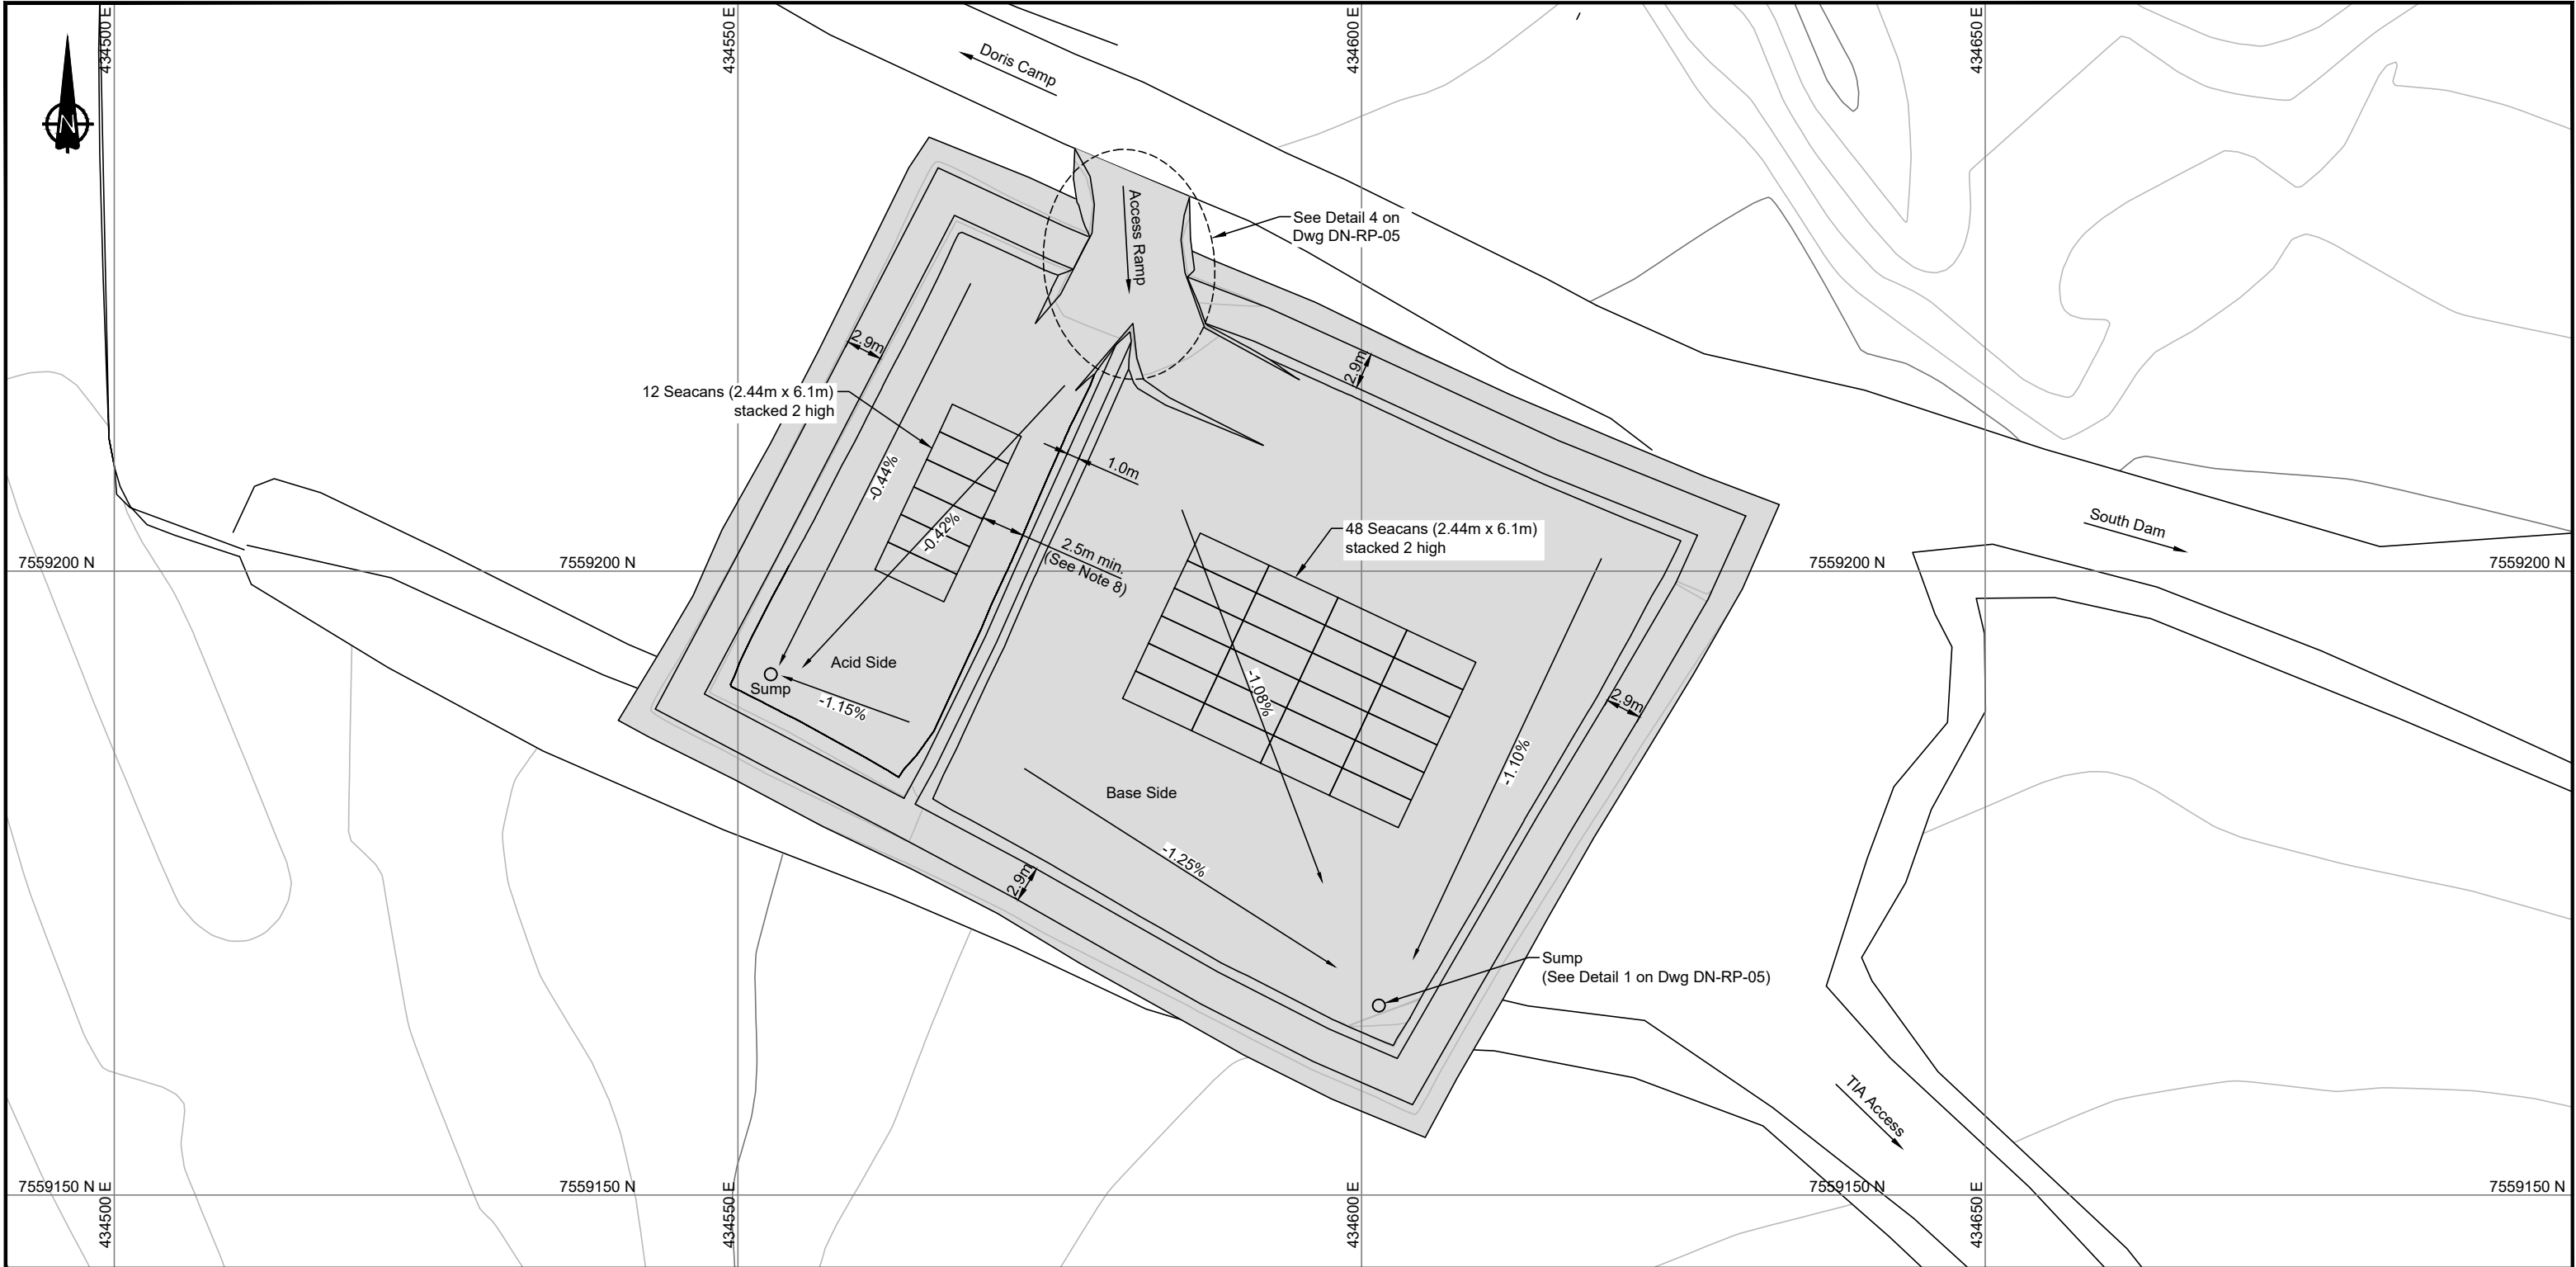PROJECT NO: 1CT022.005
Revision A
October 13, 2016
Drawing DN-RP-00



NOTES

1. The co-ordinate system is \square TM NAD 83, Zone 13

2. All dimensions are in metric units, unless specifically mentioned.

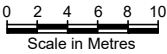
3. Construction shall be in accordance with the following Technical Specifications: Earthworks and Geotechnical Engineering, Hope Bay Project, Nunavut, Canada, Revision G – Issued for Construction.



4. The design vehicle for the facility is the Hyster HR45-40LS reach stacker.
5. Secans are to be placed two high.


6. Liner shall be deployed, seamed and repaired by a certified liner installer in accordance with the manufacturers specifications.

7. As-built pad surface provided by TMAC.


8. Secans should be placed a minimum of 2.5m from the toe of the containment berms to allow for snow clearing.



| |
|---|
| | | | | | | | | | |  | | |  | | | North Dam Reagent Pad | |
| | | | | | | | | | | | | | | | | DRAWING TITLE: | |
| | | | | | | | | | | | | | Final Layout Design | |
| | | | | | | | | | | DESIGN: MMM | | | DRAWN: NV | | | REVIEWED: MMM | | | DORIS NORTH PROJECT | |
| | | | | | | | | | | CHECKED: MMM | | | APPROVED: EMR | | | DATE: Oct. 13, 2016 | |
| DRAWING NO. | | | | | | | | | | DRAWING TITLE | | | | | | | | | | DRAWING NO. | | | | | | | | | | DRAWING TITLE | | | | | | | | | | A | ISSUED FOR DISCUSSION | | | MMM | EMR | 13Oct16 | |
| | NO. | DESCRIPTION | | | CHK'D | APP'D | DATE | | | | | | | | | | | PROFESSIONAL ENGINEERS STAMP | | | FILE NAME: 1CT022.005-DN-RP-01-03.dwg | | | | | | SRK JOB NO.: 1CH022.005.300 | | | DRAWING NO. DN-RP-01 | | | SHEET 2 of 6 | | | REVISION NO. A | |
| | REFERENCE DRAWINGS | | | | | | | | | | | | | | | | | | | | REVISIONS | |

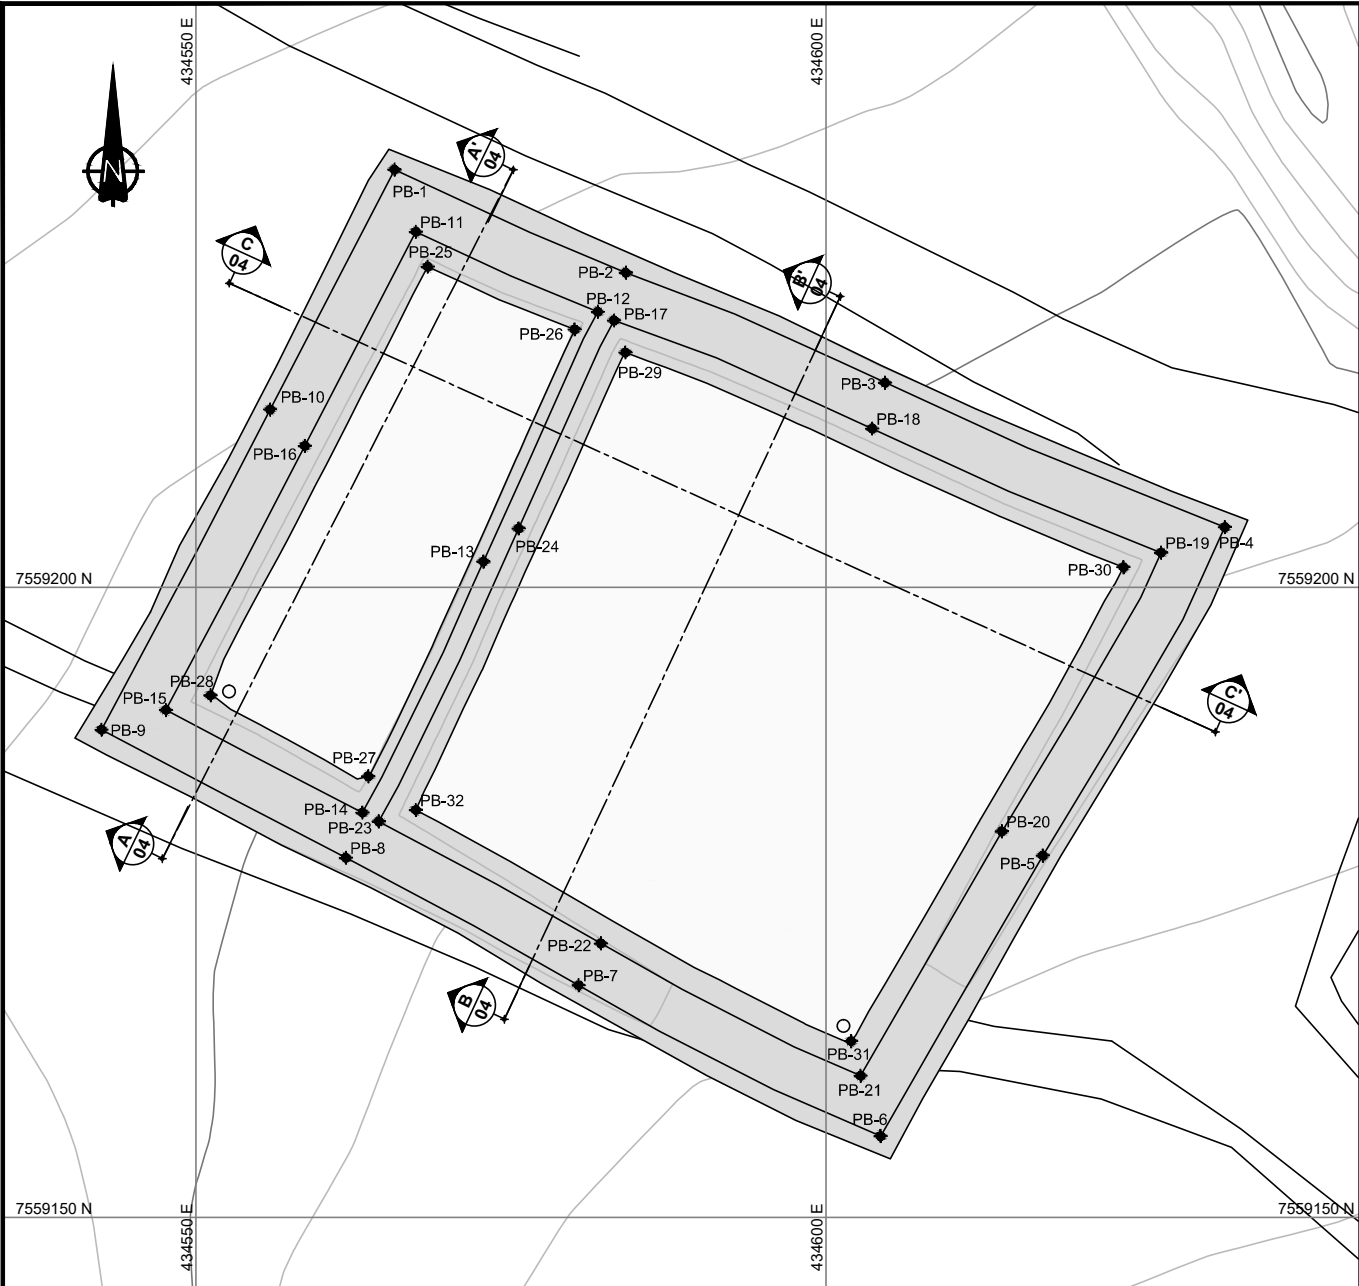


REAGENT PAD BERMS

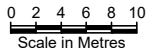

| REAGENT PAD BERM STAKEOUT POINTS: | | | |
|-----------------------------------|--------------|-------------|---------------|
| ID | Northing (m) | Easting (m) | Elevation (m) |
| PB-1 | 7,559,233.15 | 434,565.77 | 43.74 |
| PB-2 | 7,559,224.97 | 434,584.13 | 43.64 |
| PB-3 | 7,559,216.24 | 434,604.68 | 43.51 |
| PB-4 | 7,559,204.77 | 434,631.66 | 43.52 |
| PB-5 | 7,559,178.71 | 434,617.21 | 43.19 |
| PB-6 | 7,559,156.45 | 434,604.34 | 42.88 |
| PB-7 | 7,559,168.42 | 434,580.38 | 43.12 |
| PB-8 | 7,559,178.54 | 434,561.91 | 43.59 |
| PB-9 | 7,559,188.70 | 434,542.52 | 43.68 |
| PB-10 | 7,559,214.11 | 434,555.90 | 43.62 |
| PB-11 | 7,559,228.21 | 434,567.46 | 43.72 |
| PB-12 | 7,559,221.87 | 434,581.90 | 43.54 |
| PB-13 | 7,559,202.04 | 434,572.82 | 43.43 |
| PB-14 | 7,559,182.12 | 434,563.22 | 43.59 |
| PB-15 | 7,559,190.26 | 434,547.62 | 43.69 |
| PB-16 | 7,559,211.22 | 434,558.65 | 43.61 |
| PB-17 | 7,559,221.18 | 434,583.19 | 43.54 |
| PB-18 | 7,559,212.59 | 434,603.67 | 43.47 |
| PB-19 | 7,559,202.75 | 434,626.60 | 43.51 |
| PB-20 | 7,559,180.63 | 434,613.97 | 43.19 |
| PB-21 | 7,559,161.24 | 434,602.75 | 42.90 |
| PB-22 | 7,559,171.74 | 434,582.15 | 43.13 |
| PB-23 | 7,559,181.42 | 434,564.52 | 43.57 |
| PB-24 | 7,559,204.67 | 434,575.62 | 43.45 |
| PB-25 | 7,559,225.44 | 434,568.40 | 42.75 |
| PB-26 | 7,559,220.47 | 434,580.06 | 42.70 |
| PB-27 | 7,559,185.00 | 434,563.69 | 43.00 |
| PB-28 | 7,559,191.43 | 434,551.17 | 42.47 |
| PB-29 | 7,559,218.64 | 434,584.09 | 42.60 |
| PB-30 | 7,559,201.59 | 434,623.61 | 42.51 |
| PB-31 | 7,559,163.98 | 434,602.00 | 42.01 |
| PB-32 | 7,559,182.32 | 434,567.46 | 42.53 |


| TOP OF BEDDING MATERIAL STAKEOUT POINTS: | | | |
|--|--------------|-------------|---------------|
| ID | Northing (m) | Easting (m) | Elevation (m) |
| TB-1 | 7,559,233.10 | 434,565.79 | 43.89 |
| TB-2 | 7,559,224.94 | 434,584.12 | 43.79 |
| TB-3 | 7,559,215.28 | 434,606.74 | 43.62 |
| TB-4 | 7,559,204.75 | 434,631.61 | 43.67 |
| TB-5 | 7,559,181.40 | 434,618.80 | 43.38 |
| TB-6 | 7,559,156.49 | 434,604.32 | 43.03 |
| TB-7 | 7,559,168.31 | 434,580.64 | 43.27 |
| TB-8 | 7,559,178.57 | 434,561.92 | 43.74 |
| TB-9 | 7,559,188.71 | 434,542.57 | 43.83 |
| TB-10 | 7,559,213.44 | 434,555.60 | 43.77 |
| TB-11 | 7,559,228.17 | 434,567.47 | 43.87 |
| TB-12 | 7,559,221.86 | 434,581.85 | 43.69 |
| TB-13 | 7,559,204.04 | 434,573.68 | 43.59 |
| TB-14 | 7,559,182.16 | 434,563.21 | 43.74 |
| TB-15 | 7,559,190.28 | 434,547.67 | 43.84 |
| TB-16 | 7,559,212.37 | 434,559.29 | 43.77 |
| TB-17 | 7,559,221.13 | 434,583.21 | 43.69 |
| TB-18 | 7,559,212.73 | 434,603.30 | 43.62 |
| TB-19 | 7,559,202.73 | 434,626.56 | 43.66 |
| TB-20 | 7,559,182.49 | 434,615.06 | 43.37 |
| TB-21 | 7,559,161.28 | 434,602.74 | 43.05 |
| TB-22 | 7,559,171.87 | 434,581.99 | 43.28 |
| TB-23 | 7,559,181.43 | 434,564.56 | 43.72 |
| TB-24 | 7,559,203.85 | 434,575.29 | 43.59 |
| TB-25 | 7,559,225.00 | 434,568.55 | 42.75 |
| TB-26 | 7,559,220.39 | 434,579.31 | 42.70 |
| TB-27 | 7,559,185.22 | 434,562.73 | 42.64 |
| TB-28 | 7,559,191.59 | 434,551.58 | 42.55 |
| TB-29 | 7,559,218.23 | 434,584.23 | 42.60 |
| TB-30 | 7,559,201.42 | 434,623.14 | 42.51 |
| TB-31 | 7,559,164.24 | 434,601.77 | 42.05 |
| TB-32 | 7,559,182.47 | 434,567.89 | 42.53 |
| TB-33 | 7,559,191.72 | 434,552.66 | 42.50 |
| TB-34 | 7,559,165.19 | 434,601.40 | 42.02 |

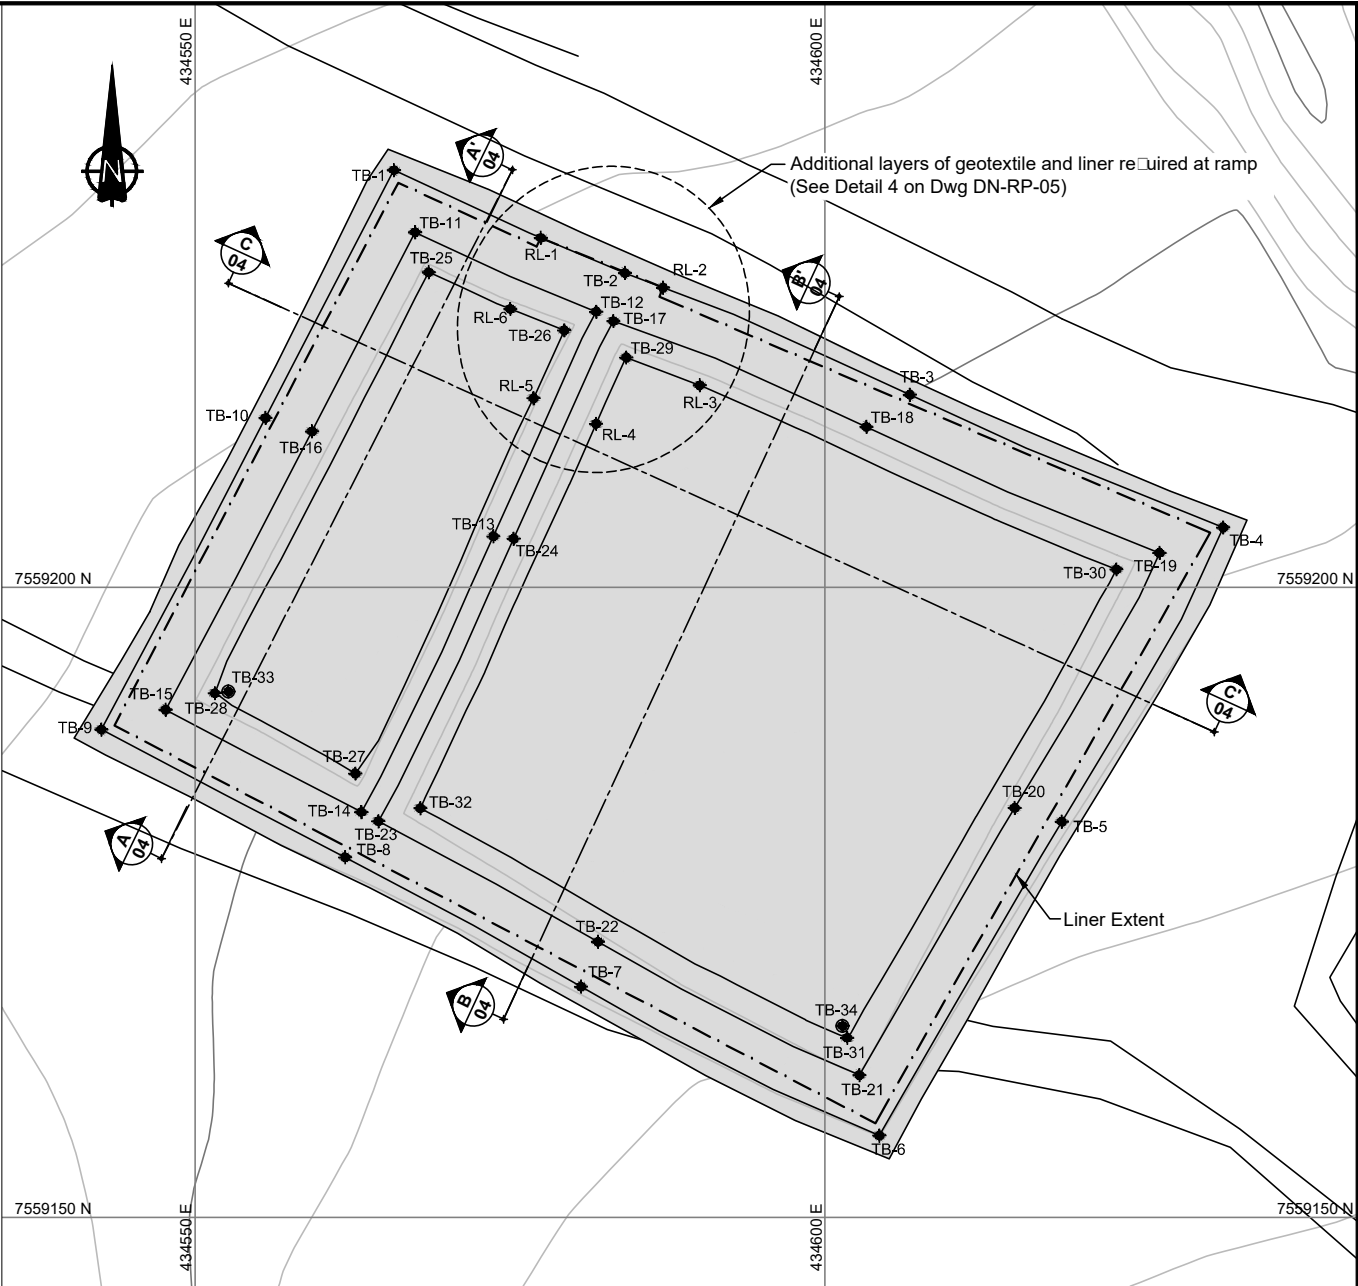

RAMP LINER STAKEOUT POINTS:

| ID | Northing (m) | Easting (m) | Elevation (m) |
|------|--------------|-------------|---------------|
| RL-1 | 7,559,227.73 | 434,577.45 | 43.83 |
| RL-2 | 7,559,223.78 | 434,587.15 | 43.75 |
| RL-3 | 7,559,216.03 | 434,590.07 | 42.58 |
| RL-4 | 7,559,212.98 | 434,581.84 | 42.61 |
| RL-5 | 7,559,215.00 | 434,576.87 | 42.86 |
| RL-6 | 7,559,222.10 | 434,575.03 | 42.73 |

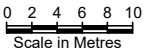TOP OF BEDDING MATERIAL/LINER




- NOTES**
- The co-ordinate system is TM NAD 83, Zone 13.
 - All dimensions are in metric units, unless specifically mentioned.

C:\JL SITE\Hope Bay\Des North\North Dam Reagent\Prod\CT022.005-DN-RP-01-03.dwg

| | | | | | | | | | | | | | | |
|--|--|--|--|--|--|--|--|--|--|--|--|--|--|--|
| | | | | | | | | | | | | | | |
| | | | | | | | | | | | | | | |
PROFESSIONAL ENGINEERS STAMP




| | | | | | |
|---------------------------------------|-----|-----------|-----|-----------|---------------|
| DESIGN: | MMM | DRAWN: | NV | REVIEWED: | MMM |
| CHECKED: | MMM | APPROVED: | EMR | DATE: | Oct. 13, 2016 |
| FILE NAME: 1CT022.005-DN-RP-01-03.dwg | | | | | |

| | |
|-----------------------------|--|
| | |
| DORIS NORTH PROJECT | |
| SRK JOB NO.: 1CH022.005.300 | |

| | | |
|--|--------|--------------|
| North Dam Reagent Pad | | |
| DRAWING TITLE: | | |
| Reagent Pad Berms and Top of Bedding Material/Liner Plan Views | | |
| DRAWING NO. | SHEET | REVISION NO. |
| DN-RP-02 | 3 of 6 | A |

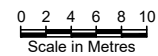


| ID | Northing (m) | Easting (m) | Elevation (m) |
|-------|--------------|-------------|---------------|
| PF-1 | 7,559,227.05 | 434,567.70 | 43.68 |
| PF-2 | 7,559,221.59 | 434,581.23 | 43.64 |
| PF-3 | 7,559,183.49 | 434,562.89 | 43.42 |
| PF-4 | 7,559,190.93 | 434,549.40 | 43.45 |
| PF-5 | 7,559,220.42 | 434,583.67 | 43.61 |
| PF-6 | 7,559,210.83 | 434,606.00 | 43.50 |
| PF-7 | 7,559,202.44 | 434,625.58 | 43.52 |
| PF-8 | 7,559,161.98 | 434,602.53 | 43.05 |
| PF-9 | 7,559,172.30 | 434,582.29 | 43.20 |
| PF-10 | 7,559,181.76 | 434,565.62 | 43.48 |
| PF-11 | 7,559,191.72 | 434,552.66 | 43.40 |
| PF-12 | 7,559,165.19 | 434,601.40 | 42.95 |

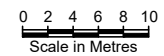


SHEET
2 of 6

LEGEND

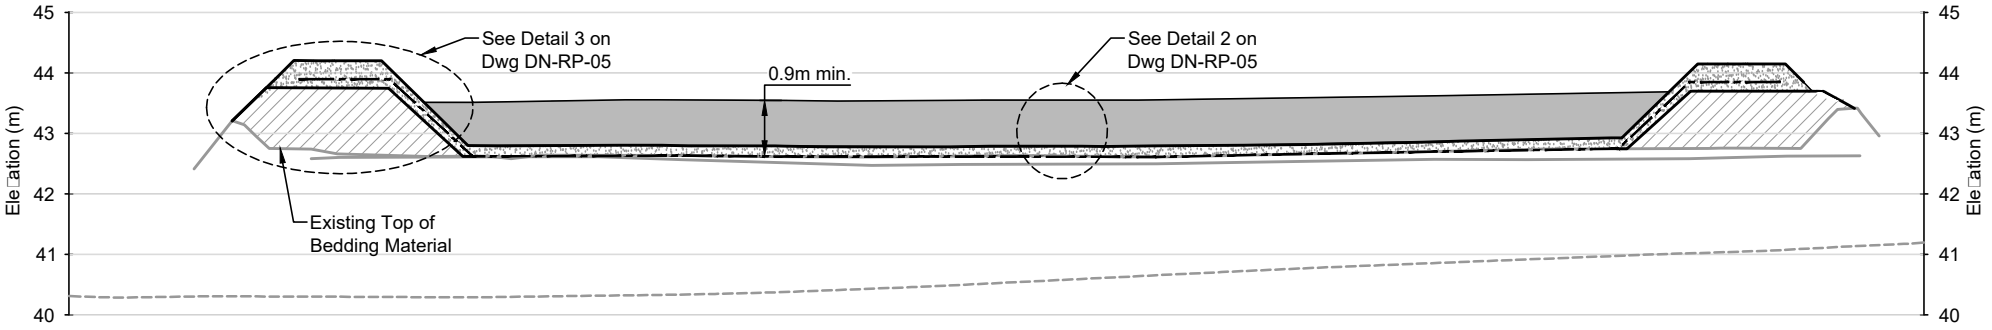
- Surfacing Material
- Bedding Material
- Transition Material
- HDPE Liner
- Reagent Pad Design
- Existing Ground
- Original Ground



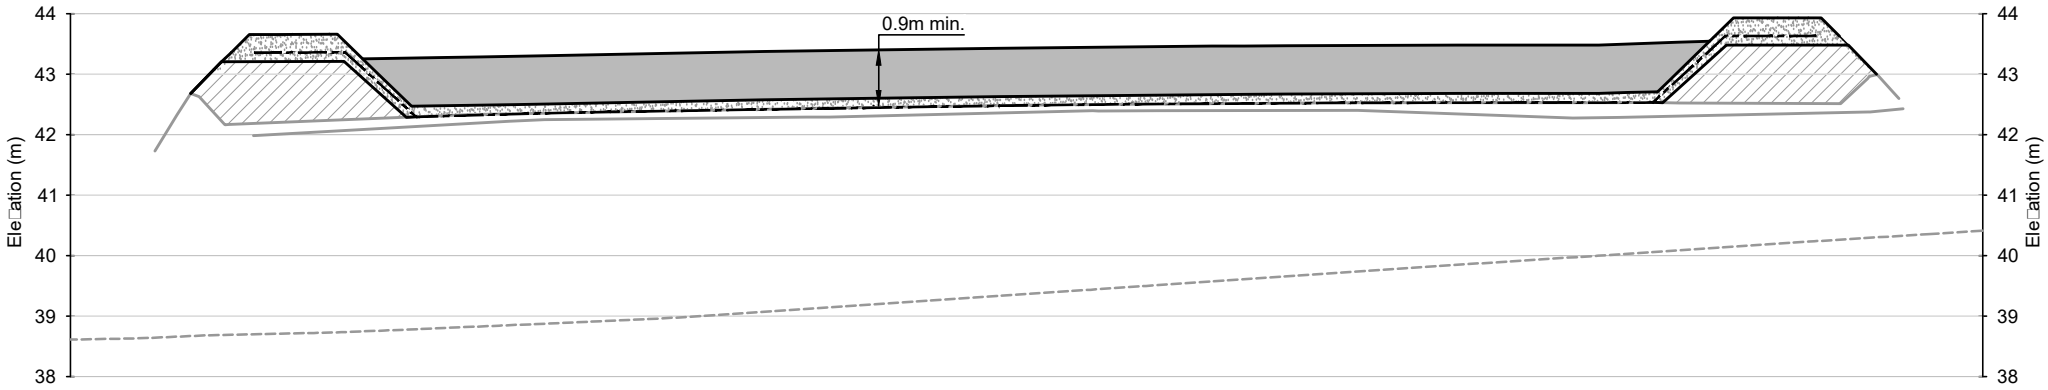A
02
SECTION A
0 1 2 3 4 5
Horizontal Scale in Metres
Vertical Exaggeration 2X



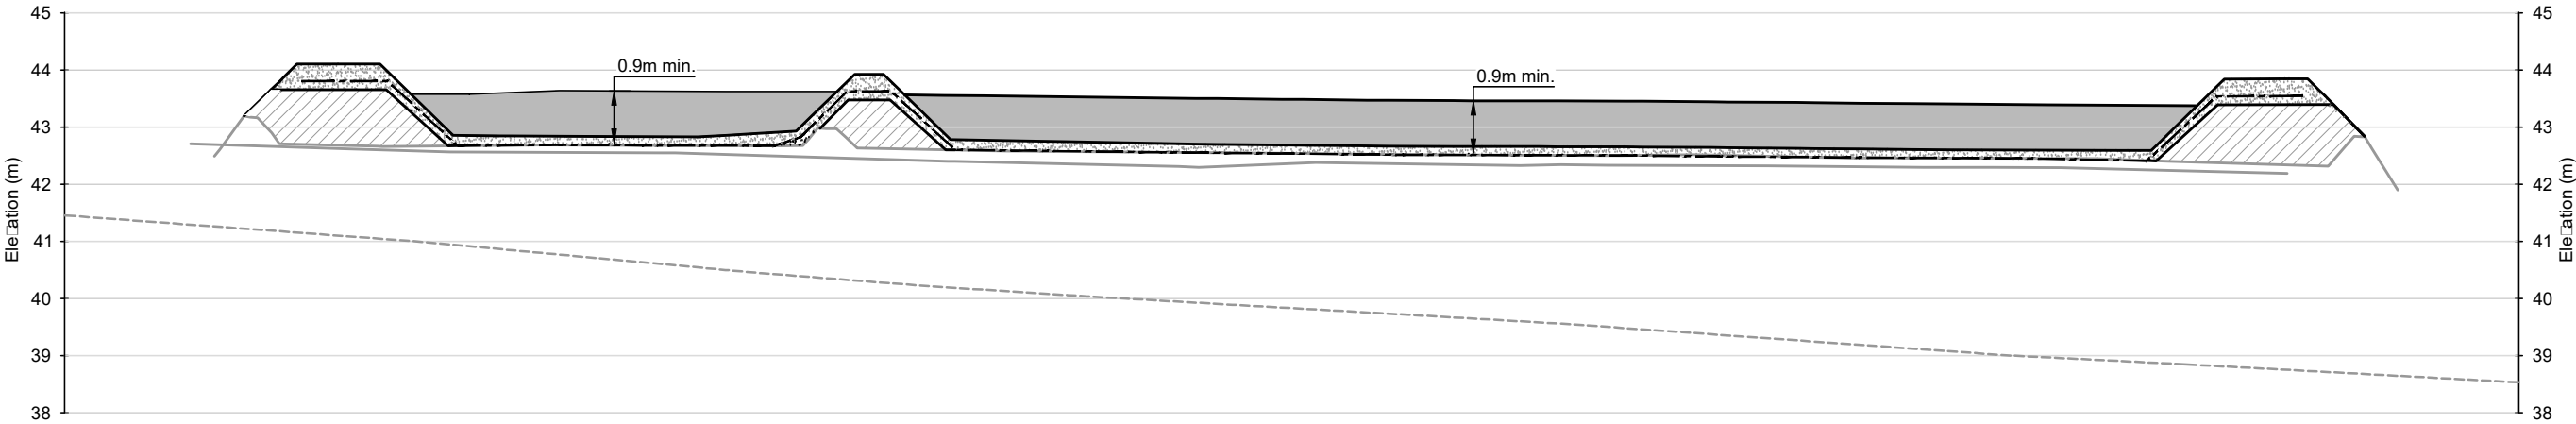B
02
SECTION B
0 1 2 3 4 5
Horizontal Scale in Metres
Vertical Exaggeration 2X



C
02
SECTION C
0 1 2 3 4 5
Horizontal Scale in Metres
Vertical Exaggeration 2X


C:\01 - SITE\Shope Bay\Doris North\North Dam Reagent Pad\1CT022.005-DN-RP-01-03.dwg

| | | | | | | | | | | | | | |
|--|--|--|--|--|--|--|--|--|--|--|-----------------------|--|--|
| | | | | | | | | | | | North Dam Reagent Pad | | |
| | | | | | | | | | | | DRAWING TITLE: | | |
| | | | | | | | | | | | Sections | | |
| | | | | | | | | | | | DRAWING NO. | | |
| | | | | | | | | | | | DN-RP-04 | | |
| | | | | | | | | | | | SHEET | | |
| | | | | | | | | | | | 5 of 6 | | |
| | | | | | | | | | | | REVISION NO. | | |
| | | | | | | | | | | | A | | |


| | | | | | | | | |
|--------------------|---------------|-------------|---------------|-----------|-----------------------|-------|-------|---------|
| DRAWING NO. | DRAWING TITLE | DRAWING NO. | DRAWING TITLE | A | ISSUED FOR DISCUSSION | MMM | EMR | 13oct16 |
| | | | | NO. | DESCRIPTION | CHK'D | APP'D | DATE |
| REFERENCE DRAWINGS | | | | REVISIONS | | | | |

| | | | | | |
|------------------------------|--|---------------------------------------|--|-----------------------------|--|
| PROFESSIONAL ENGINEERS STAMP | | FILE NAME: 1CT022.005-DN-RP-01-03.dwg | | SRK JOB NO.: 1CH022.005.300 | |
|------------------------------|--|---------------------------------------|--|-----------------------------|--|


| | | | | | |
|----------------|---------------|---------------------|---------------------|--|--|
| srk consulting | | | TMAC RESOURCES | | |
| DESIGN: MMM | DRAWN: NV | REVIEWED: MMM | DORIS NORTH PROJECT | | |
| CHECKED: MMM | APPROVED: EMR | DATE: Oct. 13, 2016 | | | |

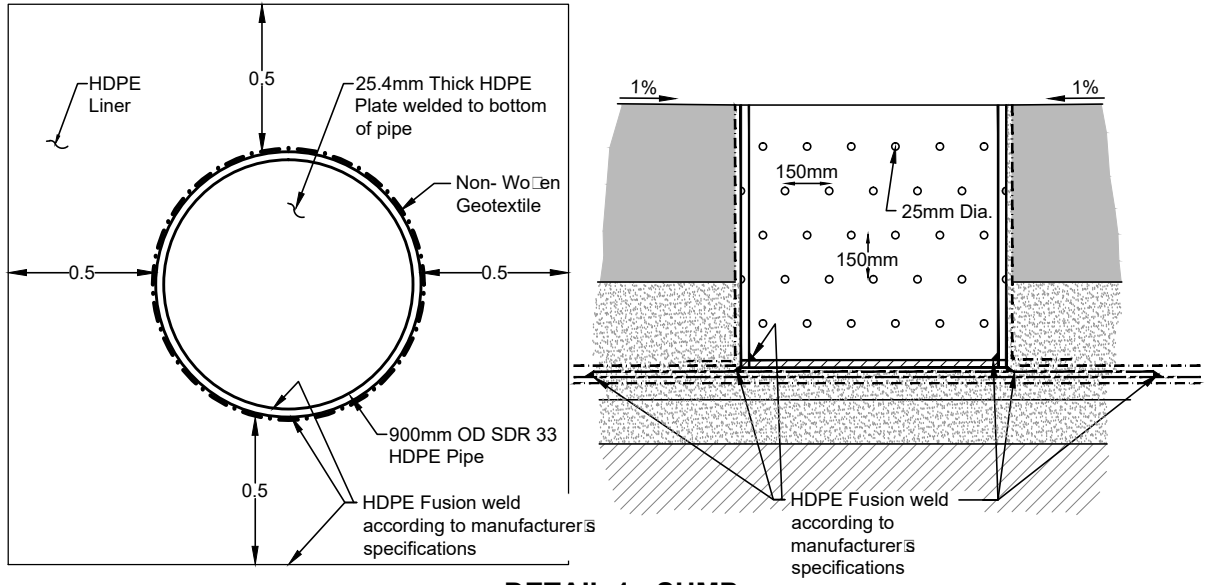


DETAIL 1 - SUMP
NTS

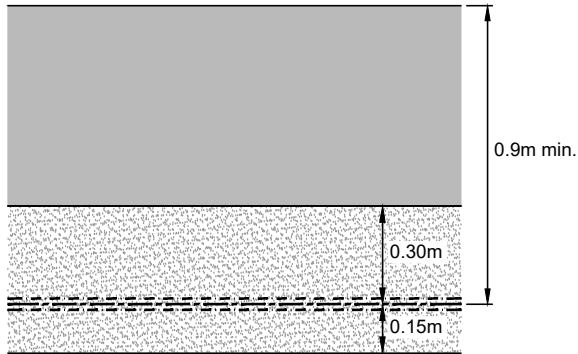

DETAIL 2
TYPICAL LINER SYSTEM
NTS

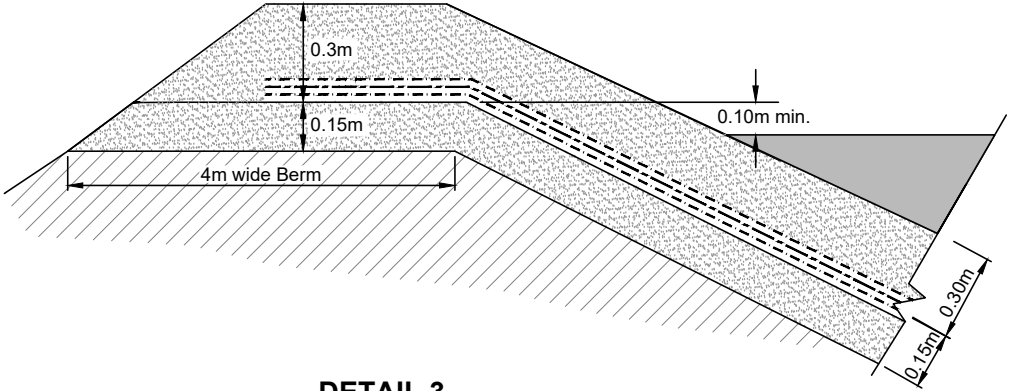

DETAIL 3
TYPICAL LINER SYSTEM AT CONTAINMENT BERM
NTS

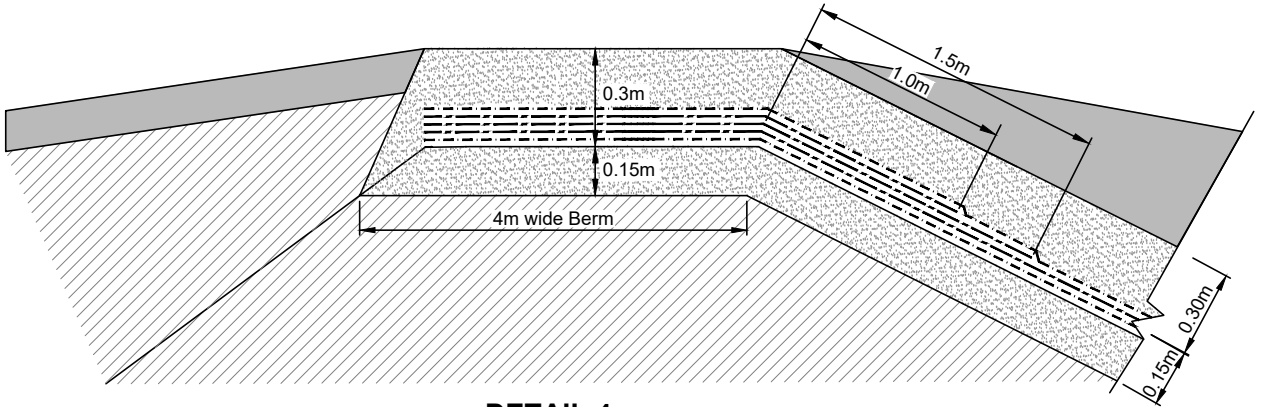



DETAIL 4
TYPICAL LINER SYSTEM AT ACCESS RAMP
NTS

LEGEND

- Surfacing Material
- Bedding Material
- Transition Material
- Run of Quarry Material
- Rip Rap
- Non-woven Geotextile (385g/m²)
- 60 mil HDPE Liner

C:\01 - SITE\Hope Bay\Des North\North Dam Reagent Pad\1CT022.005-DN-RP-01-03.dwg

| |
|---|
| | | | | | | | | | |  | | |  | | North Dam Reagent Pad | |
| | | | | | | | | | | | | | | | DRAWING TITLE: | |
| | | | | | | | | | | | | | Details | |
| | | | | | | | | | | DESIGN: MMM | | | DRAWN: NV | | REVIEWED: MMM | | DORIS NORTH PROJECT | |
| | | | | | | | | | | CHECKED: MMM | | | APPROVED: EMR | | DATE: Oct. 13, 2016 | |
| DRAWING NO. | | | | | | | | | | DRAWING TITLE | | | | | | | | | | DRAWING NO. | | | | | | | | | | DRAWING TITLE | | | | | | | | | | A | | | | | | | | | | ISSUED FOR DISCUSSION | | | | | | | | | | MMM | | | | | | | | | | EMR | | | | | | | | | | 13oct16 | |
| |


Engineering Drawings for the Doris North Airstrip Expansion, Doris North Project, Nunavut, Canada

ACTIVE DRAWING STATUS

| DWG NUMBER | DRAWING TITLE | REVISION | DATE | STATUS | PREVIOUS REVISION HISTORY | | | |
|------------|---|----------|---------------|----------------------|---------------------------|-----------------------|-----------------------|-----------------------|
| DN-AE-00 | Engineering Drawings for the Doris North Airstrip Expansion, Doris North Project, Nunavut, Canada | 5 | Oct. 7, 2016 | South Apron Updates | Rev. 4, Oct. 4, 2016 | Rev. 3, June 24, 2016 | Rev. 2, Feb. 10, 2016 | Rev. 1, Oct. 22, 2015 |
| DN-AE-01 | General Arrangement | 5 | Oct. 7, 2016 | South Apron Updates | Rev. 4, Oct. 4, 2016 | Rev. 3, June 24, 2016 | Rev. 2, Feb. 10, 2016 | Rev. 1, Oct. 22, 2015 |
| DN-AE-02 | Airstrip Expansion - Plan and Centerline Profile | 5 | Oct. 7, 2016 | South Apron Updates | Rev. 4, Oct. 4, 2016 | Rev. 3, June 24, 2016 | Rev. 2, Feb. 10, 2016 | Rev. 1, Oct. 22, 2015 |
| DN-AE-03 | Airstrip Expansion - Sections | 1 | Oct. 22, 2015 | Runway Crowned | Rev. 0, Oct. 19, 2015 | Rev. A, Oct. 14, 2015 | | |
| DN-AE-04 | Obstacle Limitation Surfaces | 3 | June 24, 2016 | South Apron Addition | Rev. 2, Feb. 10, 2016 | Rev. 1, Oct. 22, 2015 | | |
| DN-AE-05 | Airstrip Expansion South Apron - Plan, Sections and Details | 2 | Oct. 7, 2016 | South Apron Updates | Rev. 1, Oct. 4, 2016 | Rev. 0, June 24, 2016 | | |
| DN-AE-06 | Airstrip Expansion South Apron Stakeout Point Plans | 2 | Oct. 7, 2016 | South Apron Updates | Rev. 1, Oct. 4, 2016 | Rev. 0, June 24, 2016 | | |
| DN-AE-07 | Airstrip Expansion South Apron Final Layout and Stakeout Points | 1 | Oct. 7, 2016 | South Apron Updates | Rev. 0, Oct. 4, 2016 | | | |



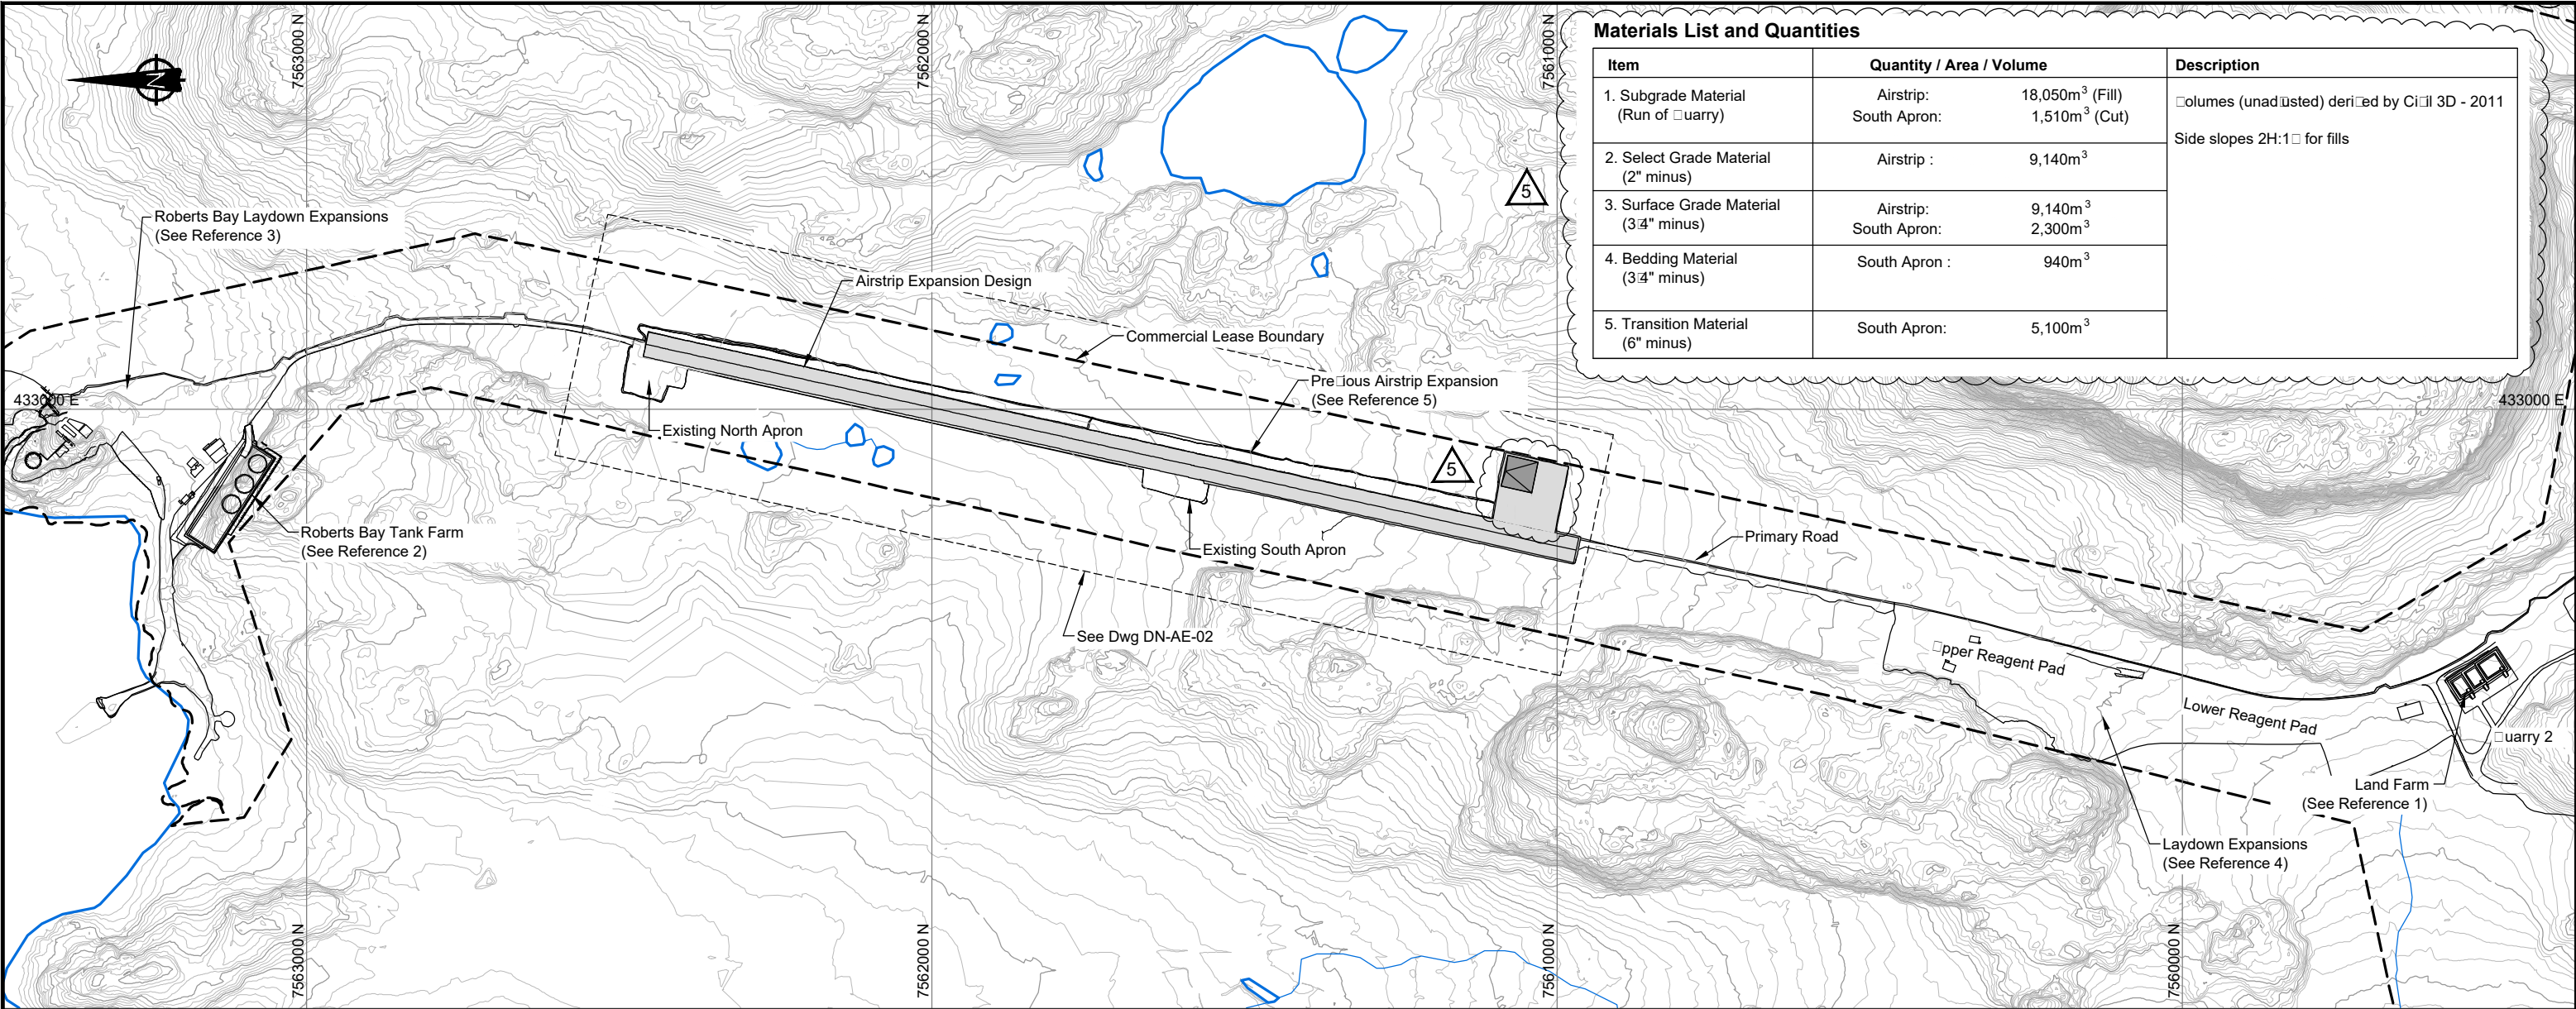PROJECT NO: 1CT022.005.300
Revision 5
October 7, 2016
Drawing DN-AE-00



Materials List and Quantities

| Item | Quantity / Area / Volume | | Description |
|---|---------------------------|--|--|
| 1. Subgrade Material (Run of Quarry) | Airstrip: South Apron: | 18,050m ³ (Fill) 1,510m ³ (Cut) | Volumes (unadjusted) derived by Civil 3D - 2011 Side slopes 2H:1V for fills |
| 2. Select Grade Material (2" minus) | Airstrip : | 9,140m ³ | |
| 3. Surface Grade Material (3/4" minus) | Airstrip: South Apron: | 9,140m ³ 2,300m ³ | |
| 4. Bedding Material (3/4" minus) | South Apron : | 940m ³ | |
| 5. Transition Material (6" minus) | South Apron: | 5,100m ³ | |

NOTES

1. The designs are based on the contour information shown on these drawings. It is however the Contractor's responsibility to confirm that the contours are a fair reflection of the ground levels in the vicinity of the works, and to advise the Construction Manager and Engineer of any differences.

2. The co-ordinate system is NAD 83, Zone 13.

3. All dimensions are in metric units, unless specifically mentioned.

4. All drawings are scaled appropriately for D-Scale construction drawings. Scales may not be correct if these drawings are reproduced and presented in any other size format.

5. The Engineer will provide the Construction Manager and Contractor with digital design files for setting out the works.

6. The Contractor and Construction Manager shall familiarize themselves with all appropriate Licenses and/or Permits pertaining to execution of the Works. The Engineer will not be responsible for any infringements.

7. The Contractor is to take due care that no wildlife or birds' nest are disturbed during construction. The Construction Manager is to be immediately notified if such sites are found.

8. The Contractor will employ best practices to identify archaeological sites, and maintain archaeological site exclusion boundaries of 30m minimum radius from any of these works.

9. These works must be executed in accordance with the standard TMAC health and safety, and environmental standards and protocols. It is the Contractors responsibility to familiarize himself with these documents.
10. Construction shall be in accordance with the following Technical Specifications: Earthworks and Geotechnical Engineering, Hope Bay project, Nunavut, Canada, revision G -Issue for Construction.

11. The airstrip expansion alignment and dimensions were provided by TMAC are as follows:
 - The Airstrip will have a total length of 5,000 feet (1,524 m) starting at the north end of the existing airstrip.
 - Airstrip will have a total width of 131 feet (40 m) with the west shoulder remaining unchanged from the existing airstrip.
 - The Airstrip will have a minimum fill thickness of 1 m
 - The Airstrip will not be crowned but will be graded at 2% from east to west
 - The Airstrip shoulders will have side slopes of 2H:1V
 - The North Apron remains unchanged
 - The Airstrip will be constructed using Run of Quarry as subgrade material, 2 inch (51 mm) minus as Select Grade Material, and ¾ inch (19 mm) minus as Surfacing Grade Material

12. Notes in this drawing apply to all other active drawings.

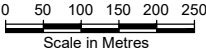
REFERENCES

1. SRK Consulting (Canada) Inc., 2012. Engineering Drawings for the Doris North Land Farm, Doris North Project, Nunavut, Canada. Revision AB. As-Built Drawings Prepared for Hope Bay Mining Limited. Project Number 1CH008.033.058. April 20, 2012
2. SRK Consulting (Canada) Inc., 2012. Engineering Drawings for the Roberts Bay Fuel Tank Farm, Doris North Project, Nunavut, Canada. Revision AB. As-Built Drawings Prepared for Hope Bay Mining Limited. Project Number 1CH008.033. April 18, 2012
3. SRK Consulting (Canada) Inc., 2011. Engineering Drawings for the Roberts Bay Laydown Area, Doris North Project, Nunavut, Canada. Revision AB. As-Built Drawings Prepared for Hope Bay Mining Limited. Project Number 1CH008.027.033, December 16, 2011
4. SRK Consulting (Canada) Inc., 2011. Engineering Drawings for the Laydown Expansions, Doris North Project, Nunavut, Canada. Revision AB. As-Built Drawings Prepared for Hope Bay Mining Limited. Project Number 1CH008.027, December 16, 2011
5. SRK Consulting (Canada) Inc., 2011. Engineering Drawings for the Airstrip Expansion Bypass Road, Doris North Project, Nunavut, Canada. Revision D. Issued for Review Drawings Prepared for Hope Bay Mining Limited. Project Number 1CH008.033, July 26, 2011



LEGEND


- Proposed Airstrip Expansion
- Lease Boundary
- 0+000

Chainage
- Existing Roads and Infrastructure
- Lakes, Ponds or Permanent Water Bodies





C:\01_ SITE\Hope Bay\Doris North\Airstrip Expansion\1CT022.005.300_ND-AE-01-05 Rev5.dwg


| | | | | | | | | | | | | | | |
|--------------------|---------------|-------------|---------------|-----|-------------------------|-------|-------|---------|---|---|-----------------------------|----------------------|-----------|---------------|
| | | | | 5 | SOUTH APRON UPDATES | MMM | EMR | 7Oct16 |  |  | Airstrip Expansion | | | |
| | | | | 4 | SOUTH APRON UPDATES | MMM | EMR | 4Oct16 | | | DRAWING TITLE: | | | |
| | | | | 3 | SOUTH APRON ADDITION | KK | EMR | 24Jun16 | | | General Arrangement | | | |
| | | | | 2 | RUNWAY EXTENDED | EMR | EMR | 10Feb16 | | | | | | |
| | | | | 1 | RUNWAY CROWNED | LW | EMR | 22Oct15 | | | | | | |
| | | | | 0 | ISSUED FOR CONSTRUCTION | LW | EMR | 19Oct15 | | | | | | |
| | | | | A | ISSUED FOR DISCUSSION | LW | EMR | 17Oct15 | DORIS NORTH PROJECT | | | | | |
| DRAWING NO. | DRAWING TITLE | DRAWING NO. | DRAWING TITLE | NO. | DESCRIPTION | CHK'D | APP'D | DATE | | | | DESIGN: TMAC | DRAWN: NV | REVIEWED: EMR |
| | | | | | | | | | CHECKED: EMR | APPROVED: EMR | DATE: Oct. 7, 2016 | | | |
| REFERENCE DRAWINGS | | | | | REVISIONS | | | | PROFESSIONAL ENGINEERS STAMP | FILE NAME: 1CT022.005.300_ND-AE-01-05 Rev5.dwg | SRK JOB NO.: 1CH022.005.300 | DRAWING NO. DN-AE-01 | | |
| | | | | | | | | | | | | SHEET 2 OF 7 | | |
| | | | | | | | | | | | | REVISION NO. 5 | | |

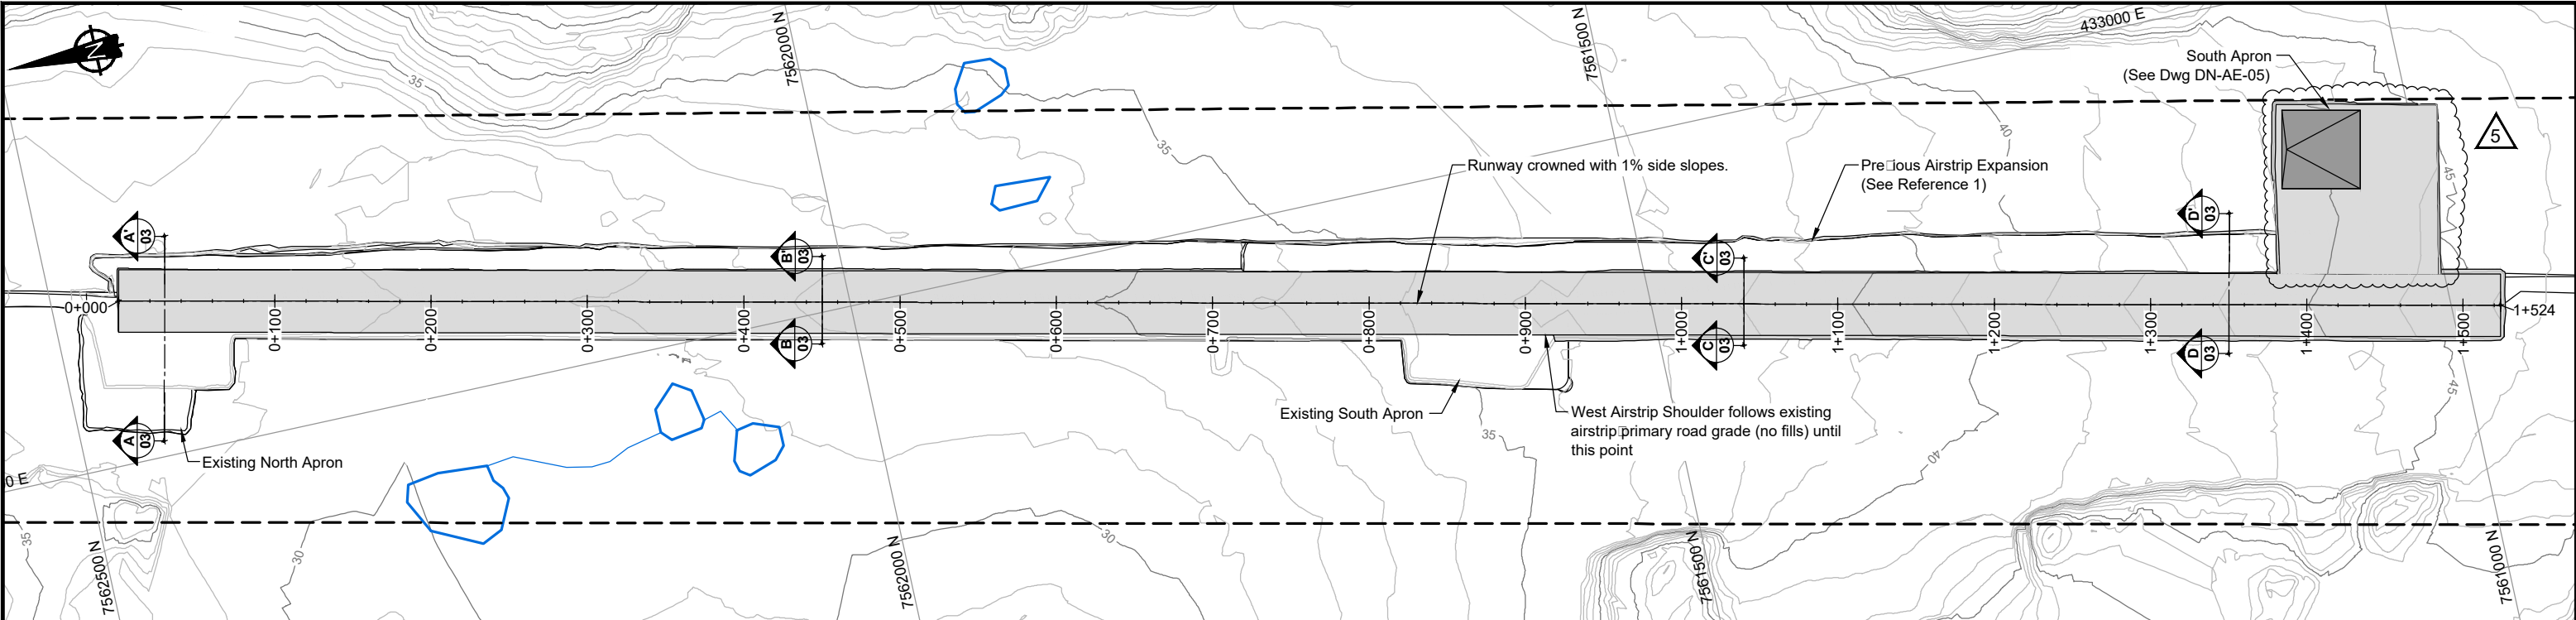

AIRSTRIp EXPANSION - PLAN

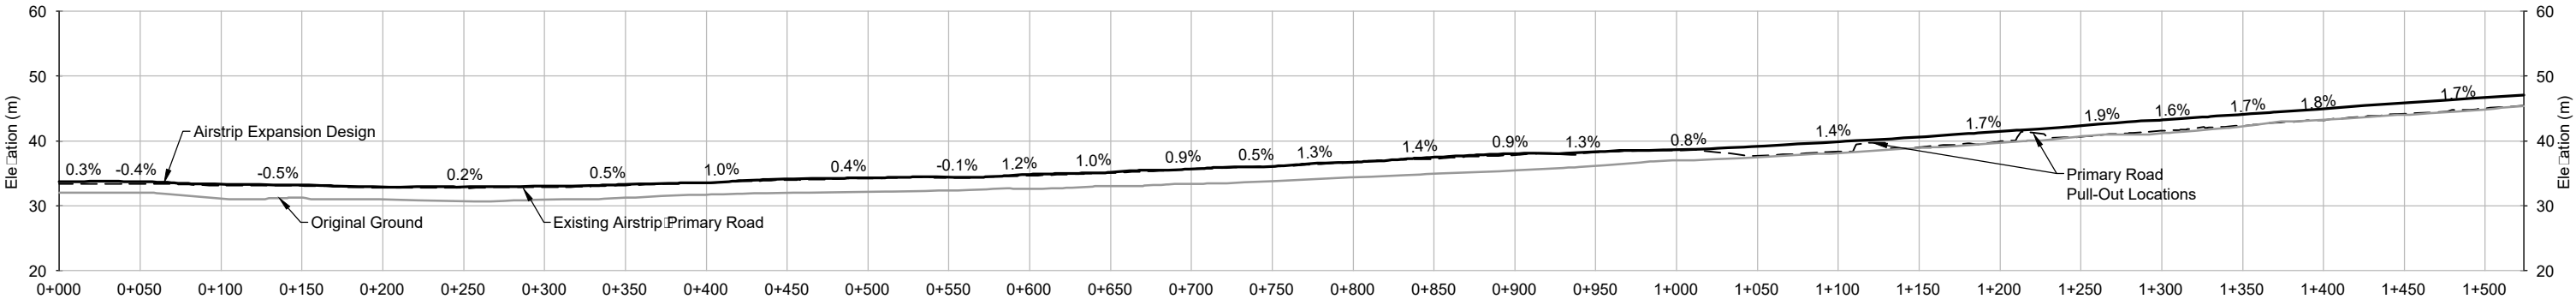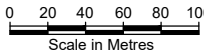

AIRSTRIp EXPANSION - CENTERLINE PROFILE

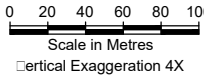

LEGEND

Proposed Airstrip Expansion

Lease Boundary

0+000

Chainage

Existing Roads and Infrastructure

Lakes, Ponds or Permanent Water Bodies

REFERENCE

1. SRK Consulting (Canada) Inc., 2011. Engineering Drawings for the Doris North Airstrip Expansion, Bypass Road, Doris North Project, Nunavut, Canada. Revision D. Issued for Reference Drawings. Prepared for Hope Bay Mining Limited. Project Number 1CH008.033. July 26, 2011.

AIRSTRIp EXPANSION STAKEOUT TABLE:

| Chainage (m) | Northing (m) | Easting (m) | Elevation (m) |
|--------------|--------------|-------------|---------------|
| 0+000 | 7,562,457.10 | 433,103.50 | 33.70 |
| 0+050 | 7,562,408.30 | 433,092.70 | 33.70 |
| 0+100 | 7,562,359.50 | 433,081.90 | 33.30 |
| 0+150 | 7,562,310.70 | 433,071.10 | 33.20 |
| 0+200 | 7,562,261.80 | 433,060.30 | 32.90 |
| 0+250 | 7,562,213.00 | 433,049.40 | 32.90 |
| 0+300 | 7,562,164.20 | 433,038.60 | 33.00 |
| 0+350 | 7,562,115.40 | 433,027.80 | 33.30 |
| 0+400 | 7,562,066.60 | 433,017.00 | 33.60 |
| 0+450 | 7,562,017.70 | 433,006.20 | 34.20 |
| 0+500 | 7,561,968.90 | 432,995.40 | 34.30 |
| 0+550 | 7,561,920.10 | 432,984.60 | 34.40 |
| 0+600 | 7,561,871.30 | 432,973.80 | 34.80 |
| 0+650 | 7,561,822.50 | 432,963.00 | 35.20 |
| 0+700 | 7,561,773.60 | 432,952.20 | 35.70 |
| 0+750 | 7,561,724.80 | 432,941.40 | 36.10 |

| | | | |
|-------|--------------|------------|-------|
| 0+800 | 7,561,676.00 | 432,930.60 | 36.70 |
| 0+850 | 7,561,627.20 | 432,919.80 | 37.50 |
| 0+900 | 7,561,578.40 | 432,909.00 | 38.10 |
| 0+950 | 7,561,529.60 | 432,898.20 | 38.30 |
| 1+000 | 7,561,480.70 | 432,887.40 | 38.60 |
| 1+050 | 7,561,431.90 | 432,876.60 | 39.20 |
| 1+100 | 7,561,383.10 | 432,865.80 | 39.90 |
| 1+150 | 7,561,334.30 | 432,855.00 | 40.60 |
| 1+200 | 7,561,285.50 | 432,844.10 | 41.50 |
| 1+250 | 7,561,236.60 | 432,833.30 | 42.40 |
| 1+300 | 7,561,187.80 | 432,822.50 | 43.30 |
| 1+350 | 7,561,139.00 | 432,811.70 | 44.10 |
| 1+400 | 7,561,090.20 | 432,800.90 | 45.00 |
| 1+450 | 7,561,041.40 | 432,790.10 | 45.90 |
| 1+500 | 7,560,992.60 | 432,779.30 | 46.70 |
| 1+524 | 7,560,969.10 | 432,774.10 | 47.10 |

C:\01_ SITE\Hope Bay\Doris North\Airstrip Expansion\1CT022.005.300_ND-AE-01-05 Rev5.dwg

DRAWING NO.

DRAWING TITLE

DRAWING NO.

DRAWING TITLE

REFERENCE DRAWINGS

5 SOUTH APRON UPDATES

4 SOUTH APRON UPDATES

3 SOUTH APRON ADDITION

2 RUNWAY EXTENDED

1 RUNWAY CROWNED

0 ISSUED FOR CONSTRUCTION

A ISSUED FOR DISCUSSION

NO.

DESCRIPTION

CHK'D

APP'D

DATE

REVISIONS

PROFESSIONAL ENGINEERS STAMP

srk consulting

DESIGN: TMAC

CHECKED: EMR

FILE NAME: 1CT022.005.300_ND-AE-01-05 Rev5.dwg

DRAWN: NV

APPROVED: EMR

REVIEWED: EMR

DATE: Oct. 7, 2016

TMAC RESOURCES

DORIS NORTH PROJECT

SRK JOB NO.: 1CH022.005.300

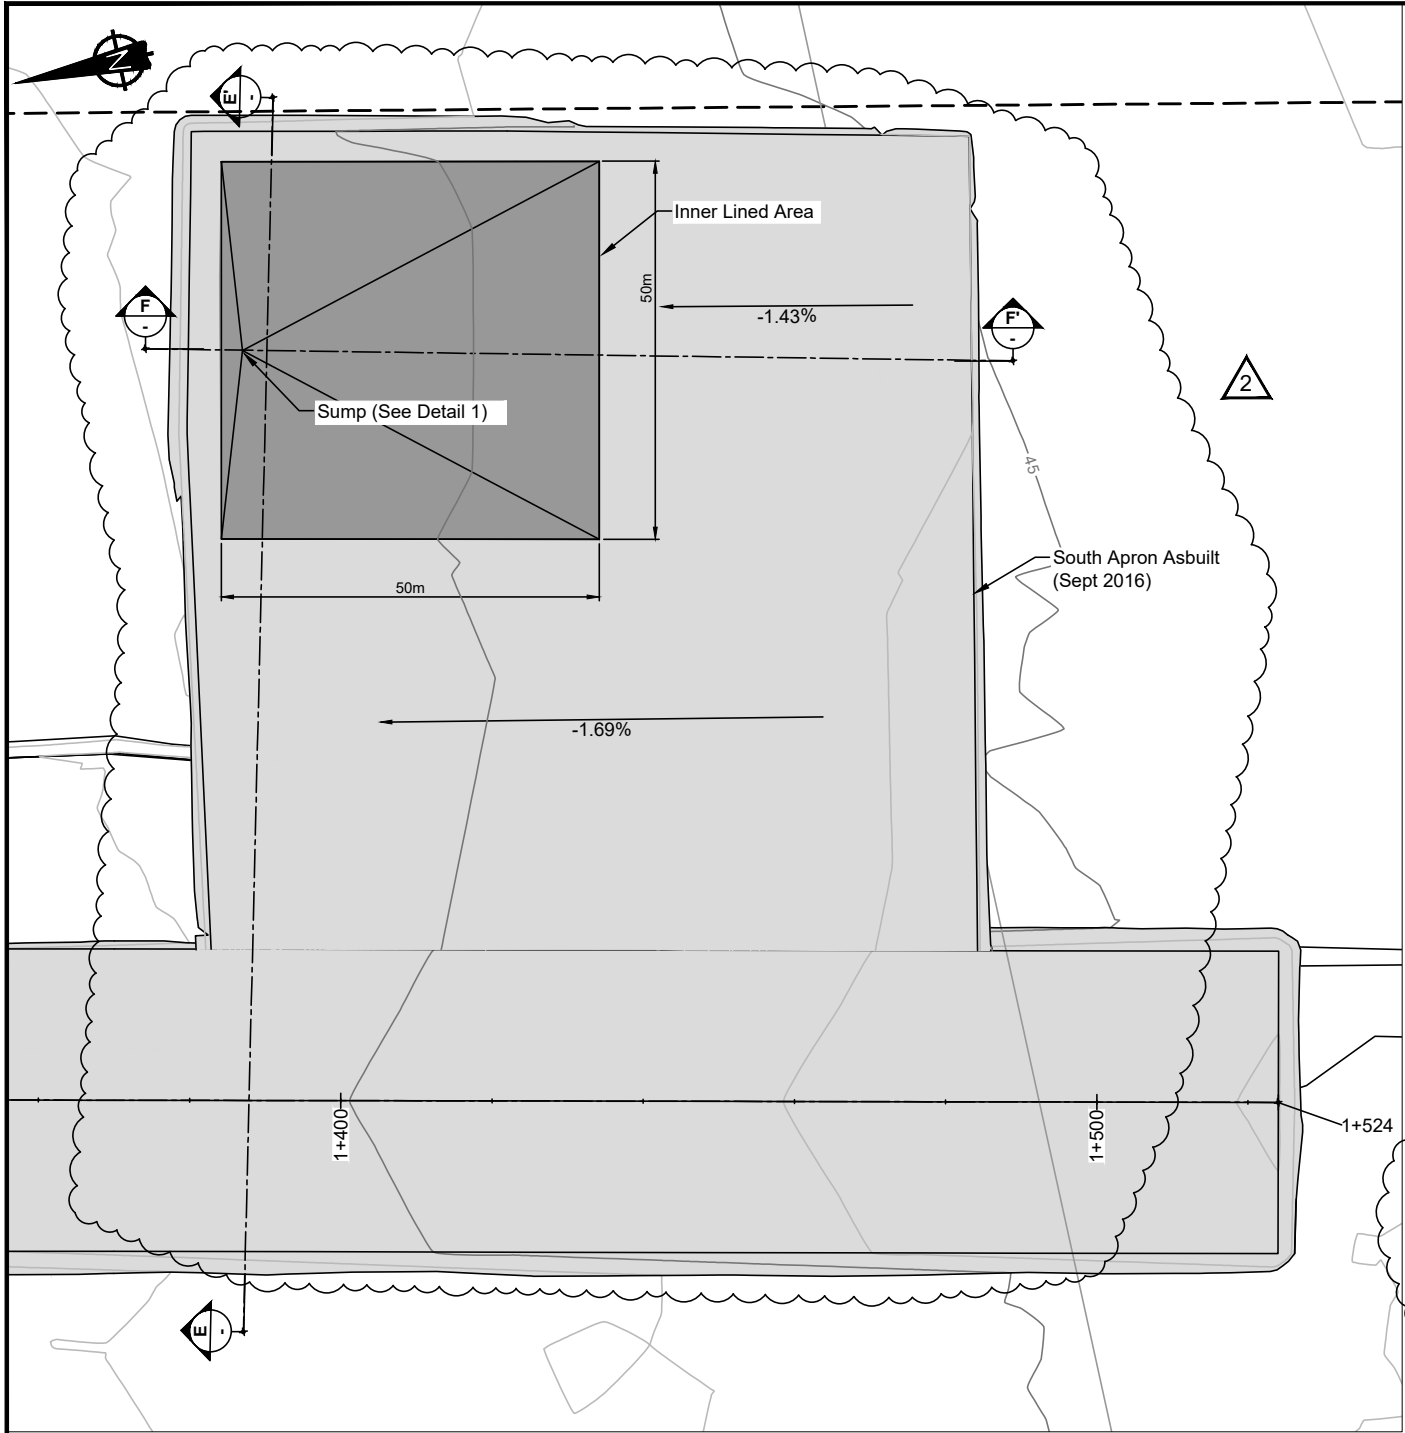
Airstrip Expansion

DRAWING TITLE: Airstrip Expansion - Plan and Centerline Profile


DRAWING NO. DN-AE-02

SHEET 3 OF 7

REVISION NO. 5




AIRSTRIP EXPANSION - PLAN

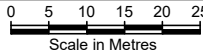


PLAN VIEW LEGEND

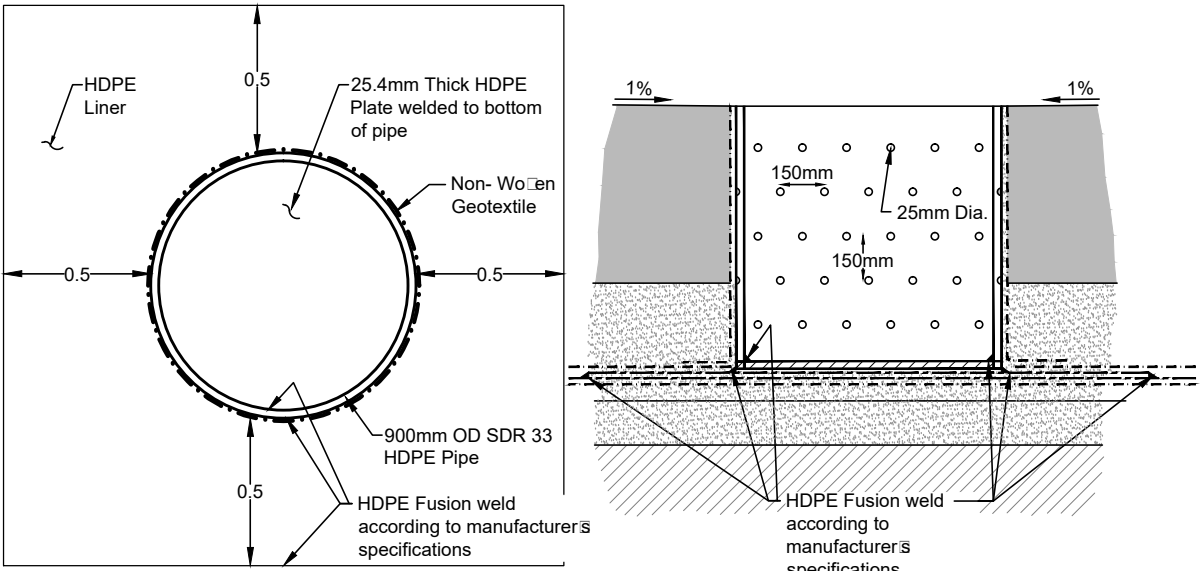- Proposed Airstrip Expansion
- Lease Boundary
- 0+000 Chainage
- Existing Roads and Infrastructure
- Lakes, Ponds or Permanent Water Bodies




DETAIL 1 - SUMP

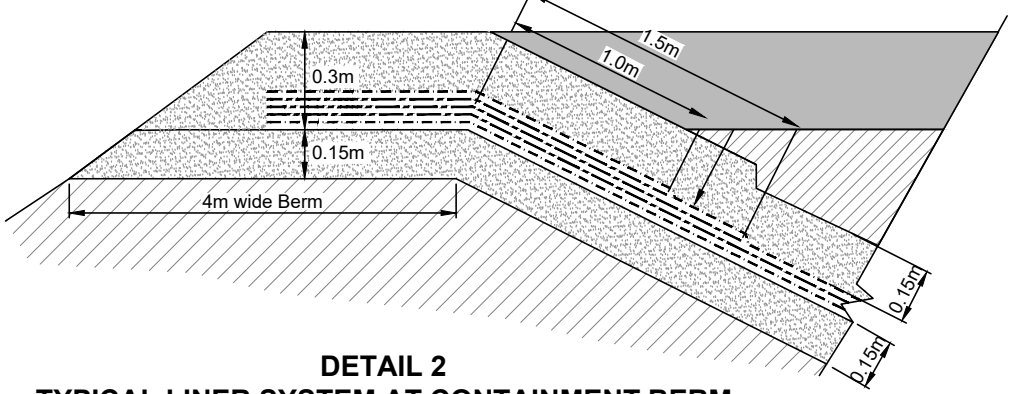NTS




DETAIL 2
TYPICAL LINER SYSTEM AT CONTAINMENT BERM

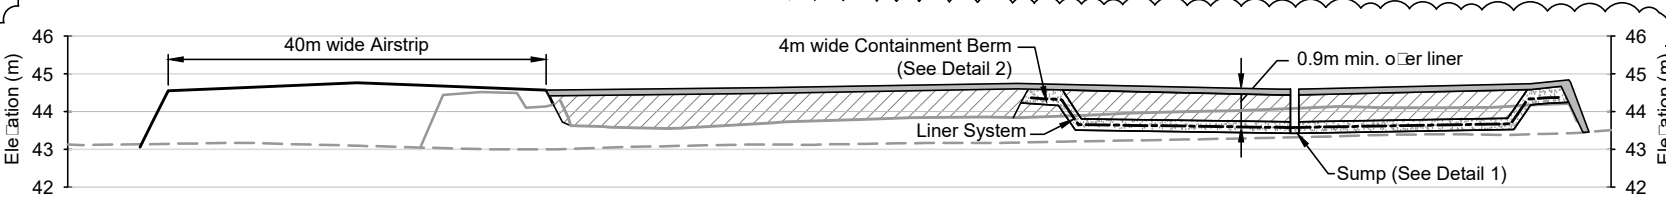NTS




SECTION E
AIRSTRIP EXPANSION & SOUTH APRON

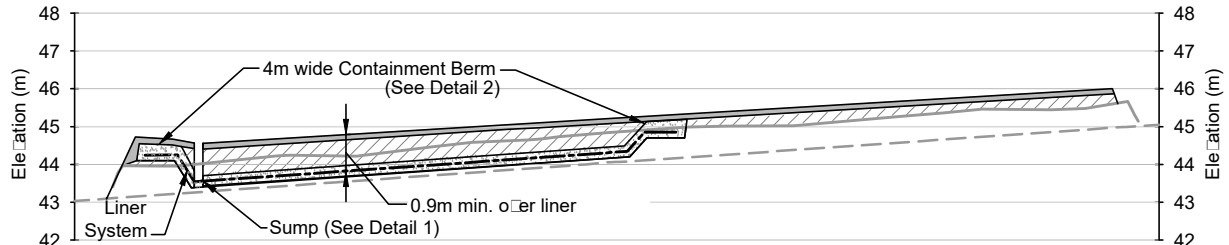E
-



SECTION F
SOUTH APRON

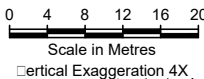F
-



SECTION LEGEND

- Surfacing Material
- Bedding Material
- Transition Material
- Run of Quarry Material
- Rip Rap
- Non-woven Geotextile
- HDPE Liner
- Airstrip Apron Design
- Existing Ground
- Original Ground

C:\01 - SITE\Shore Bay\Des North\Airstrip Expansion\1CT022.005.300_ND-AE-01-05 Rev5.dwg

| DRAWING NO. | DRAWING TITLE | DRAWING NO. | DRAWING TITLE | NO. | DESCRIPTION | CHK'D | APP'D | DATE |
|--------------------|---------------|-------------|---------------|-----|----------------------|-------|-------|---------|
| | | | | 2 | SOUTH APRON UPDATES | MMM | EMR | 7Oct16 |
| | | | | 1 | SOUTH APRON UPDATES | MMM | EMR | 4Oct16 |
| | | | | 0 | SOUTH APRON ADDITION | KK | EMR | 24Jun16 |
| REFERENCE DRAWINGS | | | | | REVISIONS | | | |

srk consulting

DESIGN: TMAC

DRAWN: NV

REVIEWED: EMR

CHECKED: EMR

APPROVED: EMR

DATE: Oct. 7, 2016

FILE NAME: 1CT022.005.300_ND-AE-01-05 Rev5.dwg

TMAC RESOURCES

DORIS NORTH PROJECT

SRK JOB NO.: 1CH022.005.300

Airstrip Expansion

DRAWING TITLE: Airstrip Expansion South Apron Plan, Sections and Details

DRAWING NO. DN-AE-05

SHEET 6 OF 7

REVISION NO. 2

