

Memo

To:	Oliver Curran, VP Environmental Affairs	Client:	TMAC Resources Inc.
From:	Ryan Williams, Senior Consultant, PEng	Project No:	1CT022.055
Reviewed By:	Cameron Hore, Senior Consultant, PEng	Date:	April 1, 2020
Subject:	Hope Bay Project: Doris and Madrid 2019 Construction Summary Report		

1 Introduction

This memo provides a summary of formal documentation related to the engineering and construction support provided by SRK Consulting (Canada) Inc. (SRK) during 2019 for the following facilities at TMAC Resources Inc's Hope Bay site:

- Madrid South All-Weather Road (from 0 to 1 km);
- Madrid North Contact Water Pond (CWP);
- Madrid North Waste Rock Pile (WRP);
- Madrid North Portal Pad; and
- Naartok East Overburden Stockpile.

For all construction in 2019, SRK provided Issued for Construction (IFC) drawings and construction quality assurance (CQA) where necessary. High-density polyethylene (HDPE) liner installation was performed by A&A Technical Services. Earthworks were completed by Nuna Logistics Ltd. and as-built surveys were conducted by Sub-Arctic Surveys Ltd. SRK has produced the as-built drawings included in this memo based on the survey data provided by Sub-Arctic.

Construction rock for all the components described in this report was sourced from either Quarry 2 at Doris, Quarry D located at approximately kilometre 7 along the Doris-Windy Road, or from approved construction waste rock from the Naartok East Crown Pillar Recovery (CPR). Quarry 2 and Quarry D are both designated construction quarries. Geochemical characterization of this material has been completed (SRK 2007, SRK 2008, SRK 2017) and the material has been confirmed to be non potentially acid generating and non neutral metal leaching. Geochemical characterization of outcrop from within the Naartok East CPR boundaries indicate that arsenic content is low, suggesting that waste rock from Naartok East has a potentially low risk for neutral pH leaching and could be geochemically suitable as construction rock (SRK 2019).

2 Summary of Attachments

The attachments to this memo are organised into separate infrastructure items with sub-level attachments for different forms of documentation.

Of the infrastructure items constructed in 2019, only the Madrid North CWP and the Madrid North Portal Pads involved the installation of liner materials. The complete Madrid North CWP and Madrid North Portal Pad as-built construction reports are provided separately (SRK 2020a, SRK 2020b). The A&A Liner Installation Report for the Madrid North CWP and the Madrid North Portal Pads is provided in Attachment 2.3 and 4.2, respectively.

The contents of all attachments are summarized in Table 1.

Table 1: Contents of Attachments

Attachment		Infrastructure Item	Contents
1	1.1	Madrid South All-Weather Road (0 to 1 km)	Issued for Construction Drawings
	1.2		As-built Drawings
2	2.1	Madrid North CWP ⁽¹⁾	Issued for Construction Drawings
	2.2		As-built Drawings
	2.3		A&A Liner Installation Report
3	3.1	Madrid North WRP	Issued for Construction Drawings
	3.2		Interim As-built Drawings ⁽²⁾
4	4.1	Madrid North Portal Pad ⁽³⁾	As-built Drawings
	4.2		A&A Liner Installation Report
5	5.1	Naartok East Overburden Stockpile	Issued for Construction Drawings
	5.2		Interim As-built Drawings ⁽⁴⁾
6	6.1	Naartok East Overburden Stockpile Expansion ⁽⁵⁾	Issued for Construction Drawings

Notes:

1. The complete as-built report for the Madrid North CWP is provided separately (SRK 2020a).
2. Construction of the Madrid North WRP is on-going as part of operations. The interim as-built drawings reflect construction activities completed in 2019.
3. Under the current water licence, IFC drawings are not required for the construction of pads. However, during construction of the Madrid North Portal Pad, a field decision was made to line one area of the pad to provide contact water management to allow temporary stockpiling of waste rock. Further details of the field decision are provided in Section 3.4.
4. Construction of the Naartok East Overburden Stockpile is on-going as part of operations. The interim as-built drawings reflect construction activities completed in 2019.
5. IFC drawings for the expansion of the Naartok East Overburden Stockpile were submitted in December 2019. However, at the time of this report construction of the expansion had not commenced. Therefore, as-built drawings are provided for the construction of the original stockpile design.

3 Field Decisions and Design Changes

3.1 Madrid South All-Weather Road

As confirmed by the As-Built Drawings in Attachment 1.2, the Madrid South All-Weather Road was constructed in accordance with the IFC drawings. No design changes were made during construction.

3.2 Madrid North CWP

In general, the Madrid North CWP was built to the design lines, grades, and requirements as confirmed by the As-Built Drawings. Deviations from, and amendments to, the designs were generally completed to adapt the design to encountered field conditions. The main field decisions and design changes during construction of the CWP are summarized below. Further details are provided in the as-built construction summary report (SRK 2020a).

3.2.1 Overburden Excavation

During excavation of overburden to expose bedrock for the HDPE liner tie-in, a significant pocket of overburden material was encountered at the southern end of the CWP berm. This overburden pocket was found to be approximately 5 m deep. As a result, a decision was made in the field by TMAC and the SRK Site Engineer to backfill the excavated overburden pocket with ROQ and shift the liner tie-in point to higher ground upstream. Deeper than anticipated overburden was also encountered in the northern end of the CWP. Overburden was up to 4 m deep at its deepest. However, concrete plinths were able to be used and the liner to bedrock tie-in did not shift significantly from the original projected design.

These two deeper than anticipated overburden areas resulted in two main design deviations. Firstly, in the southern section, it resulted in the overburden excavation area being backfilled and moving the alignment of the liner tie-in further north into the CWP basin. Secondly in the northern section, it resulted in taller than anticipated concrete plinths. Both changes, while noteworthy, do not impact the overall design intent of the CWP.

3.2.2 Berm Alignment Modification

After filling in the southern overburden pocket with ROQ, a field decision was made by TMAC and the SRK Site Engineer to modify the CWP berm alignment. This was done in order to simplify the liner to bedrock tie-in. The modification involved adding a new berm, approximately 20 m long and perpendicular to the existing berm, at chainage 0+040. The liner then was tied into a bedrock outcrop to the northwest. This enabled the length of the liner to bedrock tie-in to be shortened and allowed the temporary access ramp (built into the excavation backfill area) to be used as part of the berm fill. The implications of the berm re-alignment meant that the CWP basin area, and therefore pond capacity, was slightly reduced. However, the reduction in storage area was minimal and most of the area that was cut-off by the new berm was above the full supply level (elev. 69.7 m). The as-built CWP storage capacity, with the berm alignment modification, exceeds the design storage capacity and therefore meets the design intent.

3.2.3 Concrete Plinths

The CWP design included an allowance for concrete plinths, if required, once the overburden was excavated and the bedrock exposed. Concrete plinths were designed to be a minimum of 0.3 m high, with a maximum height of 0.5 m.

During excavation of overburden, several overburden pockets were encountered, as well as many undulations in the bedrock. Some areas ended up having near vertical faces up to 2 m high. Except for the one large overburden pocket that was backfilled, concrete plinths were used to bridge across the excavated pockets and/ or bedrock undulations to facilitate a smooth liner tie-in. As a result, some of the concrete plinths were required to be constructed taller than the maximum design plinth height. Therefore, backfill was specified on both sides of the plinth for additional lateral support.

The GSE polylock embedment strip, as recommended in the original design to allow the liner to be welded to the top of concrete, was not available on site. Instead, the liner was bolted directly into the top of concrete using Sopramastic and a stainless-steel plate. This method achieves the design intent.

3.2.4 Berm Downstream Slope

After completion of earthworks and liner installation, the final CWP layout was surveyed by Sub-Arctic. SRK reviewed the as-built survey and identified that the downstream slopes were steeper than design slope of 2H:1V. These over-steepened slopes were also noted at various times during the ongoing QA checks on site. The outside as-built slopes were typically between 1.7H:1V to 1.9H:1V, but some sections were as steep as 1.65H:1V. SRK instructed TMAC to place additional fill or regrade the slopes to achieve the design slope of 2H:1V. Instead, TMAC requested SRK to complete a stability analysis to determine if the steeper than design slopes were stable in the current arrangement to meet the minimum required factors of safety.

SRK completed a stability analysis to assess the risk of geotechnical instability of the CWP berm in its as-built condition. The results of the analysis indicate that the berm is stable and meets minimum factors of safety (FoS), provided the overburden in the foundation remains frozen, or as a minimum, doesn't thaw beyond the average active layer thickness in this area (typically around 1 m). If the overburden completely thaws, the FoS may reduce below the criteria of 1.5 but this is not an indication that immediate failure is expected. Therefore, the risk of failure is low. Additionally, if a failure were to occur it would be slow and progressive rather than rapid, i.e. there would be enough warning provided adequate monitoring is in place.

SRK is therefore satisfied that the berm's downstream slope does not currently need to be regraded to meet a slope of 2H:1V. Further details of the analysis are provided in SRK (2020a).

3.3 Madrid North WRP

Based on the as-built survey data, the Madrid North WRP perimeter berm and access road was built according to design, though the WRP pad was constructed higher than originally intended. However, the pad still achieves the design intent of creating a graded base towards the CWP,

and therefore the increased height of the pad does not affect the design. TMAC operations were in regular communication with SRK during construction of the pad and SRK is satisfied that the constructed pad meets the design objectives.

SRK notes that based on the as-built survey, the toe of the WRP at its southern extent has exceeded the design toe location and is encroaching on the full supply level of the Madrid North CWP. SRK recommends that during freshet and summer months, the WRP toe be monitored to ensure the pond level in the CWP does not reach the toe of the WRP.

TMAC are currently free dumping the first bench of waste rock on the constructed WRP pad and are meeting the overall design slopes of 2.5H:1V based on the as-built survey. At the time of this report, the WRP sumps had not been constructed, though SRK understands TMAC is planning to construct the sumps prior to the 2020 freshet. SRK will continue to provide on-going construction support and will inspect the constructed WRP during the 2020 annual geotechnical inspection (typically scheduled for the months of July or August). The construction process and as-built drawings for the sumps will be reported in the 2020 after they are constructed.

3.4 Madrid North Portal Pad

The Madrid North Portal Pad was originally designed as a pad laydown area to support development of the Madrid North Portal. It was designed in accordance with other pads on site, consisting of a minimum 1 m (for thermal protection of permafrost) of geochemically suitable run-of-quarry (ROQ) or run-of-mine (ROM) rock.

During construction, TMAC decided that it would be preferable for underground trucks delivering waste from the portal development to temporarily place waste rock on the pad and instead allow larger haul trucks designed for surface operations to collect the waste and haul it to the waste rock pile. Based on this decision, the dedicated area of the portal pad where the transfers would occur required contact water management. A field decision was made to line one area of the pad with geomembrane to create a waste rock re-handling area that could manage potential contact water during daily operations.

SRK produced a design for the lined temporary waste storage area to facilitate construction in the field. The design included standard material specifications and thicknesses for transition and bedding material to protect the liner, as well as lined berms to create sufficient storage capacity for the maximum daily snowmelt. The lined cell area was graded to the northeast corner to create a sump area for collection of potential contact water. The size of the lined cell was designed to accommodate underground waste from the portal development for at least one day of operations.

The As-Built Drawings for the pad and lined cell are provided in Attachment 4.1. A&A's Liner Installation Report is also included in Attachment 4.2. Based on the as-built data, the lined cell area meets the design storage capacity and the design grade. Further construction details are provided in SRK (2020b).

3.5 Naartok Overburden Stockpile

As confirmed by the As-Built Drawings in Attachment 5.2, the Naartok East Overburden Stockpile was constructed in general accordance with the IFC drawings. No design changes were made during construction. Additional ROQ/ROM access roads were built within the footprint of the stockpile to facilitate haul truck access. This is considered an operational requirement and does not impact the design or function of the stockpile.

The as-built data (collected January 2020) indicates that the downstream slope of the stockpile is slightly steeper than the design slope of 5H:1V. However, TMAC are continuing to shape and re-grade the stockpile to meet the design grades.

In December 2019, TMAC requested SRK to evaluate expansion options for the overburden stockpile. SRK completed the design to expand the overburden stockpile height and footprint and IFC drawings were submitted in December 2019. At the time of receipt of as-built survey data (January 2020) TMAC had not commenced the stockpile expansion, therefore the as-built drawings only include comparison of as-built surfaces to the original stockpile design.

Disclaimer—SRK Consulting (Canada) Inc. has prepared this document for TMAC Resources Inc. Any use or decisions by which a third party makes of this document are the responsibility of such third parties. In no circumstance does SRK accept any consequential liability arising from commercial decisions or actions resulting from the use of this report by a third party.

The opinions expressed in this report have been based on the information available to SRK at the time of preparation. SRK has exercised all due care in reviewing information supplied by others for use on this project. Whilst SRK has compared key supplied data with expected values, the accuracy of the results and conclusions from the review are entirely reliant on the accuracy and completeness of the supplied data. SRK does not accept responsibility for any errors or omissions in the supplied information, except to the extent that SRK was hired to verify the data.

4 References

SRK Consulting (Canada) Inc., 2007. Geochemical Characterization of Quarry Materials, Doris-North Project, Hope Bay, Nunavut, Canada (Revised March 2007). Report Prepared for Miramar Hope Bay Ltd., April 2007.

SRK Consulting (Canada) Inc., 2008. Geochemical Characterization of Quarry Materials for the Doris-Windy All-Weather Road, Hope Bay Project. Report Prepared for Hope Bay Mining Ltd., 1CH008.000. August 2008.

SRK Consulting (Canada) Inc., 2017. Geochemical Characterization of Madrid-Boston Project Quarries Report, Hope Bay Project. Report Prepared for TMAC Resources Inc., 1CT022.013. November 2017.

SRK Consulting (Canada) Inc. 2019. Classification of Waste Rock in Support of Segregating Construction Rock from Naartok East Crown Pillar Recovery, Madrid North, Hope Bay Project. Report prepared for TMAC Resources Inc. Project No.: 1CT022.037. August 2019.

SRK Consulting (Canada) Inc., 2020a. Madrid North Contact Water Pond As-Built Report, Hope Bay Project. Report Prepared for TMAC Resources Inc., 1CT022.043. March 2020.

SRK Consulting (Canada) Inc., 2020b. Madrid North Portal Pad As-Built Report, Hope Bay Project. Memo Prepared for TMAC Resources Inc., 1CT022.051. April 2020.

Attachment 1 – Madrid South All-Weather Road (0 to 1 km)

Attachment 1.1 Madrid South All-Weather Road - IFC Drawings

Engineering Drawings for the Madrid South All-Weather Road, Hope Bay Project, Nunavut, Canada

ACTIVE DRAWING STATUS

DWG NUMBER	DRAWING TITLE	REVISION	DATE	STATUS
MSR-00	Engineering Drawings for the Madrid South All-Weather Road, Hope Bay Project, Nunavut, Canada	0	Mar. 18, 2019	Issued for Construction
MSR-01	General Arrangement (with Orthophoto)	0	Mar. 18, 2019	Issued for Construction
MSR-02	General Arrangement	0	Mar. 18, 2019	Issued for Construction
MSR-03	Road Alignment Plan and Profile (1 of 5)	0	Mar. 18, 2019	Issued for Construction
MSR-04	Road Alignment Plan and Profile (2 of 5)	A	Mar. 14, 2014	Issued For Discussion
MSR-05	Road Alignment Plan and Profile (3 of 5)	A	Mar. 14, 2014	Issued For Discussion
MSR-06	Road Alignment Plan and Profile (4 of 5)	A	Mar. 14, 2014	Issued For Discussion
MSR-07	Road Alignment Plan and Profile (5 of 5)	D	Mar. 14, 2014	Issued For Discussion
MSR-08	Typical Road and Crossing Details	0	Mar. 18, 2019	Issued for Construction
MSR-09	Animal Crossings Plan and Sections	0	Mar. 18, 2019	Issued for Construction
MSR-10	Crossing #1 - Bridge Option - Plan, Section and Detail (1 of 2)	A	Mar. 14, 2014	Discontinued (Removed)
MSR-11	Crossing #1 - Bridge Option - Plan, Section and Detail (2 of 2)	A	Mar. 14, 2014	Discontinued (Removed)
MSR-12	Crossing #1 - Arch Culvert Option	A	Mar. 14, 2014	Discontinued (Removed)
MSR-13	Crossing #2 - Arch Culvert	A	Mar. 14, 2014	Discontinued (Removed)
MSR-14	Typical Arch Culvert Plan and Profile (1 of 2)	A	Mar. 14, 2014	Discontinued (Removed)
MSR-15	Typical Arch Culvert Details (2 of 2)	A	Mar. 14, 2014	Discontinued (Removed)
MSR-16	Material List and Quantity Estimates	B	Aug. 5, 2014	Issued For Discussion
MSR-17	Madrid North Waste Rock Access Road Plan and Profile	0	Mar. 18, 2019	Issued for Construction
MSR-18	Naartok East CPRT Access Road Plan and Profile	0	Mar. 18, 2019	Issued for Construction



Signed and Stamped Copies
2019/04/02
John Fargyle



PROJECT NO: 1CT022.043
Revision 0
March 18, 2019
Drawing MSR-00

1. Topographic contour data for the terrain model were provided by Hope Bay Mining, and is based on 2007 Aerial Photography. Contour intervals are 0.5m.
2. The co-ordinate system is UTM NAD 83, Zone 13.
3. All dimensions are in metric units, unless specifically mentioned.
4. All drawings are scaled appropriately for D-Size construction drawings. Scales may not be correct if these drawings are reproduced and presented in any other size format.
5. Construction and material specifications shall be in accordance with the following Technical Specifications: Earthworks and Geotechnical Engineering, Hope Bay Project, Nunavut, Canada. Revision H - Issued for Construction. SRK (2018).

Run of Quarry or Run of Mine Material


- Madrid South AWR (0 to 1 km): 29,260m³
- Madrid North WRP Access Road: 4,030m³
- Naartok East CPRT Access Road: 3,220m³

**ROQ / ROM volumes reported are in-place quantities calculated to neat lines. No bulking / shrinking factors have been utilized in volume determination.
Losses into the tundra are not accounted for.



- Madrid South AWR (0 to 1 km) : 1,220m³
- Madrid North WRP Access Road: 370m³
- Naartok East CPRT Access Road: 350m³

**Surfacing Material volumes based on crest width, crest length and surfacing thickness.
No allowances have been made for surfacing material fill around culverts or for transitions from ROQ / ROM fill over permafrost to surfacing material over bedrock.

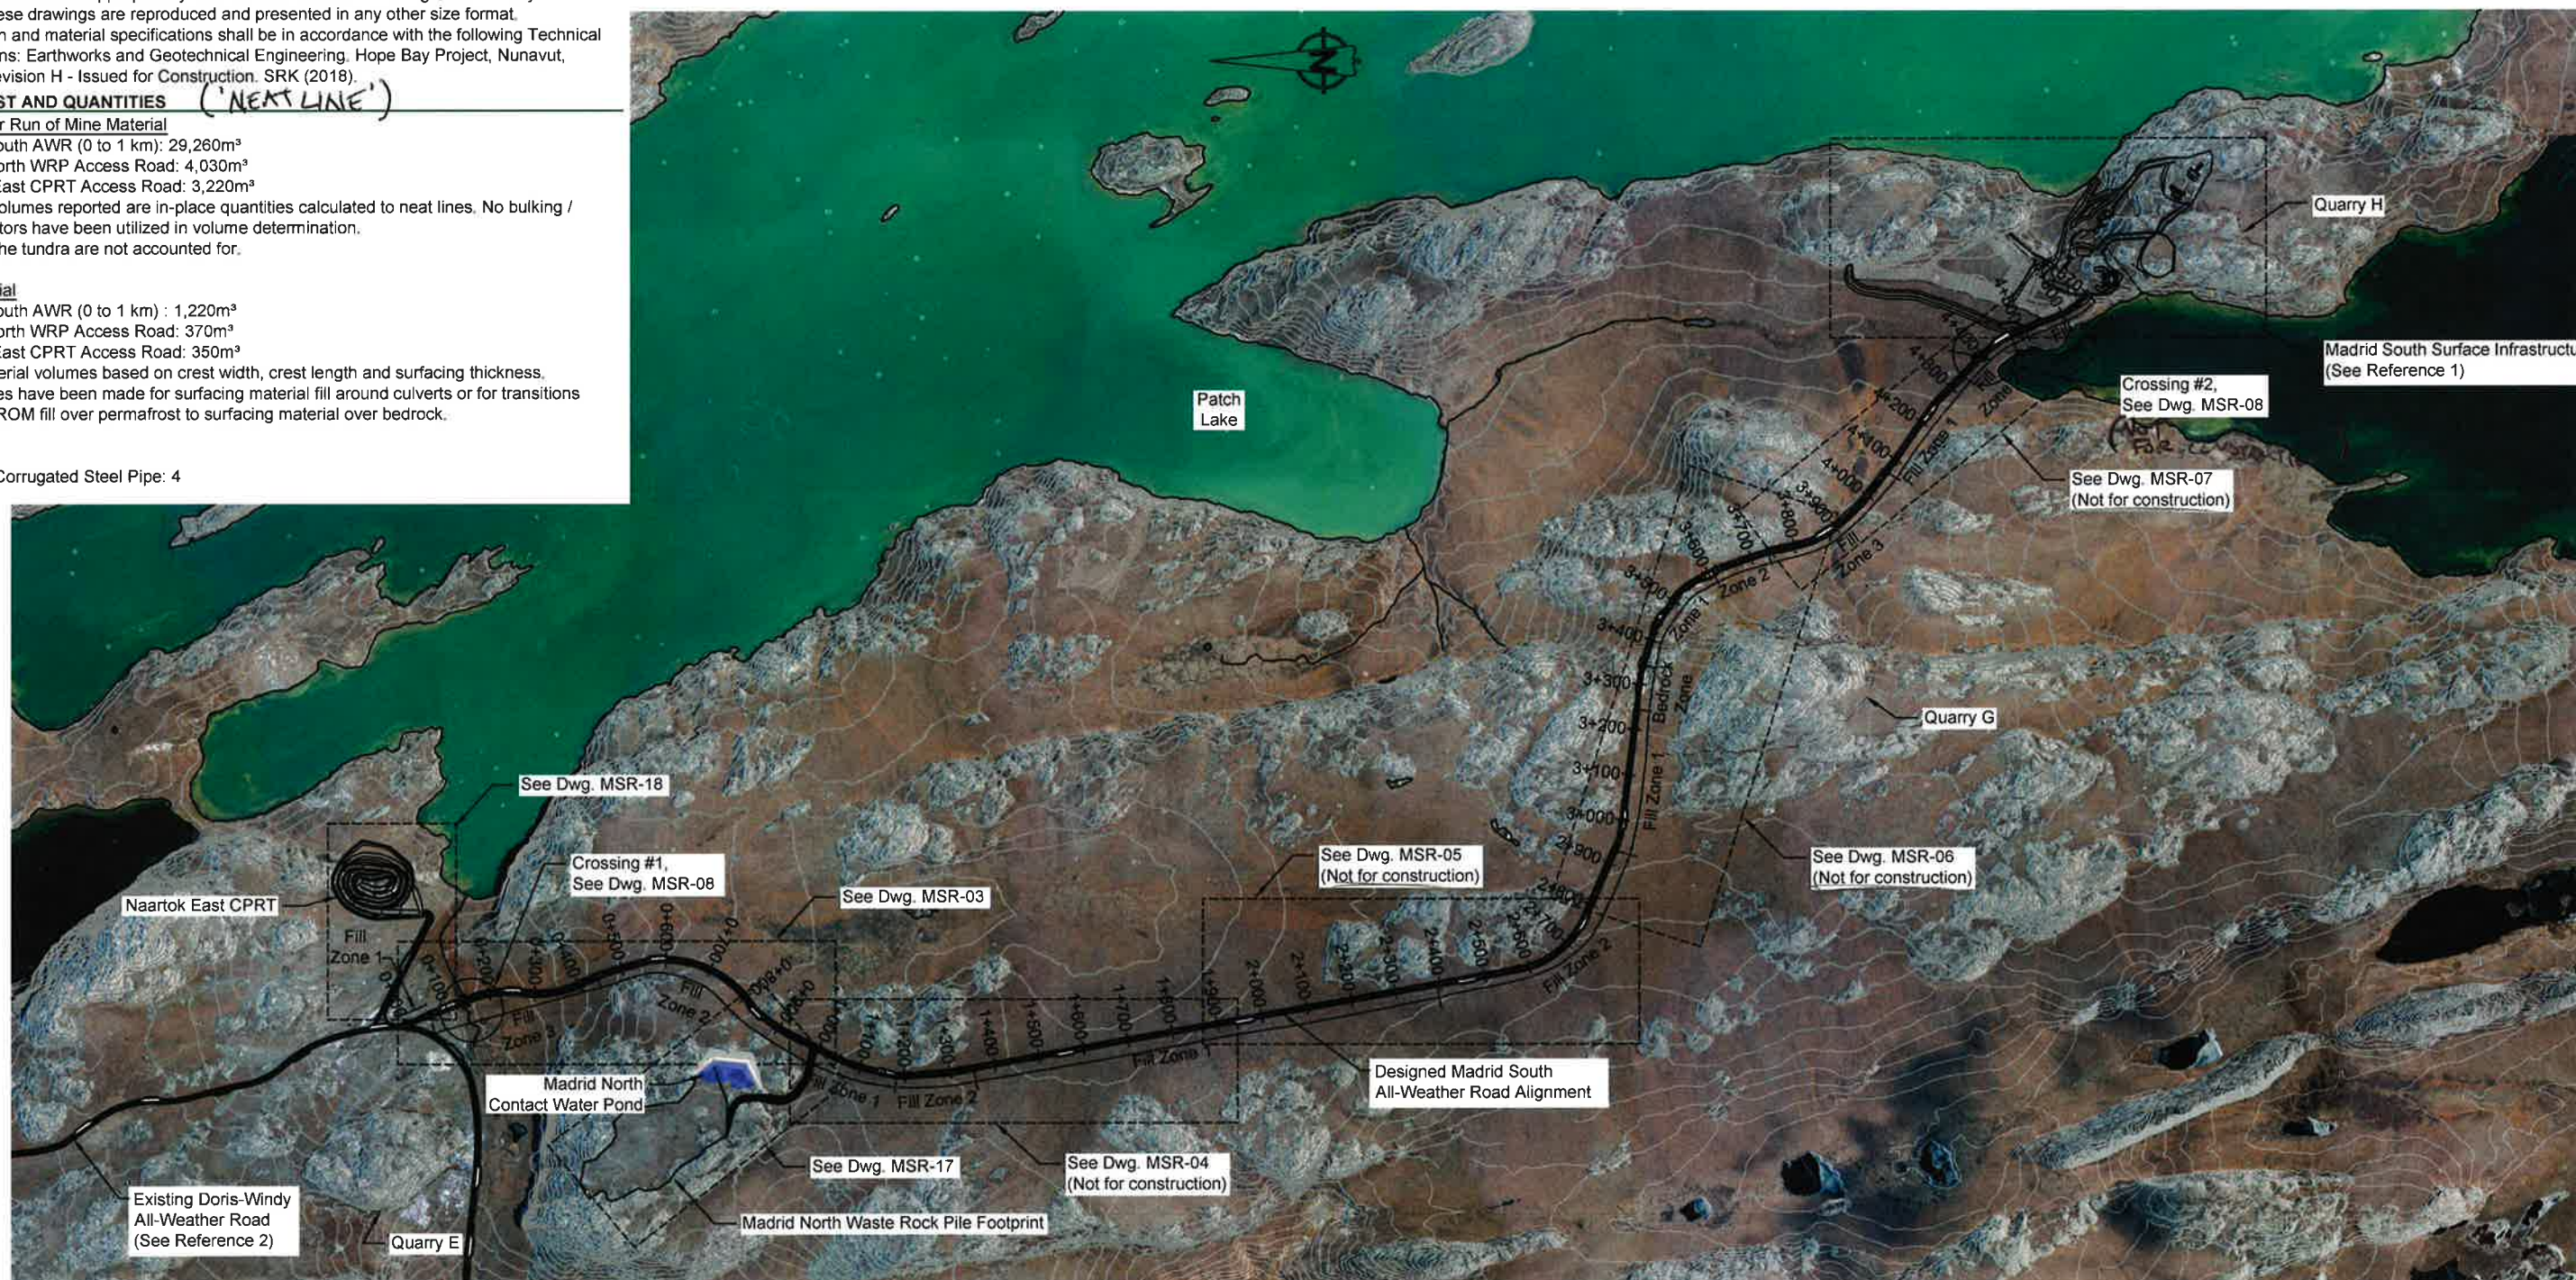1.0m Diameter Corrugated Steel Pipe: 4



 Existing Approved and Permitted Quarry
 Proposed Development Quarry


 Road Alignment
 Route Centerline

Fill Zone 1	1.0m min. Overall Road Thickness with 1.5H:1V Side Slopes
Fill Zone 2	1.5m min. Overall Road Thickness with 1.5H:1V Side Slopes
Fill Zone 3	2.0m min. Overall Road Thickness with 2.0H:1V Side Slopes
Bedrock Zone	0.3m min Road Thickness (ROQ not required) with Side Slopes to be determined in the field


1. Engineering drawings for the Madrid South Surface Infrastructure, Hope Bay Project, Nunavut, Canada. Issued for Discussion. Revision F. Project No. 1CT022.001. October 31, 2014.

2. Engineering Drawings for the Doris-Windy All-Weather Road, Doris Infrastructure Project, Nunavut, Canada. Revision AB1. As-Built Drawings Prepared for Hope Bay Mining Ltd. Project Number: 1CH008 033/058. May 11, 2012.



3. Geochemical Characterization of Quarry Materials for the Doris-Windy All-Weather Road, Hope Bay Project. Report prepared for Hope Bay Mining Ltd. 1CH008.000. August 2008.

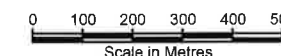[illegible]


▲ Point of Intersection
6.1% Grade
■ Turnout Location; not to scale
(See Drawing MSR-07 for Typical Layout)

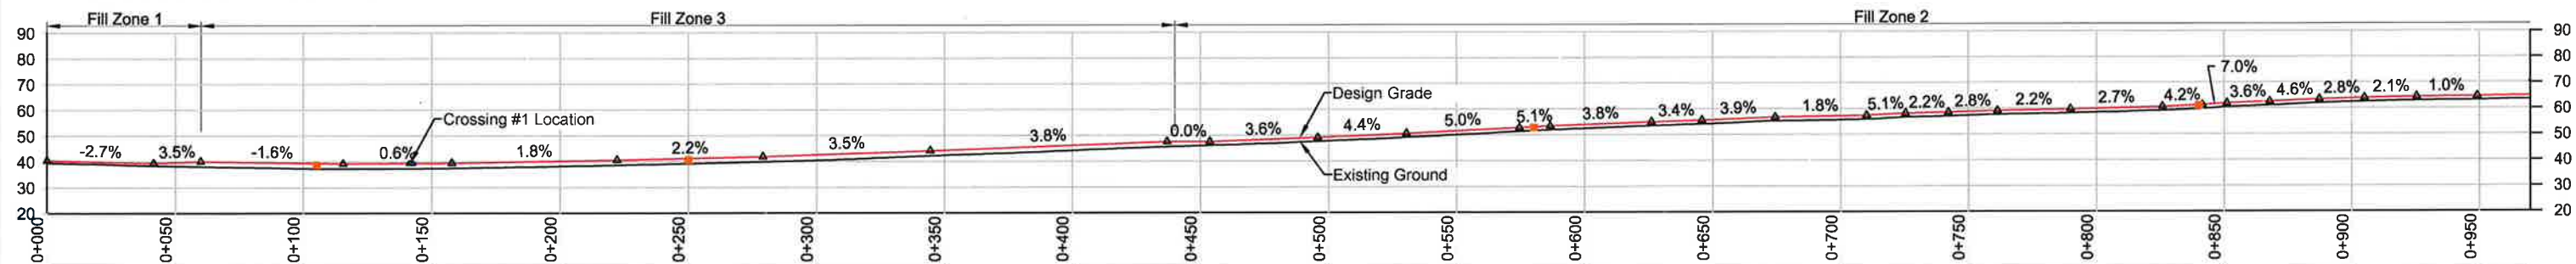

PROFILE
DORIS - WINDY to MADRID NORTH

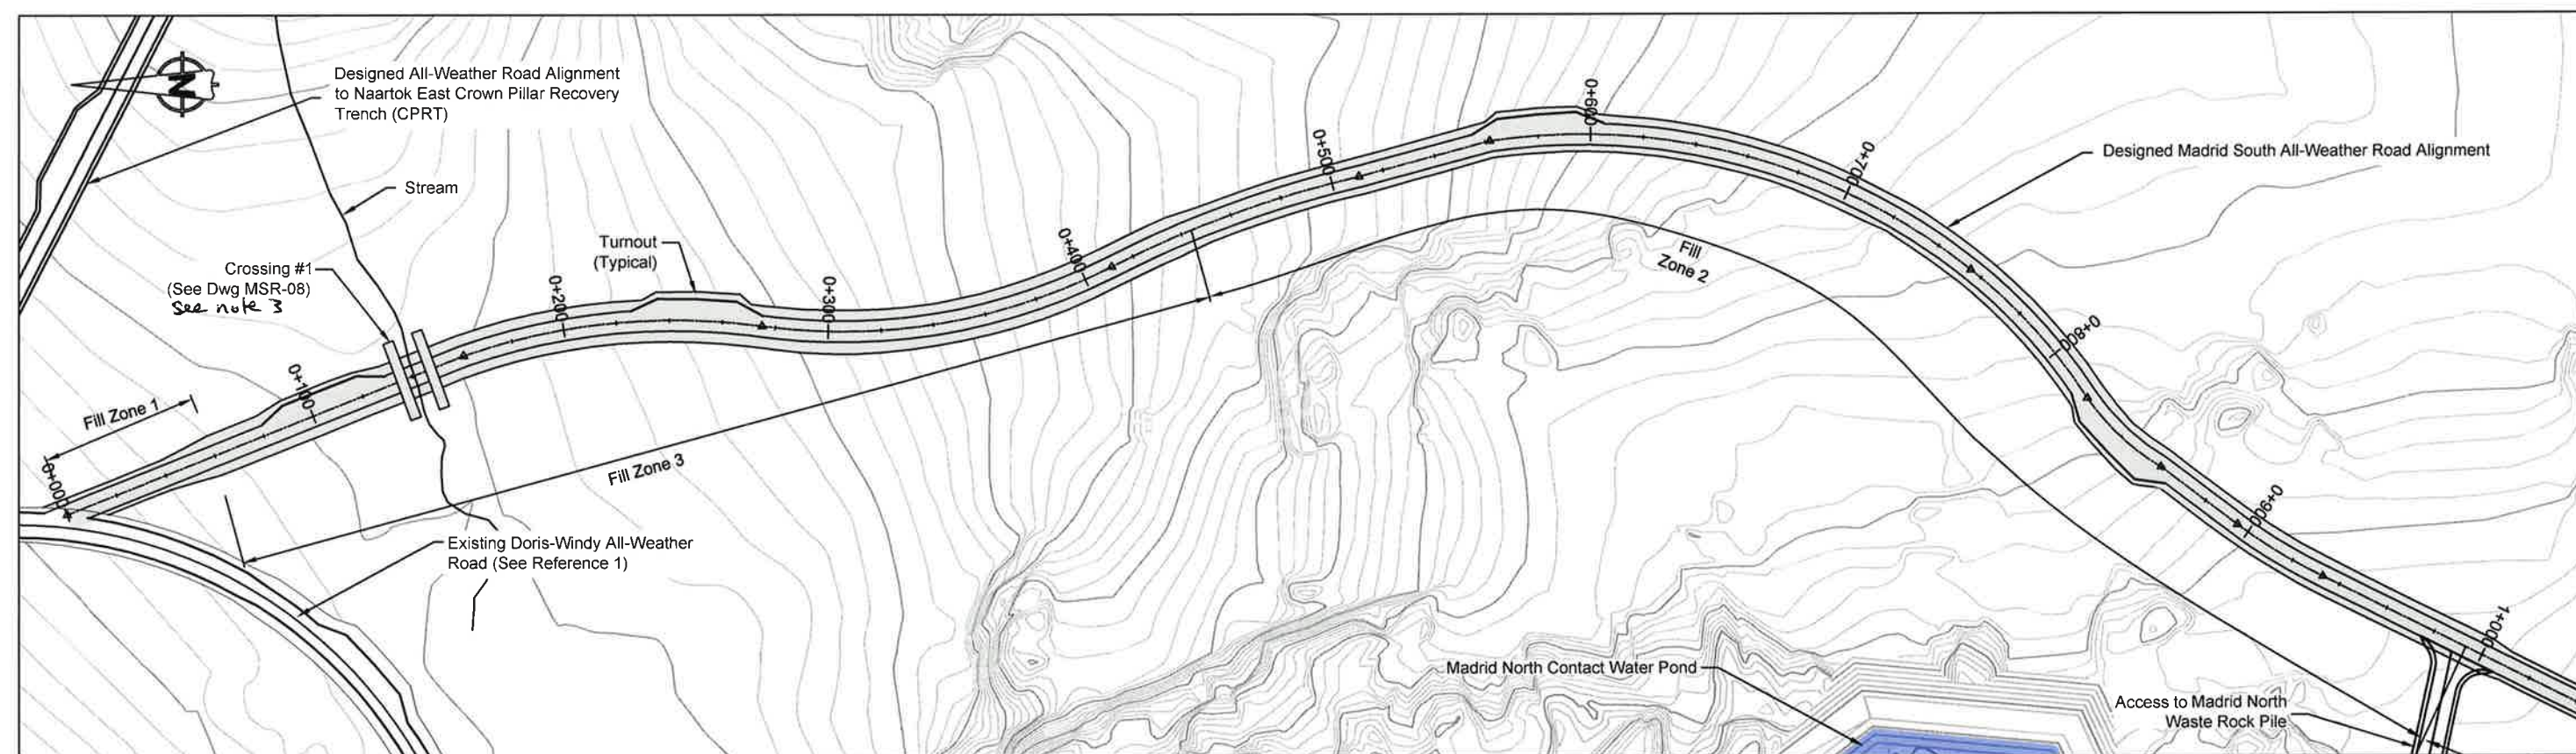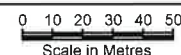

PLAN VIEW
DORIS - WINDY TO MADRID NORTH

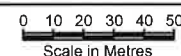

 Point of Intersection
  Road Alignment
 Route Centerline
  Crossing Location

1. All dimensions in metres unless noted otherwise.
2. Notes in this drawing apply to all other active drawings.
3. Final crossing / culvert alignments to be field fit to best allow for flow conveyance

ROAD CONSTRUCTION ZONES TABLE:	
Fill Zone 1	1.0m min. Overall Road Thickness with 1.5H:1V Side Slopes
Fill Zone 2	1.5m min. Overall Road Thickness with 1.5H:1V Side Slopes
Fill Zone 3	2.0m min. Overall Road Thickness with 2.0H:1V Side Slopes
Bedrock Zone	0.3m min Road Thickness (ROQ not required) with Side Slopes to be determined in the field

1. Engineering Drawings for the Doris-Windy All-Weather Road, Doris Infrastructure Project, Nunavut, Canada. Revision AB1. As-Built Drawings Prepared for Hope Bay Mining Ltd. Project Number: 1CH008.033/058. May 11, 2012.
2. Geochemical Characterization of Quarry Materials for the Doris-Windy All-Weather Road, Hope Bay Project. Report prepared for Hope Bay Mining Ltd., 1CH008.000. August 2008.

P:\01_SITES\Hope Bay\IACAD\IFC\Modrid Access Roads\1CT022.043 Modrid South.dwg weather road.dwg


[illegible]

DESIGN:	JK/RW	DRAWN:	NV/TAH	REVIEWED:	RW
CHECKED:	RW	APPROVED:	EMR	DATE:	March 18, 201
FILE NAME: 1CT022.043 Madrid South all weather road.dwg					




HOPE BAY PROJECT

<h1 style="text-align: center;">Madrid South All-Weather Road</h1>		
<p>DRAWING TITLE:</p> <h2 style="text-align: center;">Road Alignment Plan and Profile (1 of 5)</h2>		
<p>DRAWING NO.</p> <h3 style="text-align: center;">MSR-03</h3>	<p>SHEET 4 OF 18</p>	<p>REVISION NO.</p> <h3 style="text-align: center;">0</h3>

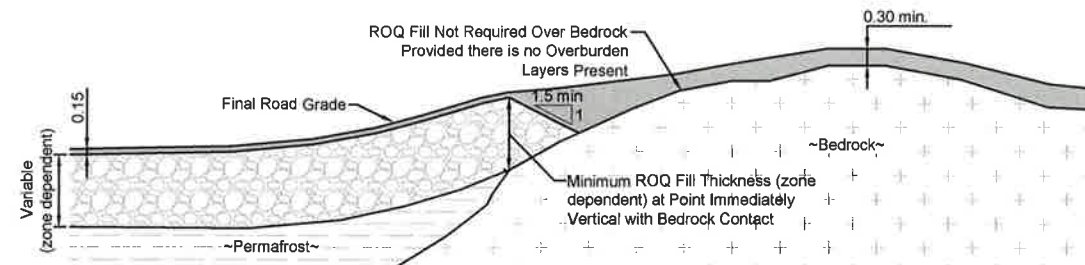




**ALL-WEATHER ROAD PROFILE
TRANSITION FROM PERMAFROST TO BEDROCK**

Scale In Metres
0 1 2 3 4 5

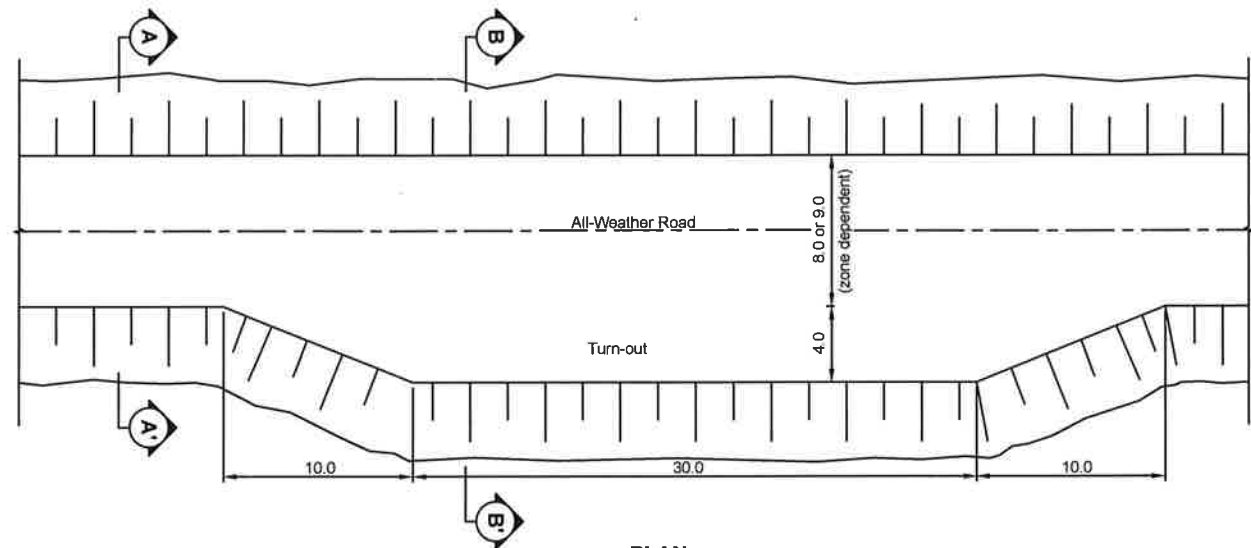


**PLAN
TYPICAL ALL-WEATHER ROAD & TURNOUT**

Scale In Metres
0 2 4 6 8 10

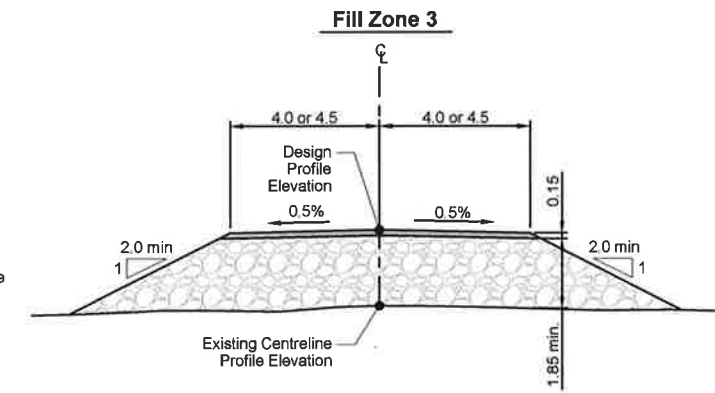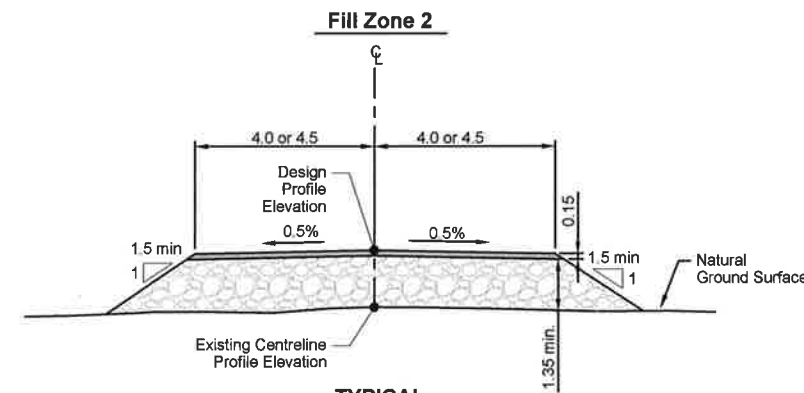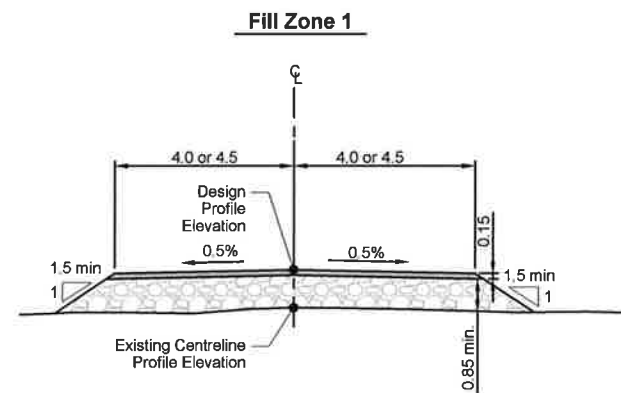


**TYPICAL
ALL-WEATHER ROAD SECTION**

Scale In Metres
0 1 2 3 4 5

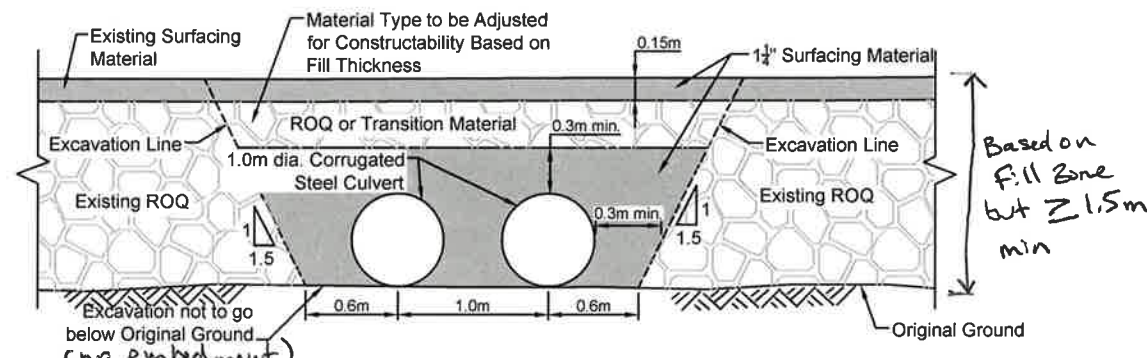

**DETAIL 6
TYPICAL CROSS SECTION OF CULVERT CROSSING**

NOT TO SCALE

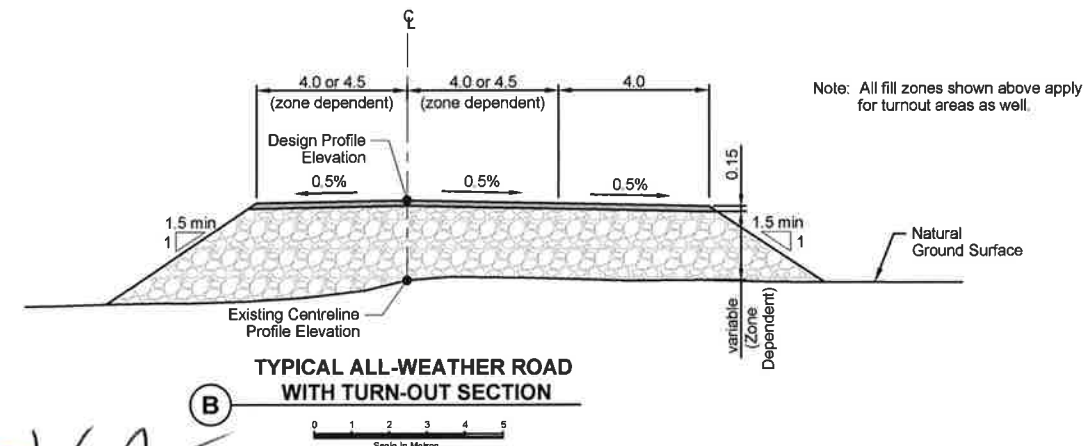

**TYPICAL ALL-WEATHER ROAD
WITH TURN-OUT SECTION**

Scale In Metres
0 1 2 3 4 5

LEGEND

- Surfacing Material
- Run of Quarry Material

NOTES


1. All dimensions in metres unless noted otherwise.
2. Minimum design thickness must be maintained for all sections of the all-weather road including turnouts. See Drawings MSR-01 for fill zone chainage intervals.
3. Safety barriers expected to be required in any areas where fill thicknesses are $\geq 3m$.

P:\M_SITES\Hope Bay\ACAD\DWG\Madrid_South_all-weather_sections.dwg



DRAWING NO.	DRAWING TITLE	DRAWING NO.	DRAWING TITLE	NO.	DESCRIPTION	CHRD	APPD	DATE
				0	Issued for Construction	RW	EMR	18Aug19
				B	Issued for Discussion	LW	EMR	5Aug14
				A	Issued for Discussion	JK	EMR	14Mar14
REFERENCE DRAWINGS				REVISIONS				




srk consulting			TMAC RESOURCES			Madrid South All-Weather Road		
DESIGN: LW/RW			DRAWN: NV/TAH			DRAWING TITLE:		
CHECKED: RW			APPROVED: EMR			Typical Road and Crossing Details		
DATE: March 18, 2019			REVIEWED: RW			DRAWING NO.		
FILE NAME: 1CT022.043 Madrid_South_all-weather_sections.dwg			SRK JOB NO.: 1CT022.001			MSR-08		
PROFESSIONAL ENGINEERS STAMP			HOPE BAY PROJECT			SHEET 9 OF 18		
						REVISION NO. 0		

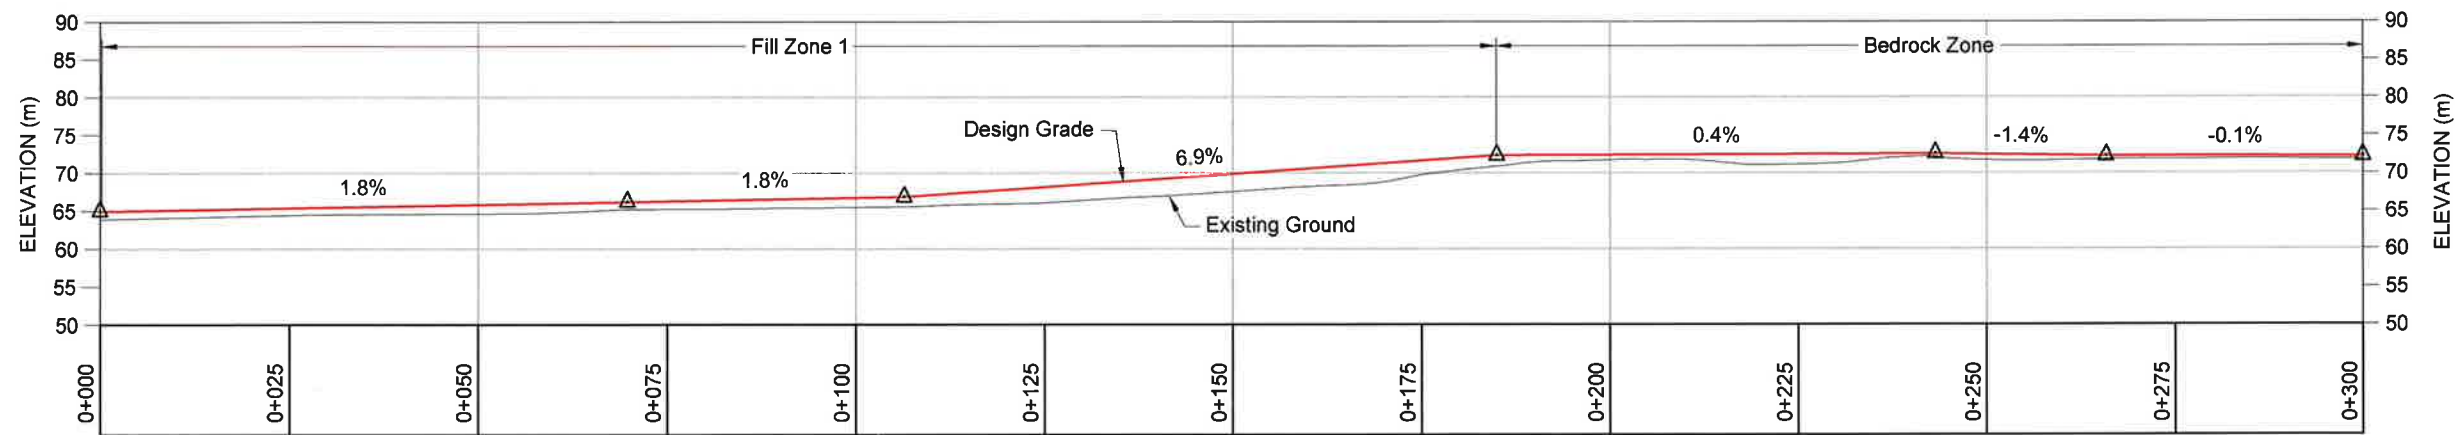

PROFILE
WASTE ROCK PILE ACCESS ROAD

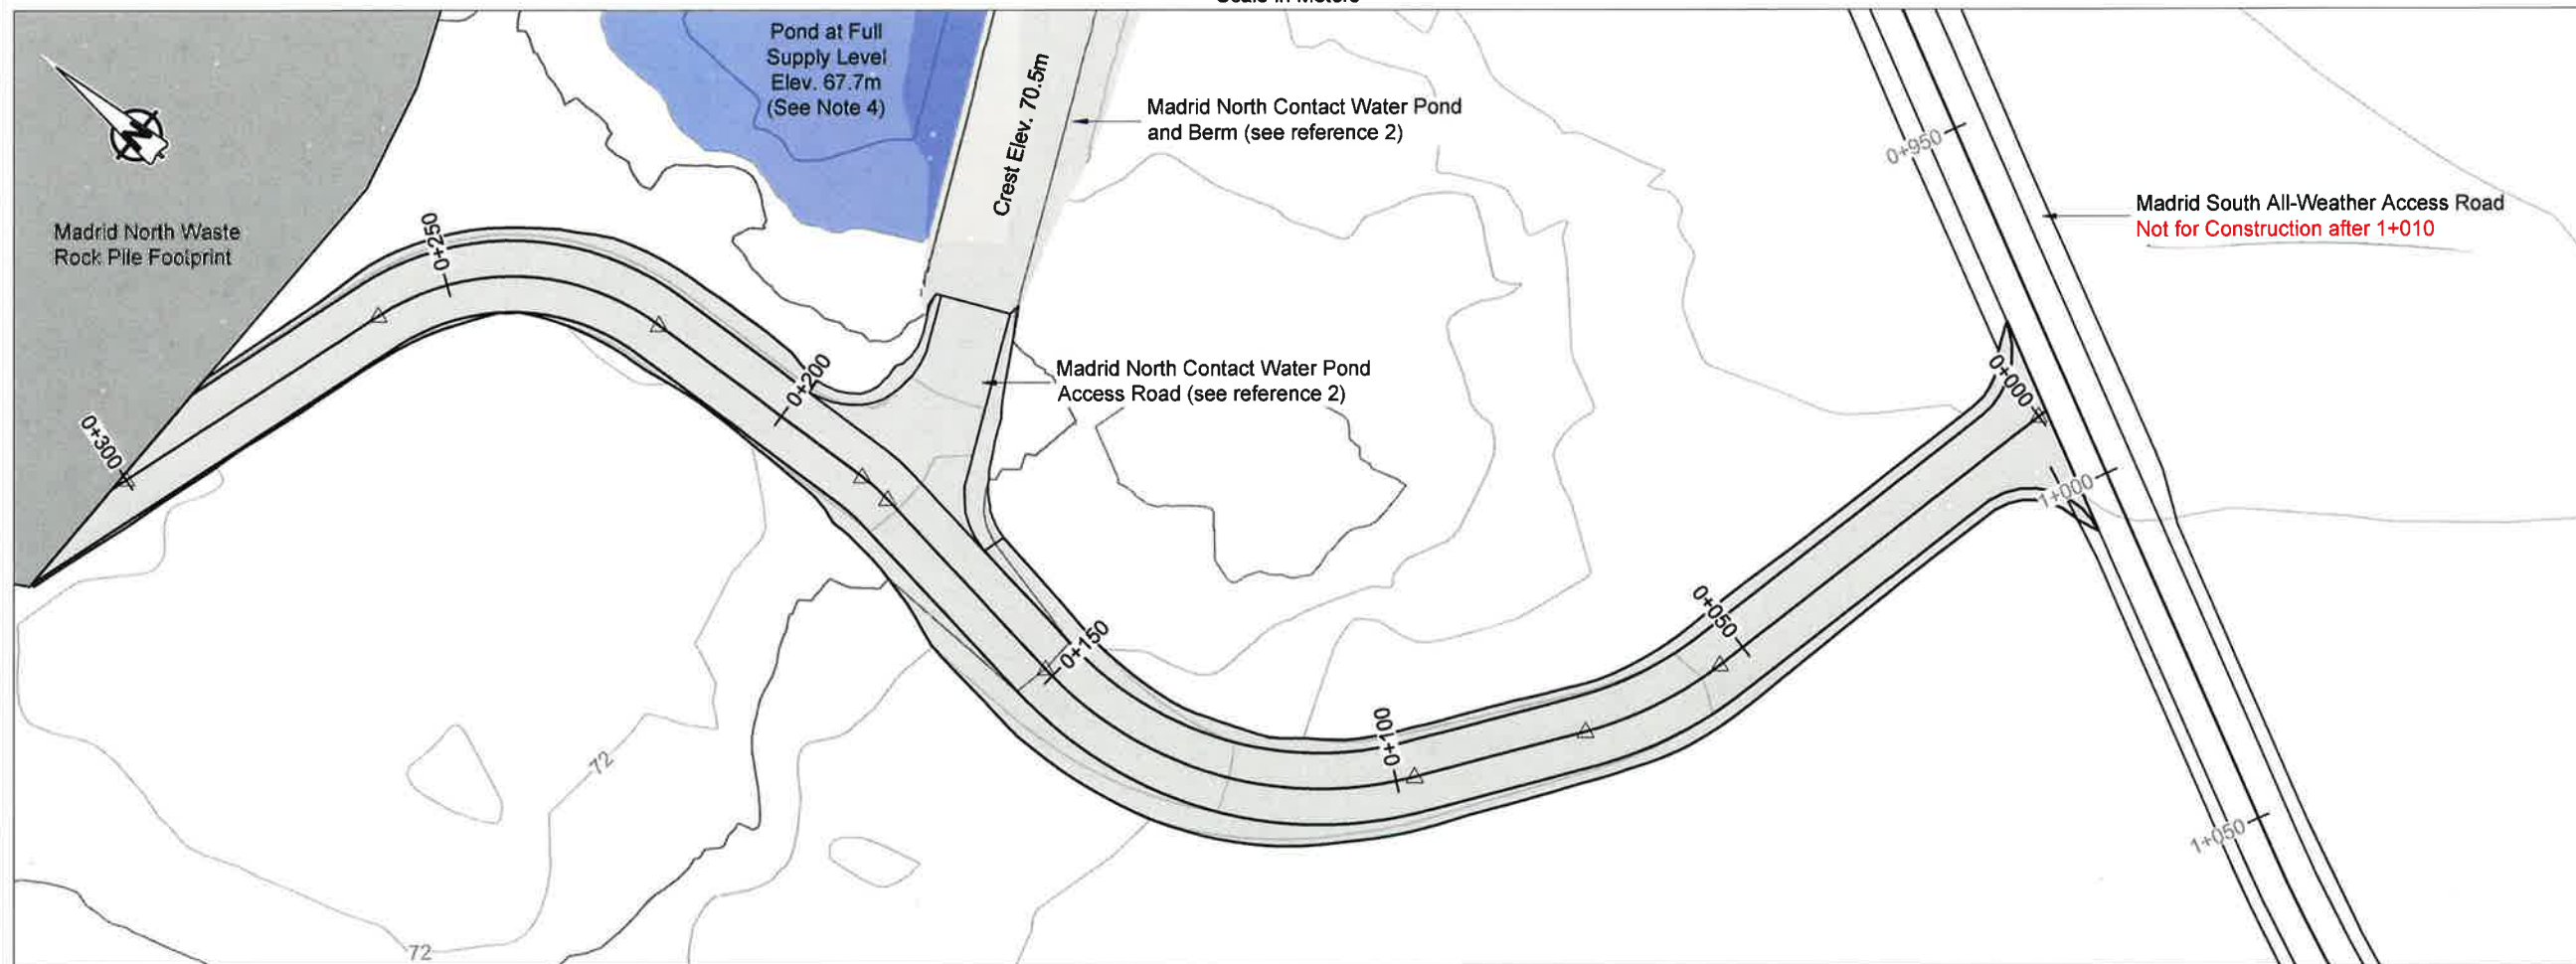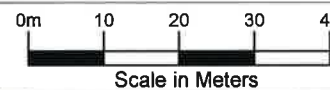

PLAN VIEW
WASTE ROCK PILE ACCESS ROAD

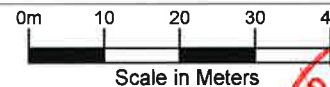

LEGEND

- △ Point of Intersection
- Route Centerline
- Road Alignment

PROFILE LEGEND

- △ Point of Intersection
- 4.1% Grade

NOTES

- Contours shown at 2.0m intervals.
- All units shown in meters unless otherwise specified.
- Construction and material specifications shall be in accordance with the following Technical Specifications: Earthworks and Geotechnical Engineering. Hope Bay Project, Nunavut, Canada. Revision H - Issued for Construction. SRK (2018).
- The CWP will normally be kept in a dry state with a maximum two-week (i.e. fourteen day) residence time for water in the pond.

REFERENCES

- NAD83 UTM Zone 13.
- Engineering Drawings for the Madrid North Contact Water pond, Hope Bay Project, Nunavut, Canada. Revision A. Issued for Discussion drawings prepared for TMAC Resources. Project number 1CT022.043. March 2019.

ROAD CONSTRUCTION ZONES TABLE:

Fill Zone 1	1.0m min. Overall Road Thickness with 1.5H:1V Side Slopes
Fill Zone 2	1.5m min. Overall Road Thickness with 1.5H:1V Side Slopes
Fill Zone 3	2.0m min. Overall Road Thickness with 2H:1V Side Slopes
Bedrock Zone	0.3m min. Road Thickness (ROQ not required) Side Slopes to be determined in the field

P:\01_SITES\Hope Bay\ACAD\FCI\Madrid Access Road\1CT022.043 - AR-PP.dwg


DRAWING NO.	DRAWING TITLE	NO.	DESCRIPTION	CHKD	APPD	DATE	NO.	DESCRIPTION	CHKD	APPD	DATE
0	Issued for Construction	RW	EMR	18Mar19							
A	Issued for Discussion	RW	EMR	5Mar19							





DESIGN:	RW	DRAWN:	TAH	REVIEWED:	RW
CHECKED:	RW	APPROVED:	EMR	DATE:	March 18, 2019
FILE NAME:	1CT022.043 - AR-PP.dwg				

SRK JOB NO.:	1CT022.036
--------------	------------


Madrid South All-Weather Road		
DRAWING TITLE:		
Madrid North Waste Rock Pile Access Road Plan and Profile		
DRAWING NO.	SHEET	REVISION NO.
MSR-17	17 OF 18	0

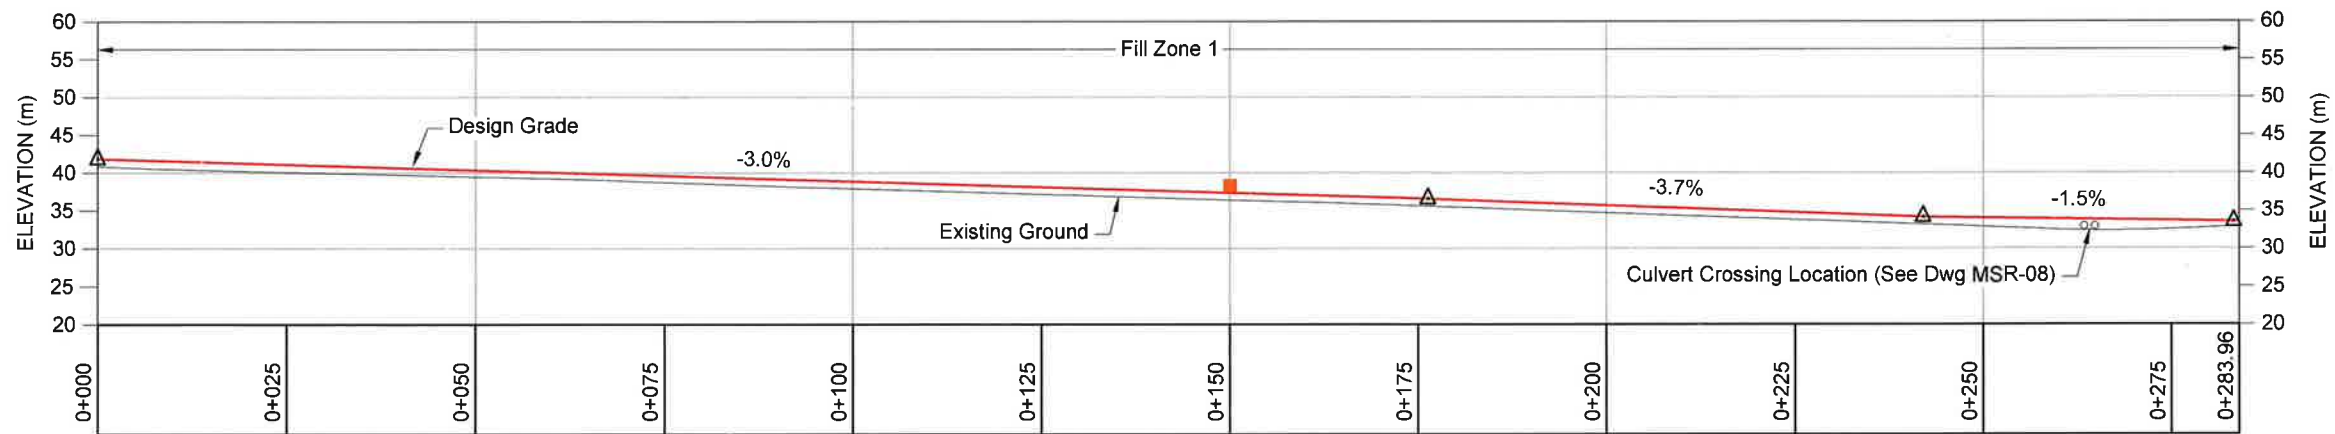

PROFILE
NAARTOK EAST CPRT ACCESS ROAD

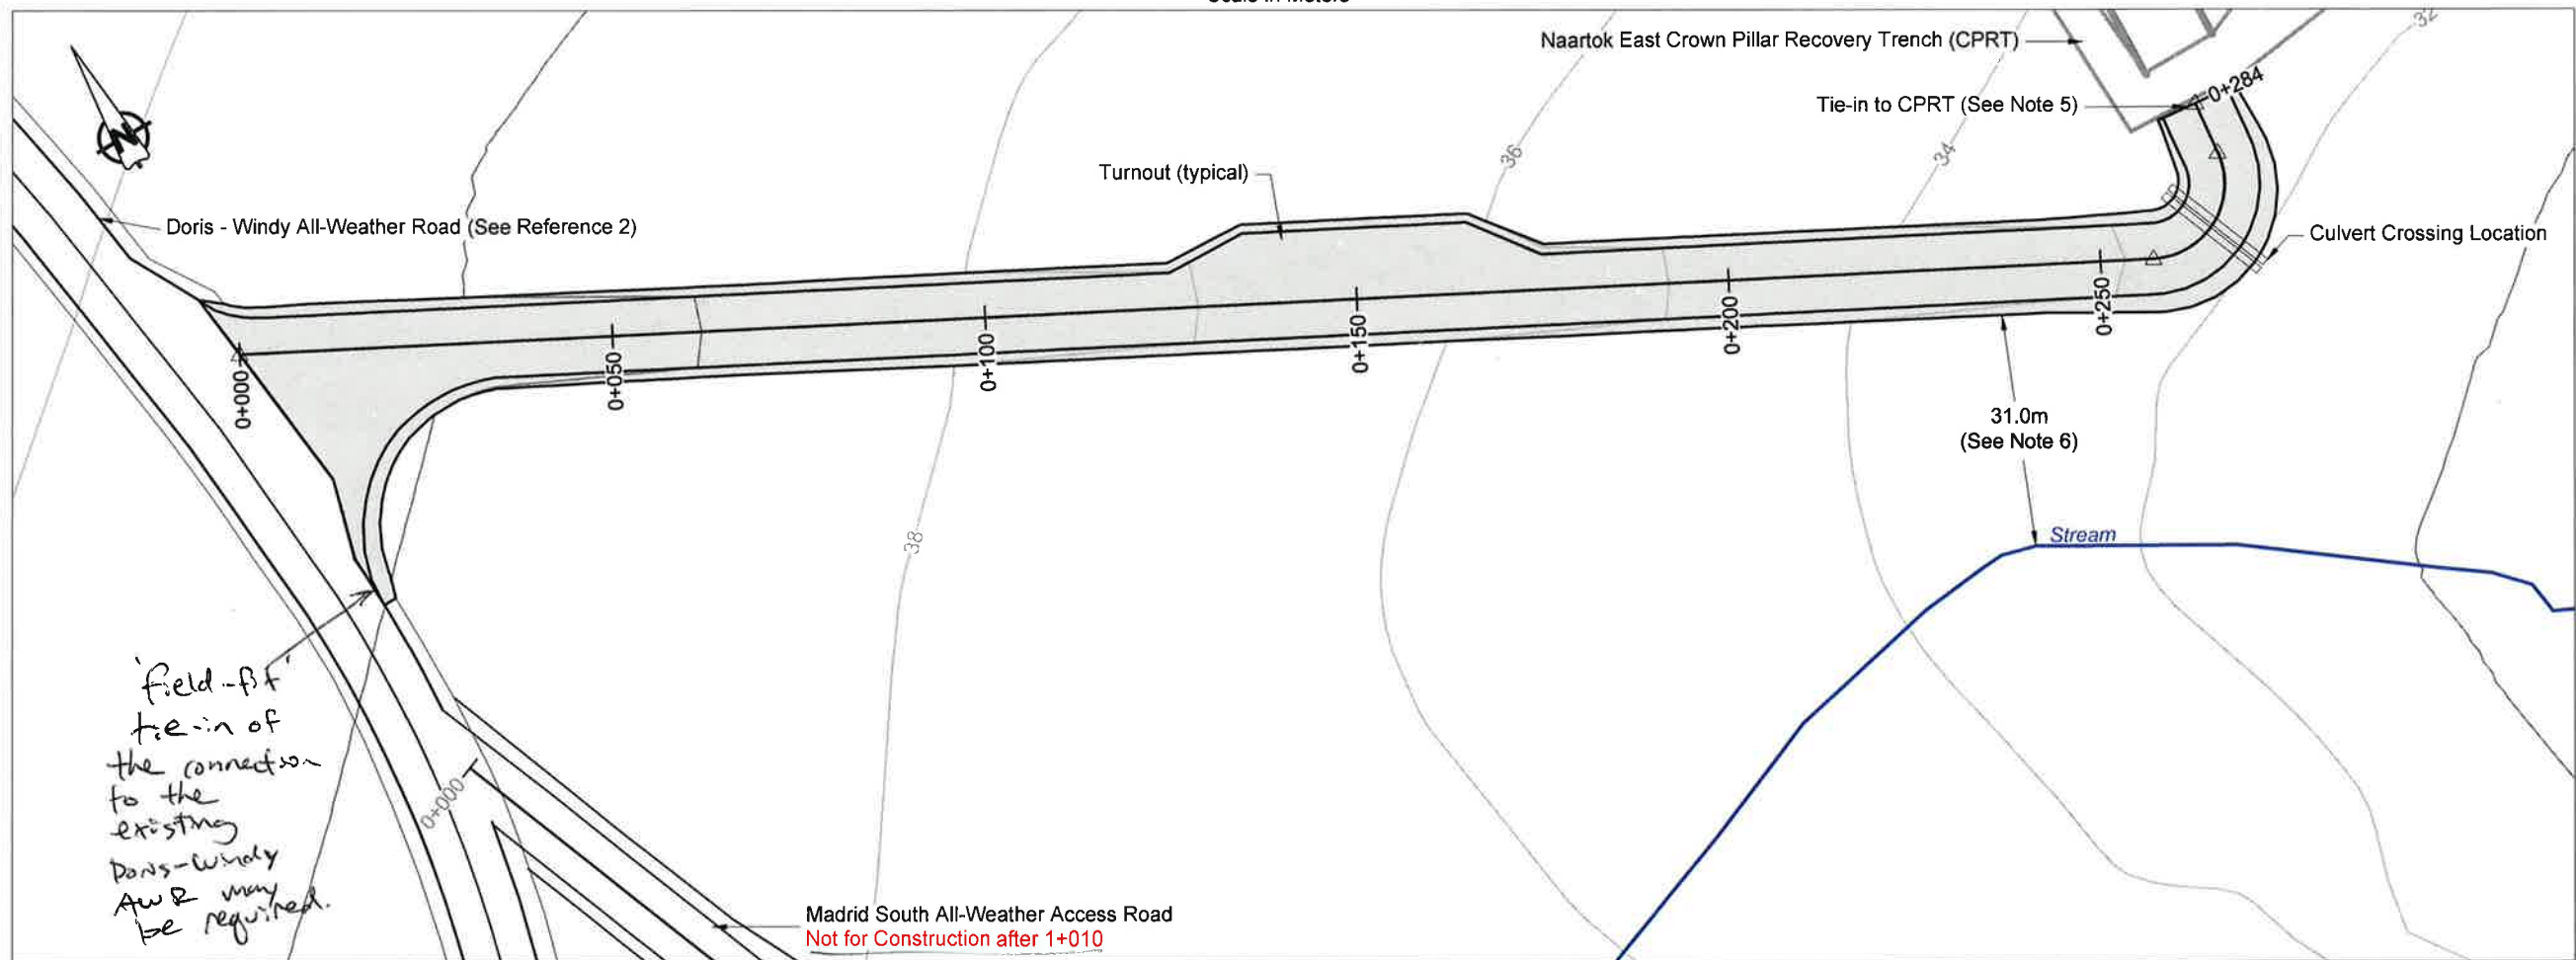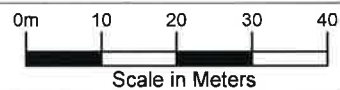

PLAN VIEW
NAARTOK EAST CPRT ACCESS ROAD

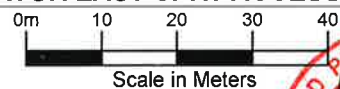

LEGEND

- △ Point of Intersection
- Route Centerline
- Road Alignment
- ▬ Crossing Location

PROFILE LEGEND

- △ Point of Intersection
- 4.1% Grade
- Turnout Location; not to scale
(See Drawing MSR-08 for Typical Layout)

NOTES

- Contours shown at 2.0m intervals.
- All units shown in meters unless otherwise specified.
- Construction and material specifications shall be in accordance with the following Technical Specifications: Earthworks and Geotechnical Engineering. Hope Bay Project, Nunavut, Canada. Revision H - Issued for Construction.
- Naartok East CPRT design provided by TMAC Resources.
- Access road tie-in to be optimized based on final CPRT design.
- A minimum 31.0m setback from streams and shorelines is required.

REFERENCES

- NAD83 UTM Zone 13.
- Engineering Drawings for the Doris-Windy All-Weather Road, Doris Infrastructure Project, Nunavut, Canada. Revision AB1. As-Built Drawings prepared for Hope Bay Mining Ltd. Project Number: 1CH008.033/058. May 11, 2012.

ROAD CONSTRUCTION ZONES TABLE:

Fill Zone 1	1.0m min. Overall Road Thickness with 1.5H:1V Side Slopes
Fill Zone 2	1.5m min. Overall Road Thickness with 1.5H:1V Side Slopes
Fill Zone 3	2.0m min. Overall Road Thickness with 2H:1V Side Slopes
Bedrock Zone	0.3m min. Road Thickness (ROQ not required) Side Slopes to be determined in the field

P:\01 SITE\Shape Base\ACAD\FC\Madrid Access Roads\1CT022.043 - AR-PP.dwg

DRAWING NO.	DRAWING TITLE	NO.	DESCRIPTION	CHKD.	APPD.	DATE	NO.	DESCRIPTION	CHKD.	APPD.	DATE
0	Issued for Construction	RW	EMR	18Mar19							
A	Issued for Discussion	RW	EMR	5Mar19							
REVISIONS											



srk consulting

DESIGN: RW
CHECKED: RW
DRAWN: TAH
APPROVED: EMR
REVIEWED: RW
DATE: March 18, 2019

TMAC
RESOURCES

HOPE BAY PROJECT

FILE NAME: 1CT022.043 - AR-PP.dwg

SRK JOB NO.: 1CT022.036

Madrid South All-Weather Road

DRAWING TITLE:
Naartok East CPRT
Access Road Plan and Profile

DRAWING NO.: MSR-18
SHEET 18 OF 18
REVISION NO. 0

Attachment 1.2 Madrid South All-Weather Road – As-built Drawings

Engineering Drawings for the Madrid South All-Weather Road (0 - 1km), Hope Bay Project, Nunavut, Canada

ACTIVE DRAWING STATUS

DWG NUMBER	DRAWING TITLE	REVISION	DATE	STATUS
MSR-00	Engineering Drawings for the Madrid South All-Weather Road, Hope Bay Project, Nunavut, Canada	AB1	Mar. 31, 2020	As-Built
MSR-01	General Arrangement (with Orthophoto)	AB1	Mar. 31, 2020	As-Built
MSR-02	General Arrangement	AB1	Mar. 31, 2020	As-Built
MSR-03	Road Alignment Plan and Profile (1 of 5)	AB1	Mar. 31, 2020	As-Built
MSR-04	Road Alignment Plan and Profile (2 of 5)	A	Mar. 14, 2014	Issued For Discussion
MSR-05	Road Alignment Plan and Profile (3 of 5)	A	Mar. 14, 2014	Issued For Discussion
MSR-06	Road Alignment Plan and Profile (4 of 5)	A	Mar. 14, 2014	Issued For Discussion
MSR-07	Road Alignment Plan and Profile (5 of 5)	D	Mar. 14, 2014	Issued For Discussion
MSR-08	Typical Road and Crossing Details	AB1	Mar. 31, 2020	As-Built
MSR-09	Animal Crossings Plan and Sections	AB1	Mar. 31, 2020	As-Built
MSR-10	Crossing #1 - Bridge Option - Plan, Section and Detail (1 of 2)	A	Mar. 14, 2014	Discontinued (Removed)
MSR-11	Crossing #1 - Bridge Option - Plan, Section and Detail (2 of 2)	A	Mar. 14, 2014	Discontinued (Removed)
MSR-12	Crossing #1 - Arch Culvert Option	A	Mar. 14, 2014	Discontinued (Removed)
MSR-13	Crossing #2 - Arch Culvert	A	Mar. 14, 2014	Discontinued (Removed)
MSR-14	Typical Arch Culvert Plan and Profile (1 of 2)	A	Mar. 14, 2014	Discontinued (Removed)
MSR-15	Typical Arch Culvert Details (2 of 2)	A	Mar. 14, 2014	Discontinued (Removed)
MSR-16	Material List and Quantity Estimates	B	Aug. 5, 2014	Discontinued (Removed)
MSR-17	Madrid North Waste Rock Access Road Plan and Profile	AB1	Mar. 31, 2020	As-Built
MSR-18	Naartok East CPRT Access Road Plan and Profile	AB1	Mar. 31, 2020	As-Built
MSR-19	Typical Road Fill Comparison Sections	AB1	Mar. 31, 2020	As-Built



Project No: 1CT022.055
March 31, 2020
Drawing MSR-00

NOTES

1. Topographic contour data for the terrain model were provided by Hope Bay Mining, and is based on 2007 Aerial Photography. Contour intervals are 0.5m.
2. The co-ordinate system is UTM NAD 83, Zone 13.
3. All dimensions are in metric units, unless specifically mentioned.
4. All drawings are scaled appropriately for D-Size construction drawings. Scales may not be correct if these drawings are reproduced and presented in any other size format.
5. Construction and material specifications shall be in accordance with the following Technical Specifications: Earthworks and Geotechnical Engineering. Hope Bay Project, Nunavut, Canada. Revision H - Issued for Construction. SRK (2018).
6. Only the first kilometer of the Madrid South All-Weather Road was constructed in 2019.
7. Only the as-built information for the Madrid South All-Weather Road (AWR) from 0 to 1km are shown in this drawing package. The 2019 construction summary report should be consulted for the as-built information for the other areas at Madrid (See Reference 5).

MATERIALS LIST AND QUANTITIES (0-1km)

Run of Quarry or Run of Mine Material

- Madrid South AWR (0 to 1 km): 29,260m³
- Madrid South AWR (0 to 1 km): 26,420m³
- Madrid North WRP Access Road: 4,030m³
- Madrid North WRP Access Road: 3,320m³
- Naartok East CPRT Access Road: 3,220m³
- Naartok East CPRT Access Road: 5,640m³

**ROQ / ROM volumes reported are bulk quantities calculated to neat lines. No bulking / shrinking factors have been utilized in volume determination. Losses into the tundra are not accounted for


Surfacing Material

- Madrid South AWR (0 to 1 km) : 1,220m³
- Madrid South AWR (0 to 1 km) : 1,720m³
- Madrid North WRP Access Road: 370m³
- Madrid North WRP Access Road: 290m³
- Naartok East CPRT Access Road: 350m³
- Naartok East CPRT Access Road: 490m³

**Surfacing Material volumes based on crest width, crest length and surfacing thickness. No allowances have been made for surfacing material fill around culverts or for transitions from ROQ / ROM fill over permafrost to surfacing material over bedrock.

Culverts

1.0m Diameter Corrugated Steel Pipe: 4

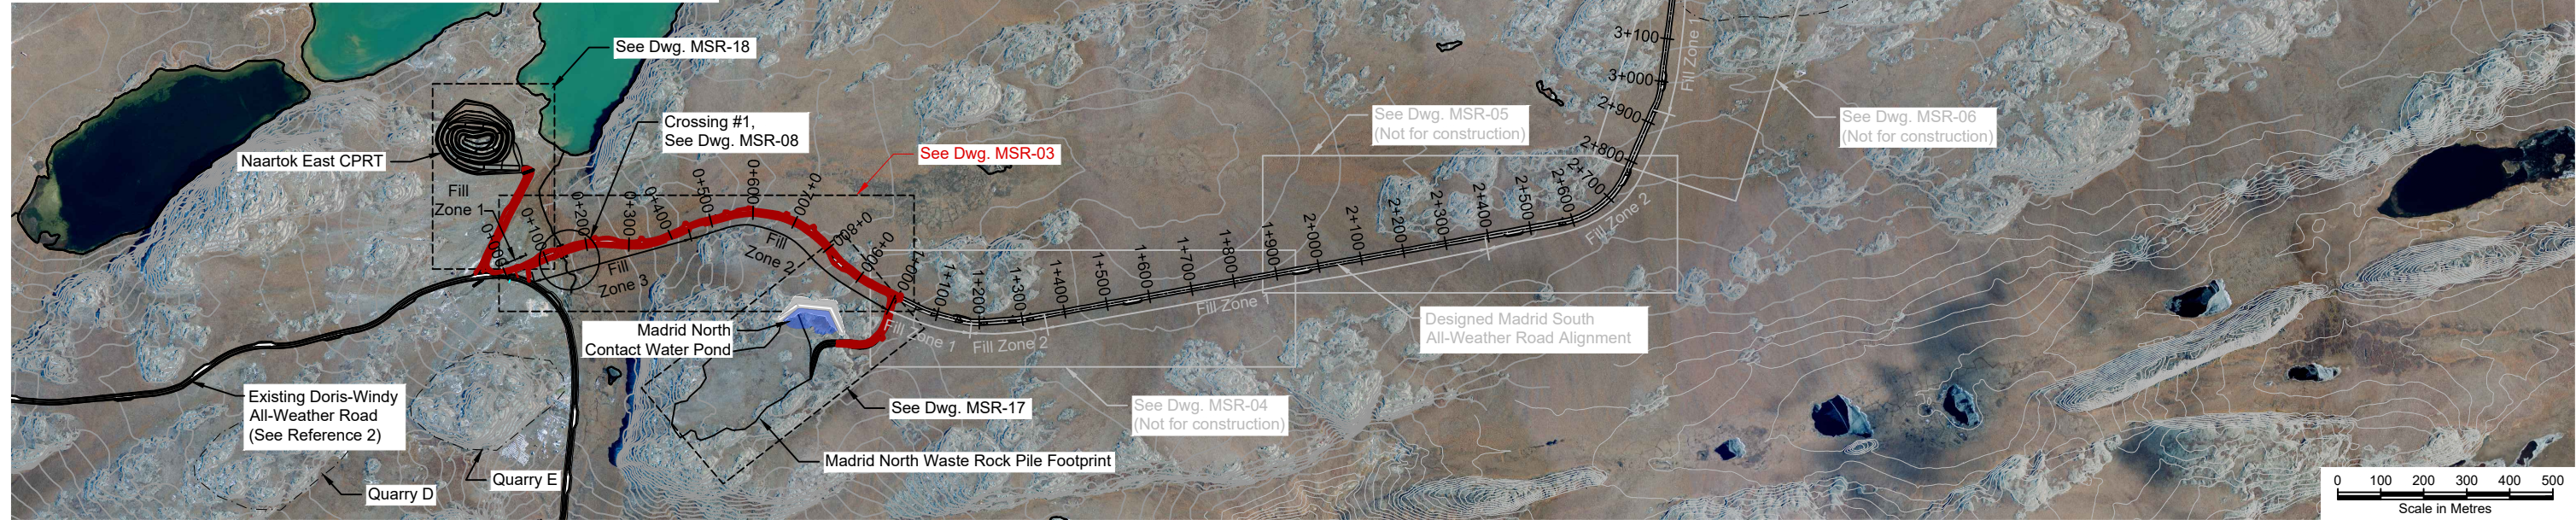

LEGEND

- Existing Approved and Permitted Quarry
- Proposed Development Quarry
- Road Alignment
- + 1+000

 Route Centerline
- 2019 As-Constructed Infrastructure

ROAD CONSTRUCTION ZONES TABLE:

Fill Zone 1	1.0m min. Overall Road Thickness with 1.5H:1V Side Slopes
Fill Zone 2	1.5m min. Overall Road Thickness with 1.5H:1V Side Slopes
Fill Zone 3	2.0m min. Overall Road Thickness with 2.0H:1V Side Slopes
Bedrock Zone	0.3m min Road Thickness (ROQ not required) with Side Slopes to be determined in the field

REFERENCES

1. Engineering drawings for the Madrid South Surface Infrastructure, Hope Bay Project, Nunavut, Canada. Issued for Discussion. Revision F. Project No. 1CT022.001. October 31, 2014.
2. Engineering Drawings for the Doris-Windy All-Weather Road, Doris Infrastructure Project, Nunavut, Canada. Revision AB1. As-Built Drawings Prepared for Hope Bay Mining Ltd. Project Number: 1CH008.033/.058. May 11, 2012.
3. Geochemical Characterization of Quarry Materials for the Doris-Windy All-Weather Road, Hope Bay Project. Report prepared for Hope Bay Mining Ltd. 1CH008.000. August 2008.
4. As-built data provided by Sub-Arctic Geomatics Ltd. File: 0527-MS+NAART RD AB.dwg. May 27, 2019.
5. Doris and Madrid 2019 Construction Summary Report. Hope Bay Project. Memo prepared for TMAC Resources. Project Number 1CT022.055. April 2020

P:\Projects\01_SITES\Hope Bay\ACAD\As-Built\Madrid Access Roads\Str 0 to 1000\1CT022.043 Madrid South_all weather road.dwg

											Madrid South All-Weather Road		
								DRAWING TITLE:			Madrid South All-Weather Access Road General Arrangement (with Orthophoto)		
								DRAWING NO.			MSR-01		
								SHEET			2 OF 19		
								REVISION NO.			AB1		

DRAWING NO.	DRAWING TITLE	DRAWING NO.	DRAWING TITLE
REFERENCE DRAWINGS		REVISIONS	

AB1	As-Built	RW	JBK	31Mar20
D	Issued for Construction	RW	EMR	18Mar19
D	Issued for Discussion	RW	EMR	5Mar19
C	Minor Edits	LW	EMR	31Oct14
B	Issued for Discussion	LW	EMR	5Aug14
A	Issued for Discussion	JK	EMR	14Mar14
NO.	DESCRIPTION	CHKD	APPD	DATE


PROFESSIONAL ENGINEERS STAMP		FILE NAME: 1CT022.043 Madrid South_all weather road.dwg		SRK JOB NO.: 1CT022.001	
------------------------------	--	---	--	-------------------------	--

HOPE BAY PROJECT		
DESIGN:	RW	DRAWN: NV/TAH
CHECKED:	RW	APPROVED: JBK
		REVIEWED: RW
		DATE: March 31, 2020

REGISTERED PROFESSIONAL ENGINEER R.C. WILLIAMS LICENSEE NTNU		srk consulting		TMAC RESOURCES	
---	--	----------------	--	----------------	--

NOTES

1. Topographic contour data for the terrain model were provided by Hope Bay Mining, and is based on 2007 Aerial Photography. Contour intervals are 0.5m.
2. The co-ordinate system is UTM NAD 83, Zone 13.
3. All dimensions are in metric units, unless specifically mentioned.
4. All drawings are scaled appropriately for D-Size construction drawings. Scales may not be correct if these drawings are reproduced and presented in any other size format.
5. Construction and material specifications shall be in accordance with the following Technical Specifications: Earthworks and Geotechnical Engineering. Hope Bay Project, Nunavut, Canada. Revision H - Issued for Construction. SRK (2018).
6. Only the first kilometer of the Madrid South All-Weather Road was constructed in 2019.
7. Only the as-built information for the Madrid South All-Weather Road (AWR) from 0 to 1km are shown in this drawing package. The 2019 construction summary report should be consulted for the as-built information for the other areas at Madrid (See Reference 5).

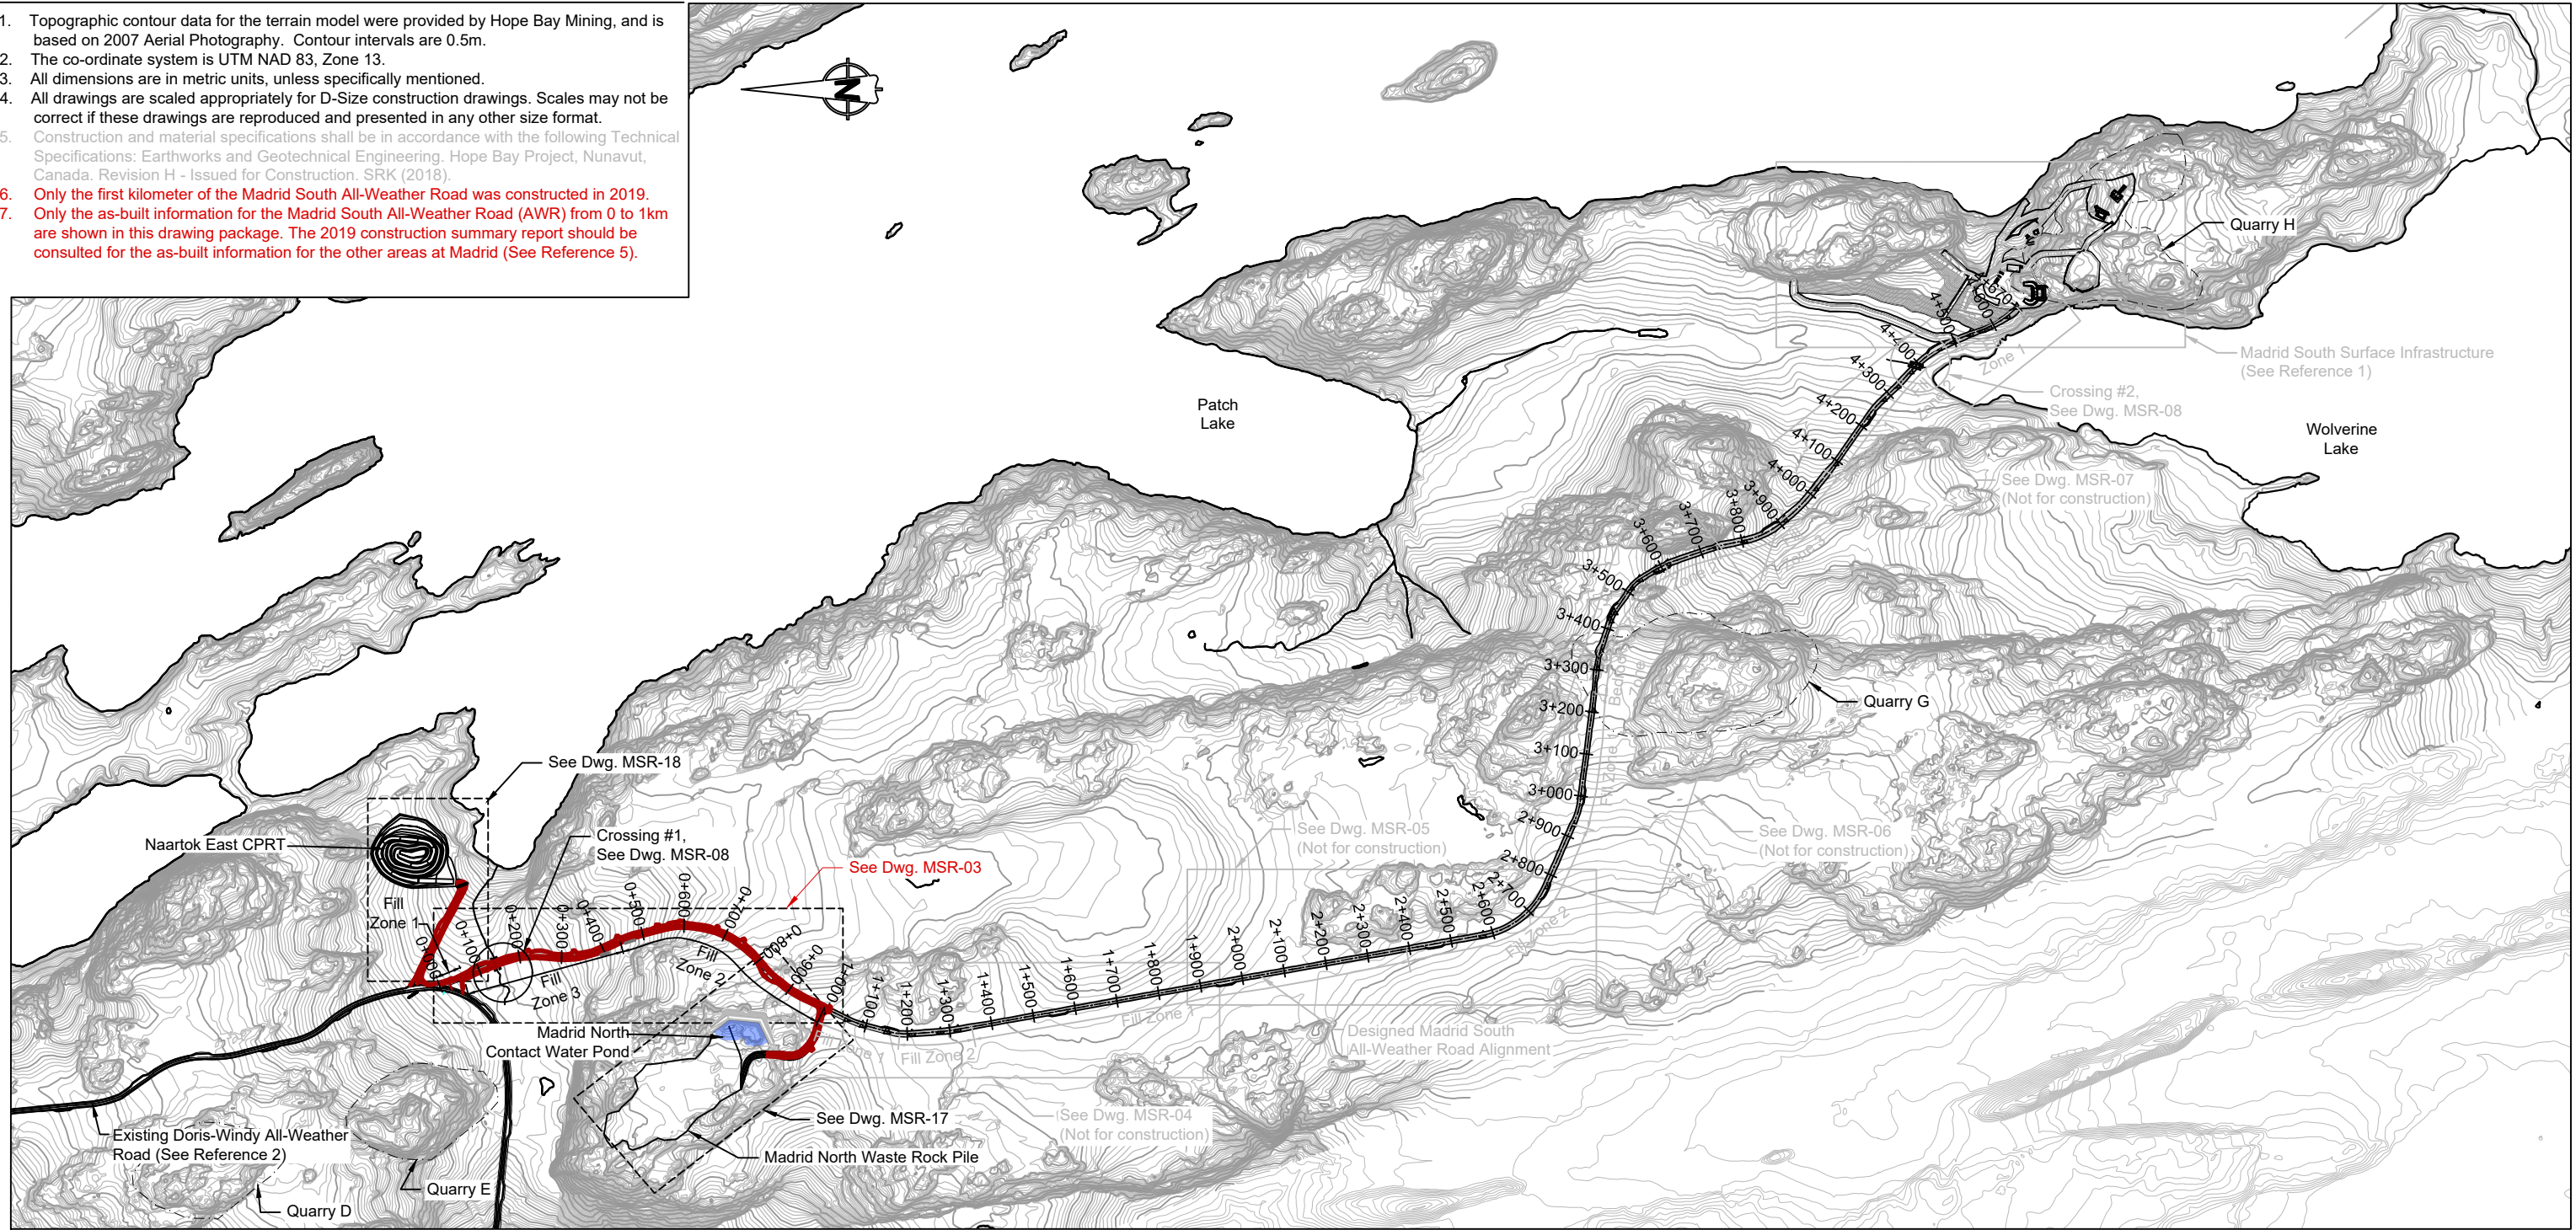

LEGEND


- Existing Approved and Permitted Quarry
- Proposed Development Quarry
- Road Alignment
- Route Centerline
- 2019 As-Constructed Infrastructure

ROAD CONSTRUCTION ZONES TABLE:

Fill Zone 1	1.0m min. Overall Road Thickness with 1.5H:1V Side Slopes
Fill Zone 2	1.5m min. Overall Road Thickness with 1.5H:1V Side Slopes
Fill Zone 3	2.0m min. Overall Road Thickness with 2.0H:1V Side Slopes
Bedrock Zone	0.3m min Road Thickness (ROQ not required) with Side Slopes to be determined in the field



REFERENCES

1. Engineering drawings for the Madrid South Surface Infrastructure, Hope Bay Project, Nunavut, Canada. Issued for Discussion. Revision F. Project No. 1CT022.001. October 31, 2014.
2. Engineering Drawings for the Doris-Windy All-Weather Road, Doris Infrastructure Project, Nunavut, Canada. Revision AB1. As-Built Drawings Prepared for Hope Bay Mining Ltd. Project Number: 1CH008.033/.058. May 11, 2012
3. Geochemical Characterization of Quarry Materials for the Doris-Windy All-Weather Road, Hope Bay Project. Report prepared for Hope Bay Mining Ltd., 1CH008.000. August 2008.
4. As-built data provided by Sub-Arctic Geomatics Ltd. File: 0527-MS+NAART RD AB.dwg. May 27, 2019.
5. Doris and Madrid 2019 Construction Summary Report. Hope Bay Project. Memo prepared for TMAC Resources. Project Number 1CT022.055. April 2020.

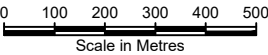


P:\Projects\01_SITES\Hope Bay\ACAD\As-Built\Madrid Access Roads\Stn 0 to 1000\1CT022.043 Madrid South_all weather road.dwg

																																																																																																																																																																																																																																																																																																																																																																																																																																																																																																																																																																																																																																																																																																																																																																																																																																																																																																																																																																																																																																																																																																																																																																																																																																																																																																																																																																																																																					</
--	--	----

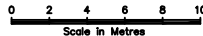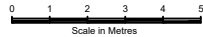

1. All dimensions in metres unless noted otherwise.
2. Minimum design thickness must be maintained for all sections of the all-weather road including turnouts. See Drawings MSR-01 for fill zone chainage intervals.
3. As-built culverts are 300 mm diameter corrugated steel culverts. A total of three culverts were installed, and the third culvert was installed on an angle to the road approximately 10m north of the two parallel culverts as shown in as-built Detail 6.
4. Road constructed as per design with the exception of some road segment not 'crowned' in the middle. See drawing MSR-19 for additional as-built details.
5. Location of the culverts are based on the as-built polylines provided by Sub-Arctic. As-built linework provided is assumed to be the culvert centerline. The 0.3m diameter culverts were projected from this survey line. Survey of bedding material was not provided.

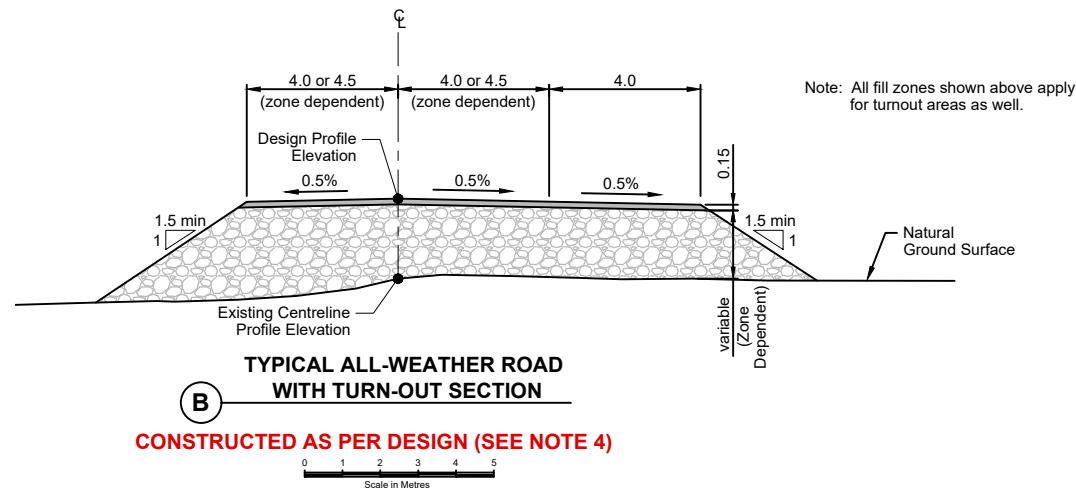

<h1 style="text-align: center;">Madrid South All-Weather Road</h1>		
<p>DRAWING TITLE:</p> <h2 style="text-align: center;">Typical Road and Crossing Details</h2>		
<p>DRAWING NO.</p> <h3 style="text-align: center;">MSR-08</h3>	<p>SHEET</p> <p style="text-align: center;">9 OF 19</p>	<p>REVISION NO.</p> <h3 style="text-align: center;">AB1</h3>

P:\Projects\01_SITES\Hope Bay\VCAD\As-Built\Madrid Access Roads\Sta 0 to 1000\1CT022.043 Madrid South plan_sections.dwg

LEGEND


Surfacing Material

Run of Quarry Material

NOTES


1. All dimensions in metres unless noted otherwise.

2. Locations for animal crossings will be identified by Land Owner and Elders once road construction is completed.


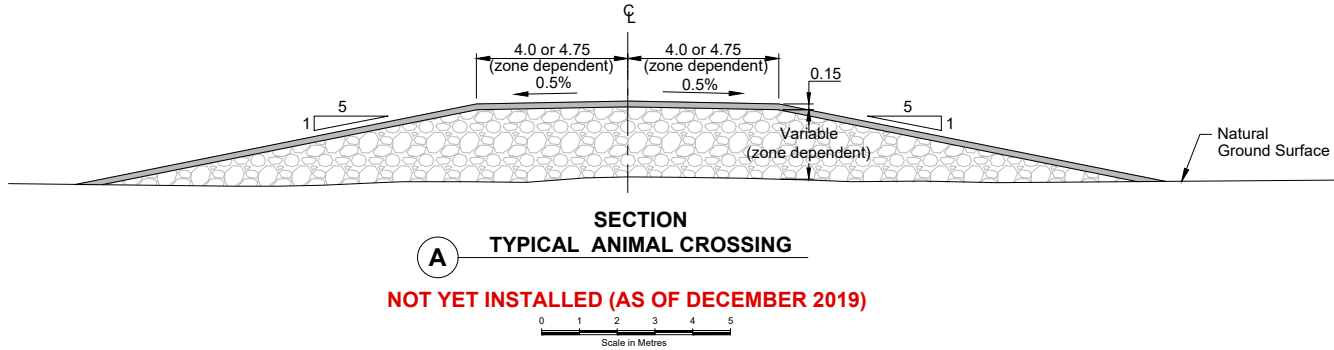


																																																																																																																																																																																																																																																																																																																																																																																																																																																																																																																																																																																																																																																																																																																																																																																																																																																																																																																																																																																																																																																																																																																																																																																																																																																																																																																																																																																																																					</
--	--	----



P:\Projects\01_SITES\Hope Bay\MCAD\As-Built\Madrid Access Roads\Sta 0 to 1000\1CT022.043 Madrid South plan_sections.dwg

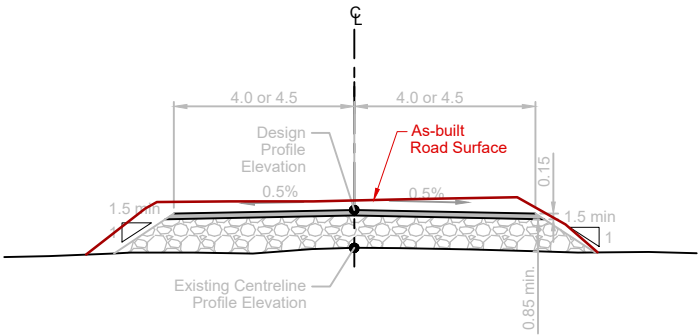


C TYPICAL ROAD FILL - Zone 1
See MSR-17 for section location

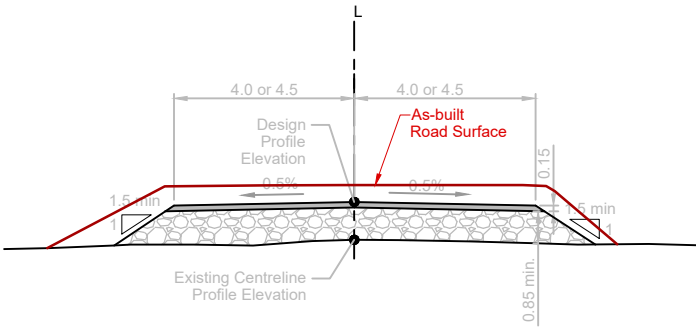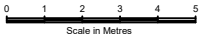


D TYPICAL ROAD FILL - Zone 1
See MSR-18 for section location

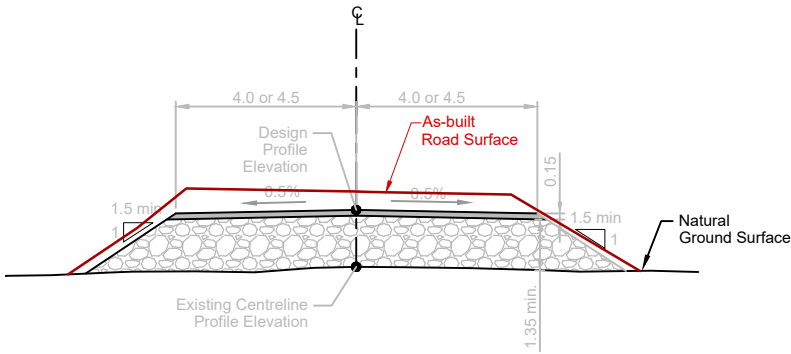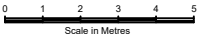

E ROAD FILL - Zone 2
See MSR-03 for section location

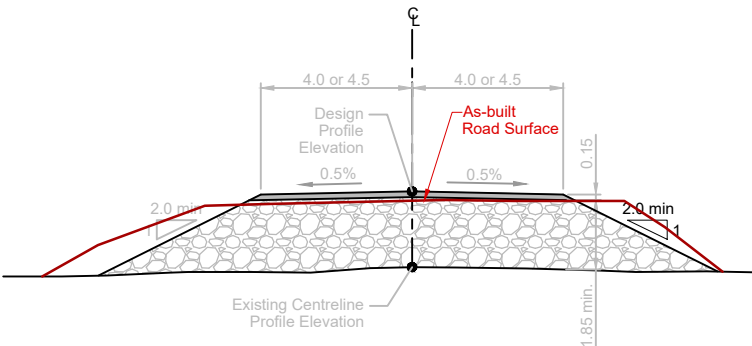

F TYPICAL ROAD FILL - Zone 3
See MSR-03 for section location

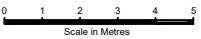

LEGEND

- Surfacing Material
- Run of Quarry Material
- 2019 As-Built Infrastructure

NOTES

- All dimensions in metres unless noted otherwise.
- Minimum design thickness must be maintained for all sections of the all-weather road including turnouts. See Drawings MSR-01 for fill zone chainage intervals.

DRAWING NO.	DRAWING TITLE	DRAWING NO.	DRAWING TITLE	AB1	As-Built	RW	JBK	31Mar30
				NO.	DESCRIPTION	CHKD	APPD	DATE
REFERENCE DRAWINGS				REVISIONS				



DESIGN: LW/RW	DRAWN: NV/TAH	REVIEWED: RW
CHECKED: RW	APPROVED: JBK	DATE: March 31, 2020

FILE NAME: 1CT022.043 Madrid South plan_sections.dwg



HOPE BAY PROJECT

SRK JOB NO.: 1CT022.001

Madrid South All-Weather Road

DRAWING TITLE:

Typical Road Fill Comparison

DRAWING NO.

MSR-19

SHEET

19 OF 19

REVISION NO.

AB1

Attachment 2 – Madrid North Contact Water Pond

Attachment 2.1 Madrid North Contact Water Pond – IFC Drawings

Engineering Drawings for the Madrid North Contact Water Pond Hope Bay Project, Nunavut, Canada

Active Drawing Status

Drawing Number	Drawing Title	Issue	Date	Revision
MN-CWP-01	General Arrangement (With Orthophoto)	Issued for Construction	March 19, 2019	0
MN-CWP-02	General Arrangement	Issued for Construction	March 19, 2019	0
MN-CWP-03	Contact Water Pond Anticipated Foundation Conditions Plan and Profile	Issued for Construction	March 19, 2019	0
MN-CWP-04	Contact Water Pond Plan and Profile	Issued for Construction	March 19, 2019	0
MN-CWP-05	Contact Water Pond Typical Sections	Issued for Construction	March 19, 2019	0
MN-CWP-06	Contact Water Pond Typical Details	Issued for Construction	March 19, 2019	0
MN-CWP-07	Liner Tie-in Typical Details	Issued for Construction	March 19, 2019	0





Signed and stamped copies
2019/04/02

A handwritten signature in black ink, appearing to read "John King", is written over the "srk consulting" logo.



Project Number: 1CT022.043

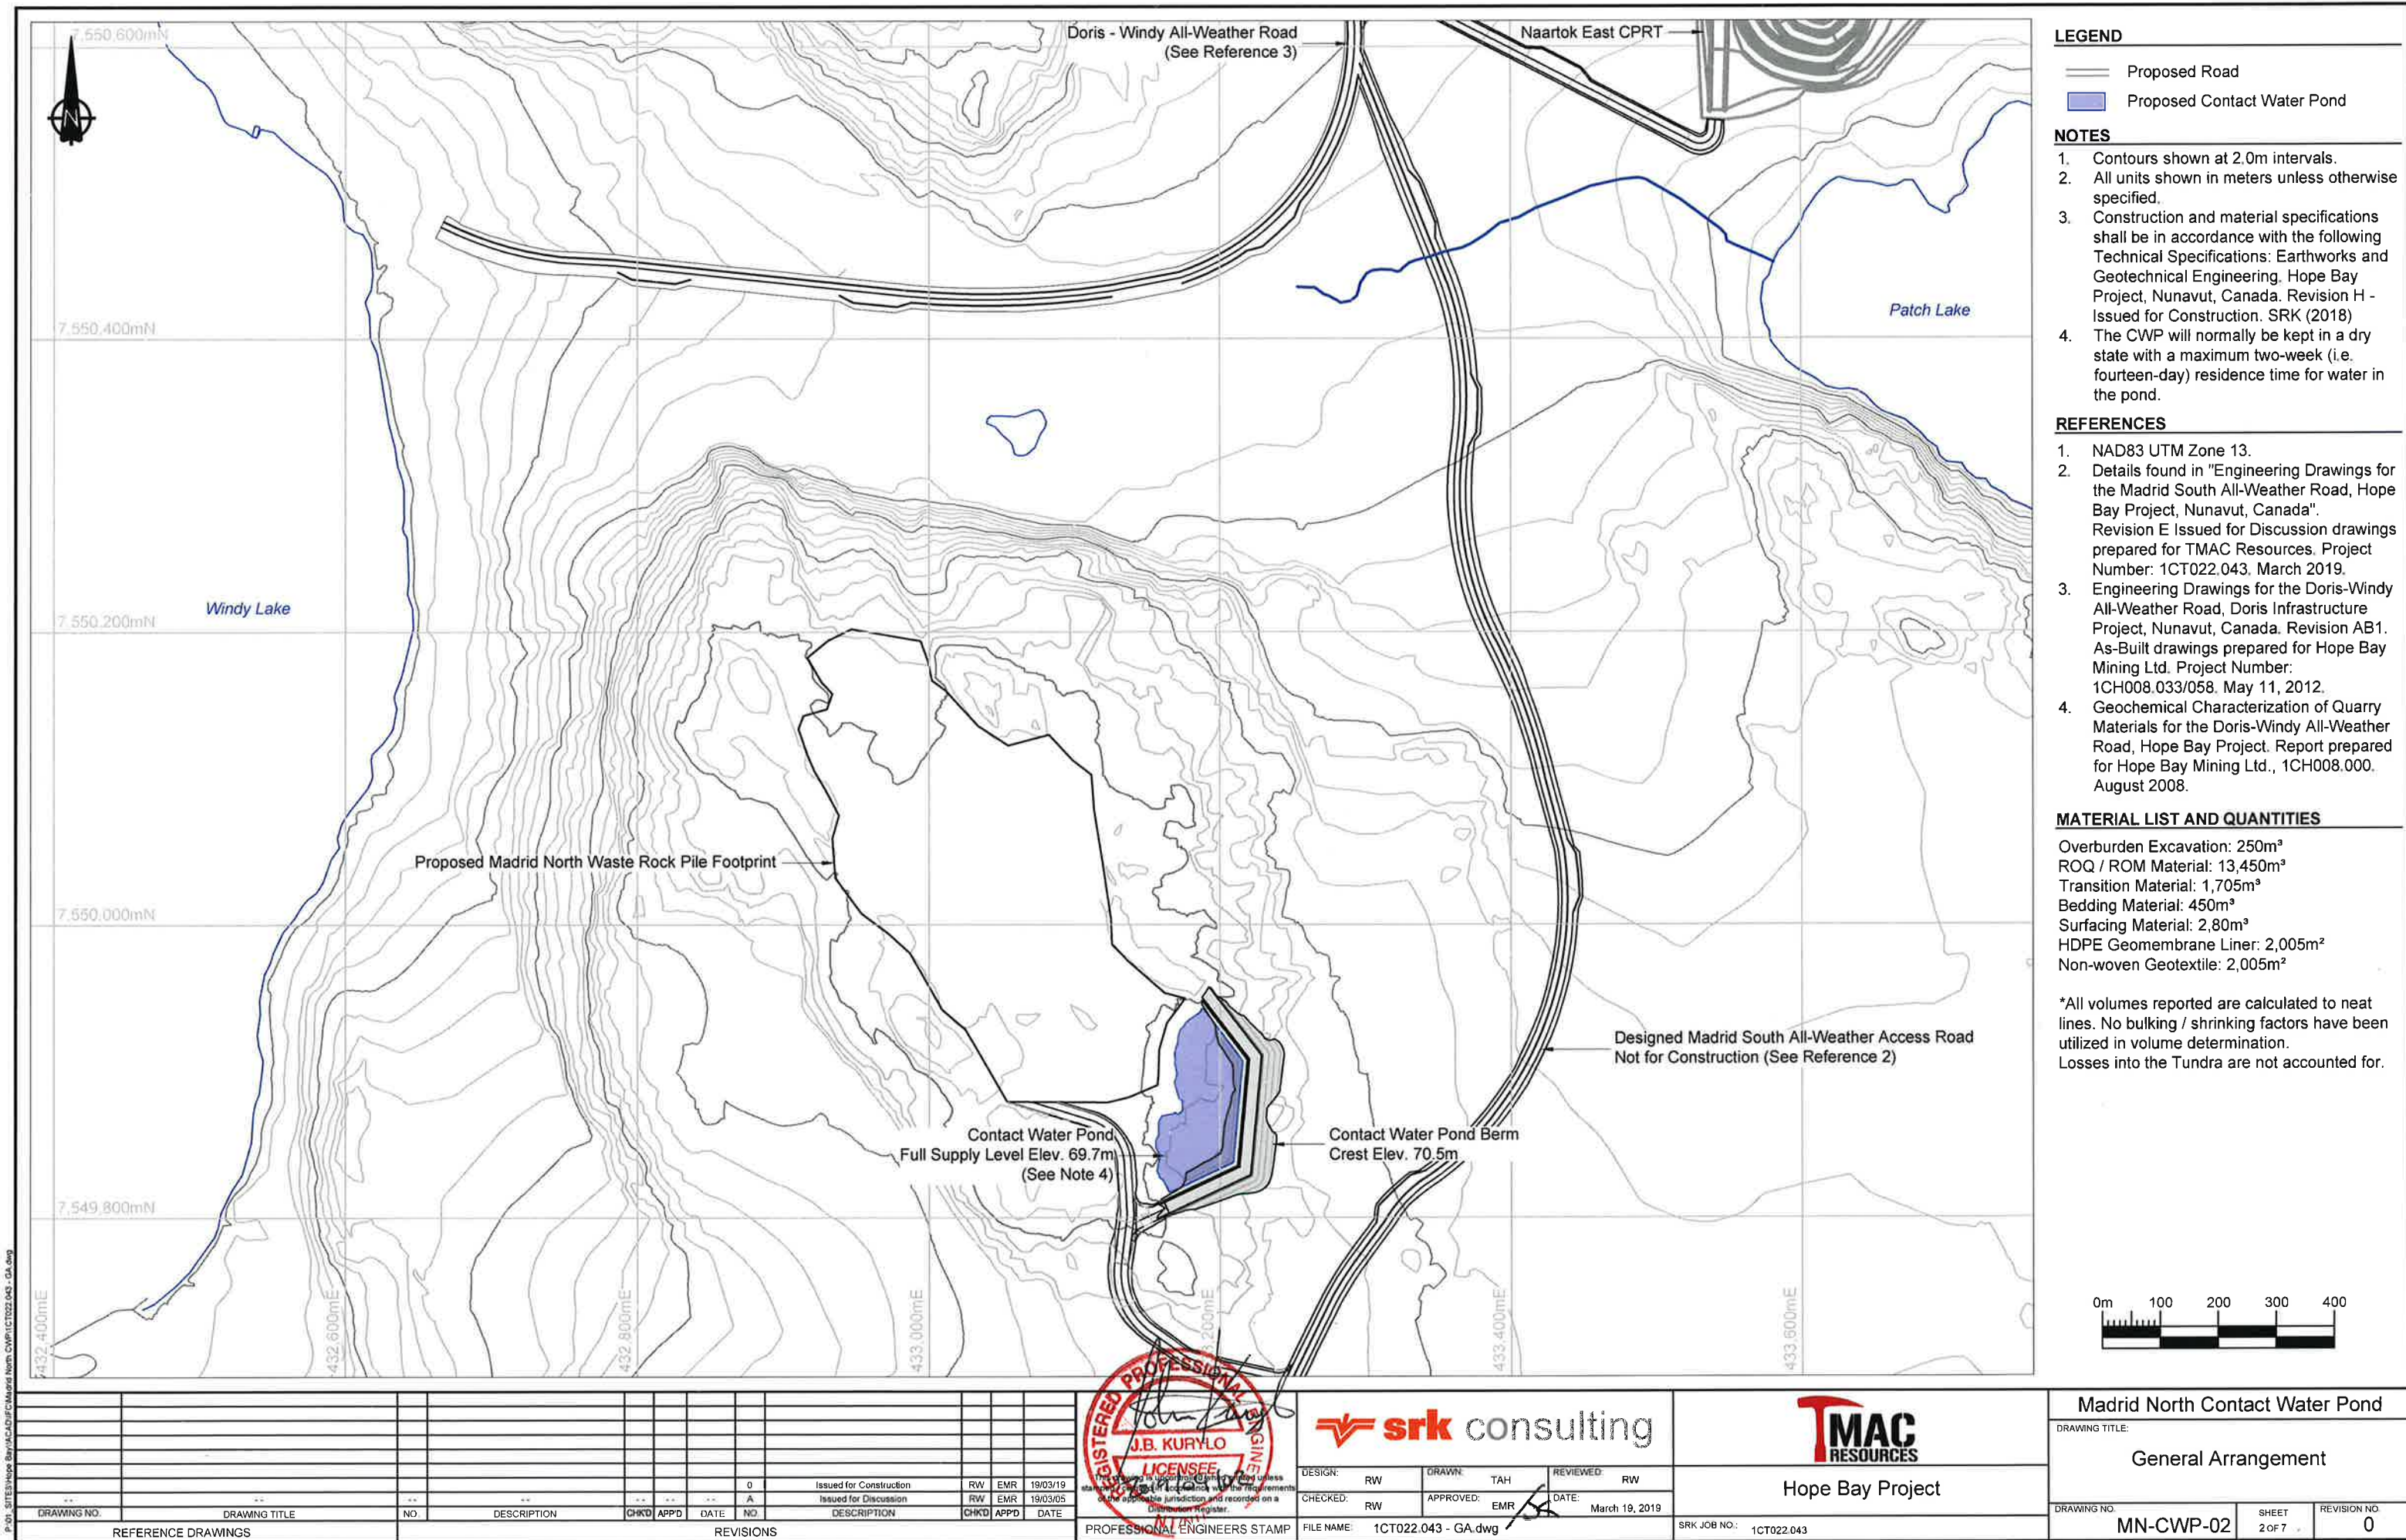

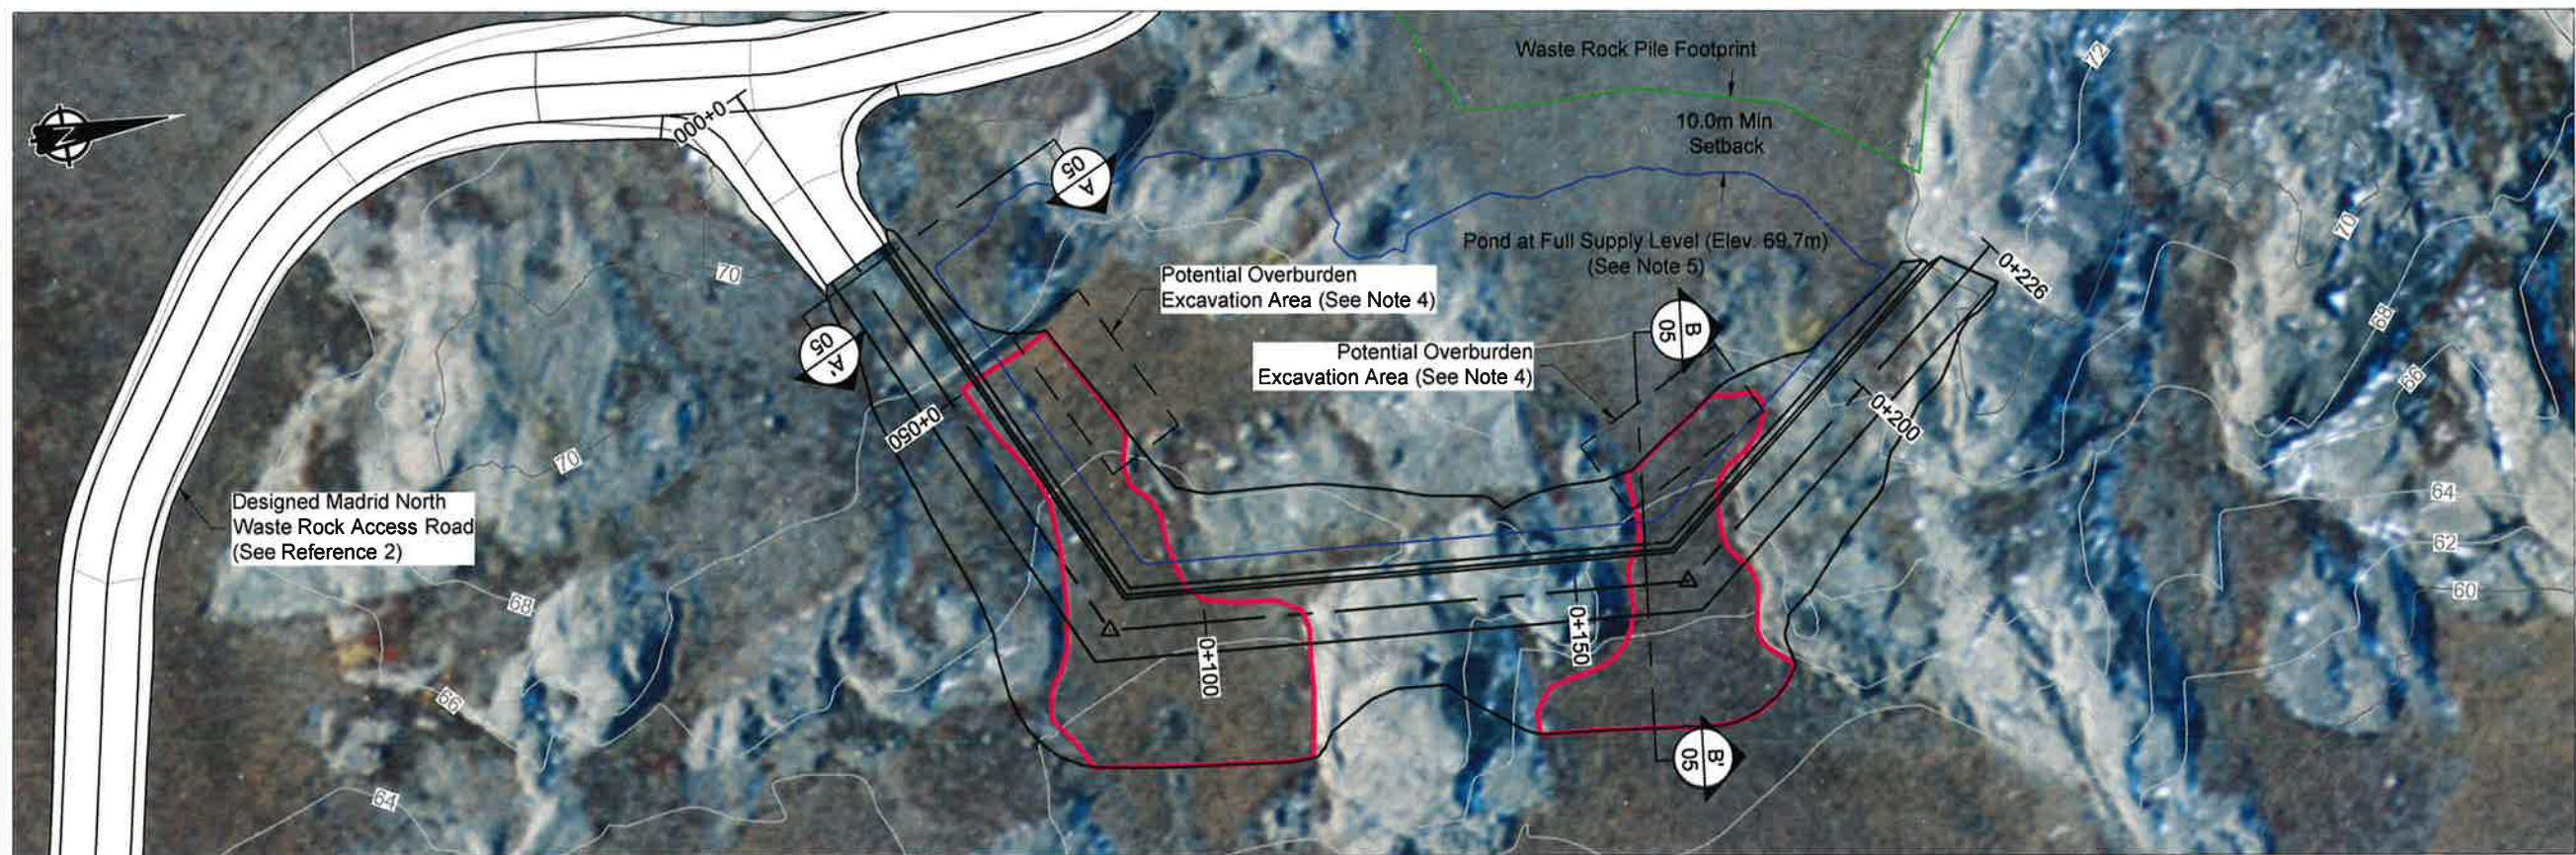

Contact Water Pond Berm Plan View

LEGEND


- Anticipated Overburden
- Contact Water Pond
- Contact Water Pond Berm
- Waste Rock Pile Footprint

NOTES

1. Contours shown at 2.0m intervals.
2. All dimensions shown in meters unless otherwise stated.
3. The majority of the CWP berm footprint is expected to encounter bedrock outcrop. However, based on aerial imagery overburden may be encountered in low-lying areas. *including tundra mat or organic*
4. If overburden is encountered at the upstream toe, it will be excavated to bedrock to allow liner to tie-in to the bedrock foundation.
5. The CWP will normally be kept in a dry state with a maximum two-week (i.e. fourteen-day) residence time for water in the pond.
6. Construction and material specifications shall be in accordance with the following Technical Specifications: Earthworks and Geotechnical Engineering. Hope Bay Project, Nunavut, Canada. Revision H - Issued for Construction. SRK (2018).

REFERENCES

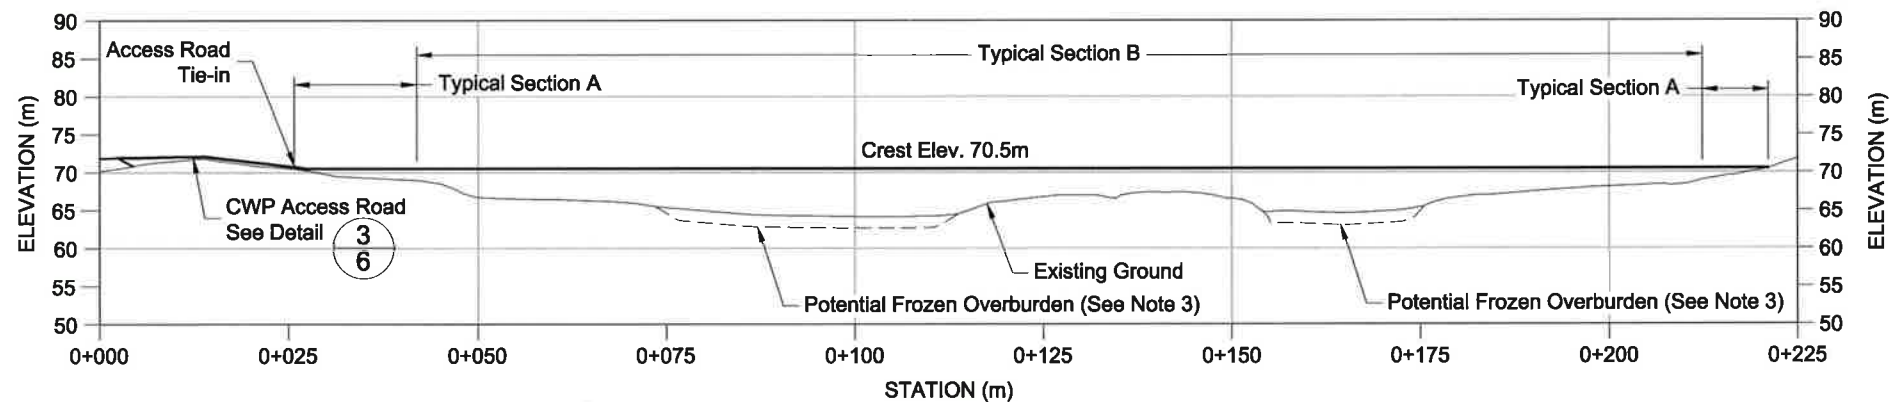


1. NAD83 UTM Zone 13.
2. Engineering Drawings for the Madrid South All-Weather Road, Hope Bay Project, Nunavut, Canada. Issued for Discussion. Revision A. Project No. 1CT022.043. March 2019.
3. Geochemical Characterization of Quarry Materials for the Doris-Windy All-Weather Road, Hope Bay Project. Report prepared for Hope Bay Mining Ltd., 1CH008.000. August 2008.




Contact Water Pond Berm Profile View



P:\01_SITES\Hope Bay\CAD\FC\Madrid North CWP\1CT022.043 - OB.dwg


																		Madrid North Contact Water Pond					
																		DRAWING TITLE: Contact Water Pond Anticipated Foundation Conditions Plan and Profile					
												DESIGN: RW		DRAWN: TAH		REVIEWED: RW		Hope Bay Project					
												CHECKED: RW		APPROVED: EMR		DATE: March 19, 2019							
REFERENCE DRAWINGS												PROFESSIONAL ENGINEERS STAMP		FILE NAME: 1CT022.043 - OB.dwg		SRK JOB NO.: 1CT022.043		DRAWING NO: MN-CWP-03		SHEET 3 OF 7		REVISION NO: 0	
REVISIONS																							

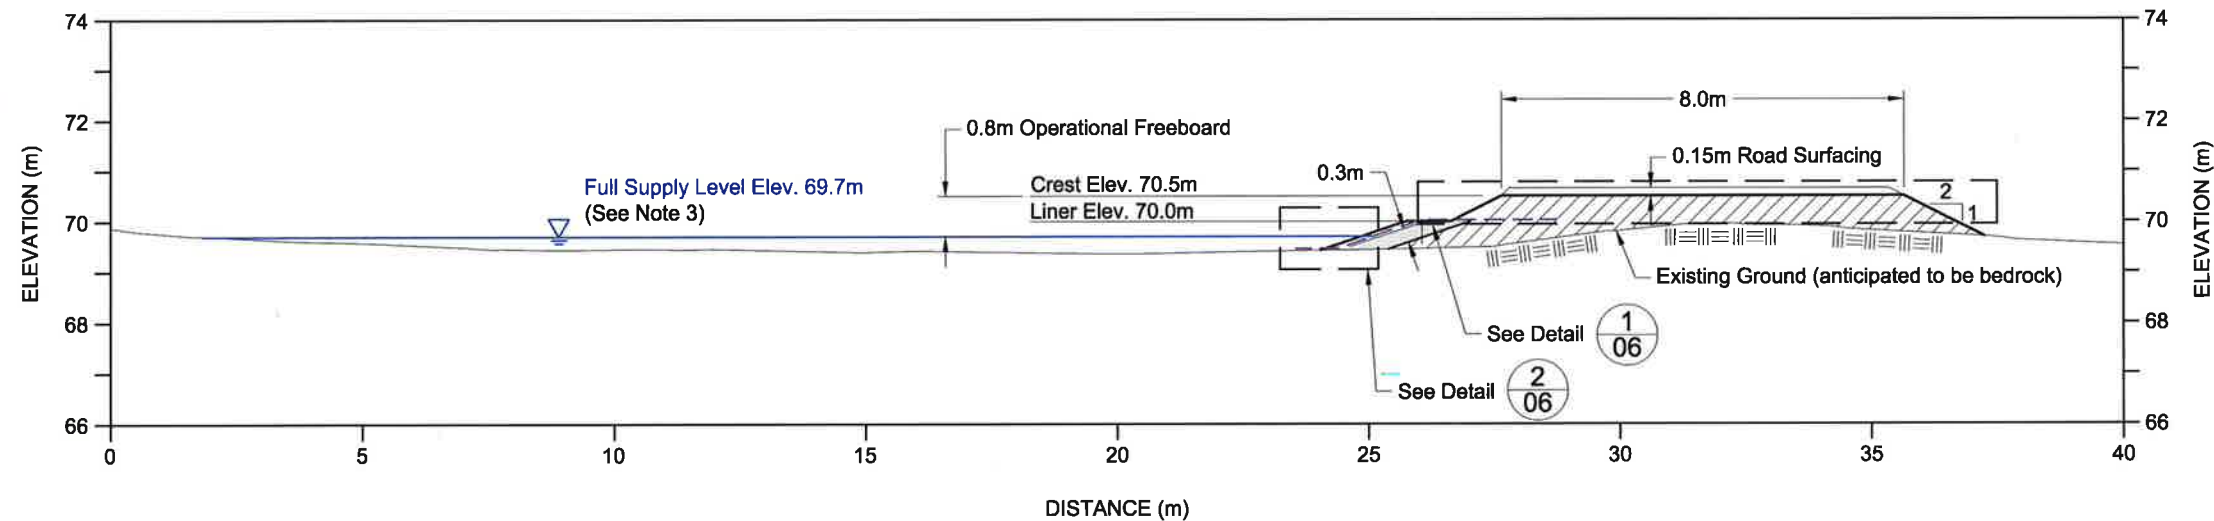


A
03 Cross Section A-A' - Berm Sections less than 1.5m

- LEGEND**
- Liner System
 - Bedding Material
 - Transition Material
 - Run of Quarry (ROQ) or Run of Mine (ROM) Material

- NOTES**
1. All dimensions shown in meters unless otherwise stated.
 2. If overburden is encountered at the upstream toe, it will be excavated to bedrock to tie-in to the bedrock foundation. Thickness of excavation will vary and will depend on conditions encountered. Excavation to be backfilled with bedding material if necessary to protect the liner tie-in.
 3. The CWP will normally be kept in a dry state with a maximum two-week (i.e. fourteen-day) residence time for water in the pond.
 4. Construction and material specifications shall be in accordance with the following Technical Specifications: Earthworks and Geotechnical Engineering. Hope Bay Project, Nunavut, Canada. Revision H - Issued for Construction. SRK (2018).
 5. Where the height of the berm exceeds 3.0m, safety berms or barriers are required on the crest. See Typical Berm Barrier Options on drawing MN-CWP-06.

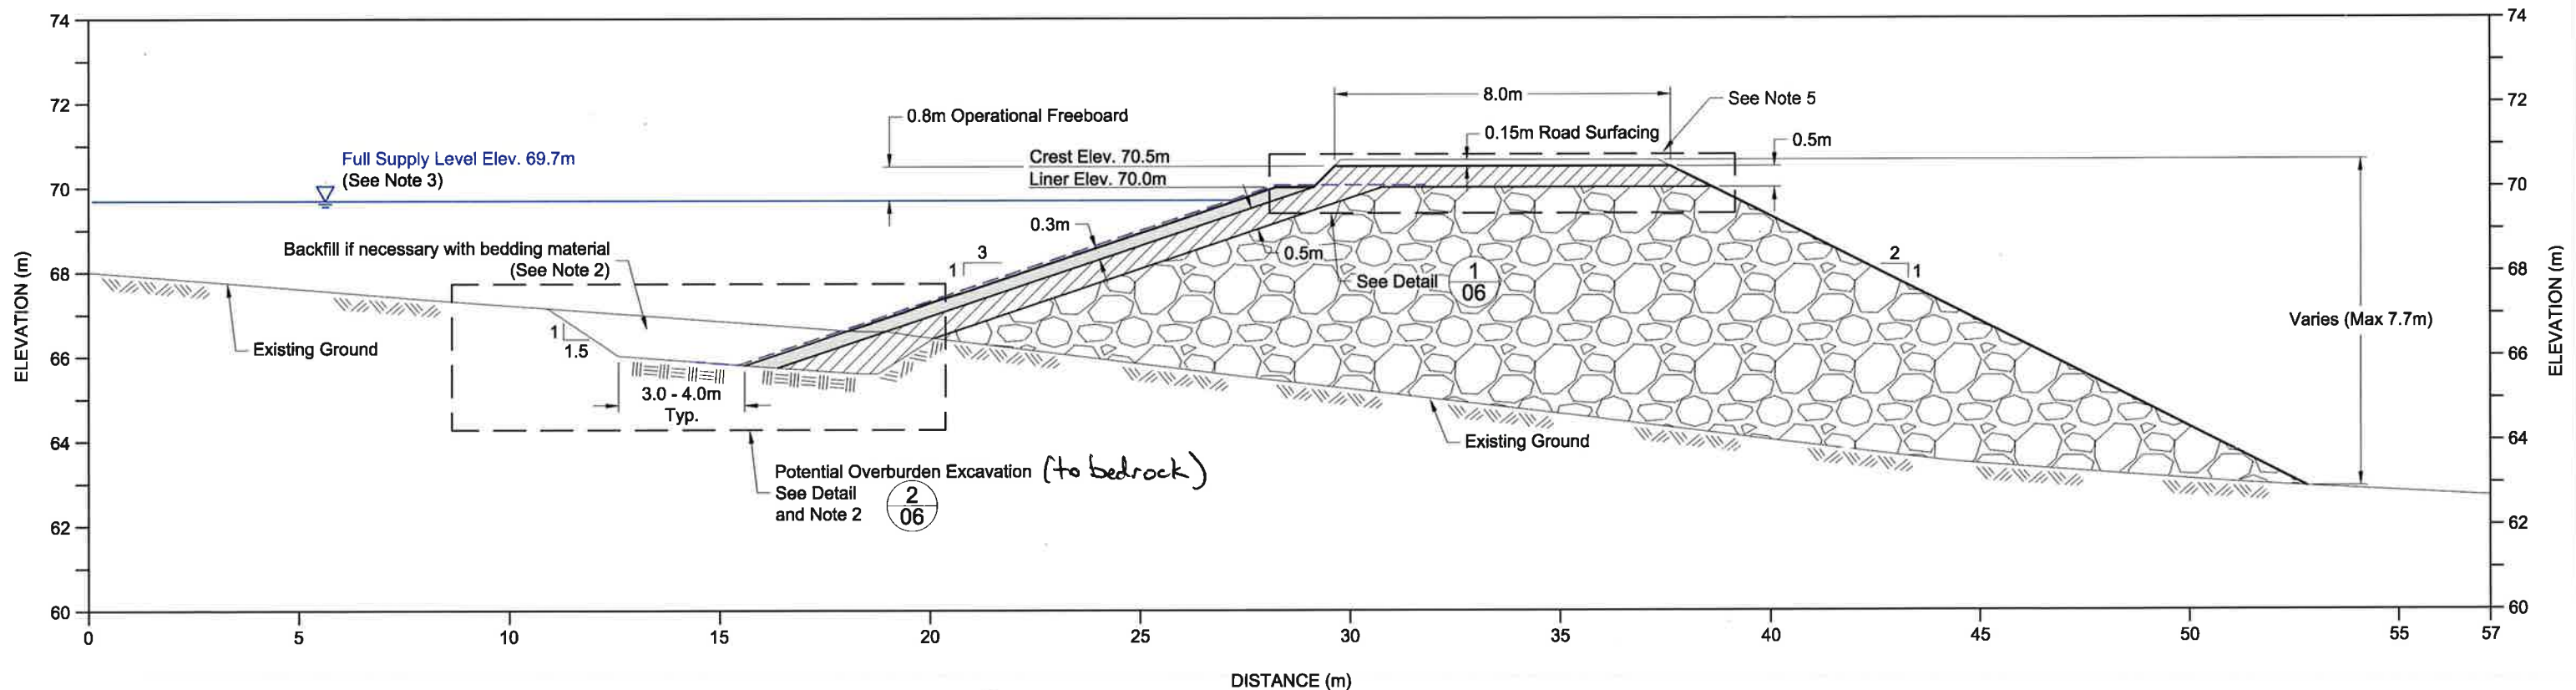


B
03 Cross Section B-B' - Berm Sections 1.5m or higher

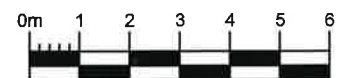


P:\01_SITES\Hope Bay\CAD\DWG\Contact Water Pond\1CT022.043 - PP.dwg


														Madrid North Contact Water Pond	
										Hope Bay Project		Contact Water Pond		Typical Sections	
										1CT022.043 - PP.dwg		MN-CWP-05		0	
										1CT022.043		5 of 7		0	

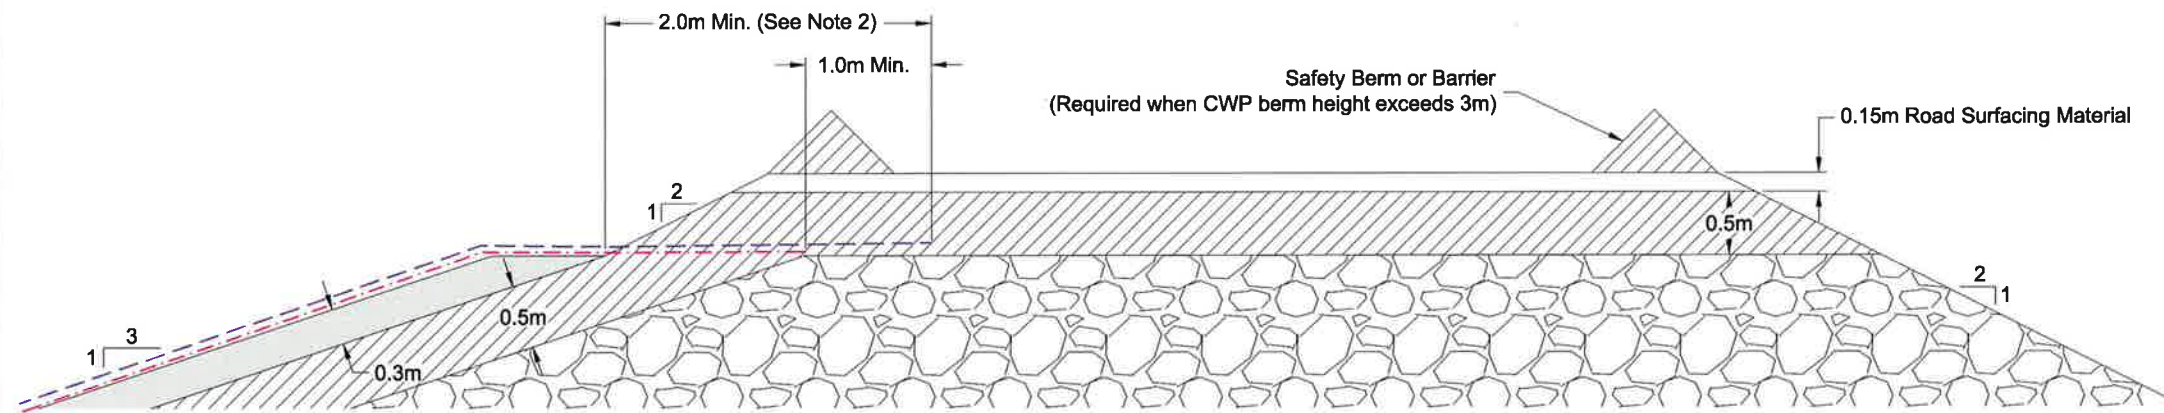


1
05 Typical Liner Anchor Detail

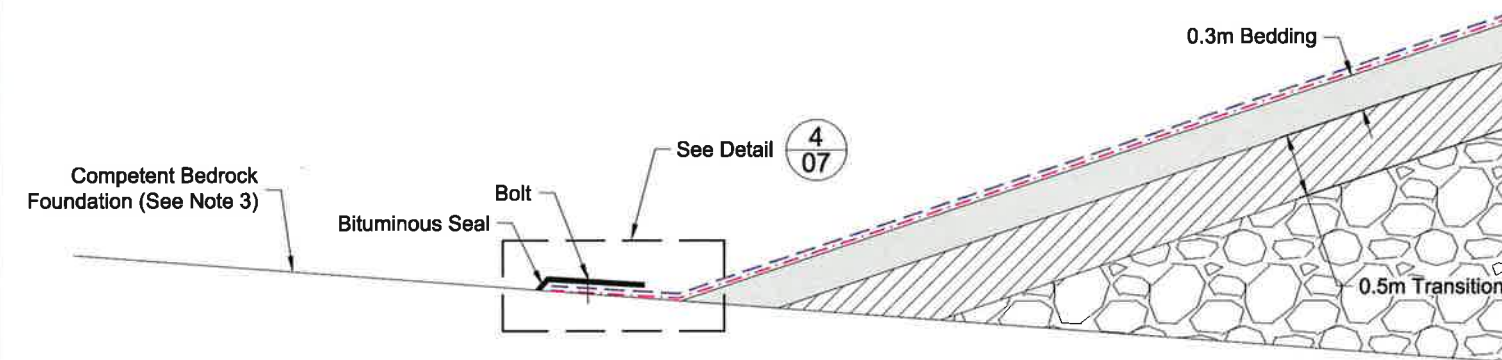


2
05 Typical Liner Anchor at Bedrock - Mechanical Tie-down Option

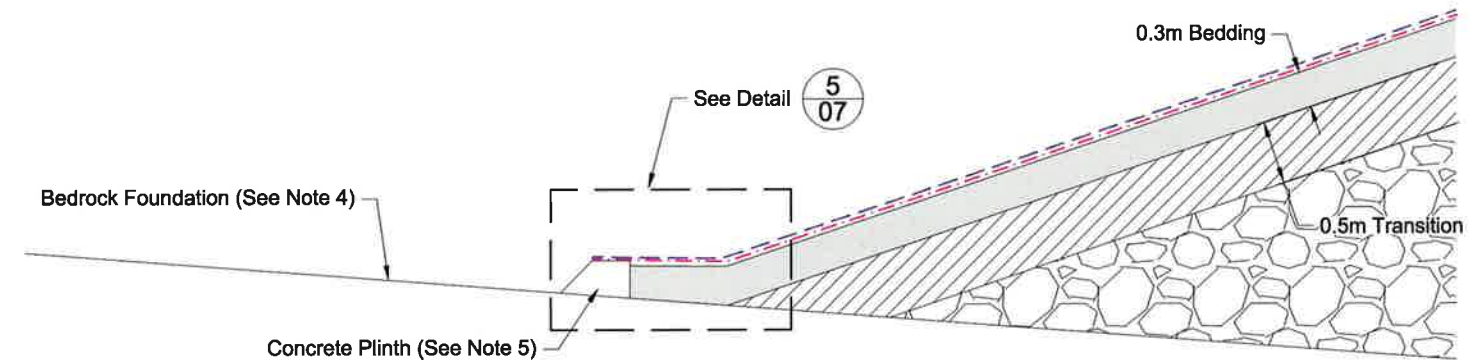


2
05 Typical Liner Anchor at Bedrock - Concrete Plinth Option

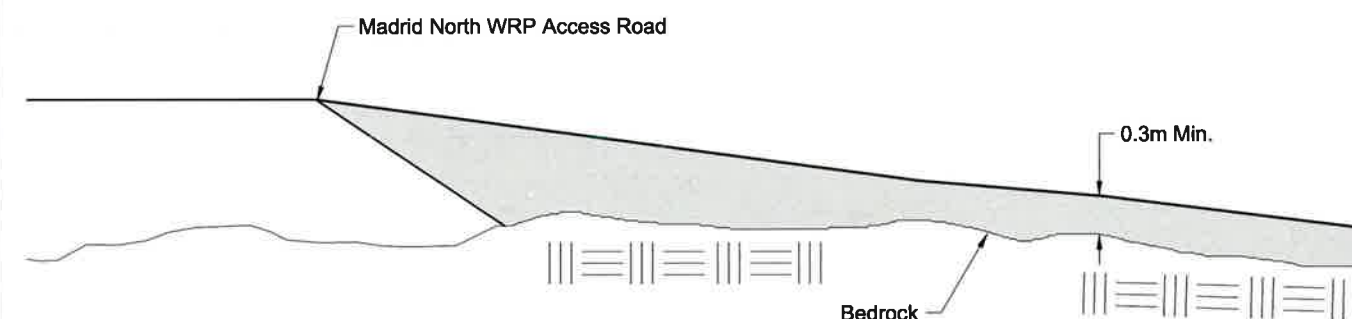

3
04,05 CWP Access Road Detail

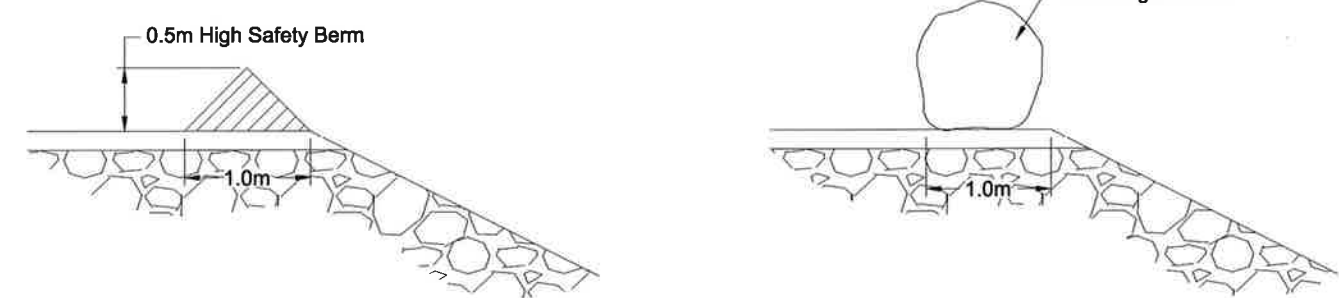

Typical Safety Berm or Barrier Options

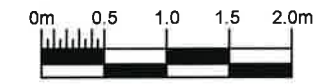



LEGEND







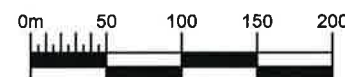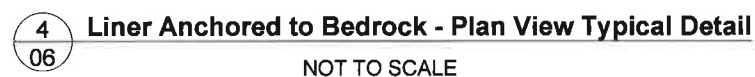

---	Liner	///	Transition Material
---	Non-woven Geotextile	□	Run of Quarry (ROQ) or Run of Mine (ROM) Material
---	Bedding Material	■	Bituminous Seal

- NOTES**
- All dimensions shown in meters unless otherwise stated.
 - Minimum 1.0m liner overlap with ROQ/ROM material. Total covered liner overlap must be a minimum of 2.0m. Non-woven geotextile to terminate at ROQ/ROM.
 - If competent bedrock conditions are encountered, liner can be mechanically tied in to bedrock. A bituminous seal may also be applied. Bedrock conditions to be inspected and approved by field engineer.
 - If bedrock conditions are unfavourable (e.g. weathered, highly fractured) or the bedrock surface is highly irregular, a concrete plinth may be required to facilitate liner tie-in. Bedrock conditions to be inspected and approved by the field engineer.
 - Liner to be affixed to top of concrete plinth with GSE Polylock Concrete Embedment Strip or Approved Alternative. Steel reinforcement bars also required and should be typically drilled and grouted a minimum 450mm into bedrock.
 - Construction and material specifications shall be in accordance with the following Technical Specifications: Earthworks and Geotechnical Engineering. Hope Bay Project, Nunavut, Canada. Revision H - Issued for Construction. SRK (2018).

P:\01_SITES\Hope Bay\ACAD\DWG\Madrid North CWP\1CT022.043 - PP.dwg

																Madrid North Contact Water Pond DRAWING TITLE: Contact Water Pond Typical Details	
										DESIGN: RW DRAWN: TAH REVIEWED: RW CHECKED: RW APPROVED: EMR DATE: March 19, 2019		Hope Bay Project		SRK JOB NO.: 1CT022.043		MN-CWP-06	
REFERENCE DRAWINGS NO. DESCRIPTION 0 A Issued for Construction RW EMR 19/03/19 1 A Issued for Discussion RW EMR 19/03/05										FILE NAME: 1CT022.043 - PP.dwg		SHEET 6 OF 7		REVISION NO. 0			



LEGEND			
	HDPE Liner		HDPE Liner
	Non-woven Geotextile		Run of Quarry (ROQ) or Run of Mine (ROM) Material
	Bedding Material		Bedrock
	Concrete		Bituminous Seal

NOTES

1. All dimensions shown in meters unless otherwise stated.
2. Bedrock conditions and contact point for the liner will be inspected in the field by the engineer. The engineer will make a final decision for the required adhesion method.
3. Typical details shown may vary and additional details will be provided if required.
4. Construction and material specifications shall be in accordance with the following Technical Specifications: Earthworks and Geotechnical Engineering. Hope Bay Project, Nunavut, Canada, Revision H - Issued for Construction. SRK (2018).

5. In cold ($\sim 20^{\circ}\text{C}$) ambient air temperature periods, the area where concrete is placed or poured, may be required to be heated and horded, or a polymer added to the mix. This would be done to ensure the concrete cures appropriately and maintains its strength and integrity (i.e. does not excessively crack).

P-01 SITES Hope Bay\ACAD\NEC\Mudra North CWP\1CT022 043 - pp.doc

[illegible]

Attachment 2.2 Madrid North Contact Water Pond – As-built Drawings

As-Built Drawings for the Madrid North Contact Water Pond Hope Bay Project, Nunavut, Canada

Active Drawing Status

Drawing Number	Drawing Title	Issue	Date	Revision
MN-CWP-01	General Arrangement (With Orthophoto)	As-Built	2020/03/24	AB1
MN-CWP-02	General Arrangement	As-Built	2020/03/24	AB1
MN-CWP-03	Contact Water Pond Foundation Conditions Plan and Profile	As-Built	2020/03/24	AB1
MN-CWP-04	Contact Water Pond As-Built Berm and Concrete Plinths	As-Built	2020/03/24	AB1
MN-CWP-05	Contact Water Pond Typical Sections	As-Built	2020/03/24	AB1
MN-CWP-06	Contact Water Pond Typical Sections	As-Built	2020/03/24	AB1
MN-CWP-07	Contact Water Pond Typical Details	As-Built	2020/03/24	AB1
MN-CWP-08	Liner Tie-in Typical Details	As-Built	2020/03/24	AB1
MN-CWP-09	Contact Water Pond Instrumentation Plan	As-Built	2020/03/24	AB1
MN-CWP-10	As-Built Liner Panel Layout	As-Built	2020/03/24	AB1



Project Number: 1CT022.043

Design Quantity vs. As-Built Quantity

Overburden Excavation:	250m³
Overburden Excavation:	301m³
ROQ / ROM Material:	13,450m³
ROQ / ROM Material:	15,509m³
Transition Material:	1,705m³
Transition Material:	770m³
Bedding Material:	450m³
Bedding Material:	644m³
Surfacing Material:	2,80m³
Surfacing Material:	0m³
HDPE Geomembrane Liner:	2,005m²
HDPE Geomembrane Liner:	3,289m²
Non-woven Geotextile:	2,005m²
Non-woven Geotextile:	3,289m²


*All design values reported are calculated to neat lines. No bulking / shrinking factors have been utilized in volume determination.

Losses into the Tundra are not accounted for.

*As-Built Liner area reported does not account for overlaps, sacrificial panels, or patches.

*Quantities are calculated based on as-built survey and LiDAR topography. Differences between the LiDAR surface and the actual ground conditions may not be accounted for.


Elev. 68.0m: 1,836m³
Elev. 68.7m: 3,734m³
Elev. 69.7m (FSL): 9,293m³

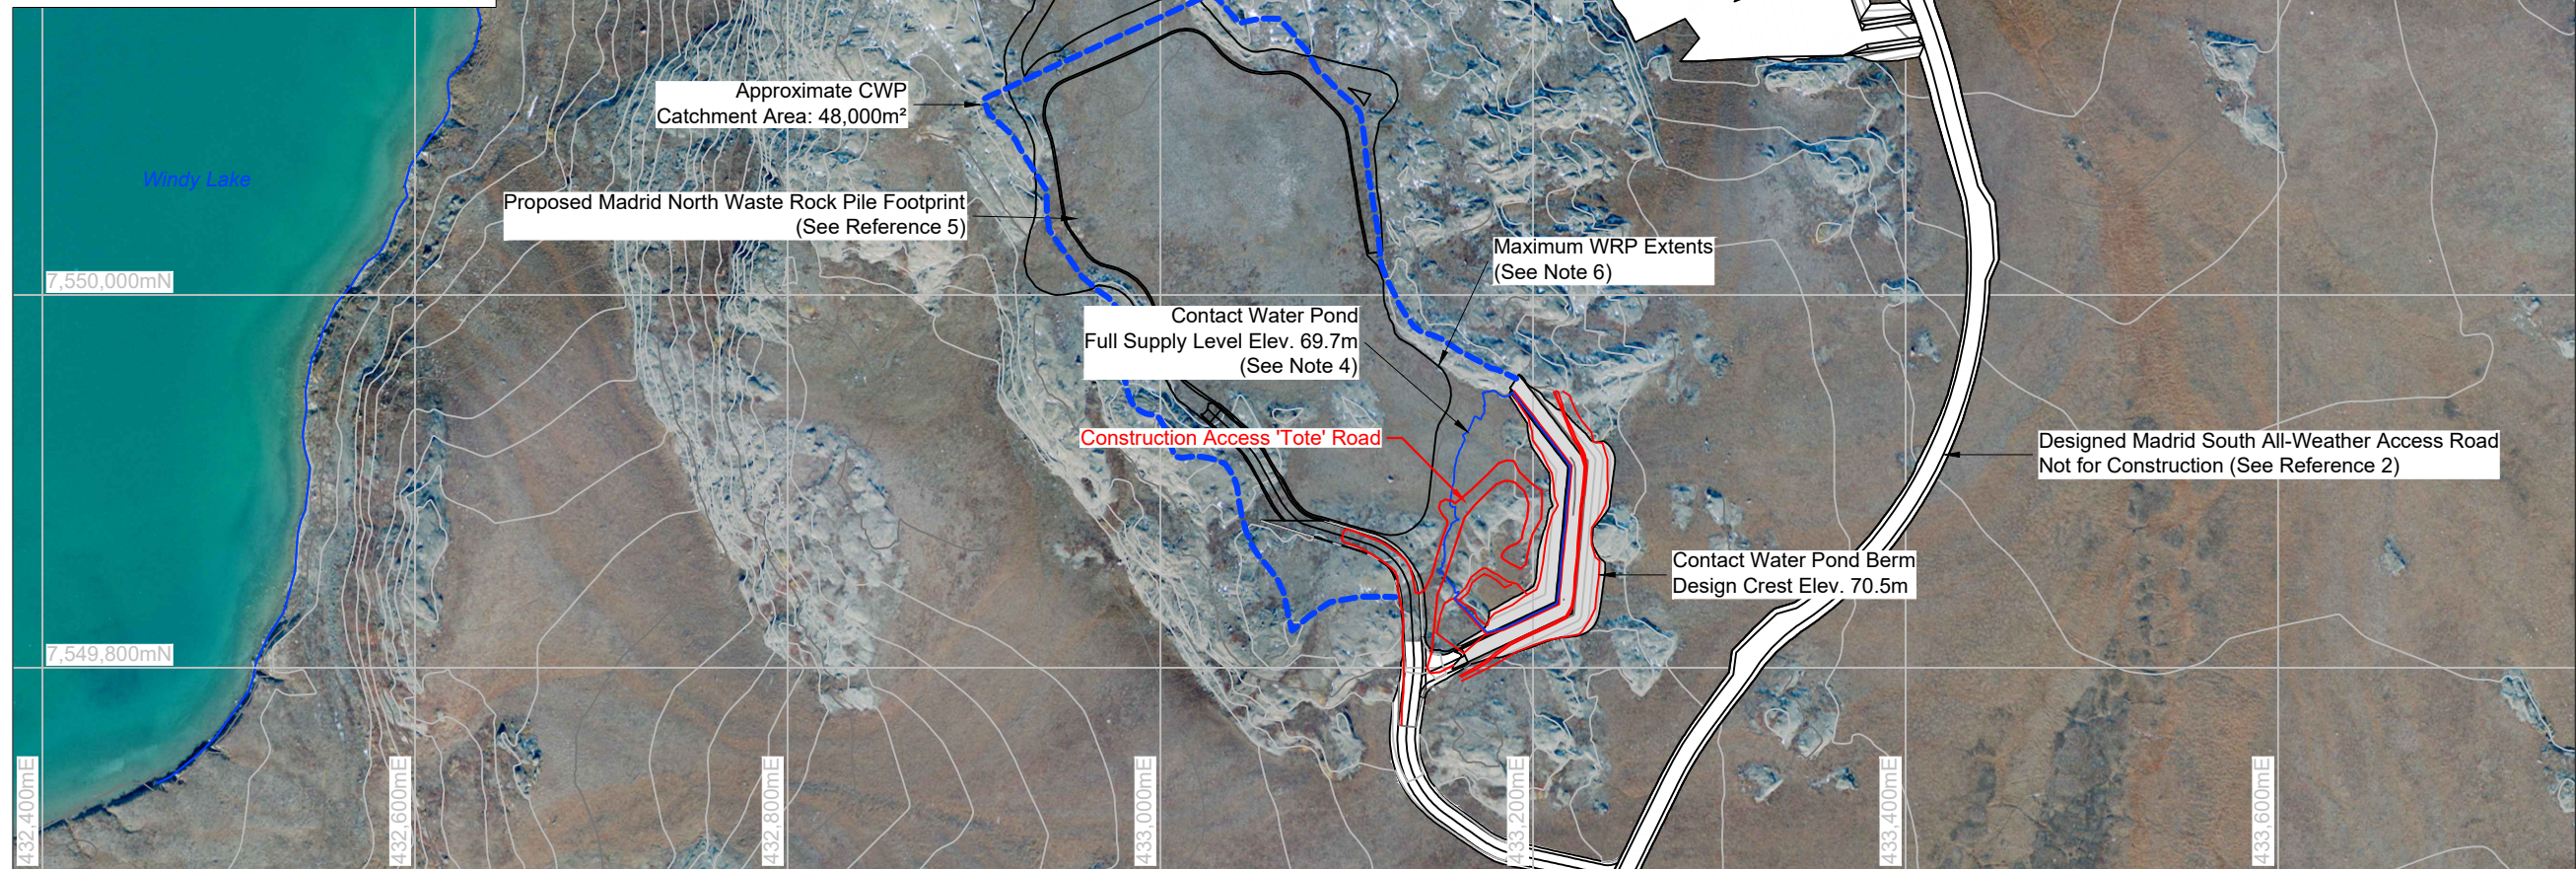

 Proposed Infrastructure
 Design Footprint
 As-built Infrastructure
 Proposed Contact Water Pond

1. Contours shown at 2.0m intervals, based off of LiDAR, 2007.
2. All units shown in meters unless otherwise specified.
3. Construction and material specifications shall be in accordance with the following Technical Specifications: Earthworks and Geotechnical Engineering. Hope Bay Project, Nunavut, Canada. Revision H - Issued for Construction. SRK (2018).
4. The CWP will normally be kept in a dry state with a maximum two-week (i.e. fourteen day) residence time for water in the pond.
5. Imagery provided by client, 2007.
6. WRP toe must stay above elevation 70.0m where it is immediately upstream of the CWP.

1. NAD83 UTM Zone 13.
2. Engineering Drawings for the Madrid South All-Weather Road, Hope Bay Project, Nunavut, Canada. Revision 0 Issued for Construction drawings prepared for TMAC Resources Inc.. Project Number: 1CT022.043. March 2019.
3. Engineering Drawings for the Doris-Windy All-Weather Road, Doris Infrastructure Project, Nunavut, Canada. Revision AB1. As-Built drawings prepared for Hope Bay Mining Ltd. Project Number: 1CH008.033/058. May 11, 2012.
4. Geochemical Characterization of Quarry Materials for the Doris-Windy All-Weather Road, Hope Bay Project. Report prepared for Hope Bay Mining Ltd., 1CH008.000. August 2008.
5. Engineering Drawings for the Madrid North Waste Rock Pile, Hope Bay Project, Nunavut, Canada. Revision 1. Prepared for TMAC Resources Inc. Project Number, 1CT022.043. August 2019.
6. Engineering Drawings for the Madrid North Portal Surface Infrastructure Pad, Hope Bay Project. Revision 1. Prepared for TMAC Resources Inc. Project Number, 1CT022.051. October 2019.
7. Engineering Drawings for the Naartok East CPR Overburden Stockpile, Madrid North Project, Hope Bay. Revision 0. Prepared for TMAC Resources Inc. Project Number 1CT022.043. December 2019
8. **As-built surveys provided by Sub-Arctic Geomatics Ltd. dated May 2019 - September 2019.**

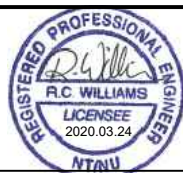[illegible]

DESIGN: RW	DRAWN: TAH	REVIEWED: RW
CHECKED: RW	APPROVED: JBK	DATE: March 24, 2020

FILE NAME:	1CT022.043 - GA.dwg
------------	---------------------



Hope Bay Project

SRK JOB NO.:	1CT022.043
--------------	------------

Madrid North Contact Water Pond

DRAWING TITLE:


General Arrangement (With Orthophoto)

DRAWING NO.


MN-CWP-01

REVISION NO.

AB1 |

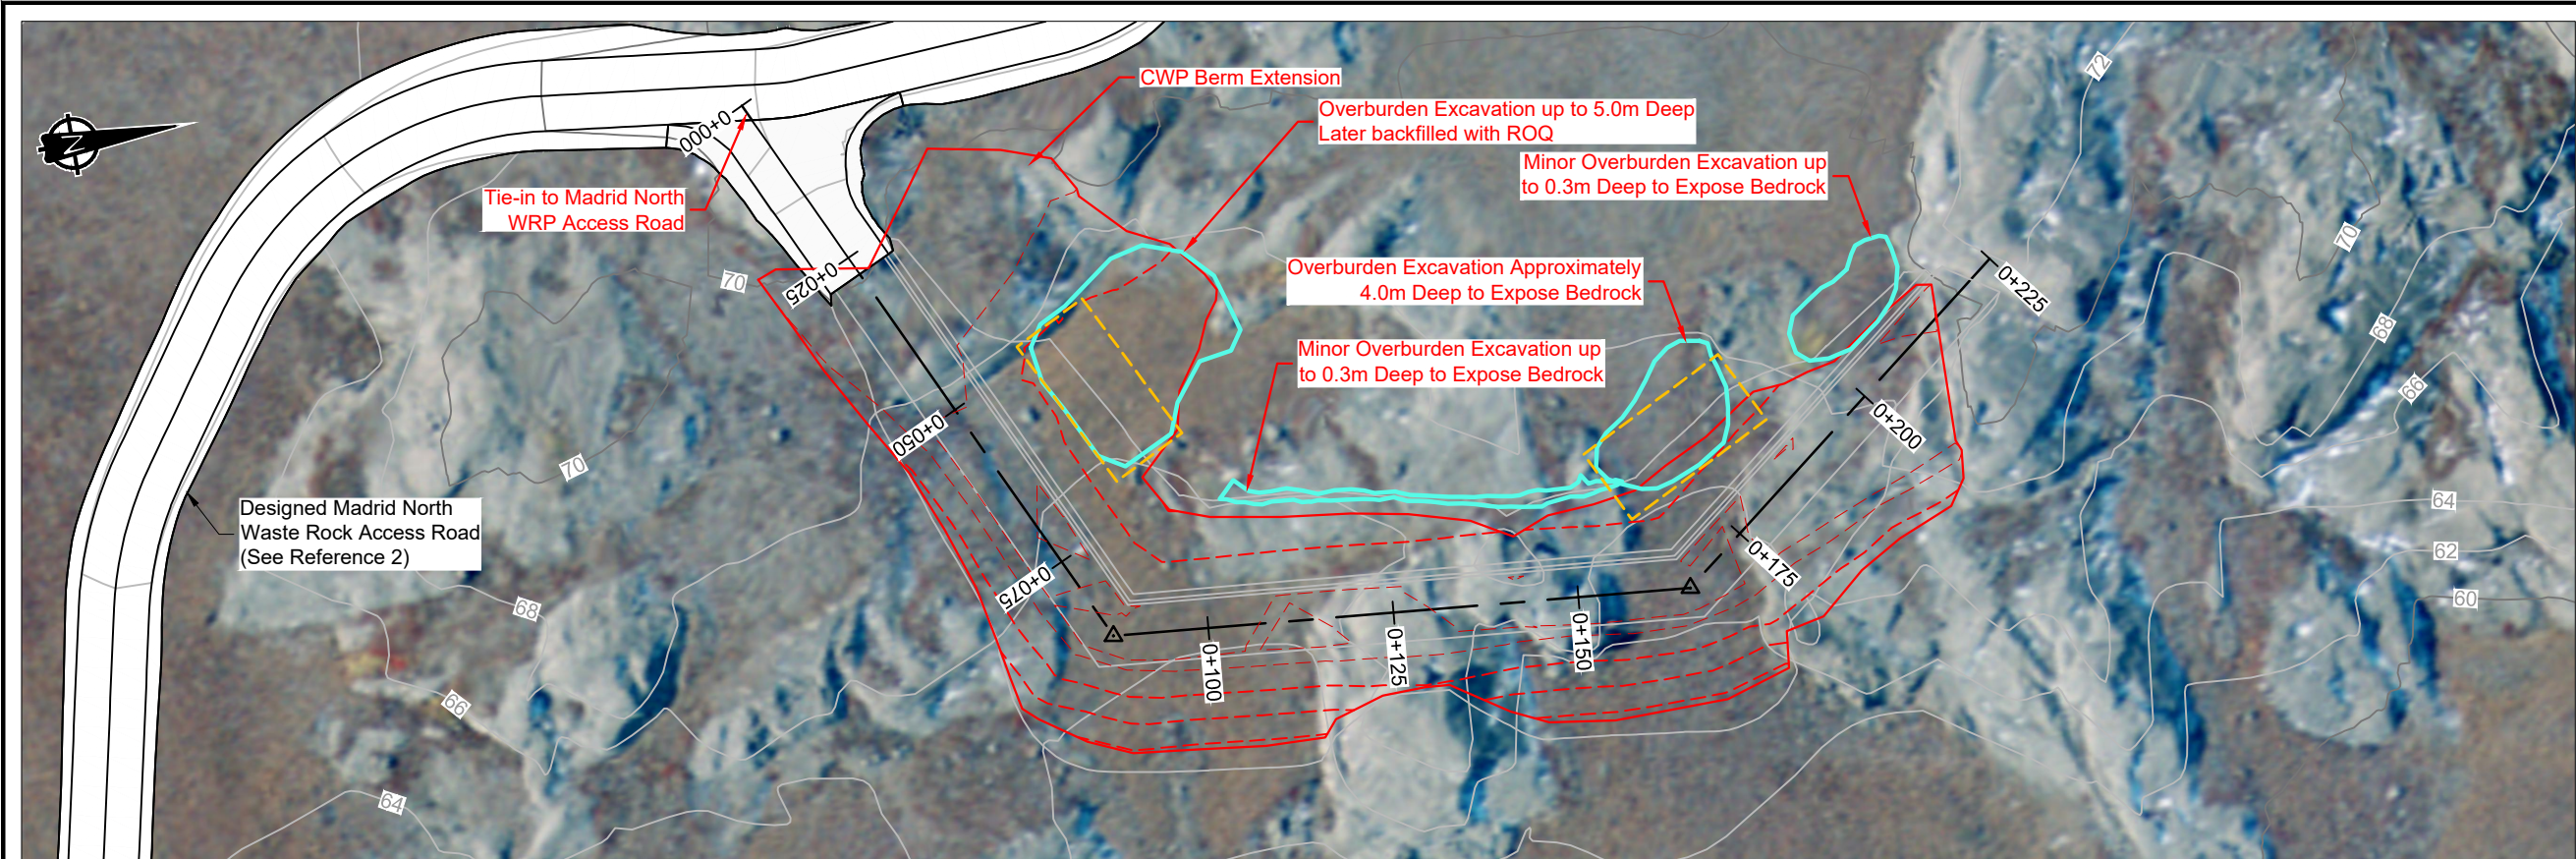

Contact Water Pond Berm Plan View

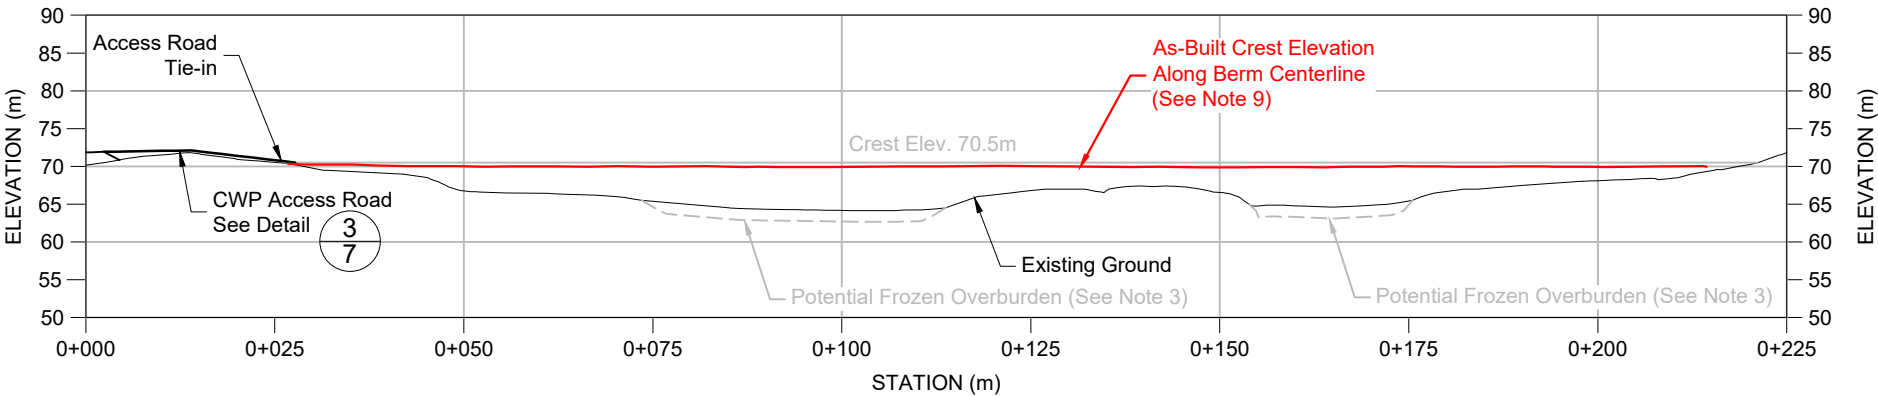


Contact Water Pond Berm Profile View

LEGEND

- Anticipated Overburden Excavation Area (Design)
- As-built Overburden Excavation (See Note 7)
- Design Contact Water Pond Berm
- As-Built Contact Water Pond Berm


- NOTES**
- Contours shown at 1.0m intervals, based off LiDAR, 2007.
 - All dimensions shown in meters unless otherwise stated.
 - The majority of the CWP berm footprint is expected to encounter bedrock outcrop. However, based on aerial imagery overburden may be encountered in low-lying areas.
 - If overburden is encountered at the upstream toe, it will be excavated to bedrock to allow liner to tie-in to the bedrock foundation.
 - The CWP will normally be kept in a dry state with a maximum two-week (i.e. fourteen-day) residence time for water in the pond.
 - Construction and material specifications shall be in accordance with the following Technical Specifications: Earthworks and Geotechnical Engineering. Hope Bay Project, Nunavut, Canada. Revision H - Issued for Construction. SRK (2018).
 - As-built overburden excavation extents are approximate, and are based on as-built surveys and site observation.
 - Construction access 'tote' road (MN-CWP-01 & 02) is not shown on this drawing.
 - As-built crest elevation along berm centerline is approximately 70.0m (i.e. minimum elevation of the liner). As-built crest elevation along the upstream and downstream crest edge is approximately 70.5m. See as-built cross sections on MN-CWP-05 & 06.

- REFERENCES**
- NAD83 UTM Zone 13.
 - Engineering Drawings for the Madrid South All-Weather Road, Hope ay Project, Nunavut, Canada. Issued for Discussion. Revision A. Project No. 1CT022.043. March 2019.
 - Geochemical Characterization of Quarry Materials for the Doris-Windy All-Weather Road, Hope Bay Project. Report prepared for Hope Bay Mining Ltd., 1CH008.000. August 2008.
 - As-built surveys provided by Sub-Arctic Geomatics Ltd. dated May 2019 - September 2019.

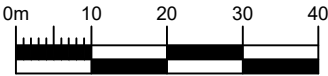

P:\Project\01 - SITE\Hope Bay\ACAD\As-Built\Madrid CWP\1CT022.043 - OB.dwg

																Madrid North Contact Water Pond	
												DESIGN: RW		DRAWN: TAH		REVIEWED: RW	
												CHECKED: RW		APPROVED: JBK		DATE: March 24, 2020	
										FILE NAME: 1CT022.043 - OB.dwg		SRK JOB NO.: 1CT022.043					
										PROFESSIONAL ENGINEERS STAMP				Hope Bay Project		DRAWING TITLE:	
																Contact Water Pond	
																Foundation Conditions Plan and Profile	
																DRAWING NO.	
																MN-CWP-03	
																SHEET	
																3 OF 10	
																REVISION NO.	
																AB1	

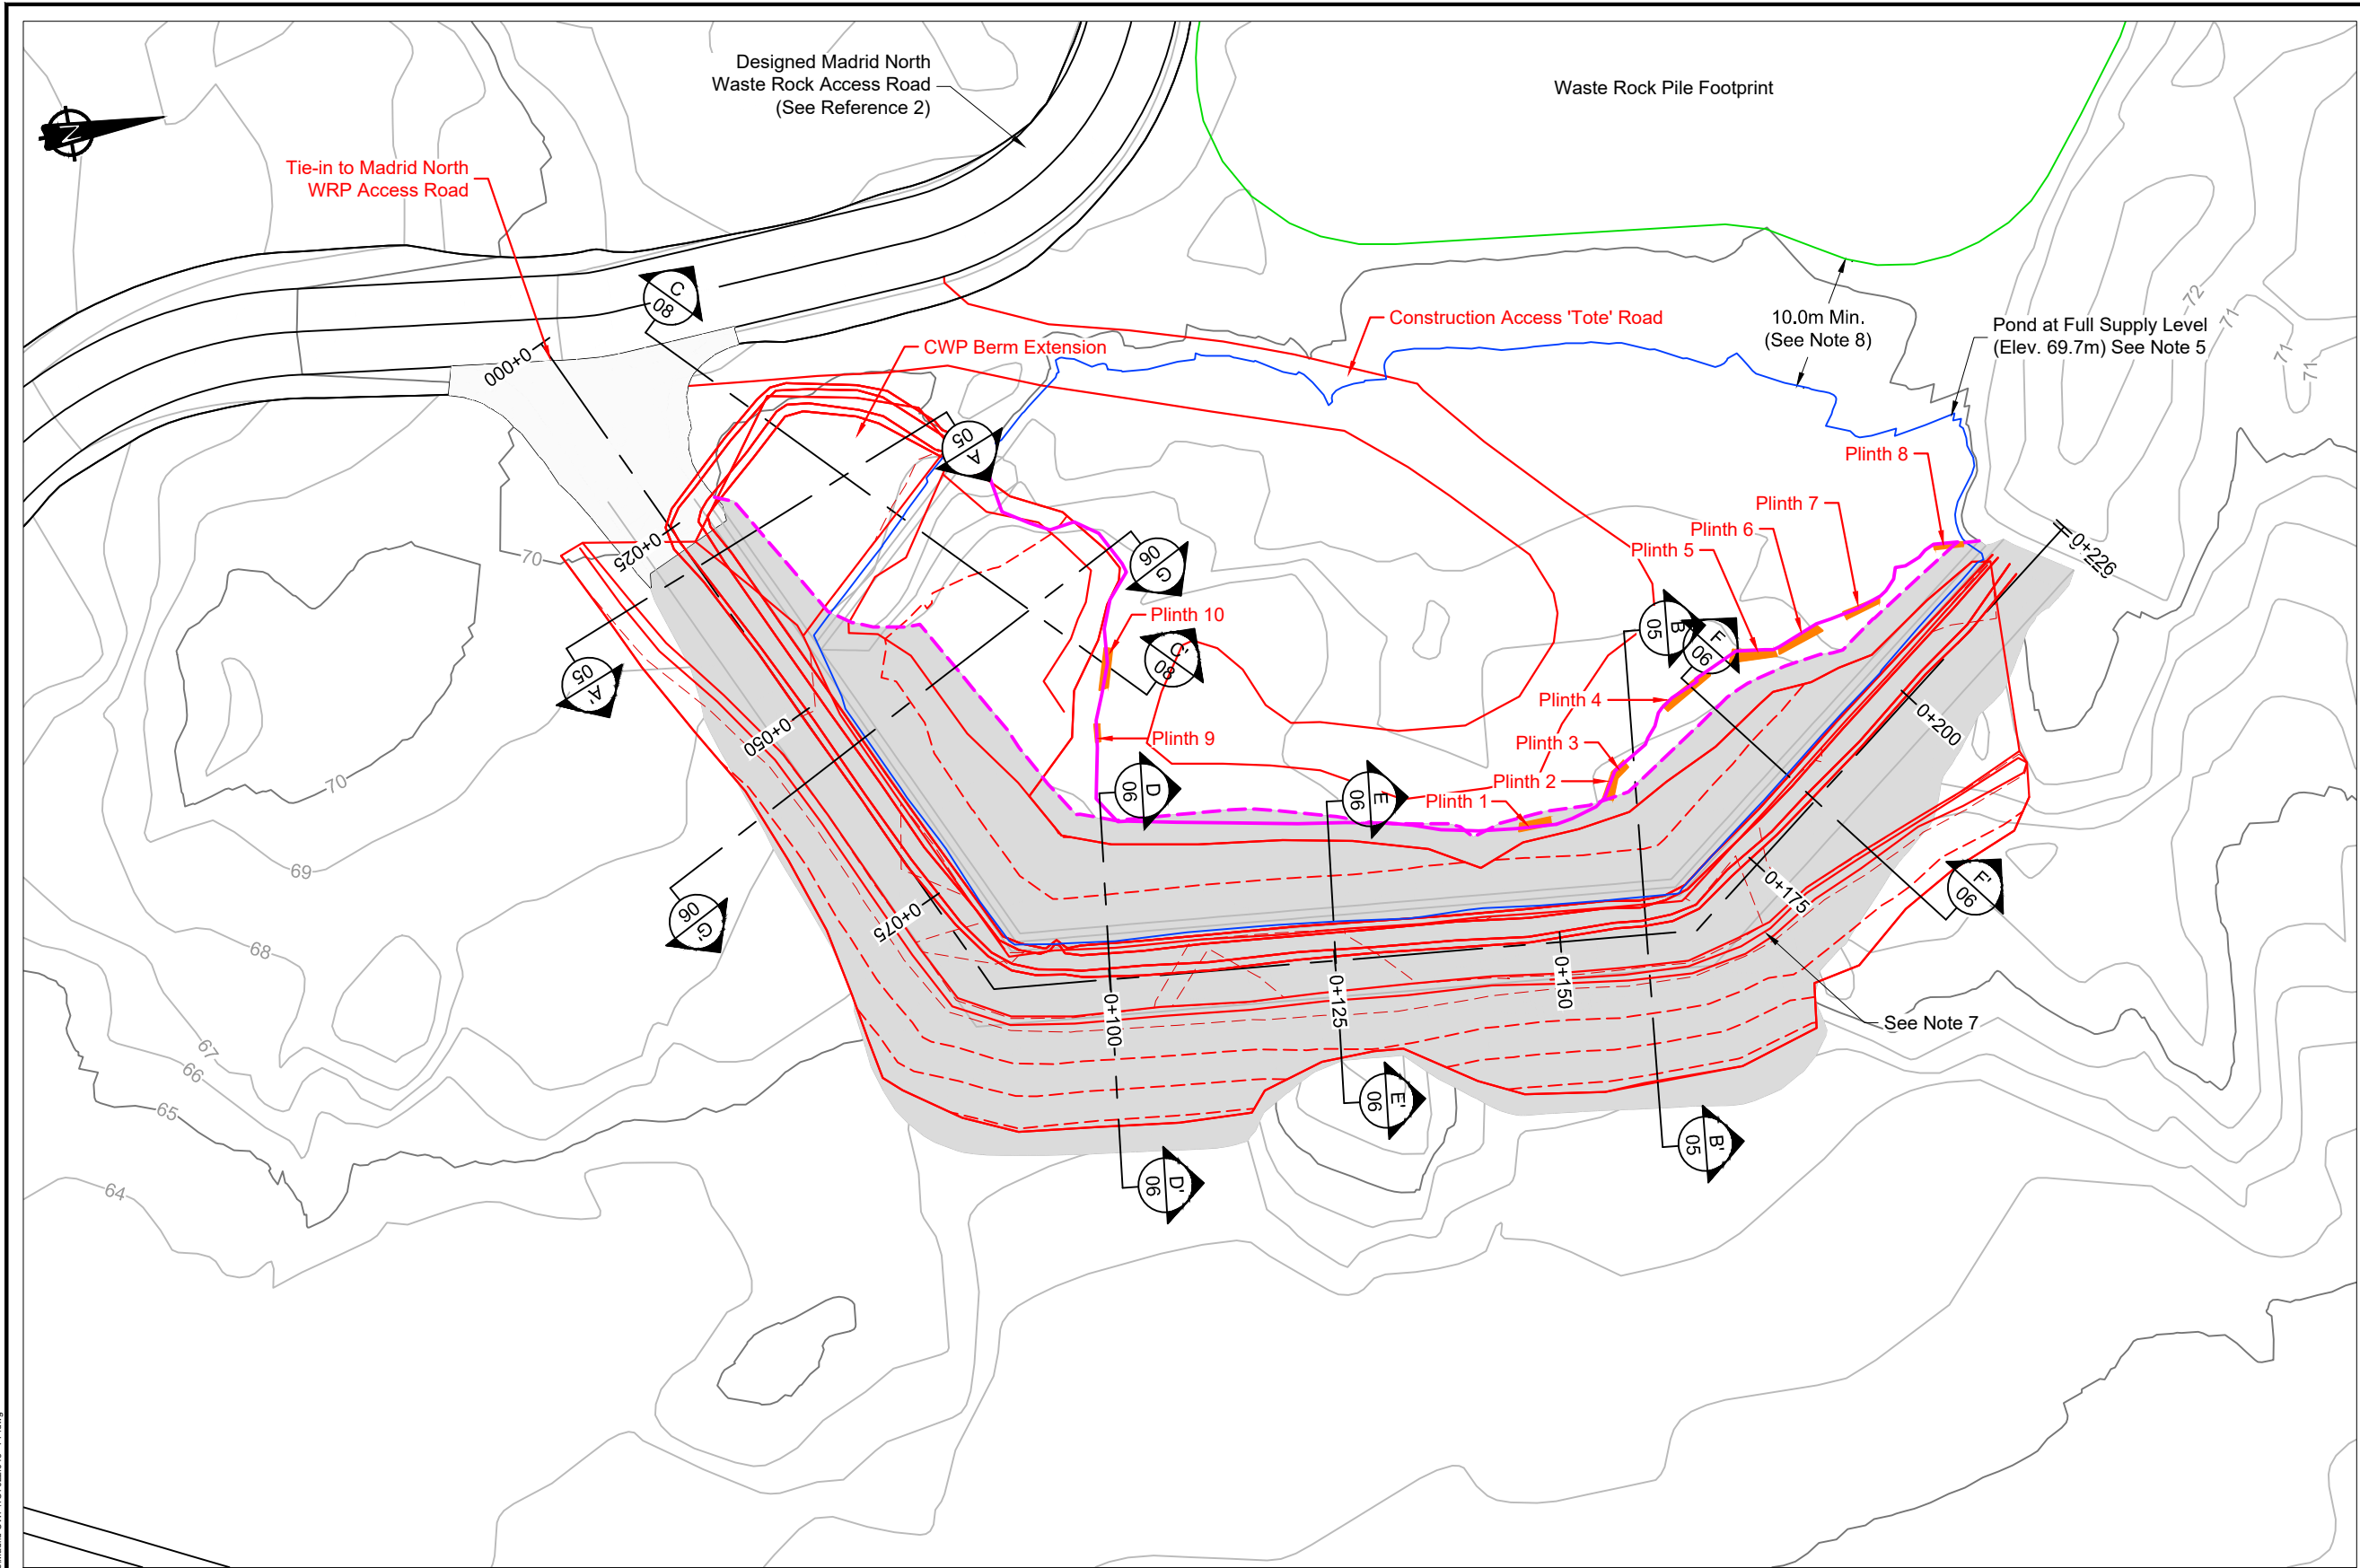


- LEGEND**
- Design Liner to Bedrock Tie-in
 - As-Built Liner to Bedrock Tie-in
 - Contact Water Pond
 - As-Built Contact Water Pond Berm
 - Design Contact Water Pond Berm
 - As-Built Plinth Location
 - Maximum Proposed Waste Rock Pile Footprint

- NOTES**
- Contours shown at 1.0m intervals.
 - All dimensions shown in meters unless otherwise stated.
 - The majority of the CWP berm footprint is expected to encounter bedrock outcrop. However, based on aerial imagery overburden may be encountered in low-lying areas.
 - If overburden is encountered at the upstream toe, it will be excavated to bedrock to allow liner to tie-in to the bedrock foundation.
 - The CWP will normally be kept in a dry state with a maximum two-week (i.e. fourteen-day) residence time for water in the pond.
 - Construction and material specifications shall be in accordance with the following Technical Specifications: Earthworks and Geotechnical Engineering. Hope Bay Project, Nunavut, Canada. Revision H - Issued for Construction. SRK (2018).
 - Where the height of the berm exceeds 3.0m, safety berms or barriers are required on the crest. See Typical Berm Barrier Options on drawing MN-CWP-06.
 - WRP toe must stay above elevation 70.0m or a minimum of 10m away from the pond's full supply extents.

- REFERENCES**
- NAD83 UTM Zone 13.
 - Engineering Drawings for the Madrid South All-Weather Road, Hope ay Project, Nunavut, Canada. Issued for Discussion. Revision A. Project No. 1CT022.043. March 2019.
 - Geochemical Characterization of Quarry Materials for the Doris-Windy All-Weather Road, Hope Bay Project. Report prepared for Hope Bay Mining Ltd., 1CH008.000. August 2008.
 - As-built surveys provided by Sub-Arctic Geomatics Ltd. dated May 2019 - September 2019.



DRAWING NO.	DRAWING TITLE	NO.	DESCRIPTION	CHKD	APPD	DATE	NO.	DESCRIPTION	CHKD	APPD	DATE
AB1	As-Built										
0	Issued for Construction										
A	Issued for Discussion										

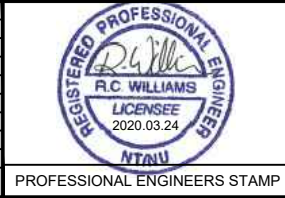

srk consulting

DESIGN: RW DRAWN: TAH REVIEWED: RW
CHECKED: RW APPROVED: JBK DATE: March 24, 2020
FILE NAME: 1CT022.043 - PP.dwg

TMAC RESOURCES


Hope Bay Project

DRAWING NO.: 1CT022.043

Madrid North Contact Water Pond

DRAWING TITLE:
Contact Water Pond As-Built Berm and Concrete Plinths

DRAWING NO. **MN-CWP-04** SHEET **4 OF 10** REVISION NO. **AB1**

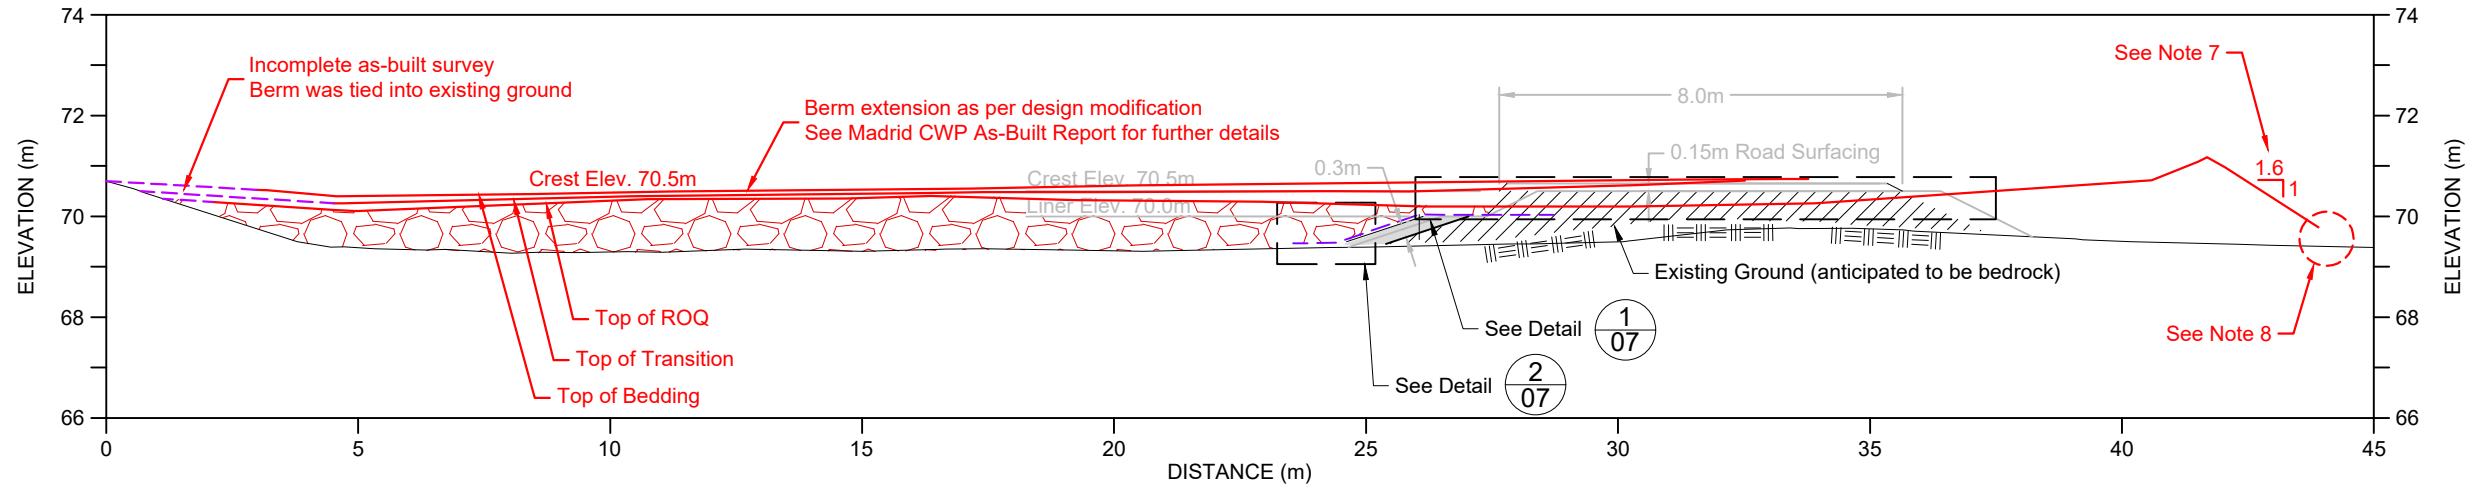


A
04 **Cross Section A-A' - Berm Sections less than 1.5m**

LEGEND

- | | |
|-----------------------------|--|
| --- Design Liner System | Design Bedding Material |
| - - - As-Built Liner System | Design Transition Material |
| --- As-Built Survey | Design Run of Quarry (ROQ) or Run of Mine (ROM) Material |

NOTES


1. All dimensions shown in meters unless otherwise stated.
2. If overburden is encountered at the upstream toe, it will be excavated to bedrock to tie-in to the bedrock foundation. Thickness of excavation will vary and will depend on conditions encountered. Excavation to be backfilled with bedding material if necessary to protect the liner tie-in.
3. The CWP will normally be kept in a dry state with a maximum two-week (i.e. fourteen-day) residence time for water in the pond.
4. Construction and material specifications shall be in accordance with the following Technical Specifications: Earthworks and Geotechnical Engineering, Hope Bay Project, Nunavut, Canada. Revision H - Issued for Construction. SRK (2018).
5. Where the height of the berm exceeds 3.0m, safety berms or barriers are required on the crest. See Typical Berm Barrier Options on drawing MN-CWP-06.
6. As-built surveys provided by Sub-Arctic Geomatics Ltd. dated May 2019 - September 2019.
7. Stability analyses completed on over-steepened downstream slopes have determined that the risk of instability is low. See Appendix D of the Madrid CWP As-Built Report for further details.
8. Updated topography survey not available. Difference is attributed to differences between LiDAR survey and actual field conditions.

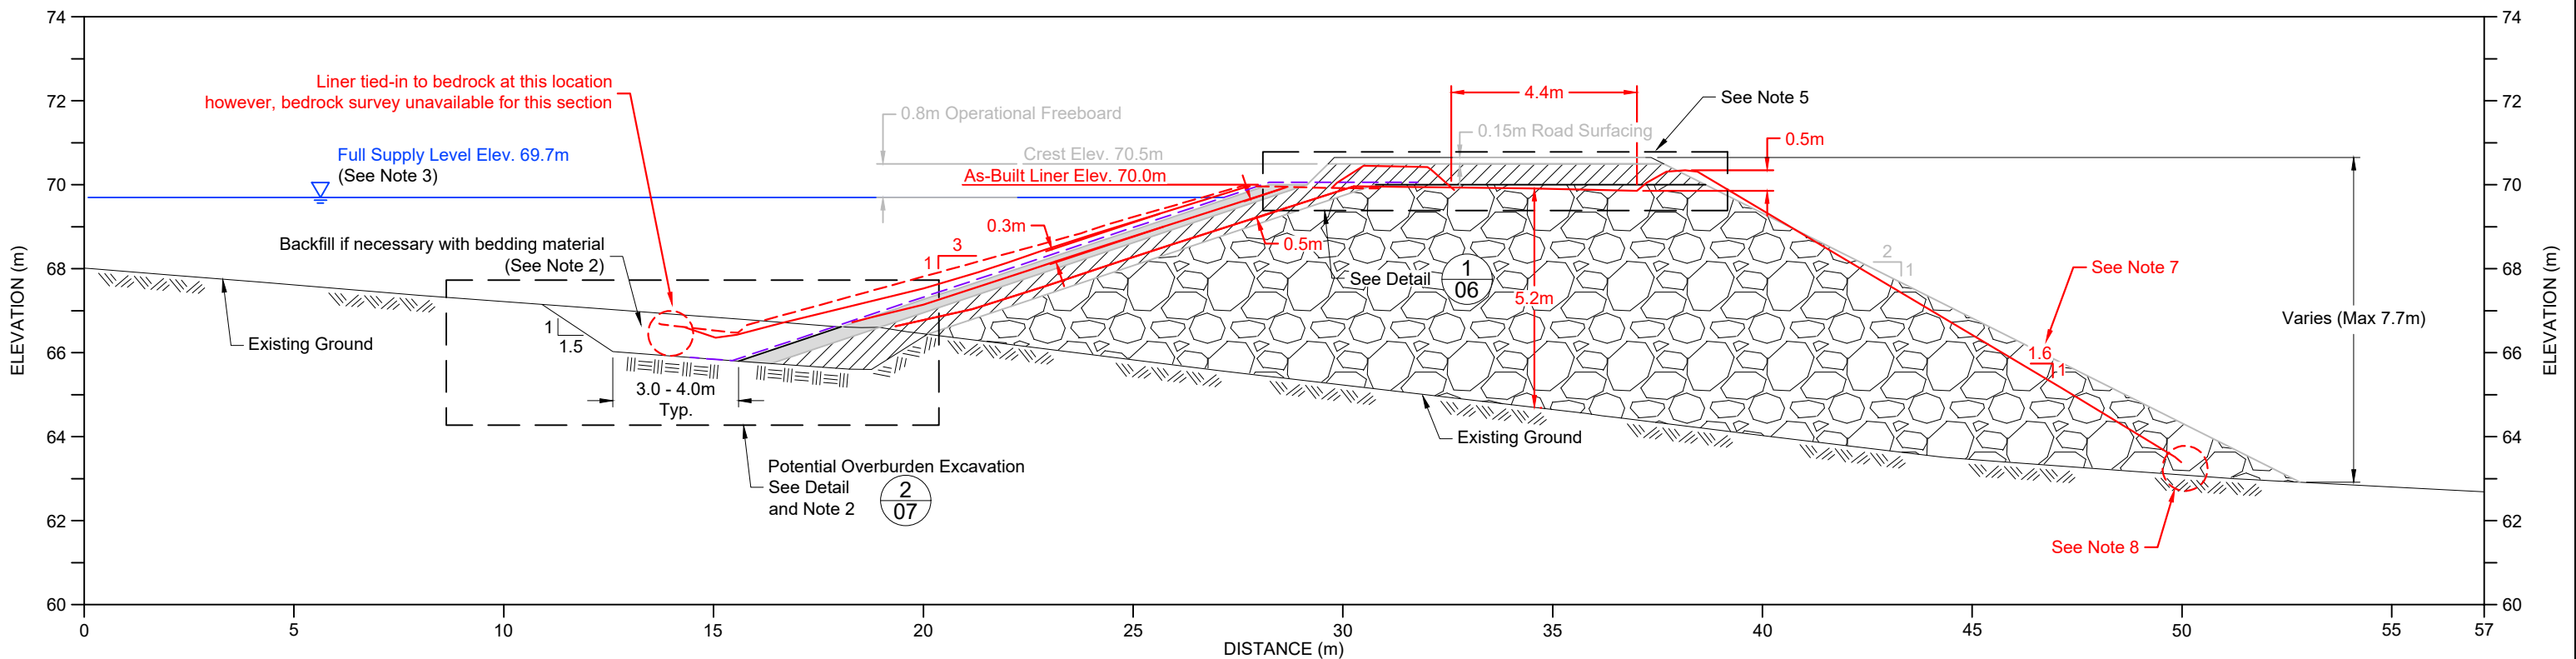

B
04 **Cross Section B-B' - Berm Sections 1.5m or higher**



DRAWING NO.	DRAWING TITLE	NO.	DESCRIPTION	CHKD	APPD	DATE	NO.	DESCRIPTION	CHKD	APPD	DATE
AB1	As-Built										
0	Issued for Construction										
A	Issued for Discussion										

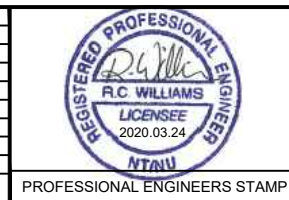

srk consulting

DESIGN: RW	DRAWN: TAH	REVIEWED: RW
CHECKED: RW	APPROVED: JBK	DATE: March 24, 2020
















FILE NAME: 1CT022.043 - PP.dwg


TMAC RESOURCES

Hope Bay Project

SRK JOB NO.: 1CT022.043

Madrid North Contact Water Pond		
DRAWING TITLE:		
Contact Water Pond Typical Sections		
DRAWING NO.	SHEET	REVISION NO.
MN-CWP-05	5 OF 10	AB1

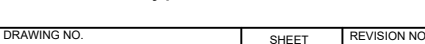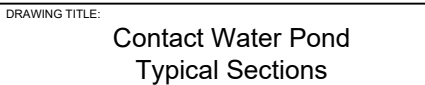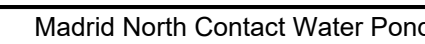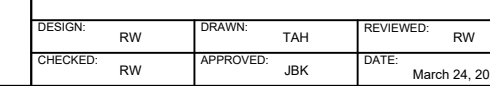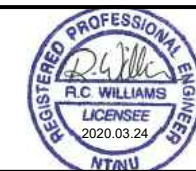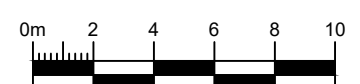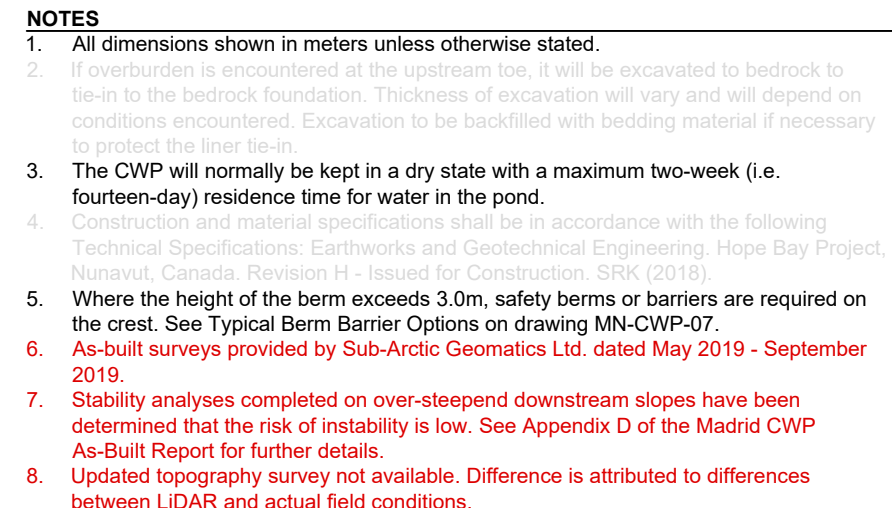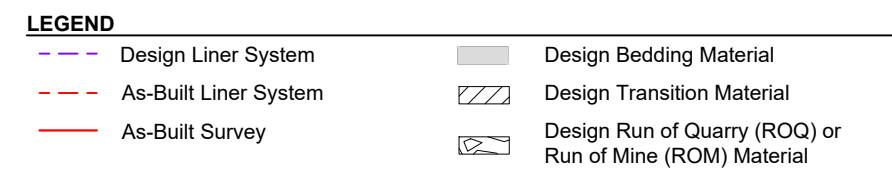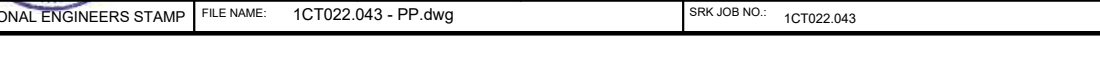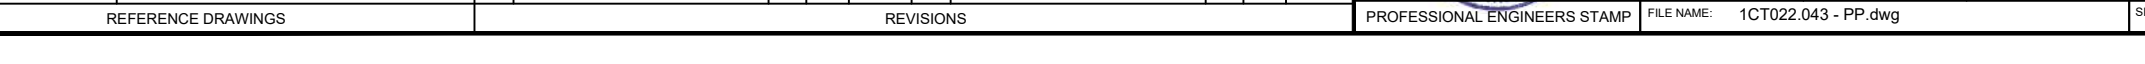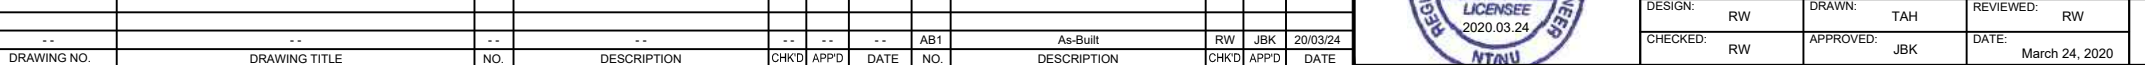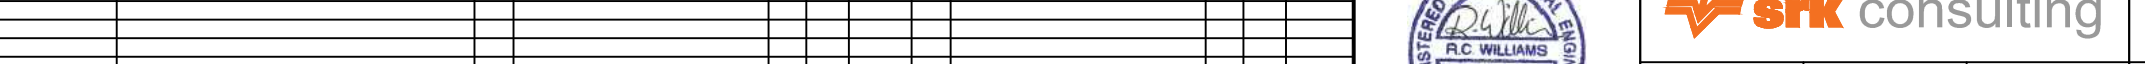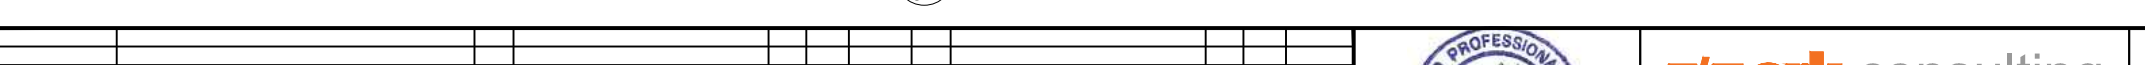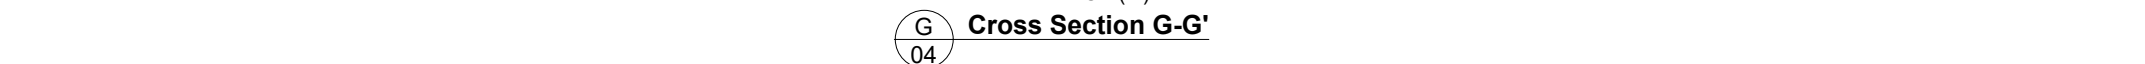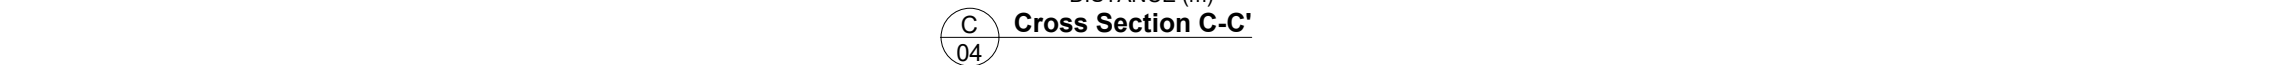

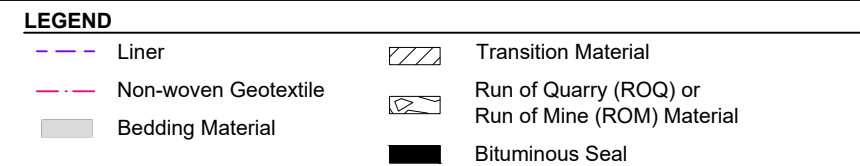

- ### NOTES
1. All dimensions shown in meters unless otherwise stated.
 2. Minimum 1.0m liner overlap with ROQ/ROM material. Total covered liner overlap must be a minimum of 2.0m. Non-woven geotextile to terminate at ROQ/ROM.
 3. If competent bedrock conditions are encountered, liner can be mechanically tied in to bedrock. A bituminous seal may also be applied. Bedrock conditions to be inspected and approved by field engineer.
 4. If bedrock conditions are unfavourable (e.g. weathered, highly fractured) or the bedrock surface is highly irregular, a concrete plinth may be required to facilitate liner tie-in. Bedrock conditions to be inspected and approved by the field engineer.
 5. Liner to be affixed to top of concrete plinth with GSE Polylock Concrete Embedment Strip or Approved Alternative. Steel reinforcement bars also required and should be typically drilled and grouted a minimum 450mm into bedrock.
 6. Construction and material specifications shall be in accordance with the following Technical Specifications: Earthworks and Geotechnical Engineering. Hope Bay Project, Nunavut, Canada. Revision H - Issued for Construction. SRK (2018).
 7. Safety berms on the downstream crest edge were constructed with regular breaks to allow drainage and prevent ponding on the crest.
 8. As-built concrete plinths varied in height as required to adapt to the field conditions. See the Madrid CWP As-Built Report for further details.
 9. Safety berm height to suit light vehicles and water trucks.

Competent Bedrock Foundation (See Note 3)

Bituminous Seal


Bolt

See Detail 4/08

0.3m Bedding


0.5m Transition

2 Typical Liner Anchor at Bedrock - Mechanical Tie-down Option
05 (Constructed as per design)

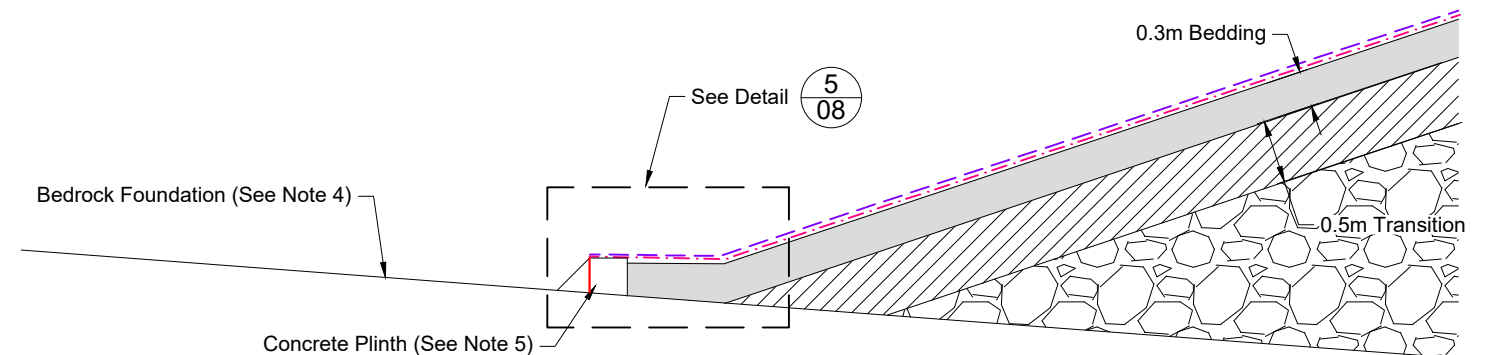

2
05



Typical Liner Anchor at Bedrock - Concrete Plinth Option (See Note 8)

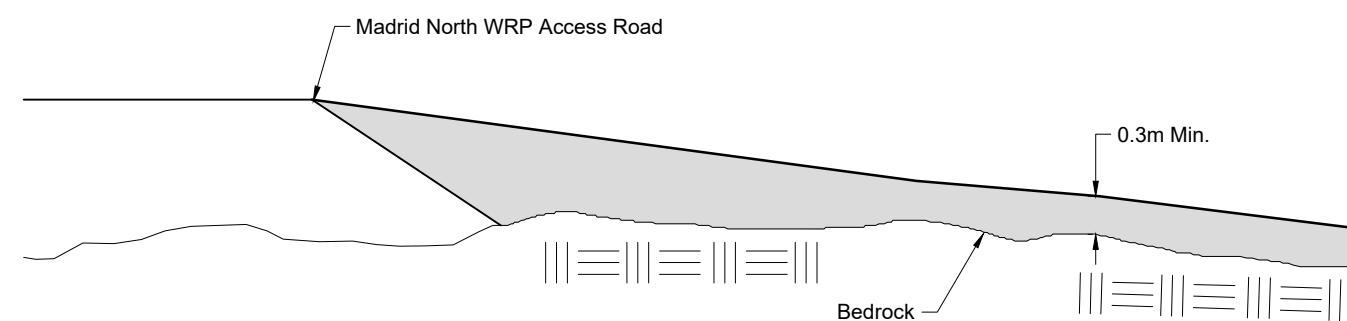

3 CWP Access Road Detail
(Constructed as per design)



Typical Safety Berm or Barrier Options

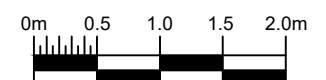
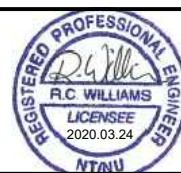
[illegible]

DESIGN: RW	DRAWN: TAH	REVIEWED: RW
CHECKED: RW	APPROVED: JBK	DATE: March 24, 2020



Hope Bay Project

<h1>Madrid North Contact Water Pond</h1>		
<p>DRAWING TITLE:</p> <h2>Contact Water Pond Typical Details</h2>		
<p>DRAWING NO.</p> <h3>MN-CWP-07</h3>	<p>SHEET</p> <p>7 OF 10</p>	<p>REVISION NO.</p> <h3>AB1</h3>

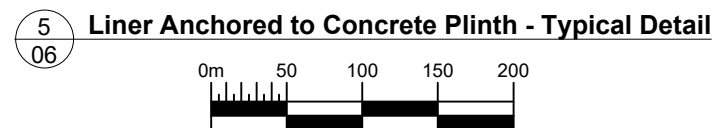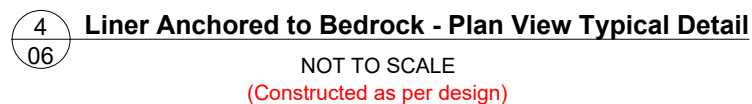

1. All dimensions shown in meters unless otherwise stated.
2. Bedrock conditions and contact point for the liner will be inspected in the field by the engineer. The engineer will make a final decision for the required adhesion method.
3. Typical details shown may vary and additional Details will be provided if required.
4. Construction and material specifications shall be in accordance with the following Technical Specifications: Earthworks and Geotechnical Engineering. Hope Bay Project, Nunavut, Canada. Revision H - Issued for Construction. SRK (2018).
5. GSE Polylock Concrete Embedment trip was not available. Instead, liner was bolted and anchored to top of concrete using stainless steel plate and bituminous seal as per detail 4.
6. CETCO Waterstop was not available. Instead, grout (Multicrete Sub Zero Grout) and mortar (Sikaset Plug) were used as necessary to fill bedrock fractures and any voids identified underneath plinths.
7. Where concrete plinths exceeded the maximum design height, bedding material fill was placed on both sides of the plinth for lateral support. Note that concrete plinths are not load bearing.
8. Maximum rebar embedment depth was approximately 0.3m due to equipment limitations.

[illegible]

Attachment 2.3 Madrid North Contact Water Pond – Liner Installation Report

**A&A Technical Services
Yellowknife NT**


**TMAC Resources
Hope Bay
Madrid CWP HDPE Liner installation
June 25 - July 24, 2019**



**A&A Technical Services
Yellowknife NT**

**TMAC Resources
Hope Bay
Madrid CWP HDPE Liner installation
June 25 - July 24, 2019**

<u>Page</u>	<u>Table of contents</u>
1	As built survey drawing
2	Liner panel dimension log
3+4	Daily welder qualifications and destruct sample Q/C data.
5+6	Non-destructive air pressure test Q/C data.
6+7	IAGI CWT certificates
8	Subgrade acceptance and warranty

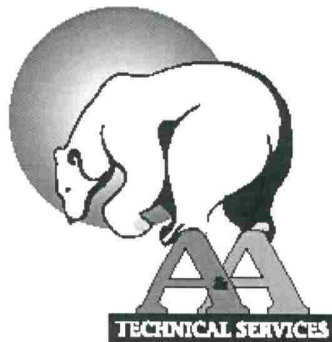



PERIMETER : 409 m
AREA : 3202 m²

	DATA FILE(S)	REV	DESCRIPTION
	DRAWN BY: Jean-Simon Hurdubise DATE DRAWN: JULY 23, 2019	CHECKED BY: Jean-Simon Hurdubise	SURVEIVED BY: Jean-Simon Hurdubise
	FILE NAME: CWP_LINERASE	DATE SURVEIVED: JULY 19-23, 2019	
			SUB-ACTIO GE

BOX 2441 YELLOWKNIFE
NORTHWEST TERRITORIES
X1A 2P8
PHONE: 867-873-2047 FAX: 867-873-9079
WEB: WWW.SUB-ARCTIC.CA
EMAIL: SAG@SUB-ARCTIC.CA



CWP LINER AS BUILT


SION NO. 0



TMAC Resources
Hope Bay - Madrid CWP HDPE Liner

Panel log

Panel #	Solmax roll number	Length m	width	m2
P-1	138390	22.5	6.7	150.8
P-2	138390	14.5	6.7	99.3
P-3	138390	14.3	6.7	97.2
P-4	138390	14.5	6.7	95.8
P-5	138390	13.5	6.7	97.2
P-6	138390	11.8	6.7	90.5
P-7	138390	11.4	6.7	79.1
P-8	138390	11.0	6.7	76.4
P-9	138390	12.0	6.7	73.7
P-10	138390	11.0	6.7	80.4
P-11	138390	16.0	6.7	73.7
P-12	138390	15.0	6.7	107.2
P-13	138390	15.0	6.7	100.5
P-14	138390	19.5	6.7	100.5
P-15	138390	18.4	6.7	130.7
P-16	138390	17.6	6.7	123.3
P-17	138390	6.0	6.7	117.9
P-18	138390	12.0	6.7	40.2
P-19	138390	12.0	6.7	80.4
P-20	138401	12.0	6.7	80.4
P-21	138401	7.0	6.7	80.4
P-22	138401	11.3	2.3	46.9
P-23	138401	28.5	6.7	26.0
P-24	138401	27.1	6.7	191.0
P-25	138401	28.1	6.7	181.6
P-26	138401	3.7	1.1	188.3
P-27	138401	4.0	5.5	4.1
P-28	138401	11.2	5.5	22.0
P-29	138401	14.5	6.8	61.6
P-30	135267	14.7	6.6	98.6
P-31	135267	16.1	6.7	97.0
P-32	135267	15.1	6.7	107.9
P-33	135267	11.5	6.7	101.2
P-34	135267	9.1	6.7	77.1
P-35	135267	7.9	6.7	61.0
P-36	135267	8.9	6.7	52.9
			Total m2	3292.26

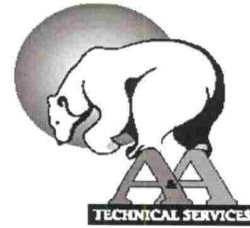


TMAC Resources
Hope Bay - Madrid CWP HDPE Liner
Daily welder qualification tests

Peel strength		Temp. 400 C Speed 2.3m/minute	
28-Jun-19	Inside weld	Outside weld	Minimum ppi (lbs/inch)
1	136	141	91
2	140	140	91
3	142	136	91
4	145	142	91
28-Jun-19	Shear Strength		Minimum ppi (lbs/inch)
1	161		120
2	155		120

Peel strength		Temp. 400 C Speed 2.3m/minute	
05-Jul-19	Inside weld	Outside weld	Minimum ppi (lbs/inch)
1	144	135	91
2	146	150	91
3	148	151	91
4	146	149	91
05-Jul-19	Shear Strength		Minimum ppi (lbs/inch)
1	161		120
2	160		120

Peel strength		Temp. 400 C Speed 2.3m/minute	
08-Jul-19	Inside weld	Outside weld	Minimum ppi (lbs/inch)
1	140	142	91
2	146	138	91
3	139	144	91
4	142	145	91
08-Jul-19	Shear Strength		Minimum ppi (lbs/inch)
1	158		120
2	155		120

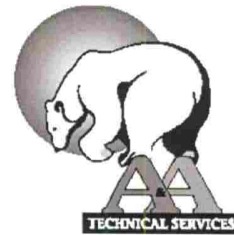

TMAC Resources
Hope Bay - Madrid CWP HDPE Liner
Daily welder qualification tests

Peel strength		Temp. 400 C Speed 2.3m/minute	
16-Jul-19	Inside weld	Outside weld	Minimum ppi (lbs/inch)
1	144	142	91
2	140	137	91
3	148	142	91
4	139	139	91
16-Jul-19	Shear Strength		Minimum ppi (lbs/inch)
1	158		120
2	161		120


Peel strength		Temp. 400 C Speed 2.3m/minute	
22-Jul-19	Inside weld	Outside weld	Minimum ppi (lbs/inch)
1	144	145	91
2	135	139	91
3	140	143	91
4	145	140	91
22-Jul-19	Shear Strength		Minimum ppi (lbs/inch)
1	153		120
2	159		120

Extrusion welder qualification Preheat 250 C Extrudite 250 C

08-Jul-19	Peel strength		Minimum ppi (lbs/inch)
1	138		78
2	144		78
	Shear Strength		
1	158		120
2	152		120

Extrusion welder qualification Preheat 250 C Extrudite 250 C

22-Jul-19	Peel strength		Minimum ppi (lbs/inch)
1	141		78
2	139		78
	Shear Strength		
1	162		120
2	158		120

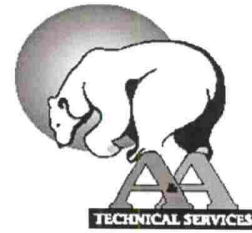

TMAC Resources
Hope Bay - Madrid CWP HDPE Liner


Non destructive air pressure testing of wedge weld seams. (5minutes)

Date	Technician	Seam location	Start psi	Finish psi	Pass/Fail	Comments
28-Jun-19	AH	P1-P2	35	35	Pass	
28-Jun-19	AH	P2-P3	30	30	Pass	
28-Jun-19	AH	P-3-P4	32	32	Pass	
28-Jun-19	AH	P-4-P5	32	32	Pass	
28-Jun-19	AH	P-5-P-6	35	35	Pass	
28-Jun-19	AH	P6-P7	30	30	Pass	
03-Jul-19	AH	P7-P8	30	30	Pass	Witnessed by SRK
03-Jul-19	AH	P8-P9	35	35	Pass	
05-Jul-19	AH	P1-P10	30	30	Pass	
05-Jul-19	AH	P10-P11	35	35	Pass	
05-Jul-19	AH	P11-P12	35	35	Pass	
05-Jul-19	AH	P12-P13	35	35	Pass	
08-Jul-19	AH	P14-P15a	35	35	Pass	
08-Jul-19	AH	P14-P15b	32	32	Pass	
08-Jul-19	AH	P15-P16	35	35	Pass	
16-Jul-19	GH	P17-P18	30	30	Pass	
16-Jul-19	GH	P18-P19	30	30	Pass	
16-Jul-19	GH	P13-P20	30	30	Pass	
16-Jul-19	GH	P20-P22	30	30	Pass	
16-Jul-19	GH	Toe P11	30	30	Pass	
16-Jul-19	GH	Toe P12	30	30	Pass	
16-Jul-19	GH	Toe P13	30	30	Pass	
16-Jul-19	GH	Toe P20	30	30	Pass	
16-Jul-19	GH	Toe P22	30	30	Pass	
16-Jul-19	GH	P22-P23	30	30	Pass	
17-Jul-19	GH	P19-P23	30	30	Pass	
17-Jul-19	GH	P18-P23	30	30	Pass	
17-Jul-19	GH	P17-P23	30	30	Pass	
17-Jul-19	GH	P23-P24	30	30	Pass	
17-Jul-19	GH	P21-P26	32	32	Pass	
17-Jul-19	GH	P26-P16	30	30	Pass	
22-Jul-19	GH	P9-P27	30	30	Pass	
22-Jul-19	GH	P27-P28	30	30	Pass	
22-Jul-19	GH	P28-P29	30	30	Pass	

P1 = Liner panel number in relation to drawing

A&A Technical Services
Yellowknife NT
June/July 2019

TMAC Resources
Hope Bay - Madrid CWP HDPE Liner

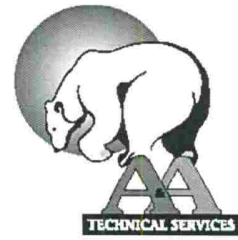

Non destructive air pressure testing of wedge weld seams. (5minutes)

[illegible]

P1 = Liner panel number in relation to drawing

CERTIFIED WELDING TECHNICIAN



**The International Association of Geosynthetic Installers
Certifies:**

ALAN HARMAN

As a **Certified Welding Technician**, in polyethylene wedge and extrusion welding, having demonstrated superior hands-on skills, knowledge and experience in the welding and installation of polyethylene (PE) geomembranes, and having basic mechanical aptitude for working with welders and equipment on the job site.
Registration number: **CWT162010**

Valid 07 June 2016 — 07 June 2021

President, IAGI

Managing Director, IAGI



CERTIFIED WELDING TECHNICIAN



The International Association of Geosynthetic Installers Certifies:

GUY HORESAY

As a **Certified Welding Technician**, in polyethylene wedge and extrusion welding, having demonstrated superior hands-on skills, knowledge and experience in the welding and installation of polyethylene (PE) geomembranes, and having basic mechanical aptitude for working with welders and equipment on the job site.

Registration number: **CWT170010**

Valid 07 June 2016 — 07 June 2021

President, IAGI

Managing Director, IAGI



A&A Technical Services
Subgrade acceptance and warranty

Client –TMAC Resources
Hope Bay
Madrid CWP HDPE Liner installation
June 25 - July 24, 2019

Upon arrival to site the fuel tank pad area to be lined was thoroughly inspected by A&A Technical Services installation supervisor and deemed to be a suitable surface on which to place the HDPE lining system. The SOLMAX 60mil textured HDPE liner was under laid with a layer of 540g/m2 non-woven geotextile supplied by the client.

Warranties issued by A&A Technical Services shall cover only the cost of replacement and/or repair of defective installations, determined or agreed to be the responsibility of A&A Technical Services, provide that the warranty work will be performed to the same standards and scope of work set out in the contract documents. A&A's installation warranty shall commence upon acceptance of the individual geosynthetic components by the owner or its representative as such components are completed. The installation warranty period shall not exceed beyond 1 years. Our installation warranty is rendered null and void if the installed geosynthetics are subject to abuse by machinery, equipment or personnel not under the control of A&A, harmful chemicals or unusual weather conditions or catastrophic earthworks failures.

A&A Technical Services shall not be held liable for defects, damage and/or deficient materials and installations, either in whole or in part should the defects, damage or deficient materials and installations arise as the result from the use of poor quality and inappropriate or unsuitable earthworks material or site preparation. This limitation of liability extends to improper and/or construction techniques, and methods and equipment used to create the earthworks covering all or any portion of the completed geosynthetic installation.

Signed:  Dated: July 25, 2019

Al Harman
President
A&A Technical Services
Yellowknife NT

Attachment 3 – Madrid North Waste Rock Pile

Attachment 3.1 Madrid North Waste Rock Pile – IFC Drawings


Engineering Drawings for the Madrid North Waste Rock Pile Hope Bay Project, Nunavut, Canada

Active Drawing Status

Drawing Number	Drawing Title	Issue	Date	Revision
MN-WRP-01	Existing Conditions (with orthophoto)	Issued for Construction	2019/08/13	1
MN-WRP-02	Existing Conditions	Issued for Construction	2019/08/13	1
MN-WRP-03	Existing Drainage Flowpaths	Issued for Construction	2019/08/13	1
MN-WRP-04	Waste Rock Pile Pad - Part 1	Issued for Construction	2019/08/13	1
MN-WRP-05	Waste Rock Pile Pad - Part 2	Issued for Construction	2019/08/13	1
MN-WRP-06	Waste Rock Pile Pad Sections	Issued for Construction	2019/08/13	1
MN-WRP-07	Waste Rock Pile	Issued for Construction	2019/08/13	1
MN-WRP-08	Waste Rock Pile Sections	Issued for Construction	2019/08/13	1
MN-WRP-09	Typical Details	Issued for Construction	2019/08/13	1
MN-WRP-10	Typical Sump Details	Issued for Construction	2019/08/13	0



Project Number: 1CT022.043

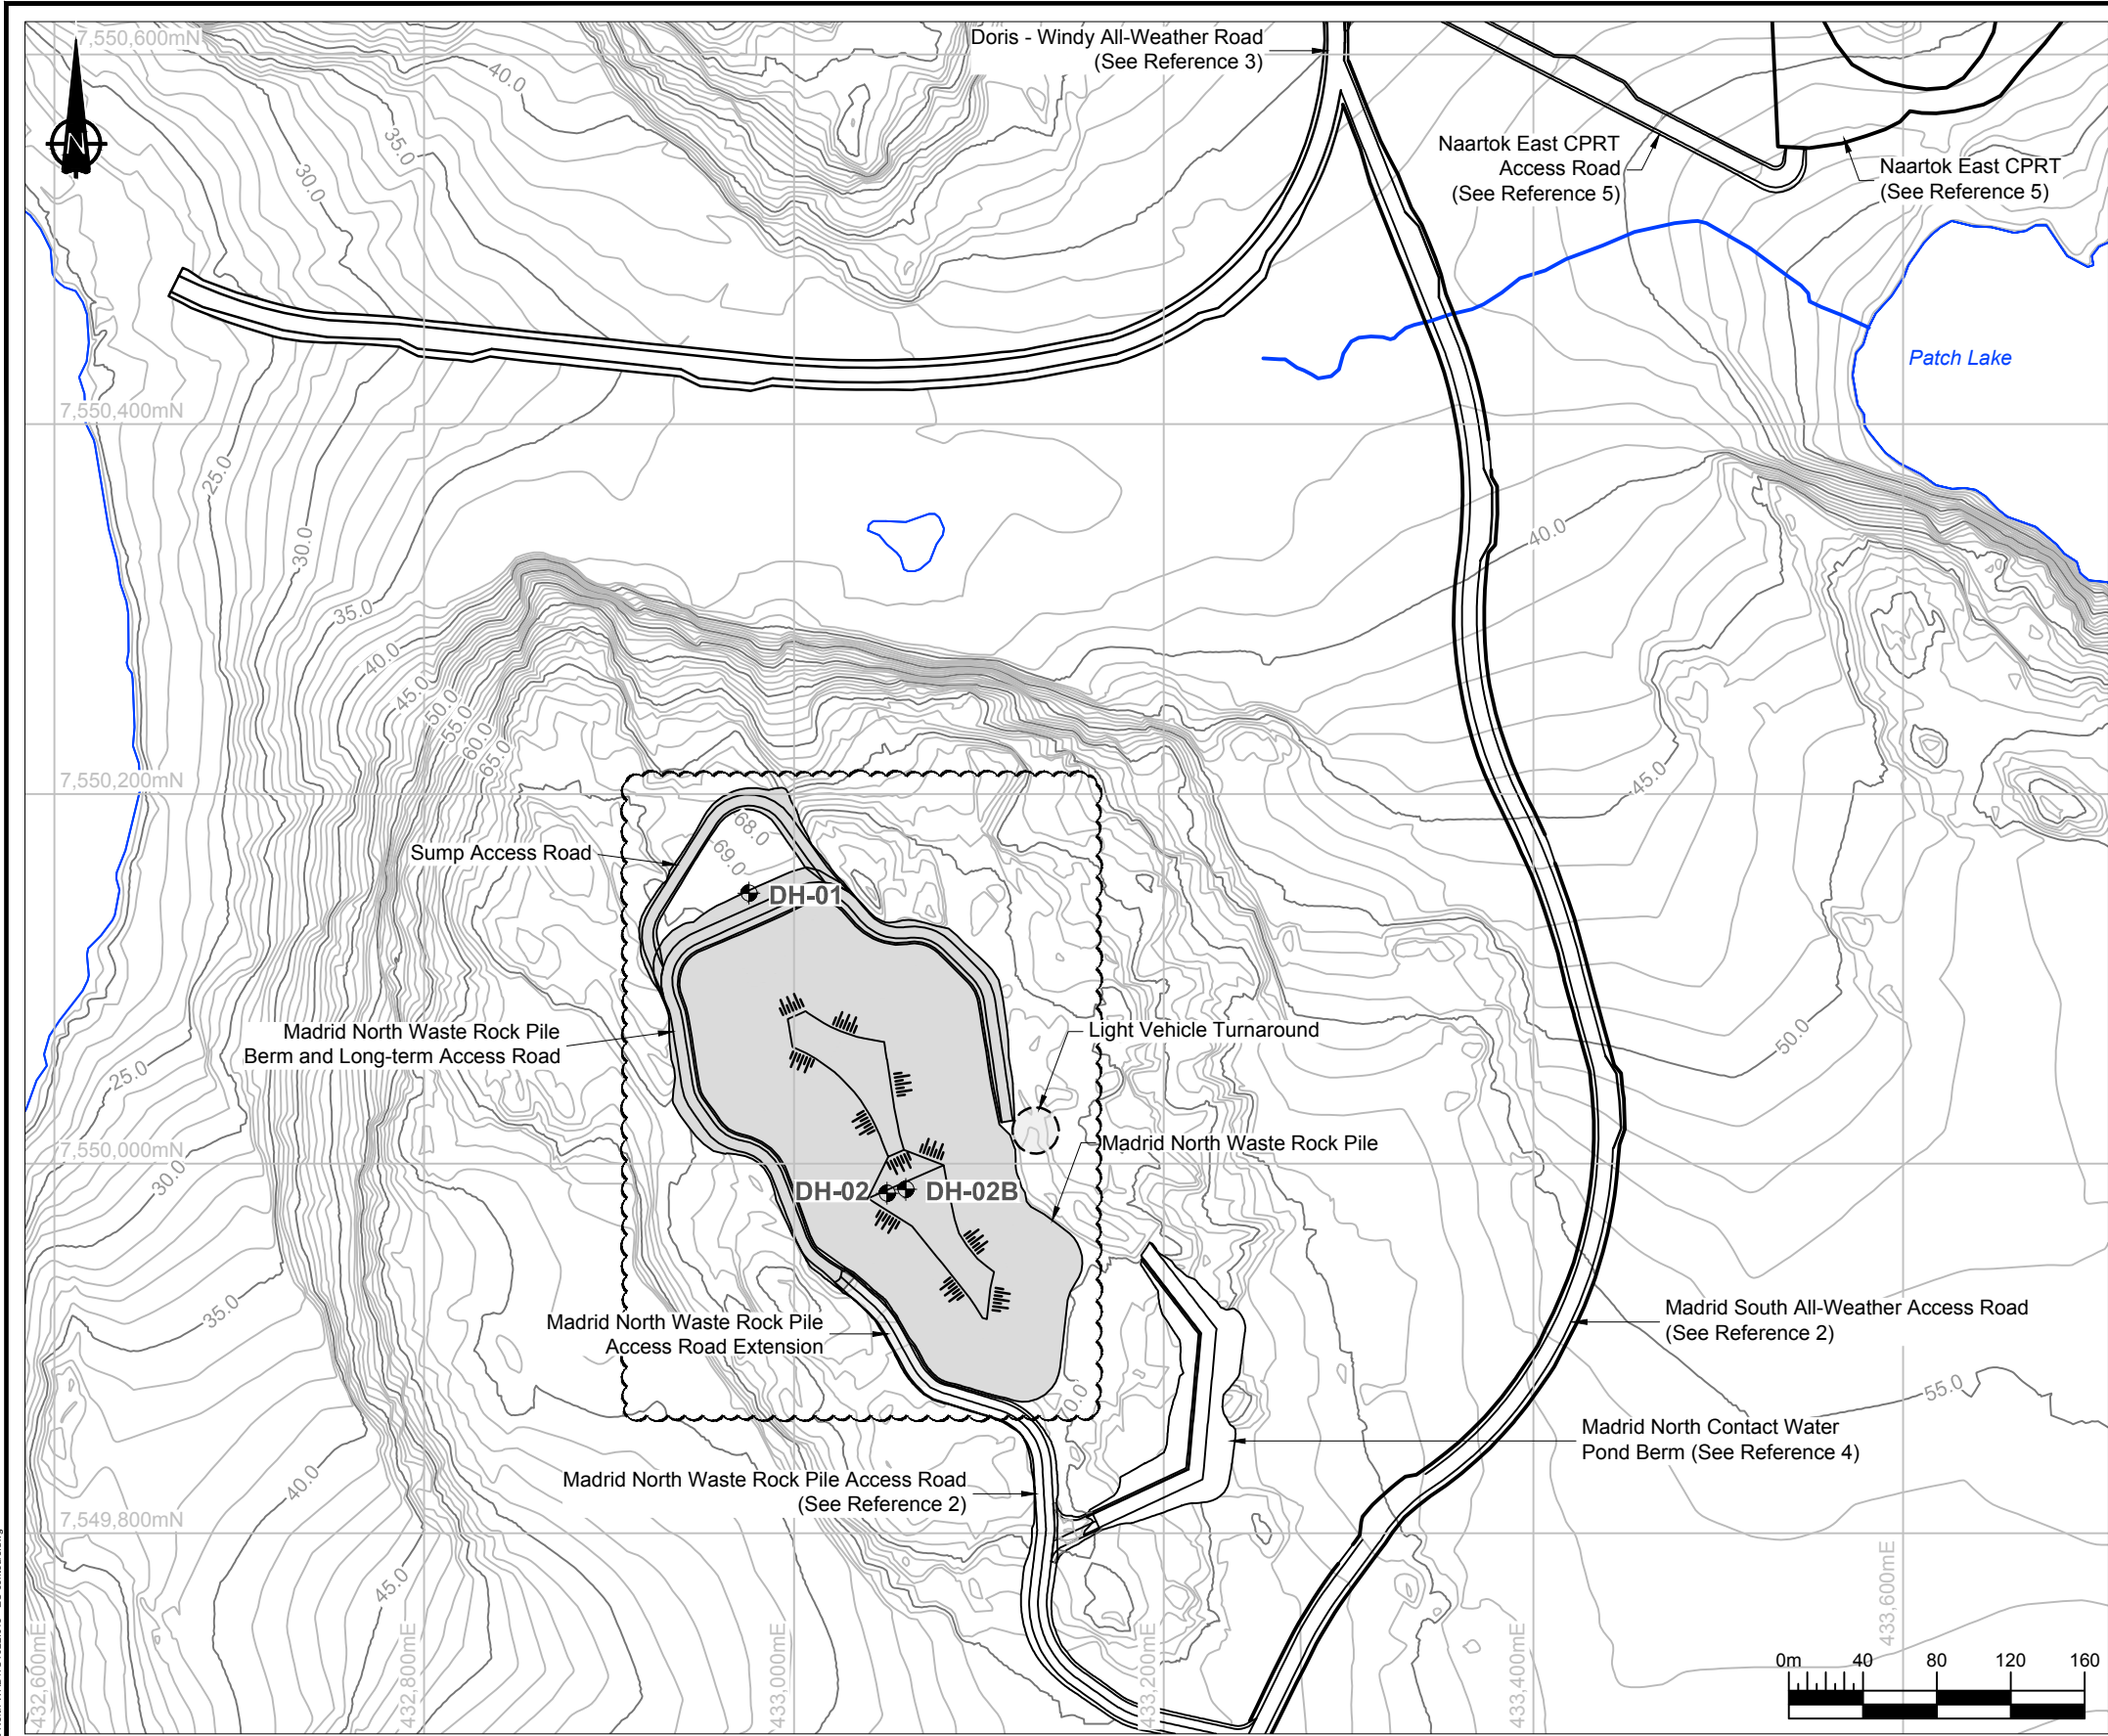

LEGEND

SRK 2018 Site Investigation Borehole

Proposed Road

Streams and Waterbodies

Proposed Infrastructure

NOTES

- The designs are based on the contour information shown on these drawings. It is the Contractor's responsibility to confirm that the contours are a fair reflection of the ground levels in the vicinity of the works, and to advise the Construction Manager and Engineer of any differences.
- Contours shown at 1.0m intervals.
- All units shown in meters unless otherwise specified.
- Construction and material specifications shall be in accordance with the following Technical Specifications: Earthworks and Geotechnical Engineering. Hope Bay Project, Nunavut, Canada. Revision H - Issued for Construction. SRK (2018).
- Madrid North Waste Rock Pile permitting design provided in Reference 5.

REFERENCES

- NAD83 UTM Zone 13.
- Engineering Drawings for the Madrid South All-Weather Road, Hope Bay Project, Nunavut, Canada. Prepared for TMAC Resources. Project Number: 1CT022.043. March 2019.
- Engineering Drawings for the Doris-Windy All-Weather Road, Doris Infrastructure Project, Nunavut, Canada. Revision AB1. As-Built drawings prepared for Hope Bay Mining Ltd. Project Number: 1CH008.033/058. May 11, 2012.
- Engineering Drawings for the Madrid North Contact Water Pond, Hope Bay Project. Prepared for TMAC Resources. Project Number 1CT022.043. March 2019.
- Engineering Permitting Drawings for the Madrid North DEIS Surface Infrastructure, Hope Bay Project, Nunavut, Canada. Prepared for TMAC Resources. Project Number 1CT022.013. November 2017.

STRATIGRAPHIC LEGEND

Clay / Silt

Sand / Gravel

Bedrock

STRATIGRAPHY SECTIONS

DH-01

Depth (m)

DH-02


Depth (m)






DH-02B

Depth (m)

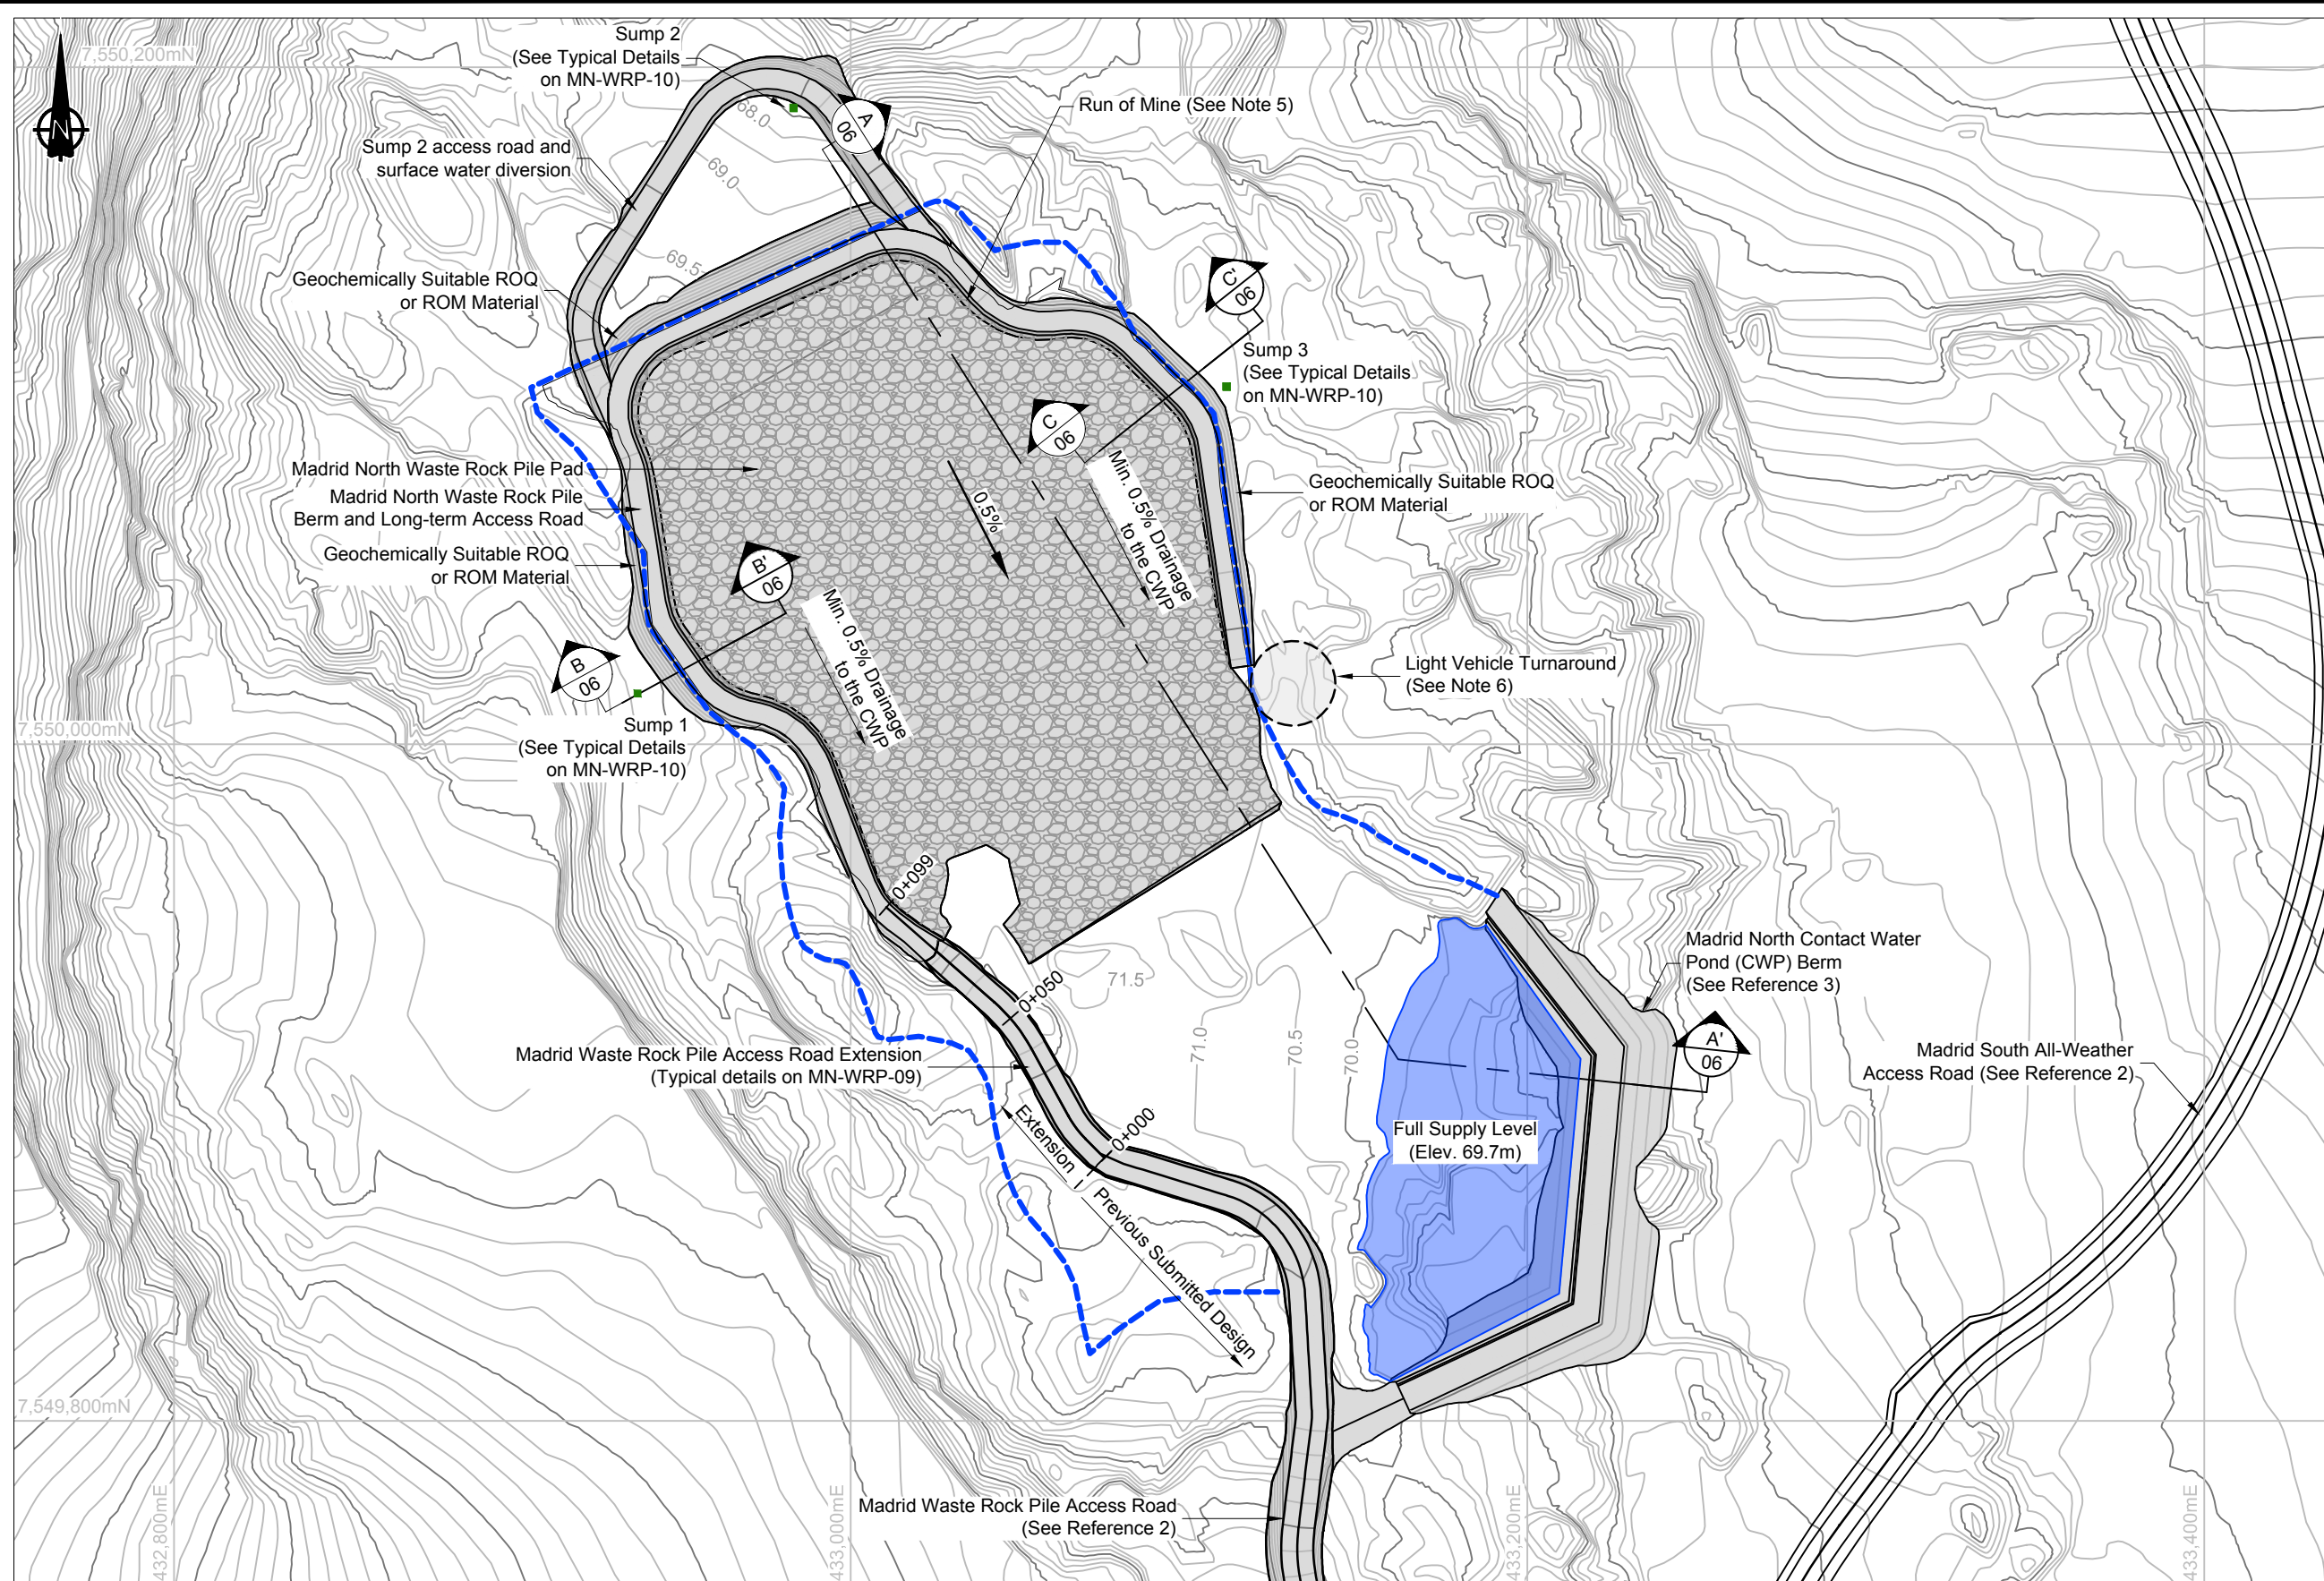
										Original Drawings Stamped and Signed by Engineer									Madrid North Waste Rock Pile		
										This drawing is uncontrolled when printed unless stamped / certified in accordance with the requirements of the applicable jurisdiction and recorded on a Distribution Register.									DRAWING TITLE: Existing Conditions		
										DESIGN: RW			DRAWN: TAH			REVIEWED: RW			Hope Bay Project		
										CHECKED: CH			APPROVED: JBK			DATE: 2019/08/12					
										FILE NAME: 1CT022.043 - EC-contours.dwg						SRK JOB NO.: 1CT022.043			DRAWING NO.: MN-WRP-02		
																			SHEET 2 OF 10		
																			REVISION NO. 1		

P:\01_SITES\Hope Bay\JCAD\EC\Madrid North WRP\1CT022.043 - EC-contours.dwg



- ## LEGEND
-
- | | |
|---|--|
|  | Sump Location |
|  | Approximate Catchment Boundary |
|  | Contact Water Pond |
|  | Geochemically Suitable Run of Quarry (ROQ) or Run of Mine (ROM) Material |
|  | Compacted and Sorted Run of Mine Material |

 1. The designs are based on the contour information shown on these drawings. It is the Contractor's responsibility to confirm that the contours are a fair reflection of the ground levels in the vicinity of the works, and to advise the Construction Manager and Engineer of any differences.
2. Contours shown at 0.5m intervals.
3. All units shown in meters unless otherwise specified.
4. Construction and material specifications shall be in accordance with the following Technical Specifications: Earthworks and Geotechnical Engineering. Hope Bay Project, Nunavut, Canada. Revision H - Issued for Construction. SRK (2018).
5. Compacted and Sorted Run of Mine Material to be built as per ROQ technical specifications, with maximum particle size reduced to 0.75m.

6. Light vehicle turnaround to be field fit to facilitate long-term access. 
7. As-built survey of compacted pad layers is required. Final as-built survey of the pad and berms is required before waste rock for the waste rock pile can be placed.

1. NAD83 UTM Zone 13.
2. Engineering Drawings for the Madrid South All-Weather Road, Hope Bay Project, Nunavut, Canada. Prepared for TMAC Resources. Project Number: 1CT022.043. March 2019.
3. Engineering Drawings for the Madrid North Contact Water Pond, Hope Bay Project. Report prepared for TMAC Resources. Project Number 1CT022.043. March 2019.

[illegible]

Original Drawings
Stamped and
Signed by Engineer

This drawing is uncontrolled when printed unless
stamped / certified in accordance with the requirements
of the applicable jurisdiction and recorded on a
Distribution Register.



DESIGN:	RW	DRAWN:	TAH	REVIEWED:	RW
CHECKED:	CH	APPROVED:	JBK	DATE:	2018/08/12
FILE NAME:	1CT022.043 - GA-max.dwg				



Hope Bay Project

SRK JOB NO.:	1CT022.043
--------------	------------

Madrid North Waste Rock Pile

DRAWING TITLE:

Waste Rock Pile Pad - Part 2

DRAWING NO.


NO. MN-WRP-05

SHEET	REVISION NO.
-------	--------------




SHEET
5 OF 10

REVISION NO. _____

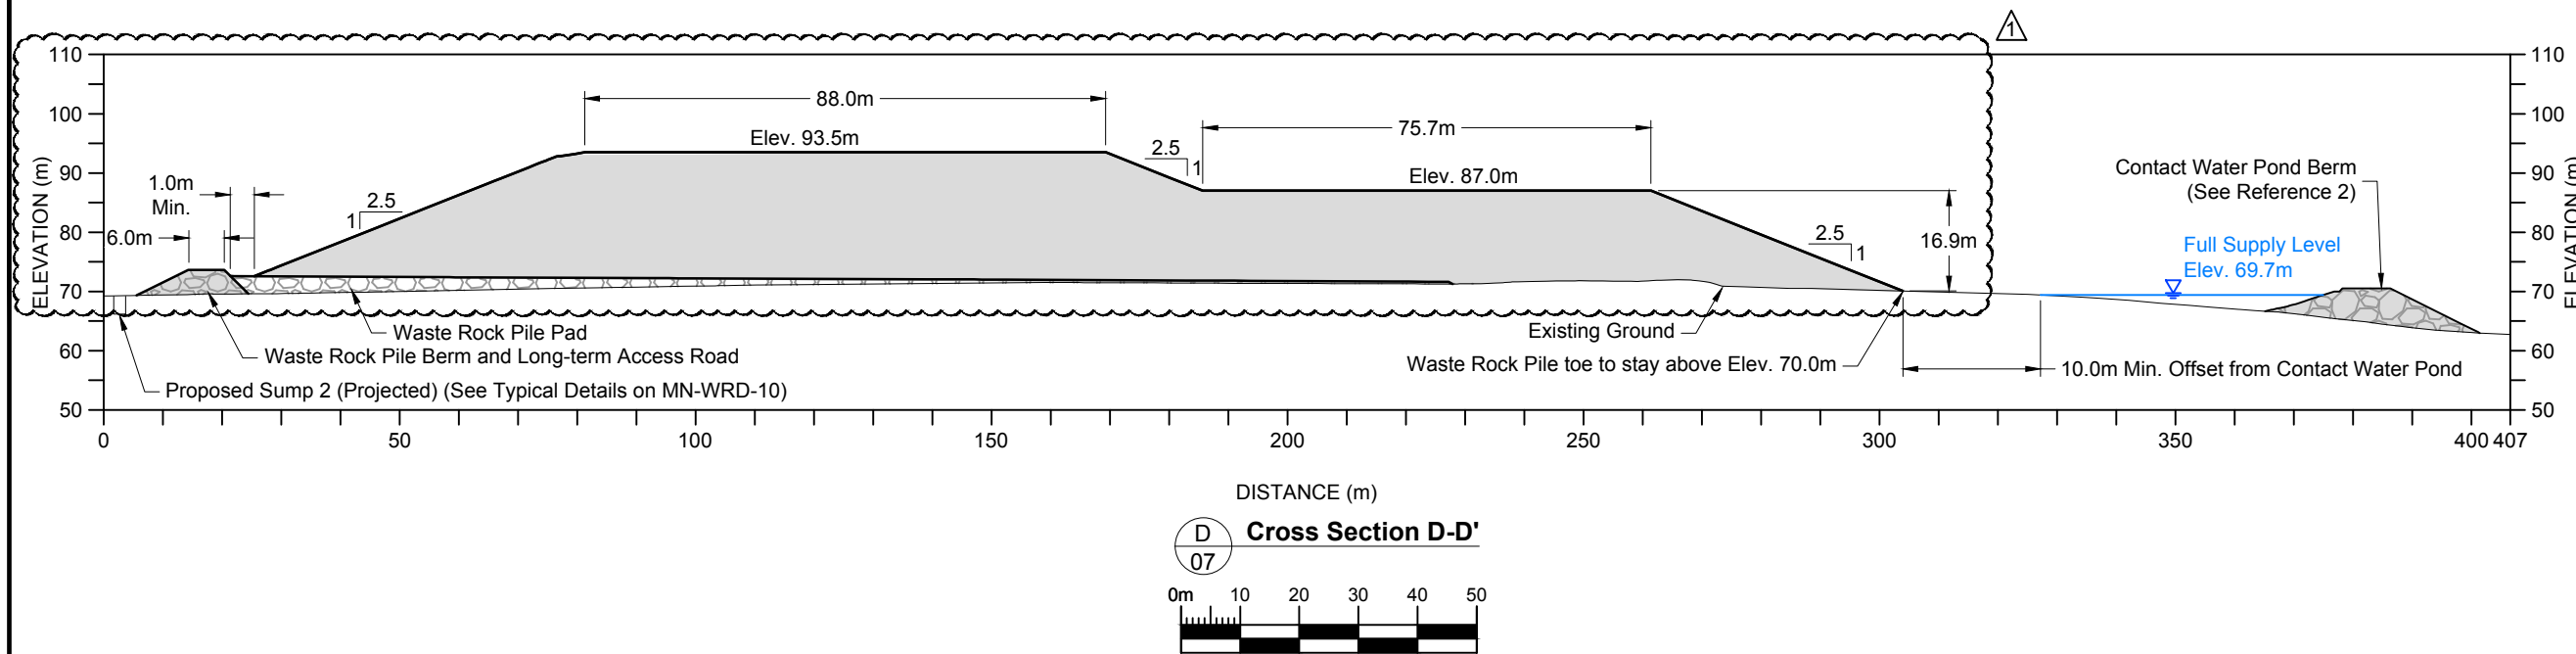1



 - ### LEGEND


-  Geochemically Suitable Run of Quarry (ROQ) or Run of Mine (ROM) Material
-  Compacted and Sorted Run of Mine Material
-  Bulk Waste Rock Material





NOTES

1. Final as-built survey of the pad and berms is required before waste rock for the waste rock pile can be placed.
2. Waste Rock Pile designed in accordance with Reference 1. Waste Rock Pile benches and access ramps to be determined by TMAC during operations. Bench heights, widths, and slope angles as per Reference 1.




REFERENCE

1. Hope Bay Project, Geotechnical Design Parameters and Overburden Summary Report. Prepared for TMAC Resources. Project Number 1CT022.013. November 2017.
2. Engineering Drawings for the Madrid North Contact Water Pond. Hope Bay Project. Prepared for TMAC Resources. Project Number 1CT022.043. March 2019.




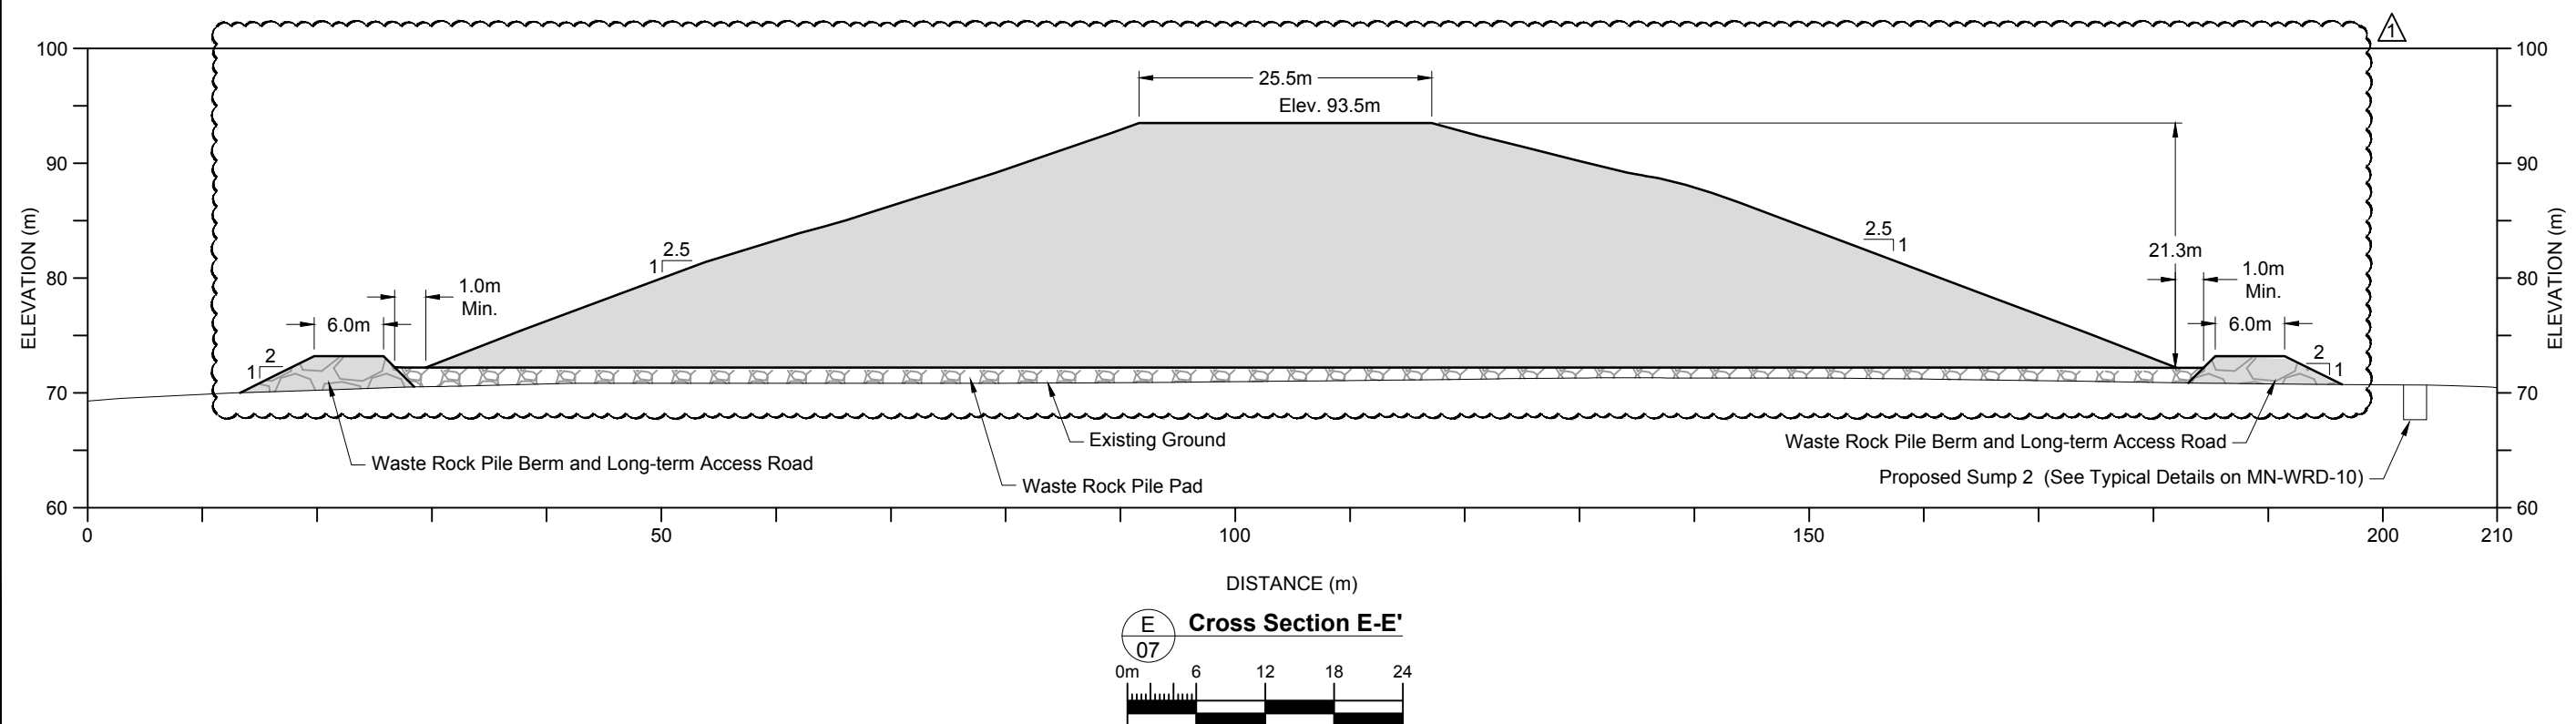
[illegible]

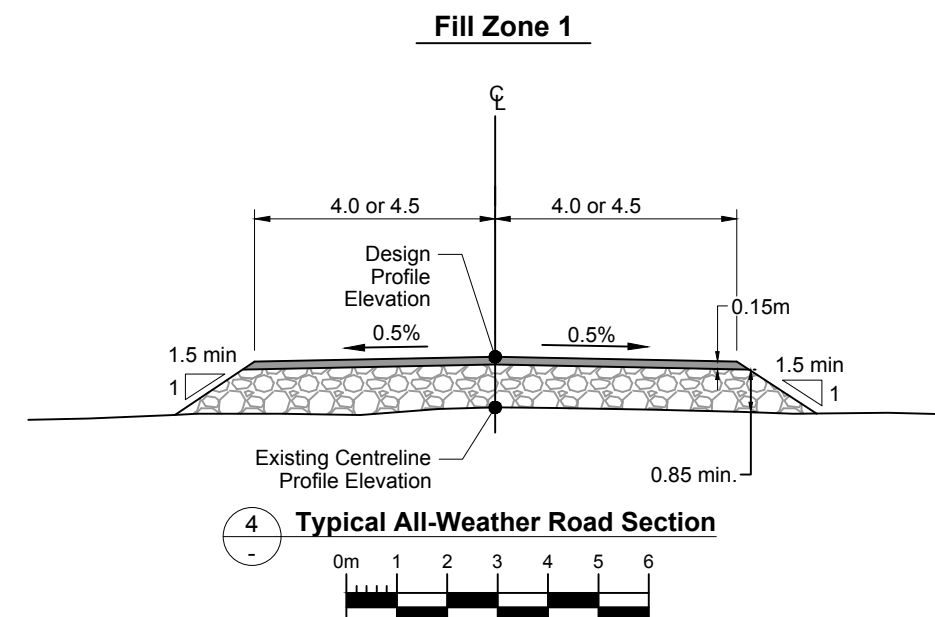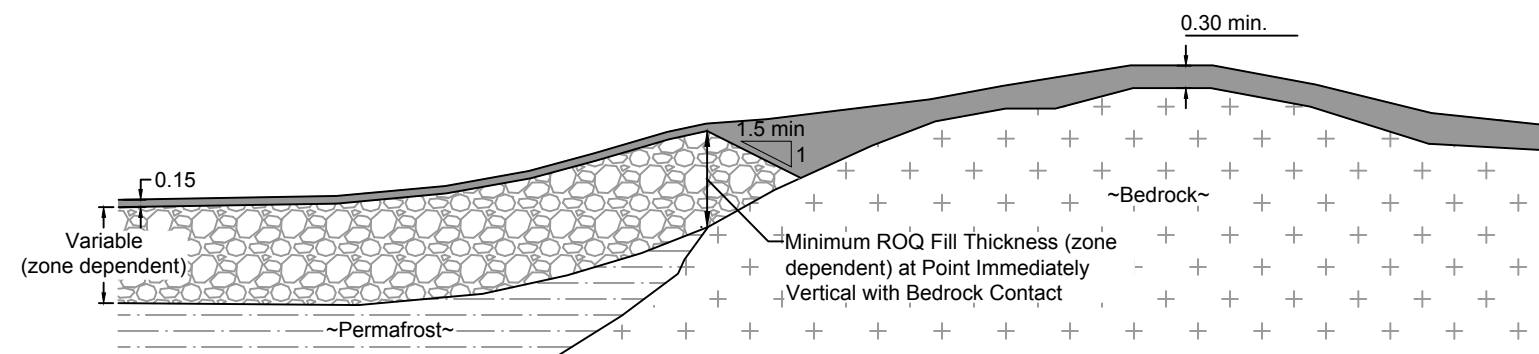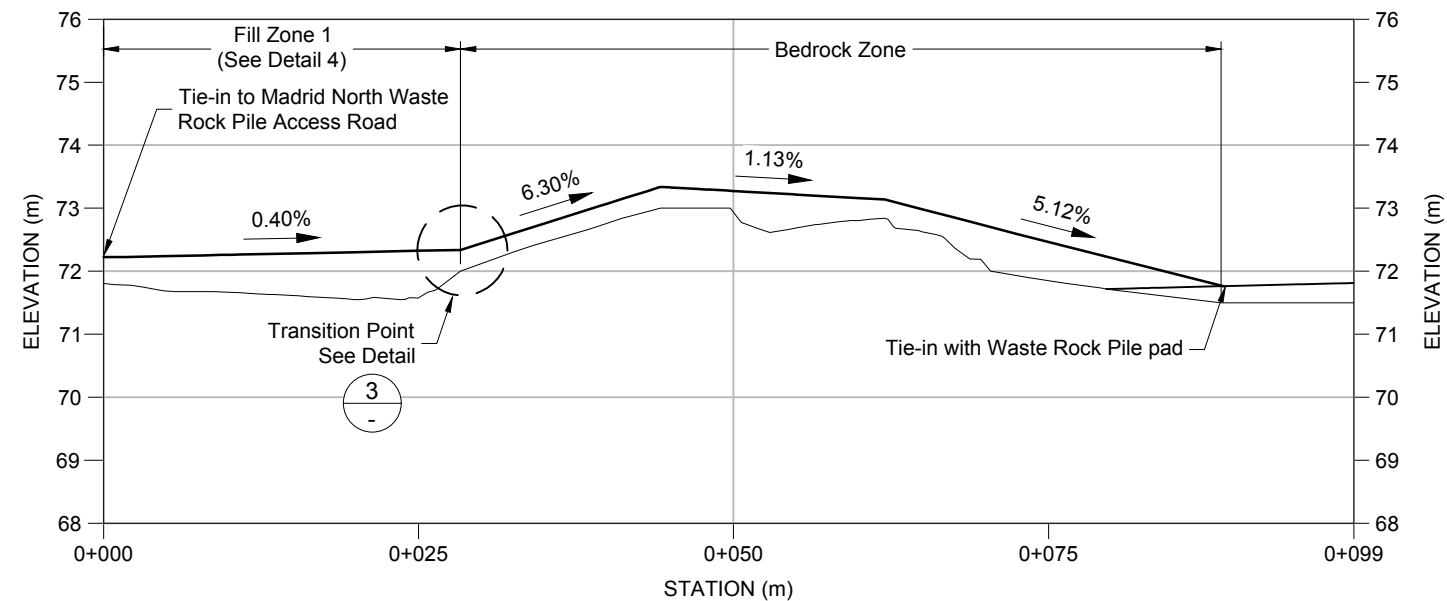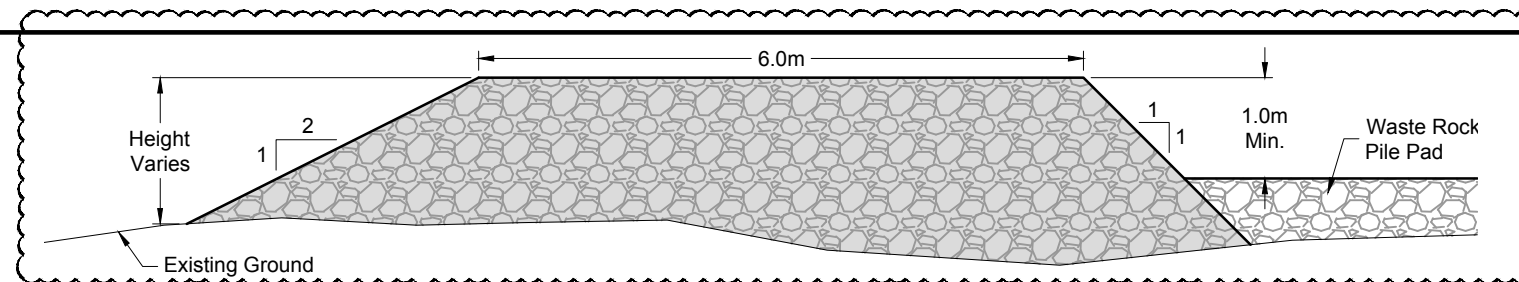[illegible]

P:\01_SITES\Hope Bay\JACAD\EC\Madrid North WRP\1CT022.043 - Sump.dwg

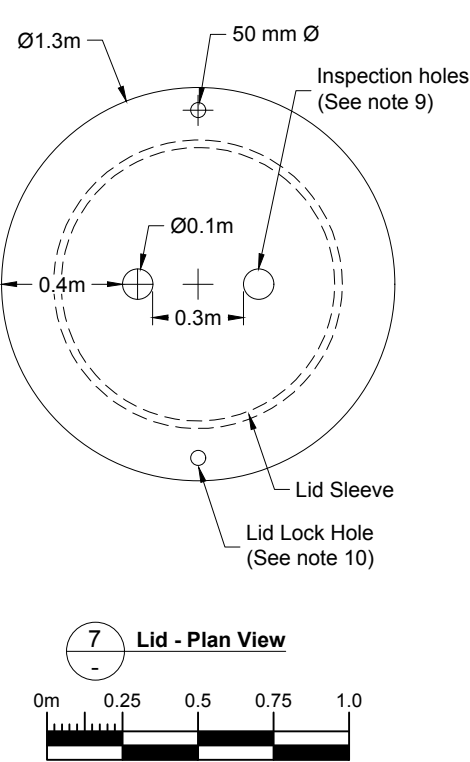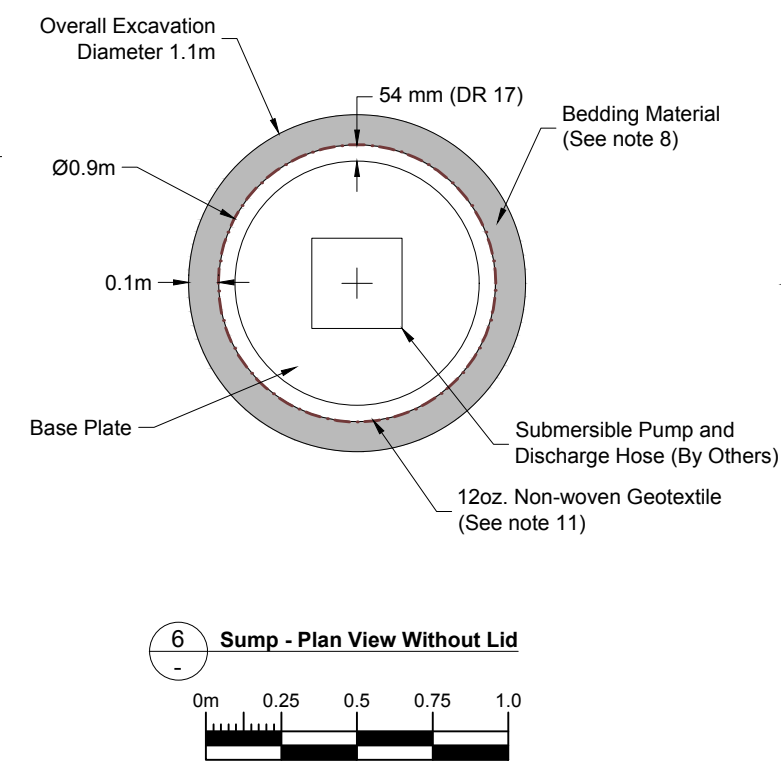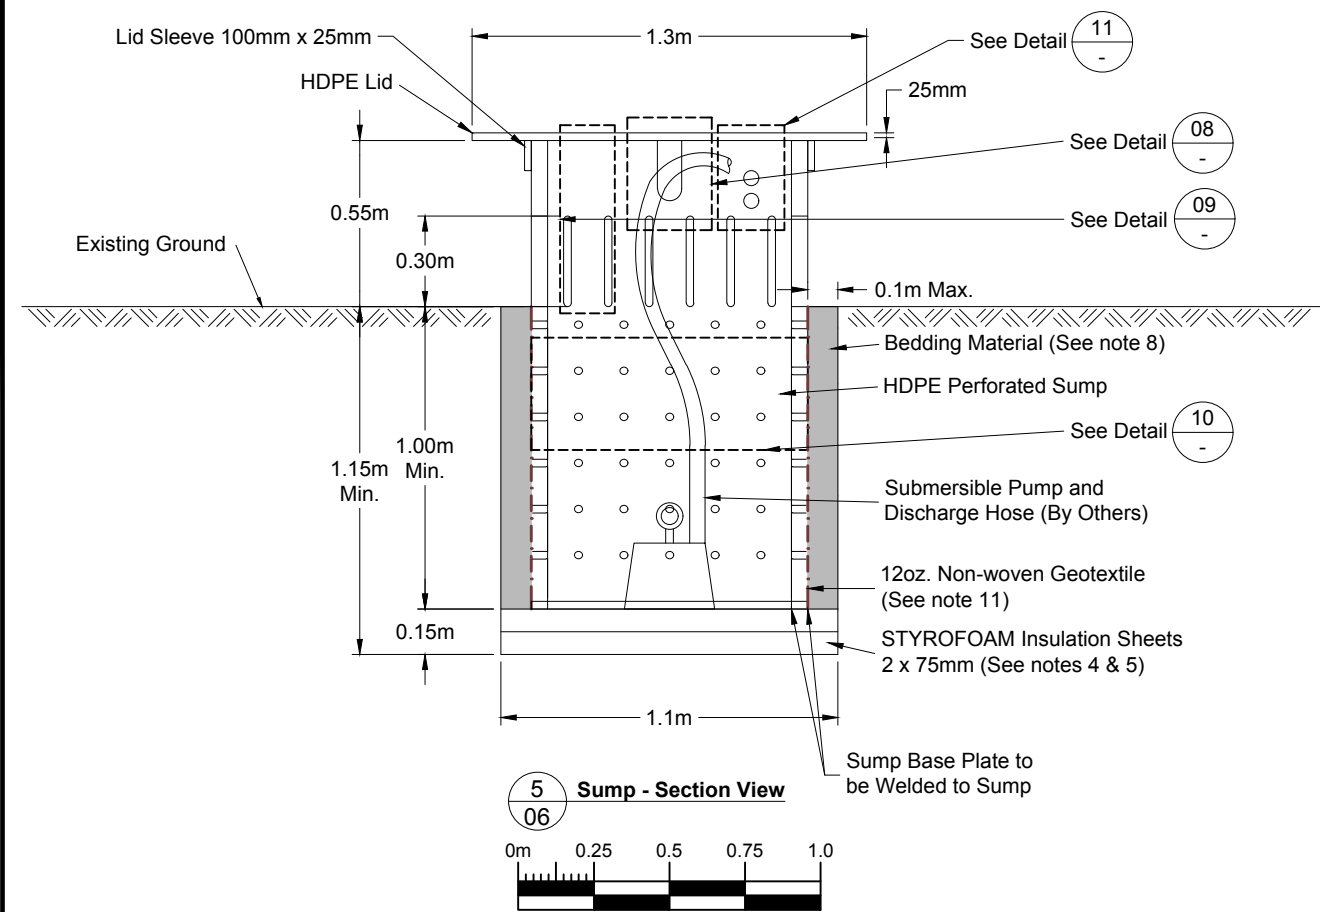

- LEGEND**
- 12oz. Non-Woven Geotextile
 - Bedding Material
- NOTES**
- All units in meters unless otherwise specified.
 - Construction shall be in accordance with the following Technical Specifications: Earthworks and Geotechnical Engineering. Hope Bay Project, Nunavut, Canada. Revision H - Issued for Construction.
 - The size and type of pump shall be specified by others, but no continuous or intermittent heat source shall be located within the sump.
 - The insulation sheets shall be of type STYROFOAM Highload 40 manufactured by Dow Chemical Company, or equivalent. Adjacent horizontal layers of STYROFOAM insulation shall be rotated by 90 degrees.
 - Contractor to place STYROFOAM insulation by cutting to suit.
 - Special hand excavation techniques shall be considered for inserting the sump into the ground. The maximum annulus between the outside edge of the sump and the excavation shall be 100 mm. No excavation into the tundra is permitted outside the sump footprint. A 10 m buffer zone on the undisturbed tundra around the sump shall be established, and no tracked or wheeled construction equipment is allowed within this buffer zone.
 - Excavated overburden to be disposed of on existing Naartok East Overburden Stockpile. No excavated overburden to be left on tundra surrounding sump.
 - Bedding material to be backfilled in thin layers (<0.3 m) and compacted by hand with crowbar or similar to ensure no bridging or large voids within backfill.
 - Inspection holes to be covered with wire mesh to prevent animal entry.
 - Lid to be secured to sump via lid lock holes with rope or straps (by others).
 - Geotextile to be secured to sump prior to placement in excavation.

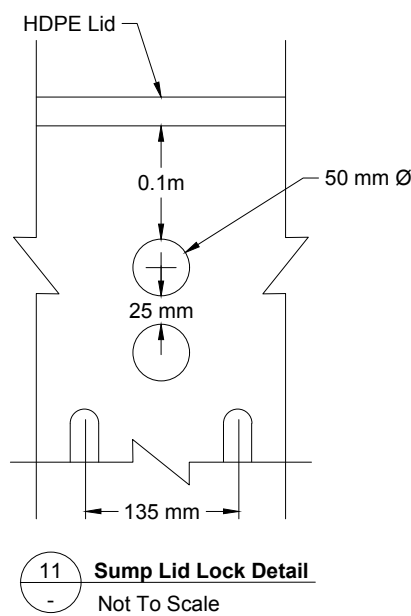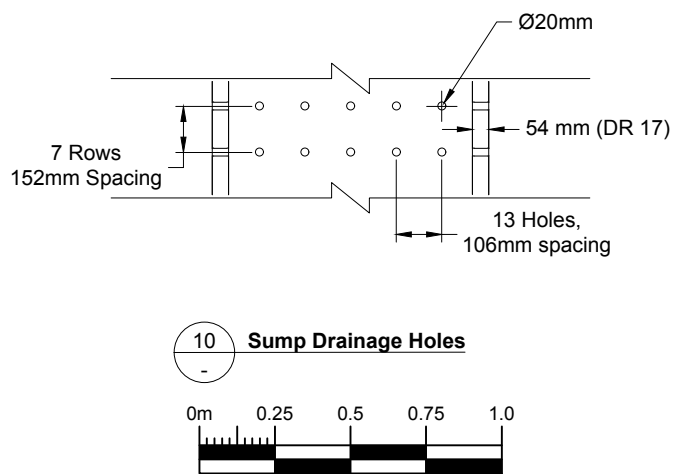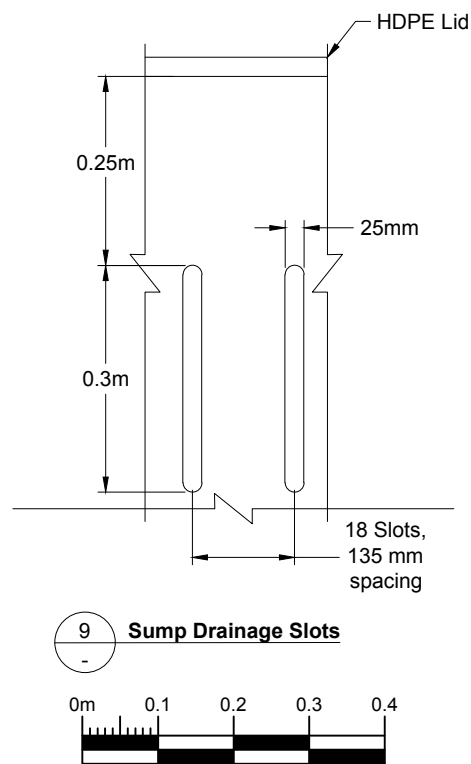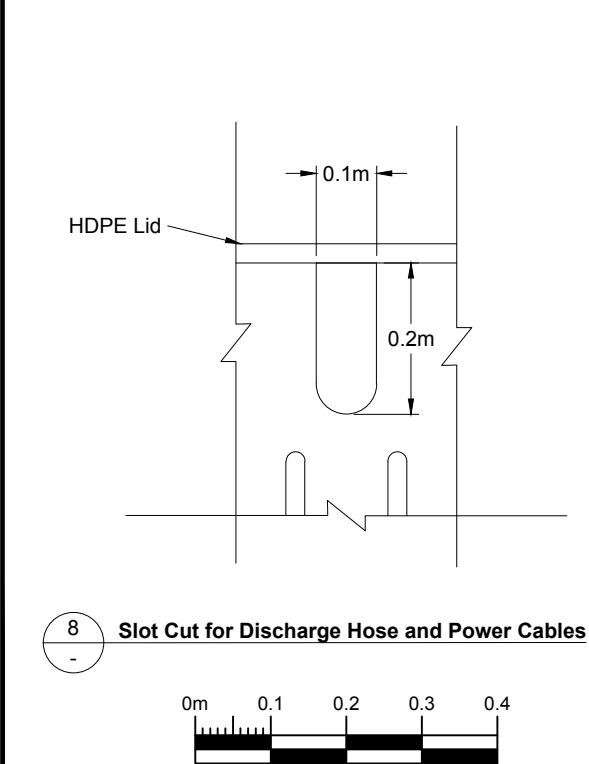

REFERENCE DRAWINGS	REVISIONS
MN-WRP-06	Waste Rock Pad Sections
DRAWING NO.	DRAWING TITLE
NO.	DESCRIPTION
CHKD	APPD
DATE	NO.
DATE	DESCRIPTION
CHKD	APPD
DATE	DESCRIPTION

Original Drawings
Stamped and
Signed by Engineer

This drawing is uncontrolled when printed unless stamped / certified in accordance with the requirements of the applicable jurisdiction and recorded on a Distribution Register.

srk consulting

DESIGN: CH
DRAWN: TH
REVIEWED: TW

CHECKED: CH
APPROVED: JBK
DATE: 2019/08/12

FILE NAME: 1CT022.043 - Sump.dwg

TMAC RESOURCES

Hope Bay Project

SRK JOB NO.: 1CT022.043

Madrid North Waste Rock Pile

DRAWING TITLE:
Typical Sump Details

DRAWING NO.: MN-WRP-10
SHEET: 10 OF 10
REVISION NO.: 0

Attachment 3.2 Madrid North Waste Rock Pile – Interim As-built Drawings


Engineering Drawings for the Madrid North Waste Rock Pile Hope Bay Project, Nunavut, Canada

Active Drawing Status

Drawing Number	Drawing Title	Issue	Date	Revision
MN-WRP-01	Existing Conditions (with orthophoto)	As-Built	2020/03/31	AB1
MN-WRP-02	Existing Conditions	As-Built	2020/03/31	AB1
MN-WRP-03	Existing Drainage Flowpaths	As-Built	2020/03/31	AB1
MN-WRP-04	Waste Rock Pile Pad - Part 1	As-Built	2020/03/31	AB1
MN-WRP-05	Waste Rock Pile Pad - Part 2	As-Built	2020/03/31	AB1
MN-WRP-06	Waste Rock Pile Pad Sections	As-Built	2020/03/31	AB1
MN-WRP-07	Waste Rock Pile	As-Built	2020/03/31	AB1
MN-WRP-08	Waste Rock Pile Sections	As-Built	2020/03/31	AB1
MN-WRP-09	Typical Details	As-Built	2020/03/31	AB1
MN-WRP-10	Typical Sump Details	As-Built	2020/03/31	AB1



Project Number: 1CT022.043

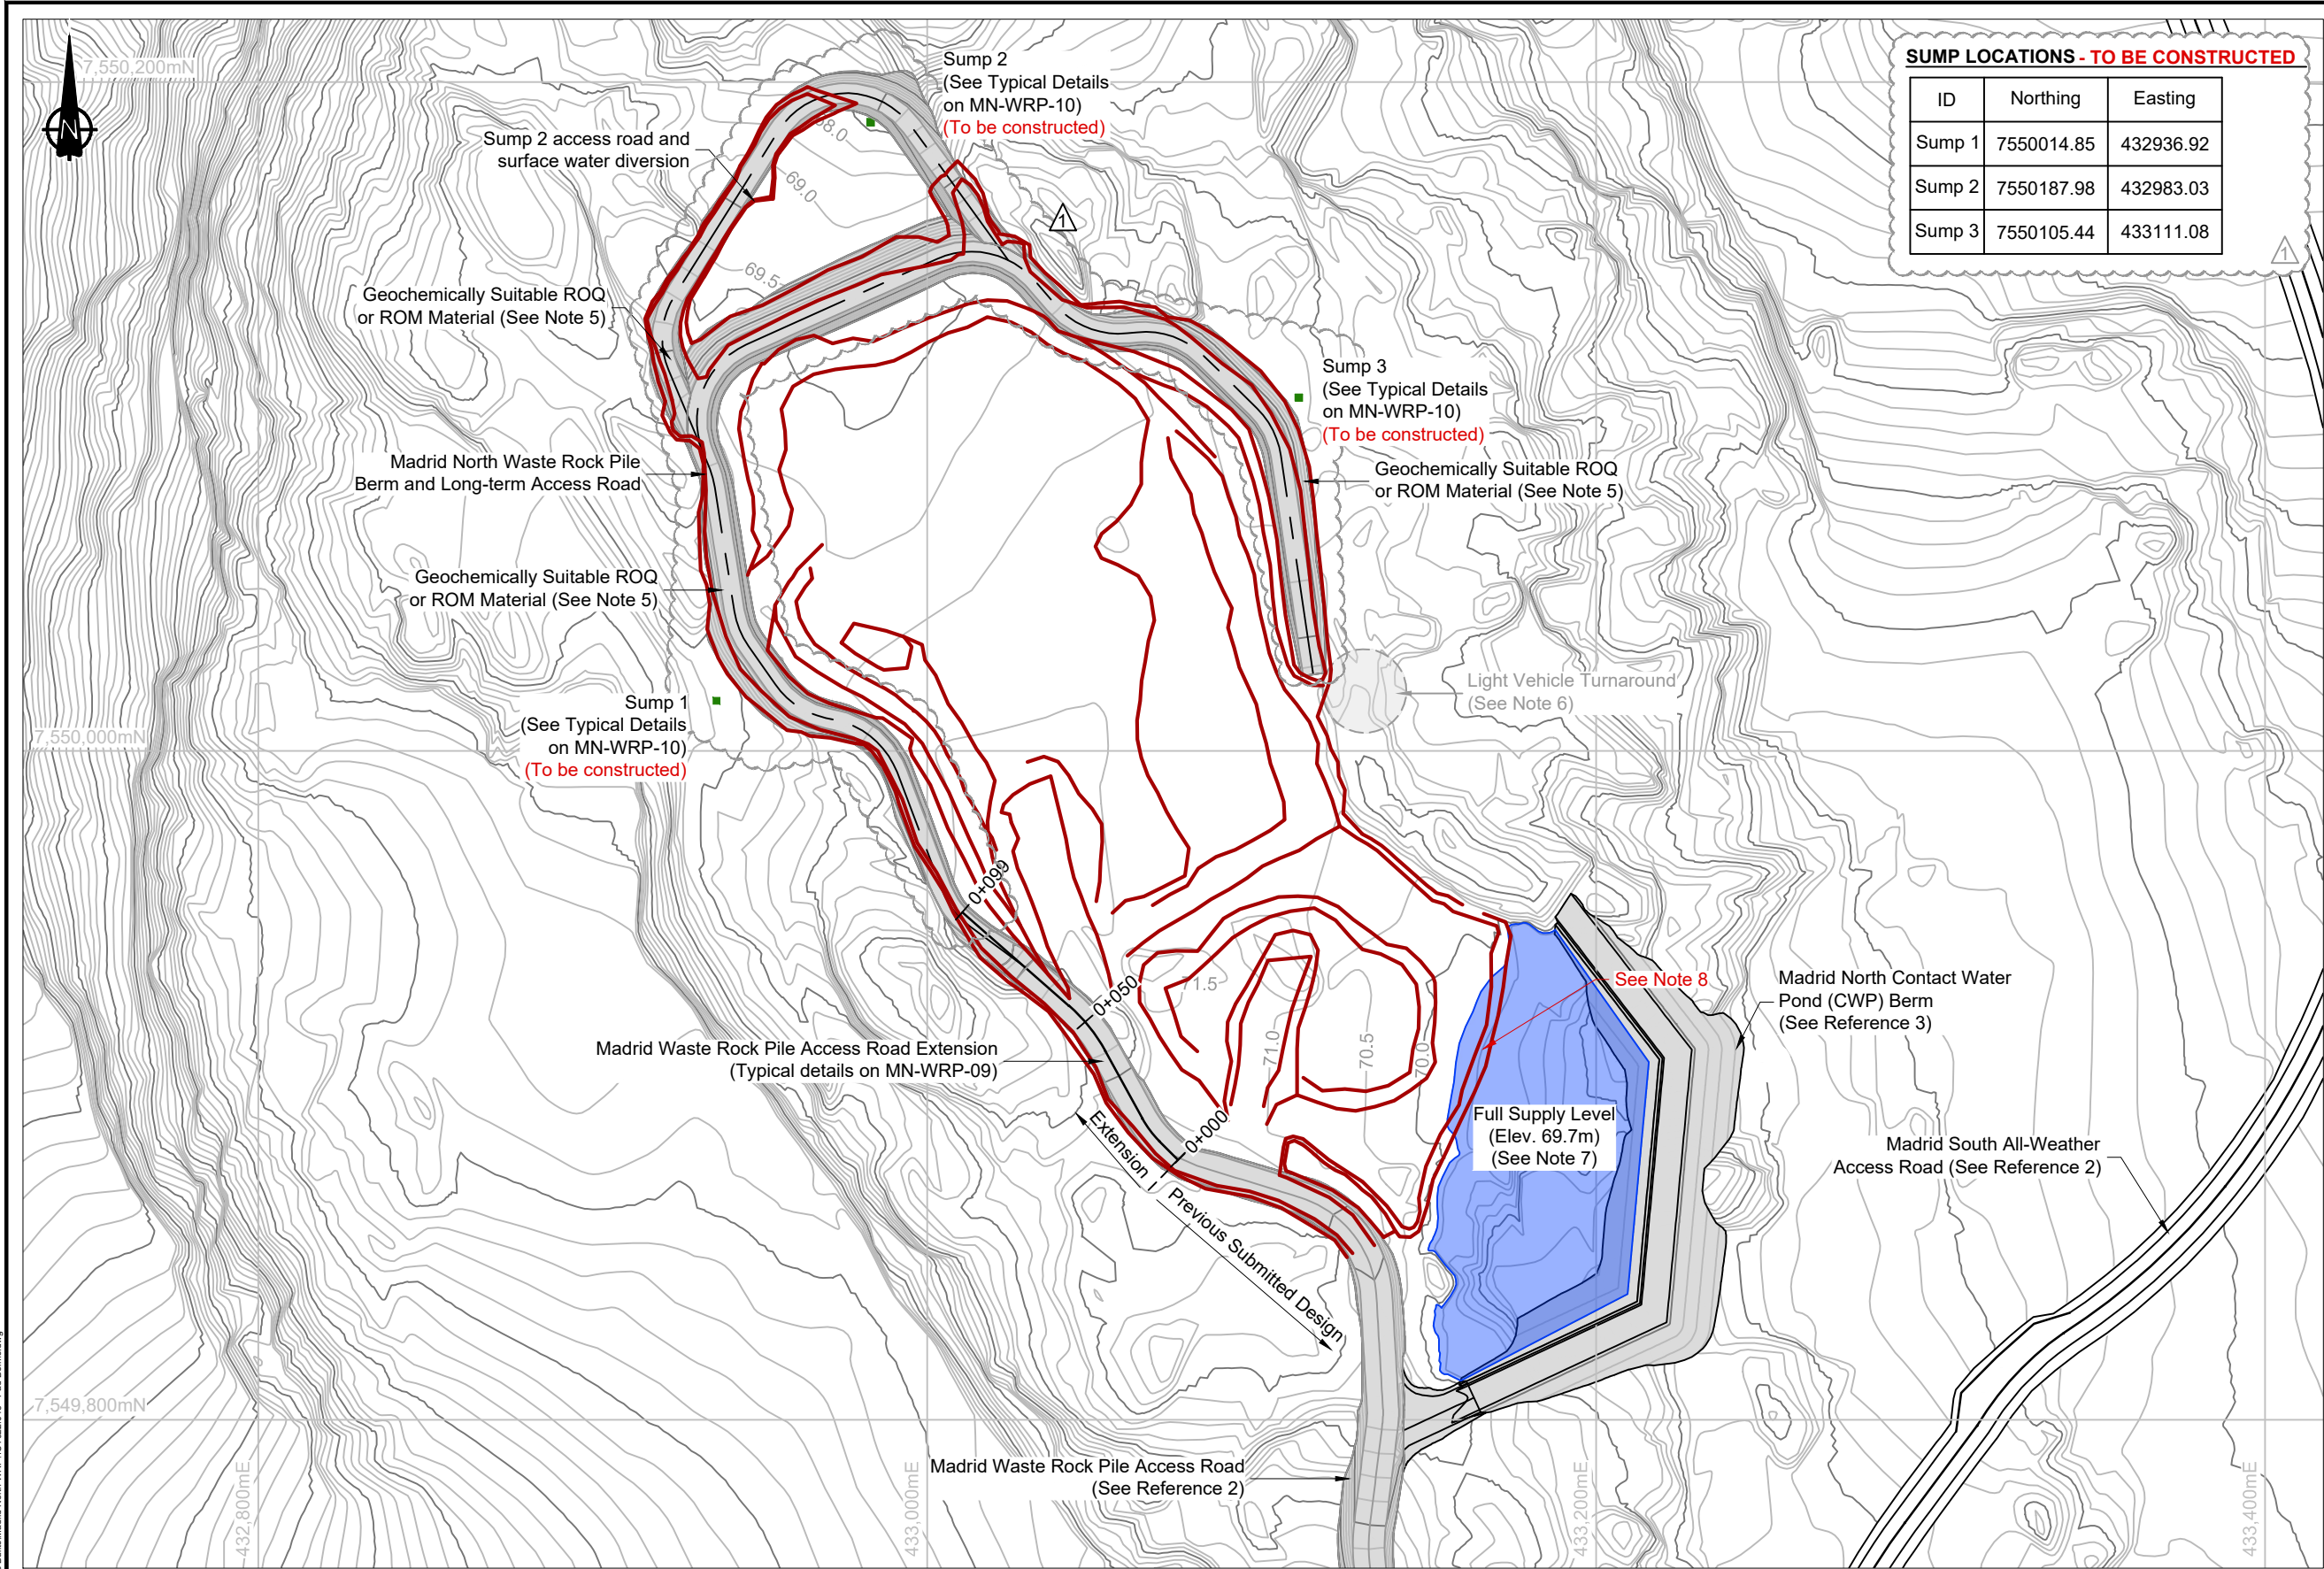

SUMP LOCATIONS - TO BE CONSTRUCTED

ID	Northing	Easting
Sump 1	7550014.85	432936.92
Sump 2	7550187.98	432983.03
Sump 3	7550105.44	433111.08

LEGEND

- Sump Location
- As-Constructed WRP (2019)
- Contact Water Pond
- Geochemically Suitable Run of Quarry (ROQ) or Run of Mine (ROM) Material

NOTES

- The designs are based on the contour information shown on these drawings. It is the Contractor's responsibility to confirm that the contours are a fair reflection of the ground levels in the vicinity of the works, and to advise the Construction Manager and Engineer of any differences.
- Contours shown at 0.5m intervals.
- All units shown in meters unless otherwise specified.
- Construction and material specifications shall be in accordance with the following Technical Specifications: Earthworks and Geotechnical Engineering. Hope Bay Project, Nunavut, Canada. Revision H - Issued for Construction. SRK (2018).
- Geochemically suitable ROQ or ROM to be built as per ROQ technical specifications.
- Light vehicle turnaround to be field fit to facilitate long-term access.
- The CWP is intended to be operated in a dry state with a maximum two weeks residence time.
- Existing topography shown is based on LiDAR survey and not actual field conditions. During construction, the 70.0m contour was surveyed and staked out by Sub-Arctic. The WRP toe is built along the true 70.0m contour and is above the CWP Full Supply Level.

REFERENCES

- NAD83 UTM Zone 13.
- Engineering Drawings for the Madrid South All-Weather Road, Hope Bay Project, Nunavut, Canada. Prepared for TMAC Resources. Project Number: 1CT022.043. March 2019.
- Engineering Drawings for the Madrid North Contact Water Pond, Hope Bay Project. Report prepared for TMAC Resources. Project Number 1CT022.043. March 2019.
- As-Built data provided by Sub-Arctic Geomatics Ltd. June 2019 - January 2020.



REFERENCE DRAWINGS	NO.	DRAWING TITLE	DESCRIPTION	CHKD	APPD	DATE	NO.	DESCRIPTION	CHKD	APPD	DATE
MN-WRP-03	Existing Drainage Flowpaths	--	--	--	--	--	0	Issued for Construction	RW	JBK	19/06/14
REVISIONS											
AB1											
As-Built											
RW											
1											
Issued for Construction											
RW											
19/08/12											



DESIGN:	RW	DRAWN:	TAH	REVIEWED:	RW
CHECKED:	CH	APPROVED:	JBK	DATE:	2020/03/31
FILE NAME: 1CT022.043 - Pad Berms.dwg					



Hope Bay Project

SRK JOB NO.: 1CT022.043

Madrid North Waste Rock Pile

DRAWING TITLE:

Waste Rock Pile Pad - Part 1

DRAWING NO.


MN-WRP-04

SHEET

4 OF 10

REVISION NO.

AB1

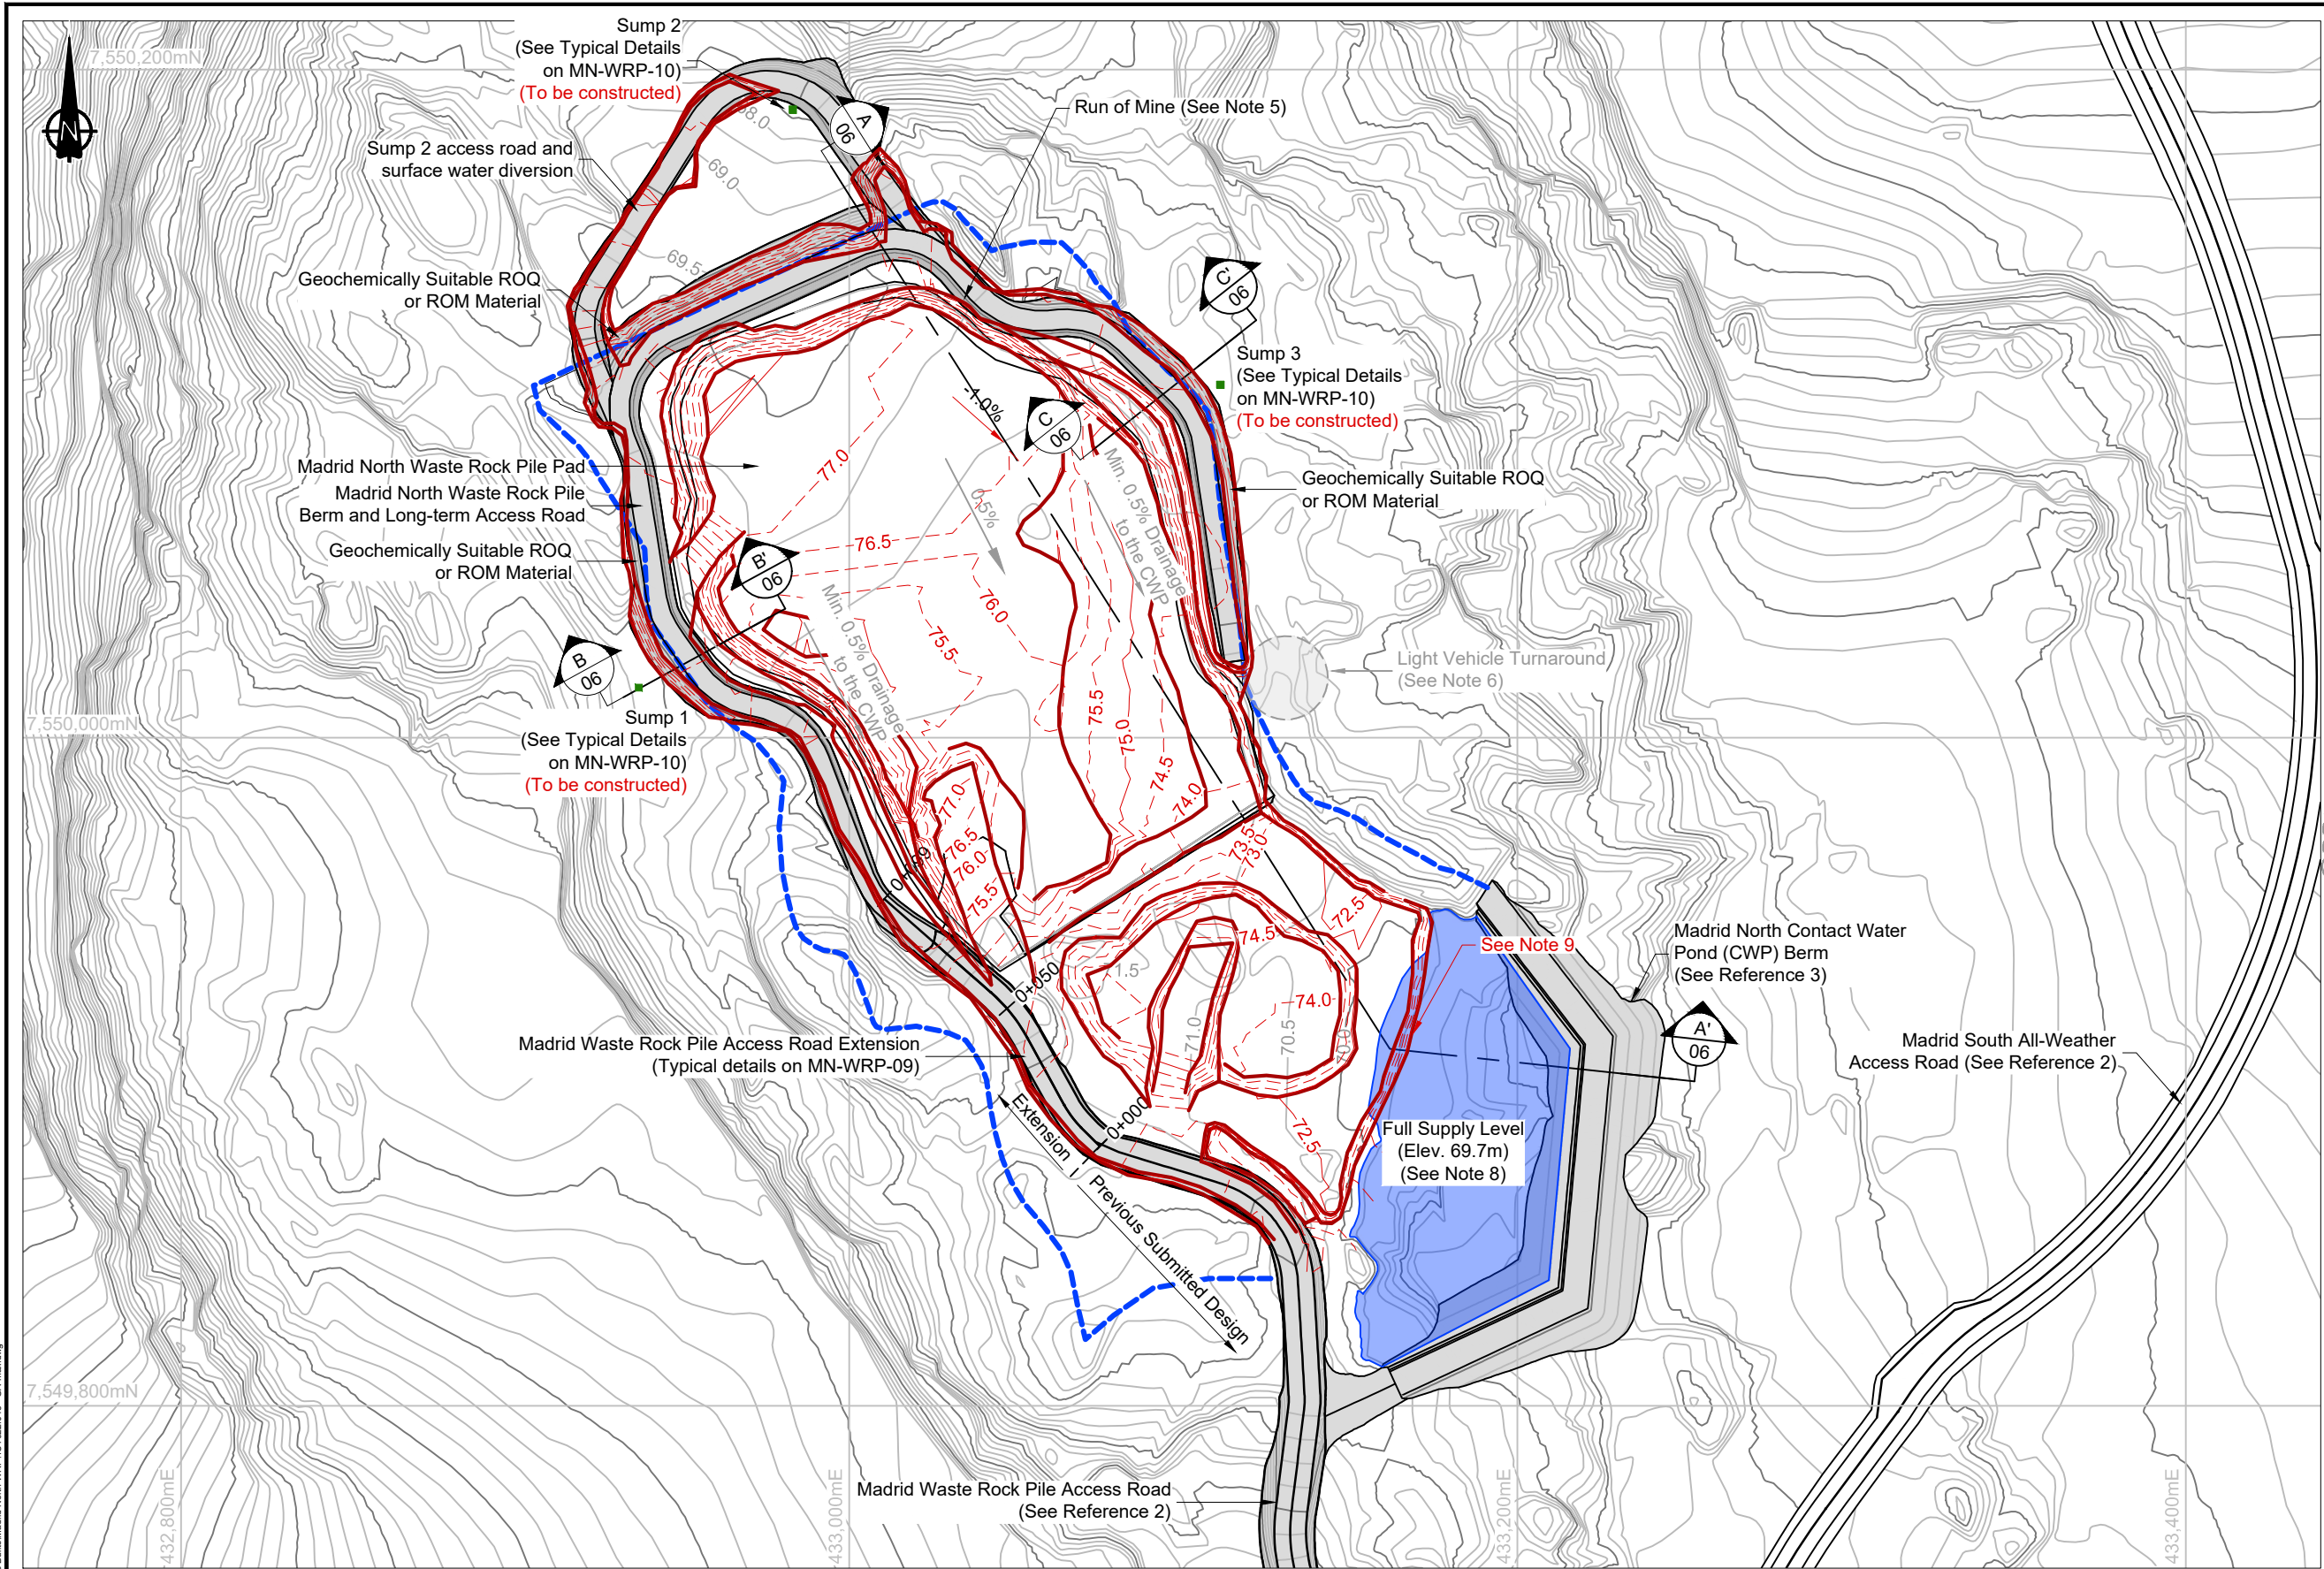

LEGEND

- Sump Location
- Approximate Catchment Boundary
- Contact Water Pond
- Geochemically Suitable Run of Quarry (ROQ) or Run of Mine (ROM) Material
- Compacted and Sorted Run of Mine Material
- As-Constructed WRP (2019)

NOTES

- The designs are based on the contour information shown on these drawings. It is the Contractor's responsibility to confirm that the contours are a fair reflection of the ground levels in the vicinity of the works, and to advise the Construction Manager and Engineer of any differences.
- Contours shown at 0.5m intervals.
- All units shown in meters unless otherwise specified.
- Construction and material specifications shall be in accordance with the following Technical Specifications: Earthworks and Geotechnical Engineering. Hope Bay Project, Nunavut, Canada. Revision H - Issued for Construction. SRK (2018).
- Compacted and Sorted Run of Mine Material to be built as per ROQ technical specifications, with maximum particle size reduced to 0.75m.
- Light vehicle turnaround to be field fit to facilitate long-term access.
- As-built survey of compacted pad layers is required. Final as-built survey of the pad and berms is required before waste rock for the waste rock pile can be placed.
- The CWP is intended to be operated in a dry state with a maximum two weeks residence time.
- Existing topography shown is based on LiDAR survey and not actual field conditions. During construction, the 70.0m elevation contour was surveyed and staked-out by Sub-Arctic. The WRP toe is built along the true 70.0m contour and is above the CWP Full Supply Level.

REFERENCES

- NAD83 UTM Zone 13.
- Engineering Drawings for the Madrid South All-Weather Road, Hope Bay Project, Nunavut, Canada. Prepared for TMAC Resources. Project Number: 1CT022.043. March 2019.
- Engineering Drawings for the Madrid North Contact Water Pond, Hope Bay Project. Report prepared for TMAC Resources. Project Number 1CT022.043. March 2019.
- As-Built data provided by Sub-Arctic Geomatics Ltd. June 2019 - January 2020.



REFERENCE DRAWINGS				REVISIONS			
DRAWING NO.	DRAWING TITLE	NO.	DESCRIPTION	CHKD	APPD	DATE	DESCRIPTION
MN-WRP-06	Waste Rock Pile Pad Sections	--	--	--	--	--	--
AB1	As-Built	1	Issued for Construction	RW	JBK	20/03/31	
0	Issued for Construction	RW	JBK	19/08/13			
A	Issued for Discussion	--	--	--	--	--	



srk consulting

DESIGN: RW DRAWN: TAH REVIEWED: RW

CHECKED: CH APPROVED: JBK DATE: 2020/03/31

FILE NAME: 1CT022.043 - GA-max.dwg

TMAC RESOURCES


Hope Bay Project

SRK JOB NO.: 1CT022.043


Madrid North Waste Rock Pile

DRAWING TITLE: Waste Rock Pile Pad - Part 2


DRAWING NO. MN-WRP-05 SHEET 5 OF 10 REVISION NO. AB1

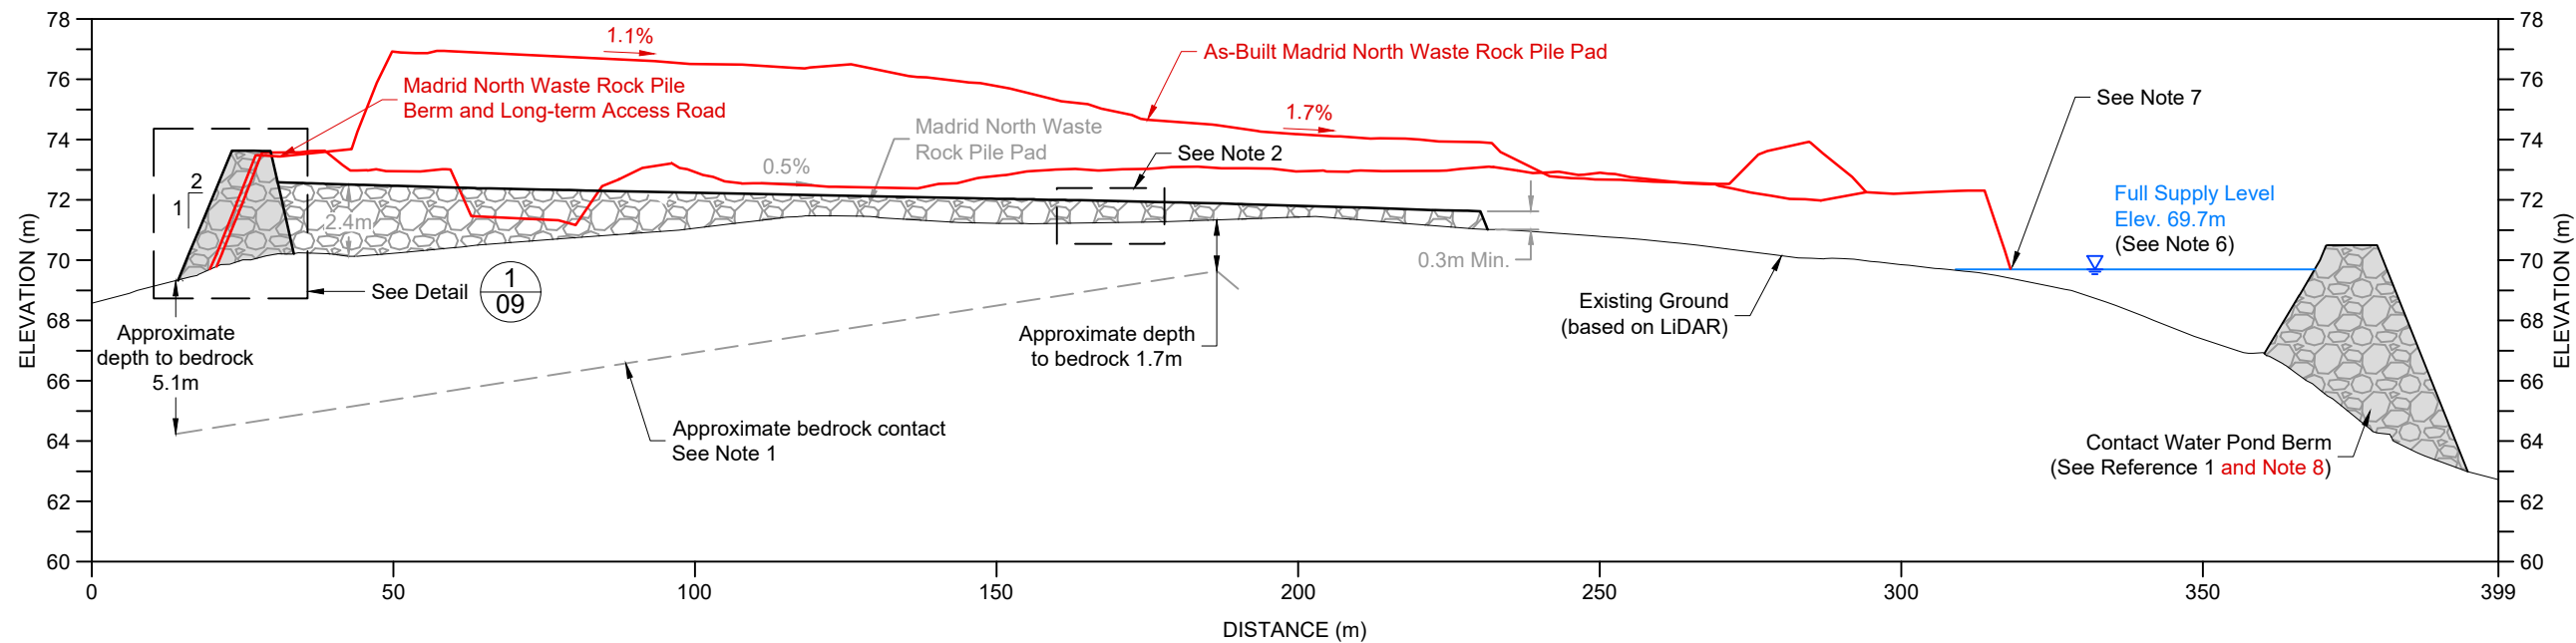


A
05
Cross Section A-A'
5x Vertical Exaggeration

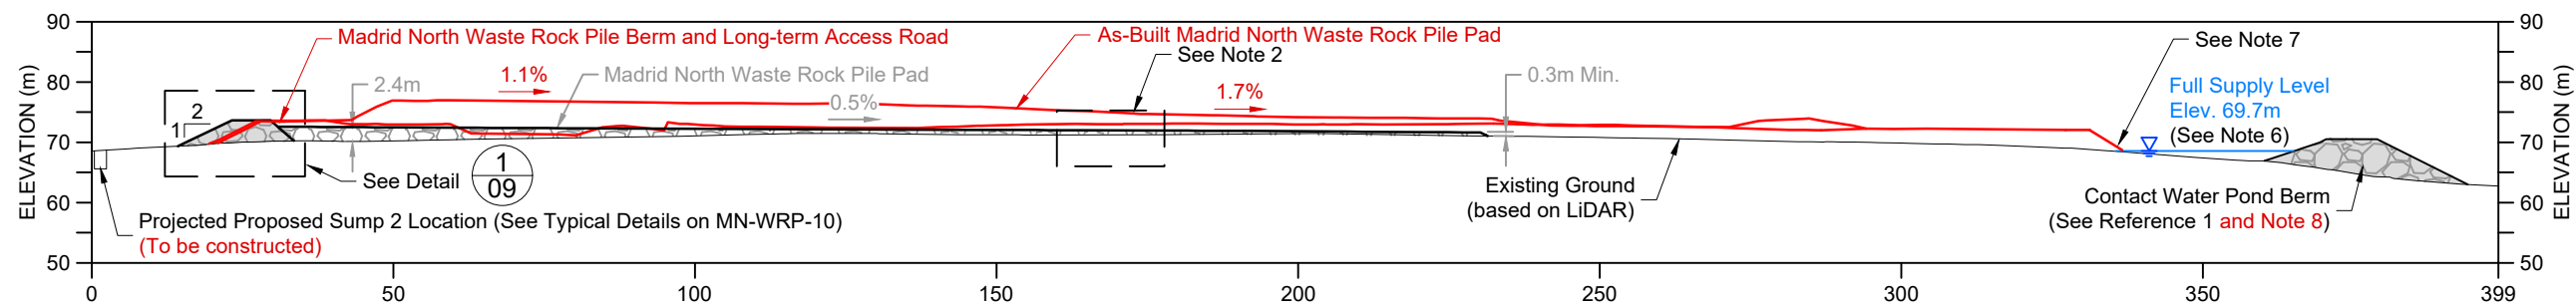

A
05
Cross Section A-A'
1x Vertical Exaggeration

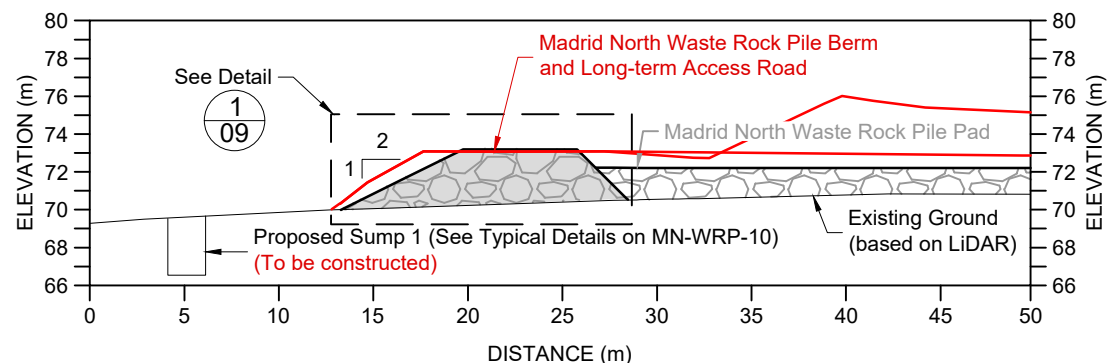

B
05
Cross Section B-B'

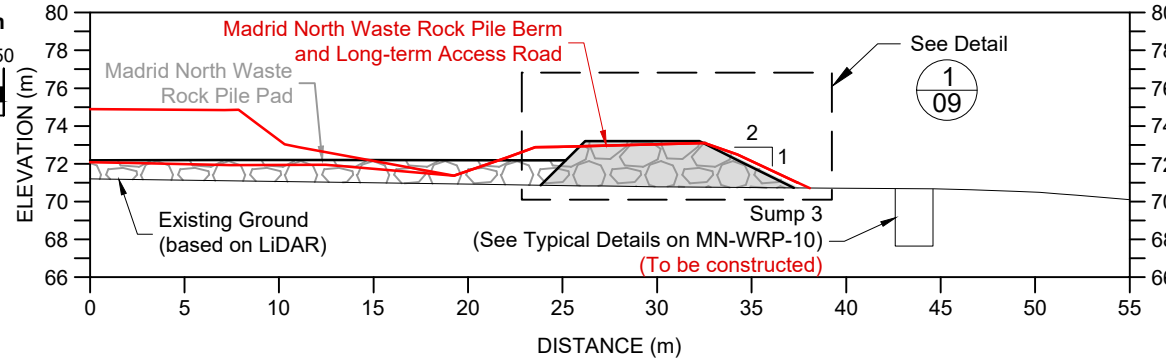

C
05
Cross Section C-C'

LEGEND

- As-Constructed WRP (2019)
- Geochemically Suitable Run of Quarry (ROQ) or Run of Mine (ROM) Material
- Compacted and Sorted Run of Mine Material

NOTES



- Approximate bedrock contact based on 2018 borehole investigation locations shown on drawing MN-WRP-02.
- Pad thickness is less than maximum allowable particle size of 0.75m. Additional sorting will be required.
- Compacted and Sorted Run of Mine Material to be built as per ROQ technical specifications, with maximum particle size reduced to 0.75m.
- As-built survey of compacted pad layers is required. Final as-built survey of the pad and berms is required before waste rock for the waste rock pile can be placed.
- Safety barriers required when berm and long-term access roads is 3m or higher in height.
- The WCP is intended to operate in a dry state with a maximum two weeks residence time.
- Existing topography shown is based on LiDAR survey and not actual field conditions. During construction, the 70.0m elevation contour was surveyed and staked-out by Sub-Arctic. The WRP toe is built along the true 70.0m contour and is above the CWP Full Supply Level.
- The focus of this drawing set is solely on the as-built conditions of the Madrid North Waste Rock Pile (WRP) for 2019. The 2019 construction summary report (Reference 3) should be consulted to see the as-built arrangements for any infrastructure outside of the Madrid North WRP extents.

REFERENCE


- Engineering Drawings for the Madrid North Contact Water Pond, Hope Bay Project. Prepared for TMAC Resources. Project Number 1CT022.043. March 2019.
- As-Built data provided by Sub-Arctic Geomatics Ltd. June 2019 - January 2020.
- Doris and Madrid 2019 Construction Summary Report. Hope Bay Project. Memo prepared for TMAC Resources. Project Number 1CT022.055. April 2020.

P:\Project\01 - SITE\Hope Bay\ACAD\As-Built\Madrid North WRP\1CT022.043 - GA-max.dwg

REFERENCE DRAWINGS	NO.	DESCRIPTION	CHKD	APPD	DATE	NO.	DESCRIPTION	CHKD	APPD	DATE
MN-WRP-09	Typical Details	--	--	--	--	AB1	As-Built	RW	JBK	20/03/31
					1	Issued for Construction	RW	JBK	19/08/12	
					0	Issued for Construction	RW	JBK	19/06/14	
					A	Issued for Discussion	--	--	--	

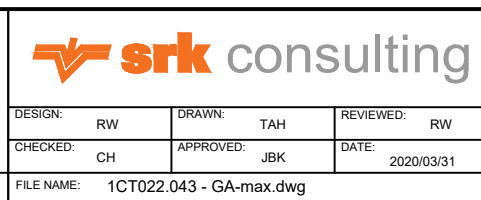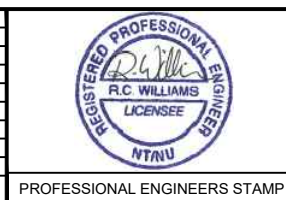

Madrid North Waste Rock Pile		
DRAWING TITLE:		
Waste Rock Pad Sections		
DRAWING NO.	SHEET	REVISION NO.
MN-WRP-06	6 OF 10	AB1

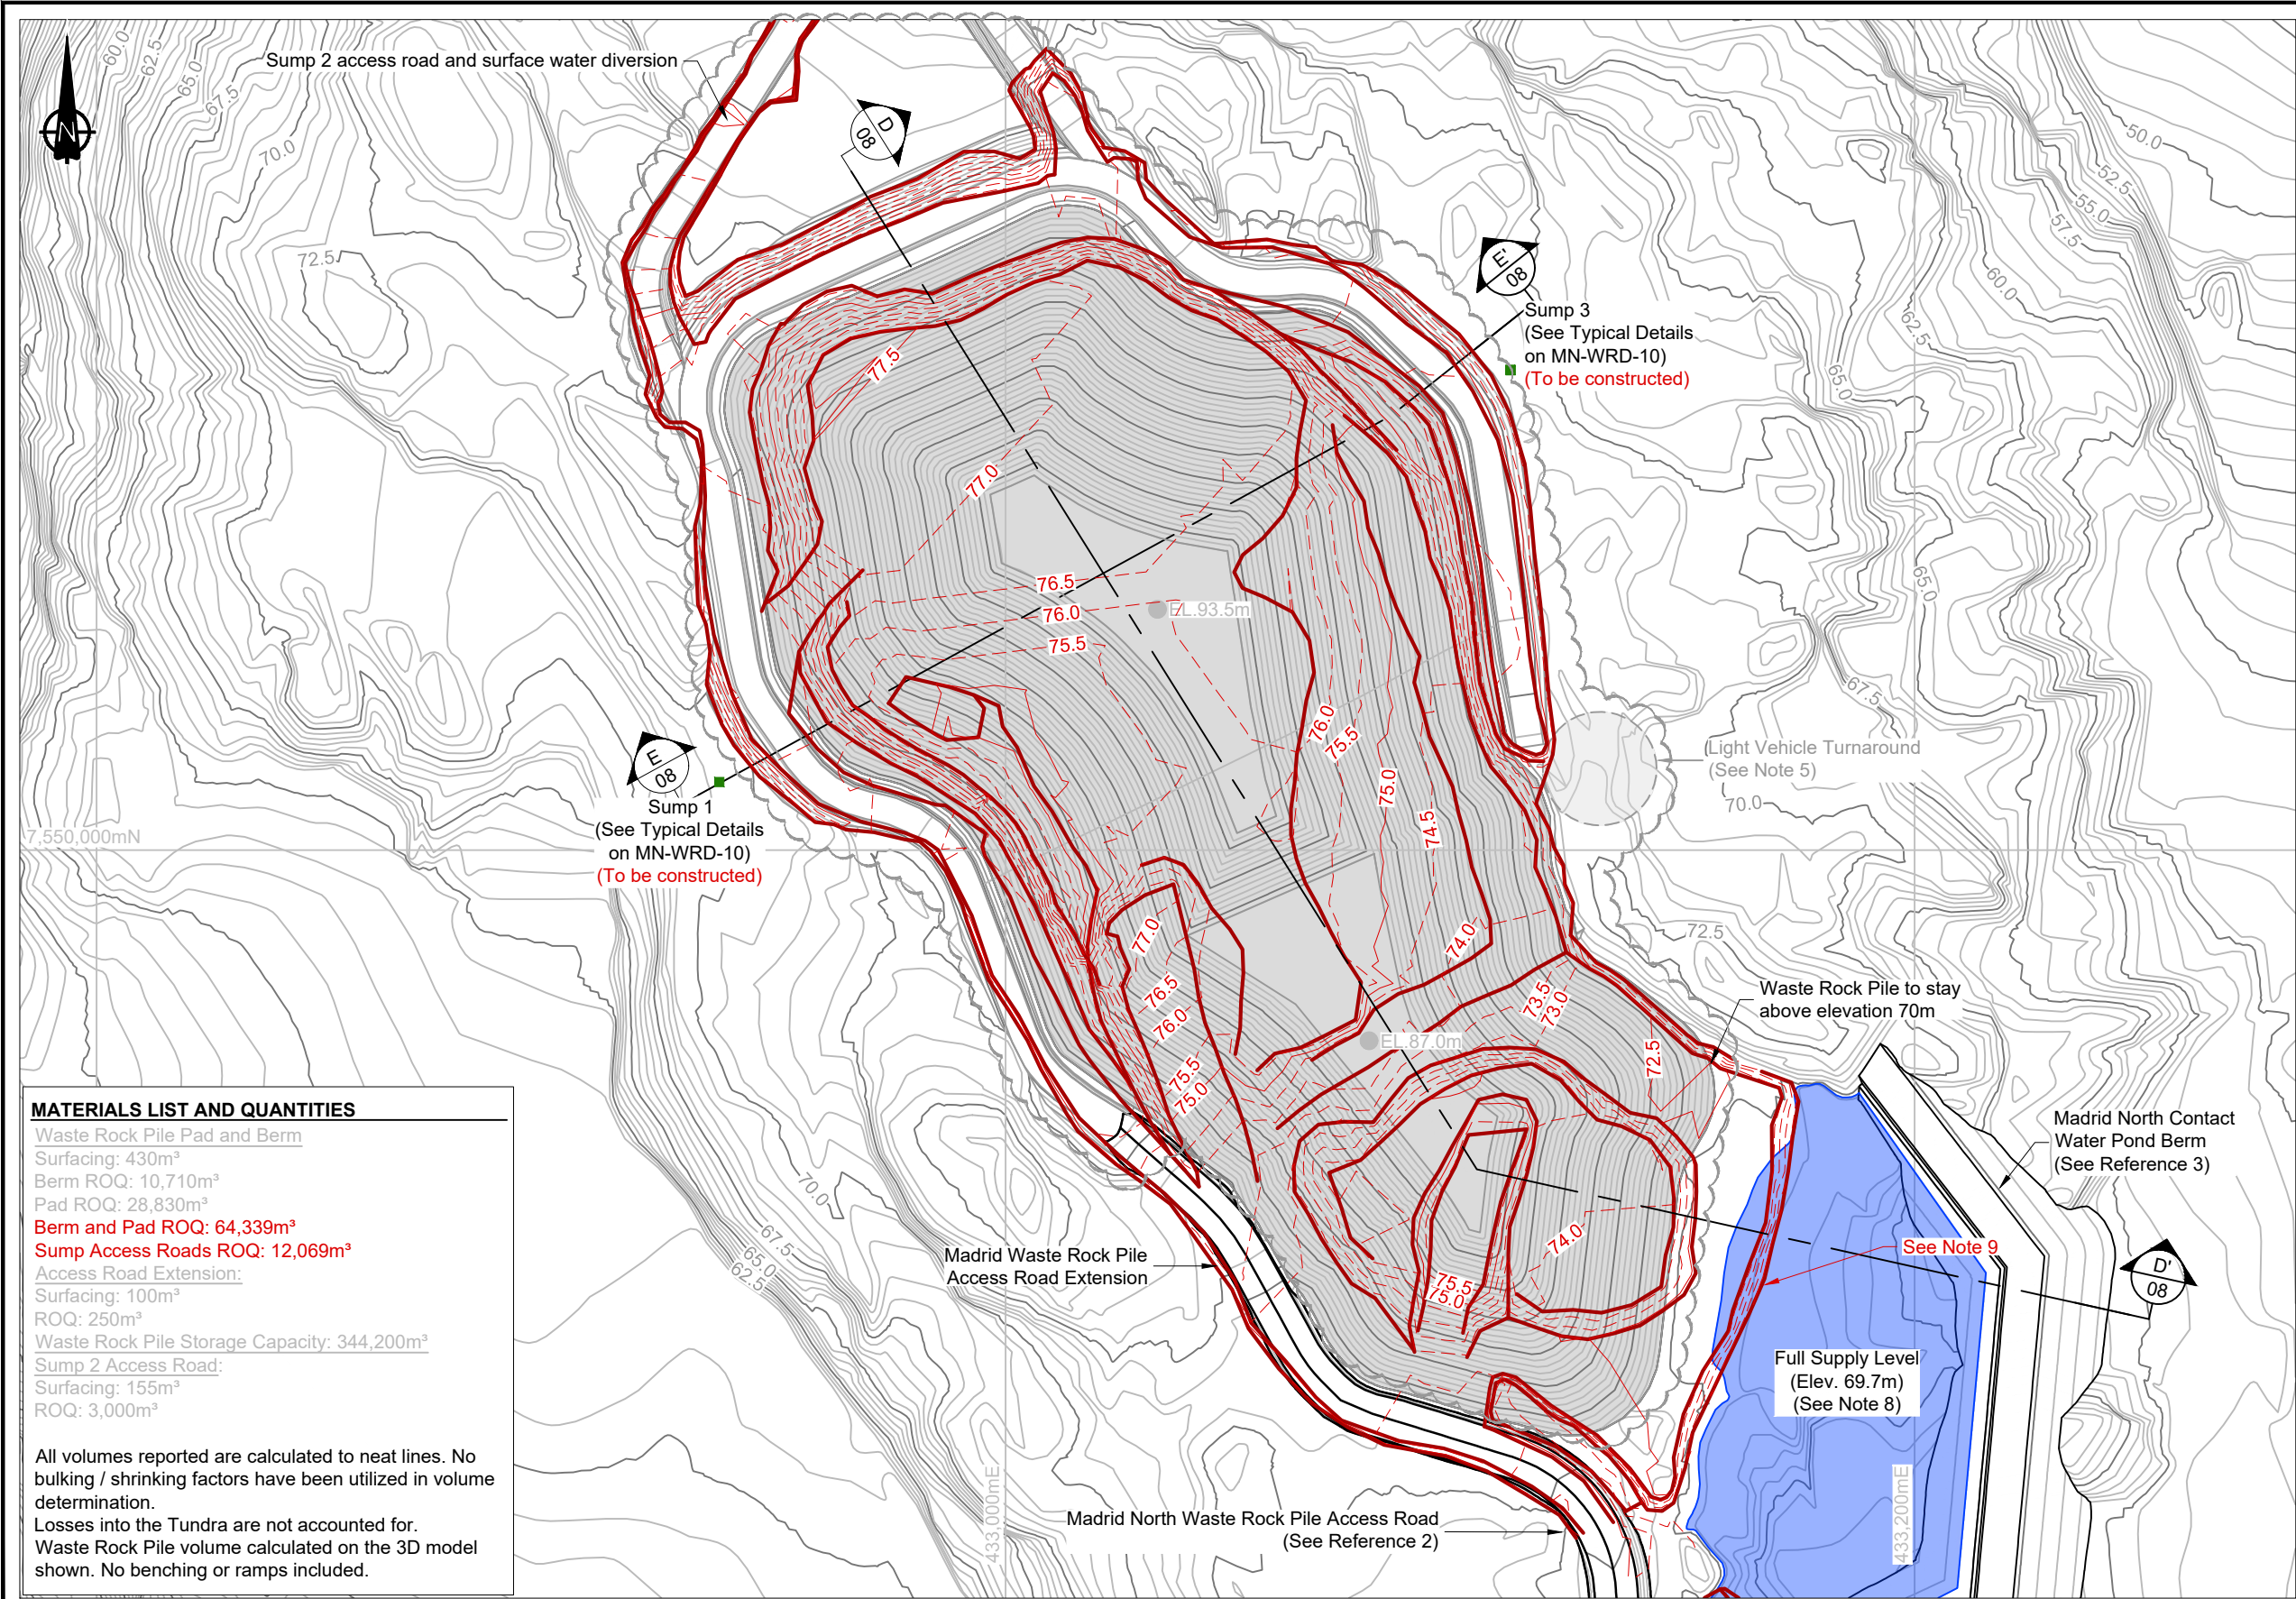

MATERIALS LIST AND QUANTITIES

Waste Rock Pile Pad and Berm

Surfacing: 430m³

Berm ROQ: 10,710m³

Pad ROQ: 28,830m³

Berm and Pad ROQ: 64,339m³

Sump Access Roads ROQ: 12,069m³

Access Road Extension:

Surfacing: 100m³

ROQ: 250m³

Waste Rock Pile Storage Capacity: 344,200m³

Sump 2 Access Road:

Surfacing: 155m³

ROQ: 3,000m³

All volumes reported are calculated to neat lines. No bulking / shrinking factors have been utilized in volume determination. Losses into the Tundra are not accounted for. Waste Rock Pile volume calculated on the 3D model shown. No benching or ramps included.

LEGEND


- Sump Location
- Contact Water Pond
- Waste Rock Pile
- As-Constructed WRP (2019)

NOTES

- The designs are based on the contour information shown on these drawings. It is the Contractor's responsibility to confirm that the contours are a fair reflection of the ground levels in the vicinity of the works, and to advise the Construction Manager and Engineer of any differences.
- Contours shown at 0.5m intervals.
- All units shown in meters unless otherwise specified.
- Construction and material specifications shall be in accordance with the following Technical Specifications: Earthworks and Geotechnical Engineering. Hope Bay Project, Nunavut, Canada Revision H - Issued for Construction. SRK (2018).
- Light vehicle turnaround to be field fit to facilitate long-term access.
- Final as-built survey of the pad and berms is required before waste rock for the waste rock pile can be placed.
- Waste Rock Pile designed in accordance with Reference 4. Waste Rock Pile benches and access ramps to be determined by TMAC during operations. Bench heights, widths and slope angles as per Reference 4.
- The CWP is intended to be operated in a dry state with a maximum two weeks residence time.
- Existing topography shown is based on LiDAR survey and not actual field conditions. During construction, the 70.0m elevation contour was surveyed and staked-out by Sub-Arctic. The WRP toe is built along the true 70.0m contour and is above the CWP Full Supply Level.

REFERENCES

- NAD83 UTM Zone 13.
- Engineering Drawings for the Madrid South All-Weather Road, Hope Bay Project, Nunavut, CanadaP prepared for TMAC Resources. Project Number: 1CT022.043. March 2019.
- Engineering Drawings for the Madrid North Contact Water Pond, Hope Bay Project. Report prepared for TMAC Resources. Project Number 1CT022.043. March 2019.
- Hope Bay Project, Geotechnical Design Parameters and Overburden Summary Report. Prepared for TMAC Resources. Project Number 1CT022.013. November 2017.
- As-Built data provided by Sub-Arctic Geomatics Ltd. June 2019 - January 2020.

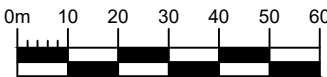

P:\Project\01 - SITE\Hope Bay\ACAD\As-Built\Madrid North WRP\1CT022.043 - WRP.dwg

REFERENCE DRAWINGS				REVISIONS			
DRAWING NO.	DRAWING TITLE	NO.	DESCRIPTION	CHKD	APPD	DATE	NO.
MN-WRP-08	Waste Rock Pile Sections	--	--	--	--	--	AB1
							1
							0
							A

PROFESSIONAL ENGINEERS STAMP

DESIGN: RW
CHECKED: CH
FILE NAME: 1CT022.043 - WRP.dwg

DRAWN: TAH
APPROVED: JBK
2020/03/31

REVIEWED: RW
DATE: 2020/03/31

Hope Bay Project

SRK JOB NO.: 1CT022.043


Madrid North Waste Rock Pile

DRAWING TITLE: Waste Rock Pile



DRAWING NO. MN-WRP-07

SHEET 7 OF 10


REVISION NO. AB1

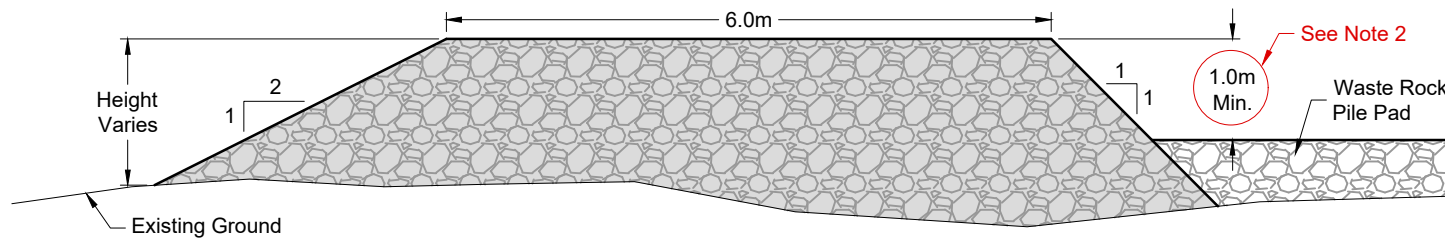



1
06 Detail 1 - Waste Rock Pile Berm and Long-term Access Road
- Berm Constructed as per design

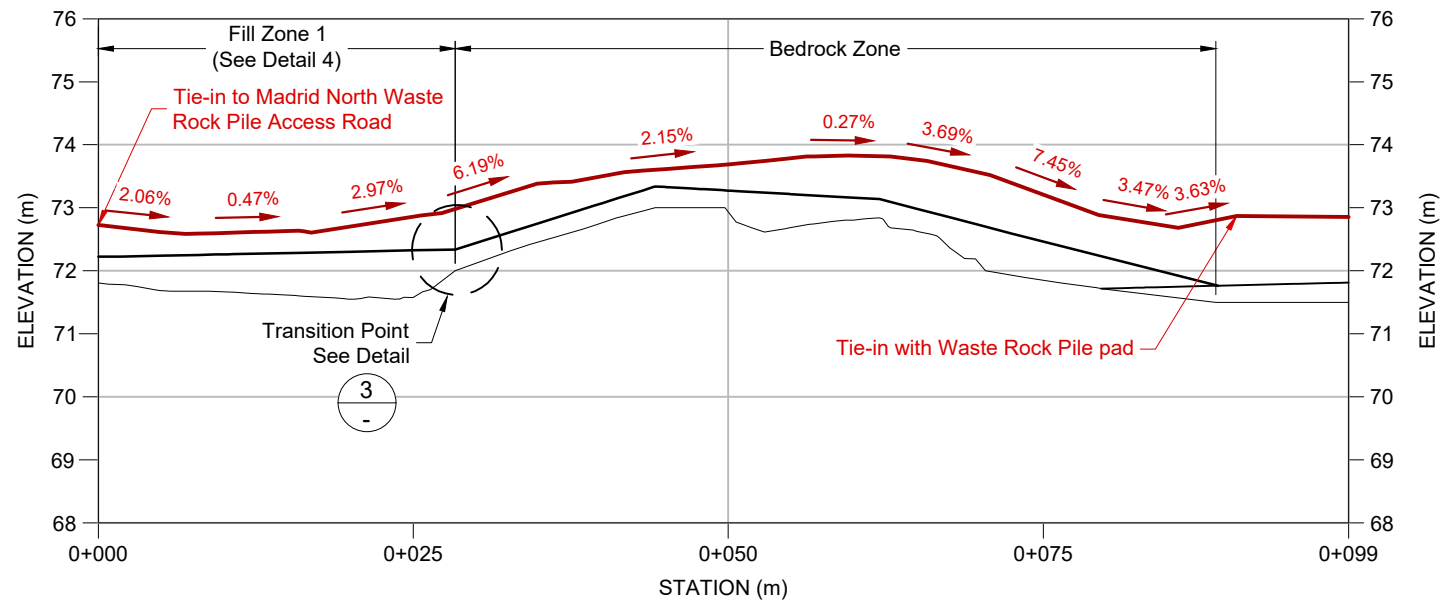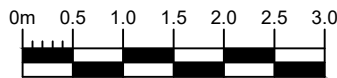


2
04 Access Road Extension Profile
5x Vertical Exaggeration

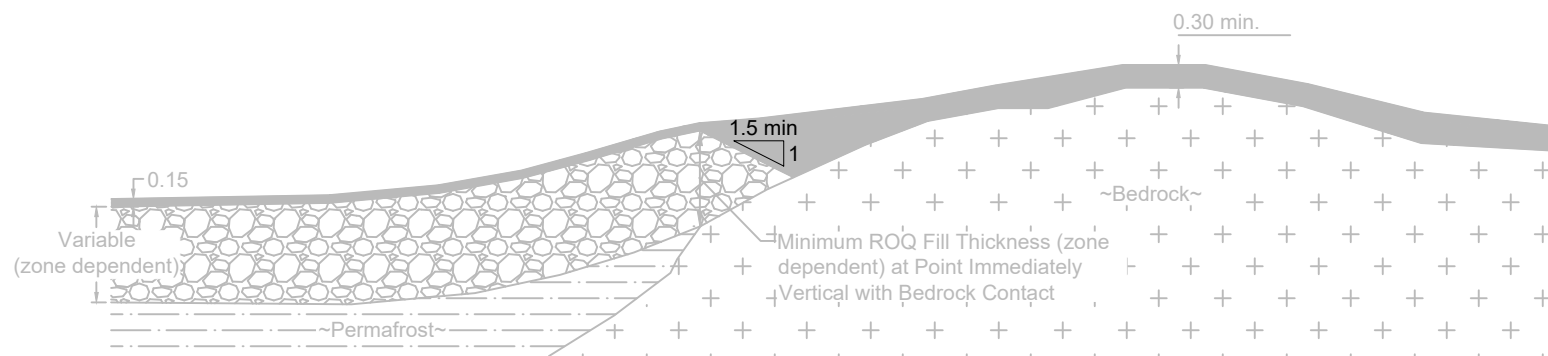

3
- All-Weather Road Profile Transition from Permafrost to Bedrock

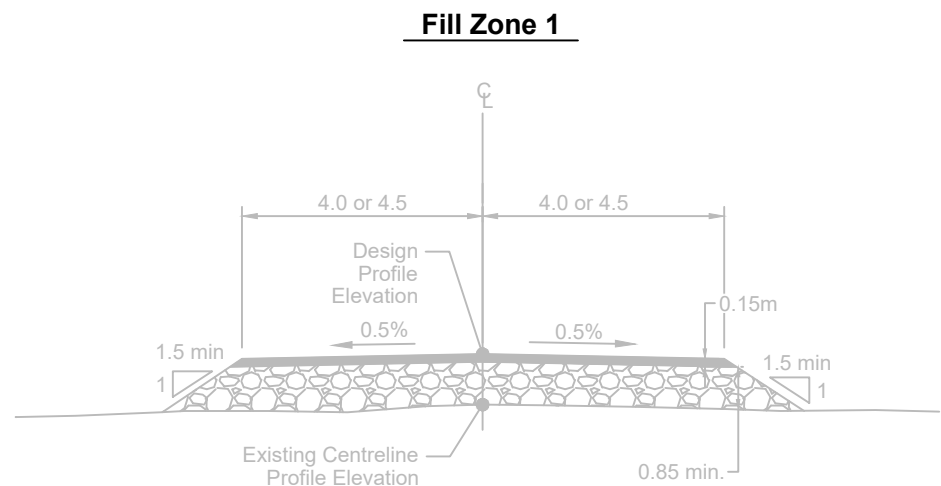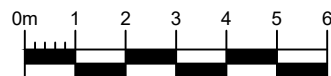

4
- Typical All-Weather Road Section

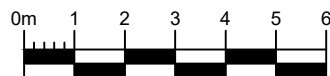

LEGEND	
	Geochemically Suitable Run of Quarry (ROQ) or Run of Mine (ROM) Material
	Compacted and Sorted Run of Mine Material


- NOTES
- Access road profile may be adjusted and rounded to optimize traffic operations
 - Where the WRP pad was over-built the 1.0m height difference between the pad and the berm does not exist, drainage ditches are to be constructed.

- REFERENCE
- As-Built data provided by Sub-Arctic Geomatics Ltd. June 2019 - January 2020.

P:\Project\01 - SITE\Hope Bay\ACAD\As-Built\Madrid North WRP\1CT022.043 - Details.dwg

																																																																																																																																																																																																																																																																																																																																																																																																																																																																																																																																																																																																																																																																																																																																																																																																																																																																																																																																																																																																																																																																																																																																																																																																																																																																																																																																																																																																																					</
--	--	----





DESIGN:	RW	DRAWN:	TAH	REVIEWED:	RW
CHECKED:	CH	APPROVED:	JBK	DATE:	2020/03/31
FILE NAME: 1CT022.043 - Details.dwg					

TMAC RESOURCES	
Hope Bay Project	
SRK JOB NO.: 1CT022.043	

Madrid North Waste Rock Pile		
DRAWING TITLE: Typical Details		
DRAWING NO. MN-WRP-09	SHEET 9 OF 10	REVISION NO. AB1

[illegible]

Attachment 4.1 Madrid North Portal Pad – As-built Drawings

Engineering Drawings for the Lined Waste Re-handling Area at the Madrid North Portal Pad


Hope Bay Project, Nunavut, Canada

Active Drawing Status





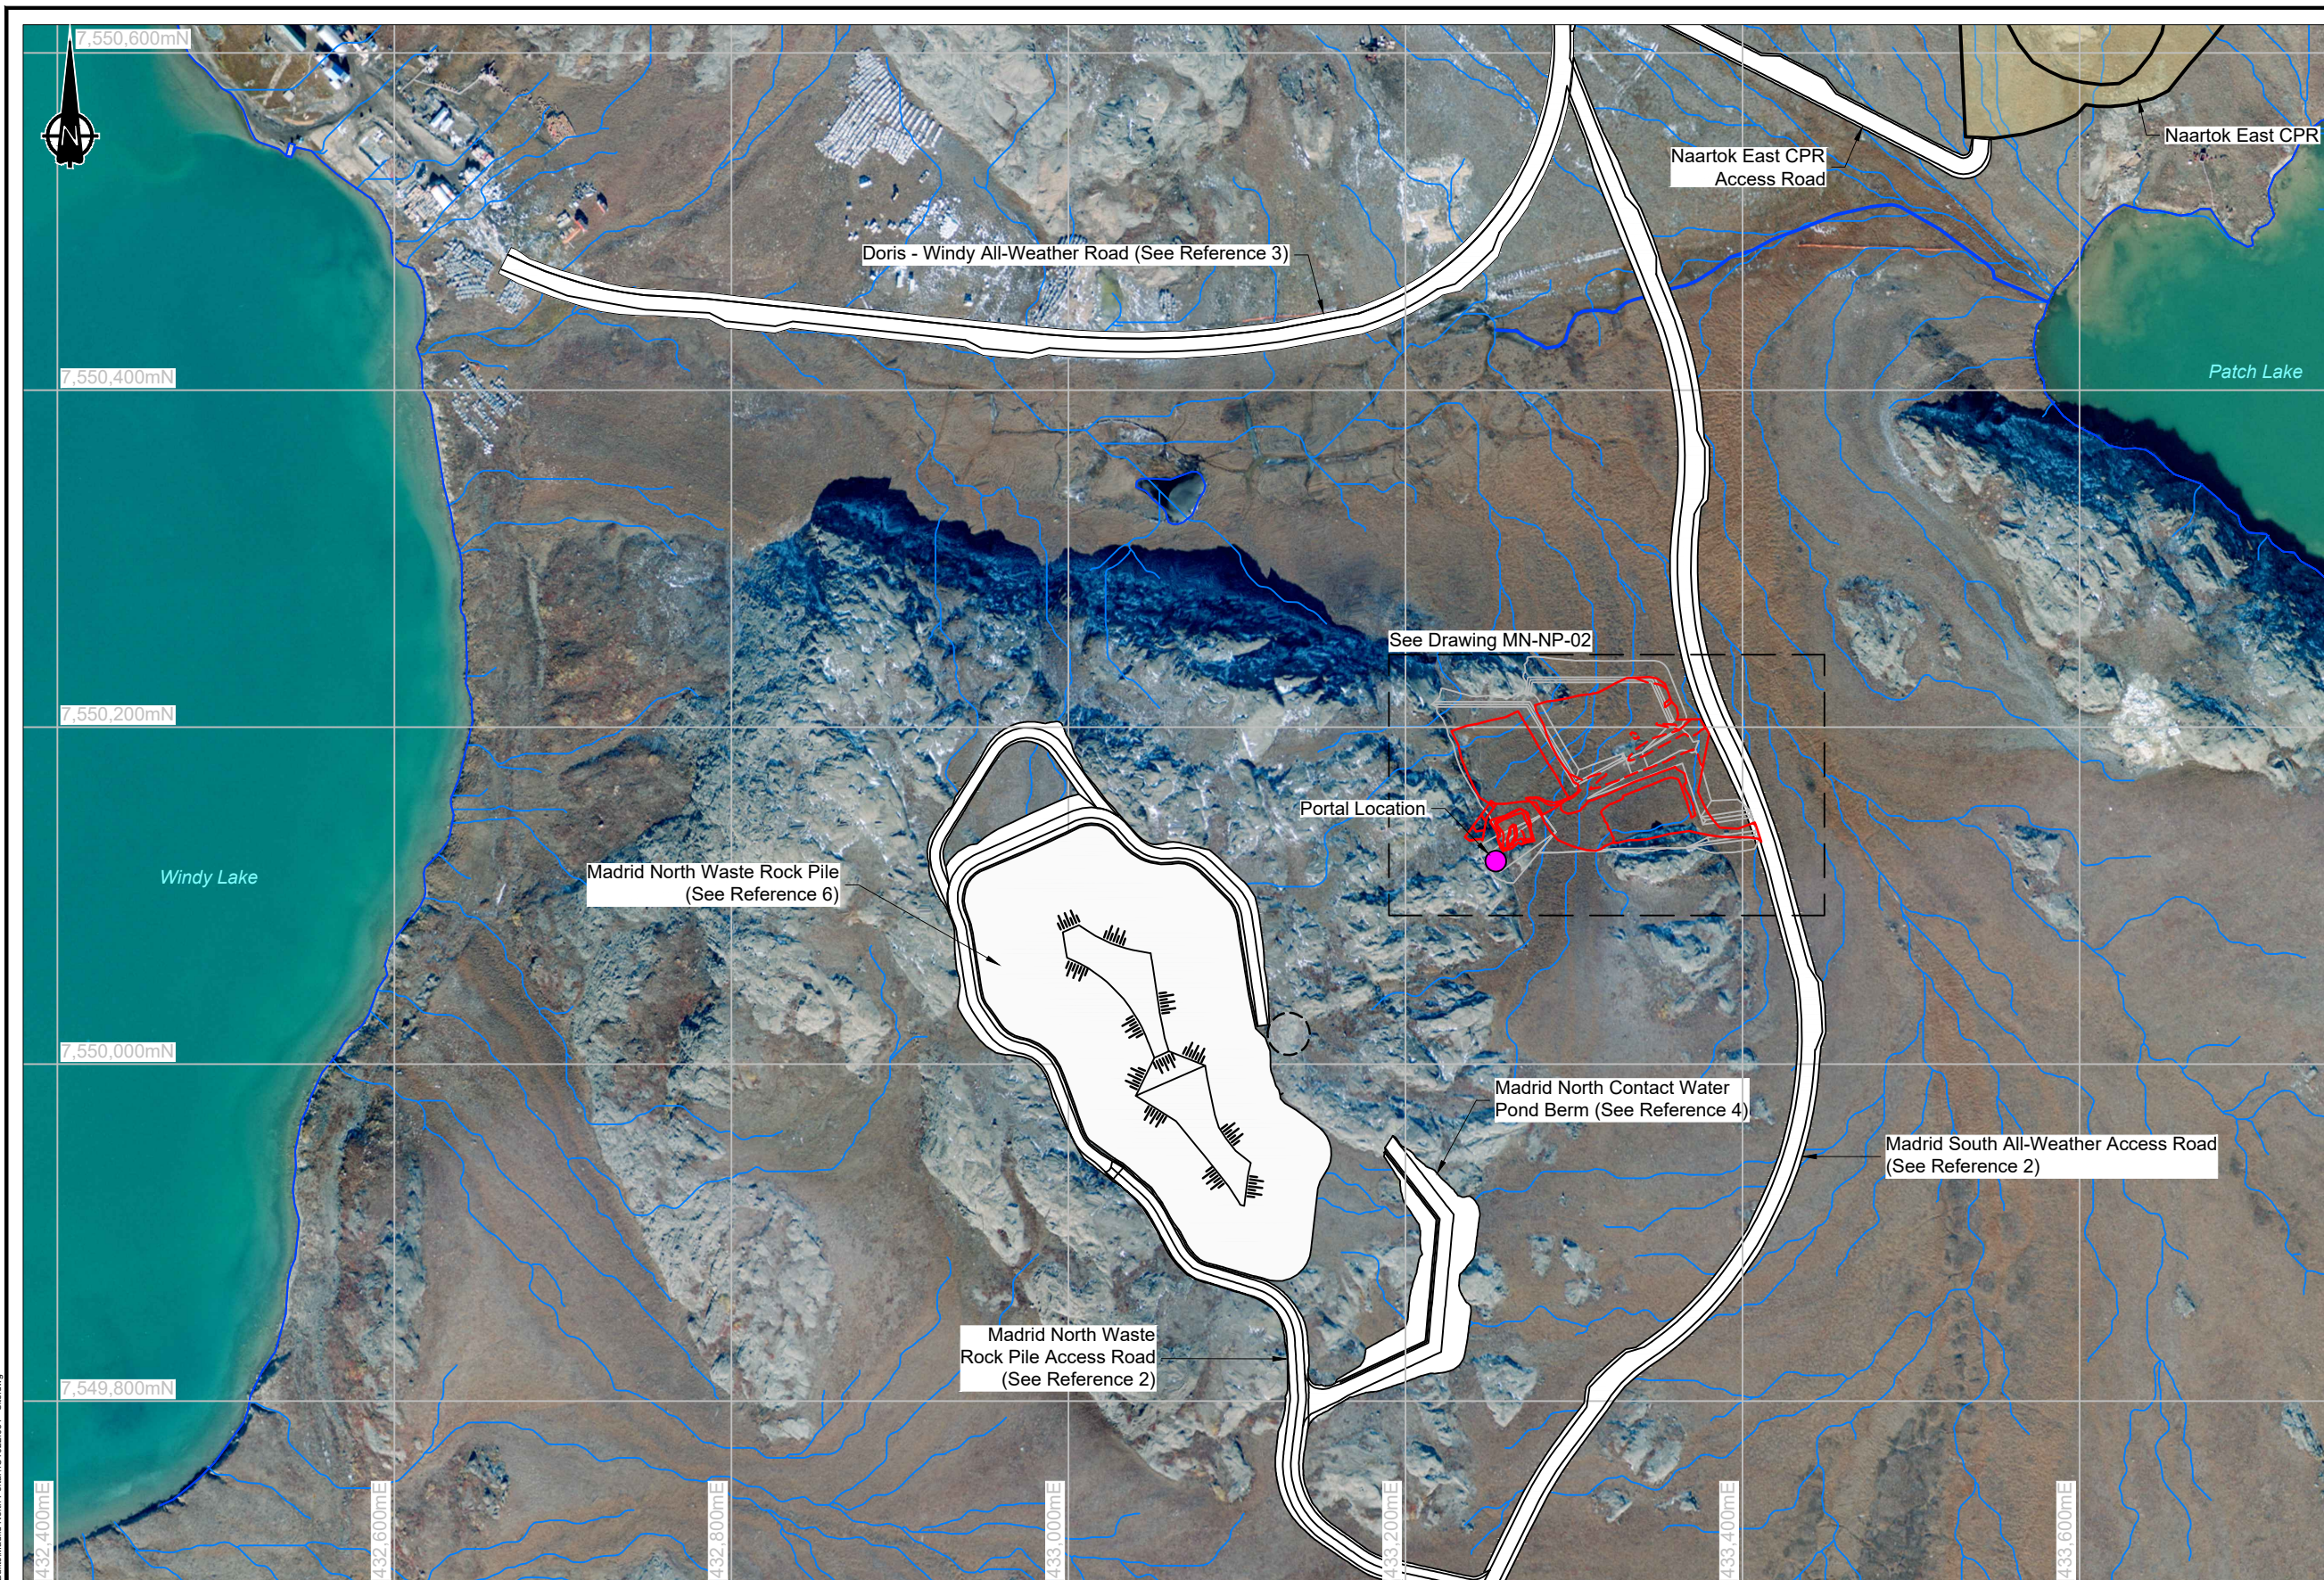


Drawing Number	Drawing Title	Issue	Date	Revision
MN-NP-01	Site Overview (with orthophoto)	As-Built	2020/03/24	AB1
MN-NP-02	Existing Conditions Prior to Pad Construction (Orthophoto)	As-Built	2020/03/24	AB1
MN-NP-03	Existing Conditions Prior to Pad Construction	As-Built	2020/03/24	AB1
MN-NP-04	Portal Pad Infrastructure	As-Built	2020/03/24	AB1
MN-NP-05	Portal Pad Infrastructure Sections Sheet 1/2	As-Built	2020/03/24	AB1
MN-NP-06	Portal Pad Infrastructure Sections Sheet 2/2	As-Built	2020/03/24	AB1
MN-NP-07	Typical Details	As-Built	2020/03/24	AB1
MN-NP-08	As-Built Liner Layout	As-Built	2020/03/24	AB1





Project Number: 1CT022.051



LEGEND

	Portal Location
	Streams and Waterbodies
	Pre-mining Drainage Pathway
	Crown Pillar Recovery Area
	Proposed Infrastructure
	Previously Submitted Designs
	2019 As-Built Infrastructure

REFERENCES

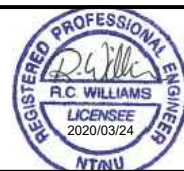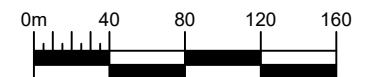

Bulk Pad and Ramp Fill: 35,600m³
Pad and Ramp ROQ: 14,486m³
 Bedrock Excavation: 120m³
 Containment Cell
Bedding Material: 950m³
Bedding Material: 883m³
 Transition Material: 1,100m³
Transition Material: 1,022m³
 Surfacing Material: 1,200m³
 ROQ Material: 150m³
 Liner: 2,100m²
Liner: 1,962m²
 Non-Woven Geotextile: 4,200m²
Non-Woven Geotextile: 3,924m²
Contingency Liner Area
Bedding Material: 350m³
Bedding Material: 525m³
 Transition Material: 400m³
 Surfacing Material: 460m³
 Liner: 770m²
Liner: 542m²
 Non-Woven Geotextile: 1,540m²
Non-Woven Geotextile: 1,084m²


Topographic map showing the proposed portal area. Key features include:

- Proposed Portal Decline** (See Note 4)
- As-built portal location** (See Note 10)
- Temporary rock ramp to access top of portal face**
- Contingency Liner** (See Note 6)
- Min. 2.0m of thermal protection cover over any excavated overburden**
- Proposed Portal Face by TMAC** (See Note 7)
- Lined area for temporary waste rock / ore re-handling stockpile** (See Note 5) See Typical Liner Detail on MN-NP-07
- As-Built toe survey not available due to snow cover. The toe will be surveyed in the summer of 2020 (See Note 9)**
- As-built Culvert 600mm Diameter**
- Surface Equipment Access**
- Culvert to be installed**
- Safety Berm**
- Slopes:** 2.1%, 2%, 4.5%, 4.2%
- Scale:** 0m to 40m
- Grid Coordinates:** 7,550,150mN, 7,550,100mN, 7,550,050mN; 433,150mE, 433,200mE, 433,250mE, 433,300mE, 433,350mE, 433,400mE, 433,450mE

-  Design Culvert Locations
-  As-Built Culvert Locations
-  Surface Water Diversion Berm
-  Portal Design by TMAC
-  2019 As-Built Infrastructure
-  Bedrock Outcrop (approximate)

1. Contours shown at 1.0m intervals.
2. All dimensions shown in meters unless otherwise specified.
3. Access road constructed in July 2019 to facilitate access to overburden drill holes.
4. Portal design provided by TMAC Resources Inc. August 2019.
5. Fully lined cell for temporary waste rock / ore re-handling stockpile (maximum 1,000 tonnes). Designed to contain contact water up to the 1 in 100 year storm plus maximum daily snowmelt. Minimum 0.9m liner cover to accommodate heavy equipment (see Typical Liner Detail on MN-NP-07).
6. Contingency liner embedded in the pad fill and sloped back towards the portal. Contingency against spillages from underground trucks.
7. Portal face contours generated by projecting TMAC's portal design to surface. See cross section A on drawing MN-NP-05.
8. Locations of offices, shops, generators, fuel tanks, etc. to be surveyed in summer 2020 and provided in final as-built drawing, along with final pad toes.
9. Based on interim survey, SRK is currently unable to check the side slope grades and confirm stability requirements of the pad have been met.
10. Final as-built portal location adjusted in the field as per TMAC mining personnel. SRK did not provide input to the portal design.

1. NAD83 UTM Zone 13.
2. Engineering Drawings for the Madrid South All-Weather Road, Hope Bay Project, Nunavut, Canada. Prepared for TMAC Resources. Project Number 1CT022.43. March 2019.
3. As-Built survey provided by Sub-Arctic Geomatics Ltd. Dated July 2019 - October 2019.

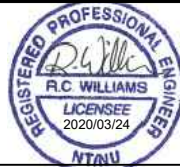[illegible]

DESIGN: RW	DRAWN: TAH	REVIEWED: RW
CHECKED: RW	APPROVED: JIRK	DATE: March 24, 2020

FILE NAME:	1CT022.051 - Portal Pad.dwg
------------	-----------------------------



Hope Bay Project

SRK JOB NO.:	1CT022.051
--------------	------------

Madrid North Portal Pad

DRAWING TITLE:


Portal Pad Infrastructure

DRAWING NO.

MN-NP-04

SHEET	REVISION NO.
-------	--------------

AB1

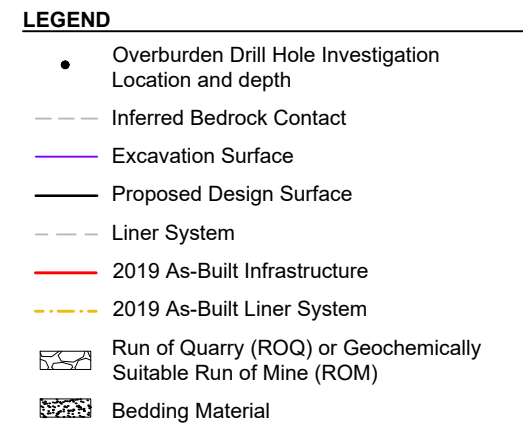



NOTES

1. All dimensions in meters unless otherwise stated.
2. Overburden excavation to be inspected by the Engineer. Additional excavation and ROQ fill may be required depending on conditions encountered. Minimum 2.0m ROQ thermal cover is required over any excavation into overburden.
3. Minimum thickness of fill placed directly on overburden is 1.0m.
4. Crushed and screened quarry rock (ROQ) and / or geochemically suitable waste rock (ROM) from selected areas of the mine will be used for construction material (References 1, 2, and 3).
5. Construction and material specifications shall be in accordance with the Technical Specifications (Reference 4).
6. Portal face design, rock support and stabilization requirements was completed by TMAC / others.
7. Final as-built portal location adjusted in field as per TMAC mining personnel. SRK did not provide input to the portal design.
8. Final pad as-built survey to be completed in summer 2020.


REFERENCE

1. Geochemical Characterization of Quarry Materials for the Doris-Windy All-Weather Road, Hope Bay Project. Report prepared for Hope Bay Mining Ltd., 1CH008.000. August 2008.
2. Geochemical Characterization of Madrid-Boston Project Quarries Report, Hope Bay Project. Report prepared for TMAC Resources Inc., 1CT022.013. November 2017.
3. Classification of Waste Rock in Support of Segregating Construction Rock from Naartok East Crown Pillar Recover Trench, Madrid North Hope Bay Project. Report prepared for TMAC Resources Inc., 1CT022.037. July 2019.
4. Technical Specifications Earthworks and Geotechnical Engineering. Hope Bay Project, Nunavut, Canada. Revision H - Issued for Construction. Report prepared for TMAC Resources Inc., 1CT022.031. April 2018.
5. **As-Built survey provided by Sub-Arctic Geomatics Ltd. Dated July 2019 - October 2019.**

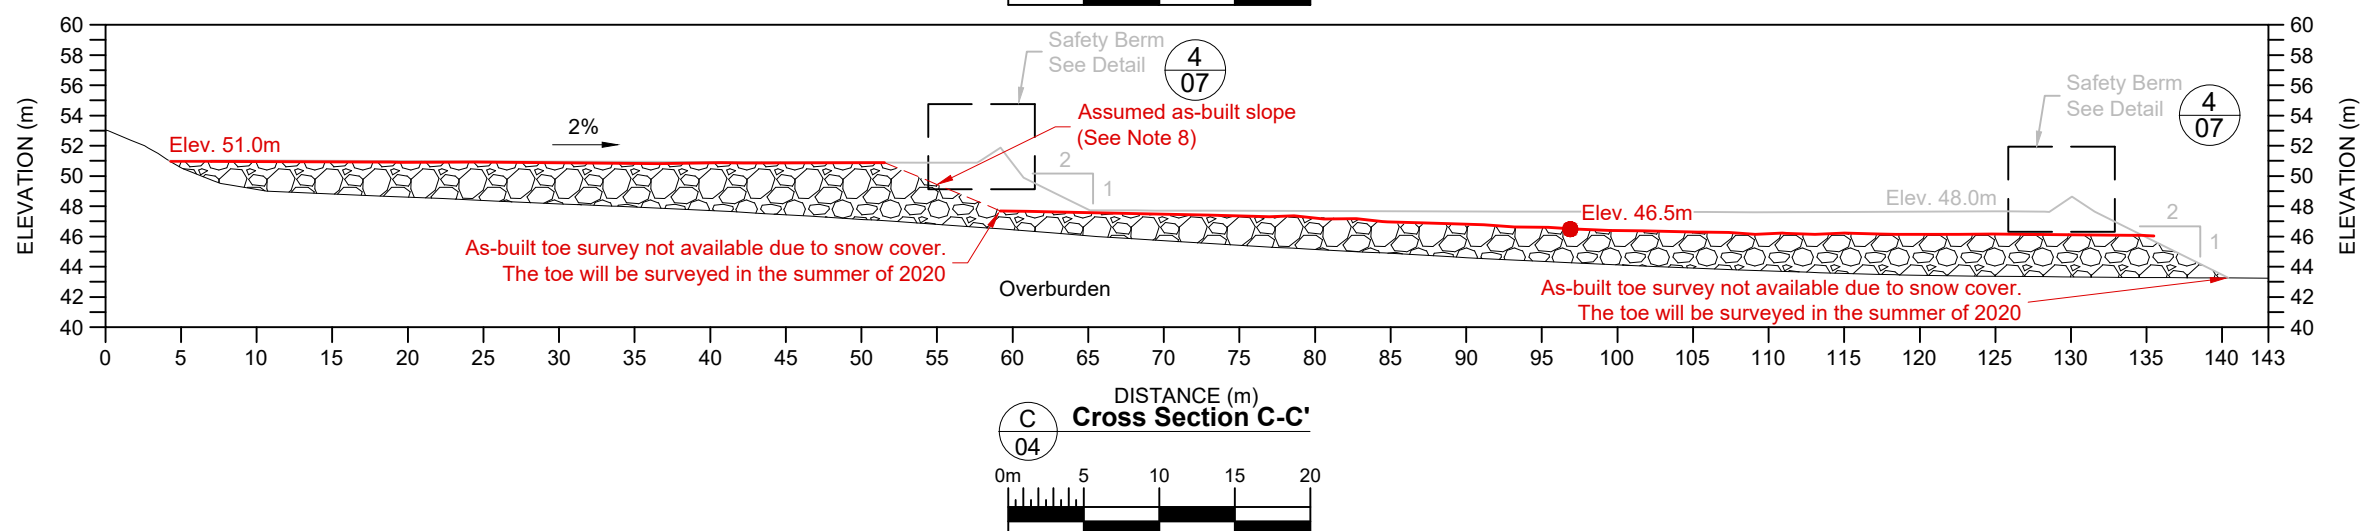
[illegible]

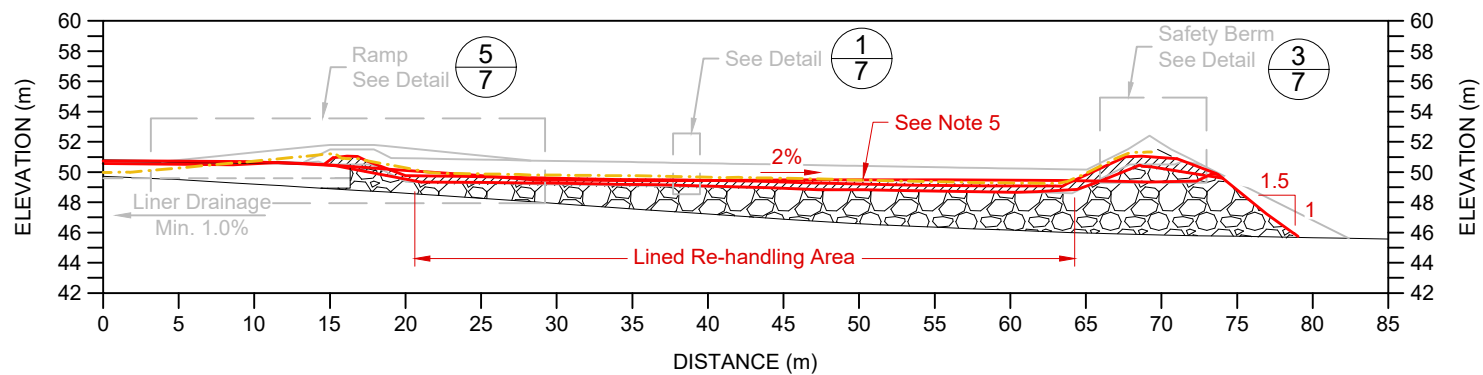

D
04 Cross Section D-D'

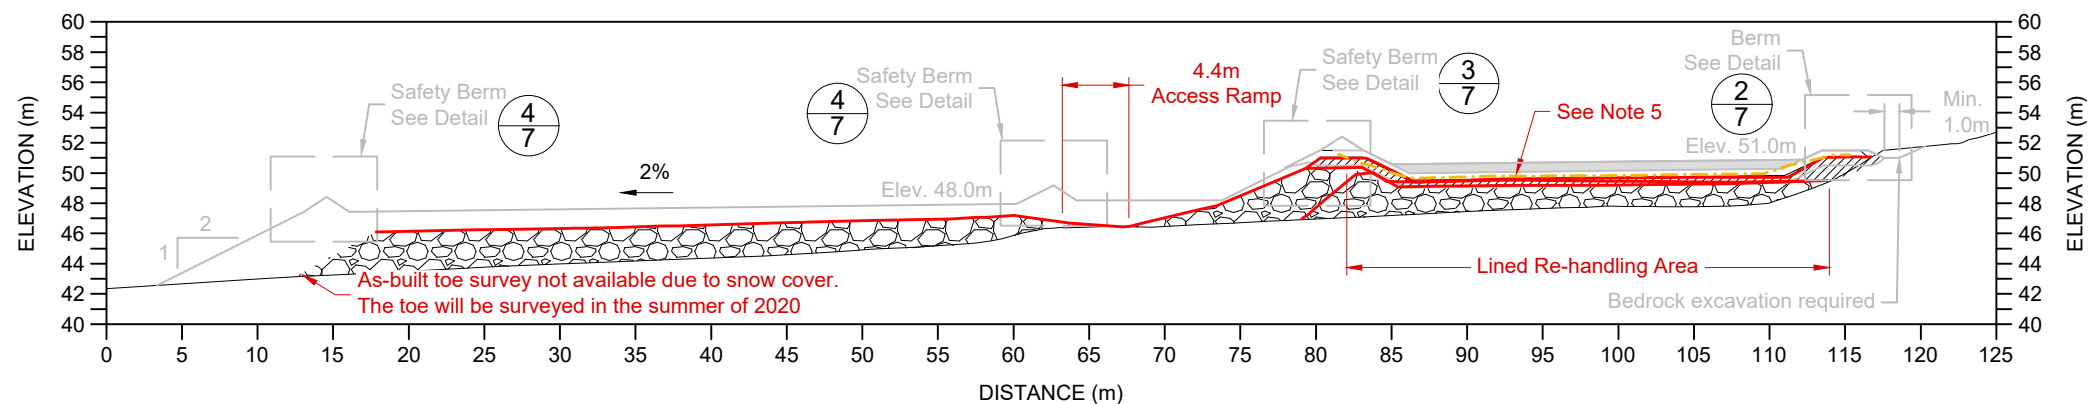

E
04 Cross Section E-E'

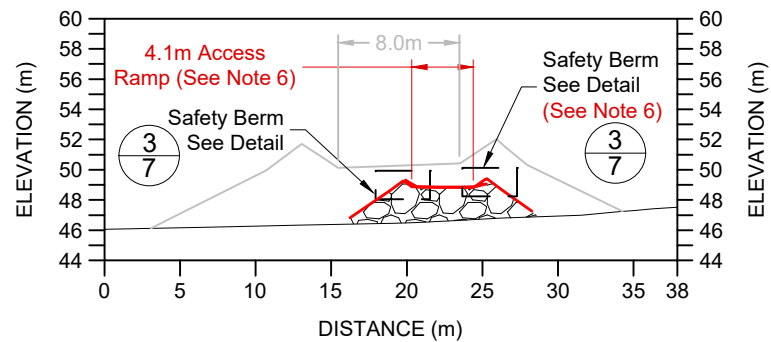

F
04 Cross Section F-F'

LEGEND

- Proposed Design Surface
- Liner System
- Excavation Surface
- 2019 As-Built Infrastructure
- 2019 As-Built Liner System
- Run of Quarry (ROQ) or Geochemically Suitable Run of Mine (ROM)
- Surfacing Material
- Transition Material

NOTES

- All dimensions in meters unless otherwise stated.
- Minimum thickness of fill placed directly on overburden is 1.0m.
- Crushed and screened quarry rock (ROQ) and/or geochemically suitable waste rock (ROM) from selected areas of the mine will be used for construction material (References 1, 2, and 3).
- Construction and material specifications shall be in accordance with the Technical Specifications (Reference 4)
- As-built data above liner was unavailable at the time of as-built drawing updates.
- As-built survey of access road from waste re-handling area to Madrid South All-Weather Road to be re-surveyed in summer 2020 to confirm minimum design road width and berm heights are met.


REFERENCE

- Geochemical Characterization of Quarry Materials for the Doris-Windy All-Weather Road, Hope Bay Project. Report prepared for Hope Bay Mining Ltd., 1CH008.000. August 2008.
- Geochemical Characterization of Madrid-Boston Project Quarries Report, Hope Bay Project. Report prepared for TMAC Resources Inc., 1CT022.013. November 2017.
- Classification of Waste Rock in Support of Segregating Construction Rock from Naartok East Crown Pillar Recover Trench, Madrid North, Hope Bay Project. Report prepared for TMAC Resources Inc., 1Ct022.037. July 2019.
- Technical Specifications Earthworks and Geotechnical Engineering. Hope Bay Project, Nunavut, Canada. Revision H - Issued for Construction. Report prepared for TMAC Resources Inc., 1CT022.031. April 2018.
- As-Built survey provided by Sub-Arctic Geomatics Ltd. Dated July 2019 - October 2019.



P:\Project\01 - SITE\Hope Bay\ACAD\As-Built\Madrid North Portal\1CT022.051 - Portal Pad.dwg

DRAWING NO.	DRAWING TITLE	NO.	DESCRIPTION	CHKD	APPD	DATE	NO.	DESCRIPTION	CHKD	APPD	DATE
REFERENCE DRAWINGS			REVISIONS								
							AB1	As-Built	RW	JBK	20/03/24
							O	Issued for Construction	RW	JBK	19/09/30
							C	Issued for Information	RW	JBK	19/09/20
							B	Issued for Information	RW	JBK	19/09/06
							A	Issued for Information	RW	JBK	19/08/30

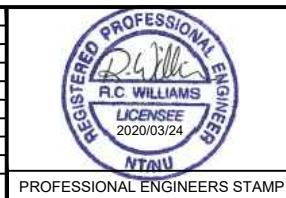

srk consulting

DESIGN: RW DRAWN: TAH REVIEWED: RW

CHECKED: RW APPROVED: JBK DATE: March 24, 2020

FILE NAME: 1CT022.051 - Portal Pad.dwg

TMAC RESOURCES

Hope Bay Project


DRAWING NO.: 1CT022.051

Madrid North Portal Pad

DRAWING TITLE: Portal Pad Infrastructure Sections Sheet 2/2

DRAWING NO. MN-NP-06 SHEET 6 OF 8 REVISION NO. AB1

P:\Project\01 - SRK\Hope Bay\ACAD\As-Built\Madrid North Portal\1CT022.051 - Details.dwg

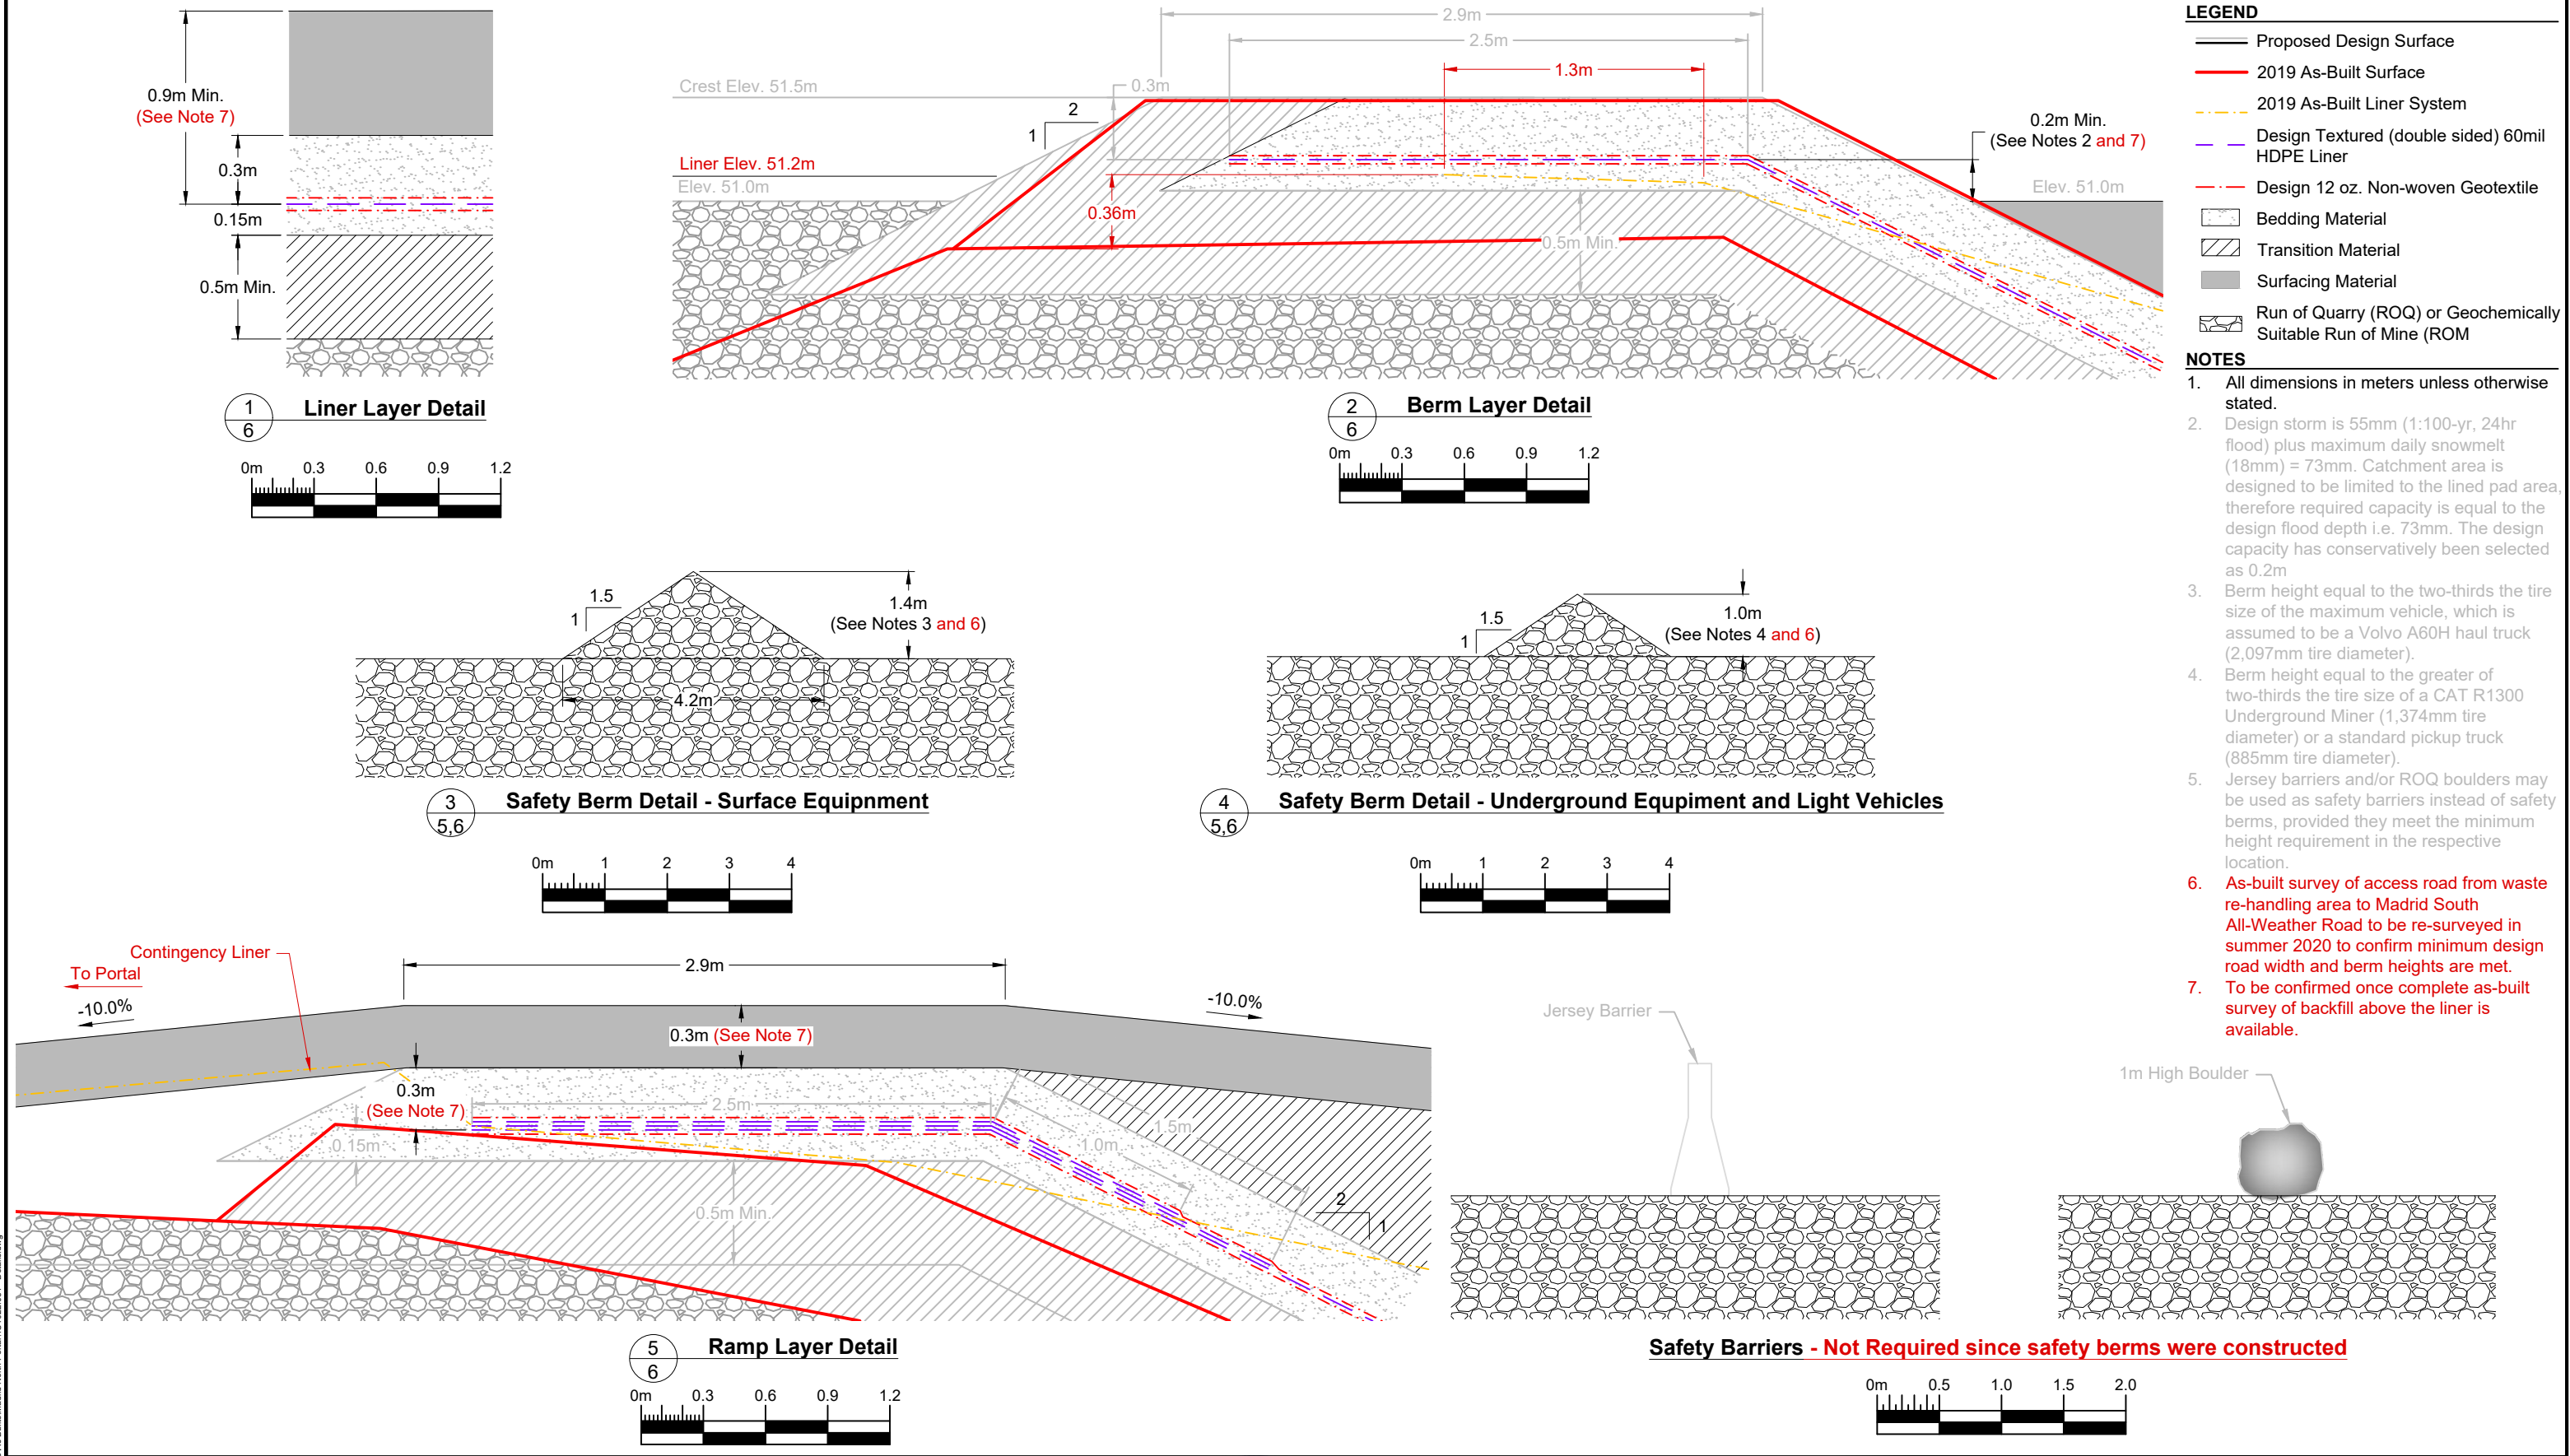

										Madrid North Portal Pad		
										DRAWING TITLE:		
										Typical Details		
										DRAWING NO.		
										MN-NP-07		
										SHEET		
										7 OF 8		
										REVISION NO.		
										AB1		

										Hope Bay Project		
										1CT022.051		

										DESIGN: RW		
										DRAWN: TAH		
										REVIEWED: RW		
										CHECKED: RW		
										APPROVED: JBK		
										DATE: 2020/03/24		
										FILE NAME: 1CT022.051 - Details.dwg		

										PROFESSIONAL ENGINEERS STAMP		
										REGISTERED PROFESSIONAL ENGINEER		
										R.C. WILLIAMS		
										LICENSEE		
										2020/03/24		
										NTAU		


										As-Built		
										RW JBK 20/03/24		
										Issued for Construction		
										RW JBK 19/09/27		
										Issued for Information		
										RW JBK 19/09/26		
										Issued for Information		
										RW JBK 19/09/20		
										Issued for Information		
										RW JBK 19/09/06		
										Issued for Information		
										RW JBK 19/08/30		
										CHKD APPD DATE		
										DESCRIPTION		
										NO. DATE		
										REVISIONS		
										REFERENCE DRAWINGS		
										NO. DESCRIPTION		

Attachment 4.2 Madrid North Portal Pad – Liner Installation Report

**A&A Technical Services
Yellowknife NT**

**Madrid Portal 60mil HDPE liner Installation
October 23 – November 7, 2019**

Client: TMAC Resources Inc.

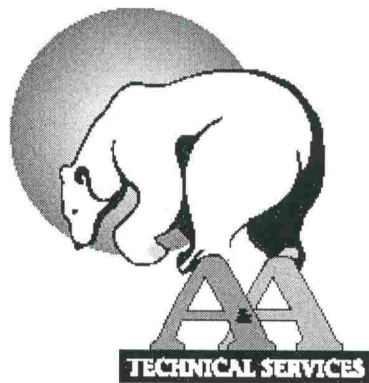


**A&A Technical Services
Yellowknife NT**

**Madrid Portal 60mil HDPE liner Installation
October 23 – November 7, 2019**

Client: TMAC Resources Inc.


August 25 – Oct 5, 2019

<u>Page</u>	<u>Table of contents</u>
1	Panel and seam layout drawing
2-5	Daily wedge/extrusion welder qualification data and destruct sample test results.
6	Non-destructive air pressure test data
7-8	International Association of Geosynthetic Installers (IAGI) Certified Welding Technician (CWT) certificates.
9	A&A Technical Services subgrade acceptance and warranty.

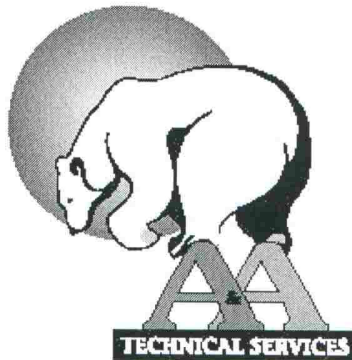


A&A Technical Services
Yellowknife NT

TMAC Resources Inc.
Hope Bay NT
Madrid Portal HDPE Liner
60mil textured HDPE sandwiched between 540g/m2 non-woven geotextile.
Panel layout drawing.

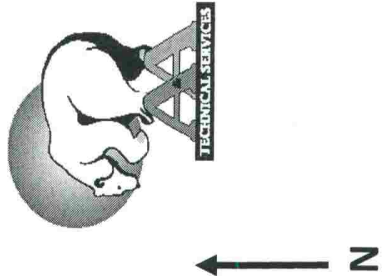

P-1 Panel number


- Extrusion Patch
- └ Extrusion T weld
- Sump
- Destruct sample location

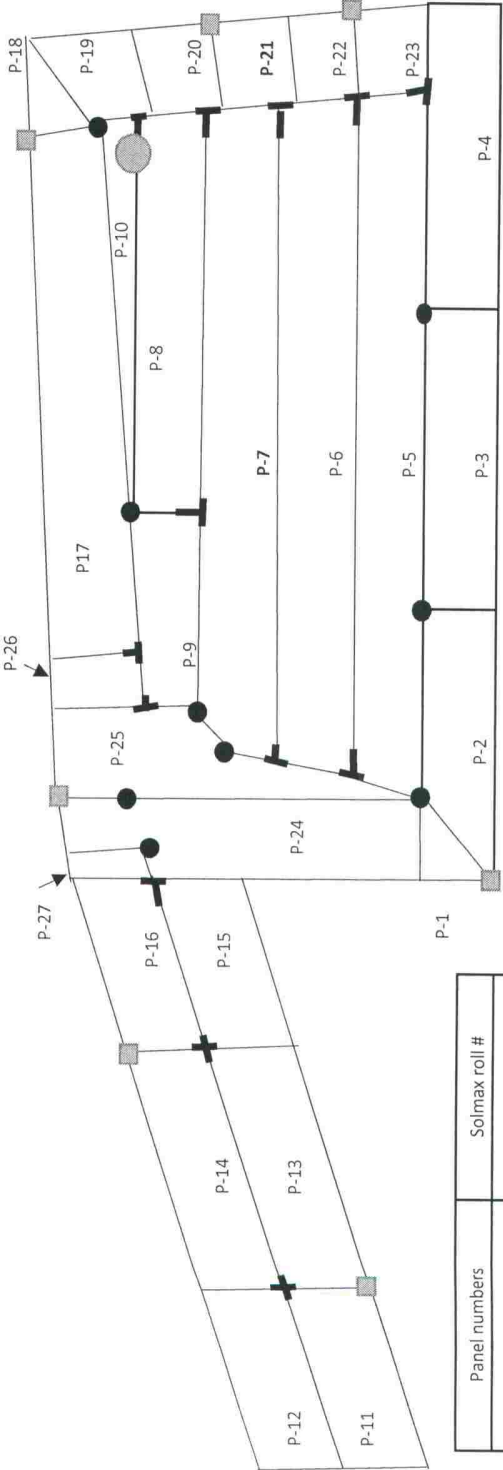

Panel numbers	Solmax roll #
P1 to P16	1-138393
P17 to P24	1-138388
P25 to P27	1-138401

* Note: Not to scale

A&A Technical Services
Yellowknife NT
October 22- November 7, 2019

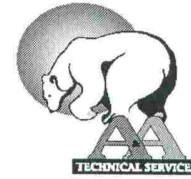

TMAC Resources

Hope Bay - Madrid Portal Solmax 60mil single textured HDPE
Daily wedge and extrusion welder qualification and destruct sample tests.

Test welds were completed in ambient conditions at site.
Peel and shear tests were conducted inside Madrid office trailer
at room temperature for prequalification of welders and
destruct test samples.
Portable hoarding was used for all wedge and extrusion welding.

Wedge Welder - Demtech Prowedge #2 Tech: AH

Peel strength Temp. 420 C Speed 1.8m minute

27-Oct-19	Inside weld	Outside weld	Minimum ppi (lbs/inch)
1	142	145	91
2	138	136	91
3	145	142	91
4	139	141	91
27-Oct-19	Shear Strength		Minimum ppi (lbs/inch)
1	160		120
2	162		120

Wedge Welder - Demtech Prowedge #2 Tech: AH

Peel strength Temp. 420 C Speed 1.8m minute

30-Oct-19	Inside weld	Outside weld	Minimum ppi (lbs/inch)
1	144	135	91
2	146	150	91
3	148	151	91
4	146	149	91
30-Oct-19	Shear Strength		Minimum ppi (lbs/inch)
1	161		120
2	160		120

Wedge Welder - Demtech Prowedge #2 Tech: GH

Peel strength Temp. 420 C Speed 1.8m minute


02-Nov-19	Inside weld	Outside weld	Minimum ppi (lbs/inch)
1	140	145	91
2	142	150	91
3	139	142	91
4	135	142	91
02-Nov-19	Shear Strength		Minimum ppi (lbs/inch)
1	161		120
2	164		120

Wedge Welder - Demtech Prowedge #2

Tech: GH

Peel strength Temp. 420 C Speed 1.8m minute

03-Nov-19	Inside weld	Outside weld	Minimum ppi (lbs/inch)
1	137	141	91
2	139	145	91
3	144	138	91
4	140	148	91
03-Nov-19	Shear Strength		Minimum ppi (lbs/inch)
1	159		120
2	162		120

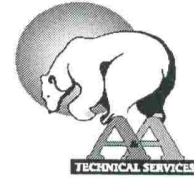

Wedge Welder - Demtech Prowedge #2

Tech: GH

Peel strength Temp. 420 C Speed 1.8m minute

04-Nov-19	Inside weld	Outside weld	Minimum ppi (lbs/inch)
1	139	148	91
2	144	140	91
3	142	139	91
4	136	139	91
04-Nov-19	Shear Strength		Minimum ppi (lbs/inch)
1	155		120
2	155		120

Extrusion welder daily prequalifications

Extrusion Welder- ProXL #1

Tech: AH

Hot air temp: - 260 C Extrudite temp: 250 C

27-Oct-19	Peel strength		Minimum ppi (lbs/inch)
1	138		78
2	144		78
3	132		78
4	138		78
27-Oct-19	Shear Strength		
1	158		120
2	152		120

Extrusion Welder- ProXL #1

Tech: GH

Hot air temp: - 260 C Extrudite temp: 250 C

30-Oct-19	Peel strength		Minimum ppi (lbs/inch)
1	141	144	78
2	132	135	78
3	140	131	78
4	136	136	78
30-Oct-19	Shear Strength		
1	158		120
2	160		120


Extrusion Welder- ProXL #1

Tech: GH

Hot air temp: - 260 C

Extrudite temp: 250 C

03-Nov-19	Peel strength		Minimum ppi (lbs/inch)
1	145		78
2	139		78
3	140		78
4	132		78
03-Nov-19	Shear Strength		
1	152		120
2	158		120

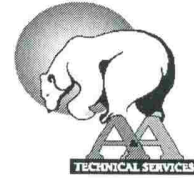

Destruct samples from wedge weld seams

Location : Top of seam panels 1 and 2.

Tech: AH

Peel strength

27-Oct-19	Inside weld	Outside weld	Minimum ppi (lbs/inch)
1	137	139	91
2	139	134	91
3	142	141	91
4	140	144	91
27-Oct-19			Minimum ppi (lbs/inch)
1	157		120
2	163		120

Location : S end of seam P11 and P13

Tech: AH

Peel strength Temp. 420 C Speed 1.8m minute

30-Oct-19	Inside weld	Outside weld	Minimum ppi (lbs/inch)
1	144	139	91
2	138	135	91
3	140	140	91
4	144	140	91
30-Oct-19	Shear Strength		Minimum ppi (lbs/inch)
1	167		120
2	155		120

Location : N end of seam P14 and P16


Tech: AH

Peel strength

30-Oct-19	Inside weld	Outside weld	Minimum ppi (lbs/inch)
1	144	144	91
2	144	138	91
3	142	141	91
4	136	145	91
30-Oct-19	Shear Strength		Minimum ppi (lbs/inch)
1	158		120
2	162		120

Location : Top of seam P17 and P-18

Tech: GH

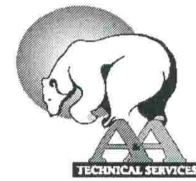

Peel strength			
02-Nov-19	Inside weld	Outside weld	Minimum ppi (lbs/inch)
1	141	132	91
2	140	145	91
3	137	135	91
4	138	139	91
02-Nov-19	Shear Strength		Minimum ppi (lbs/inch)
1	161		120
2	157		120

Location : Top of seam P20 and P21

Tech: GH

Peel strength			
02-Nov-19			Minimum ppi (lbs/inch)
1	139	144	91
2	142	141	91
3	136	139	91
4	137	135	91
02-Nov-19	Shear Strength		Minimum ppi (lbs/inch)
1	161		120
2	163		120

Location : Top of seam P22 and P23


Tech: GH

Peel strength			
02-Nov-19	Inside weld	Outside weld	Minimum ppi (lbs/inch)
1	137	144	91
2	141	142	91
3	137	142	91
4	144	142	91
02-Nov-19	Shear Strength		Minimum ppi (lbs/inch)
1	154		120
2	159		120

Location : Top of seam P24 and P25

Tech: GH

Peel strength			
03-Nov-19	Inside weld	Outside weld	Minimum ppi (lbs/inch)
1	144	142	91
2	142	145	91
3	134	144	91
4	149	142	91
03-Nov-19	Shear Strength		Minimum ppi (lbs/inch)
1	160		120
2	165		120



TECHNICAL SERVICES

Hope Bay - Madrid Portal Solmax 60mil single textured HDPE

Minimum 30 psi over 5 minutes with less than 4 psi loss in pressure = Pass

page 6

CERTIFIED WELDING TECHNICIAN



**The International Association of Geosynthetic Installers
Certifies:**

ALAN HARMAN

As a **Certified Welding Technician**, in polyethylene wedge and extrusion welding, having demonstrated superior hands-on skills, knowledge and experience in the welding and installation of polyethylene (PE) geomembranes, and having basic mechanical aptitude for working with welders and equipment on the job site.

Registration number: **CWT162010**

Valid 07 June 2016 — 07 June 2021

President, IAGI

Managing Director, IAGI



CERTIFIED WELDING TECHNICIAN



**The International Association of Geosynthetic Installers
Certifies:**

GUY HORSAY

As a **Certified Welding Technician**, in polyethylene wedge and extrusion welding, having demonstrated superior hands-on skills, knowledge and experience in the welding and installation of polyethylene (PE) geomembranes, and having basic mechanical aptitude for working with welders and equipment on the job site.

Registration number: **CWT170010**

Valid 07 June 2016 — 07 June 2021



President, IAGI

Managing Director, IAGI

**A&A Technical Services
Yellowknife NT**

**Madrid Portal 60mil HDPE liner Installation
October 23 – November 7, 2019**

Client: TMAC Resources Inc.

Upon arrival to site the containment area to be lined was thoroughly inspected by A&A Technical Services installation supervisor and deemed to be a suitable surface on which to place the HDPE lining system. The Solmax 60 mil single textured HDPE was sandwiched between two layers of 540g/m2 non-woven geotextile. The lining system was placed over a compacted layer of -25mm crushed rock and backfilled with the same.

Warranties issued by A&A Technical Services shall cover only the cost of replacement and/or repair of defective installations, determined or agreed to be the responsibility of A&A Technical Services, provide that the warranty work will be performed to the same standards and scope of work set out in the contract documents. A&A's installation warranty shall commence upon acceptance of the individual geosynthetic components by the owner or its representative as such components are completed. The installation warranty period shall not exceed beyond 1 years. Our installation warranty is rendered null and void if the installed geosynthetics are subject to abuse by machinery, equipment or personnel not under the control of A&A, harmful chemicals or unusual weather conditions or catastrophic earthworks failures.

A&A Technical Services shall not be held liable for defects, damage and/or deficient materials and installations, either in whole or in part should the defects, damage or deficient materials and installations arise as the result from the use of poor quality and inappropriate or unsuitable earthworks material or site preparation. This limitation of liability extends to improper and/or construction techniques, and methods and equipment used to create the earthworks covering all or any portion of the completed geosynthetic installation.

Signed: 

Dated: November 7, 2019

Al Harman
President
A&A Technical Services
Yellowknife NT

Attachment 5 – Naartok East Overburden Stockpile

Attachment 5.1 Naartok East Overburden Stockpile – IFC Drawings






TMAC Resources Inc.
Madrid North Project
Naartok East CPRT Overburden Stockpile

Drawing Number	Drawing Title	Issue	Date	Revision
01	Overburden Stockpile Location and Surface Water Drainage	Issued for Construction	2019/05/30	0
02	Cross Section A-A' and Typical Construction Access Road Detail	Issued for Construction	2019/05/30	0



Signed and stamped copies
2019/05/30

[Handwritten signature]



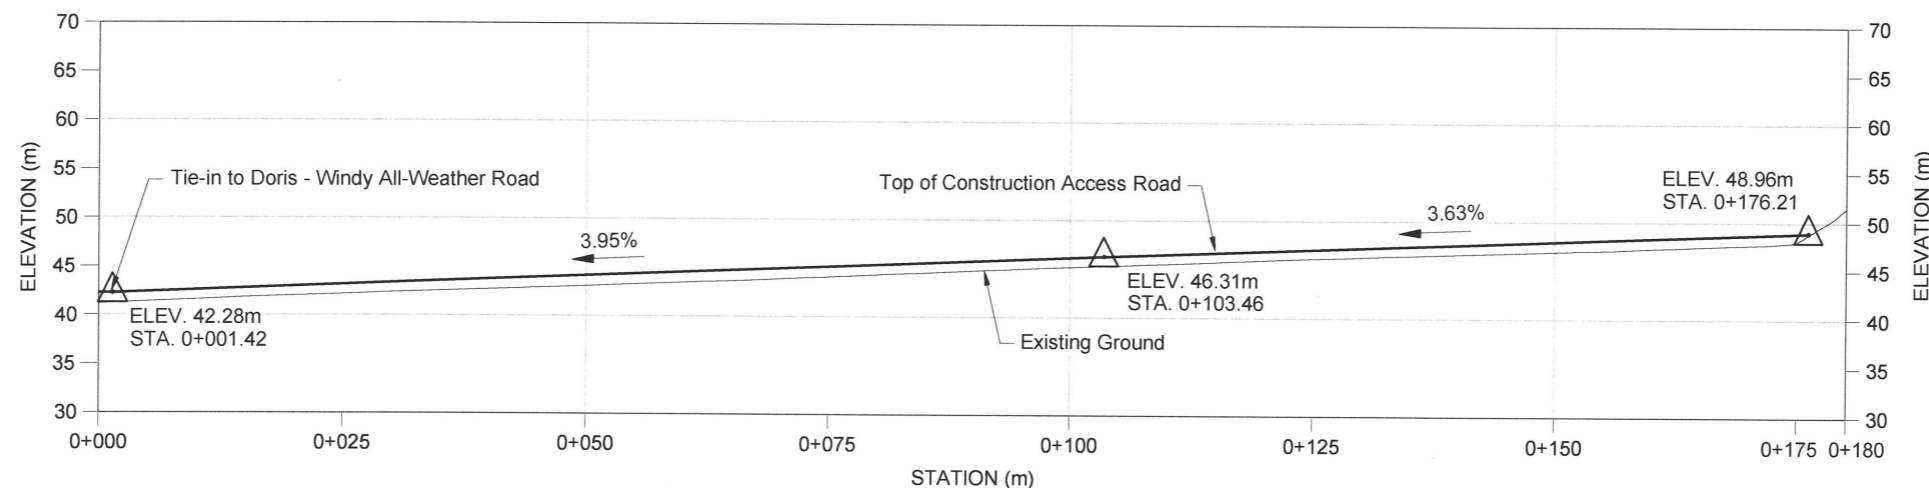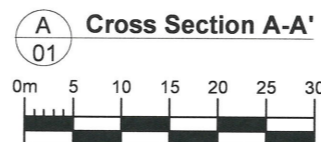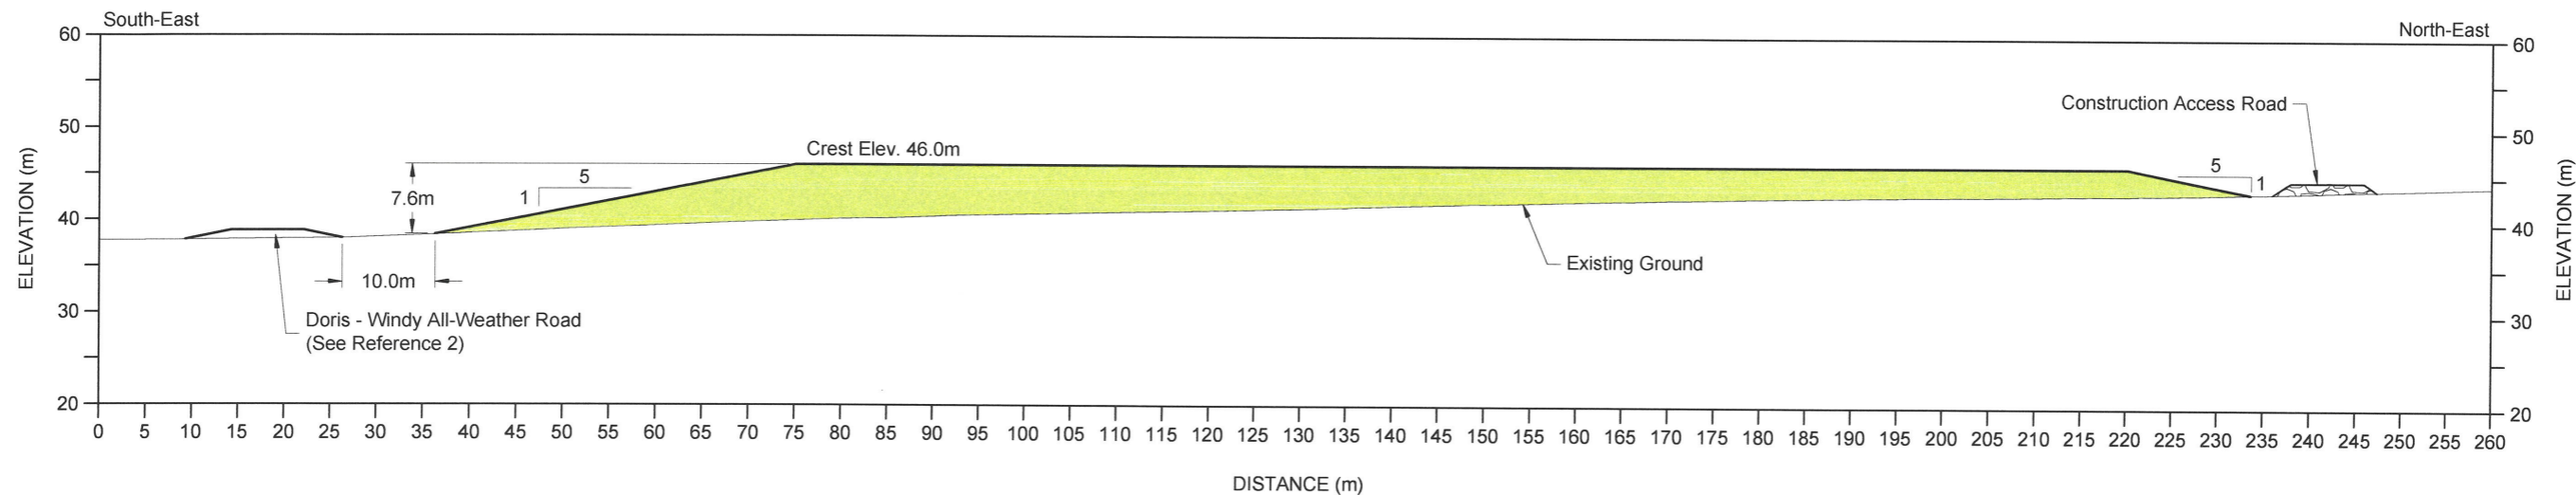

Construction Access Road Profile

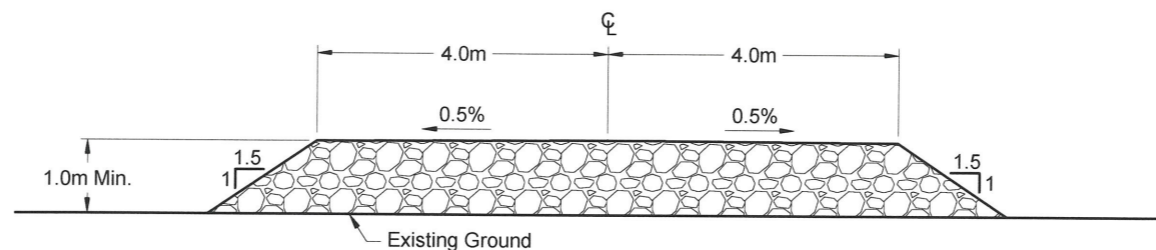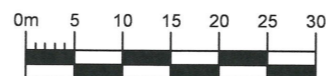

Typical Construction Access Road Detail



LEGEND

- Geochemically Suitable Run of Quarry (ROQ) or Run of Mine (ROM)
- Overburden Stockpile

NOTES

- The designs are based on the contour information shown on these drawings. It is the Contractor's responsibility to confirm that the contours are a fair reflection of the ground levels in the vicinity of the works, and to advise the Construction Manager and Engineer of any differences.
- All units shown in meters unless otherwise specified.

REFERENCES

- NAD83 UTM Zone 13.
- Engineering Drawings for the Doris-Windy All-Weather Road, Doris Infrastructure Project, Nunavut, Canada. Revision AB1. As-Built drawings prepared for Hope Bay Mining Ltd. Project Number: 1CH008.033/058. May 11, 2012.
- Geochemical Characterization of Quarry Materials for the Doris-Windy All-Weather Road, Hope Bay Project. Report prepared for Hope Bay Mining Ltd. Project Number: 1CH008.000. August 2008.

P:\01_SITES\Hope Bay\ACAD\FC\Naatok East\08 Stockpile\1CT022.043 - Stockpile.dwg

REFERENCE DRAWINGS				REVISIONS				PROFESSIONAL ENGINEERS STAMP				FILE NAME: 1CT022.043 - Stockpile.dwg				SRK JOB NO.: 1CT022.043				Naatok East Overburden Stockpile			
DRAWING NO.	DRAWING TITLE	NO.	DESCRIPTION	CHKD	APPD	DATE	NO.	DESCRIPTION	CHKD	APPD	DATE	DESIGN: RW	DRAWN: TAH	REVIEWED: RW	Hope Bay Project				DRAWING TITLE: Cross Section A-A' and Typical Construction Access Road Detail				
												CHECKED: RW				APPROVED: EMR				DATE: 2019/05/30			
																				DRAWING NO. 02			
																				SHEET 2 OF 2			
																				REVISION NO. 0			

Attachment 5.2 Naartok East Overburden Stockpile – As-built Drawings

TMAC Resources Inc.

Engineering Drawings for the Naartok East Crown Pillar Recovery (CPR) Overburden Stockpile at Madrid North, Hope Bay Project, Nunavut, Canada

Drawing Number	Drawing Title	Issue	Date	Revision
01	Overburden Stockpile Location and Surface Water Drainage	As-Built	2020/03/31	AB1
02	Cross Section A-A' and Typical Construction Access Road Detail	As-Built	2020/03/31	AB1




Overburden Stockpile Capacity: 75,000m³
Overburden Stockpile (January 2020): 97,990m³
Temporary Access Road Material: 1,450m³
Temporary Access Roads Material: 21,945m³

* All volumes reported are calculated to neat lines. Losses into the Tundra are not accounted for. The overburden stockpile capacity includes a 15% bulking factor.




Doris - Windy All-Weather Road
Constructed in 2010 and 2011
(See Reference 3)

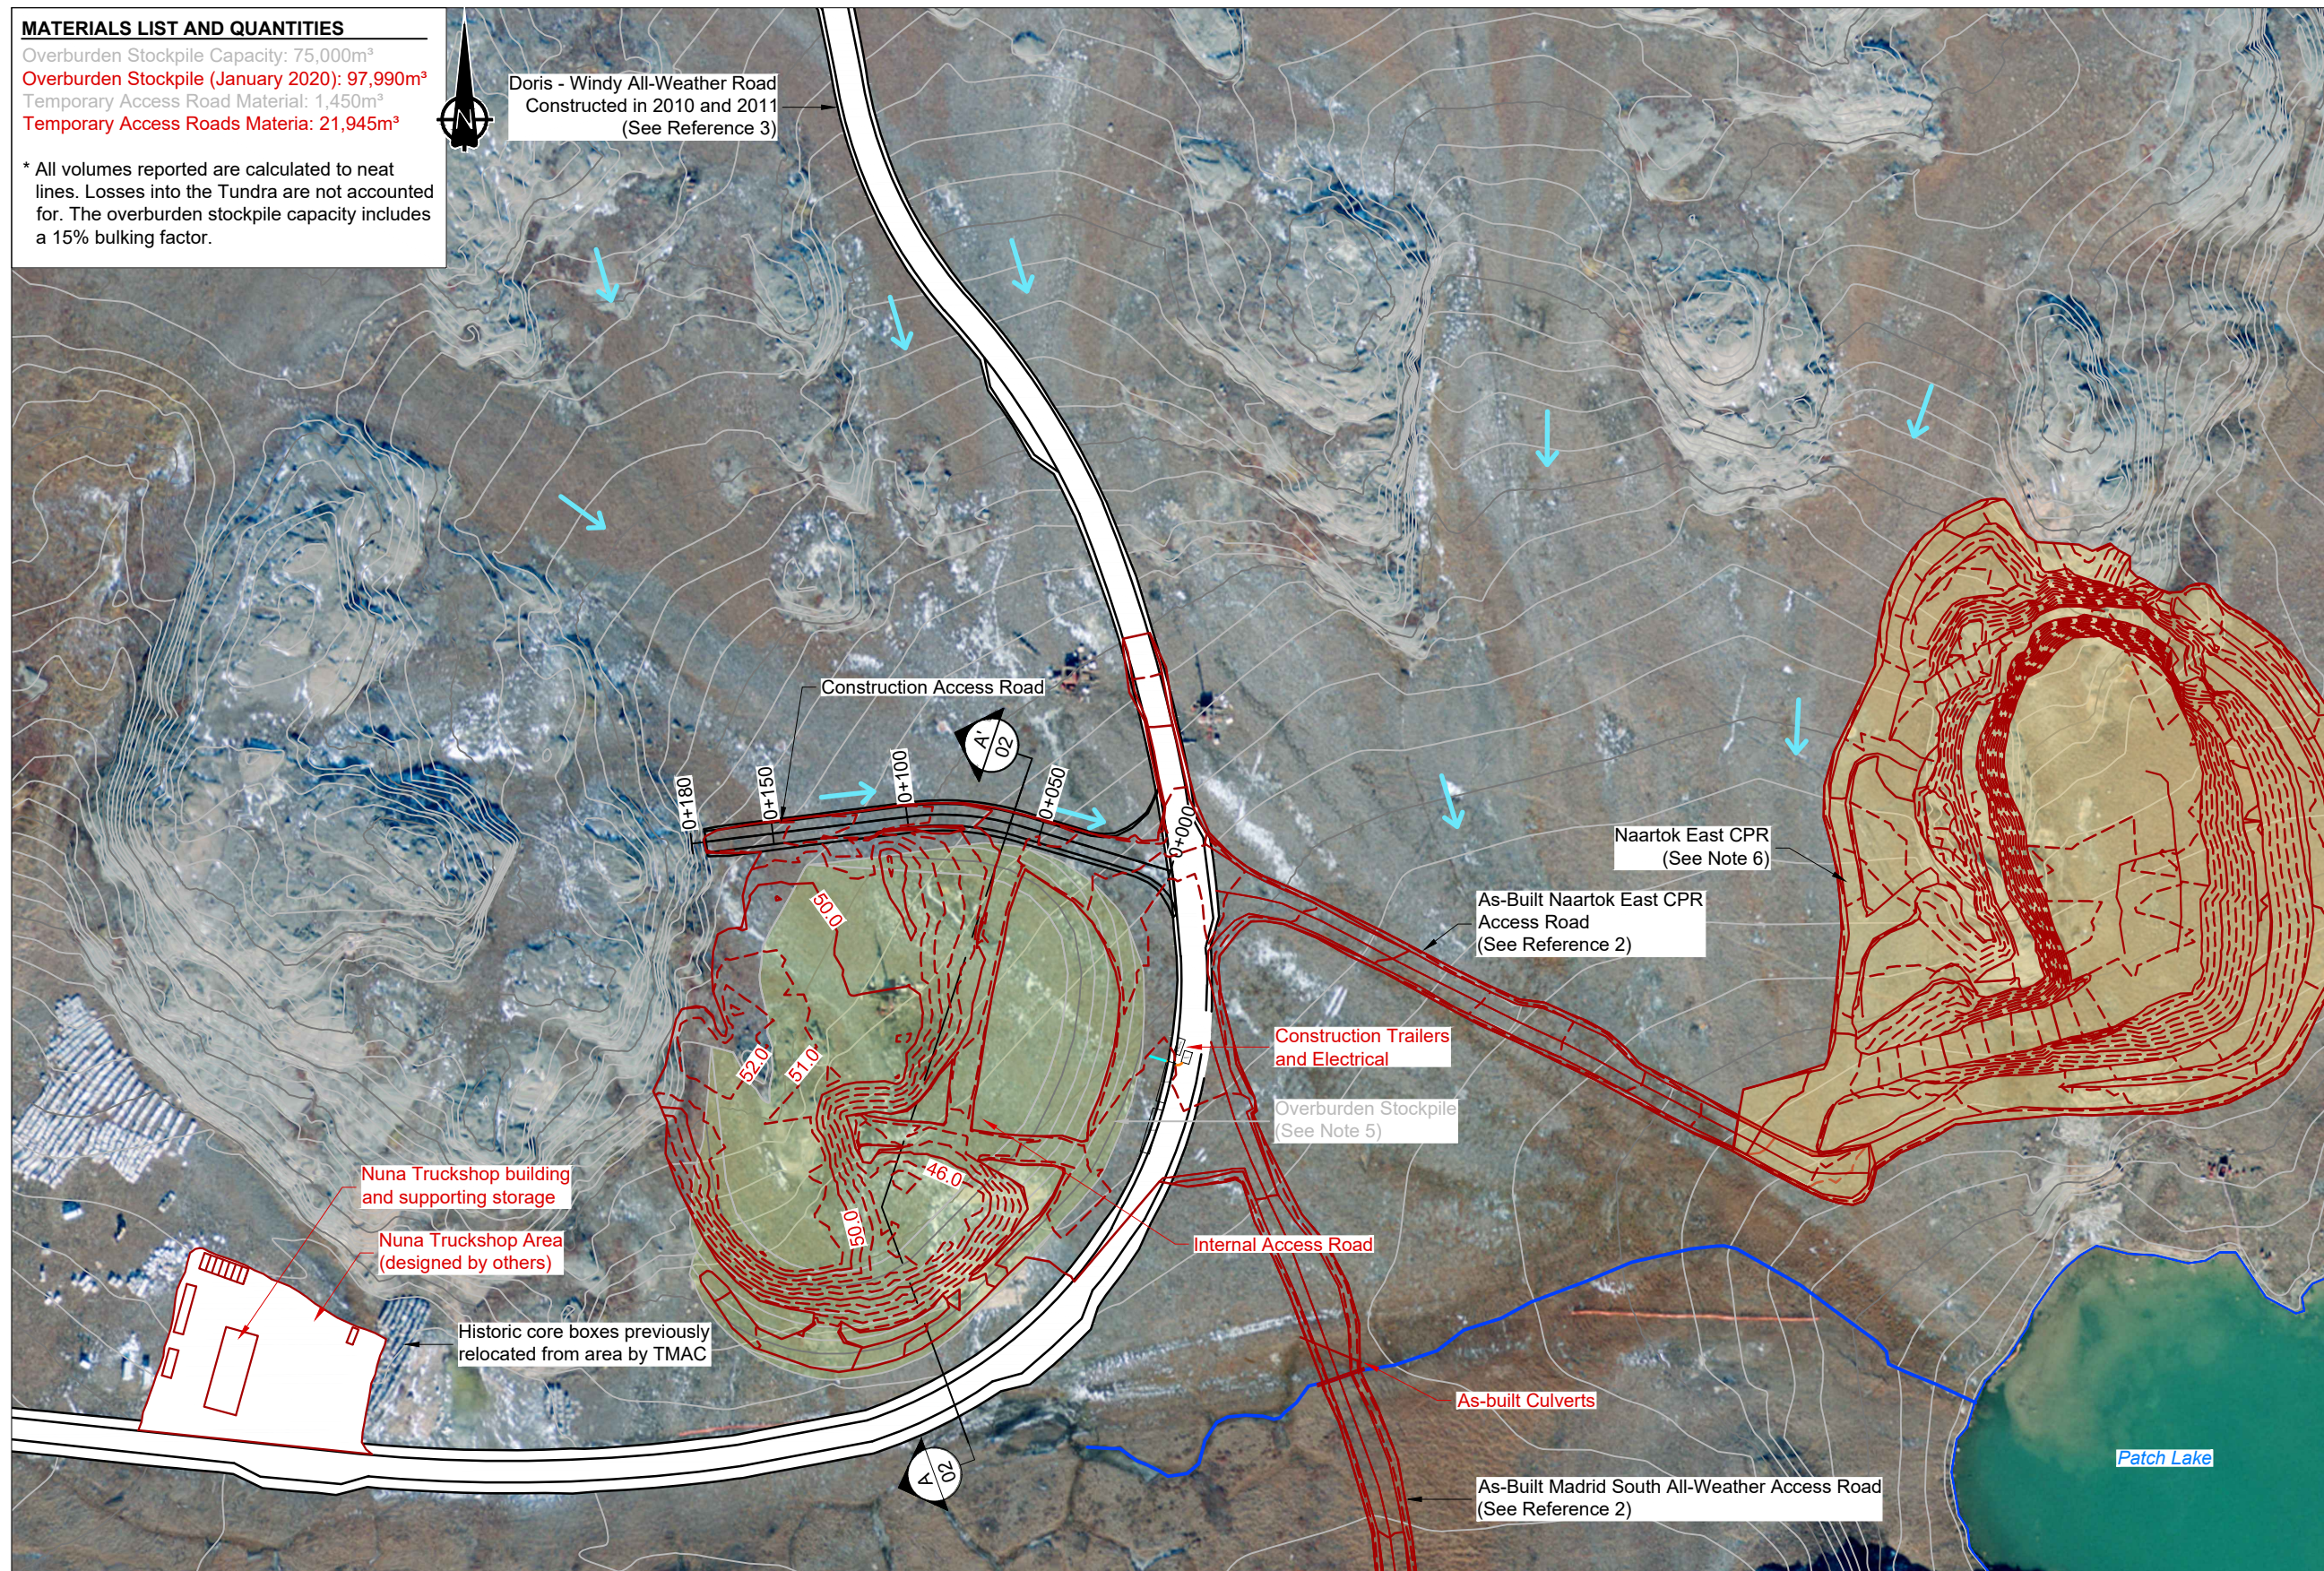

-  Drainage Direction
-  Crown Pillar Recovery Area
-  Design Overburden Stockpile Location
-  2019 As-Built Infrastructure

1. The designs are based on the contour information shown on these drawings. It is the Contractor's responsibility to confirm that the contours are a fair reflection of the ground levels in the vicinity of the works, and to advise the Construction Manager and Engineer of any differences.
2. Contours shown at 1.0m intervals.
3. All units shown in meters unless otherwise specified.
4. A minimum 31.0m setback from waterbodies is required.
5. Overburden stockpile designed in accordance with design principles as per Reference 5. This includes:
 - Overall slope angles should not exceed 5H:1V (11°).
 - Maximum height of 10m.
6. **Interim as-built configuration for the Phase 1 Naartok East CPR shown for information purposes only. Development of the CPR is currently on-going.**

1. NAD83 UTM Zone 13.
2. Details found in "Engineering Drawings for the Madrid South All-Weather Road, Hope Bay Project, Nunavut, Canada". Revision E Issued for Discussion drawings prepared for TMAC Resources. Project Number: 1CT022.043. March 2019.
3. Engineering Drawings for the Doris-Windy All-Weather Road, Doris Infrastructure Project, Nunavut, Canada. Revision AB1. As-Built drawings prepared for Hope Bay Mining Ltd. Project Number: 1CH008.033/058. May 11, 2012.
4. Geochemical Characterization of Quarry Materials for the Doris-Windy All-Weather Road, Hope Bay Project. Report prepared for Hope Bay Mining Ltd., 1CH008.000. August 2008.
5. Hope Bay Project, Geotechnical Design Parameters and Overburden Summary Report. Report prepared for TMAC Resources. Project Number: 1CT022.013. November 2017.
6. **As-built survey provided by Sub-Arctic Geomatics Ltd. Dated May 27, 2019 and January 14/15, 2020.**

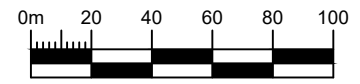[illegible]

DESIGN: RW	DRAWN: TAH	REVIEWED: RW
CHECKED: RW	APPROVED: JBK	DATE: 2020/03/31

FILE NAME: 1CT022.043 - Stockpile.dwg



Hope Bay Project

SRK JOB NO.: 1CT022.043

Madrid North Naartok East CPR

DRAWING TITLE:

Overburden Stockpile Location and
Surface Water Drainage

DRAWING NO.	SHEET	REVISION NO.
01	1 OF 2	AB1

P:\Projects\01 SITES\Hope Bav\ACAD\As-Builts\Naartok East OB Stockpile\Naartok East CPR1CT022.043 - Stockpile.dwg

Attachment 6 – Naartok East Overburden Stockpile Expansion


Attachment 6.1 Naartok East Overburden Stockpile Expansion – IFC Drawings




TMAC Resources Inc.
Madrid North Project
Naartok East CPR Overburden Stockpile

Drawing Number	Drawing Title	Issue	Date	Revision
MN-OB-01	Overburden Stockpile Expansion Drainage Pathways	Issued for Construction	12/19/2019	0
MN-OB-02	Overburden Stockpile Expansion Location and Primary Filter Berm	Issued for Construction	12/19/2019	0
MN-OB-03	Cross Section A-A' and Typical Construction Access Road Centerline Profile	Issued for Construction	12/19/2019	0
MN-OB-04	Typical Details	Issued for Construction	12/19/2019	0

Signed and Stamped Copies
2019/12/19
R. Willi

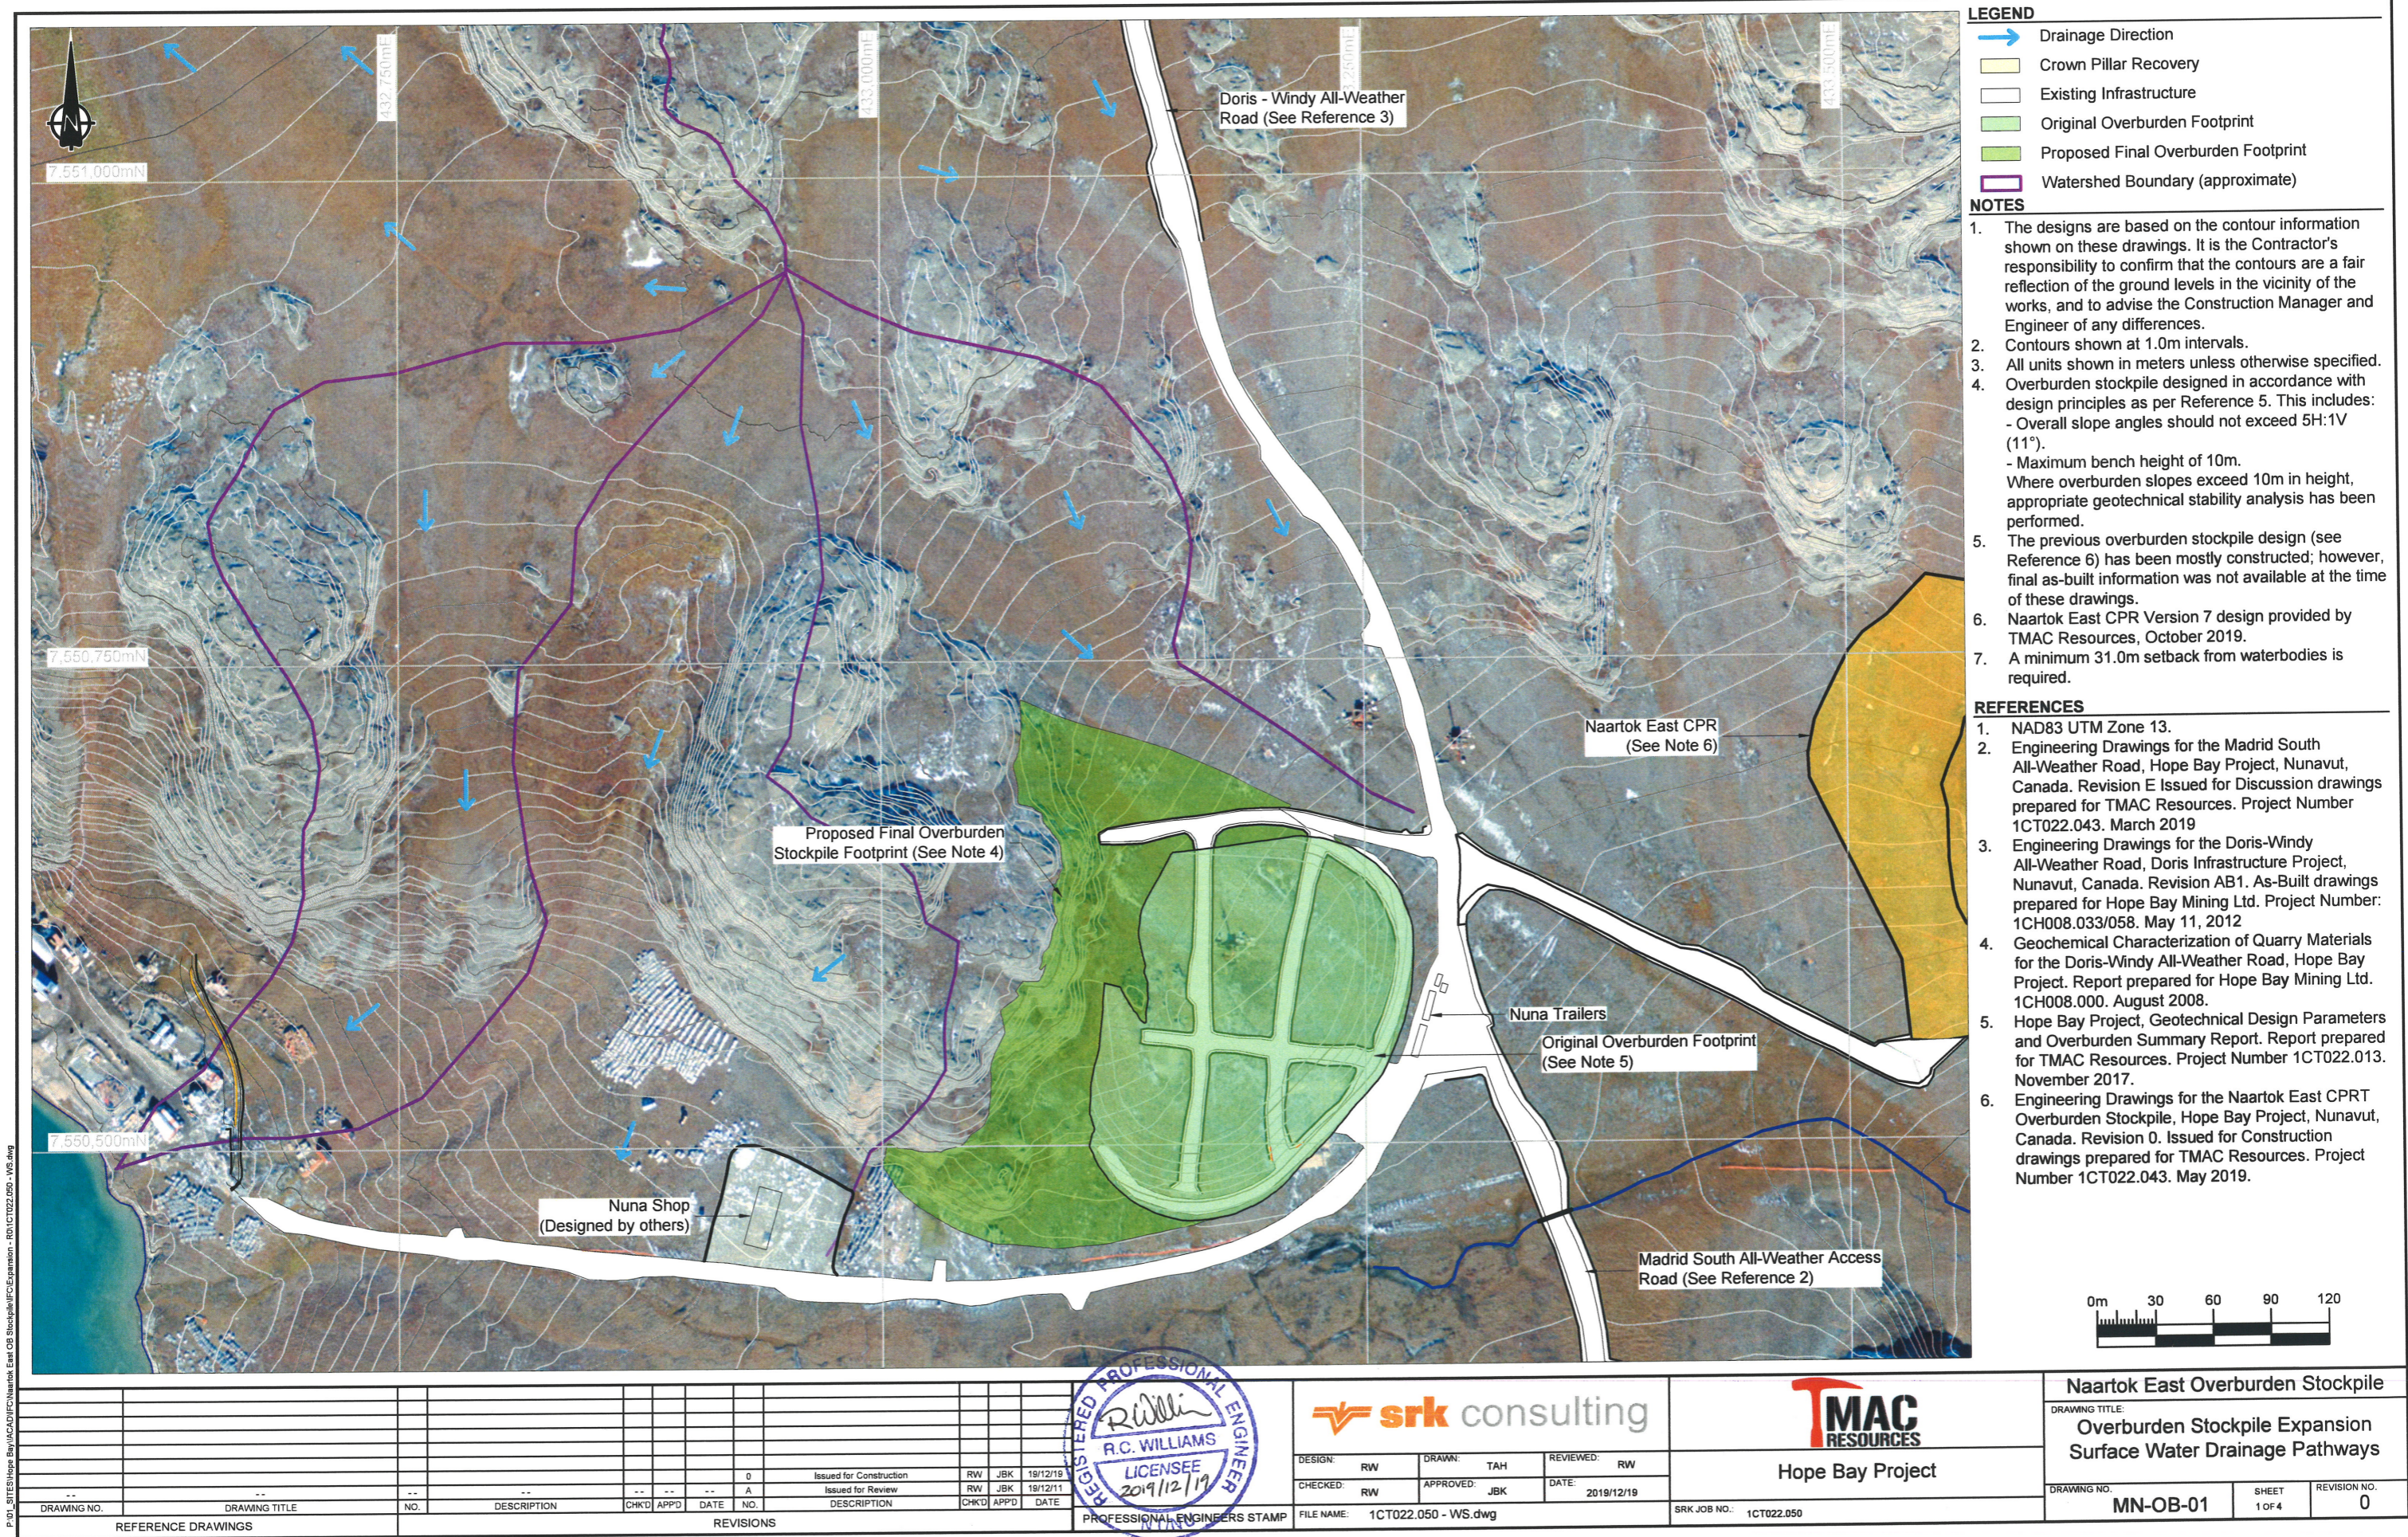


P:\01_SITES\Hope Bay\01CAD\DWG\Naartok East OB Stockpile\WC\Expansion - RD1\CT022.050 - WS.dwg

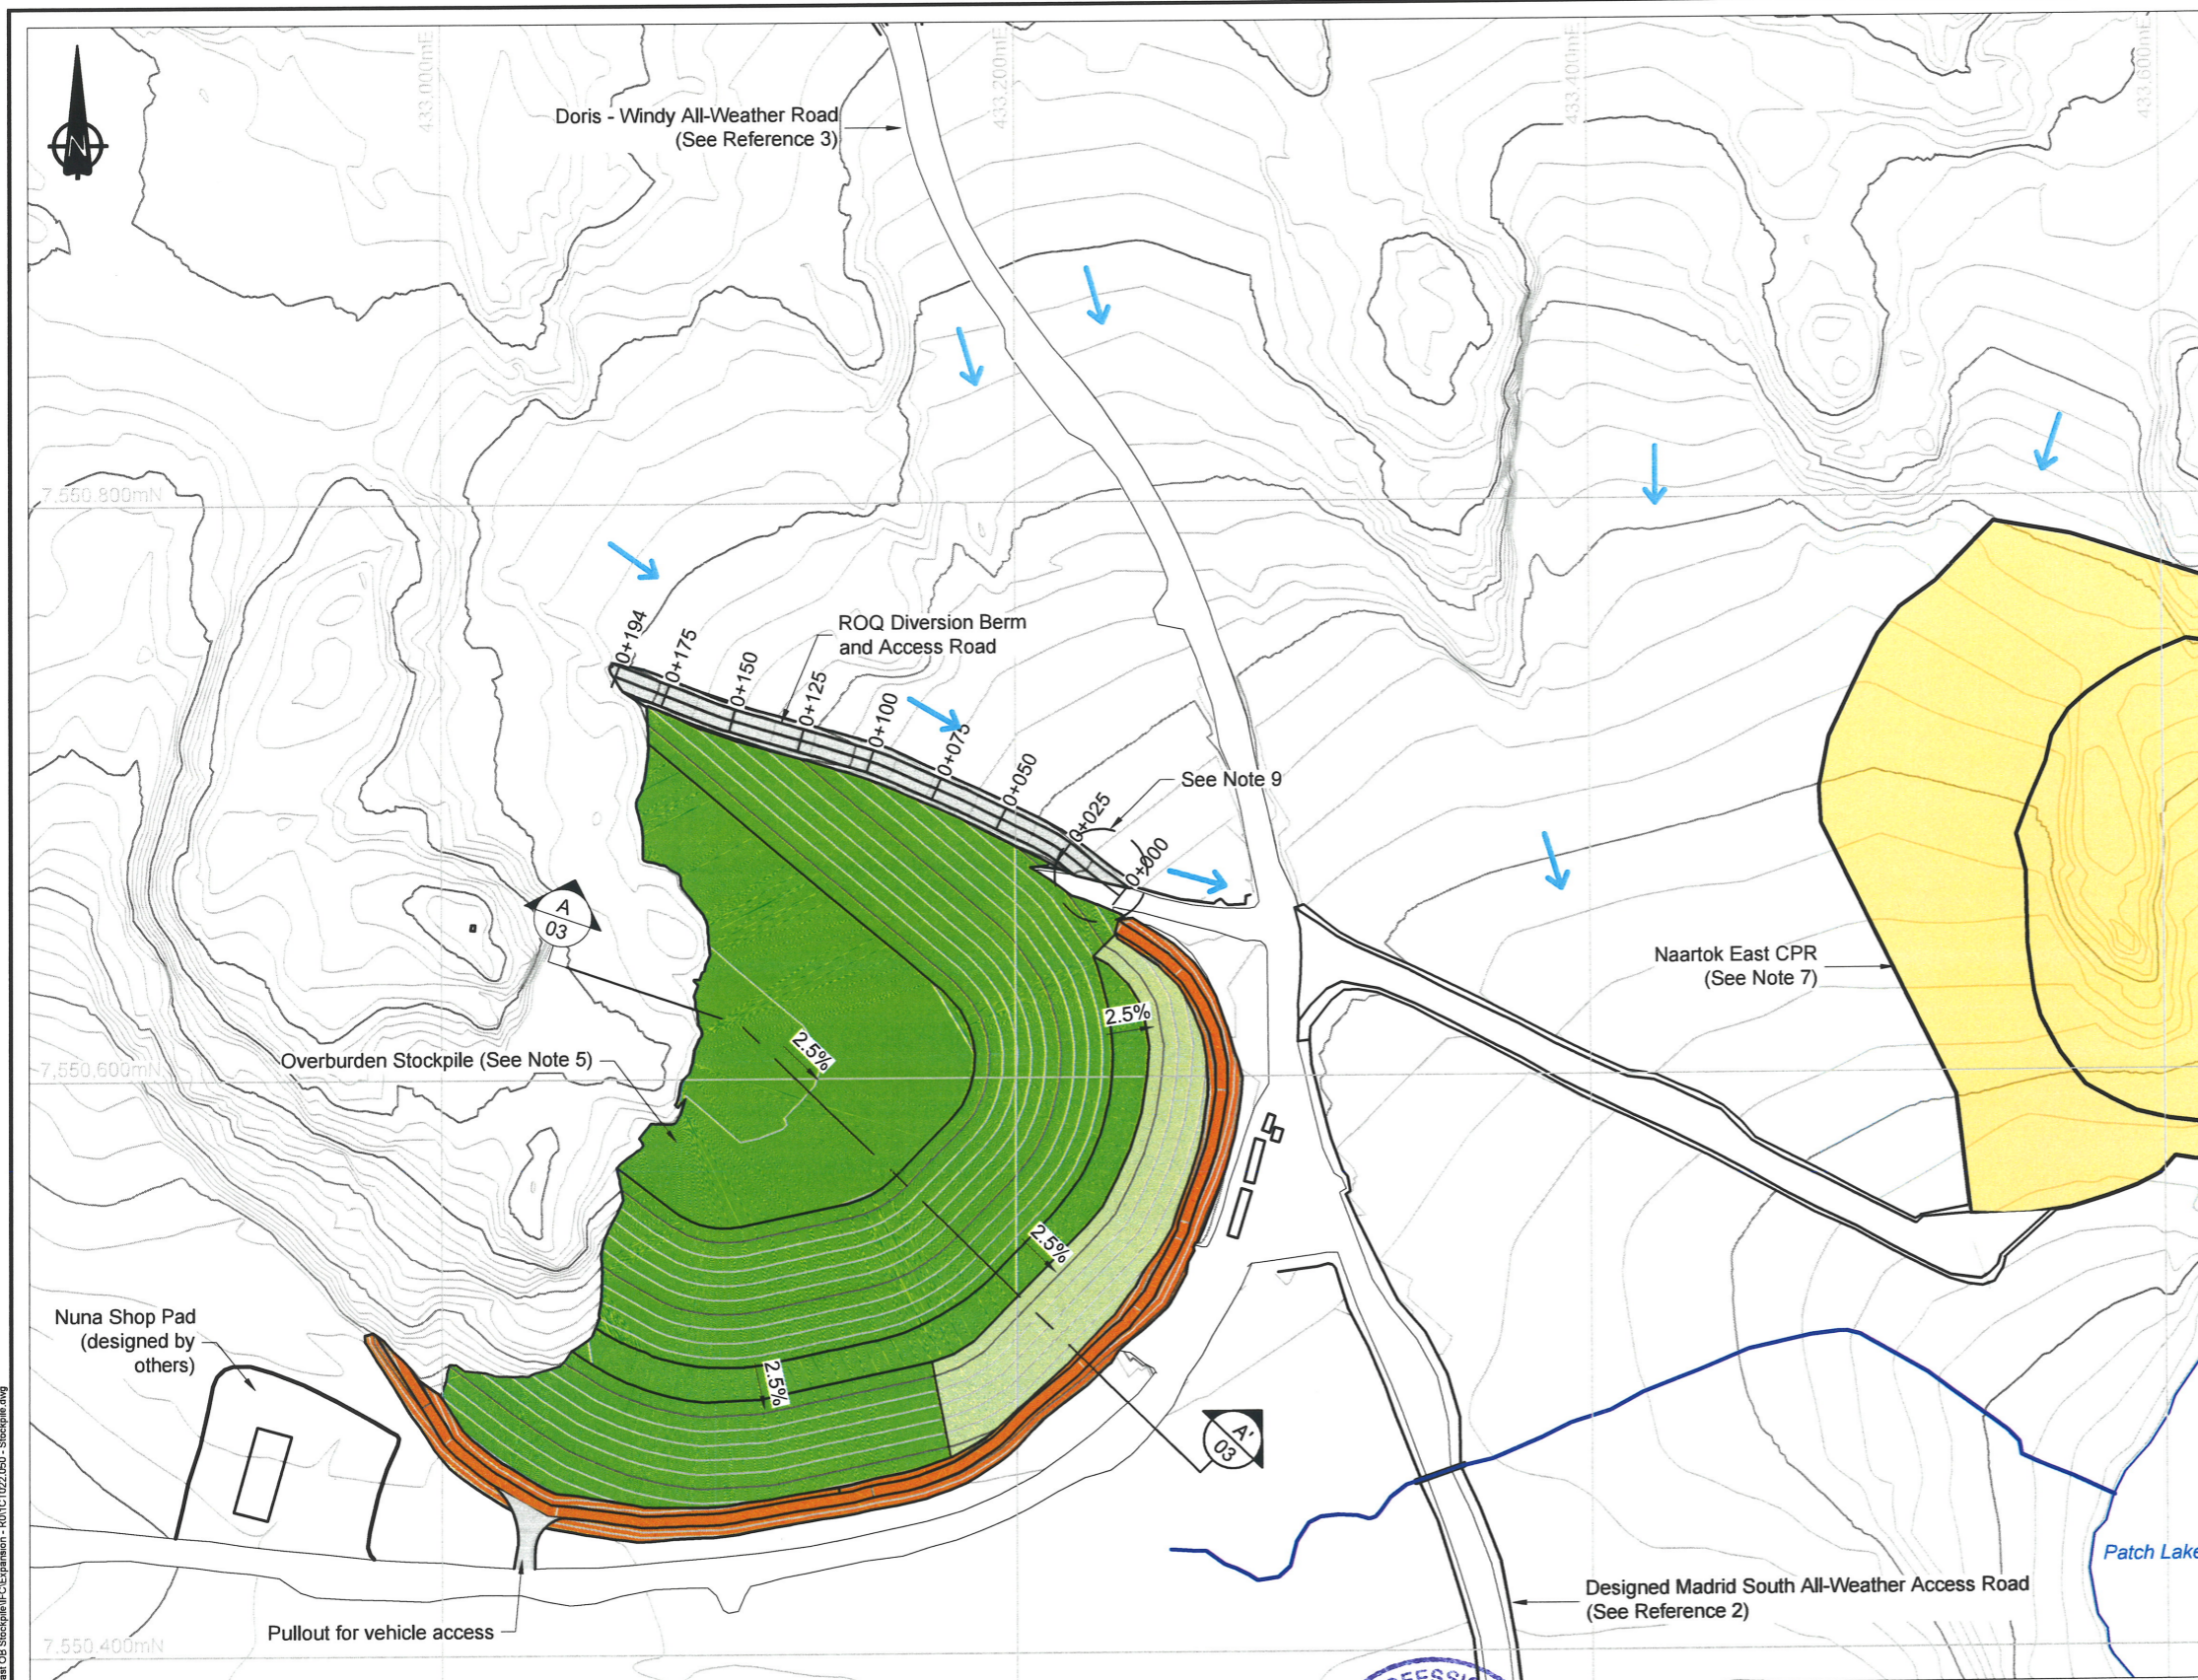


DRAWING NO. MN-OB-02	SHEET 3 OF 4	REVISION NO. 0
--------------------------------	-----------------	--------------------------


P:\01_SITES\Hope Bay\NAD83\FC\NAD83 - East OB Stockpile\FC\Expansion - FC\CT022.050 - Stockpile.dwg

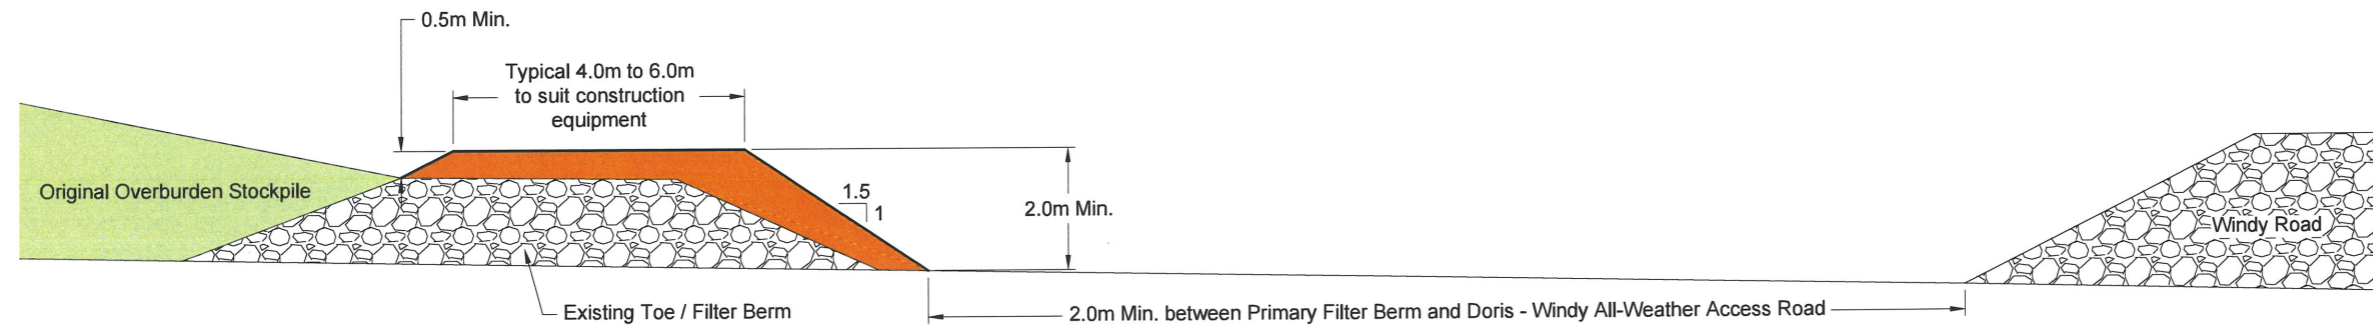

1
04 Primary Filter Berm Detail

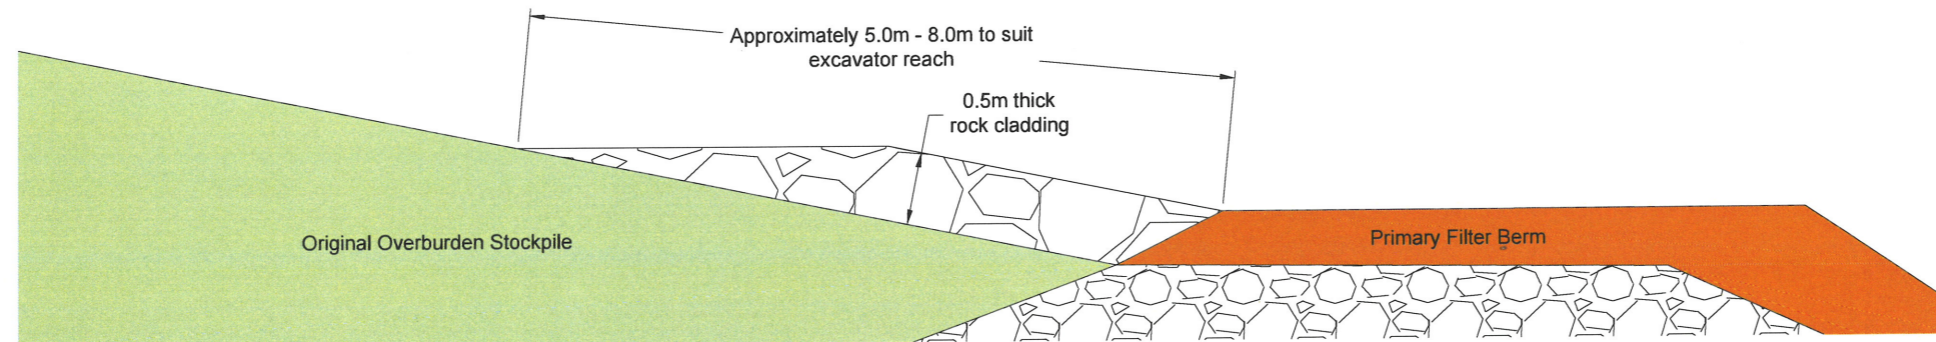

2
04 Rock Cladding Detail

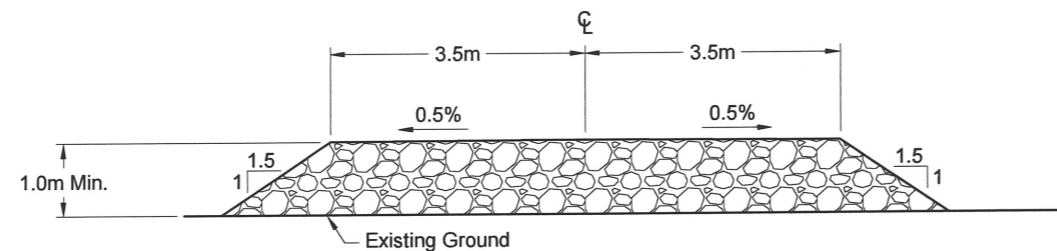

Typical Construction Access Road Detail

LEGEND

- Geochemically Suitable Run of Quarry (ROQ) or Run of Mine (ROM)
- Original Overburden Stockpile
- Primary Filter Berm (See Note 3)


NOTES

- The designs are based on the contour information shown on these drawings. It is the Contractor's responsibility to confirm that the contours are a fair reflection of the ground levels in the vicinity of the works, and to advise the Construction Manager and Engineer of any differences.
- All units shown in meters unless otherwise specified.
- Primary filter berm to consist of transition size, geochemically suitable ROQ or ROM.

REFERENCES

- NAD83 UTM Zone 13.
- Engineering Drawings for the Doris-Windy All-Weather Road, Doris Infrastructure Project, Nunavut, Canada. Revision AB1. As-Built drawings prepared for Hope Bay Mining Ltd. Project Number: 1CH008.033/058. May 11, 2012.
- Geochemical Characterization of Quarry Materials for the Doris-Windy All-Weather Road, Hope Bay Project. Report prepared for Hope Bay Mining Ltd., 1CH008.000. August 2008.

DRAWING NO.	DRAWING TITLE	NO.	DESCRIPTION	CHKD	APPD	DATE	NO.	DESCRIPTION	CHKD	APPD	DATE
--	--	--	--	--	--	--	0	Issued for Construction	RW	JBK	19/12/10
--	--	--	--	--	--	--	A	Issued for Review	RW	JBK	19/12/11
--	--	--	--	--	--	--					
REFERENCE DRAWINGS			REVISIONS								

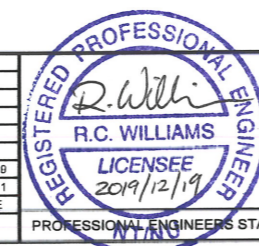

DESIGN:	RW	DRAWN:	TAH	REVIEWED:	RW
CHECKED:	RW	APPROVED:	JBK	DATE:	2019/12/19
FILE NAME: 1CT022.050 - Stockpile.dwg					

Hope Bay Project	
SRK JOB NO.: 1CT022.050	

Naartok East Overburden Stockpile		
DRAWING TITLE:		
Typical Details		
DRAWING NO.	SHEET	REVISION NO.
MN-OB-04	4 OF 4	0