



181 University Avenue  
Suite 300, PO Box 33  
Toronto, Ontario  
M5H 3M7  
416-628-0216

September 11, 2020

Derek Donald  
Technical Advisor  
Nunavut Water Board  
P.O. Box 119  
Goja Haven, NU, X0B 1J0

Sent via Email: [derek.donald@nwb-oen.ca](mailto:derek.donald@nwb-oen.ca); [licensing@nwb-oen.ca](mailto:licensing@nwb-oen.ca)

**Re: Hope Bay Project – Supplementary Submission of Madrid North WRP Sump 1, 2 and 3 As-Builts - Doris and Madrid 2019 Construction Summary Report**

Dear Mr. Donald,

On April 2, 2020, TMAC Resources Inc (TMAC) provided the Nunavut Water Board (NWB) Construction Summary Reports for infrastructure developed at Doris and Madrid under Type 'A' Water Licence 2AM-DOH1335. Included was the 'Hope Bay Project: Doris and Madrid 2019 Construction Summary Report' (SRK, dated April 1, 2020). This Construction Summary Report includes development of the Madrid North Waste Rock Pile (WRP). At time of submission, it was noted that Madrid North WRP sumps were 'to be constructed'.

TMAC recently completed the construction of Sumps 1, 2 and 3 of the Madrid WRP and as such is providing the NWB a supplemental submission to the Hope Bay Project: Doris and Madrid 2019 Construction Summary Report showing final as-built design. Please see Attachment 1 to this letter for Madrid WRP Sumps 1, 2 and 3 as-builts.

These sump as-builts are intended to be added to the existing Madrid WRP as-built package dated April 1, 2020. There have not been any significant changes other than completion of the sumps, so a reissuance of the entire package was not deemed required.

Should you have any questions please feel free to contact me at [oliver.curran@tmacresources.com](mailto:oliver.curran@tmacresources.com).

Sincerely,

**Oliver Curran**  
Vice-President, Environmental Affairs

TMAC Resources Inc.

Cc:



Licencing, NWB  
Kyle Conway, TMAC  
Sarah Warnock, TMAC  
Ashley Mathai, TMAC  
Adam Grzegorzczuk, TMAC

Attachments:

1. As Built Details: Sumps 1, 2 and 3 of the Madrid Waste Rock Pile, SRK, 2020 [3 sheets]

**Attachment 1**


As Built Details: Sumps 1, 2 and 3 of the Madrid Waste Rock Pile, SRK, 2020  
[3 sheets]

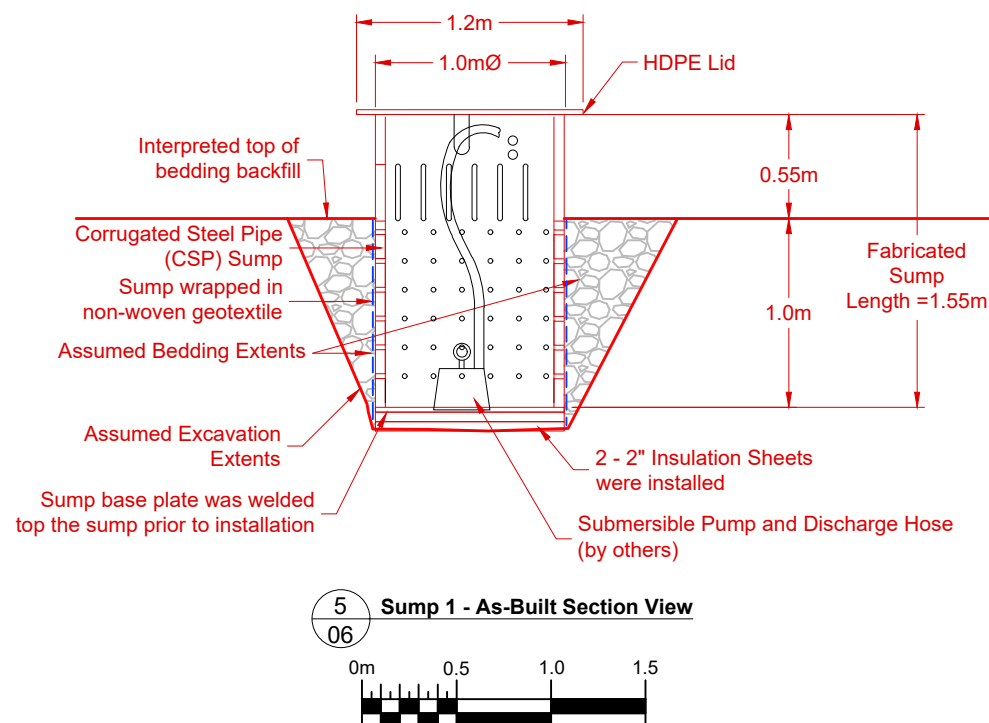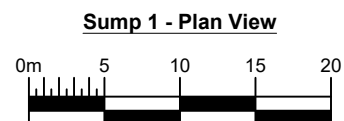


- ## REFERENCE
1. Survey provided by TMAC Resources Inc  
file name: SUMP AB-0513.csv.

																																																																																																																																																																																																																																																																																																																																																																																																																																																																																																																																																																																																																																																																																																																																																																																																																																																																																																																																																																																																																																																																																																																																																																																																																																																																																																																																																																																																																															</
--	--	----





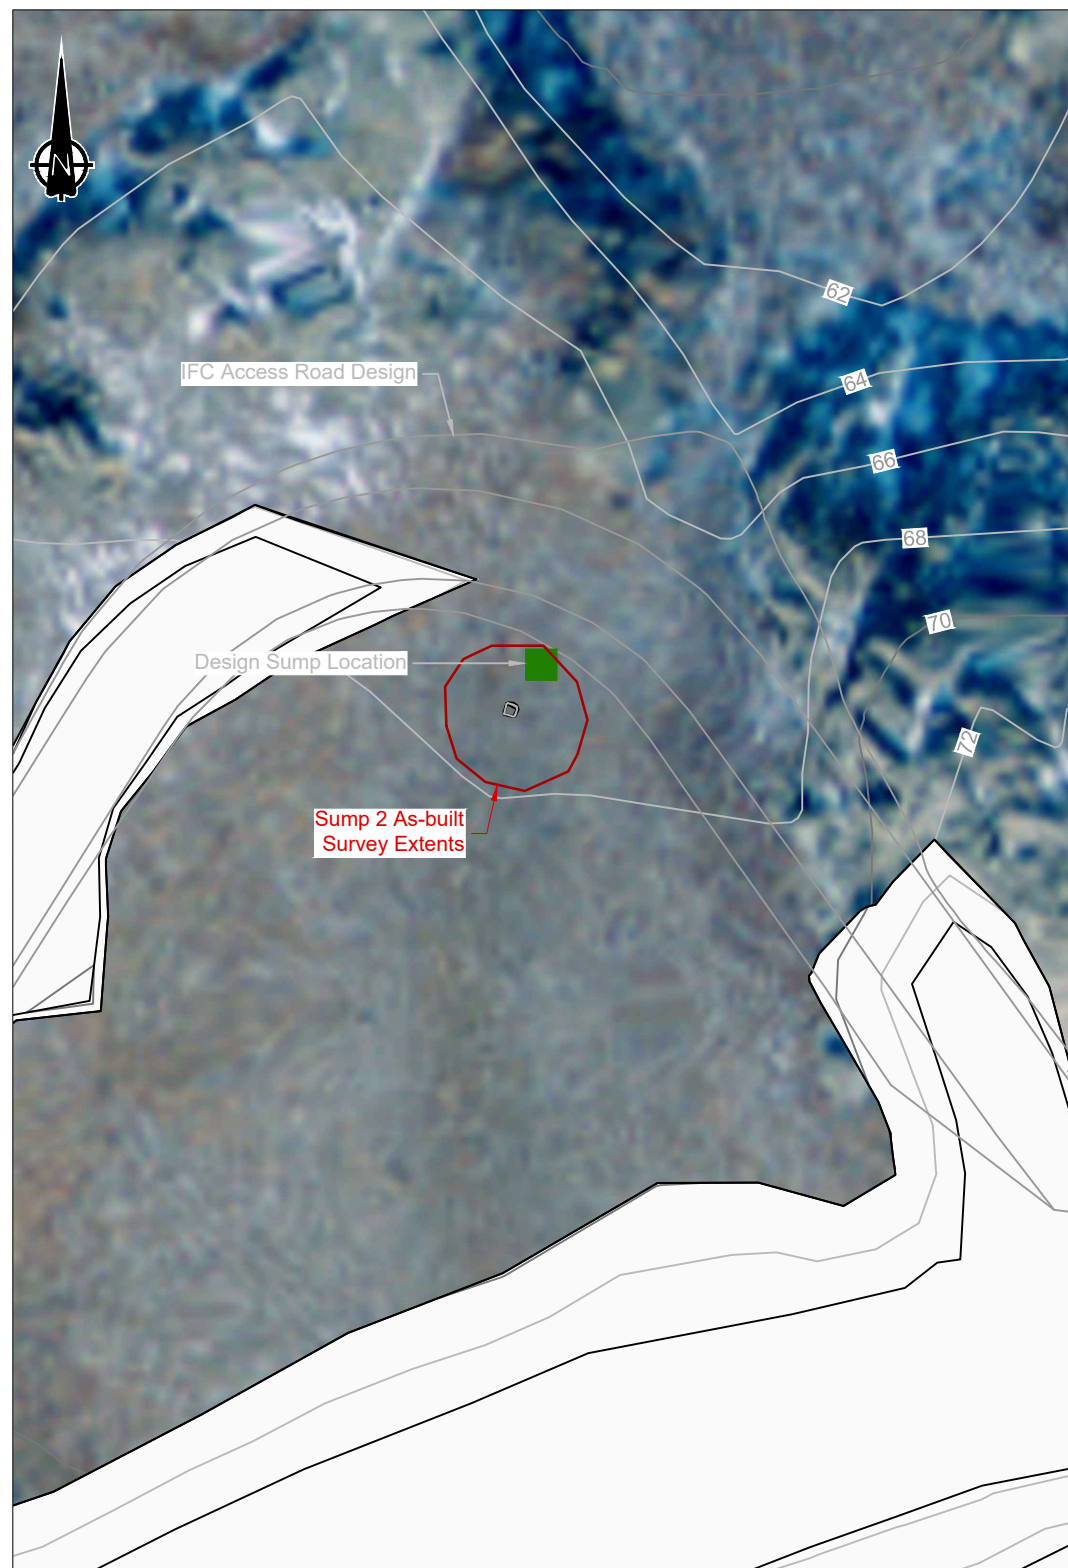



### Sump 2 - Plan View

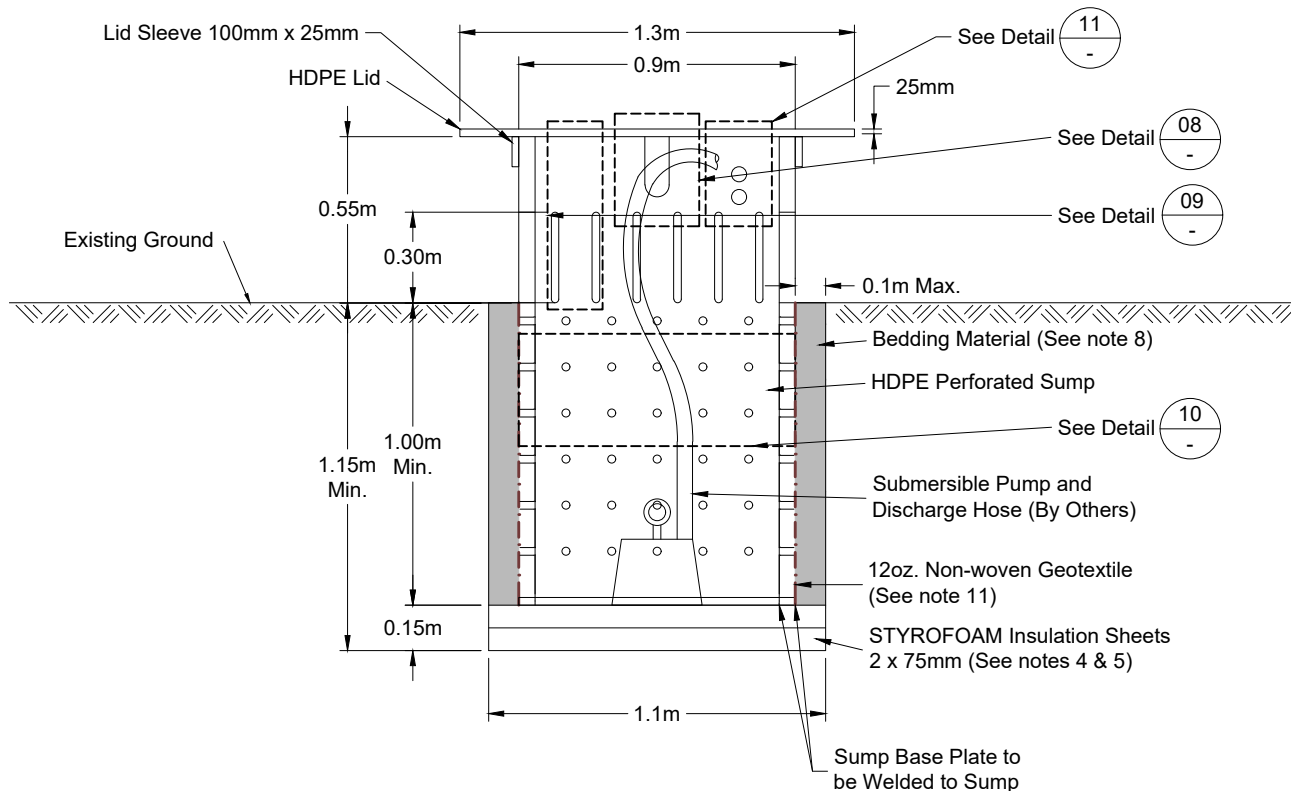

**Sump 2 - IFC Section View**

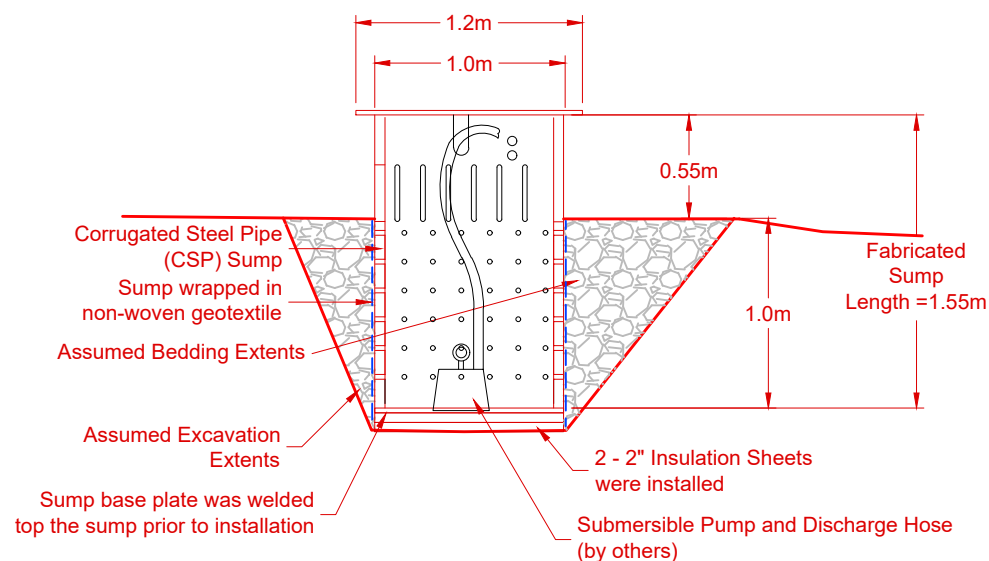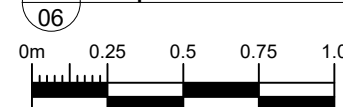

**Sump 2 - As-Built Section View**

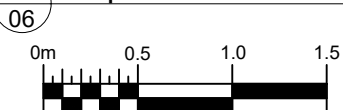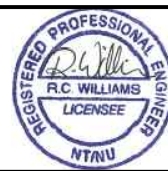[illegible]






DESIGN:	CH	DRAWN:	TH	REVIEWED:	RW
CHECKED:	RW	APPROVED:	JBK	DATE:	August 27, 2020
b FILE NAME: 1CT022.043 - Sump.dwg					



Hope Bay Project

SRK JOB NO.:	1CT022.043
--------------	------------

### LEGEND

-  Design Sump Location
-  Design 12oz. Non-Woven Geotextile
-  As-Built Non-Woven Geotextile
-  Design Bedding Material
-  As-Built Bedding Material

## NOTES

1. All units in meters unless otherwise specified.
2. TMAC confirmed the following:
  - 1.0m sump diameter
  - 1.55m sump length
  - 2 x 2" thick insulation sheets
  - 1.2m sump lid diameter
3. SRK was not present during construction of the sump. Compilation of the as-built drawings is reliant on the construction information as-built survey data provided from TMAC Resources Inc.

## REFERENCE

1. Survey provided by TMAC Resources Inc.,  
file name: SUMP AB-0513.csv.

### Madrid North Waste Rock Pile

DRAWING TITLE:

### Sump 2 As-built Details

DRAWING NO.

MN-WRP-12

SHEET

12 OF 13

REVISION NO.

AB2

