



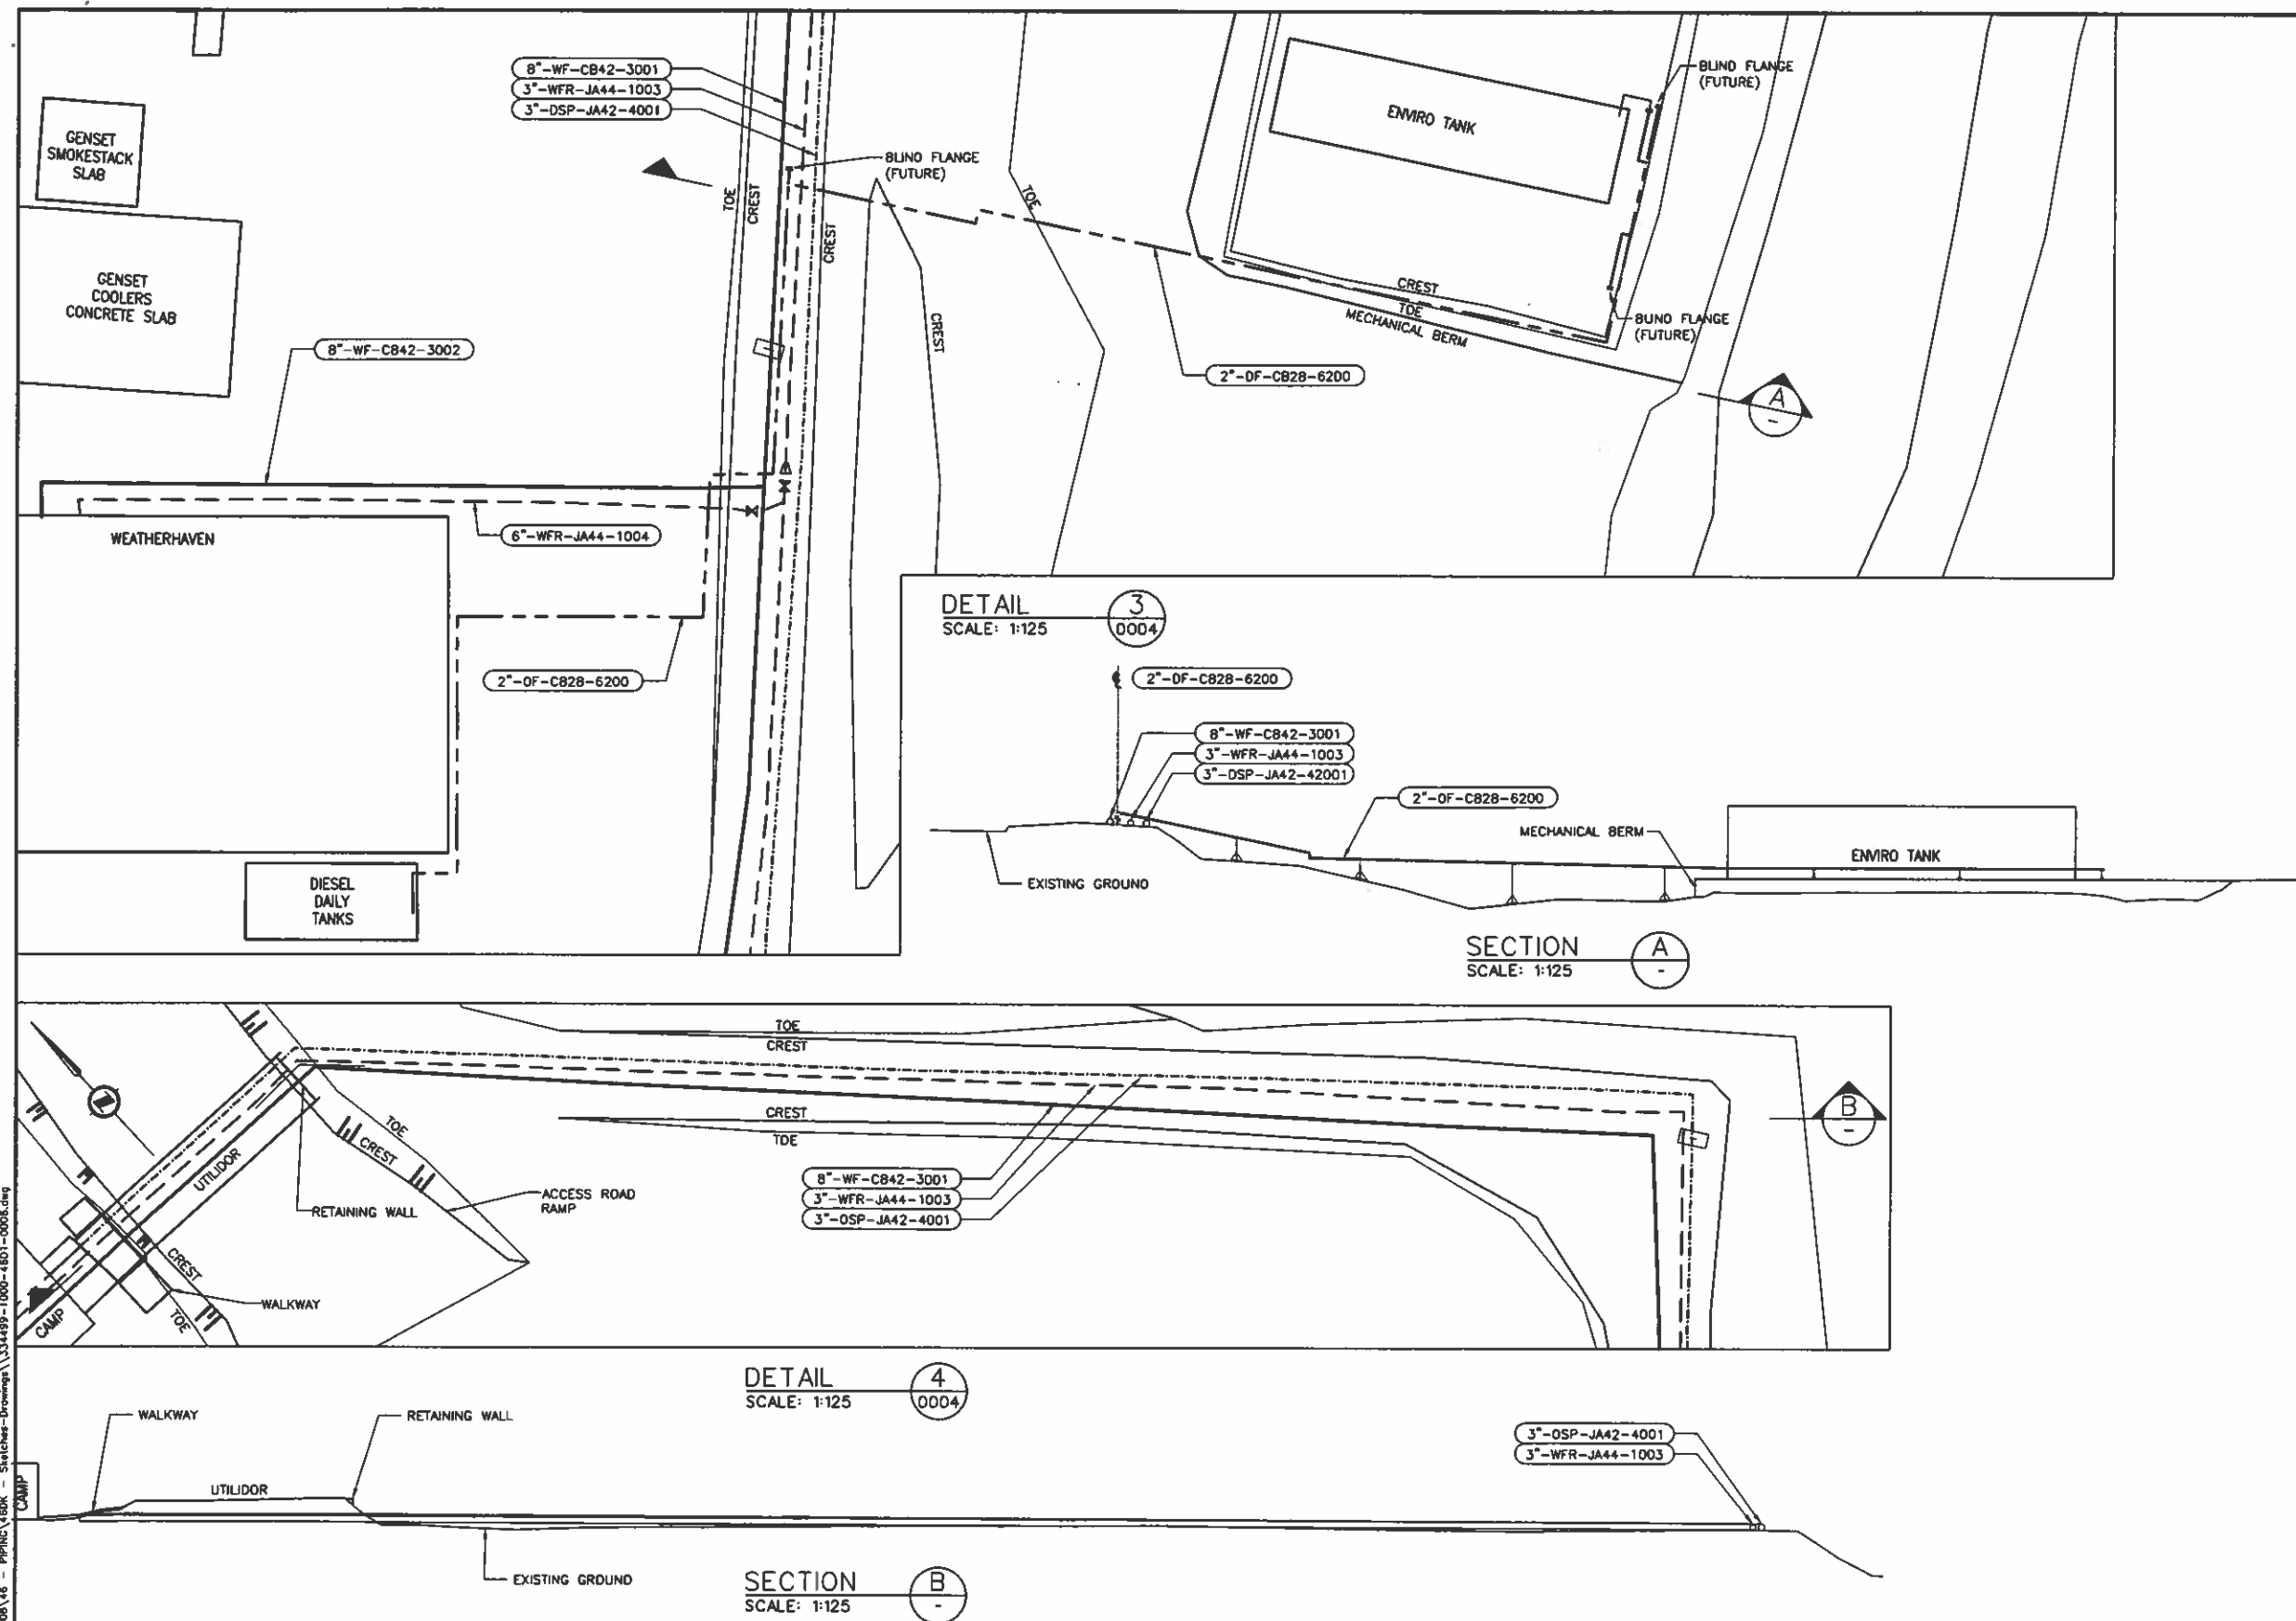

- NOTES:

AS-BUILT

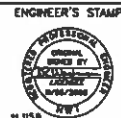

CLIENT	HOPE BAY MINING LTD.
--------	----------------------



THIS DRAWING IS THE PROPERTY OF
SNC-LAMALIN INC., AND THE USE AND COPYING
THEREOF IS SUBJECT TO THE TERMS OF THE
AGREEMENT UNDER WHICH IT WAS PREPARED.
THIS DRAWING MAY NOT BE COPIED EXCEPT AS
EXPRESSLY PROVIDED THEREIN.

PROFESSIONAL
ENGINEER

HDPE BAY MINING LIMITED
DORIS NORTH INFRASTRUCTURE PROJECT

SWC - LAVALIN INC.	DESIGNED	C.H. LEONOR	CHL	08/07/21
	DRAWN	C.H. LEONOR	CHL	08/07/21
	CHECKED	R. UMEMO	RU	08/07/22
	APPROVED LEAD ENG	R. UMEMO	RU	08/07/23
	APPROVED MGR	R. UMEMO	RU	08/07/25
	APPROVED AREA MGR	G. AKEHURST	GA	08/07/25
CLIENT	APPROVED ENG. COORD.			
	APPROVED AREA MGR			
AS SHOWN	NAME (PRINT)	INIT.	DATE	

[illegible]