



ROBERTS BAY DIESEL FUEL TANK

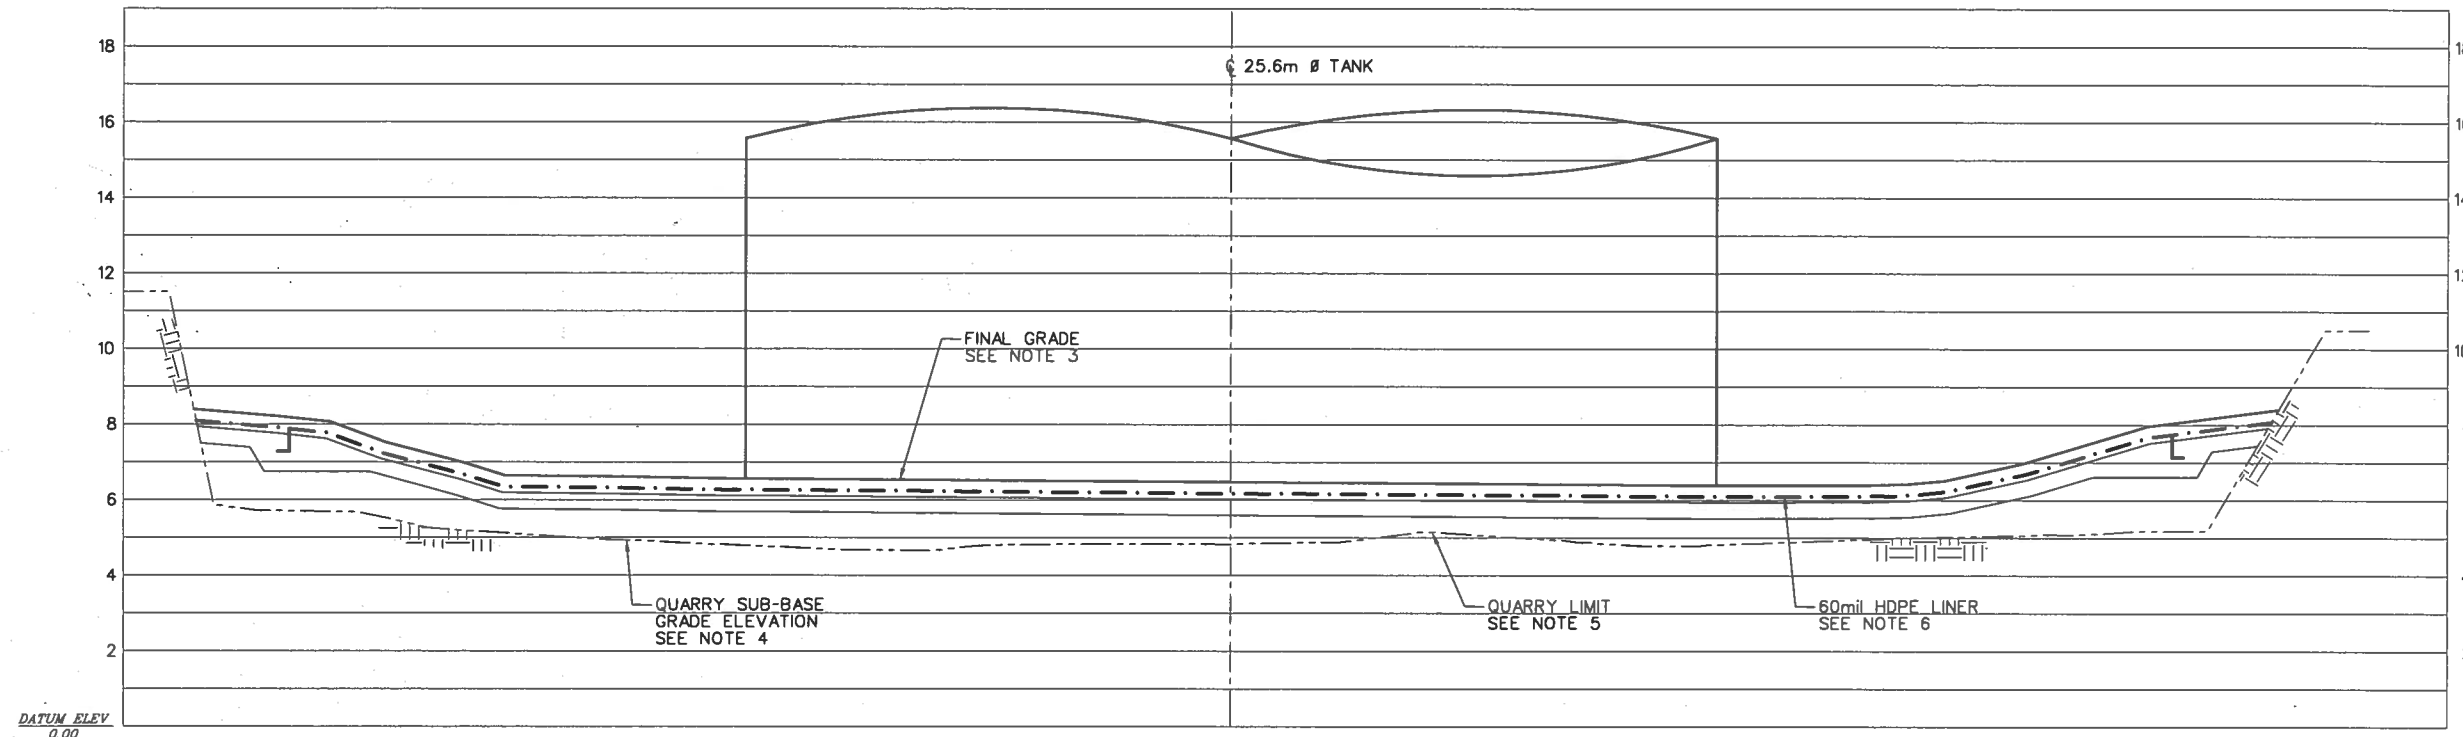

SECTION C
SCALE: 1:100 0003

AS-BUILT

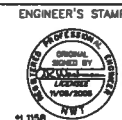

NEWMONT™
The Gold Company

CLIENT	HOPE BAY MINING LTD.
--------	----------------------

 **SNC-LAVALIN**

THIS DRAWING IS THE PROPERTY OF
SNC-LAMALIN INC., AND THE USE AND COPYING
THEREOF IS SUBJECT TO THE TERMS OF THE
AGREEMENT UNDER WHICH IT WAS PREPARED.
THIS DRAWING MAY NOT BE COPIED EXCEPT AS
EXPRESSLY PROVIDED THEREIN.

PROFESSIONAL
ENGINEER

NAME	NO.
------	-----

05	TITLE	HOPE BAY MINING LIMITED
05		DORIS 2008 PROJECT
11		ROBERTS BAY DIESEL FUEL TANK
		FINAL GRADING
		SECTION

PROJECT NO.	AREA	DISCPL.	DOC.	DRAWING NUMBER	LOC.	REVISION NUMBER
334499	1320	41	D1	0004		4

Format: Metric D (TRUE SCALE)

[illegible]