


DATE: 2009/02/12 - B3
PATH: \\334499 - HBA\2008\00 - As-Built\2009\334499-1320-4101-0010.dwg

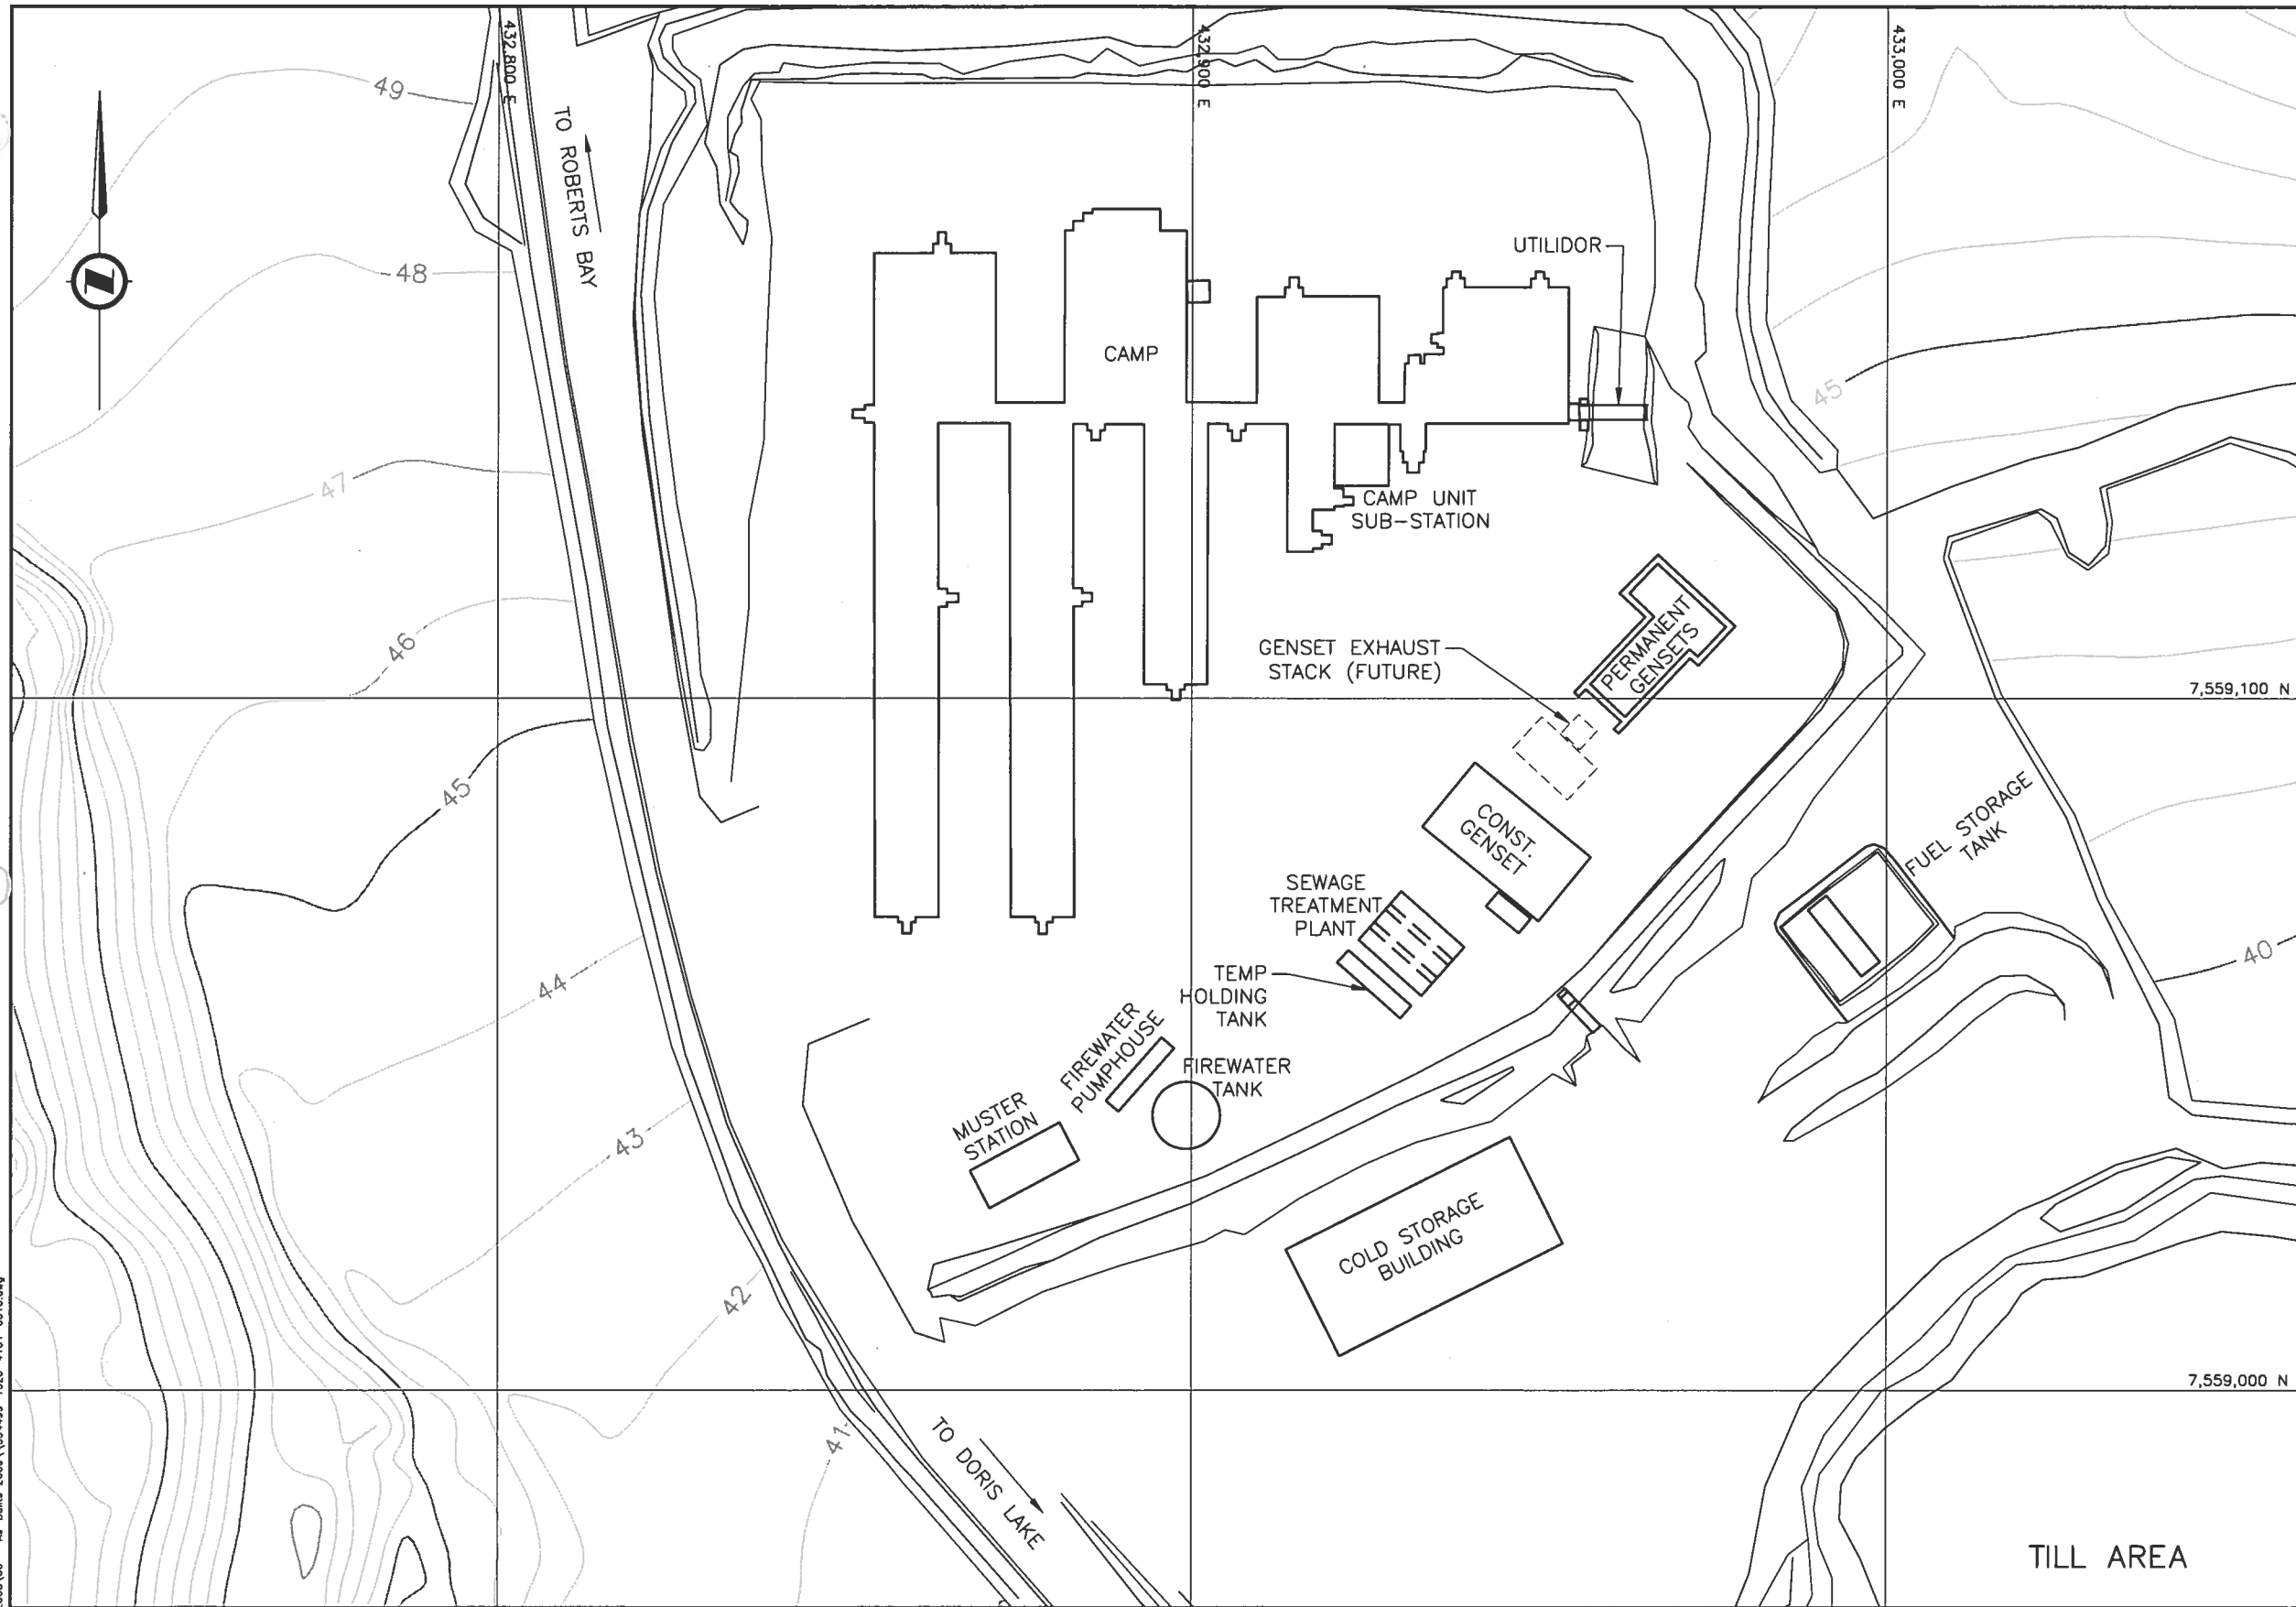


NOTES:

1. HORIZONTAL CONTROL IS UTM NAD 83 AND VERTICAL IS GEODETIC.
2. ALL DIMENSIONS AND ELEVATIONS ARE IN METRES UNLESS NOTED OTHERWISE.
3. AS-BUILT INFORMATION BASED OF SUB ARCTIC SURVEYS DATA RECEIVED OCTOBER 27, 2008.

AS-BUILT

0 1:500 25

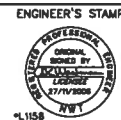

NEWMONT
The Gold Company

CLIENT HOPE BAY MINING LTD.		CLIENT DWG. NO.
SNC-LAVALIN		THIS DRAWING IS THE PROPERTY OF SNC-LAVALIN INC. AND THE USE AND COPYING THEREOF IS SUBJECT TO THE TERMS OF THE AGREEMENT UNDER WHICH IT WAS PREPARED. THIS DRAWING MAY NOT BE COPIED EXCEPT AS EXPRESSLY PROVIDED THEREIN.
PROFESSIONAL ENGINEER	NAME	NO.
TITLE		

HOPE BAY MINING LIMITED
DORIS NORTH INFRASTRUCTURE PROJECT

DORIS CAMP SITE LAYOUT
PLAN - SHEET 1

DWG. NO.	REFERENCES	NO.	DATE	REVISIONS	BY	CHK	LEAD	ENGR.	AREA	NO.	DATE	REVISIONS	BY	CHK	LEAD	ENGR.	AREA	NO.	DATE	REVISIONS	BY	CHK	LEAD	ENGR.	AREA	NO.	DATE	REVISIONS	BY	CHK	LEAD	ENGR.	AREA	NO.	DATE	REVISIONS
1320-4101-0011	DORIS CAMP SITE LAYOUT PLAN - SHEET 2										6	08/12/17	AS-BUILT																							

Format: Metric 0 (TRUE SCALE)