



X:\1CT022.002\_2015\_Hope Bay Ongoing Support\200\_Type\_A\_Water\_License\2000\_Tailings\_Management\_Plan\040\_AutoCAD\1CT022.002\_SC4\_staged.dwg

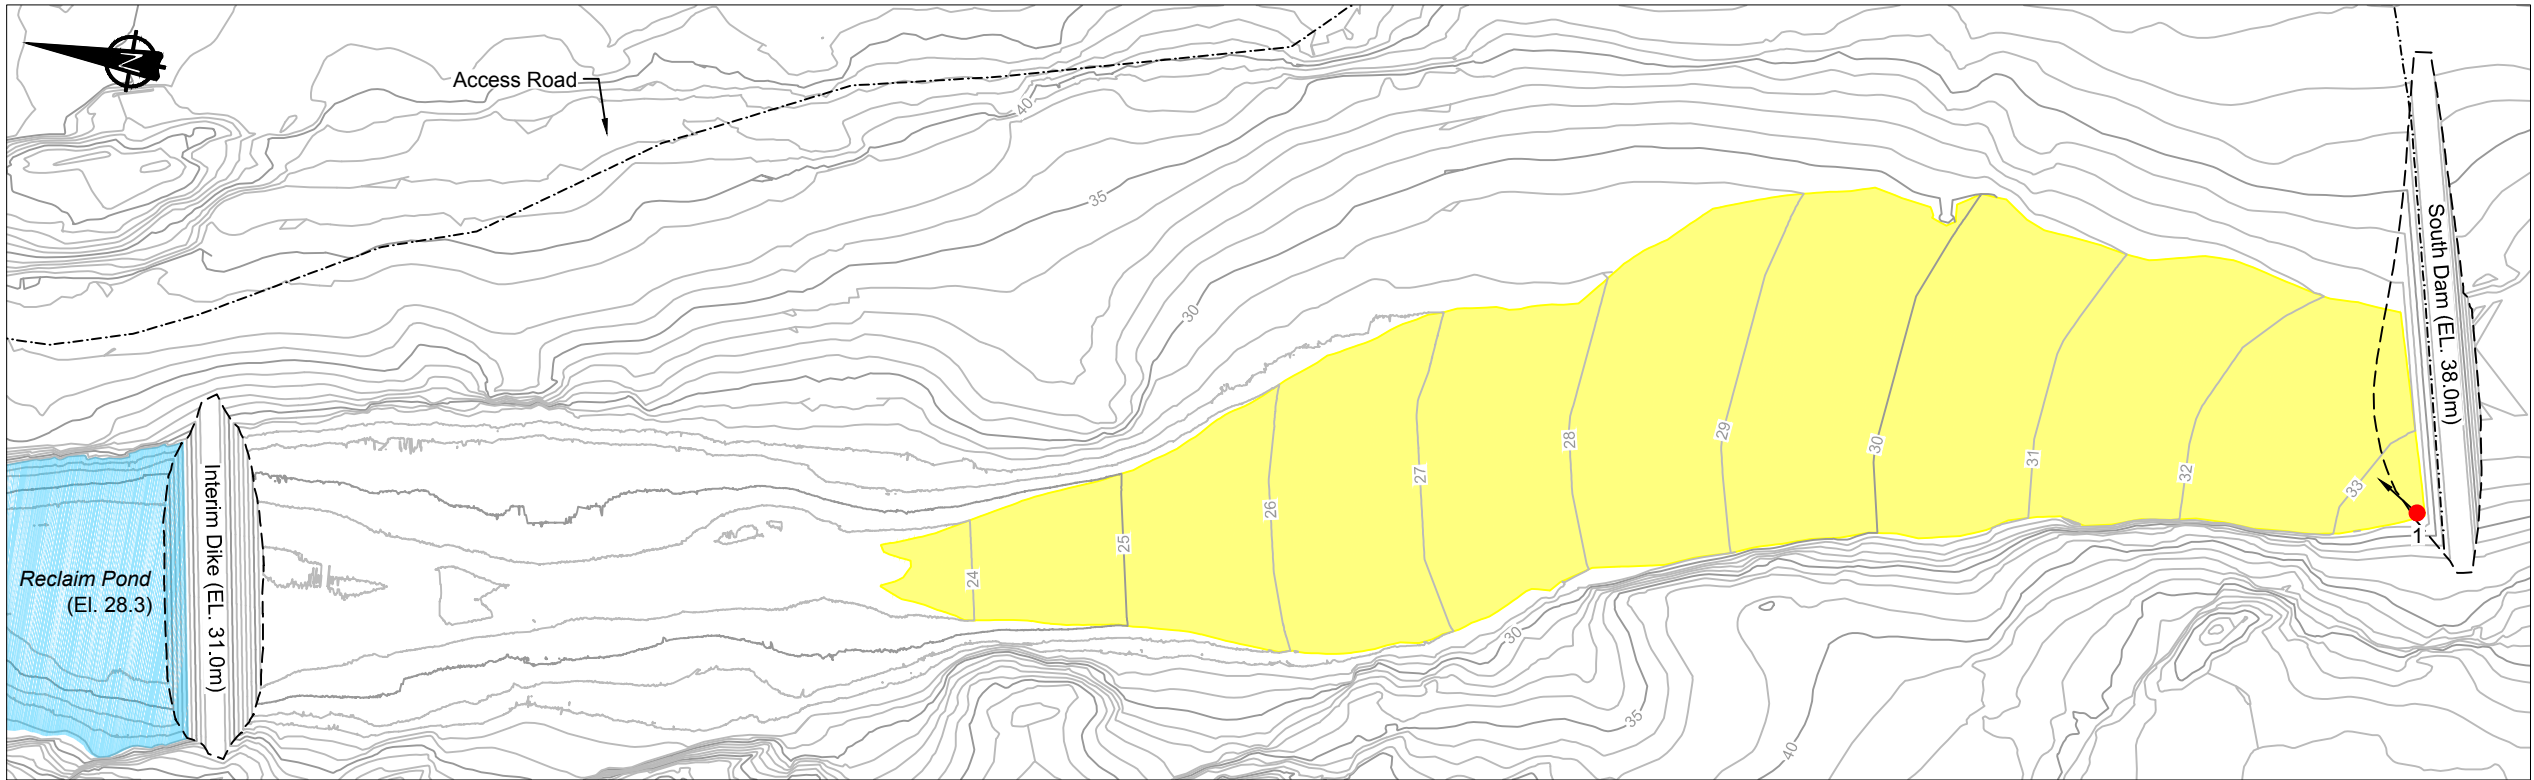

**TAILINGS DEPOSITION - YEAR 1**

Spigot Elev.: No.1: 33.5m  
Deposited Tailings: 0.34Mm³  
Duration: 1 Year  
Production Rate: 773.4m³/day (1,000tpd)  
Deposited Tailings Surface Area (cumulative): 0.17km²

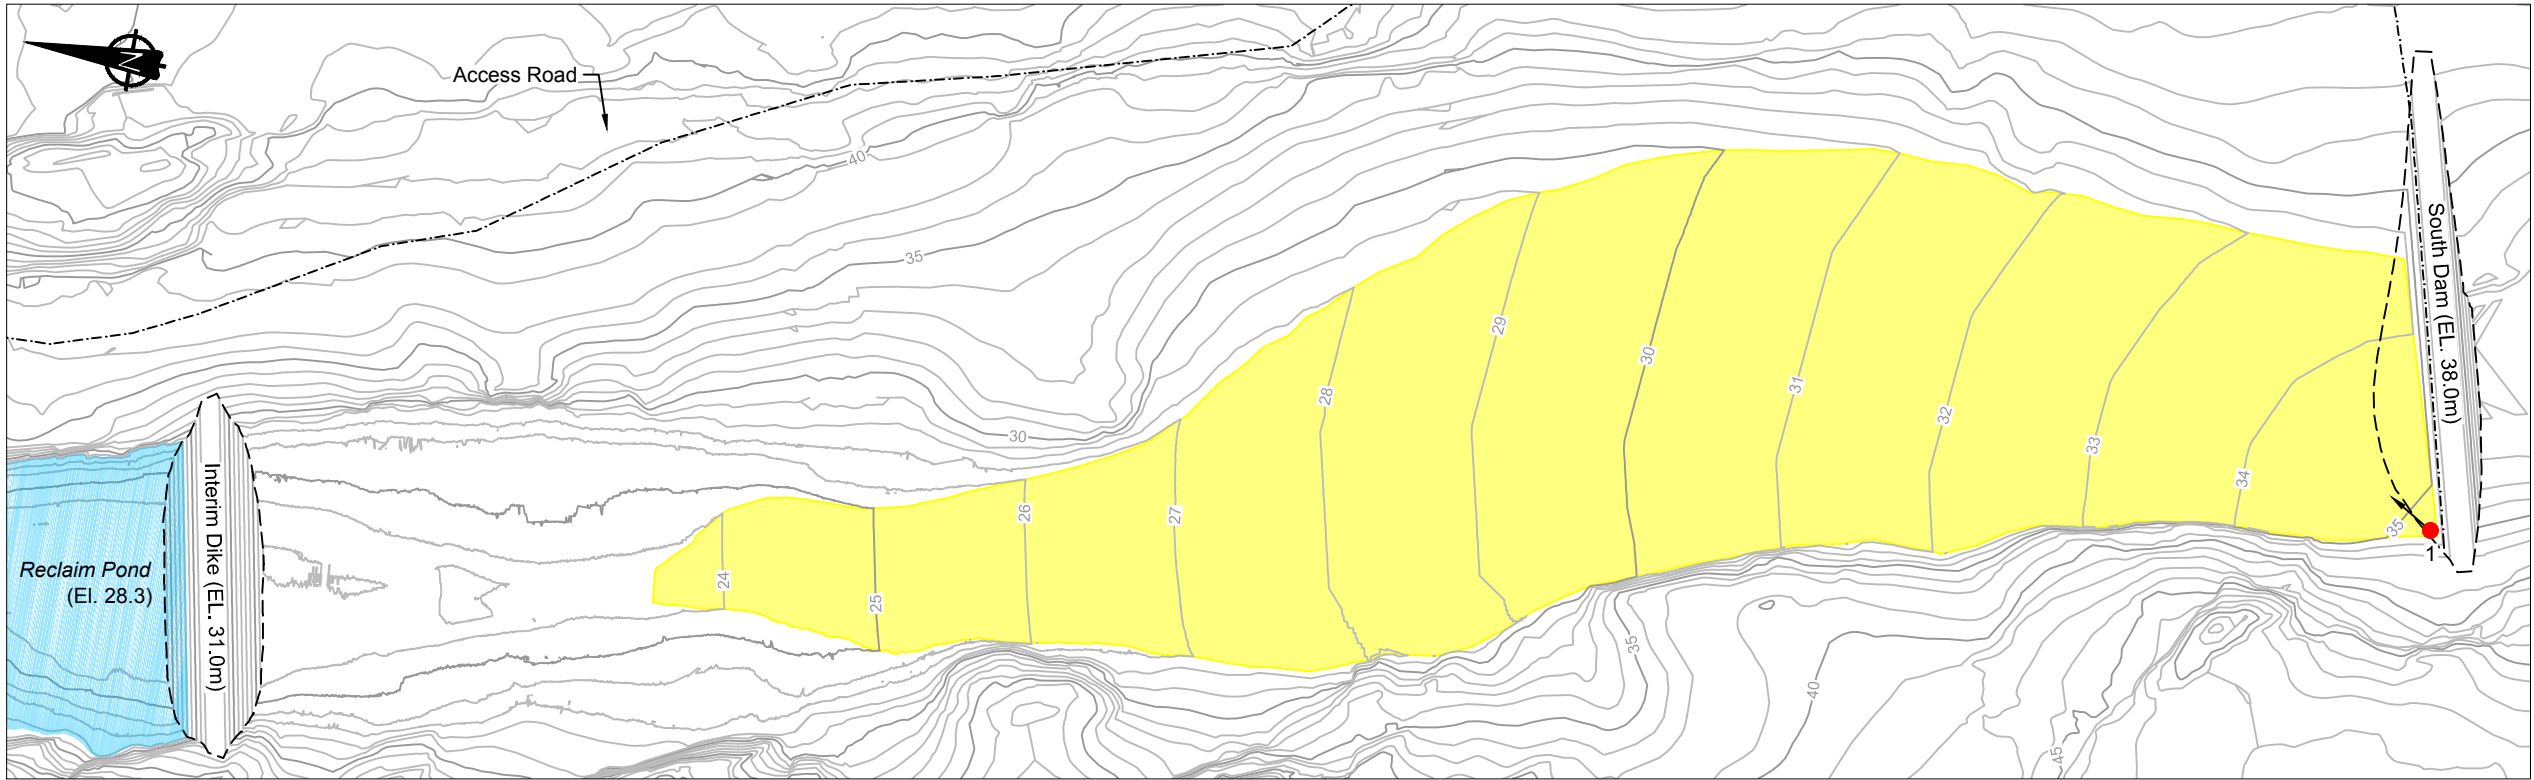

**TAILINGS DEPOSITION - YEAR 2**


Spigot Elev.: No.1: 35.25m  
Deposited Tailings (Cumulative): 0.68Mm³  
Duration: 1 Year  
Production Rate: 773.4m³/day (1,000tpd)  
Deposited Tailings Surface Area (cumulative): 0.23km²

**LEGEND**

- Spigot Location
- Major Contour (5m)
- Minor Contour (1m)
- Approximate Tailings Line
- Current Deposition
- Proposed Dam / Dike

**NOTES**

- Deposition durations are approximate and were based on an average production rate of 1,000tpd for years 1 and 2 and 2,000tpd for years 3 and 4.
- Assumed an average deposited tailings beach slope of 1.0%.
- A deposited tailings dry density of 1.29 t/m³ was used (based on laboratory testing).
- All tailings volumes presented include ice entrainment, which was assumed at 20% of production.
- Dam and dike elevations shown were assumed constant for throughout deposition.
- Total storage requirement is 2.32Mm³ (tailings 1.93Mm³ + ice entrainment 0.39Mm³).

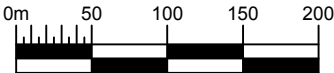

**srk consulting**

SRK JOB NO.: 1CT022.002  
FILE NAME: 1CT022.002 - SC4 -staged.dwg

**TMAC**  
RESOURCES


HOPE BAY PROJECT

DORIS NORTH TIA OMS MANUAL

**TAILINGS DEPOSITION PLAN**  
(YEARS 1 & 2)


DATE: May 2016  
APPROVED: EK/SA  
FIGURE: 8

X:\1CT022.002\_2015\_Hope Bay Ongoing Support\200\_Type\_A\_Water\_License\2000\_Tailings\_Management\_Plan\040\_AutoCAD\1CT022.002\_SC4\_staged.dwg

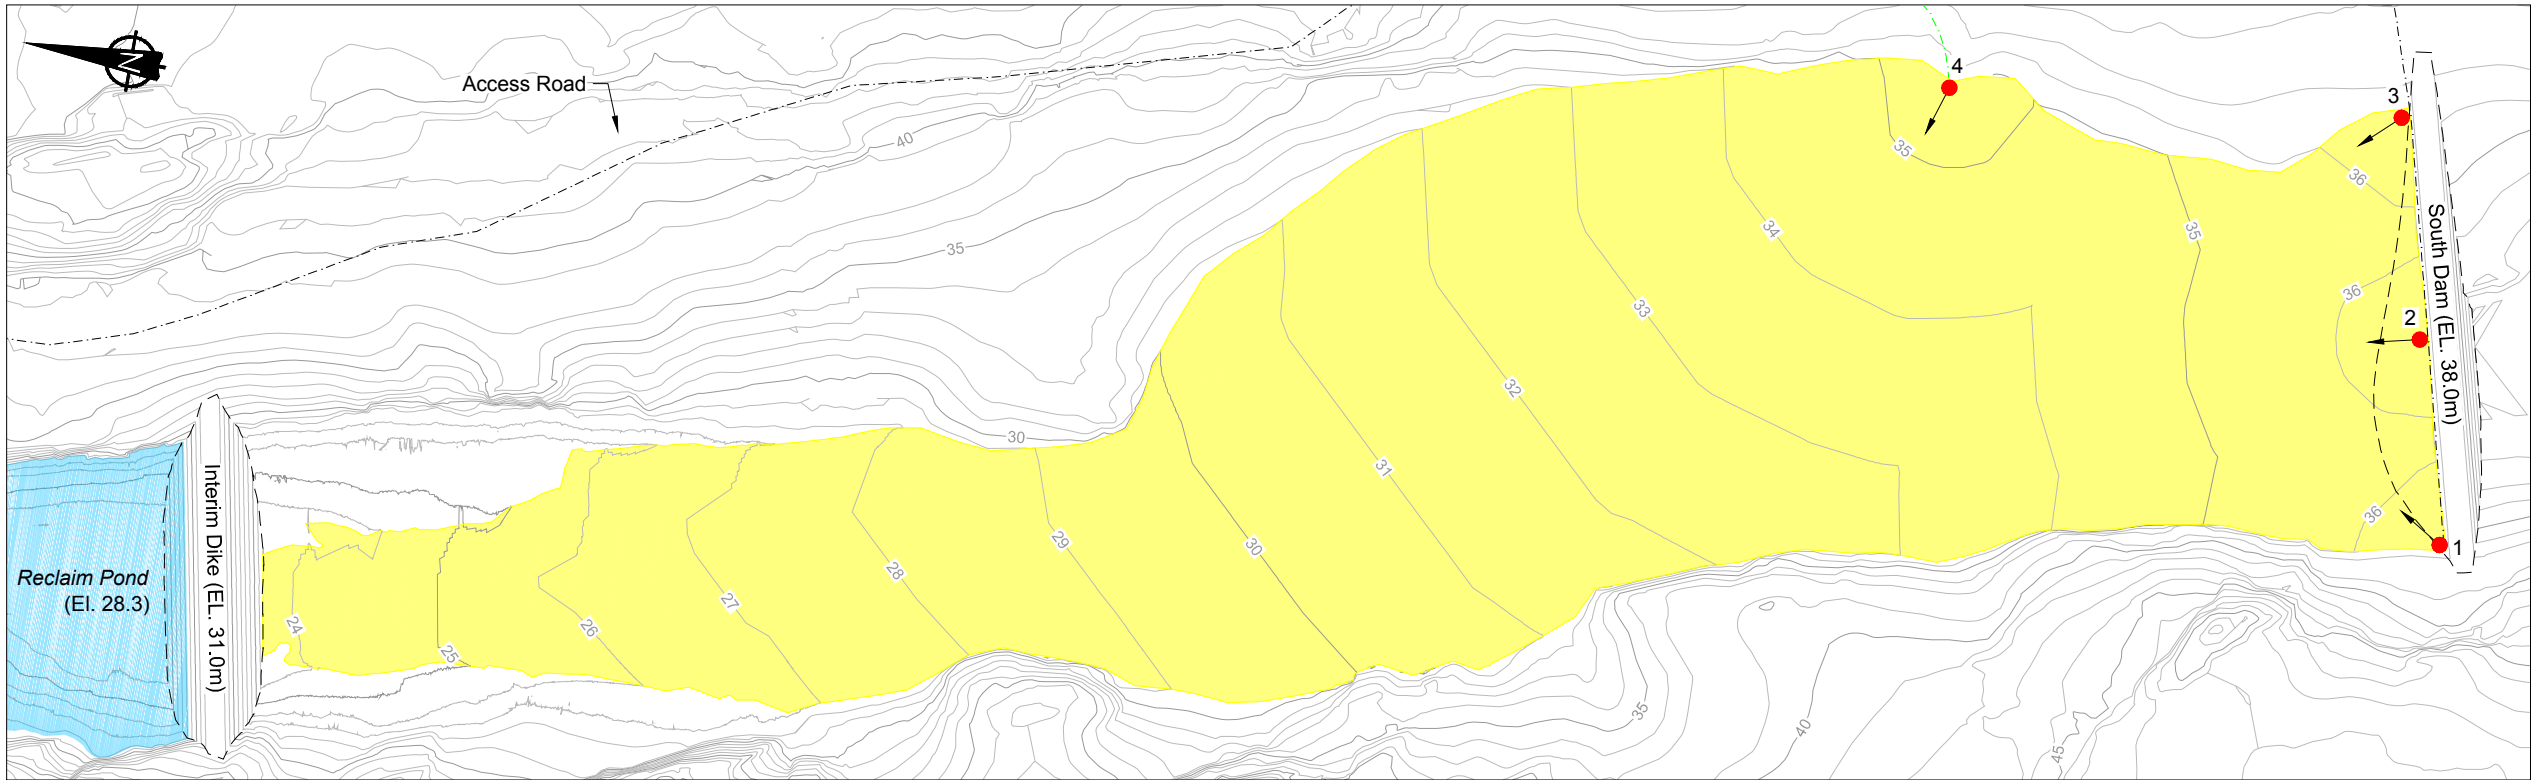

**TAILINGS DEPOSITION - YEAR 3**

Spigot Elev.: No.'s 1 to 3: 36.5m  
No. 4: 35.5m  
Production rate: 1,546.8m<sup>3</sup>/day (2,000tpd)  
Deposited Tailings (Cumulative): 1.35Mm<sup>3</sup>  
Duration: 1 Year  
Deposited Tailings Surface Area (cumulative): 0.34km<sup>2</sup>

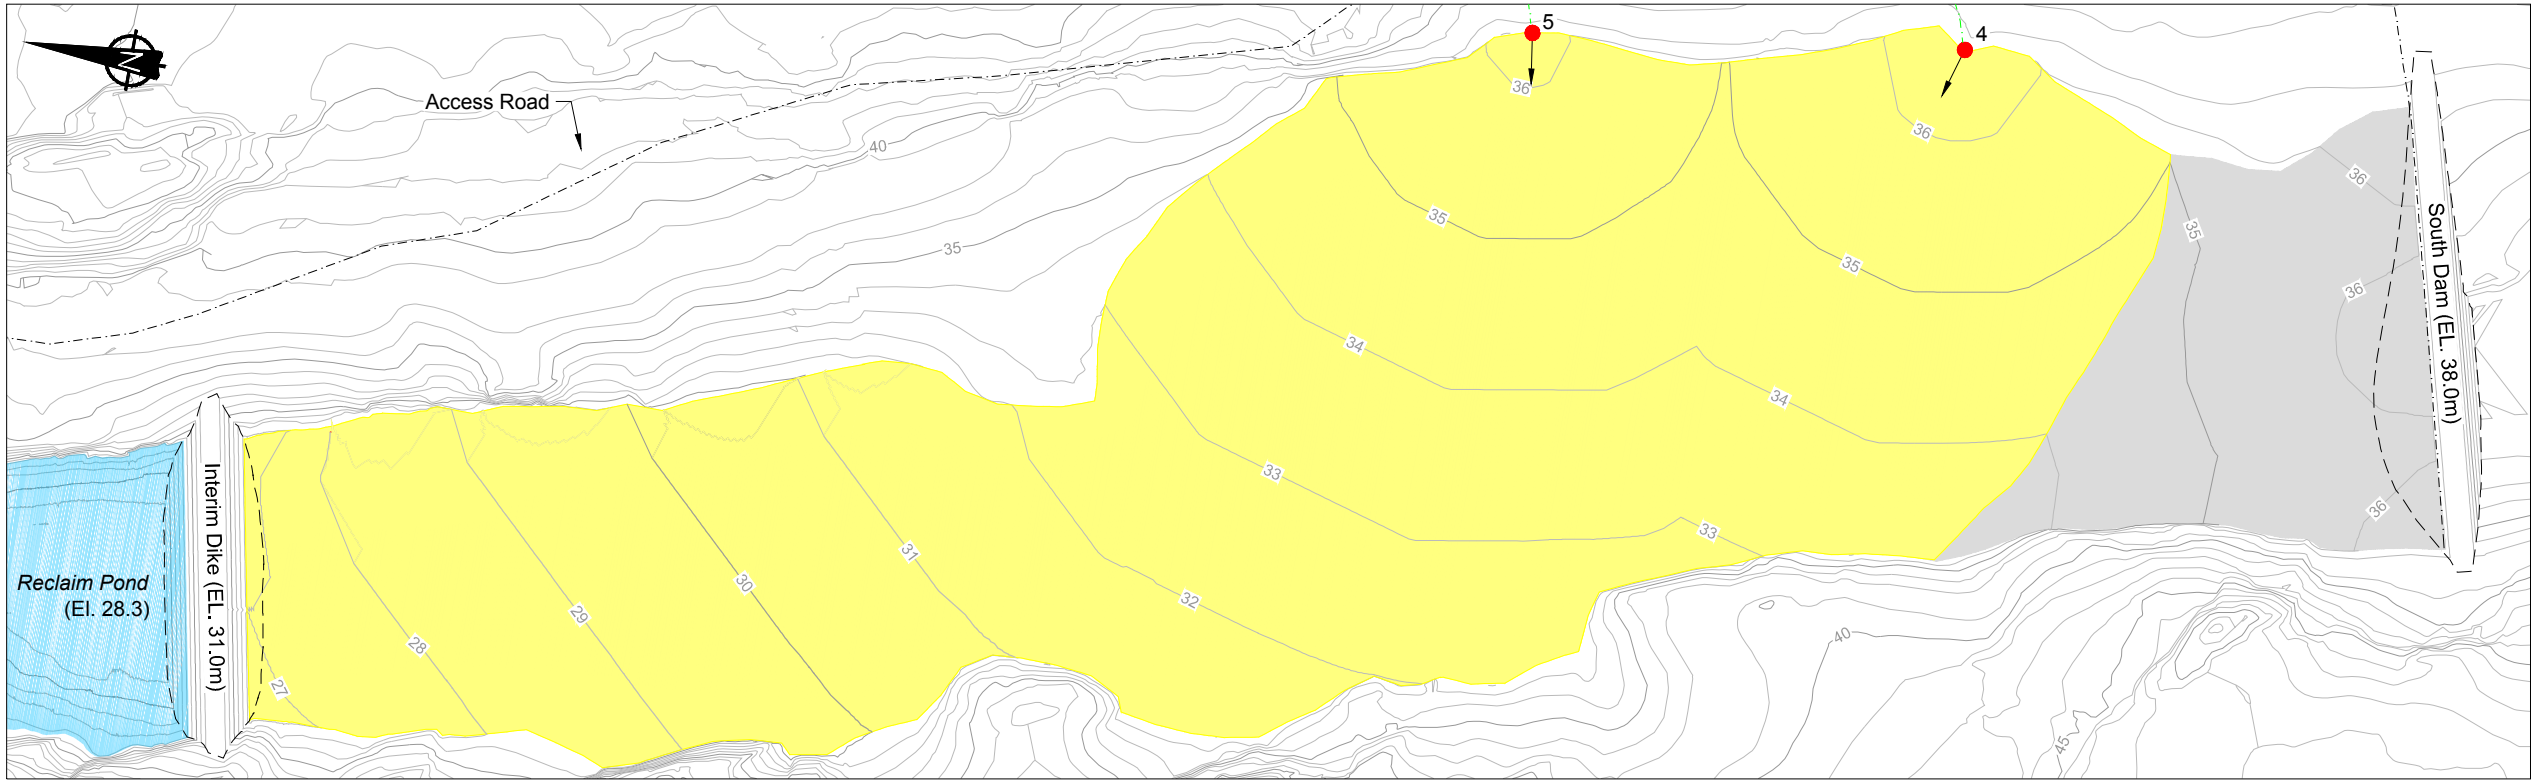

**TAILINGS DEPOSITION - YEAR 4**


Spigot Elev.: No. 4: 36.5m  
No. 5: 36.25m  
Production Rate: 1,546.8m<sup>3</sup>/day (2,000tpd)  
Deposited Tailings (Cumulative): 2.03Mm<sup>3</sup>  
Duration: 1 Year  
Deposited Tailings Surface Area (cumulative): 0.36km<sup>2</sup>  
Previous Tailings Surface Area: 0.06km<sup>2</sup>

**LEGEND**

- Spigot Location
- Major Contour (5m)
- Minor Contour (1m)
- Approximate Tailings Line
- Active Deposition
- Previous Deposition
- Proposed Dam / Dike

**NOTES**

- Deposition durations are approximate and were based on an average production rate of 1,000tpd for years 1 and 2 and 2,000tpd for years 3 and 4.
- Assumed an average deposited tailings beach slope of 1.0%.
- A deposited tailings dry density of 1.29 t/m<sup>3</sup> was used (based on laboratory testing).
- All tailings volumes presented include ice entrainment, which was assumed at 20% of production.
- Dam and dike elevations shown were assumed constant for throughout deposition.
- Total storage requirement is 2.32Mm<sup>3</sup> (tailings 1.93Mm<sup>3</sup> + ice entrainment 0.39Mm<sup>3</sup>).

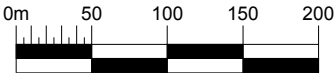

SRK JOB NO.: 1CT022.002  
FILE NAME: 1CT022.002 - SC4 -staged.dwg




HOPE BAY PROJECT

DORIS NORTH TIA OMS MANUAL

**TAILINGS DEPOSITION PLAN  
(YEARS 3 & 4)**

DATE: May 2016  
APPROVED: EK/SA  
FIGURE: 9



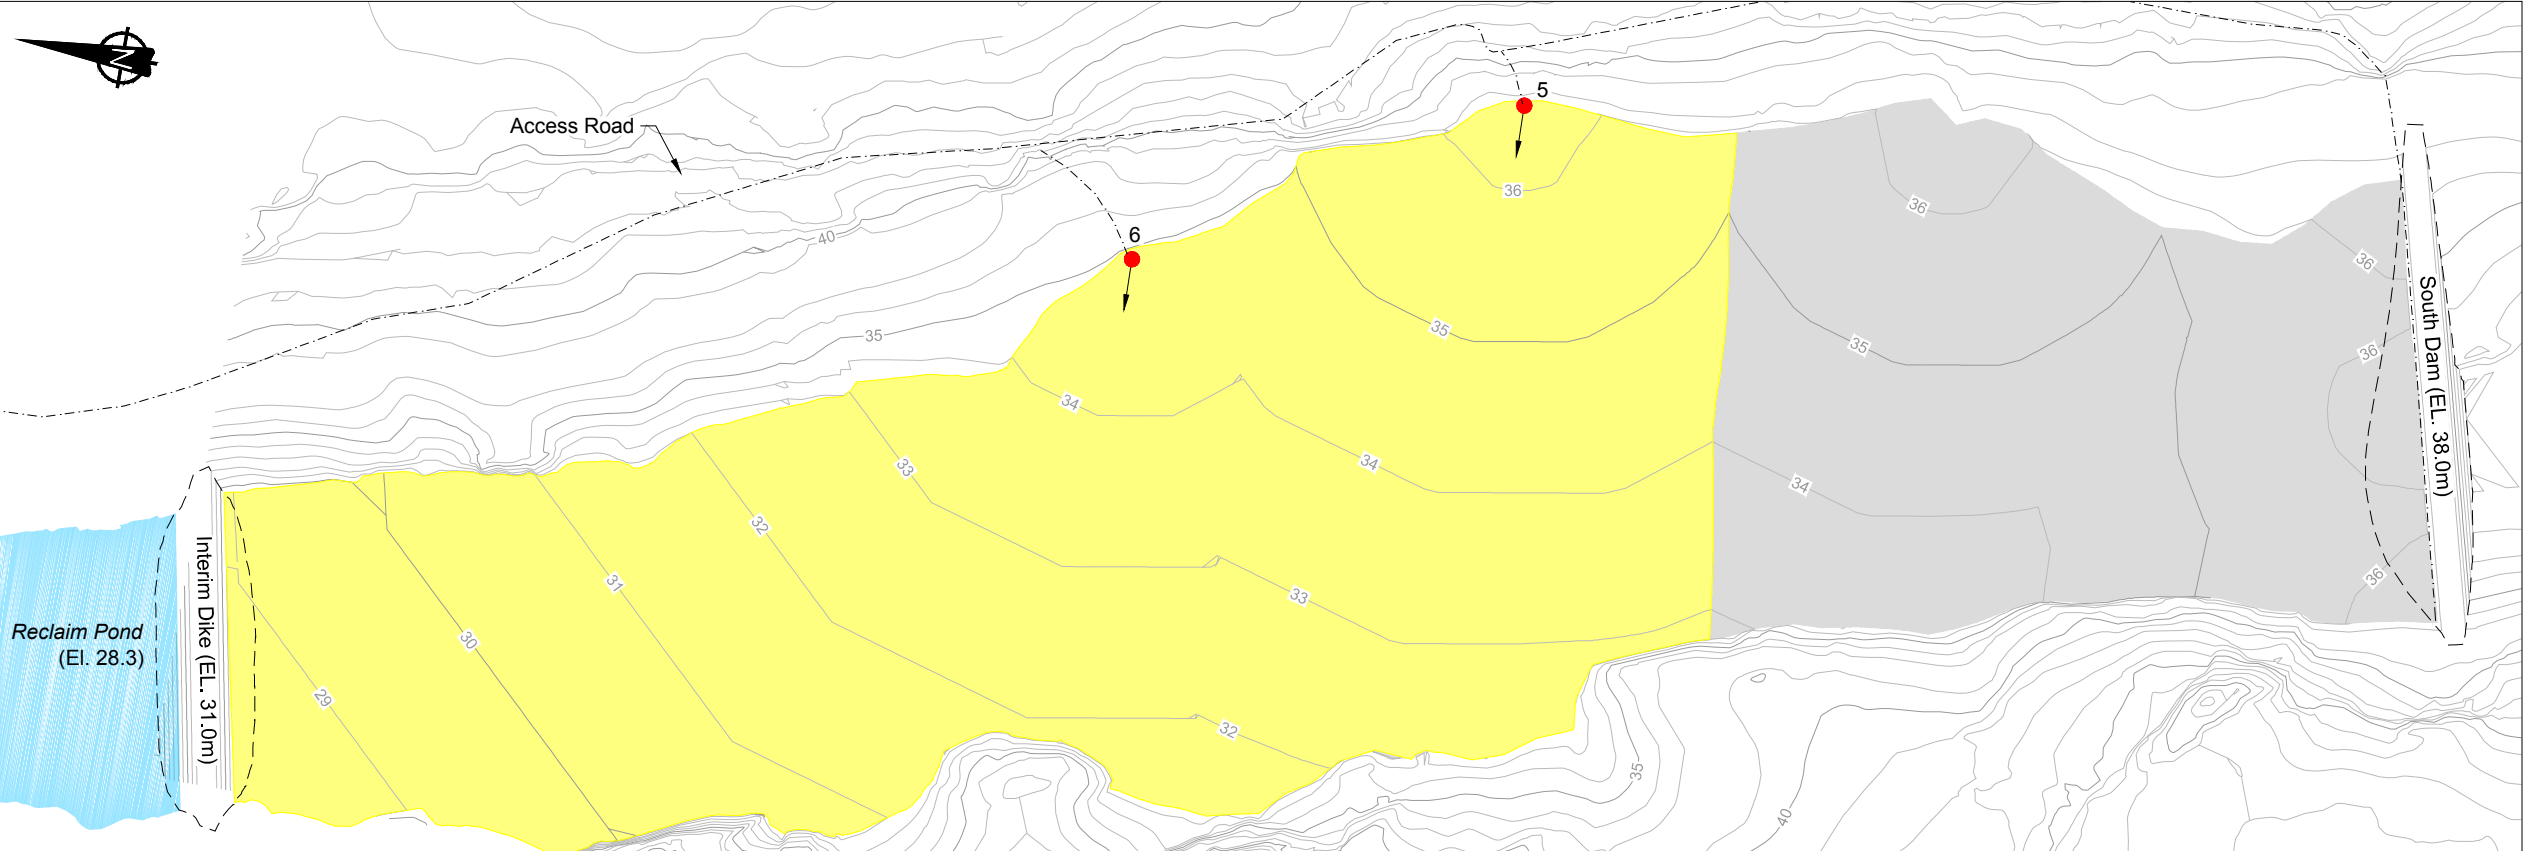

**TAILINGS DEPOSITION - END OF MINE (YEAR 4, MONTH 5)**

Spigot Elev.: No. 5: 36.5m  
No. 6: 35.0m  
Deposited Tailings (Cumulative): 2.32Mm³  
Duration: 5 Months

Production Rate: 1,546.8m³/day (2,000tpd)  
Deposited Tailings Surface Area (cumulative): 0.30km²  
Previous Tailings Surface Area (cumulative): 0.14km²

LEGEND

Spigot Location

Major Contour (5m)

Minor Contour (1m)

Approximate Tailings Line

Active Deposition

Previous Deposition

Proposed Dam / Dike

- NOTES
1. Deposition durations are approximate and were based on an average production rate of 1,000tpd for years 1 and 2 and 2,000tpd for years 3 and 4.


2. Assumed an average deposited tailings beach slope of 1.0%.

3. A deposited tailings dry density of 1.29 t/m³ was used (based on laboratory testing).

4. All tailings volumes presented include ice entrainment, which was assumed at 20% of production.

5. Dam and dike elevations shown were assumed constant for throughout deposition.

6. Total storage requirement is 2.32Mm³ (tailings 1.93Mm³ + ice entrainment 0.39Mm³).

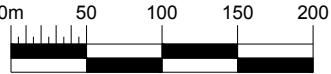

DORIS NORTH TIA OMS MANUAL

**TAILINGS DEPOSITION PLAN  
(COMPLETE AT YEAR 4 + 5 MONTHS)**


SRK JOB NO.: 1CT022.002  
FILE NAME: 1CT022.002 - SC4 -staged.dwg


HOPE BAY PROJECT


DATE:  
May 2016

APPROVED:  
EK/SA

FIGURE:  
10

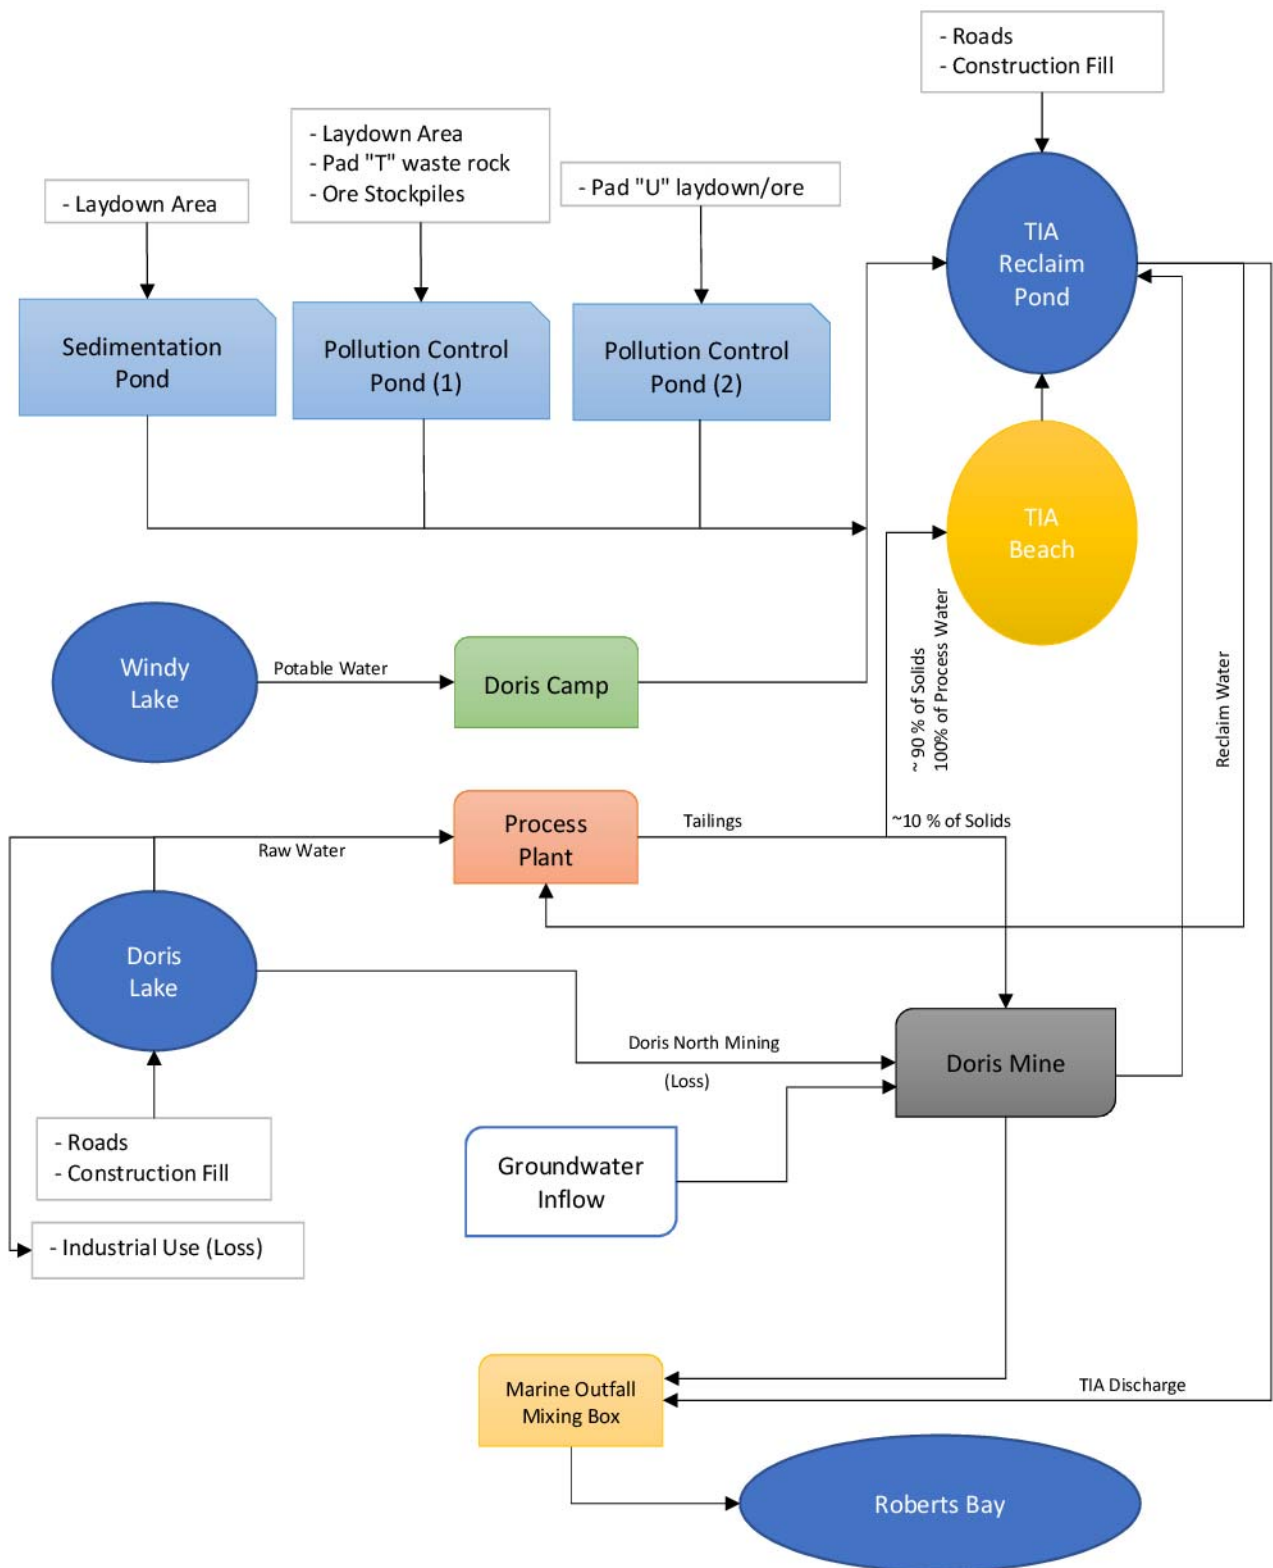

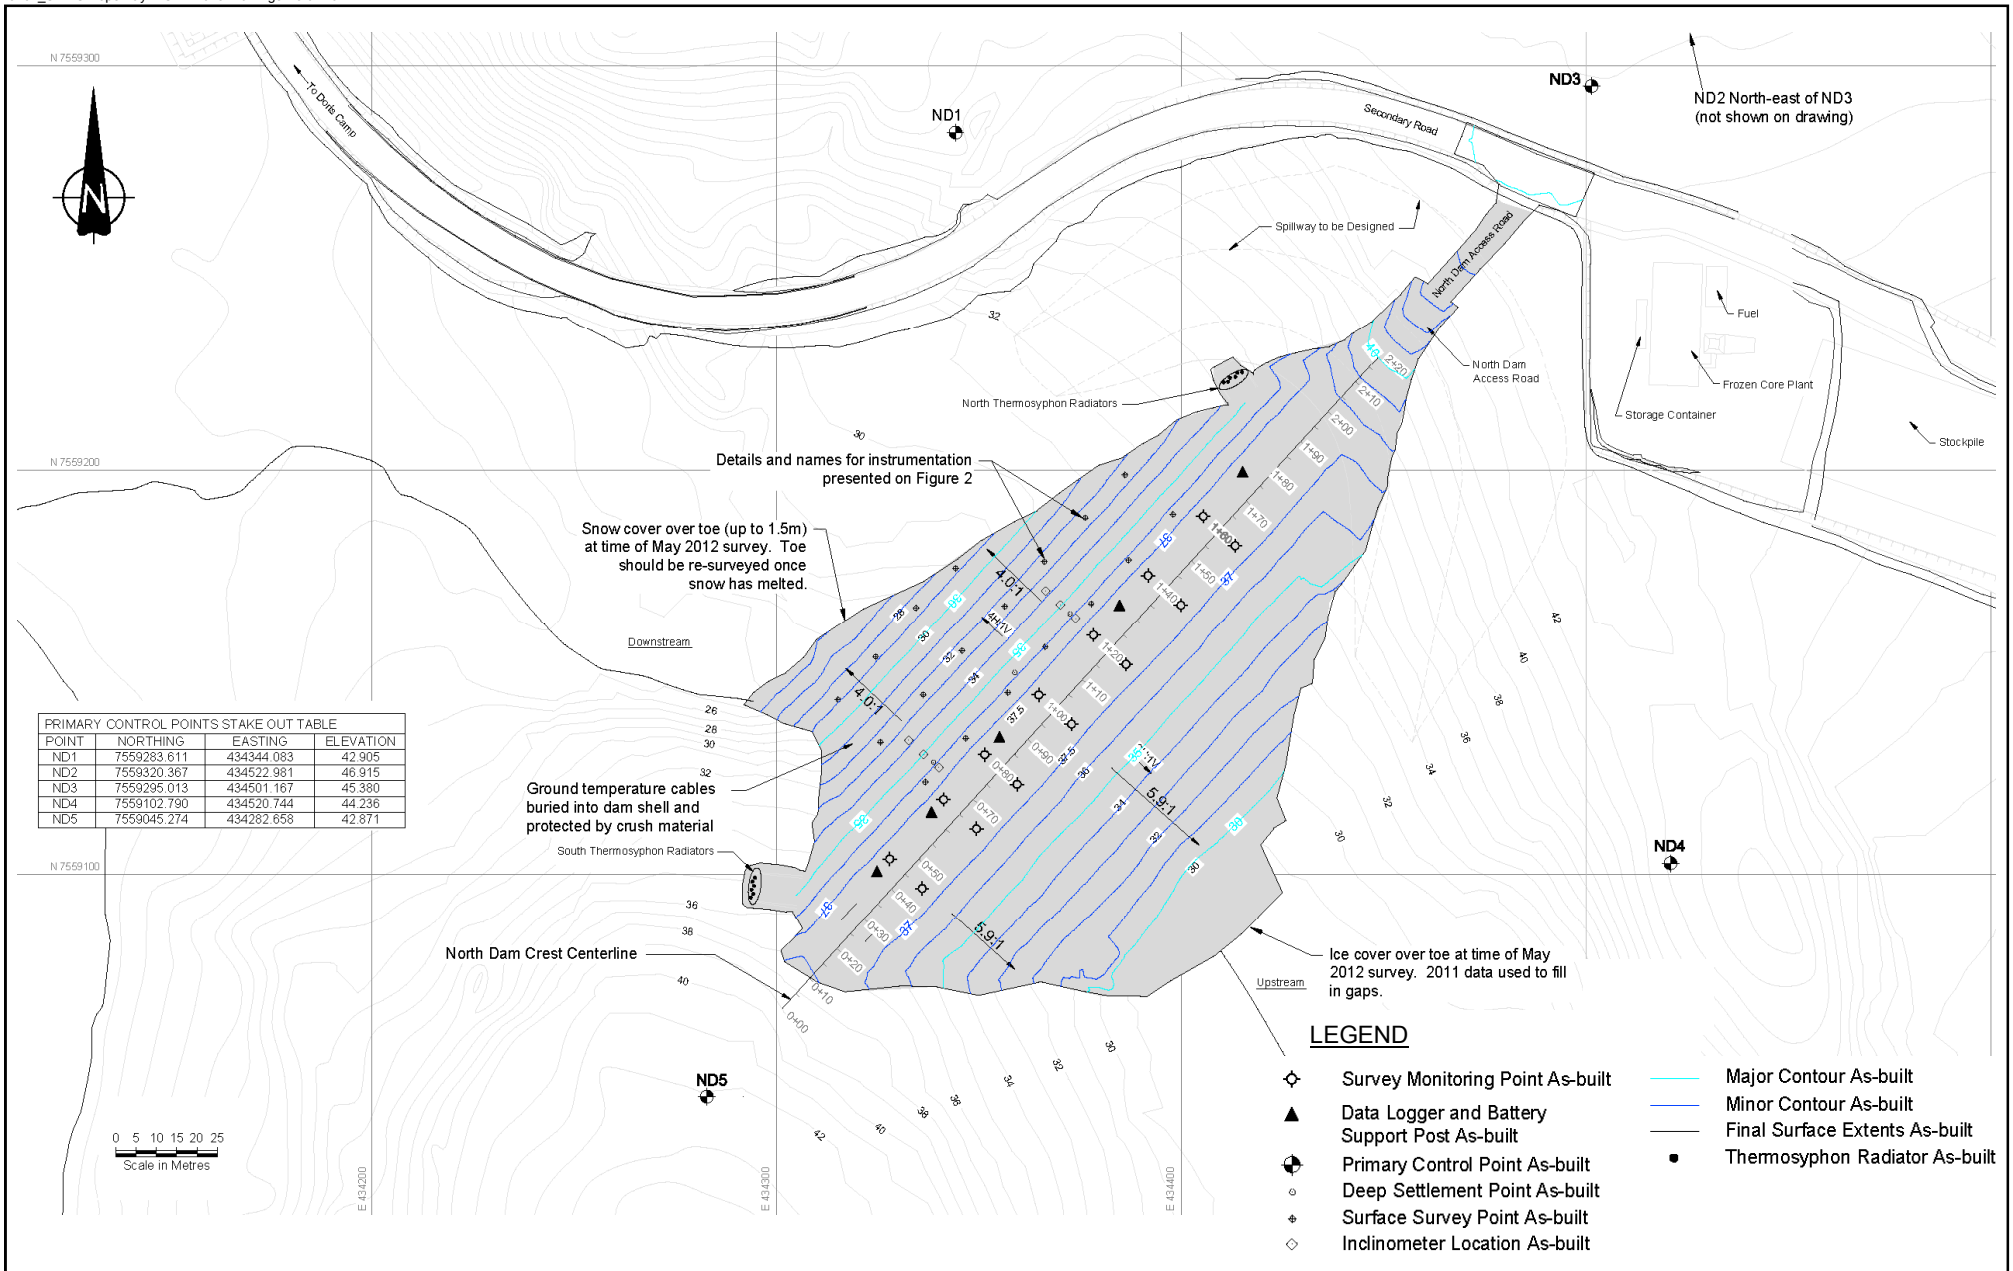

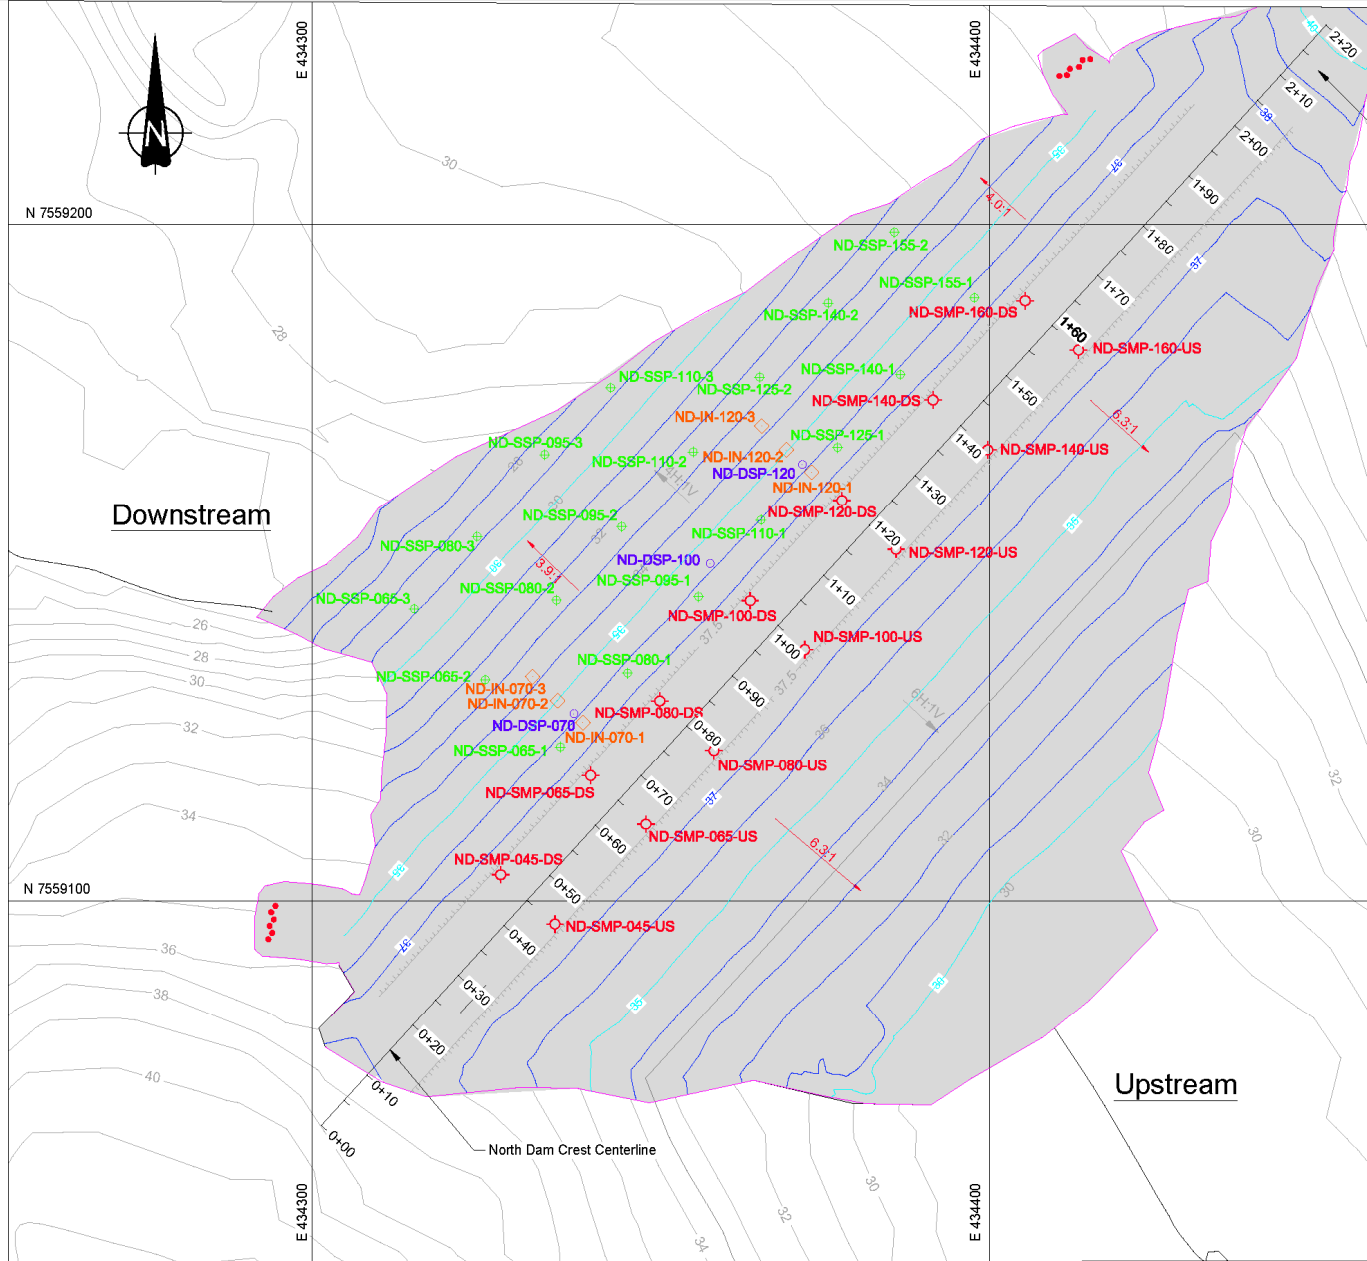

## LEGEND

- Survey Monitoring Point As-built
- Deep Settlement Point As-built
- Surface Survey Point As-built
- Inclinometer Location As-built
- Major Contour As-built
- Minor Contour As-built
- Final Surface Extents As-built
- Thermosyphon Radiator As-built

AS-BUILT DEEP SETTLEMENT POINTS  
STAKEOUT TABLE

ID	Northing	Easting	Elev. (m)
ND-DSP-070	7559127.69	434338.65	36.95
ND-DSP-100	7559149.78	434358.75	36.86
ND-DSP-120	7559164.46	434372.37	36.92

AS-BUILT INCLINOMETER LOCATION  
STAKEOUT TABLE

ID	Northing	Easting	Elev. (m)
ND-IN-070-1	7559126.41	434340.00	37.44
ND-IN-070-2	7559129.63	434336.27	36.20
ND-IN-070-3	7559133.13	434332.57	34.85
ND-IN-120-1	7559163.31	434373.78	37.44
ND-IN-120-2	7559166.64	434370.03	36.05
ND-IN-120-3	7559170.15	434366.40	34.95

AS-BUILT SURFICIAL SURVEY POINTS  
STAKEOUT TABLE

ID	Northing	Easting	Elev. (m)
ND-SSP-065-1	7559122.80	434336.67	36.77
ND-SSP-065-2	7559132.67	434325.55	32.81
ND-SSP-065-3	7559143.10	434315.11	29.43
ND-SSP-080-1	7559133.85	434346.59	36.79
ND-SSP-080-2	7559144.37	434336.10	32.92
ND-SSP-080-3	7559153.75	434324.36	29.33
ND-SSP-095-1	7559144.90	434357.04	36.58
ND-SSP-095-2	7559155.21	434345.72	32.85
ND-SSP-095-3	7559165.92	434334.35	28.70
ND-SSP-110-1	7559156.20	434366.29	36.32
ND-SSP-110-2	7559166.31	434356.29	32.88
ND-SSP-110-3	7559175.79	434344.10	28.97
ND-SSP-125-1	7559166.97	434377.61	36.77
ND-SSP-125-2	7559177.37	434366.08	32.91
ND-SSP-140-1	7559177.75	434386.85	36.48
ND-SSP-140-2	7559188.28	434376.19	32.84
ND-SSP-155-1	7559189.07	434397.79	36.80
ND-SSP-155-2	7559198.85	434385.98	32.91

AS-BUILT SURVEY MONITORING POINTS  
STAKEOUT TABLE

ID	Northing	Easting	Elev. (m)
ND-SMP-065-US	7559118.52	434341.14	38.46
ND-SMP-065-US	7559111.31	434349.30	38.36
ND-SMP-080-US	7559129.57	434351.35	38.41
ND-SMP-080-US	7559122.27	434359.34	38.40
ND-SMP-100-US	7559144.32	434364.71	38.39
ND-SMP-100-US	7559137.12	434372.77	38.46
ND-SMP-120-US	7559159.12	434378.24	38.41
ND-SMP-120-US	7559151.88	434386.24	38.46
ND-SMP-140-US	7559173.98	434391.69	38.39
ND-SMP-140-US	7559166.62	434399.77	38.42
ND-SMP-160-US	7559188.64	434405.30	38.40
ND-SMP-160-US	7559181.37	434413.18	38.43




Job No: 1CT022.002.200 Task 2000  
 Filename: HopeBay\_DorisNorthTIA\_OMS\_Manual\_SA.pptx

HOPE BAY PROJECT

DORIS TIA OMS MANUAL

### North Dam Instrumentation Layout

Date: May 2016	Approved: EK/SA	Figure: <b>13</b>
-------------------	--------------------	----------------------

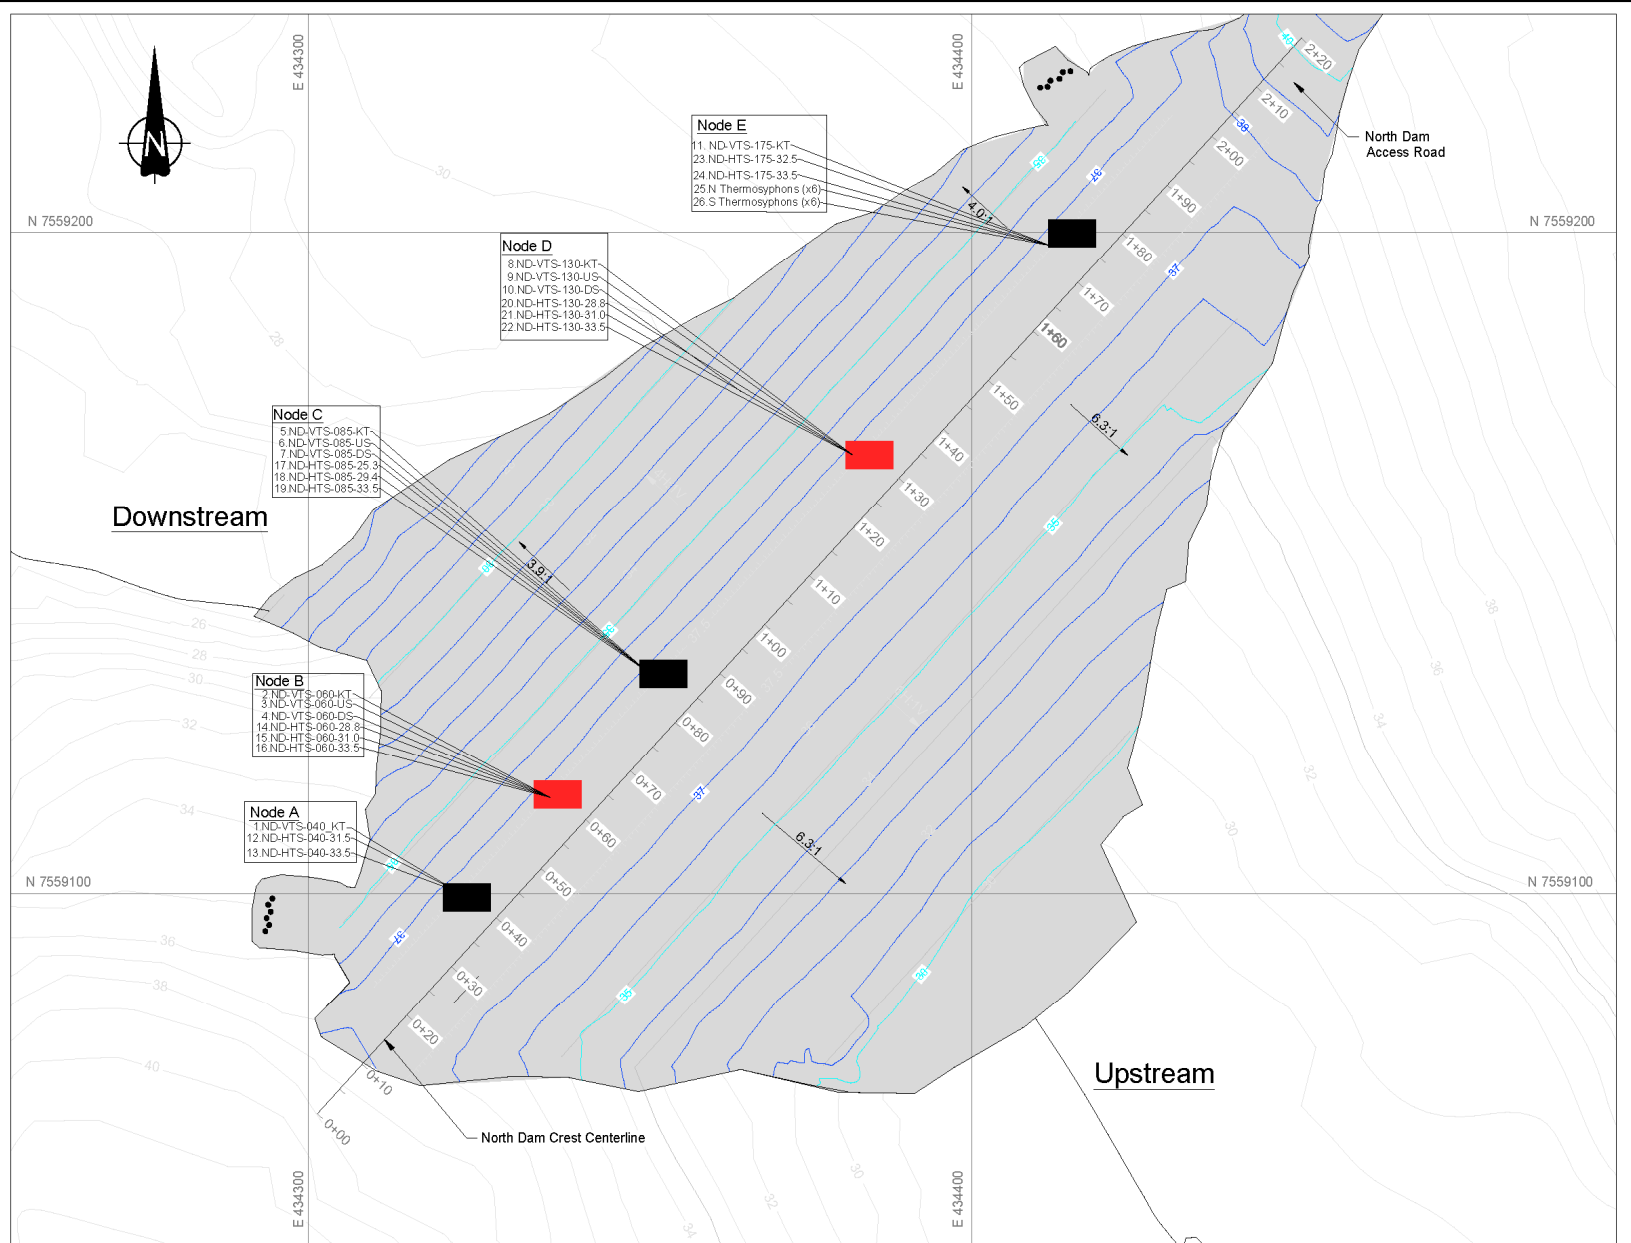**LEGEND**

- Major Contour As-built (5m)
- Major Contour As-built (1m)
- Final Surface Extents As-built
- Thermosyphon Radiator As-Built

*Note:* the two weatherproof enclosures which house the data loggers are shown in red.



Job No: 1CT022.002.200 Task 2000  
 Filename: HopeBay\_DorisNorthTIA\_OMS\_Manual\_SA.pptx




HOPE BAY PROJECT

DORIS TIA OMS MANUAL

**North Dam Ground and  
Thermosyphon Temperature  
Cable Locations**

Date: May 2016	Approved: EK/SA	Figure: <b>14</b>
-------------------	--------------------	----------------------



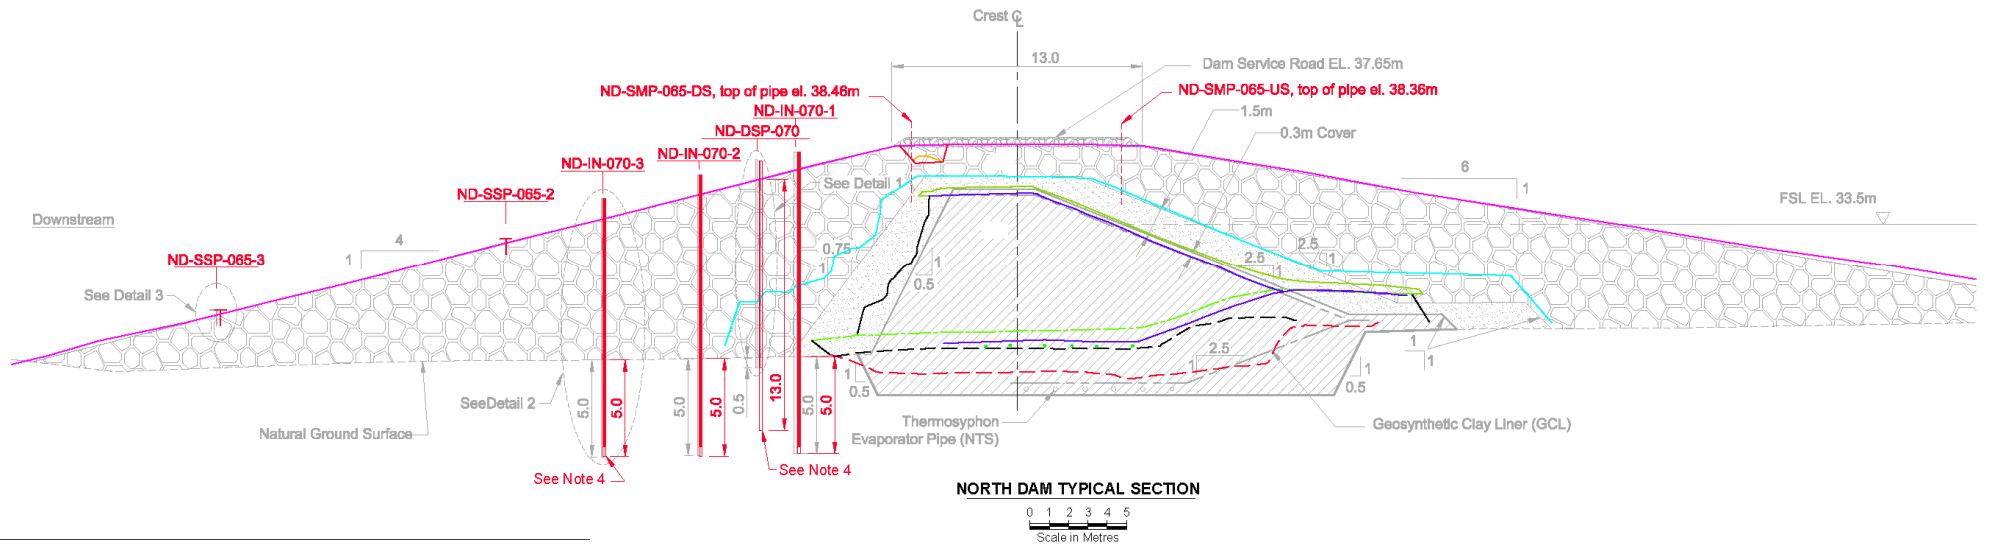


- Core Material
- Transition Material
- Run of Quarry (ROQ)
- Surfacing Material
- Bedrock
- Peat
- GCL As-built
- Core Material As-built
- Core Material (2011) As-built
- Levelling Course (Core Material) As-built
- Instrumentation Trench Cover As-built
- Key Trench / Instrumentation Trench As-built
- GCL Cover Material As-built
- Transition Material As-built
- ROQ Material As-built
- Thermosyphon Evaporator Pipes As-built



Example of as-built instrumentation installed on the downstream of dam.






X:\1CT022.002\_2015\_Hope Bay Ongoing Support\200\_Type\_A\_Water\_License\200\_Tailings\_Management\_Plan\040\_AutoCAD\1CT022.002 - Instrumentation Plan\_Figure21.dwg

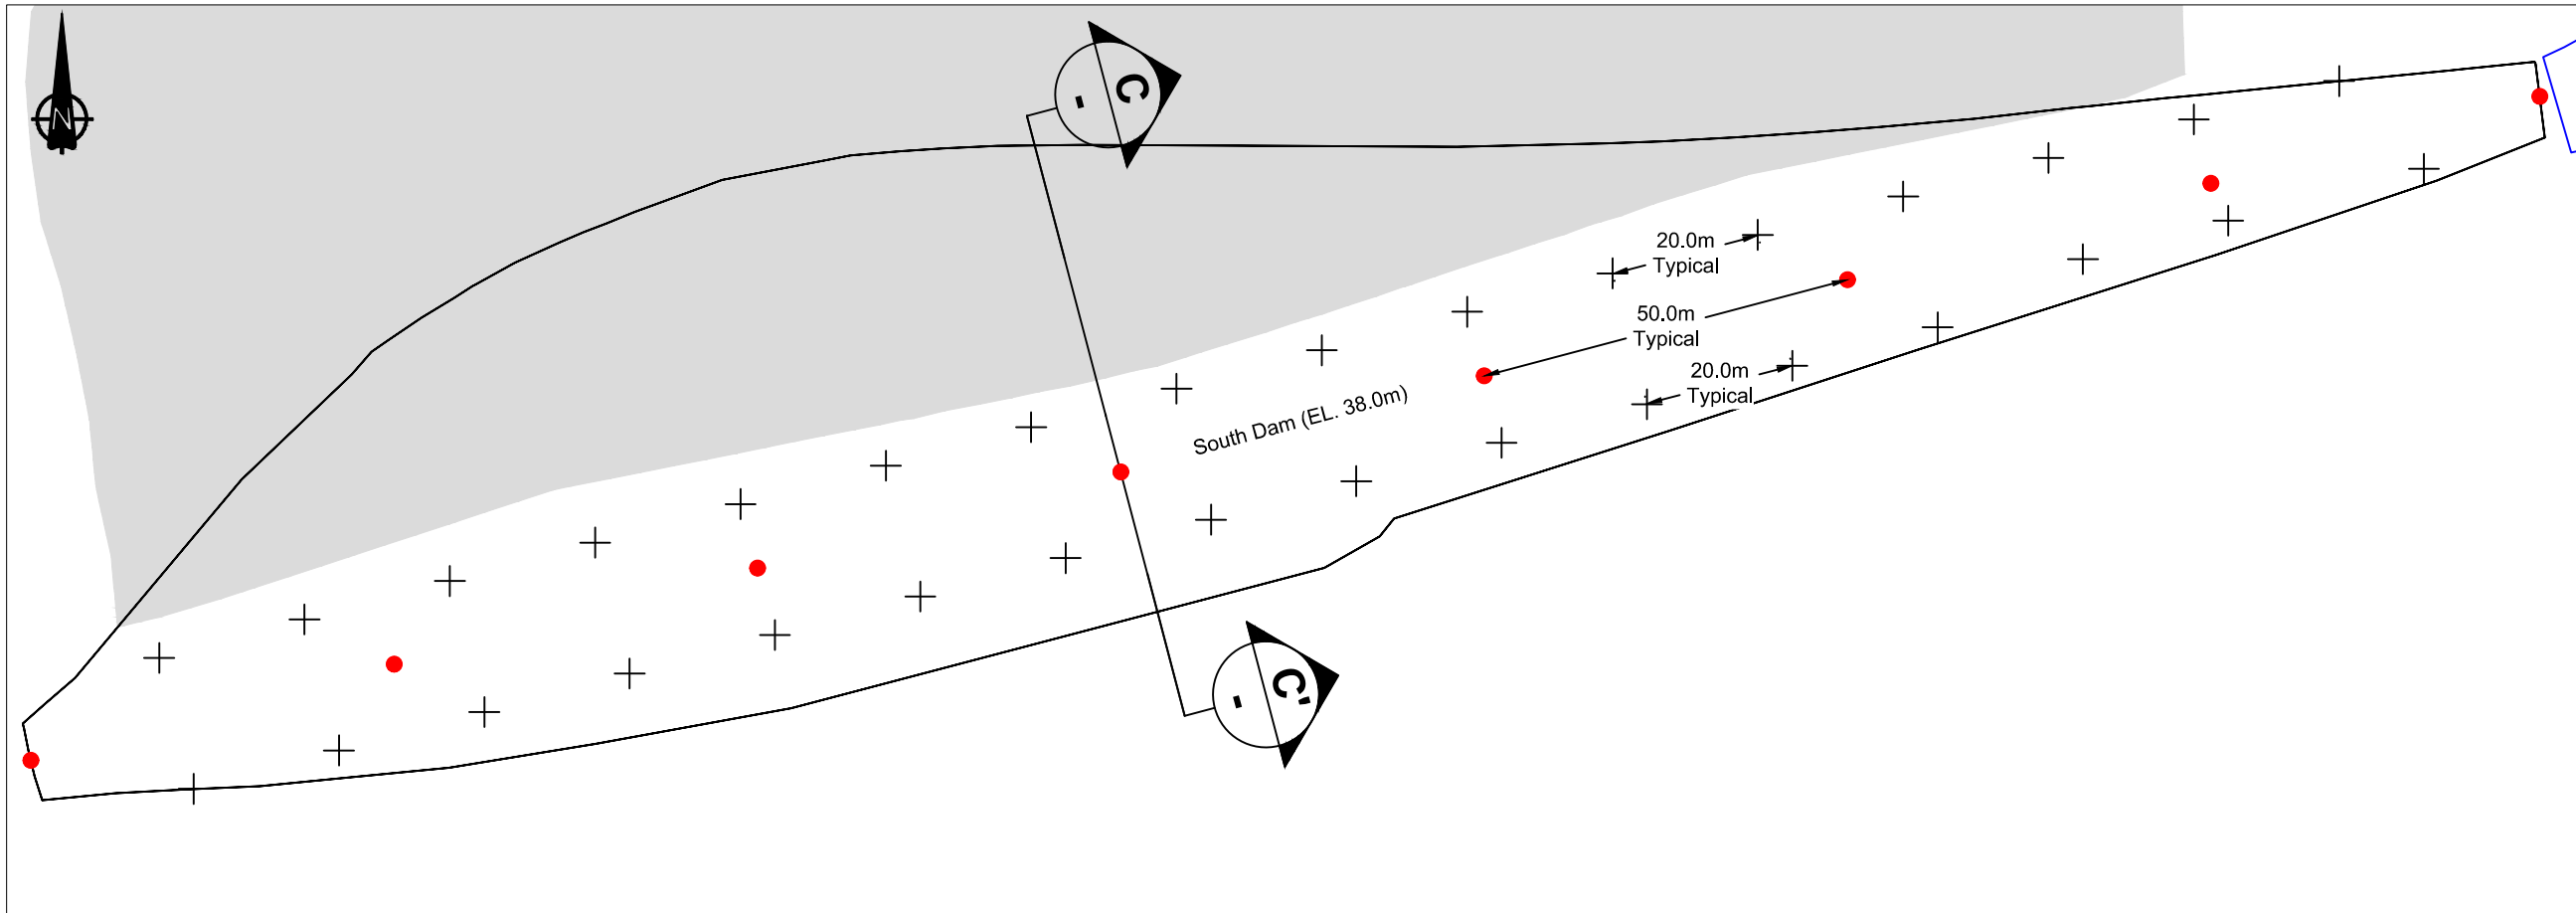


- LEGEND**
- Proposed Thermistor Location
  - ⊕ Proposed Monitoring Point Location
  - Proposed Tailings Surface

- NOTES**
1. Contours shown at 1.0m interval.
  2. Thermistors shall be installed through the centerline of the dam every 50m to a depth of 12m.
  3. The dam crest shall have survey monitoring points at 20m intervals on the upstream and downstream sides.

**PROPOSED SOUTH DAM INSTRUMENTATION**

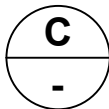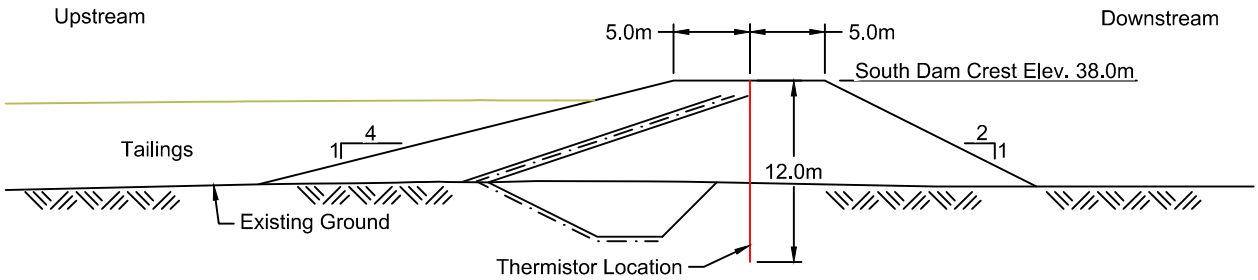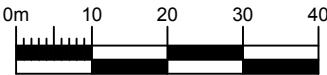

**TYPICAL SECTION THROUGH SOUTH DAM**

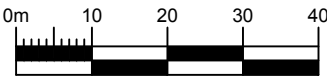

SRK JOB NO.: 1CT022.002.2000  
FILE NAME: 1CT022.002 - Instrumentation Plan\_Figure21.dwg



HOPE BAY PROJECT

DORIS NORTH TIA OMS MANUAL

South Dam Monitoring Instrumentation

DATE: May 2016  
APPROVED: EK/SA  
DRAWING: 16

APPENDIX A:

SUMMARY OF CURRENTLY AVAILABLE DUST CONTROL PRODUCTS

---